

10 STOREY

THAULEEMEE FUND BUILDING

AT BLOCK NO. 369, FALHUMATHEE MAGU

MALE' REPUBLIC OF MALDIVES

EDHURUHIYAA

AS-BUILT DRAWINGS

MINISTRY OF EDUCATION

MALE' REPUBLIC OF MALDIVES

LOCATION PLAN

Map of MALE'




BLOCK NO 369

THALEEMEE FUND 10 STOREY BUILDING
EDHURU HIYA - BLOCK NO : 369 Male'

AS BUILT

DRAWING NO: -

THAULEEMEE FUND 10 STOREY BUILDING - EDHURUHIYAA
AS BUILT

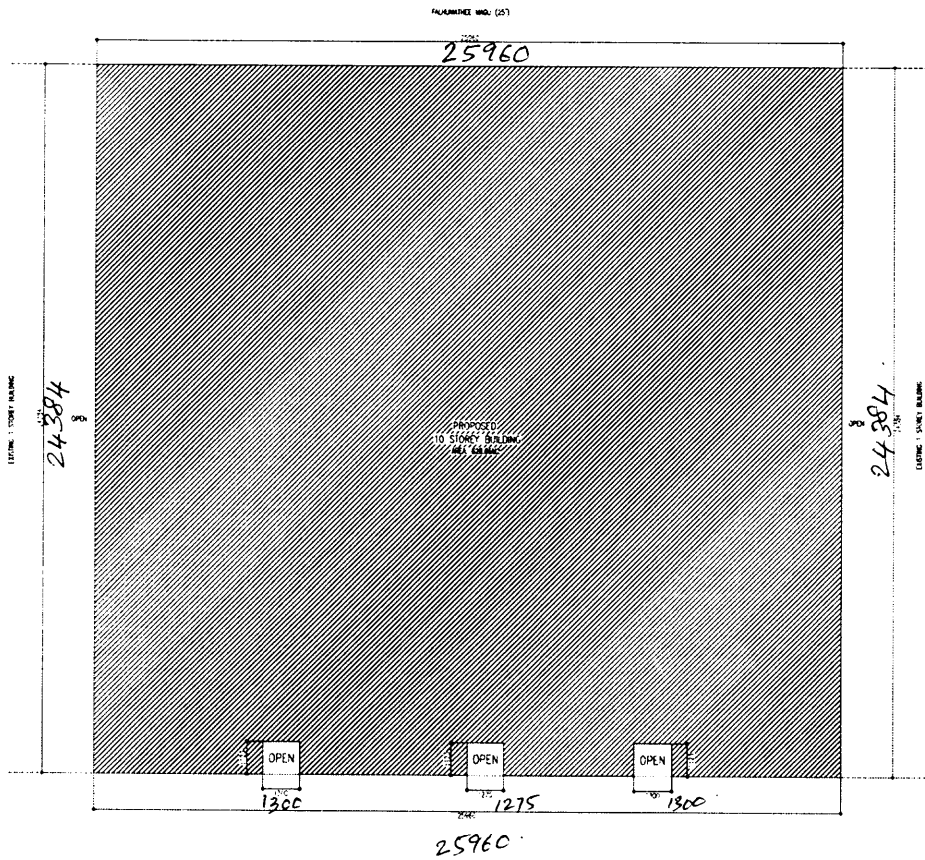


 SITE PLAN 1:100
PARKING/SERVICES/GOODOWN

TOTAL AREA ESTIMATED
AS PER THE AREA SYSTEM

DRAWING NO. A-00

THAULEEMEE FUND 10 STOREY BUILDING
EDHURU HIYA - BLOCK NO : 369 Male'

AS BUILT

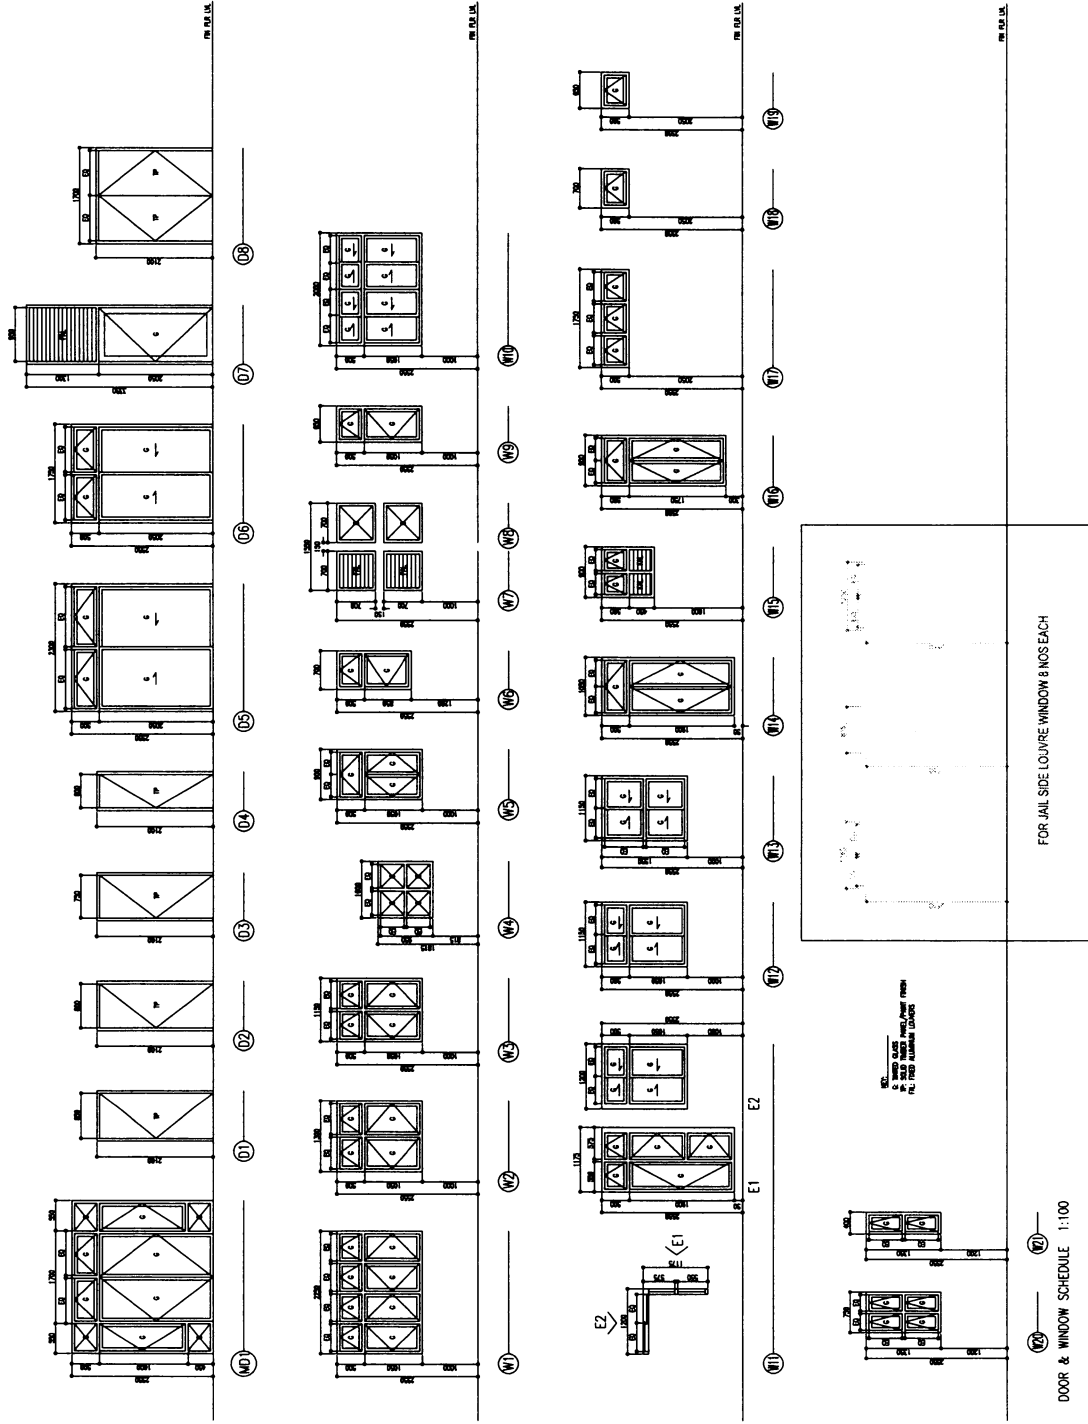


DOOR & WINDOW SCHEDULE 1:100

DRAWING NO: A14

THAULEEMEE FUND 10 STOREY BUILDING
EDHURU HIYA - BLOCK NO : 369 Male'

AS BUILT

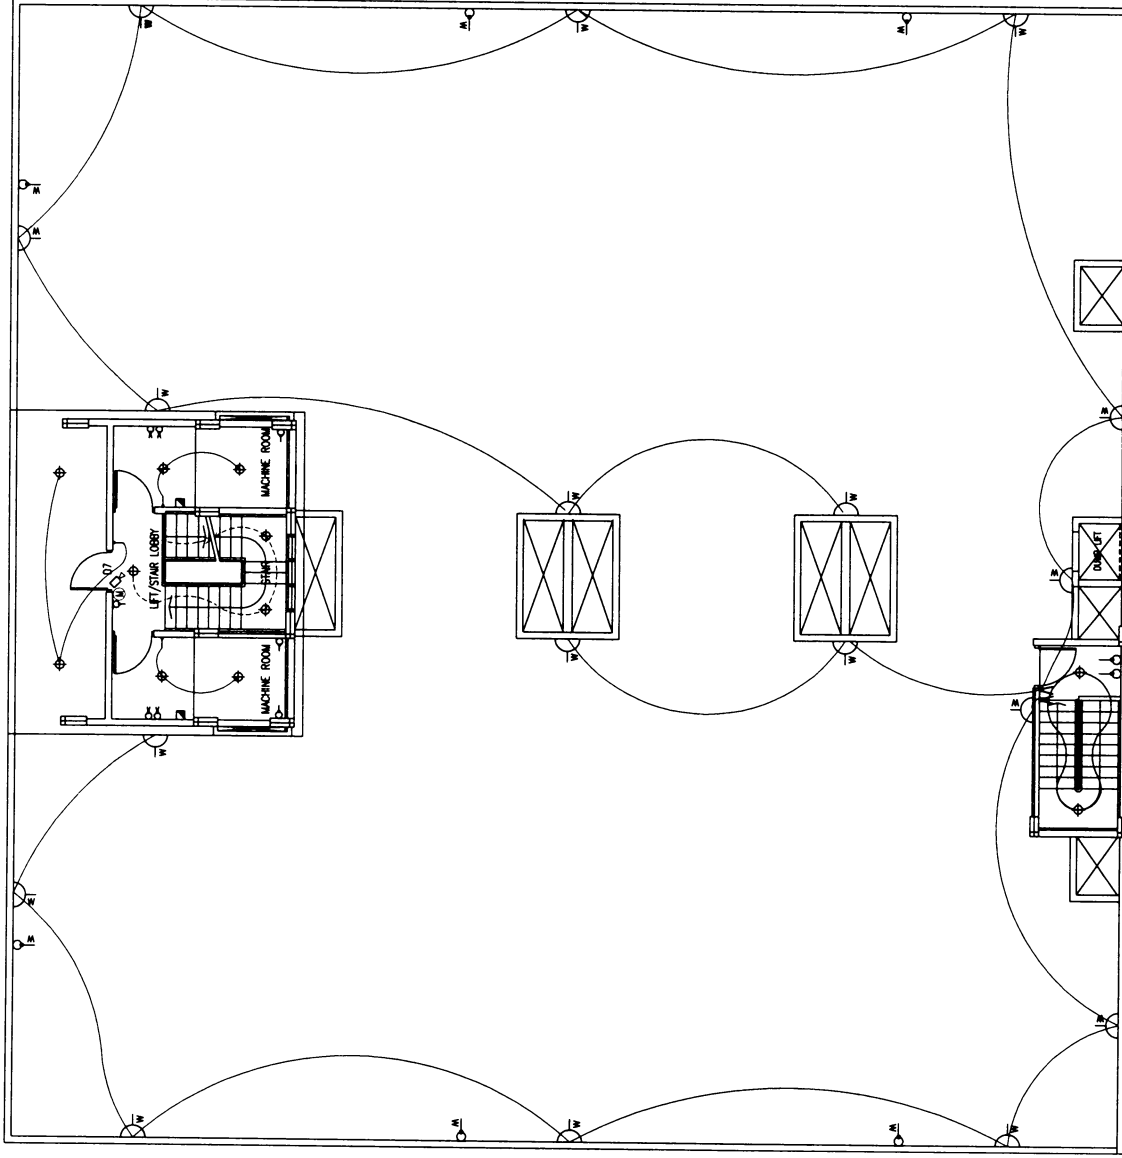


NORTH
TERRACE FLOOR ELECTRICAL LAYOUT 1:100

DRAWING NO: S12/___

THAULEEMEE FUND 10 STOREY BUILDING
EDHURU HIYA - BLOCK NO : 369 Male'

AS BUILT

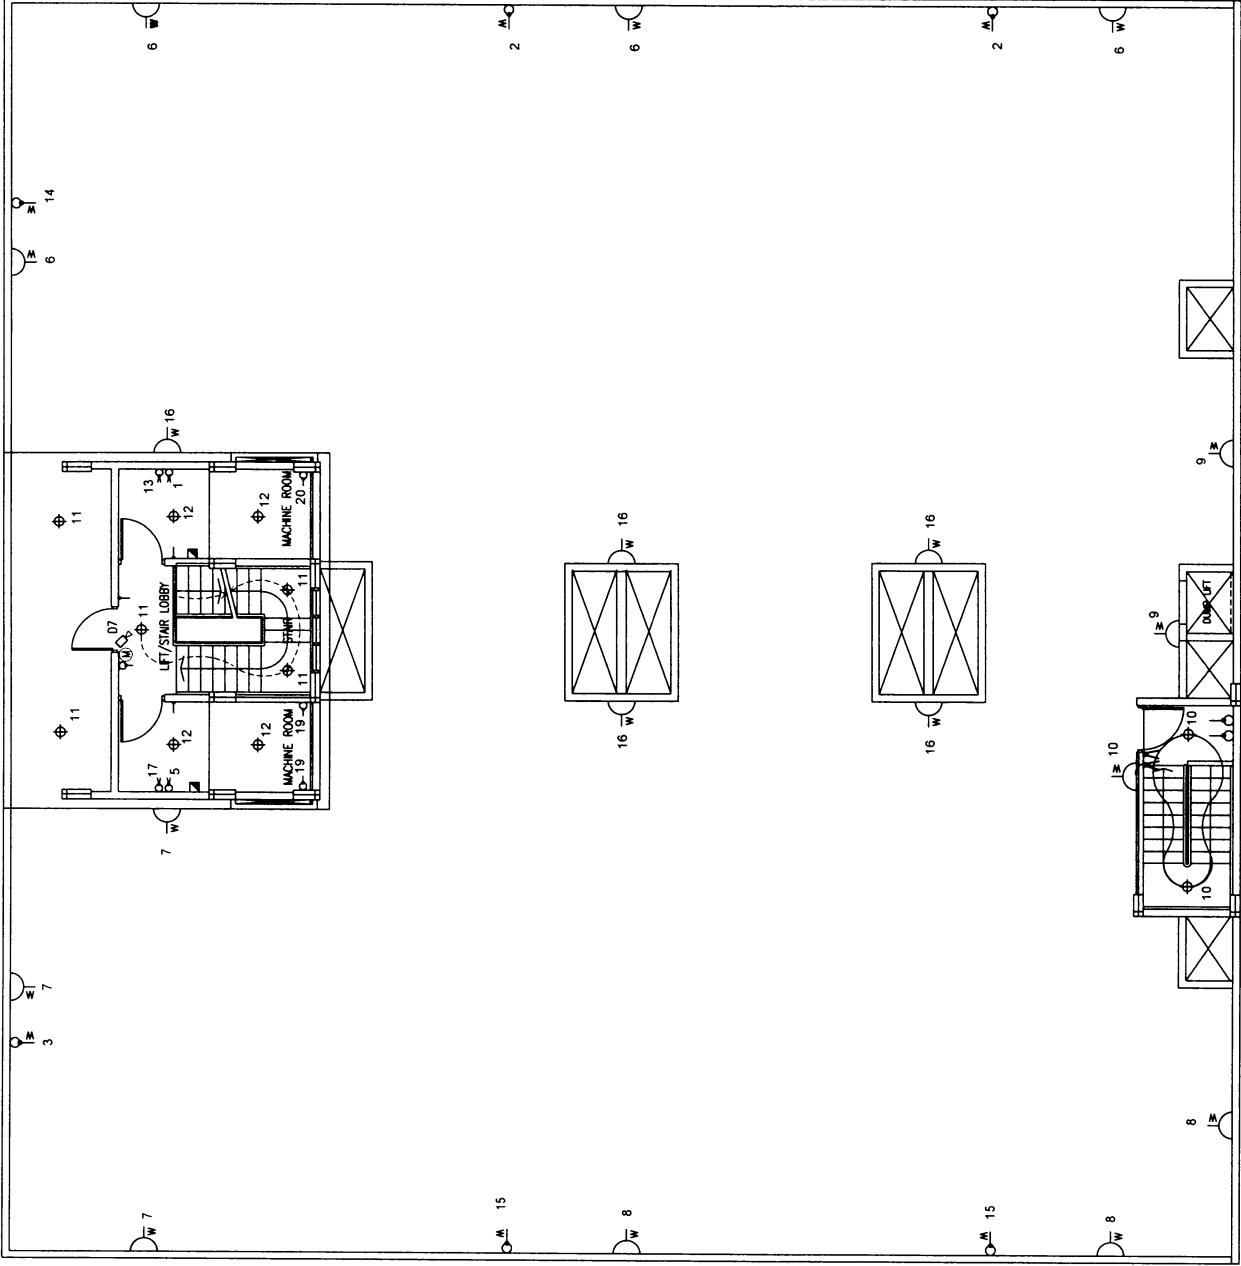



NORTH
ELECTRIC DB CIRCUIT CONNECTION LAYOUT
TERRACE FLOOR


DRAWING NO: S23/___

THAULEEMEE FUND 10 STOREY BUILDING
EDHURU HIYA - BLOCK NO : 369 Male'

AS BUILT

LEGEND		
SIMBOL	ITEM	REMARKS
	PVC pipe 35mm dia	
	PVC pipe 35mm dia	



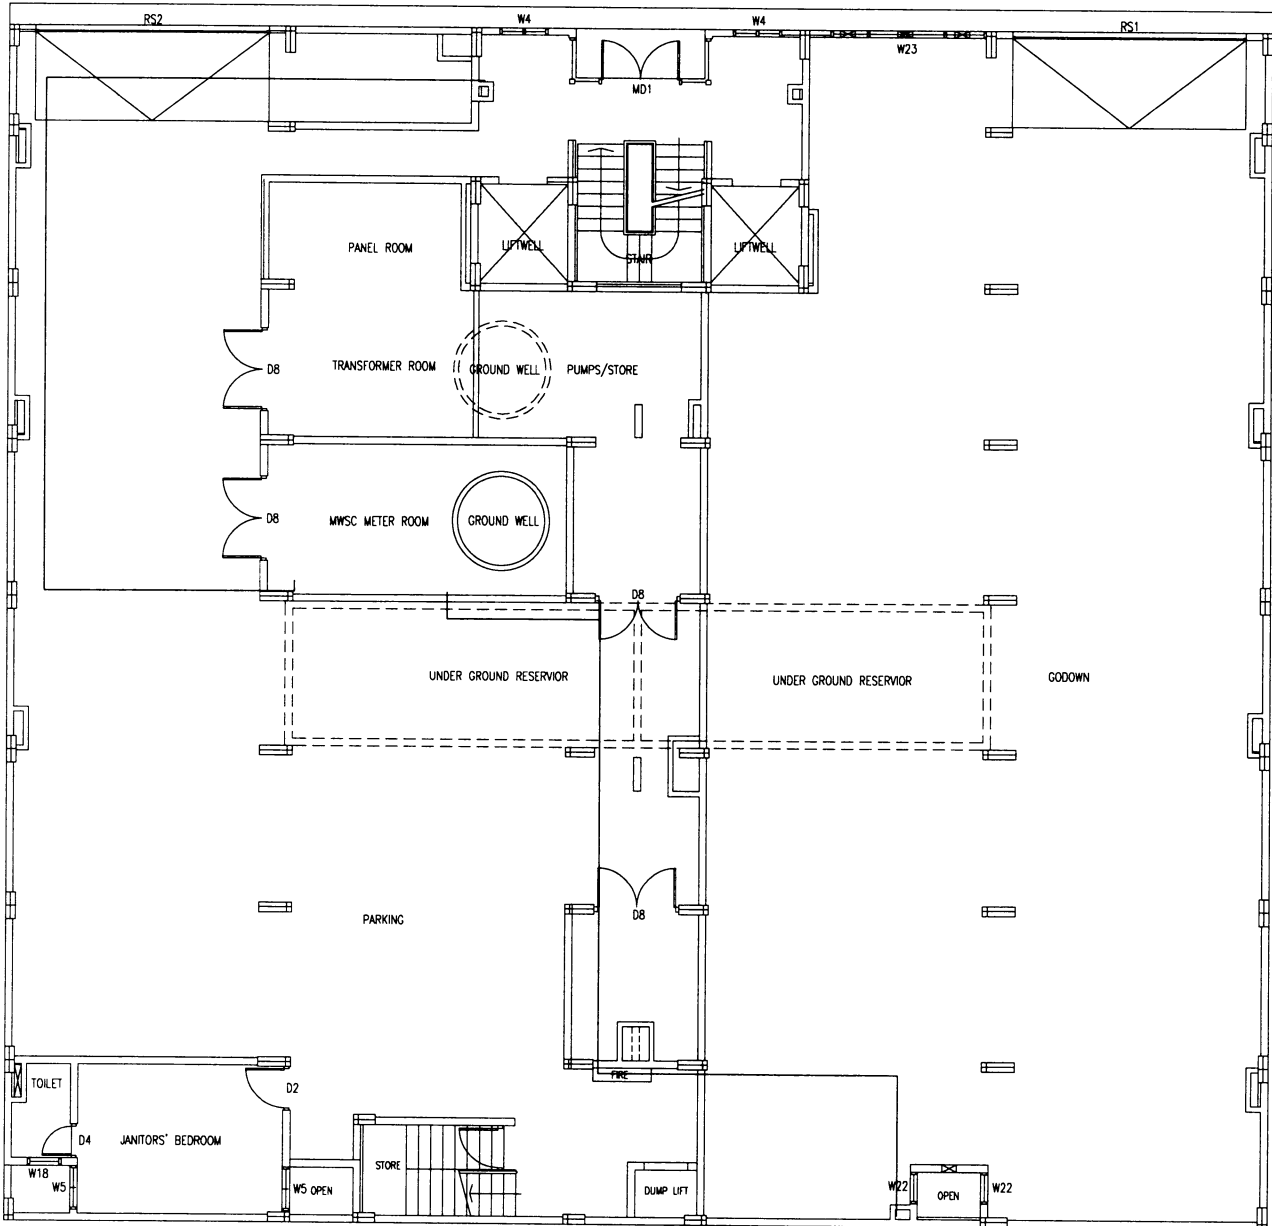


FALHUMATHEE MAGU





PROJECT	CONSTRUCTION OF 10 STOREY THAULEEMEE FUND BUILDING	DRAWN BY : ANSAR . K.A
STAGE/ DRG NO	DRAWING NO: P06-S39	CONTRACTOR: MAALAA HIGH RISING CONSTRUCTION
CONTENTS	MWSC FRESH WATER SUPPLY HORIZONTAL DISTRIBUTION LINE AT 1ST FLOOR BEAM LEVEL-FOR TERRACE FLOOR	

THAULEEMEE FUND 10 STOREY BUILDING
EDHURU HIYA - BLOCK NO : 369 Male'

AS BUILT


LEGEND		
SIMBOL	ITEM	REMARKS
	PVC pipe 2 inch dia	
	PVC pipe 3 inch dia	
	PVC pipe 4 inch dia	
	PVC pipe 6 inch dia	
	PVC BALL VALVE	

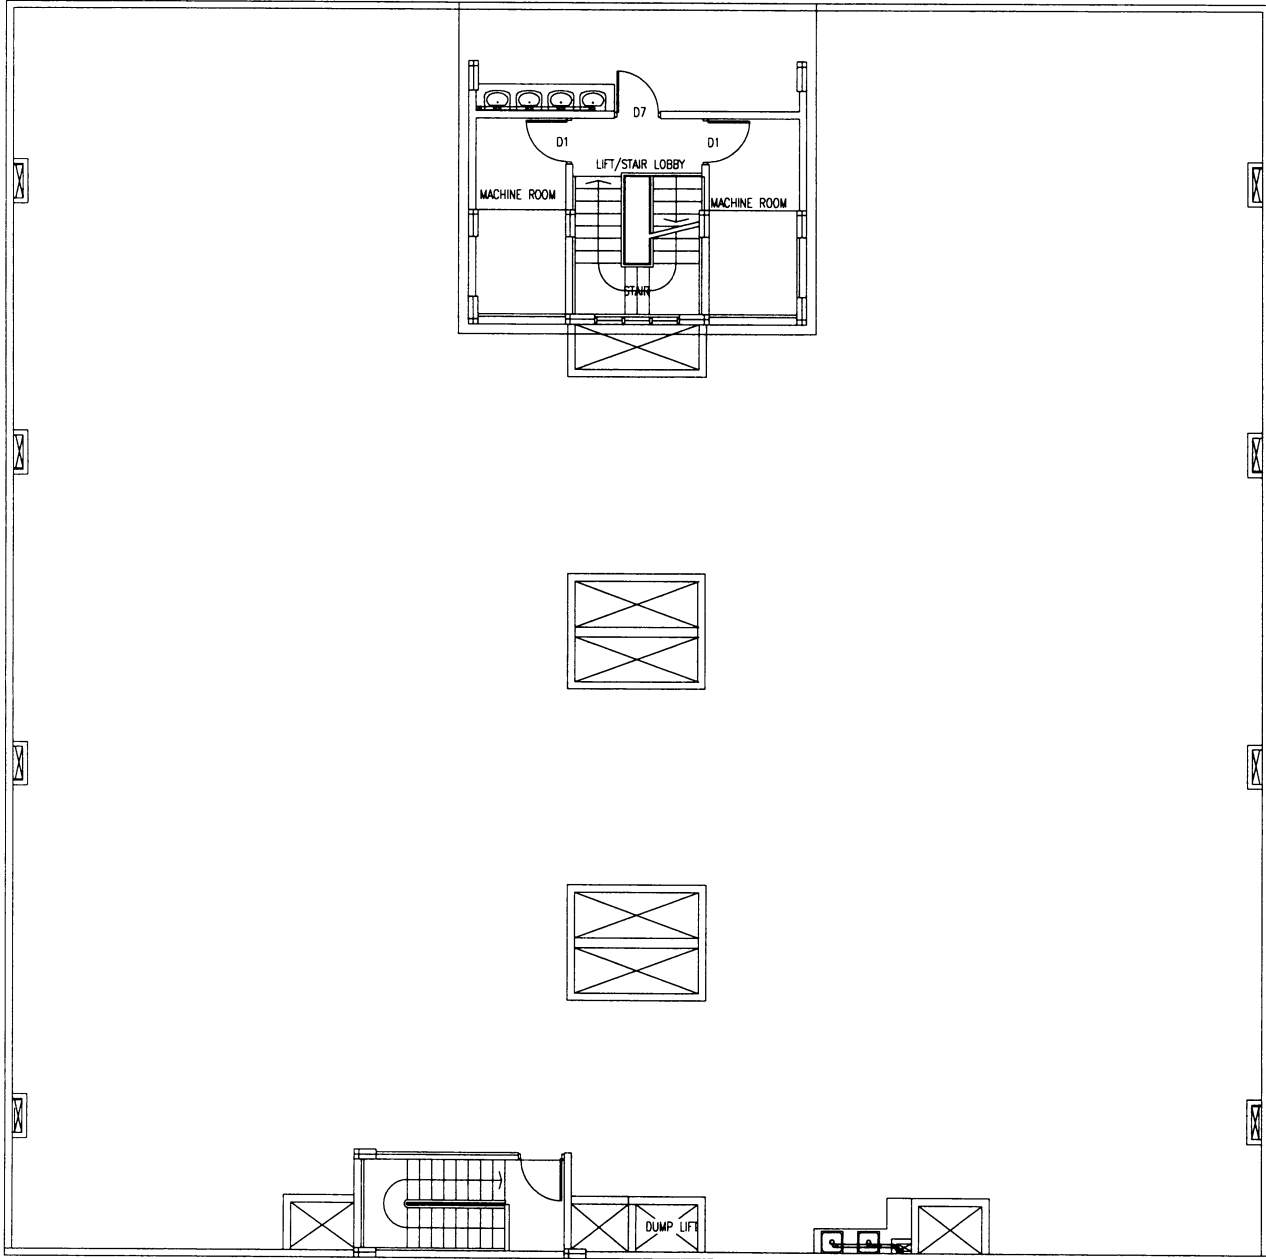

 AS BUILT DRAWING OF SEWER LINE
TERRACE FLOOR PIPE LAY OUT 1:100 (DRAWING NO.P21-S54)

THAULEEMEE FUND 10 STOREY BUILDING
EDHURU HIYA - BLOCK NO : 369 Male'

AS BUILT

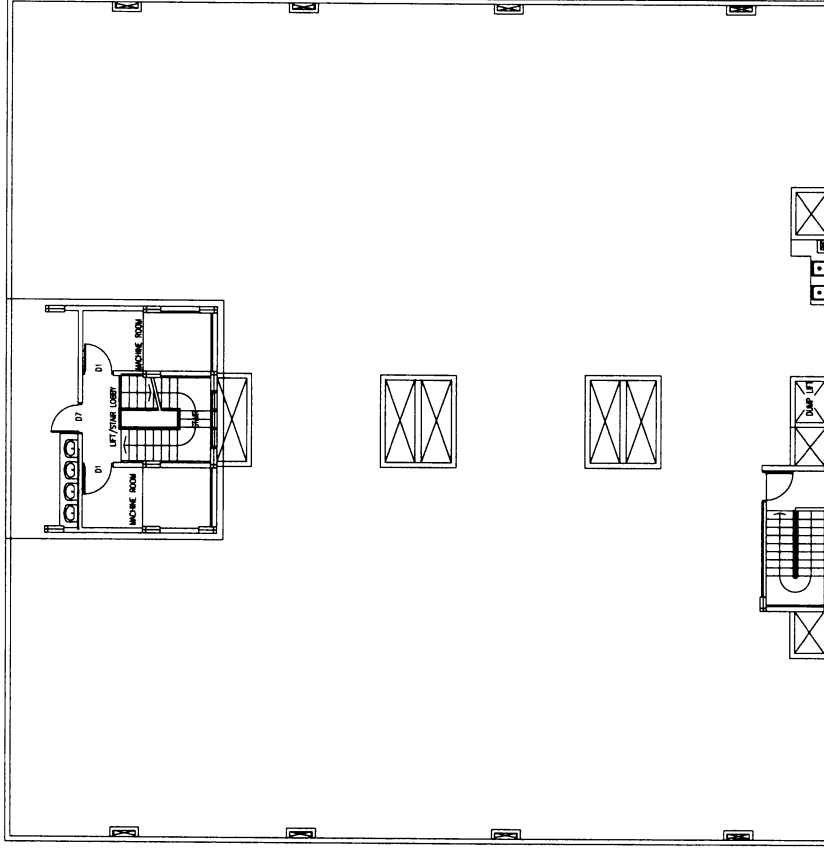

AS BUILT DRAWING OF FRESH WATER DISTRIBUTION LINE
TERRACE FLOOR PIPE LAY OUT 1:100
(DRAWING NO. 555/...)

