
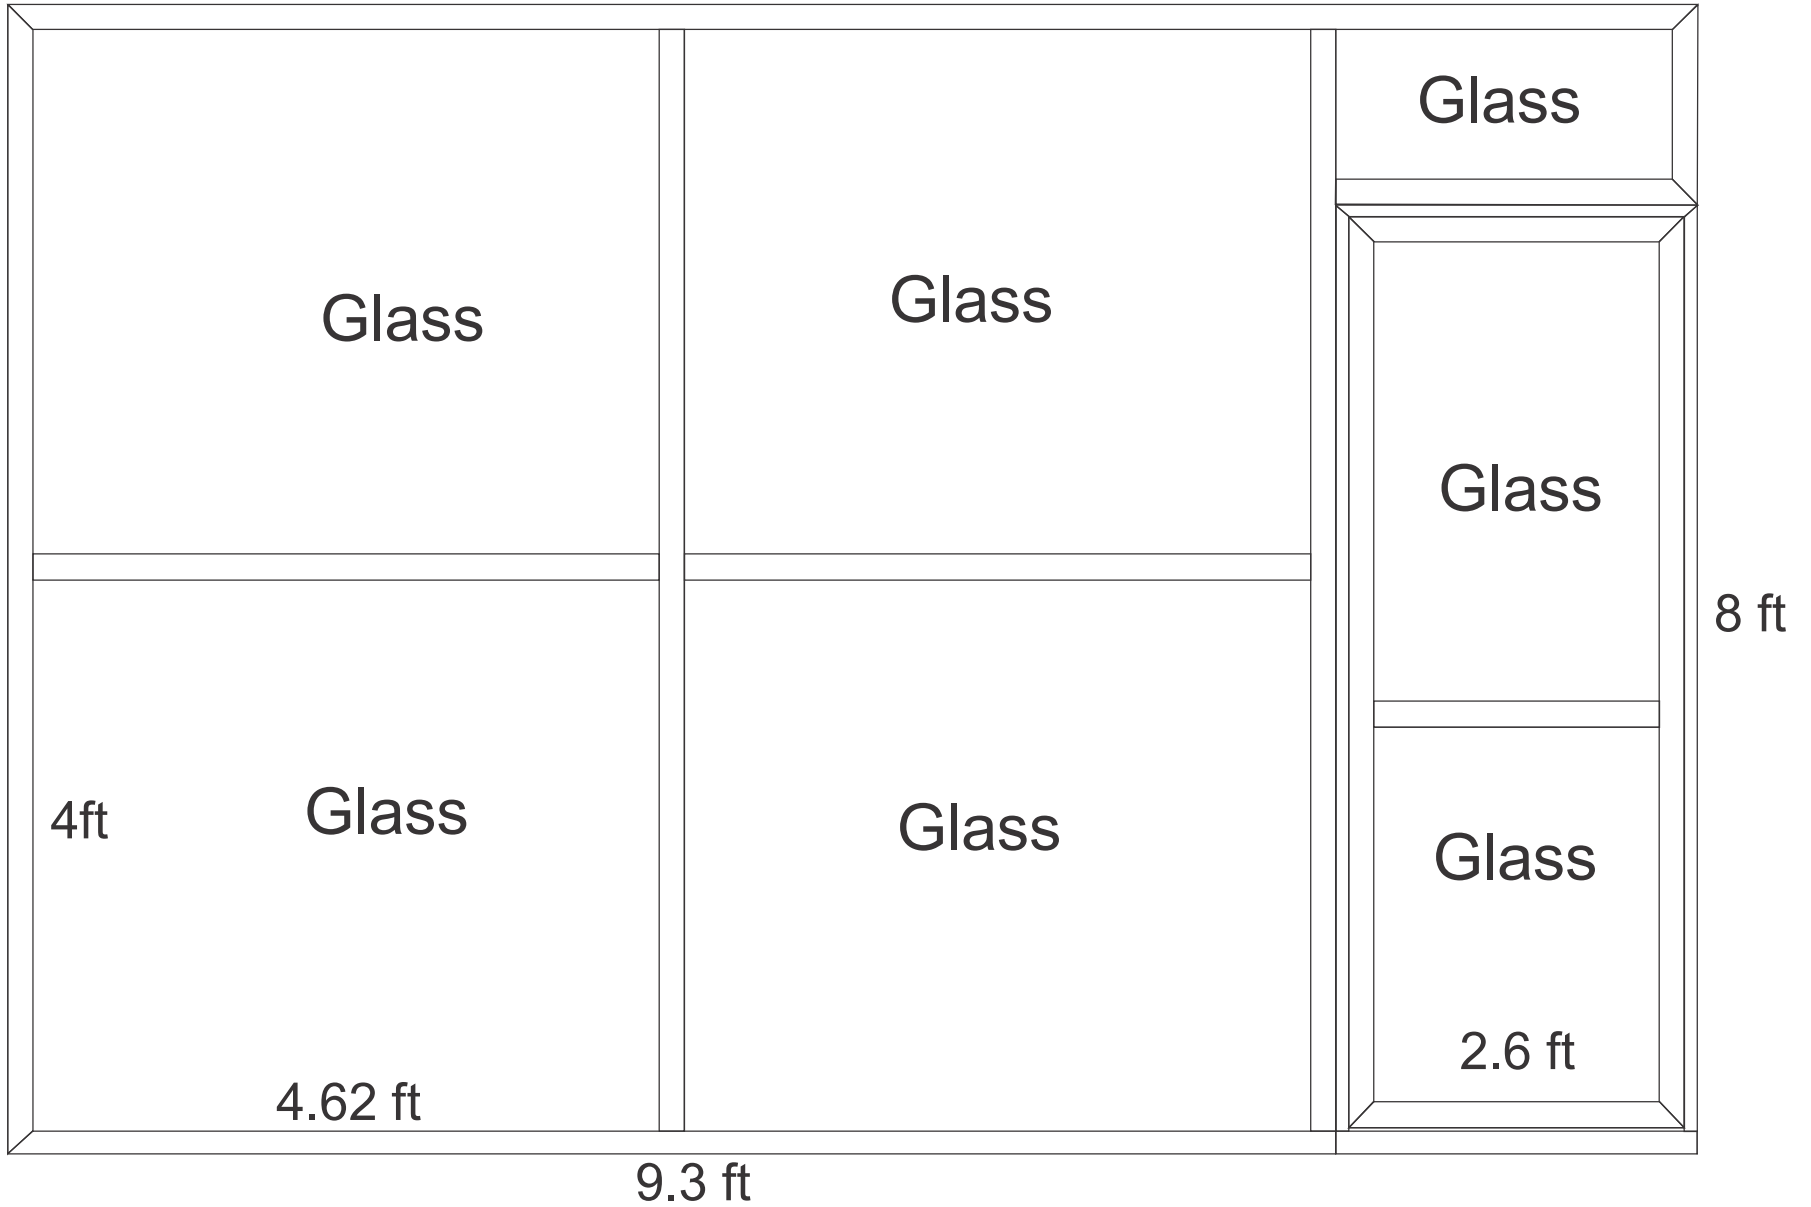


AS BUILT

 NORTH
FLOOR PLANS -AS BUILT-
GROUND FLOOR LAYOUT 1:100 (DRAWING NO. A-01)

D1

11.10 ft



Glass

Glass

Glass

Glass

4ft

Glass

Glass

Glass

8 ft

4.62 ft

2.6 ft

9.3 ft



Clear Glass

2 feet

Frost Sticker


White Aluminium

White Glass

4 feet

4 feet

4 feet

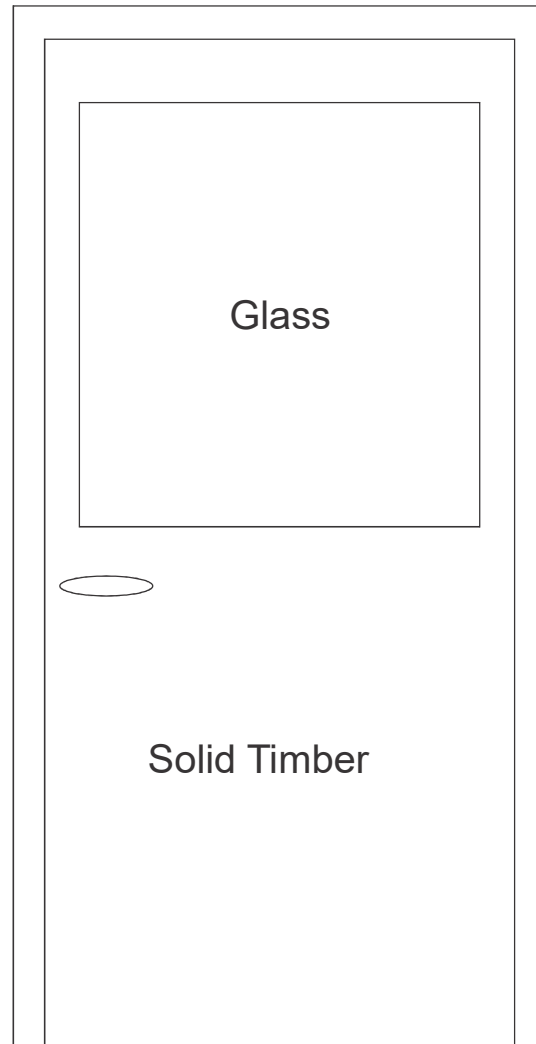

D2

All timber doors shall be 40mm thick solid timber paneled door and