
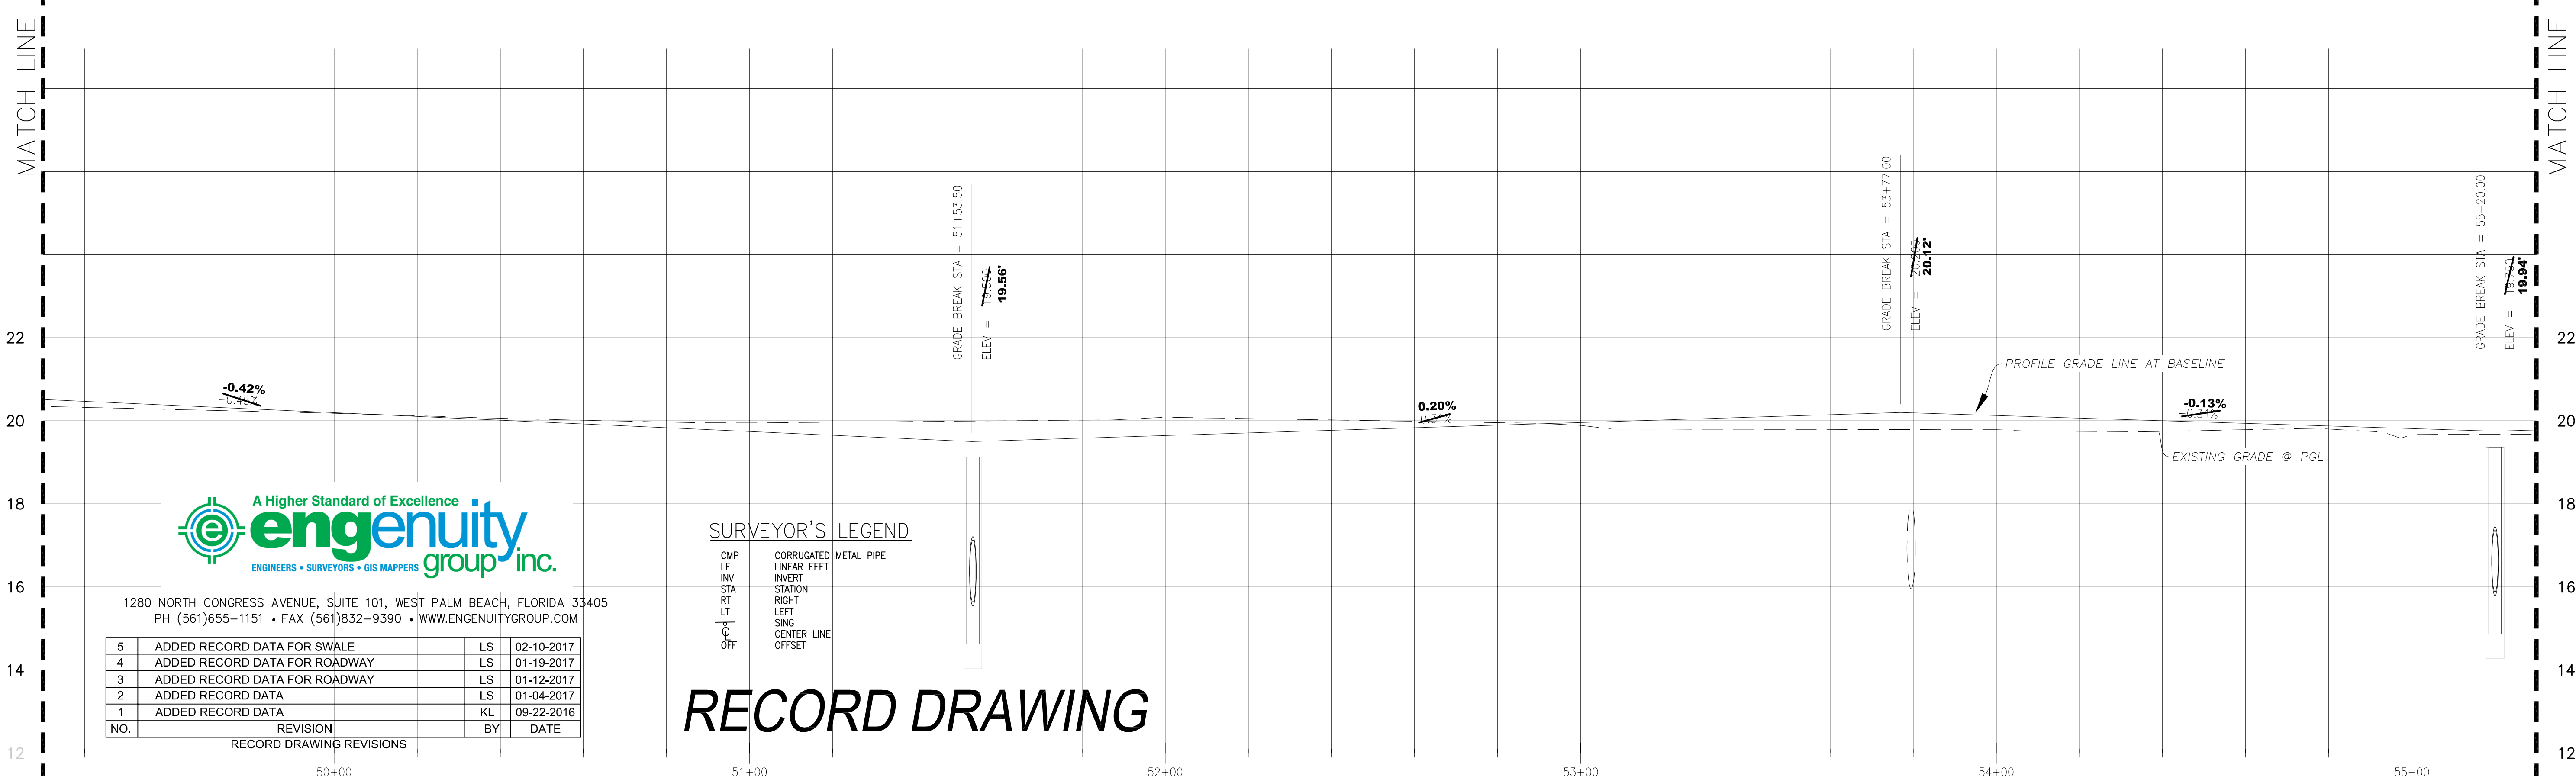


PLOT DATE: Mar 15, 2017 TIME: 8:00am BY: Jennifer
DRAWING: Y:\Land Projects R2\1602101 B Road Loxahatchee Pavement Surfacing\DWG\Page C08-C17.dwg LAYOUT: C12

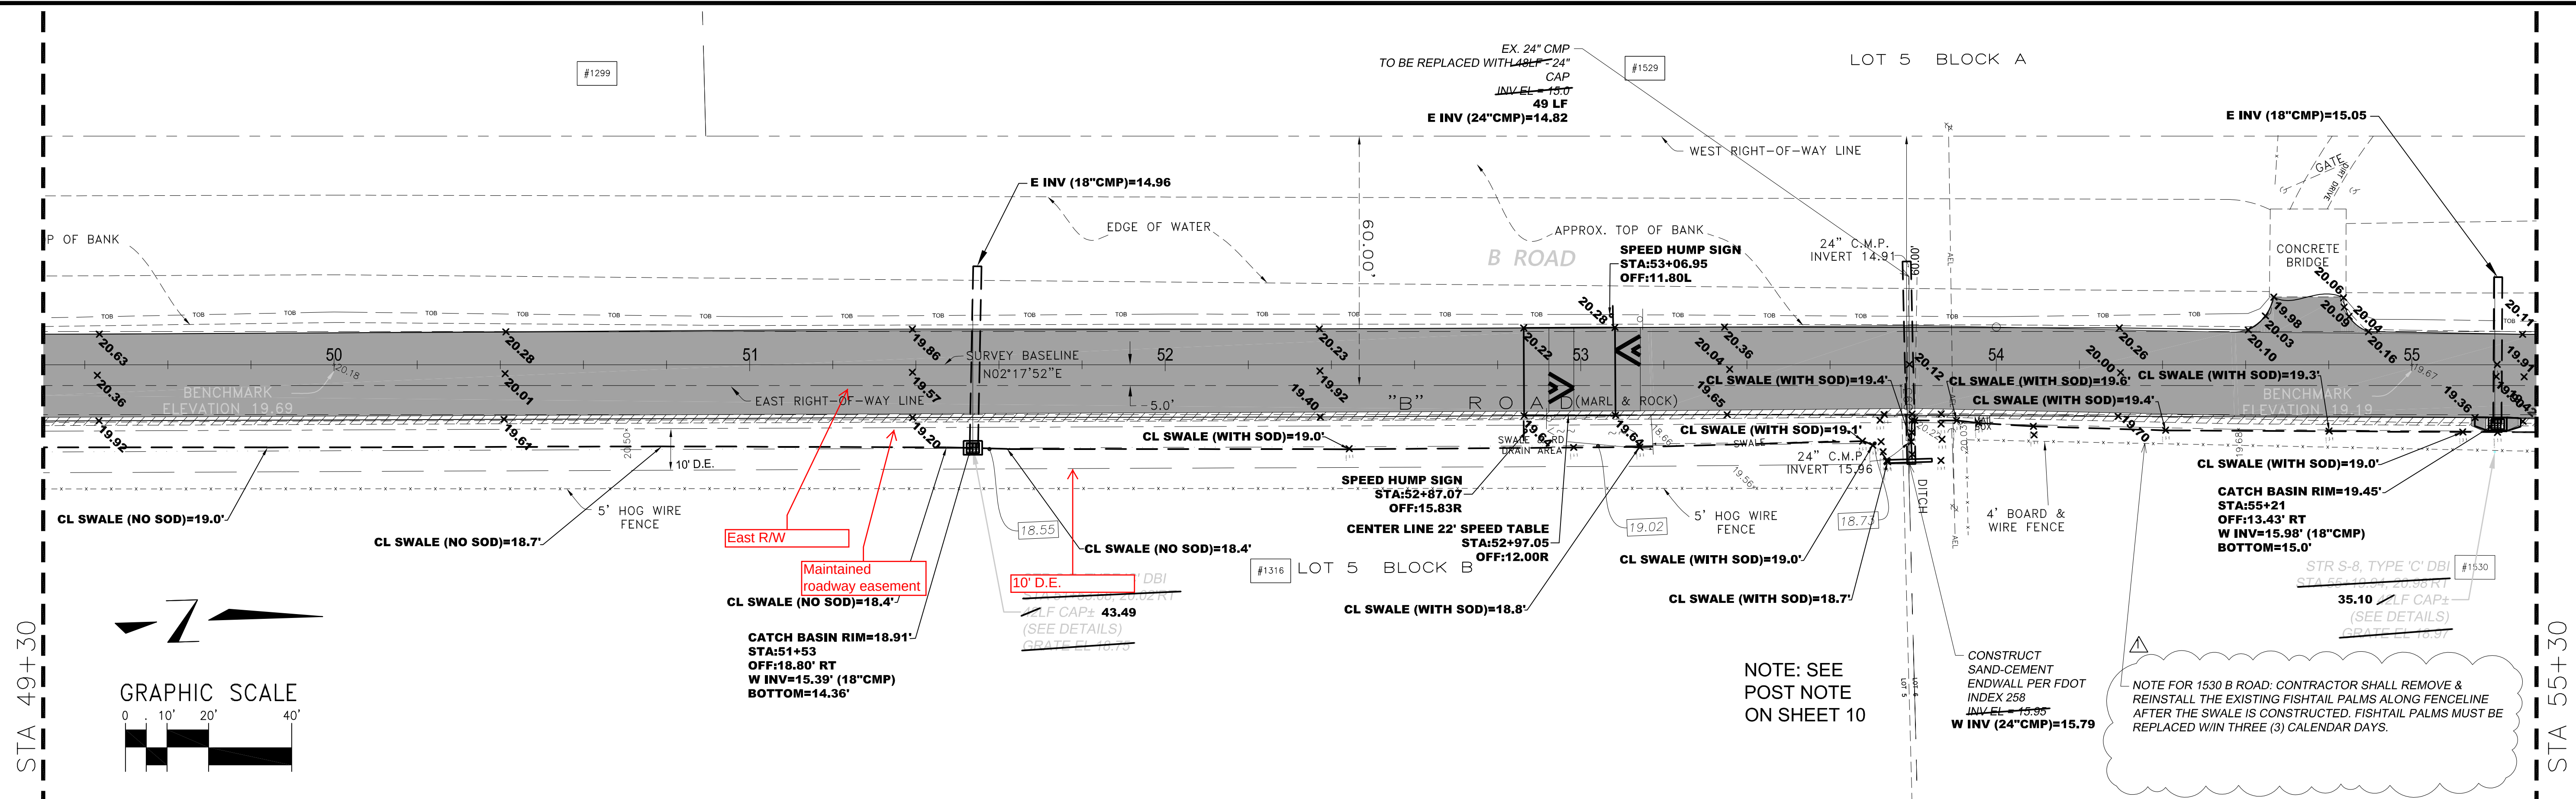

engenuity
group inc.
ENGINEERS • SURVEYORS • GIS MAPPERS

1280 NORTH CONGRESS AVENUE, SUITE 101, WEST PALM BEACH, FLORIDA 33405
PH (561)655-1151 • FAX (561)832-9390 • WWW.ENGUNITYGROUP.COM

SURVEYOR'S LEGEND

SYMBOL	DESCRIPTION
CMP	CORRUGATED METAL PIPE
LF	LINEAR FEET
INV	INVERT
STA	STATION
RT	RIGHT
LT	LEFT
C	SING. CENTER LINE
OFF	OFFSET

RECORD DRAWING

LEGEND EXISTING

SYMBOL	DESCRIPTION
WATER METER	WATER VALVE
FIRE HYDRANT	BACK FLOW PREVENTER
SANITARY MANHOLE	SANITARY CLEAN OUT
SANITARY SEWER VALVE	STORM CATCH BASIN
STORM MANHOLE	TELEPHONE MANHOLE
TELEPHONE SPUR BOX	TELEPHONE RISER
WOOD LIGHT POLE	STREET ADDRESS
MAIL BOX	CABLE TELEVISION RISER

LEGEND PROPOSED

SYMBOL	DESCRIPTION
WATER MAIN	WATER SERVICE
RESTRAIN JOINT	PROPOSED WM GATE VALVE
PROPOSED FIRE HYDRANT	PROPOSED FIRE HYDRANT
PROPOSED INSERTION VALVE	PROPOSED INSERTION VALVE

VERTICAL DATUM


ALL ELEVATIONS SHOWN (EXISTING OR PROPOSED) ARE IN NATIONAL GEODETIC VERTICAL DATUM OF 1929 (NGVD 29)

IT'S THE LAW !

CALL 48 HOURS BEFORE YOU DIG
1-800-432-4770
SUNSHINE STATE ONE CALL OF FLORIDA, INC.
UTILITIES NOTIFICATION CENTER



Town of Loxahatchee Groves
155 F Road
Loxahatchee Groves, Florida 33470

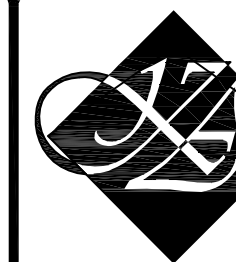

Keshavarz & Associates, Inc.
CONSULTING ENGINEERS - SURVEYORS
711 North Dixie Highway, Suite 201
West Palm Beach, Florida 33401
Tel: (561) 689-8600

FIELD BY: Adair & Brady
FIELD BOOK: PG.
DESIGNED BY: Allen T Green Jr
DRAWN BY: Amir Hadjimiri
CHECKED BY: Randy Wertepny
APPROVED BY: M. Keshavarz
DATE: Mar 15, 2017

PROJECT No.
14-1057
SHEET No.
C12

Randy Wertepny
P.E. 72504
Mar 15, 2017

ROADWAY PLAN and PROFILE
B ROAD PAVEMENT SURFACING

Town W.A. No.
14-1057

NO.	DATE	REVISION / REMARKS
1	4/2/16	REVISED DURING BID AUDIUM NO.3