



TOWN OF LOOMIS
3665 Taylor Road
P.O. Box 1330
Loomis, CA 95650
(916) 652-1840

February 22, 2024

ATTN: All Prospective Bidders
PROJECT: Storm Drain Culvert Replacement Project #22-14
SUBJECT: **ADDENDUM NO. 2**
ISSUED BY: Merrill Buck, Town Engineer

General:

This addendum is being issued to address questions raised by bidders during the bidding period. It is also being issued to shift the project from being a Spring project to a Summer project, to reduce the amount of additional potential work in dewatering and bypass pumping that might otherwise be required. As a result of this, the bid opening date has been extended.

This addendum shall hereby be made a part of the contract documents as though it was originally included. The addendum consists of this memo along with all the following pages and attachments.

Addendum Item	Contract Document	Part/Section	Description of Change
1. Updated Bid Bond Form	Specifications	Page B-11 Bid Guarantee Form	Please use the revised Bid Guarantee Form (Attachment A; 1 page)
2. Updated Sheet 22	Plans	Sheet 22 of 30	Please replace Sheet 22 of the plans with the revised Sheet 22. (Attachment B; 1 page)

The Contract Documents are hereby clarified, corrected, and changed as indicated below:

Bid Opening Date:

The bid opening date has been extended and will now occur on Thursday, March 21, 2024 at 10:00am.

Contract Duration:

The project duration stated in the Notice Inviting Bids shall be modified to instead be 100 working days.

Questions and Answers to Date:

- Q: Will the Town allow ADS HP storm pipe instead of the RCP pipe called out on the plan?
A: No. The Town will require RCP to be installed where called out on the plans.
- Q: Page 22 of 30 Plans says 12" RCP but Note 1 says 12" HDPE. Could you please clarify?
A: The intention is to have 12" RCP installed at Location #22, shown on Sheet 22. Please see Addendum Item Number 2 in the table above and Attachment B to this Addendum for correction.
- Q: Is there a rock clause for this project if the contractor should run into it during excavation?
A: No. There is not a rock clause for this project. Bedrock is not anticipated because most of the culverts are being replaced in their current location. Contractors shall bid the work under the

assumption that special equipment to remove bedrock will not be required. Should conditions turn out to be otherwise, the Town will pay for the additional effort by change order.

4. Q: Where exactly is the staging area the Town will provide for this project? How large is the area?
A: The Town will provide a staging area on Town owned land off Mandarin Court at Rippey Road. It is roughly 100 feet by 150 feet, as shown below. The area is not fenced, and the project does not require the staging area to be fenced. Should the contractor wish to do so, security fencing would be provided and paid for at the contractor's sole cost, under the bid item for mobilization.



5. Q: Can the replacement striping be done after all the paving is complete on the project.
A: Temporary delineations (floppies) or temporary striping tape may be used until all paving on the project is complete, so long as it is maintained in good condition.

Acknowledgement of Addendum 1:

Receipt of this Addendum must be acknowledged by bidders. Acknowledgement shall be made by signing and submitting at least **this page** with the bid proposal.

Signature: _____

Printed Name of Person Signing: _____

Name of Firm: _____

Questions:

If you have any questions or concerns regarding this Addendum please contact Laurie Loaiza at (530) 968-4235 or loaiza@coastlandcivil.com.

Prepared by:

A handwritten signature in blue ink that reads "Laurie M. Loaiza".

Laurie Loaiza, Engineer of Record

- Attachments:** A. Replacement Bid Guarantee Form
B. Replacement Plan Sheet Page 22

BID GUARANTEE

To Accompany Contract Proposal

KNOW ALL PERSONS BY THESE PRESENTS:

That we, the undersigned _____, as principal and _____, as surety, are held and firmly bound unto the Town of Loomis as OWNER in the penal sum of TEN PERCENT (10%) of the total amount of the bid of the principal, for the payment of which, well and truly to be made, we hereby jointly and severally bind ourselves, successors and assigns.

The condition of the above obligation is such that whereas the Principal has submitted to OWNER a certain BID, attached hereto and hereby made a part hereof to enter into a contract in writing, for the **Town of Loomis Storm Drain Culvert Replacement Project**.

NOW, THEREFORE

- (a) If said BID shall be rejected, or
- (b) If said BID shall be accepted and the Principal shall execute and deliver a contract in the Form of Contract attached hereto (properly completed in accordance with said BIDS including all required bonds for faithful performance and labor and material, as well as all required evidence of insurance) then this obligation shall be void, otherwise the same shall remain in force and effect.

In the event the Town brings suit upon this Bond, surety shall pay reasonable attorney's fees and costs incurred by the Town in such suit.

The Surety, for value received, stipulates and agrees that the obligations of said Surety and its BOND shall be in no way impaired or affected by any extension of the time within which the Town of Loomis may accept such BID; and said Surety does hereby waive notice of any such extension.

IN WITNESS WHEREOF, the Principal and the Surety have hereunto set their hands and seals, and such of them as are corporations have caused their corporate seals to be hereto affixed and these presents to be signed by their proper officers, this day and year first set forth.

By: _____ (L.S.) By: _____
 (Principal) (Seal) (Surety) (Seal)

Subscribed and sworn to before me, a Notary Public in and for the State of California, County of

_____, this _____ day of _____, 20_____.


Signature of Notary Public: _____ (Seal)

My Commission expires _____, 20_____

IMPORTANT: Surety companies executing BONDS must be authorized to transact Surety insurance in the State of California. If Contractor is Partnership, all partners should execute BOND.

FOR REDUCED PLANS, THE ORIGINAL SCALE IS IN INCHES


Path: F:\Civil 3D Projects\654923 - Loomis CIP\Plan Sets\Culvert Reconstruction\DWG\654923-SP.dwg Layout Name: Loc#22 Plot Date: Feb 15, 2024 at 10:12 am

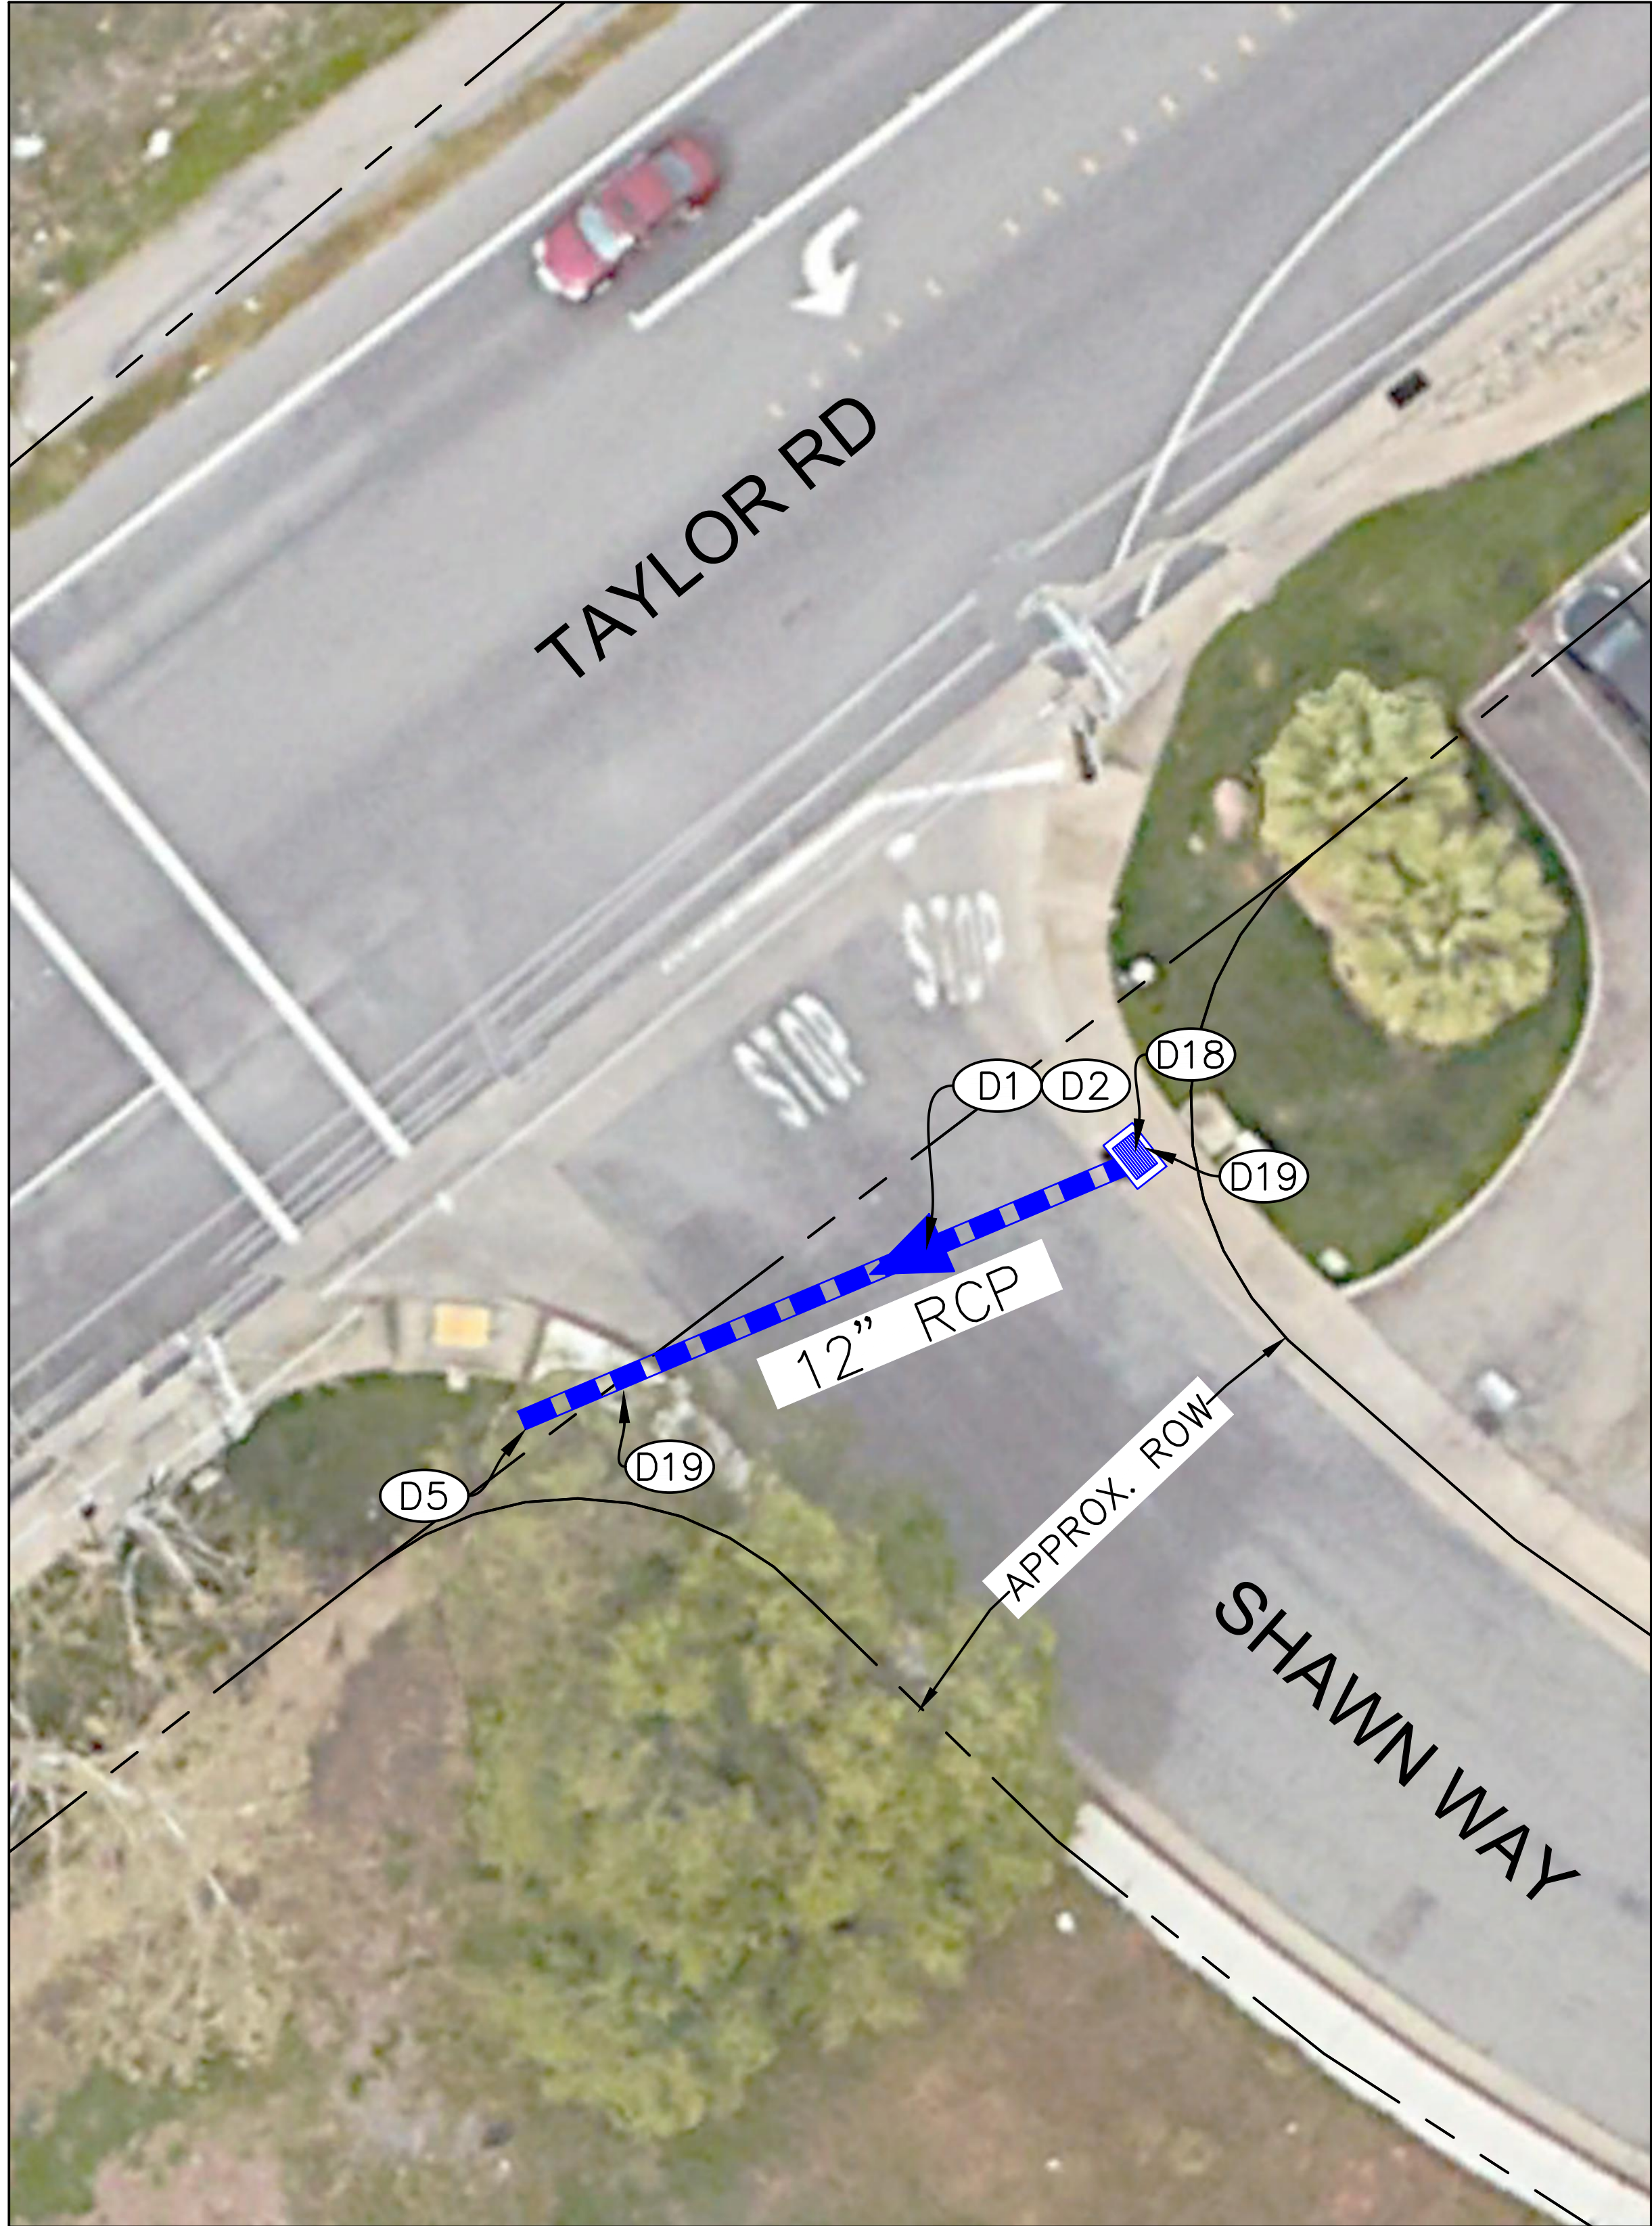

LOCATION #22 - SHAWN WAY AT TAYLOR ROAD




STRUCTURE LOCATED NORTH OF SHAWN WAY RD (LOOKING NORTH)

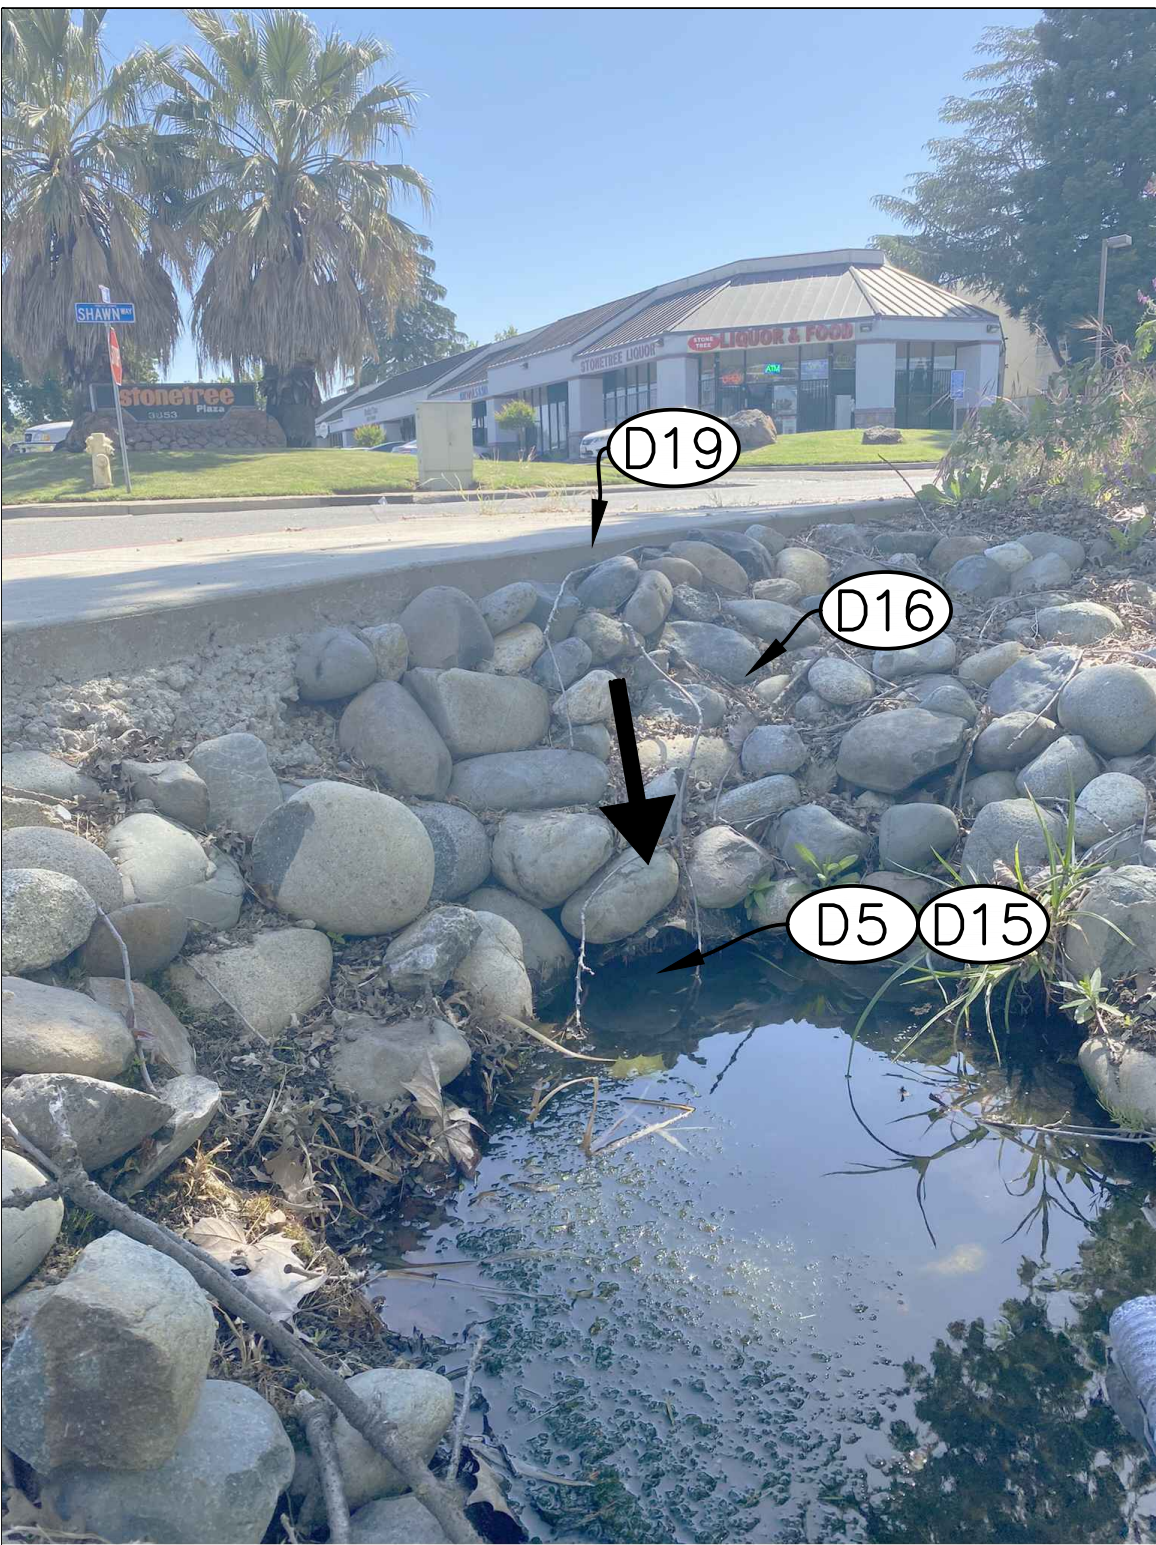

OUTFALL LOCATED SOUTH OF SHAWN WAY RD (LOOKING NORTH)

- CONSTRUCTION NOTES**
- D1 REMOVE EXISTING 12" CMP AND INSTALL APPROXIMATELY 55 LF OF 12" RCP STORM DRAIN PIPE. SLOPE TO DRAIN AT MINIMUM 0.5% OR MATCH EXISTING SLOPE, WHICHEVER IS GREATER. INFORM ENGINEER IF MINIMUM SLOPE OF 0.5% IS NOT ACHIEVABLE.
 - D2 TRENCH PAVING PER DETAIL 3. REPLACE STRIPING IN KIND.
 - D5 INSTALL OUTLET PROTECTION PER DETAIL 2.
 - D15 RAISE END OF PIPE UP 12". CONTRACTOR SHALL VERIFY THAT RAISING THE DOWNSTREAM END OF THE PIPE STILL ALLOWS FOR POSITIVE DRAINAGE. IF A MINIMUM SLOPE OF 0.5% CAN NOT BE PROVIDED, CONTRACTOR SHALL NOTIFY THE ENGINEER IMMEDIATELY.
 - D16 REMOVE EXISTING ROCK 5-FEET IN EACH DIRECTION AND PLACE CLASS 8 GEOTEXTILE FABRIC AND CLASS I (6") ROCK SLOPE PROTECTION IN ACCORDANCE WITH SECTION 72 OF THE CALTRANS STANDARD SPECIFICATIONS TO THE EXTENTS OF EXISTING ROCK REMOVAL. EXISTING ROCK MAY BE REUSED AT ENGINEER'S DISCRETION.
 - D18 CONNECT NEW PIPE TO EXISTING STRUCTURE PER DETAIL 6.
 - D19 SAWCUT EXISTING CURB, GUTTER, AND SIDEWALK (AS APPLICABLE) AT NEAREST SCORE LINE ON EACH SIDE OF PIPE AND REPLACE PER TOWN OF LOOMIS STANDARD DETAIL H2. DOWEL NEW CONCRETE TO EXISTING PER DETAIL 7.

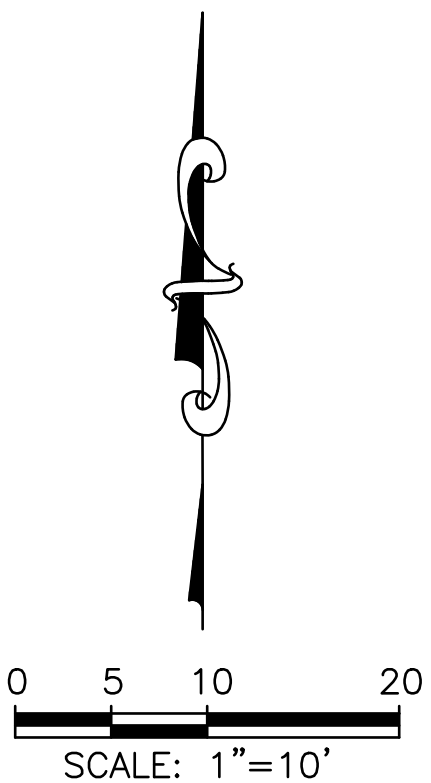

REVISION	MARK	DATE	DESCRIPTION	APPROVAL
	LML	2/16/24	ADDENDUM #1	

BID SET

DATE: AUGUST 2023

PROFESSIONAL ENGINEER
LAURE M. LOAIZA
No. 65951
CIVIL
STATE OF CALIFORNIA

PREPARED UNDER THE DIRECTION OF
Laure M. Loaiza
LAURE M. LOAIZA, RCE 65951
DESIGNED BY
EG
DRAWN BY
KAS
REVIEWED BY
LML

DATE
08/29/23

COASTLAND | DECM

11641 Blocker Dr, Ste 170
Auburn, CA 95603
530.888.9929 | coastlandcivil.com

TOWN OF LOOMIS
STREET CULVERT CROSSING RECONSTRUCTION

CALIFORNIA

LOCATION #22 - SHAWN WAY AT
TAYLOR ROAD

PROJECT NUMBER
65-4923

DRAWING DATE
AUGUST 2023

SHEET NUMBER
22 OF 30