

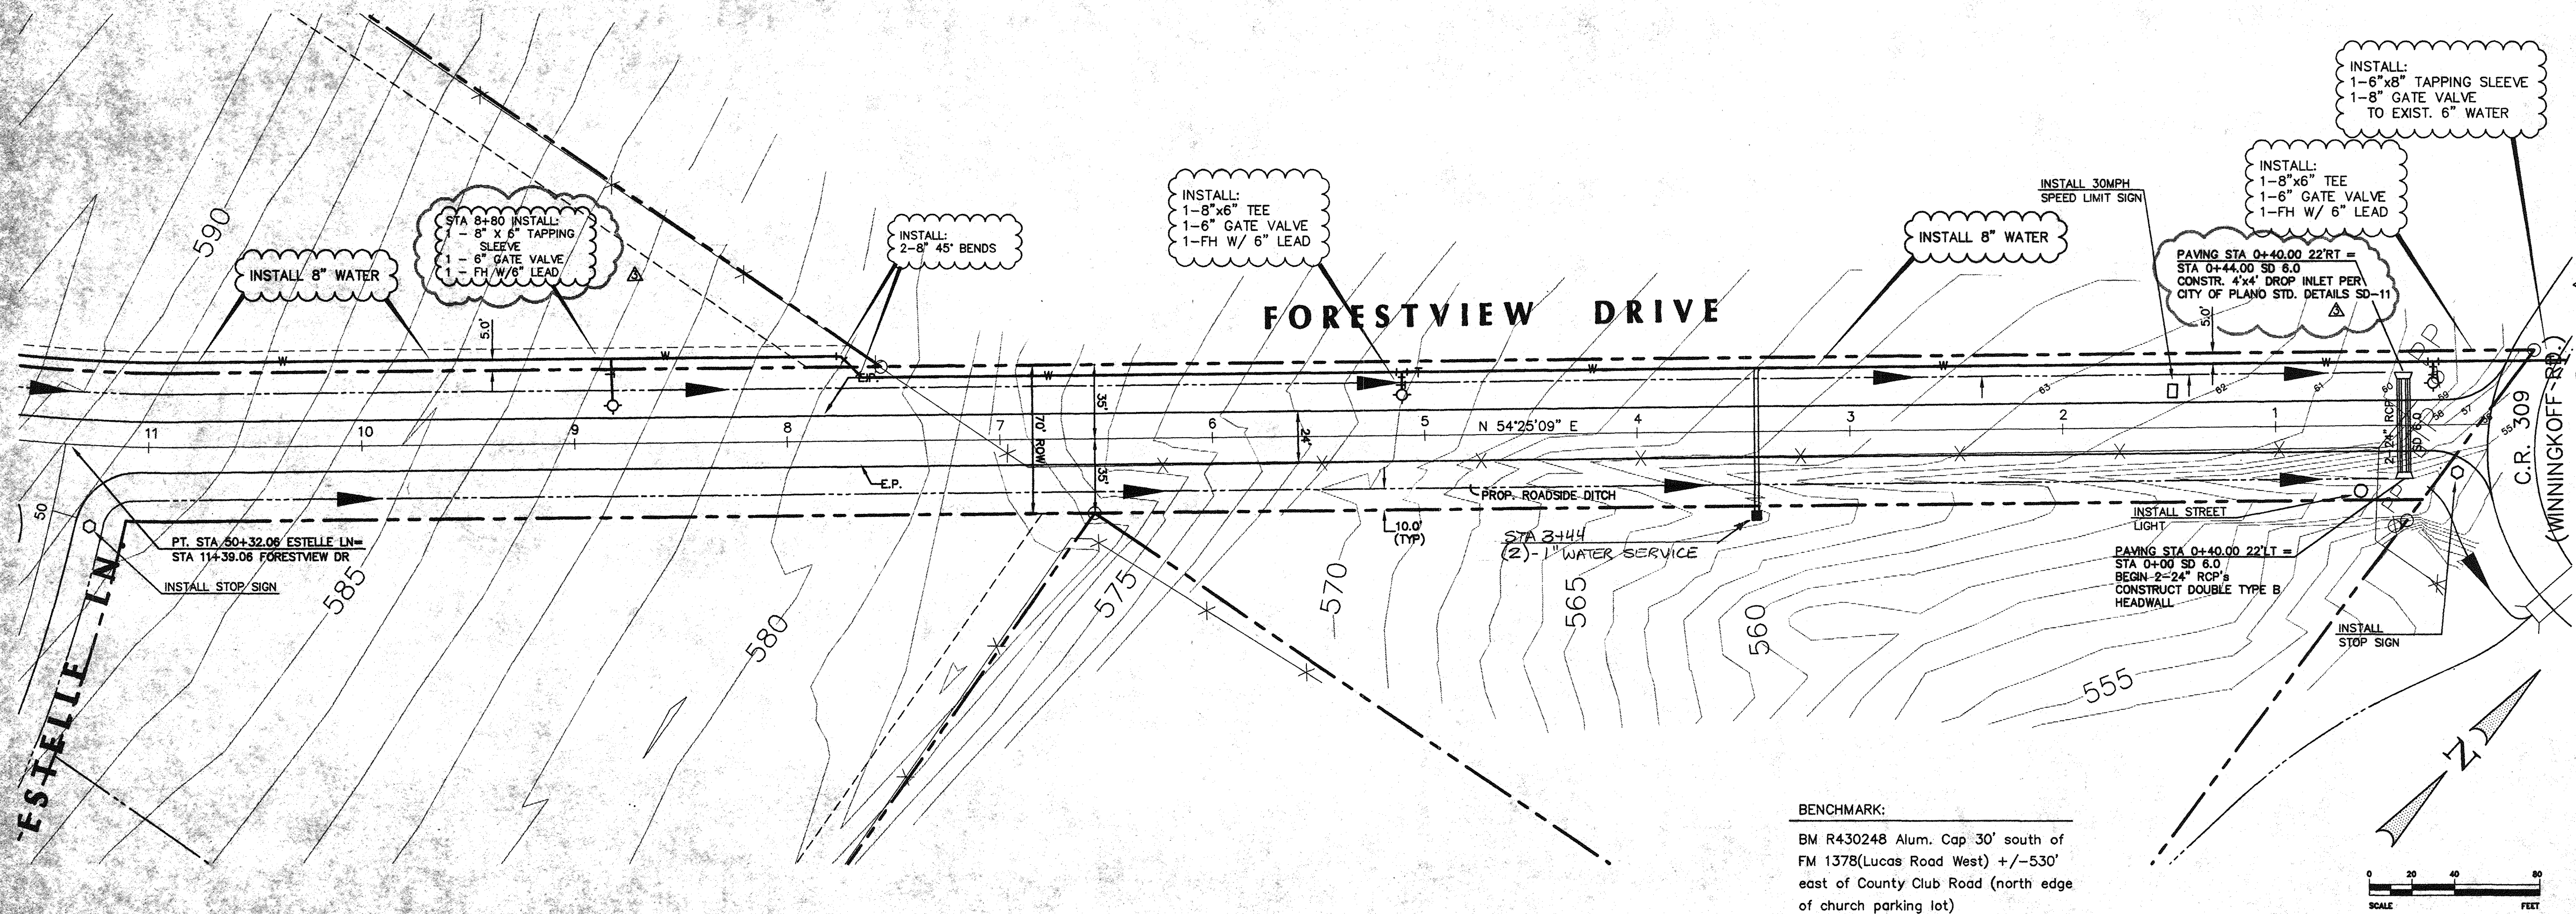


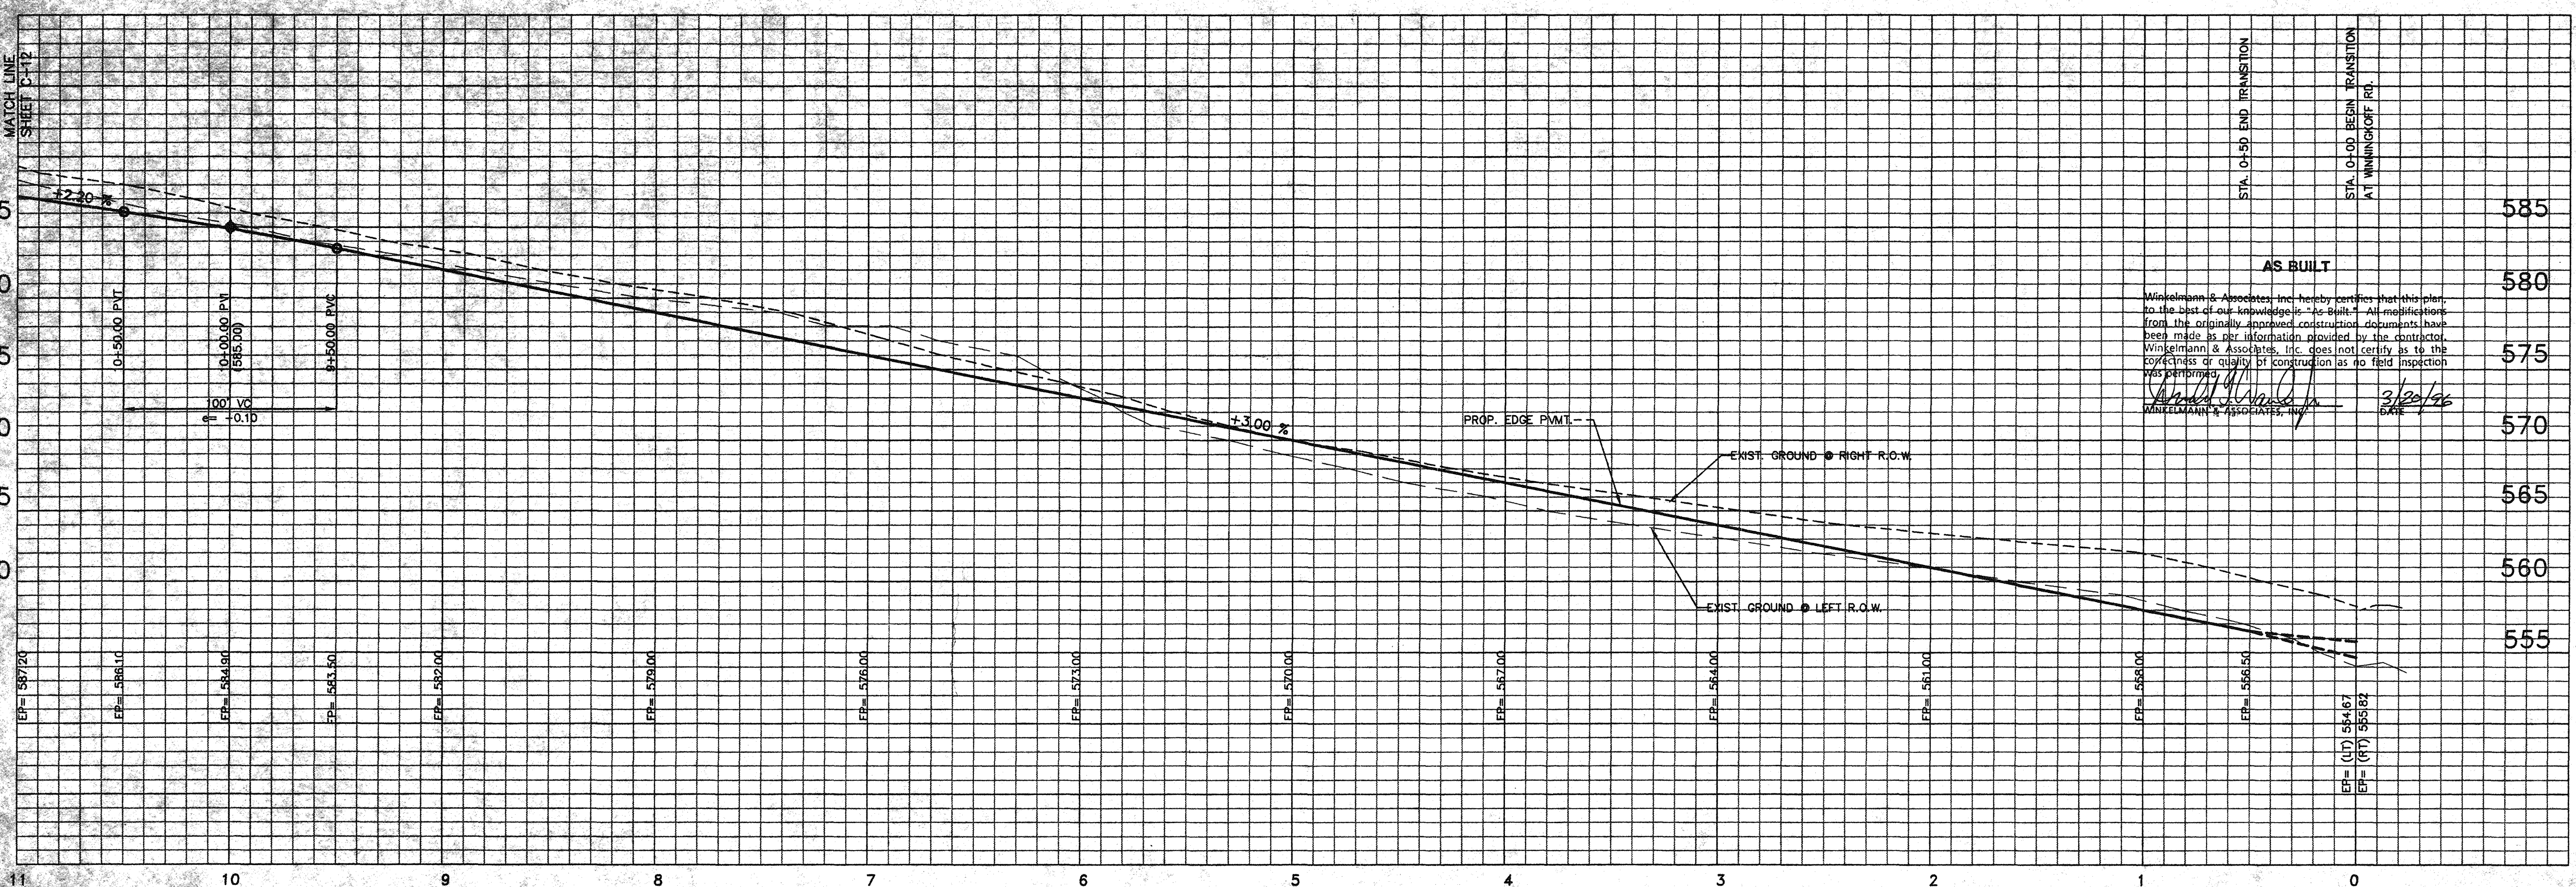

BENCHMARK:
BM R430248 Alum. Cap 30' south of
FM 1378(Lucas Road West) +/-530'
east of County Club Road (north edge
of church parking lot)

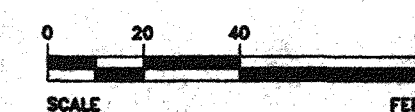

AS BUILT
Winkelman & Associates, Inc. hereby certifies that this plan, to the best of our knowledge, is "As-Built." All modifications from the originally approved construction documents have been made by the information provided by the contractor. Winkelman & Associates, Inc. does not certify as to the correctness or quality of construction as no field inspection was performed.
3/20/96
WINKELMAN & ASSOCIATES, INC.

Winkelman & Associates, Inc.
CONSULTING CIVIL ENGINEERS ■ SURVEYORS
12800 HILLCREST ROAD, SUITE 200
DALLAS, TEXAS 75244
(214) 960-7000 FAX (214) 960-7000

1-29-96

P.F. LUCAS SURVEY, ABSTRACT NO. 537
BENJAMIN SPARKS SURVEY, ABSTRACT NO. 813
COLLIN COUNTY, TEXAS

UNITED STANDARD REALTY MORTGAGE CORPORATION
718 WEST ARAPAHO STREET, 100
RICHARDSON, TEXAS 75080
(214) 783-8888

Scale : 1" = 40' Date : 1/29/96

Designed By : DFW
Drawn By : DFW
Checked By : DFW
File : 16601P66.DWG
Project No. : 16601.01

SHEET
C-11

PAVING, WATER & DRAINAGE PLAN
FORESTVIEW DRIVE
HUNTWICK ADDITION - CITY OF LUCAS, TEXAS

