

GENERAL NOTES:

- It is the CONTRACTOR's responsibility to maintain neat and accurate plans of record.
- The CONTRACTOR is responsible for maintaining adequate site drainage throughout the duration of this project.
- The CONTRACTOR is responsible for obtaining all necessary permits and approvals before construction begins.
- The CONTRACTOR shall replace all fence removed during construction in as good or better condition than before construction.
- The CONTRACTOR shall take all necessary precautions to ensure that electric power and telephone poles are either moved to a safe location by the affected utility company or not disturbed during construction. All costs incurred for moving electric power and telephone poles shall be included in the price bid for the construction of the project.
- The CONTRACTOR shall restore all property including driveways, public streets, sidewalks, public utilities, franchise utilities, private utilities, and all other improvements removed or damaged inside and outside the project limits during construction to as good or better condition than before construction. Restoration shall be made immediately after the property no longer interferes with construction.
- The information shown on these drawings concerning type and location of underground and other utilities is not guaranteed to be accurate or all-inclusive. The CONTRACTOR is responsible for making his own determinations as to the type and location of underground utilities and other utilities as may be necessary to avoid damage thereto.
- The CONTRACTOR shall not place fill or waste material on any private property without prior written permission from the City of Lucas. No excess excavated material shall be deposited in low areas or along natural drainage ways that will restrict the natural flow of water. If the CONTRACTOR places excavated material in low areas that will cause flood damage, CONTRACTOR will be responsible for all damage resulting from such fill, and he shall remove the fill at CONTRACTOR's expense.
- All streets within the scope of the Contract shall be kept accessible to fire trucks, ambulances and other emergency vehicles.
- The CONTRACTOR shall be responsible for public safety during the duration of construction. All barricades, warning signs, lights, devices, etc., for the guidance and protection of traffic and pedestrians must conform to the installation shown in 1980 Texas Manual of Uniform Traffic Control Devices, as currently amended by the Texas Department of Transportation. CONTRACTOR shall at all times provide barricades, warning signs and lighting adequate to safeguard the public from any hazards resulting from open trenches during non-work hours.
- Filter fabric fence for erosion control shall be provided in accordance with specifications and as shown on the plans and in accordance with the EPA regulations.
- The CONTRACTOR shall use the public right-of-ways and existing utility easements for access to the job site.
- The CONTRACTOR shall select the subcontractor to be utilized for testing and lab work. The CONTRACTOR shall be responsible for paying for testing and lab work. Selection of subcontractor for this purpose will be subject to approval by the City of Lucas. Testing referred to herein includes compaction and water pressure testing, which shall be required on this project. Testing shall include testing of asphalt material to be used on the project, traffic signal work, and any testing requirements.
- The CONTRACTOR shall keep excavated trenches free of groundwater during construction. If necessary, the CONTRACTOR shall utilize dewatering procedures in order to control groundwater during construction such that it does not affect his construction work.
- The CONTRACTOR shall provide means for adequately controlling and avoiding soil erosion during construction. The CONTRACTOR shall not store spoil in drainage ways during construction.
- All disturbed earth areas are to be finish graded to original or proposed contours, fertilized and covered with bermuda block sod according to NCTCOG specifications immediately after construction. Backfill to be select material free of rock and other debris. CONTRACTOR shall thoroughly water the sod immediately after placement. The CONTRACTOR shall also be responsible for continued maintenance and watering of the newly sodded areas until the entire project is completed and accepted by the City of Lucas. Watering of the bermuda block sod shall be done in a manner and quantity as directed by City of Lucas field representative.
- No existing sprinkler/irrigations systems have been shown on the plans; however, they may exist in certain areas. It is the CONTRACTOR'S responsibility to locate any existing irrigation systems within the project limits and determine if they will be affected by this construction. If CONTRACTOR encounters any sprinkler systems during construction, he shall repair and/or replace in as good or better condition than before construction.
- The CONTRACTOR shall maintain adequate sanitary facilities for use by workers throughout construction.
- The CONTRACTOR shall conform to the Occupational Safety and Health Administration's (OSHA) standards for trench safety that are in effect during the period of construction.
- All materials and workmanship shall conform to the City of Lucas Standards and Specifications and the North Central Texas Council of Government (NCTCOG) Standards and Specifications, except as noted. In the event of a conflict, the City of Lucas Standards and Specifications shall govern.
- No existing trees shall be removed without approval of the City of Lucas.
- CONTRACTOR shall provide all necessary construction staking.
- CONTRACTOR's working hours shall be in accordance with the provisions of the current City Ordinance governing hours of construction work in the City.

GENERAL NOTES CONT'D.:

- All concrete shall have a minimum compressive strength of 4000 psi at 28 days (minimum 6 sacks of cement per cubic yard) unless otherwise noted.
- All existing water lines to remain in service during construction. At times when water has to be cut-off, the CONTRACTOR shall coordinate with the City of Lucas.
- Buried water lines shall be polyvinyl chloride (PVC) AWWA C900. Above ground water lines shall be ductile iron pipe. Valves and fittings for buried water lines and above ground water lines shall be cast iron. Small water lines such as sampling lines etc., shall be copper pipe with compression type fittings.
- The CONTRACTOR is responsible for keeping streets, parking areas, sidewalks, etc., adjacent to the project free of mud and debris from construction.
- The CONTRACTOR shall assume responsibility for protection of public utilities in the construction of this project. All manholes, valve boxes, fire hydrants, etc., must be adjusted to proper line and grade by the CONTRACTOR when construction is completed. The CONTRACTOR shall also be responsible for support of existing utility poles, street signs, etc., when excavating in the vicinity of such poles.
- The City of Lucas Public Works Department is to be notified 48 hours (2 working days) prior to any construction.
- Arrangements for construction water shall be made through the City of Lucas.
- All locations of underground utility lines are approximate. CONTRACTOR shall contact the proper utility companies at least 48 hours prior to construction, shall inform them of beginning of construction and shall make arrangements to have utilities located by flagging. Flagging of utilities shall be completed prior to beginning construction.
- PVC pipe shall be manufactured from a low filler PVC component capable of meeting the highest performance standards of the ASTM specifications.
- Construction site shall be secure at all times. Safety precautions shall be taken to protect the public from any injury which might result from construction activities.
- As part of bid item, "EROSION CONTROL", the CONTRACTOR shall be responsible for implementing any and all erosion control measures as needed to control runoff of siltation from the project site. This shall include, but is not limited to, silt fencing, rock berms, inlet protection, organic filter rolls etc. The CONTRACTOR shall maintain these erosion control measures as required until the construction is completed and sod has been placed over disturbed areas.

GENERAL TRAFFIC CONTROL NOTES

Following are General Traffic Control Notes to be utilized on this project as applicable:

- All temporary signs, markings, cones, channelizing devices, warning lights and barricades shall be in accordance with the current State of Texas Manual on Uniform Traffic Control Devices (MUTCD).
- Type "A" warning lights shall be placed on all advance warning signs. In addition, flags shall be placed on all advance warning signs that detour traffic.
- Any existing conflicting markings shall be removed prior to shifting traffic.
- All temporary pavement markings required during construction shall be of the removable type. Temporary markings and striping may be required to transition travel lanes between construction phases. All pavement markings and striping shall be reflective.
- The spacing of signs and channelization devices may be adjusted to fit the geometric conditions encountered, such as driveways, intersecting roadways, vertical and horizontal alignment, etc., as approved by the City of Lucas.
- Advance warning signs shall not be displayed more than forty-eight (48) hours before physical construction begins. Signs may be erected up to one week before needed, if the sign face is fully covered.
- Use of barricades, portable barrier rails, vertical panels, and drums shall be limited to the immediate areas of construction where a hazard is present. These devices shall not be stored along the roadway within thirty (30) feet of the edge of the traveled way before or after use unless protected by guardrail, bridge rail, and/or barriers installed for other purposes. These devices shall be removed from the construction work zone when the City of Lucas determines they are no longer needed. Where there is insufficient right-of-way to provide for this thirty (30) foot setback, the City of Lucas shall approve alternate locations.
- The posted speed for warning signage is to be determined at the site by the City of Lucas.
- Reduced speed warning signage should be placed prior to and at regular intervals within the construction zone.
- As part of the bid item, "Construction Barricading/Signing/Traffic Control," the CONTRACTOR is required to submit a traffic control plan for construction a minimum of 3 days prior to changes in traffic handling or movement. These plans are to be reviewed and approved by the City of Lucas prior to construction of that phase.
- The CONTRACTOR shall accommodate existing traffic during construction and shall maintain at least one open lane of traffic at all times. Use of flag men, barricades, vertical panels, etc. shall be required and shall be considered subsidiary to "Construction Barricading/Signing/Traffic Control".
- CONTRACTOR shall be required to place temporary pavement markings and/or buttons as needed to maintain traffic in a safe and efficient manner after removal of existing markings. These temporary markings shall not be paid for separately but shall be considered subsidiary to "CONSTRUCTION BARRICADING/SIGNING/TRAFFIC CONTROL".

!! CAUTION !!

THERE ARE EXISTING AND/OR PROPOSED UTILITIES IN PROJECT AREA. UTILITY INFORMATION SHOWN ON PLANS REPRESENTS APPROXIMATE LOCATIONS OF EXISTING UTILITIES AND IS NOT NECESSARILY ALL-INCLUSIVE. CONTRACTOR SHALL BE RESPONSIBLE FOR VERIFYING EXACT LOCATIONS OF ALL EXISTING UTILITIES AND SHALL BE REQUIRED TO PROTECT UTILITIES TO AVOID DAMAGE.

PRIOR TO ANY EXCAVATION, CONTRACTOR SHALL CONTACT DIG-TESS, TEXAS ONE CALL, LONE STAR NOTIFICATION AND OTHERS AS REQUIRED TO LOCATE EXISTING UTILITIES.

CONTRACTOR SHALL ALSO CONTACT APPROPRIATE CITY UTILITY DEPARTMENT FOR FIELD LOCATES OF MUNICIPAL INFRASTRUCTURE 48 HOURS PRIOR TO CONSTRUCTION.


RECORD DRAWING
BASED ON CONTRACTOR MARKUPS,
NOT FIELD SURVEY.

6			
5			
4			
3			
2			
1			
NO.	DATE	REVISION	REVIEWED

DRAWN: _____ BW2
 DESIGN: _____ JFW
 REVIEWED: _____ MRB
 SCALE: _____ NO SCALE
 DATE: _____ APRIL 2013
 DWG. NAME: _____ 1572GENNOTE




BW2 Engineers, Inc.
 1919 S. Shiloh Road
 Suite 500, L.B. 27
 Garland, Texas 75042
 (972) 864-8200 (T) (972) 864-8220 (F)
 Firm Registration No. F-5290

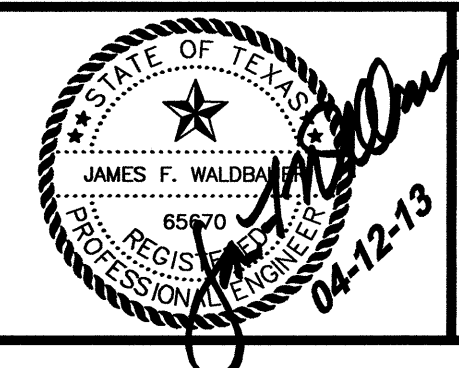


**INTERSECTION IMPROVEMENTS
 LUCAS ROAD/COUNTRY CLUB ROAD
 PROJECT GENERAL NOTES
 CITY OF LUCAS**


SHEET NO. 1
 OF 32 SHEETS
 JOB NO. 12-1572

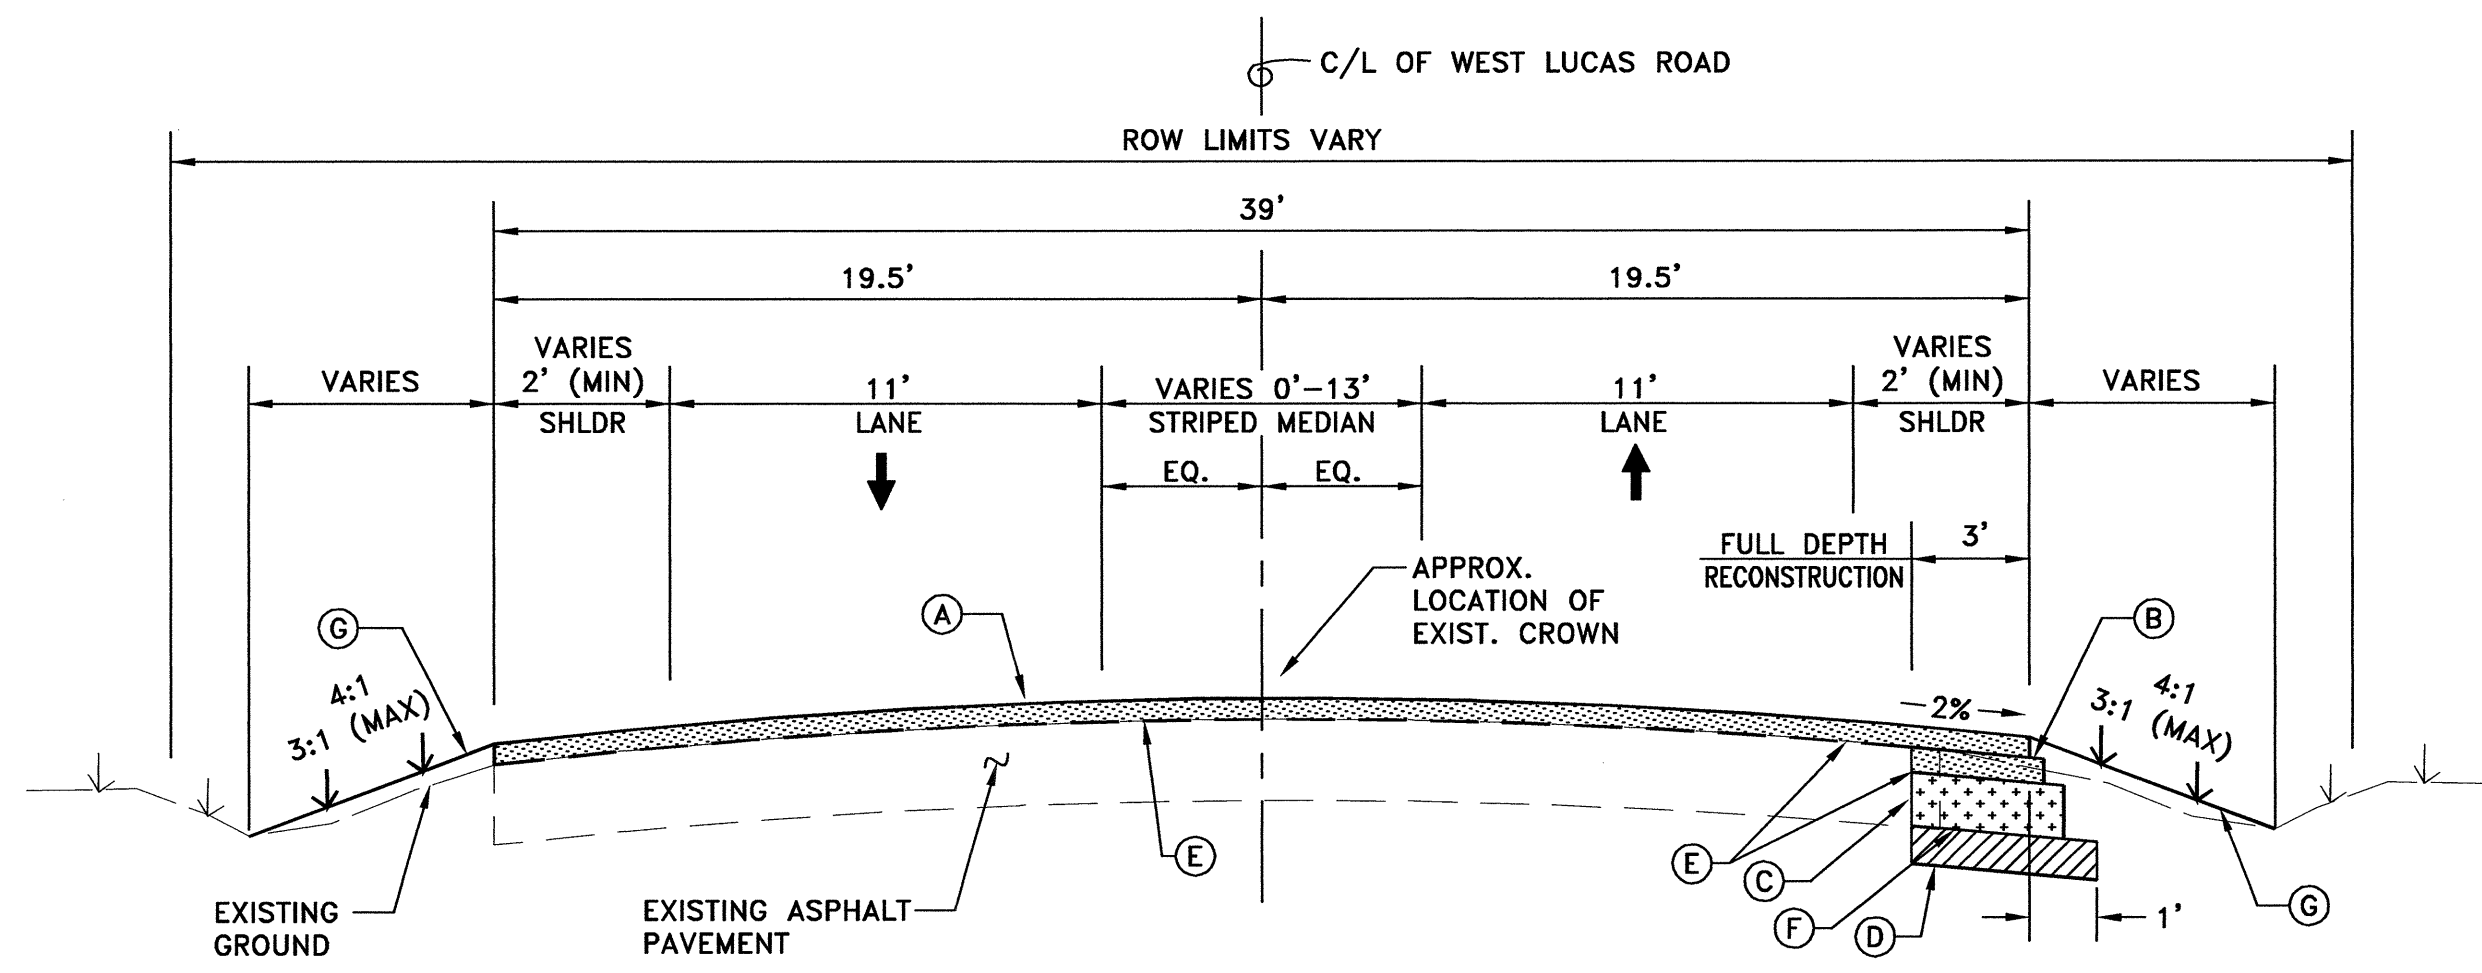


① WEST LUCAS ROAD TYPICAL SECTION
NOT TO SCALE
STA. 6+00 TO STA. 7+50

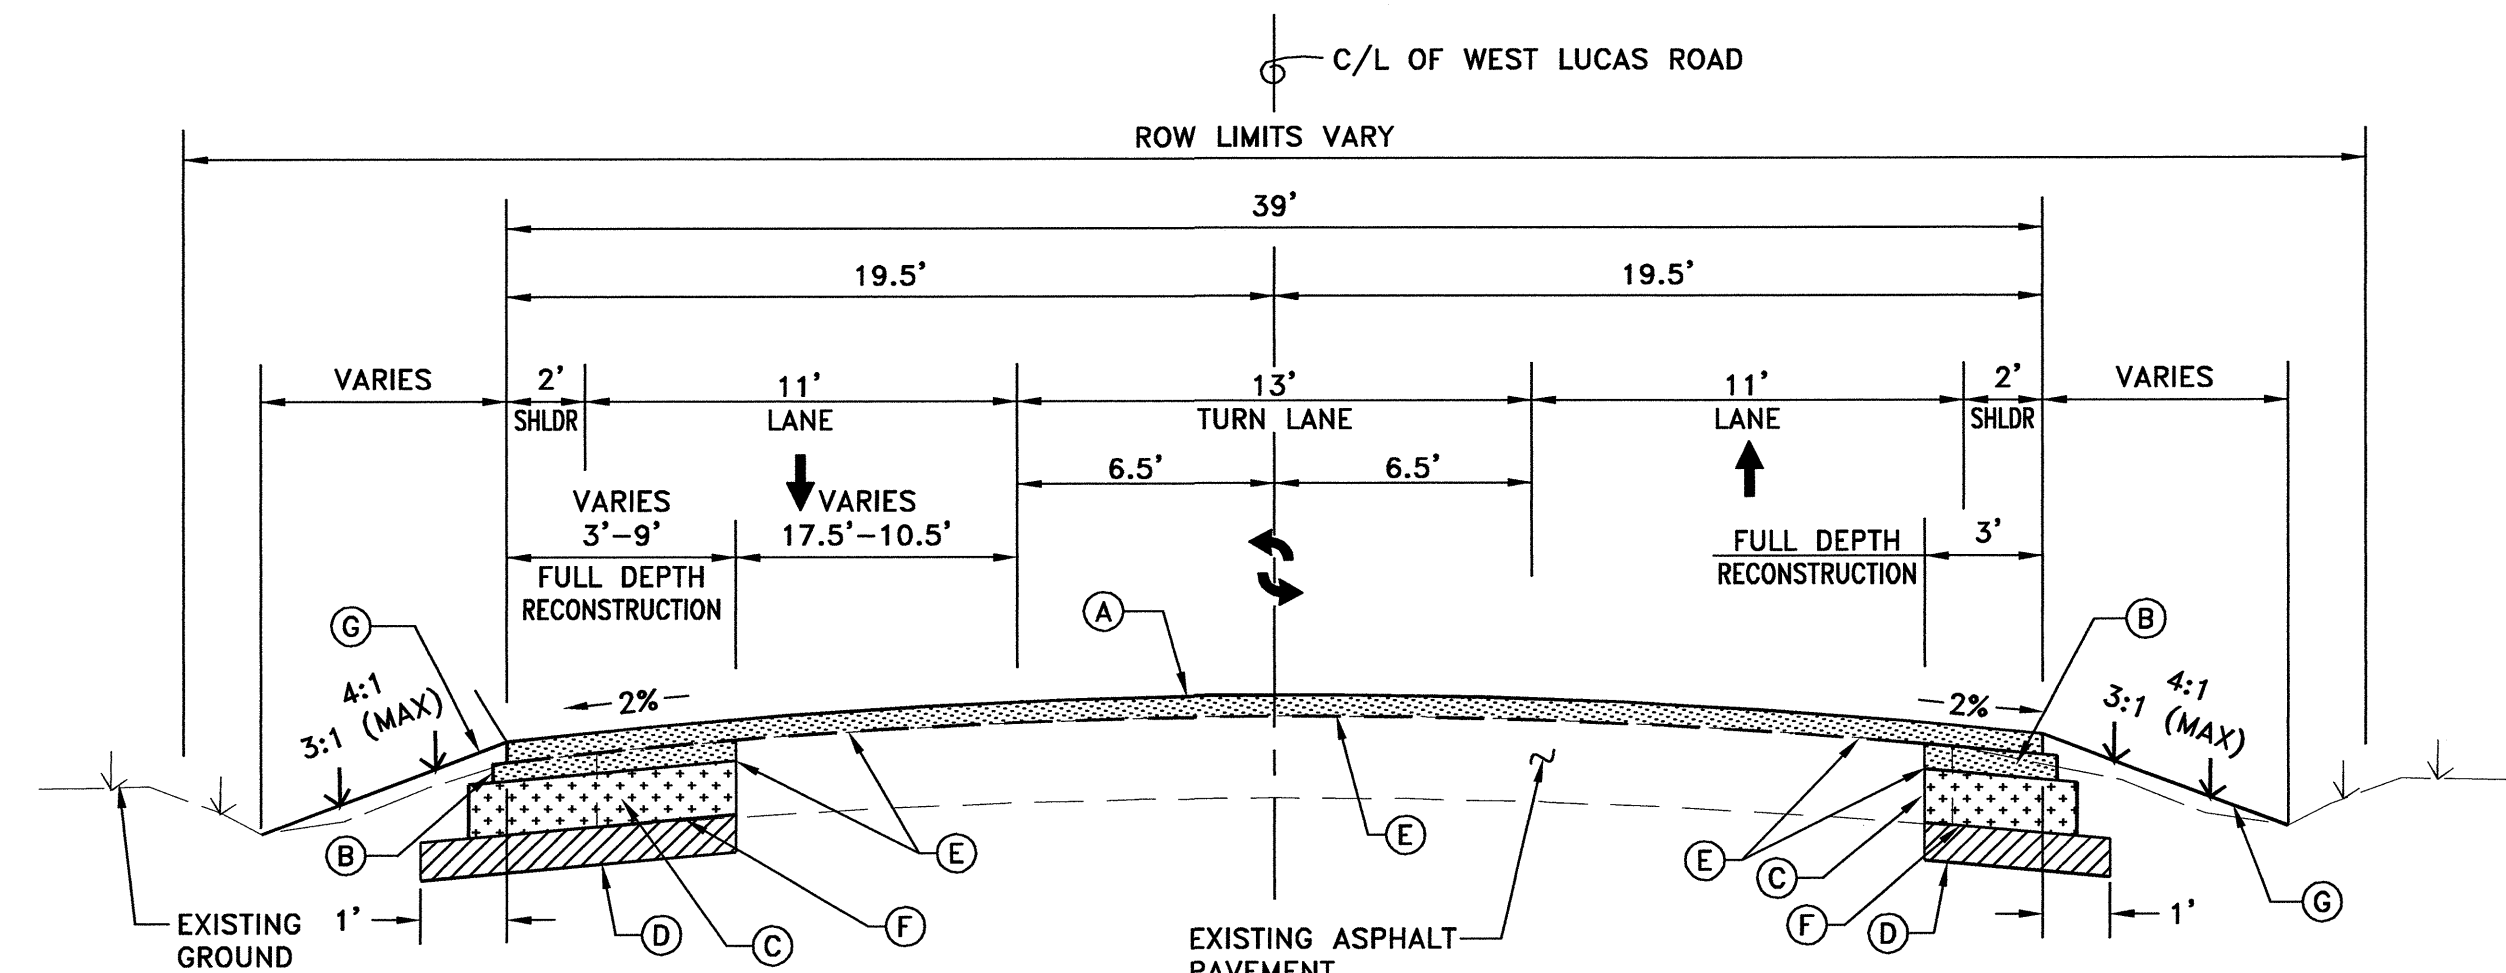

③ WEST LUCAS ROAD TYPICAL SECTION
NOT TO SCALE
STA. 15+15 TO STA. 19+89.03

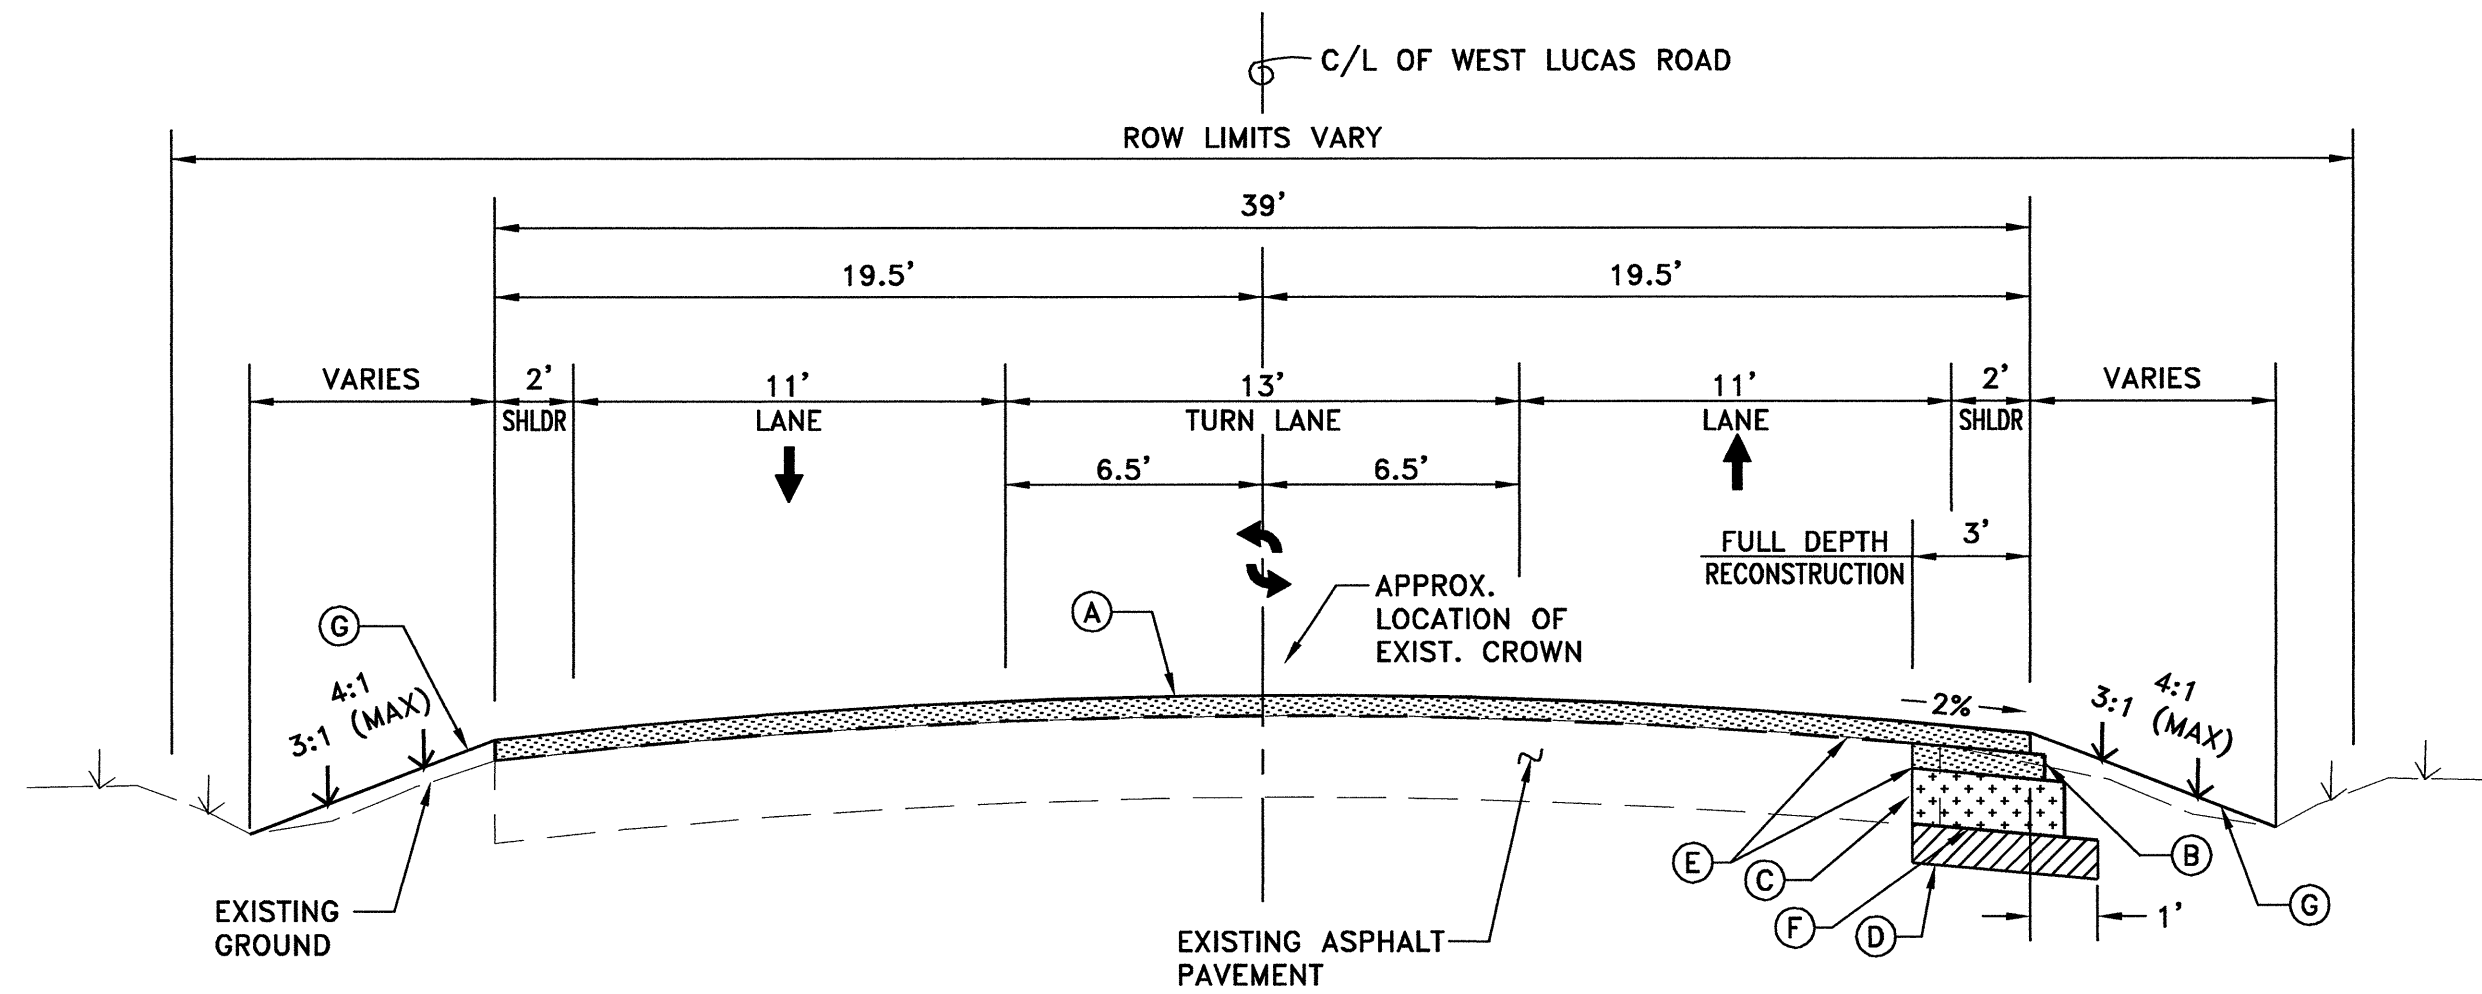

② WEST LUCAS ROAD TYPICAL SECTION
NOT TO SCALE
STA. 7+50 TO STA. 15+15

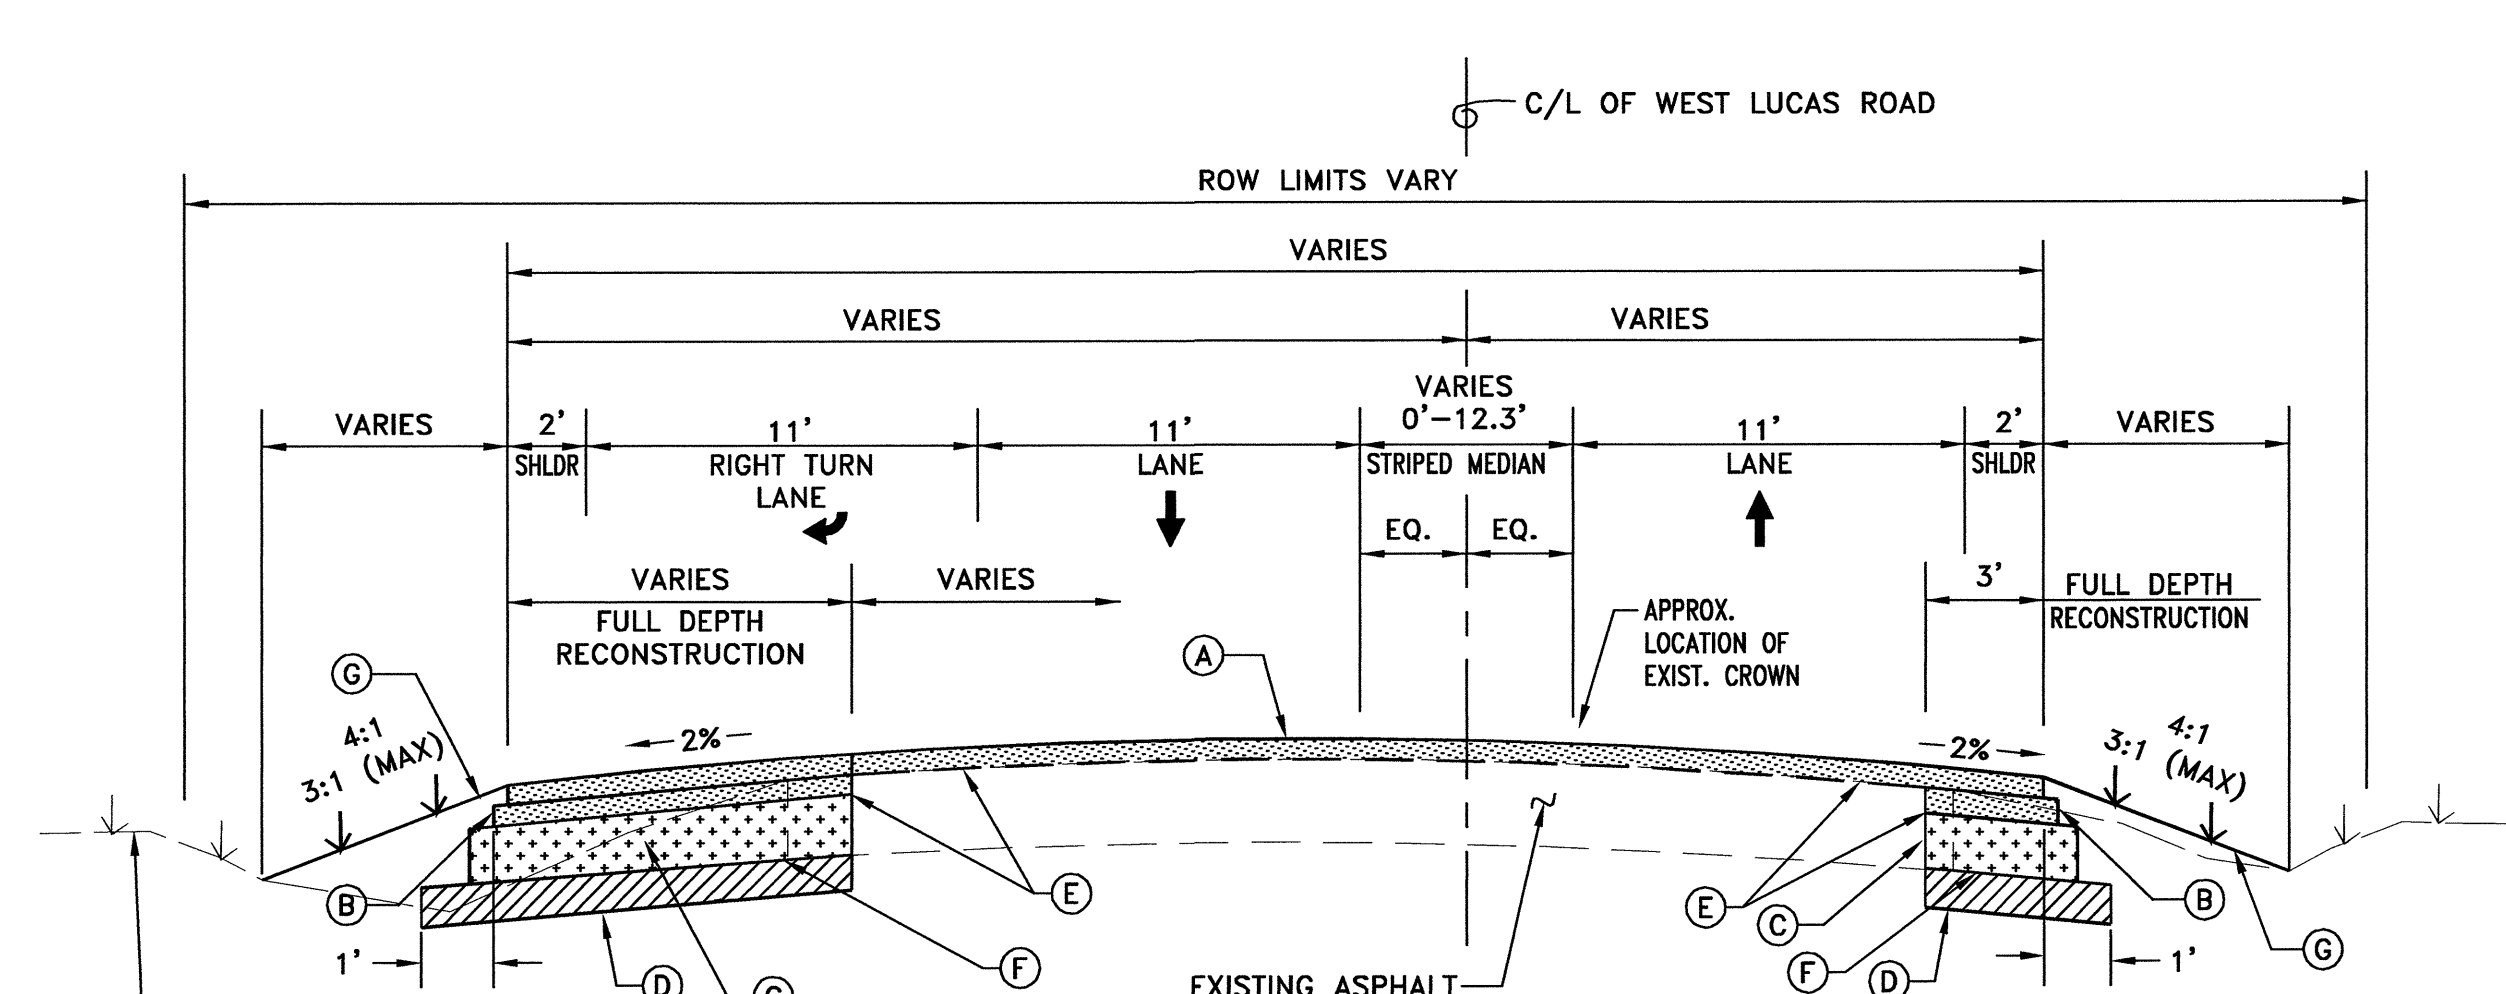


④ WEST LUCAS ROAD TYPICAL SECTION
NOT TO SCALE
STA. 21+29.98 TO STA. 24+97.28

TYPICAL SECTIONS LEGEND:

- (A) 1½" TYPE 'D' HMAC SURFACE COURSE
- (B) 3" TYPE 'D' HMAC SURFACE COURSE
- (C) 4" TYPE 'B' HMAC BINDER COURSE (2-2" COURSES)
- (D) 8" LIME TREATED SUBGRADE (6%) THOROUGHLY MIX AND COMPACTED TO 95% S.P.D.
- (E) TACK COAT (@ 0.05 GAL/S.Y.)
- (F) PRIME COAT (@ 0.30 GAL/S.Y.)
- (G) BLOCK SOD

TYPICAL SECTION NOTES:


1. EXISTING ASPHALT SURFACES TO BE CLEAN AND FREE OF LOOSE DEBRIS AND DIRT PRIOR TO BEING OVERLAID WITH NEW ASPHALT.

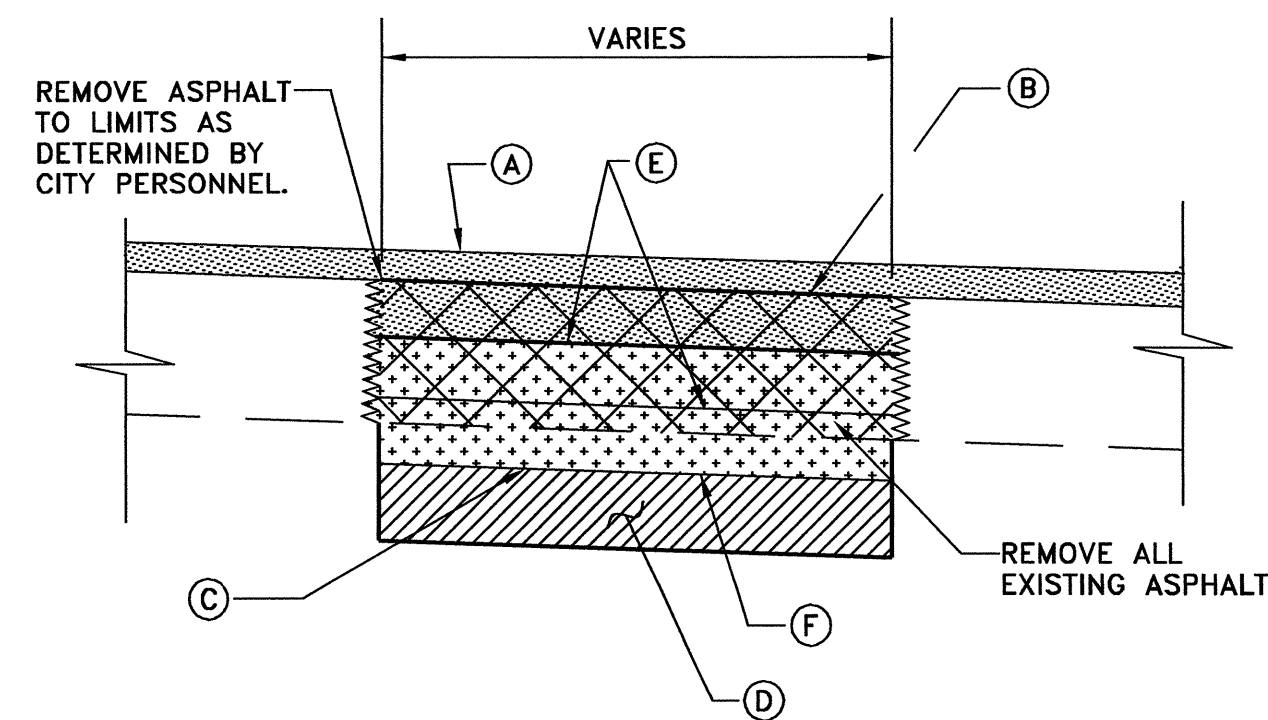

⑤ FULL-DEPTH ASPHALT REPAIR
NOT TO SCALE

NOTES:

1. FULL DEPTH ASPHALT REPAIR DETAIL TO BE UTILIZED IF ANY FAILURE AREAS ARE ENCOUNTERED. THESE AREAS SHALL BE MARKED IN THE FIELD BY CITY PERSONNEL. FULL DEPTH ASPHALT REPAIRS ARE TO BE PAID FOR BY THE SQUARE YARD AND SHALL INCLUDE ALL ITEMS AS REQUIRED BY THE DETAIL.

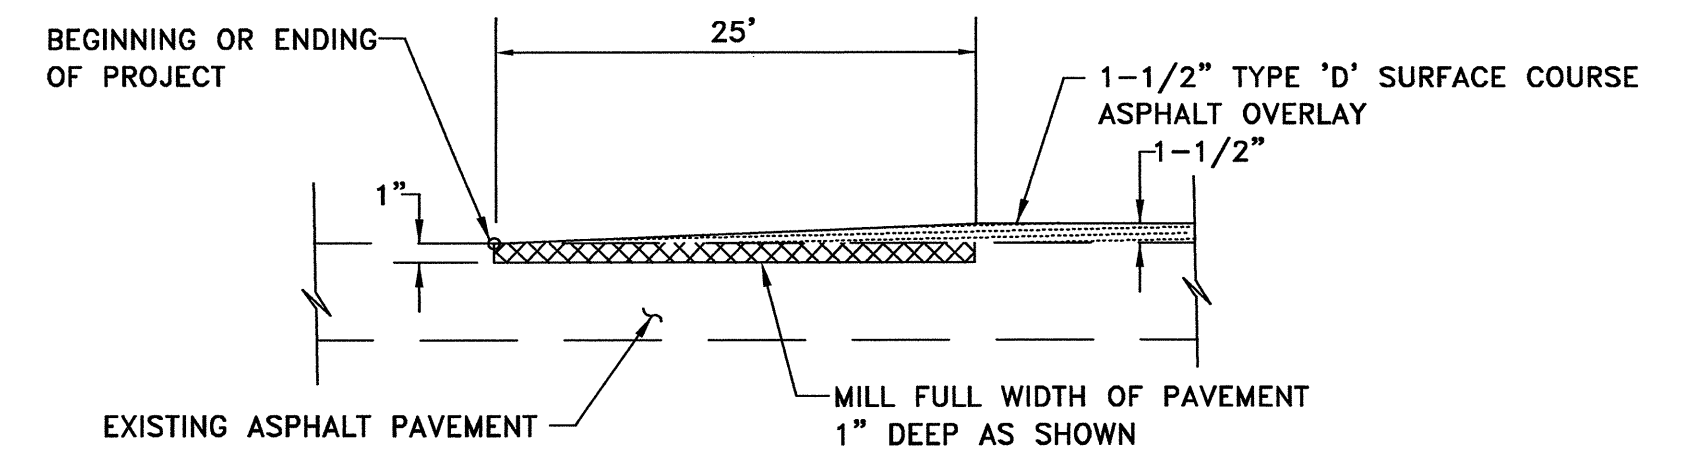

⑥ OVERLAY TRANSITION DETAIL
AT PROJECT LIMITS
NOT TO SCALE


RECORD DRAWING
BASED ON CONTRACTOR MARKUPS,
NOT FIELD SURVEY.

6			
5			
4			
3			
2			
1			
NO.	DATE	REVISION	REVIEWED

DRAWN: _____ BW2
DESIGN: _____ JMW
REVIEWED: _____ JFW
SCALE: _____ NOT TO SCALE
DATE: _____ APRIL 2013
DWG. NAME: _____ 1572TYPSECTION







BW2 Engineers, Inc.
1919 S. Shiloh Road
Suite 500, L.B. 27
Garland, Texas 75042
(972) 864-8200 (T) (972) 864-8220 (F)
Firm Registration No. F-5290

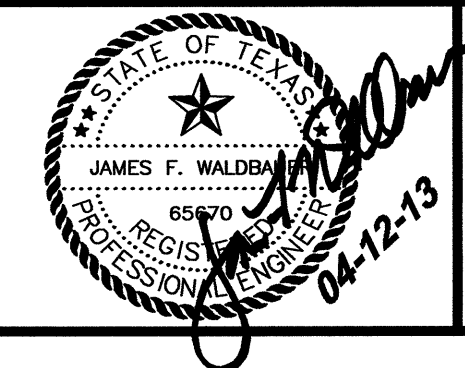

**INTERSECTION IMPROVEMENTS
LUCAS ROAD/COUNTRY CLUB ROAD
CONSTRUCTION DETAILS
CITY OF LUCAS**

SHEET NO. 2
OF 32 SHEETS
JOB NO. 12-1572

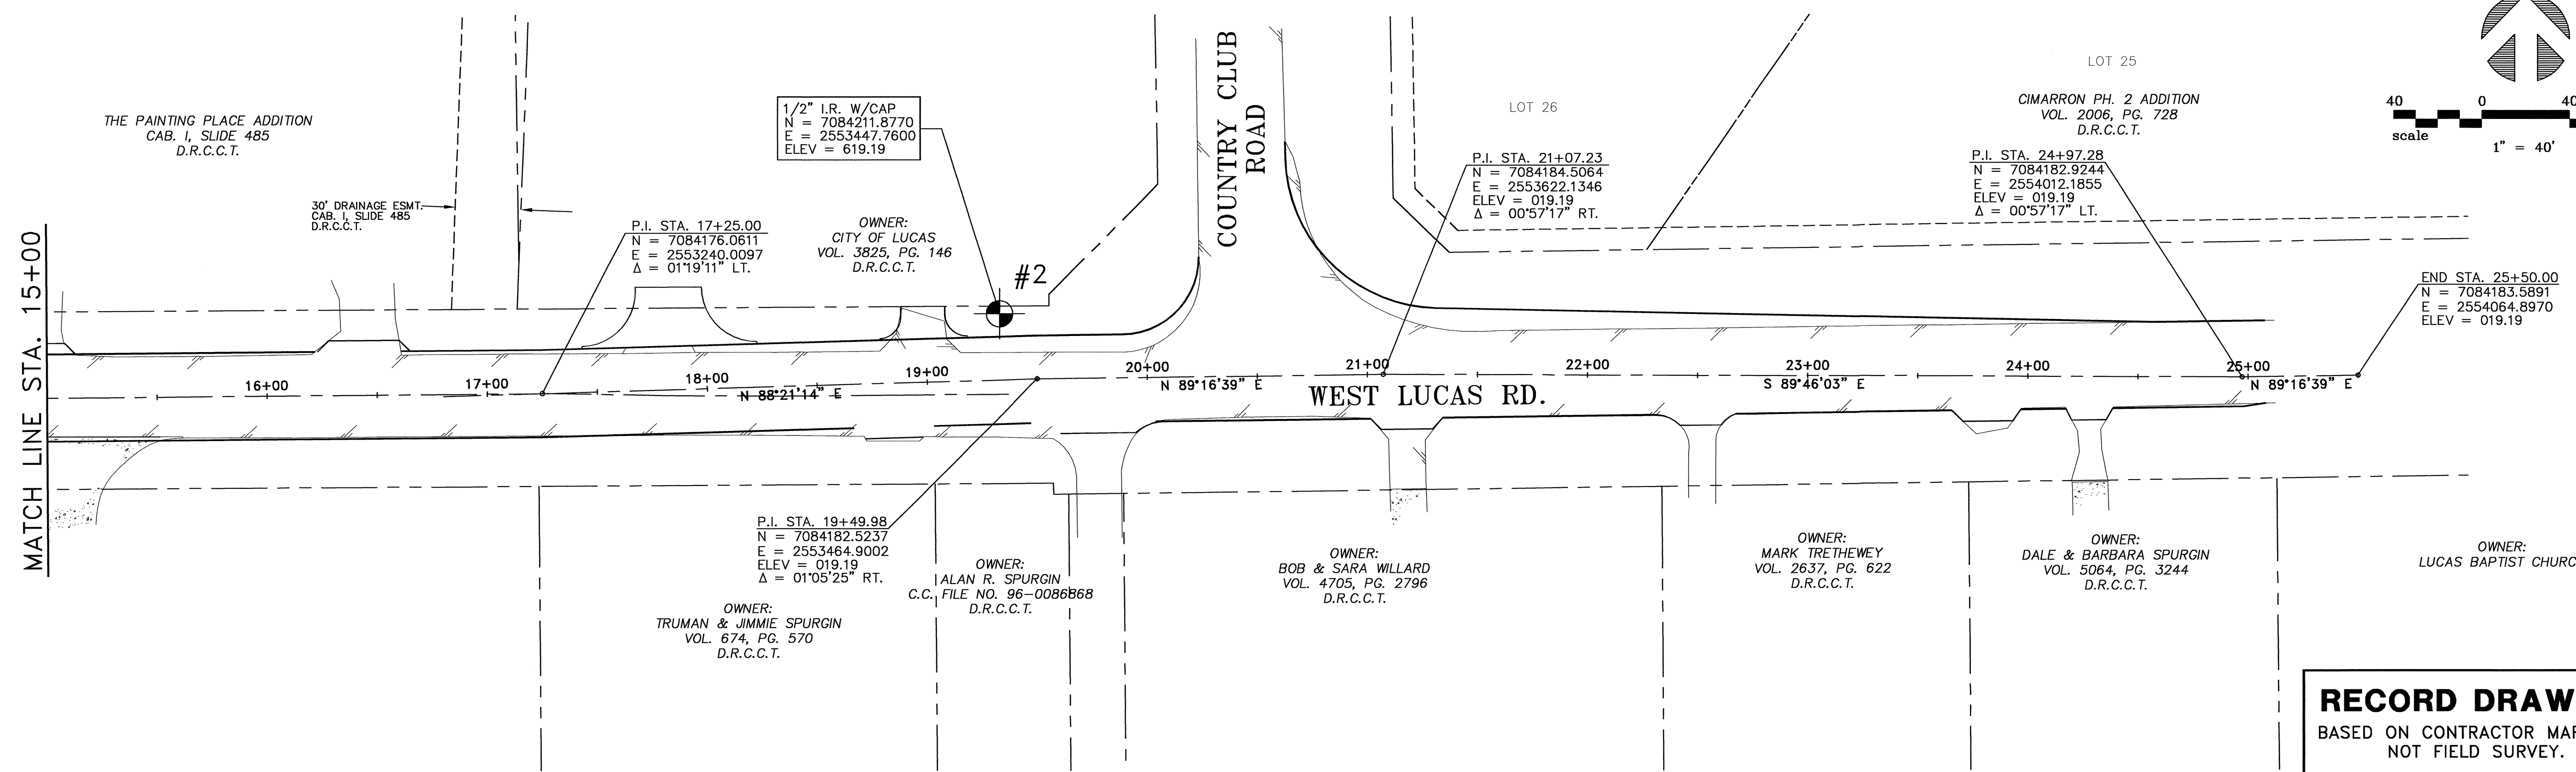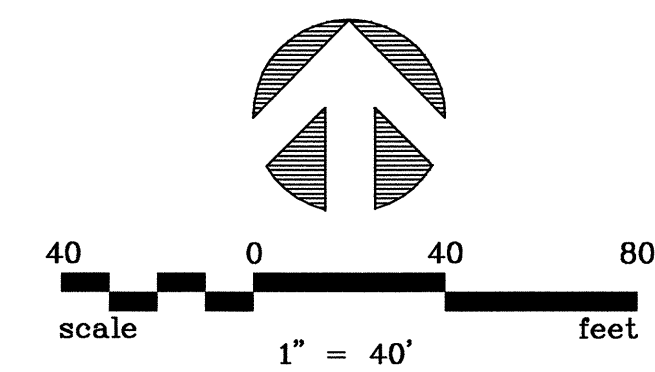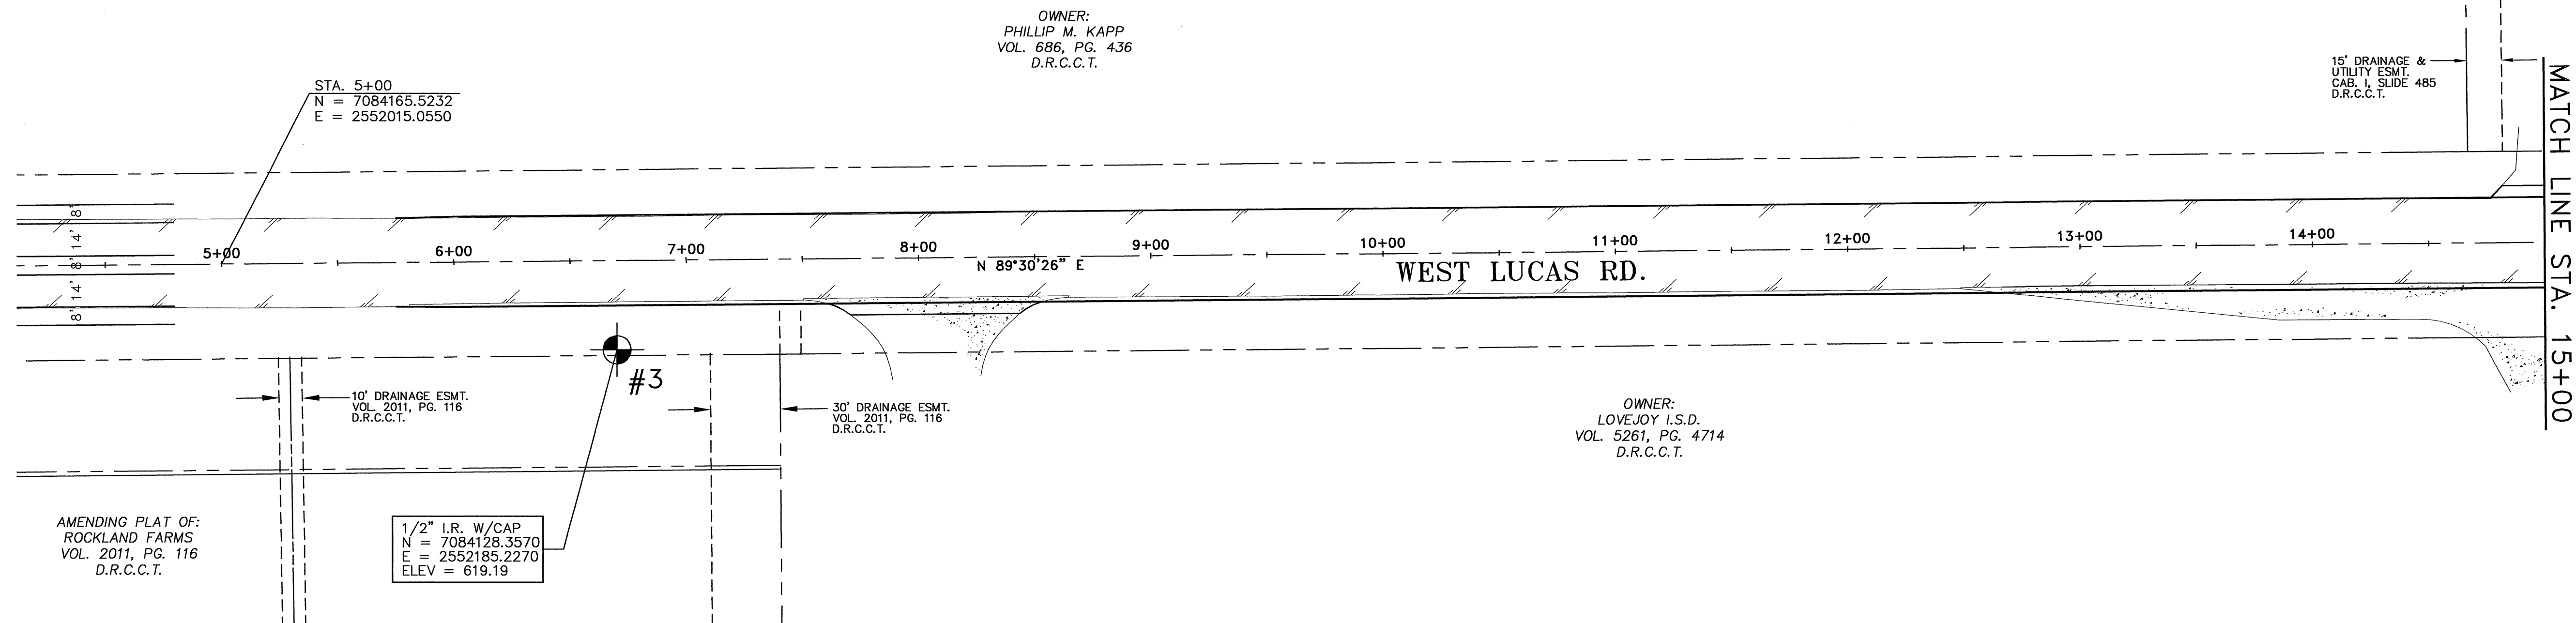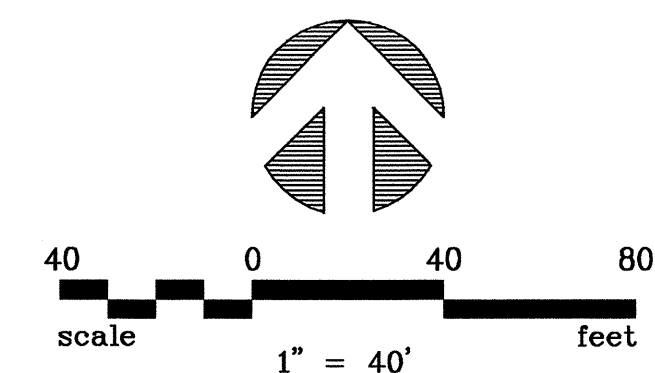


RECORD DRAWING
 BASED ON CONTRACTOR MARKUPS,
 NOT FIELD SURVEY.

6			
5			
4			
3			
2			
1			
NO.	DATE	REVISION	REVIEWED

DRAWN: BW2
 DESIGN: JFW
 REVIEWED: MRB
 SCALE: 1" = 40'
 DATE: APRIL 2013
 DWG. NAME: 1572HOR-CTRL01




BW2 Engineers, Inc.
 1919 S. Shiloh Road
 Suite 500, L.B. 27
 Garland, Texas 75042
 (972) 864-8200 (T) (972) 864-8220 (F)
 Firm Registration No. F-5290

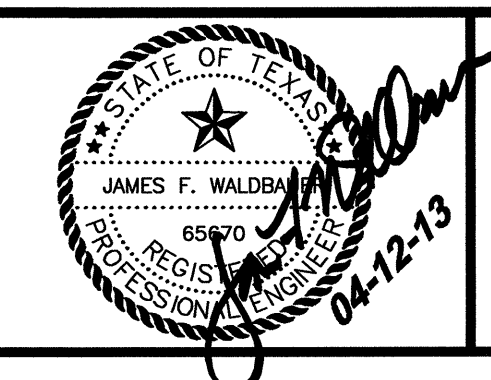

INTERSECTION IMPROVEMENTS
 LUCAS ROAD/COUNTRY CLUB ROAD
 HORIZONTAL CONTROL PLAN
CITY OF LUCAS

SHEET NO. 3
 OF 32 SHEETS
 JOB NO. 12-1572

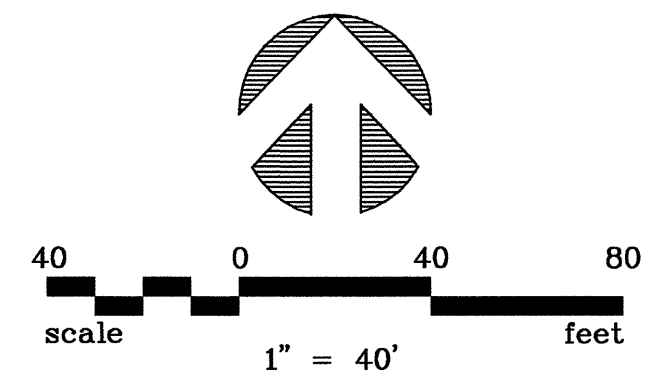


OWNER:
PHILLIP M. KAPP
VOL. 686, PG. 436
D.R.C.C.T.

INSTALL 30 L.F. OF
ORGANIC FILTER
ROLL

15' DRAINAGE &
UTILITY ESMT.
CAB. I, SLIDE 485
D.R.C.C.T.

MATCH LINE STA. 15+00

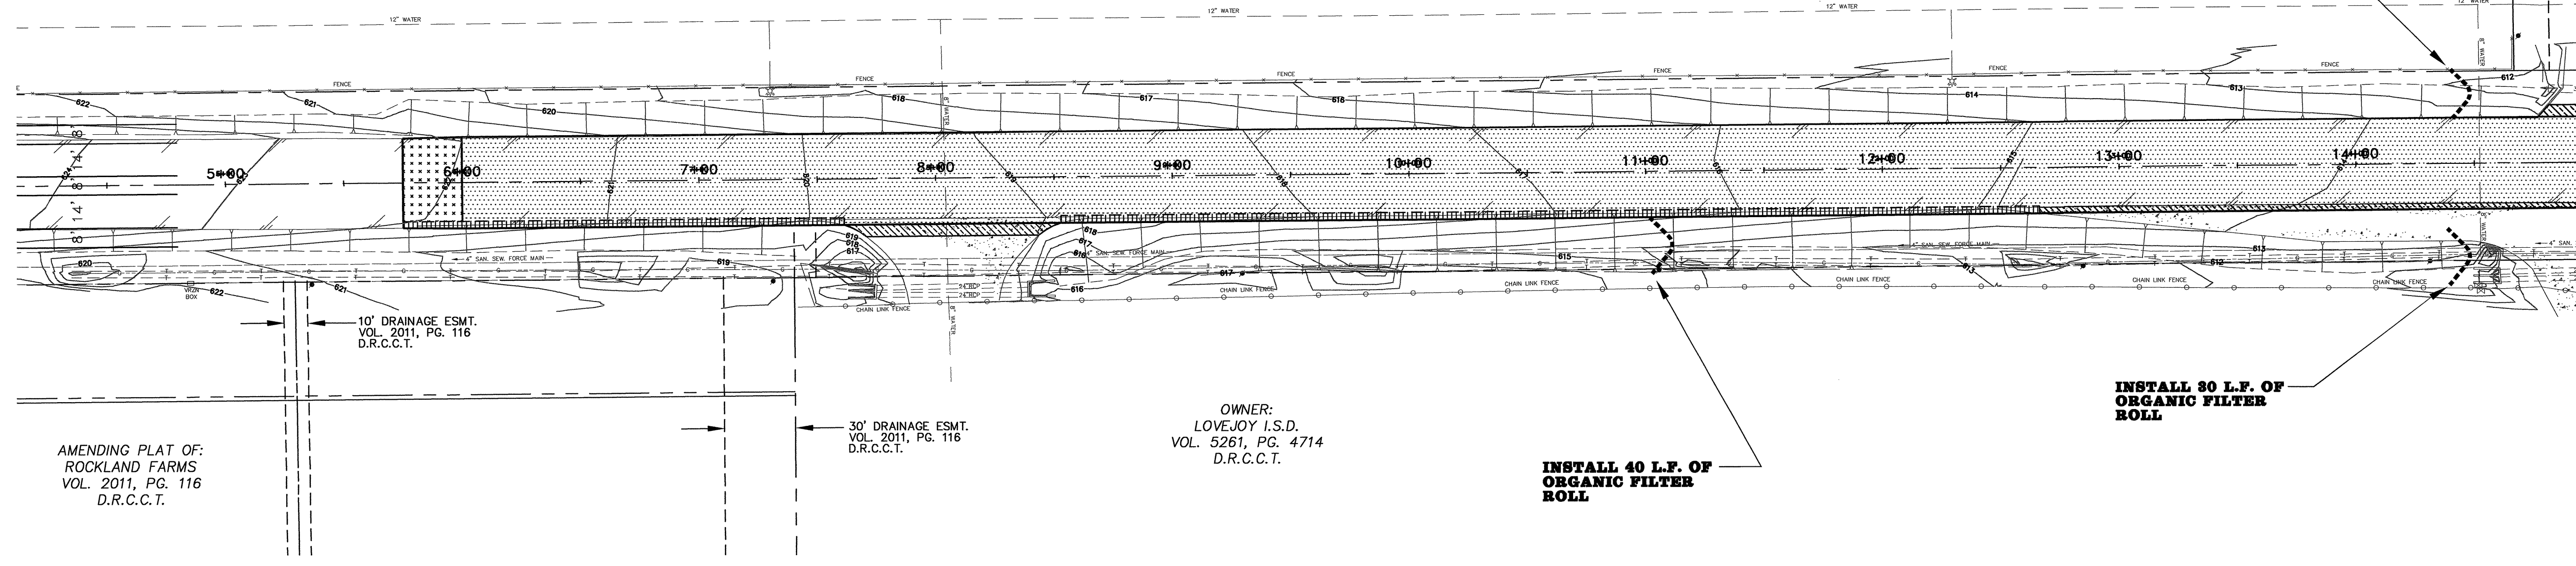

INSTALL 30 L.F. OF
ORGANIC FILTER
ROLL


INSTALL 40 L.F. OF
ORGANIC FILTER
ROLL

NOTES:
1. FOR ADDITIONAL REQUIREMENTS,
SEE EROSION CONTROL NOTES
ON SHEET 1.

AMENDING PLAT OF:
ROCKLAND FARMS
VOL. 2011, PG. 116
D.R.C.C.T.

30' DRAINAGE ESMT.
VOL. 2011, PG. 116
D.R.C.C.T.

OWNER:
LOVEJOY I.S.D.
VOL. 5261, PG. 4714
D.R.C.C.T.

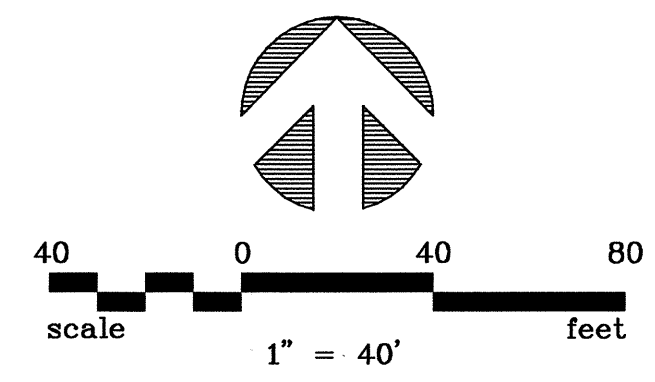

THE PAINTING PLACE ADDITION
CAB. I, SLIDE 485
D.R.C.C.T.

OWNER:
CITY OF LUCAS
VOL. 3825, PG. 146
D.R.C.C.T.


LOT 25
CIMARRON PH. 2 ADDITION
VOL. 2006, PG. 728
D.R.C.C.T.

MATCH LINE STA. 15+00

INSTALL 30 L.F. OF
ORGANIC FILTER
ROLL

INSTALL 40 L.F. OF
ORGANIC FILTER
ROLL

INSTALL 35 L.F. OF
ORGANIC FILTER
ROLL

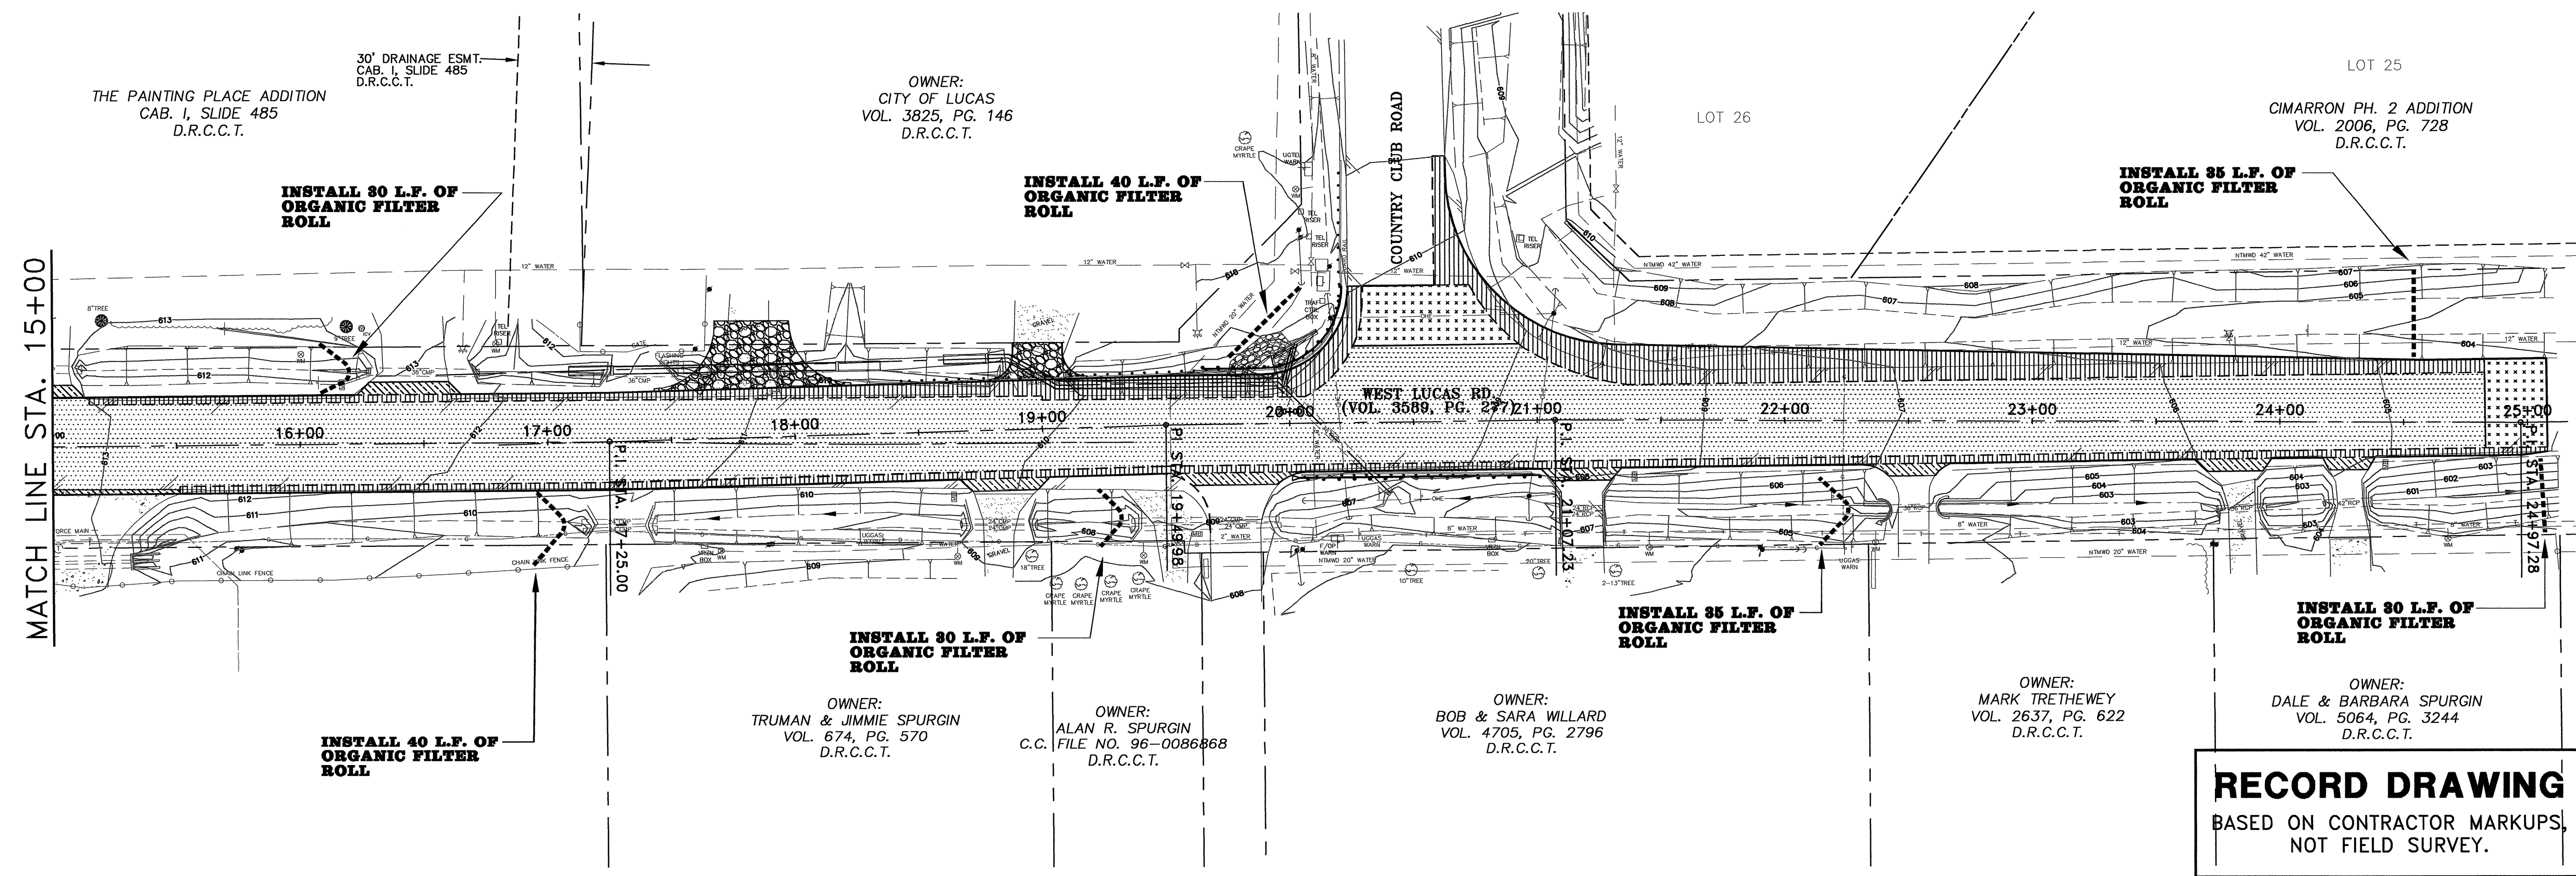

INSTALL 40 L.F. OF
ORGANIC FILTER
ROLL

INSTALL 30 L.F. OF
ORGANIC FILTER
ROLL

INSTALL 35 L.F. OF
ORGANIC FILTER
ROLL

INSTALL 30 L.F. OF
ORGANIC FILTER
ROLL

OWNER:
LUCAS BAPTIST CHURCH

OWNER:
TRUMAN & JIMMIE SPURGIN
VOL. 674, PG. 570
D.R.C.C.T.

OWNER:
ALAN R. SPURGIN
FILE NO. 96-0086868
D.R.C.C.T.

OWNER:
BOB & SARA WILLARD
VOL. 4705, PG. 2796
D.R.C.C.T.

OWNER:
MARK TRETHERWEY
VOL. 2637, PG. 622
D.R.C.C.T.

OWNER:
DALE & BARBARA SPURGIN
VOL. 5064, PG. 3244
D.R.C.C.T.

RECORD DRAWING
BASED ON CONTRACTOR MARKUPS,
NOT FIELD SURVEY.


!! CAUTION !!
THERE ARE EXISTING AND/OR PROPOSED UTILITIES IN
PROJECT AREA. UTILITY INFORMATION SHOWN ON PLANS
REPRESENTS APPROXIMATE LOCATIONS OF EXISTING
UTILITIES AND IS NOT NECESSARILY ALL-INCLUSIVE.
CONTRACTOR SHALL BE RESPONSIBLE FOR VERIFYING
EXACT LOCATIONS OF ALL EXISTING UTILITIES AND SHALL
BE REQUIRED TO PROTECT UTILITIES TO AVOID DAMAGE.
**PRIOR TO ANY EXCAVATION, CONTRACTOR
SHALL CONTACT DIG-TESS, TEXAS ONE CALL,
LONE STAR NOTIFICATION AND OTHERS AS
REQUIRED TO LOCATE EXISTING UTILITIES.**
CONTRACTOR SHALL ALSO CONTACT APPROPRIATE CITY
UTILITY DEPARTMENT FOR FIELD LOCATES OF MUNICIPAL
INFRASTRUCTURE 48 HOURS PRIOR TO CONSTRUCTION.

6			
5			
4			
3			
2			
1			
NO.	DATE	REVISION	REVIEWED

DRAWN: _____ BW2
DESIGN: _____ JFW
REVIEWED: _____ MRB
SCALE: _____ 1" = 40'
DATE: _____ APRIL 2013
DWG. NAME: 1572ERO-CTRL01









BW2 Engineers, Inc.
1919 S. Shiloh Road
Suite 500, L.B. 27
Garland, Texas 75042
(972) 864-8200 (T) (972) 864-8220 (F)
Firm Registration No. F-5290

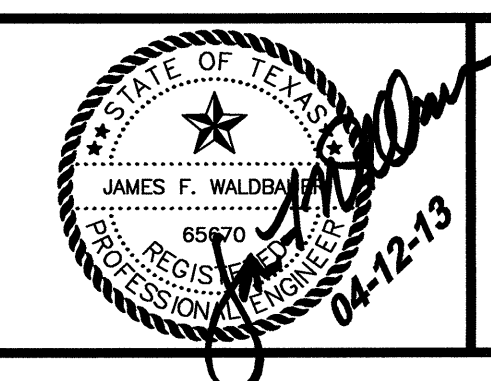

INTERSECTION IMPROVEMENTS
LUCAS ROAD/COUNTRY CLUB ROAD
EROSION CONTROL PLAN
CITY OF LUCAS

SHEET NO. 4
OF 32 SHEETS
JOB NO. 12-1572

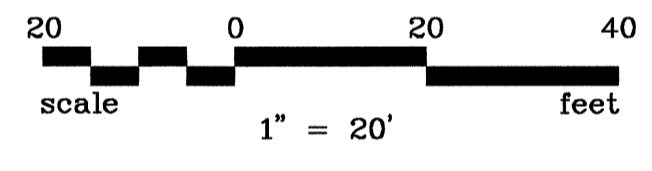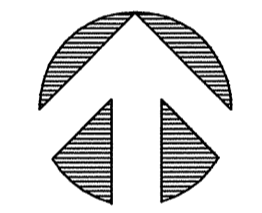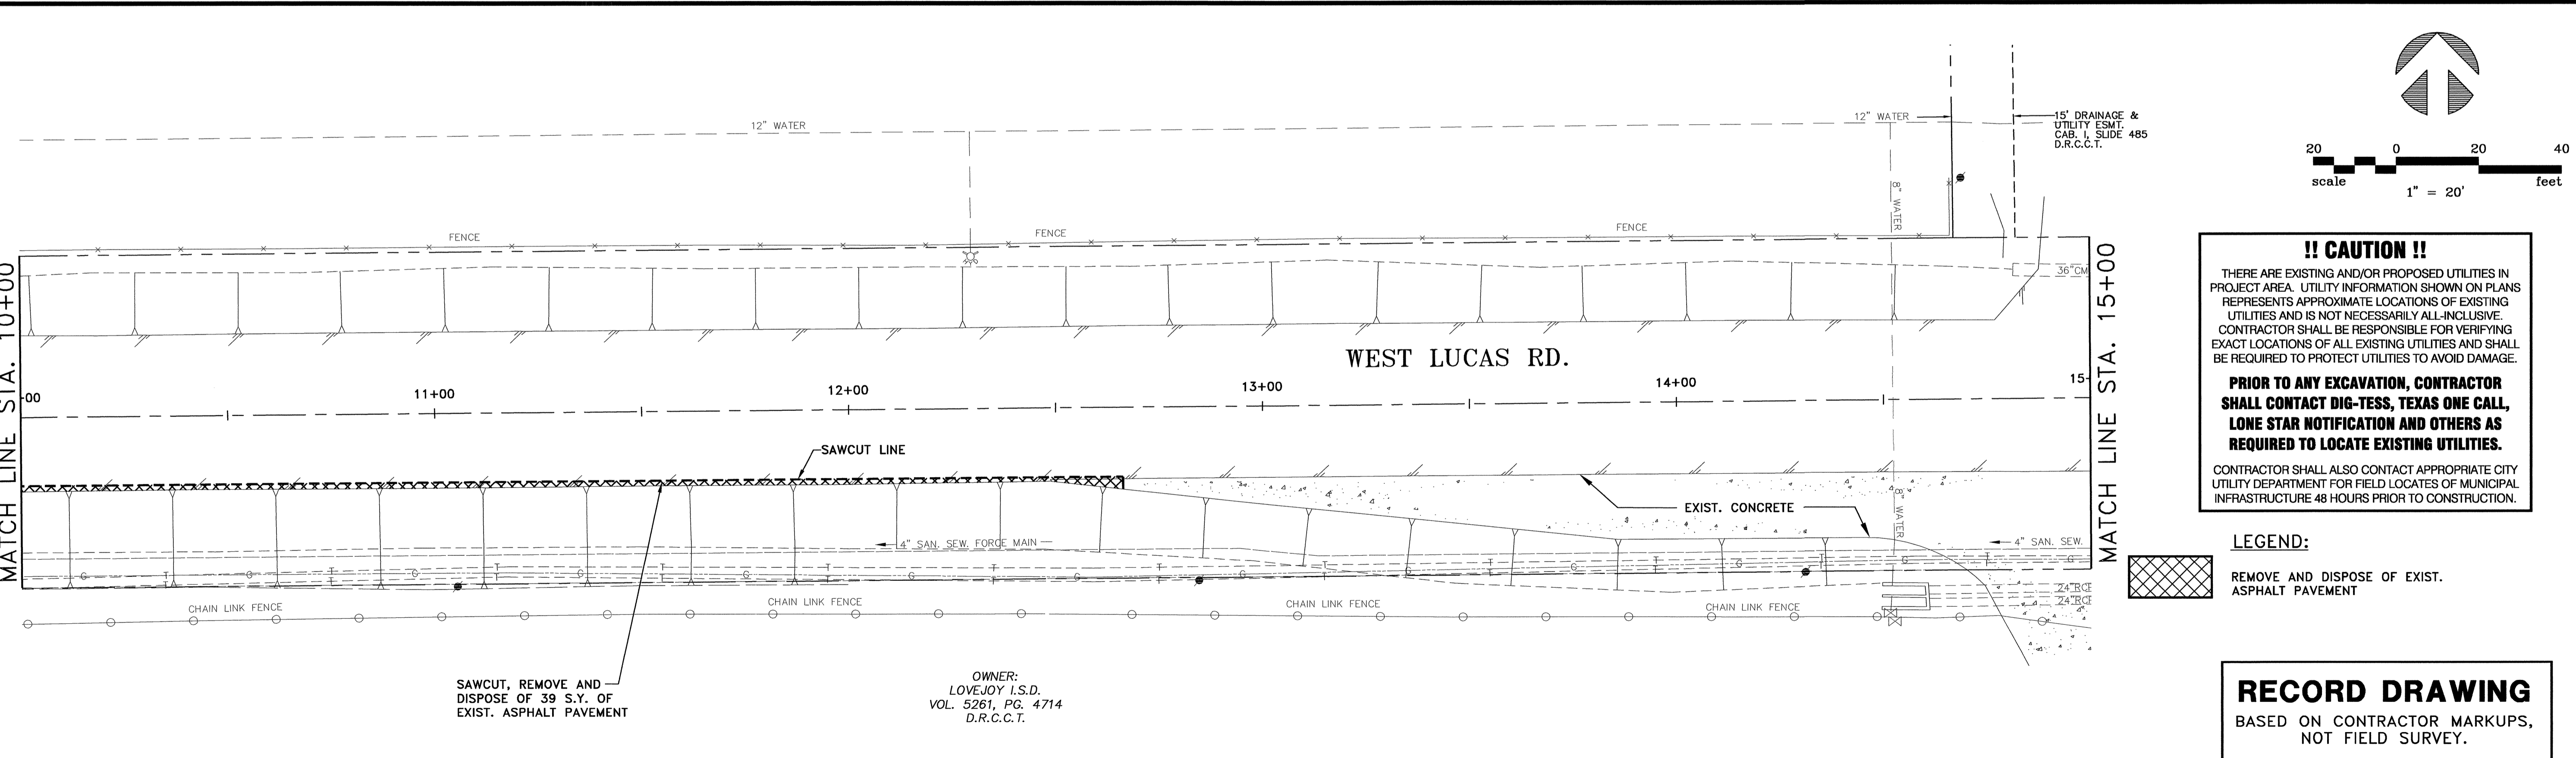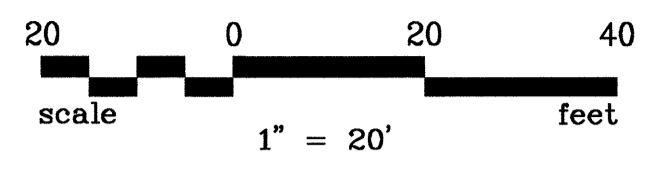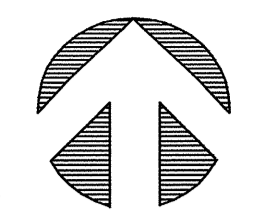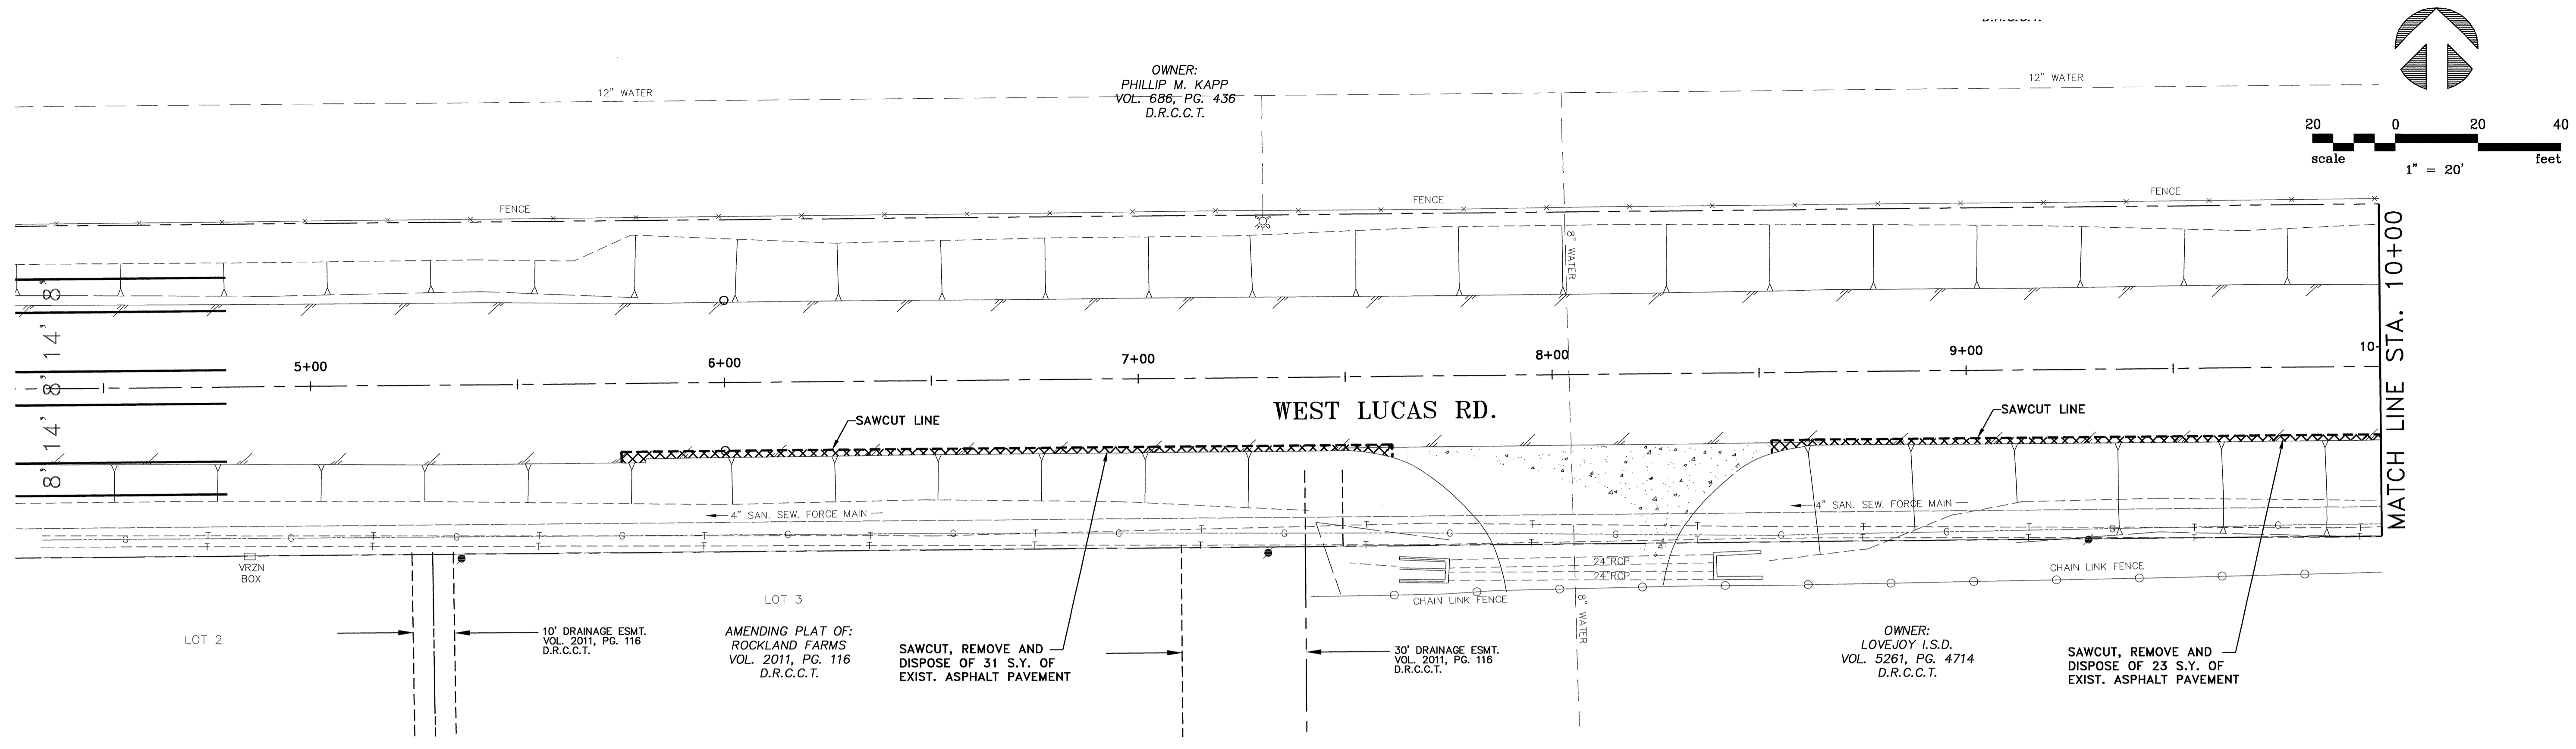

!! CAUTION !!
 THERE ARE EXISTING AND/OR PROPOSED UTILITIES IN PROJECT AREA. UTILITY INFORMATION SHOWN ON PLANS REPRESENTS APPROXIMATE LOCATIONS OF EXISTING UTILITIES AND IS NOT NECESSARILY ALL-INCLUSIVE. CONTRACTOR SHALL BE RESPONSIBLE FOR VERIFYING EXACT LOCATIONS OF ALL EXISTING UTILITIES AND SHALL BE REQUIRED TO PROTECT UTILITIES TO AVOID DAMAGE.
PRIOR TO ANY EXCAVATION, CONTRACTOR SHALL CONTACT DIG-TESS, TEXAS ONE CALL, LONE STAR NOTIFICATION AND OTHERS AS REQUIRED TO LOCATE EXISTING UTILITIES.
 CONTRACTOR SHALL ALSO CONTACT APPROPRIATE CITY UTILITY DEPARTMENT FOR FIELD LOCATES OF MUNICIPAL INFRASTRUCTURE 48 HOURS PRIOR TO CONSTRUCTION.

LEGEND:
 REMOVE AND DISPOSE OF EXIST. ASPHALT PAVEMENT


RECORD DRAWING
 BASED ON CONTRACTOR MARKUPS, NOT FIELD SURVEY.

6			
5			
4			
3			
2			
1			
NO.	DATE	REVISION	REVIEWED

DRAWN: BW2
 DESIGN: JFW
 REVIEWED: MRB
 SCALE: 1" = 20'
 DATE: APRIL 2013
 DWG. NAME: 1572DEMOPLN01




BW2 Engineers, Inc.
 1919 S. Shiloh Road
 Suite 500, L.B. 27
 Garland, Texas 75042
 (972) 864-8200 (T) (972) 864-8220 (F)
 Firm Registration No. F-5290

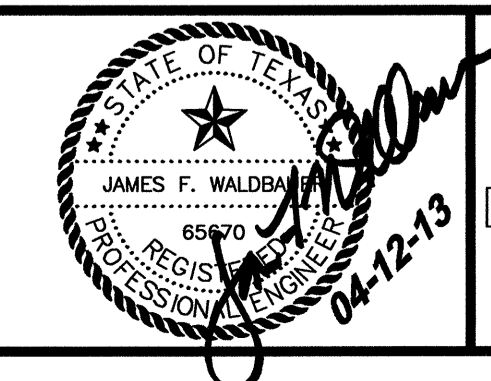

INTERSECTION IMPROVEMENTS
 LUCAS ROAD/COUNTRY CLUB ROAD
 DEMOLITION PLAN - STA. 0+00 TO STA. 15+00
CITY OF LUCAS

SHEET NO. **5**
 OF **32** SHEETS
 JOB NO. 12-1572

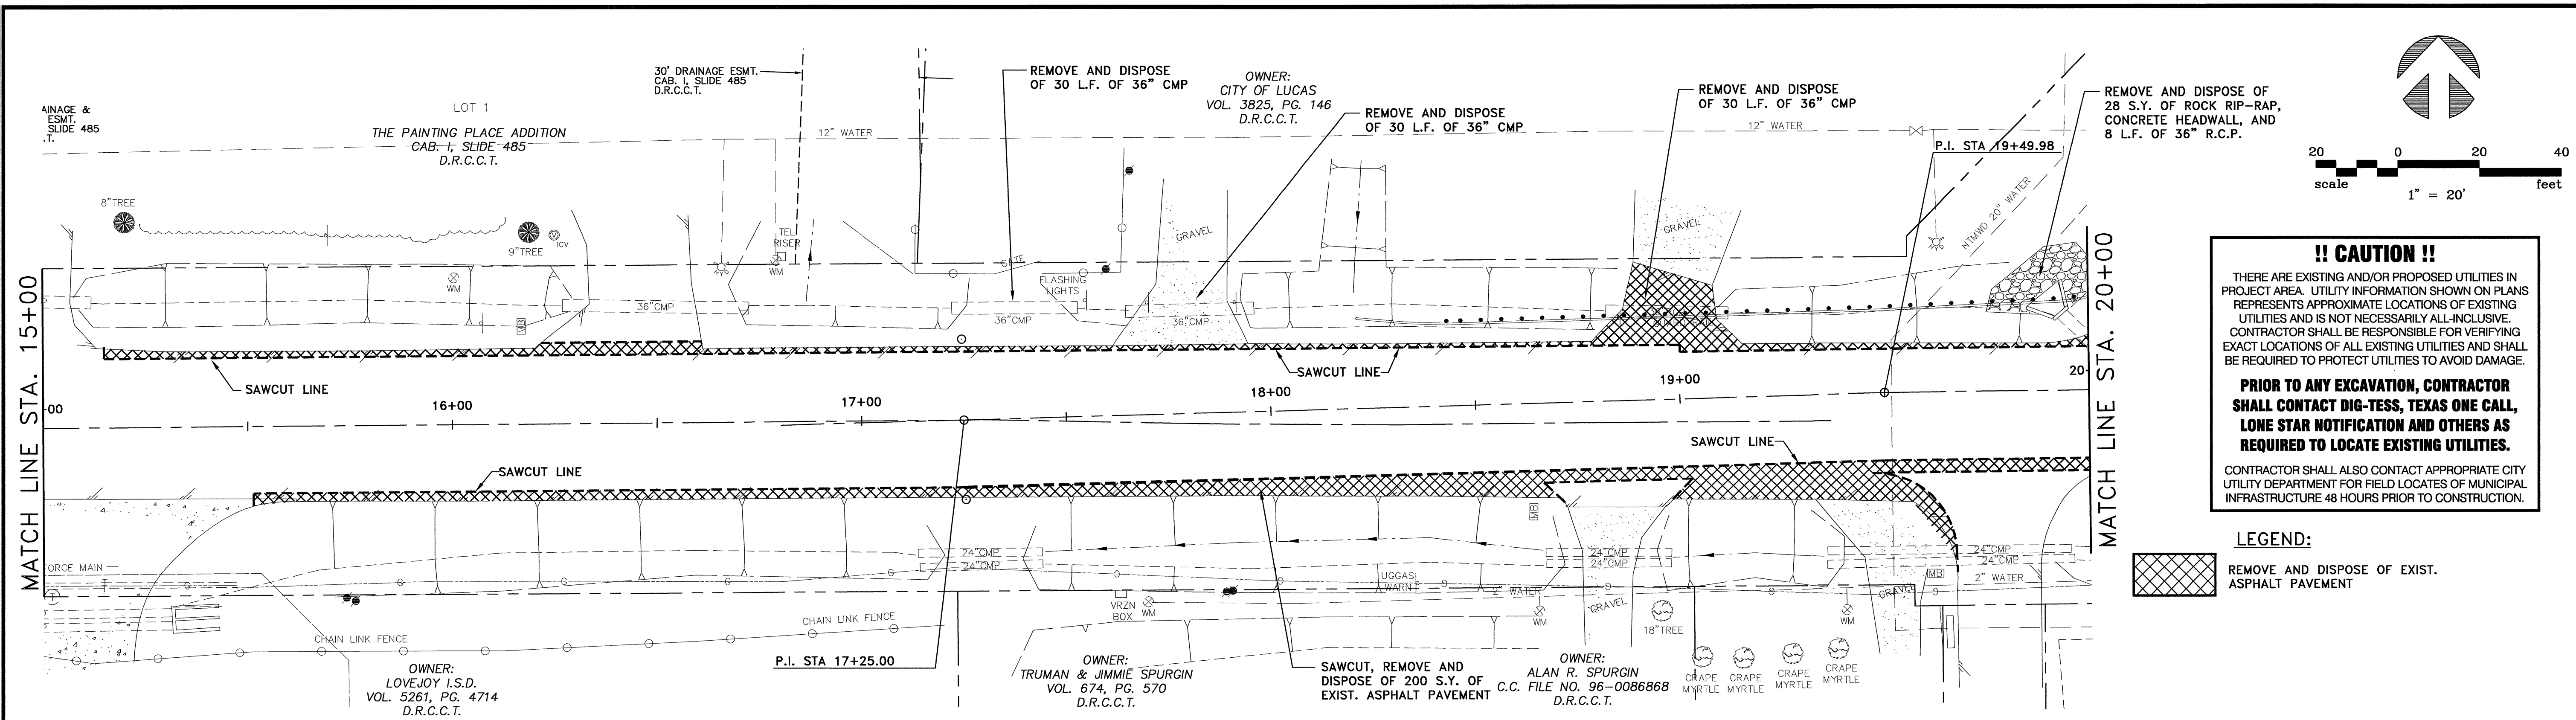

!! CAUTION !!


THERE ARE EXISTING AND/OR PROPOSED UTILITIES IN PROJECT AREA. UTILITY INFORMATION SHOWN ON PLANS REPRESENTS APPROXIMATE LOCATIONS OF EXISTING UTILITIES AND IS NOT NECESSARILY ALL-INCLUSIVE. CONTRACTOR SHALL BE RESPONSIBLE FOR VERIFYING EXACT LOCATIONS OF ALL EXISTING UTILITIES AND SHALL BE REQUIRED TO PROTECT UTILITIES TO AVOID DAMAGE.

PRIOR TO ANY EXCAVATION, CONTRACTOR SHALL CONTACT DIG-TESS, TEXAS ONE CALL, LONE STAR NOTIFICATION AND OTHERS AS REQUIRED TO LOCATE EXISTING UTILITIES.

CONTRACTOR SHALL ALSO CONTACT APPROPRIATE CITY UTILITY DEPARTMENT FOR FIELD LOCATES OF MUNICIPAL INFRASTRUCTURE 48 HOURS PRIOR TO CONSTRUCTION.

LEGEND:

REMOVE AND DISPOSE OF EXIST. ASPHALT PAVEMENT

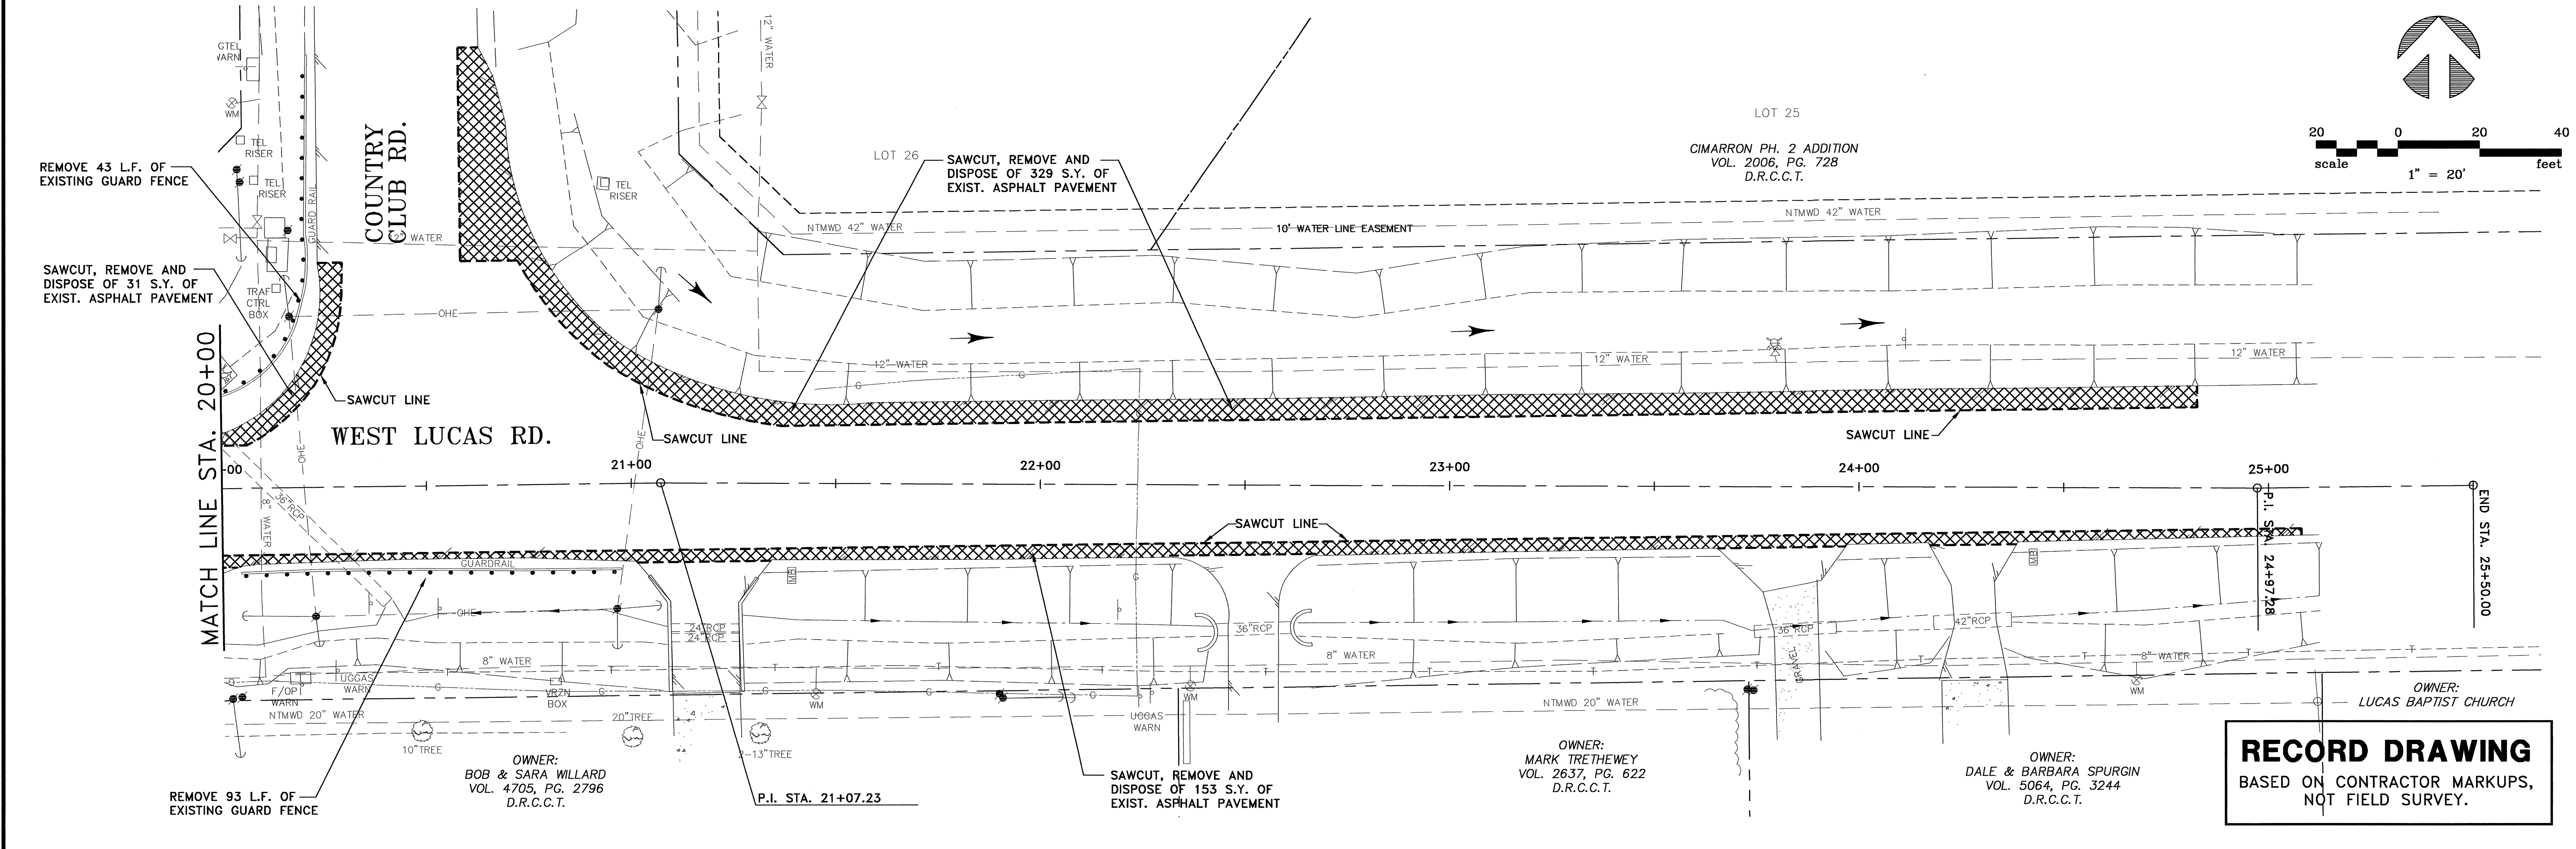

RECORD DRAWING


BASED ON CONTRACTOR MARKUPS,
NOT FIELD SURVEY.

NO.	DATE	REVISION	REVIEWED
6			
5			
4			
3			
2			
1			

DRAWN: BW2
 DESIGN: JFW
 REVIEWED: MRB
 SCALE: 1" = 20'
 DATE: APRIL 2013
 DWG. NAME: 1572DEMOPLN01





BW2 Engineers, Inc.
 1919 S. Shiloh Road
 Suite 500, L.B. 27
 Garland, Texas 75042
 (972) 864-8200 (T) (972) 864-8220 (F)
 Firm Registration No. F-5290

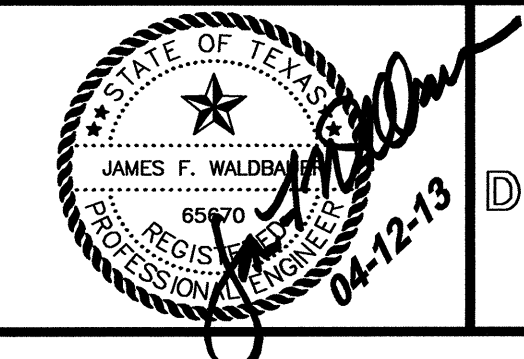


INTERSECTION IMPROVEMENTS
LUCAS ROAD/COUNTRY CLUB ROAD
 DEMOLITION PLAN - STA. 15+00 TO STA. 25+50
CITY OF LUCAS



SHEET NO. **6**
 OF **32** SHEETS
 JOB NO. 12-1572

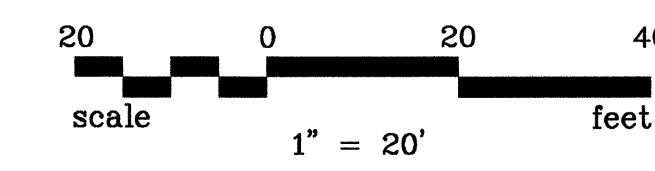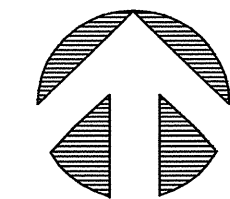


OWNER:
PHILLIP M. KAPP
VOL. 686, PG. 436
D.R.C.C.T.

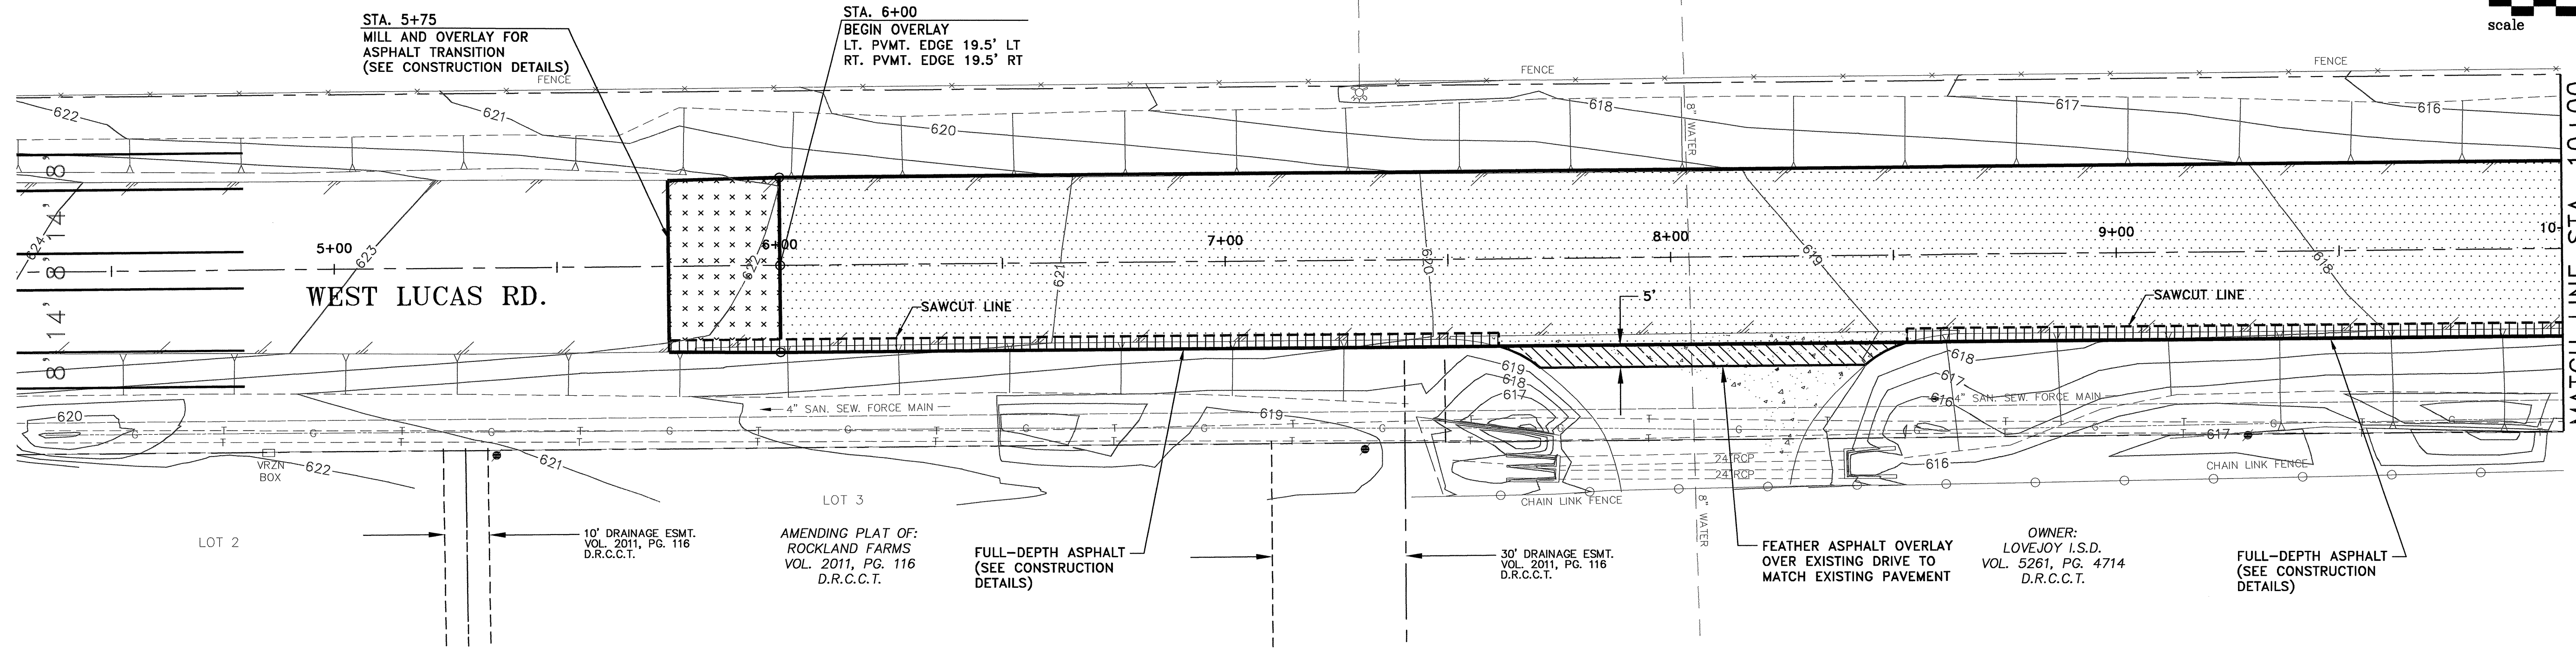

MATCH LINE STA. 10+00

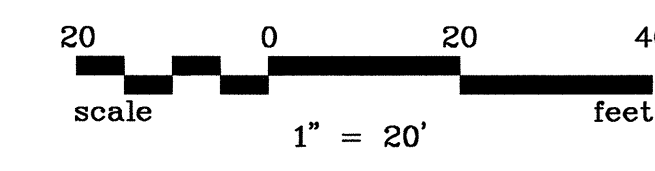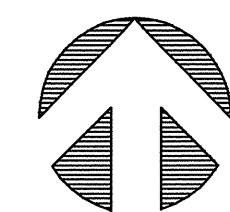

15' DRAINAGE &
UTILITY ESMT.
VOL. 485
D.R.C.C.T.

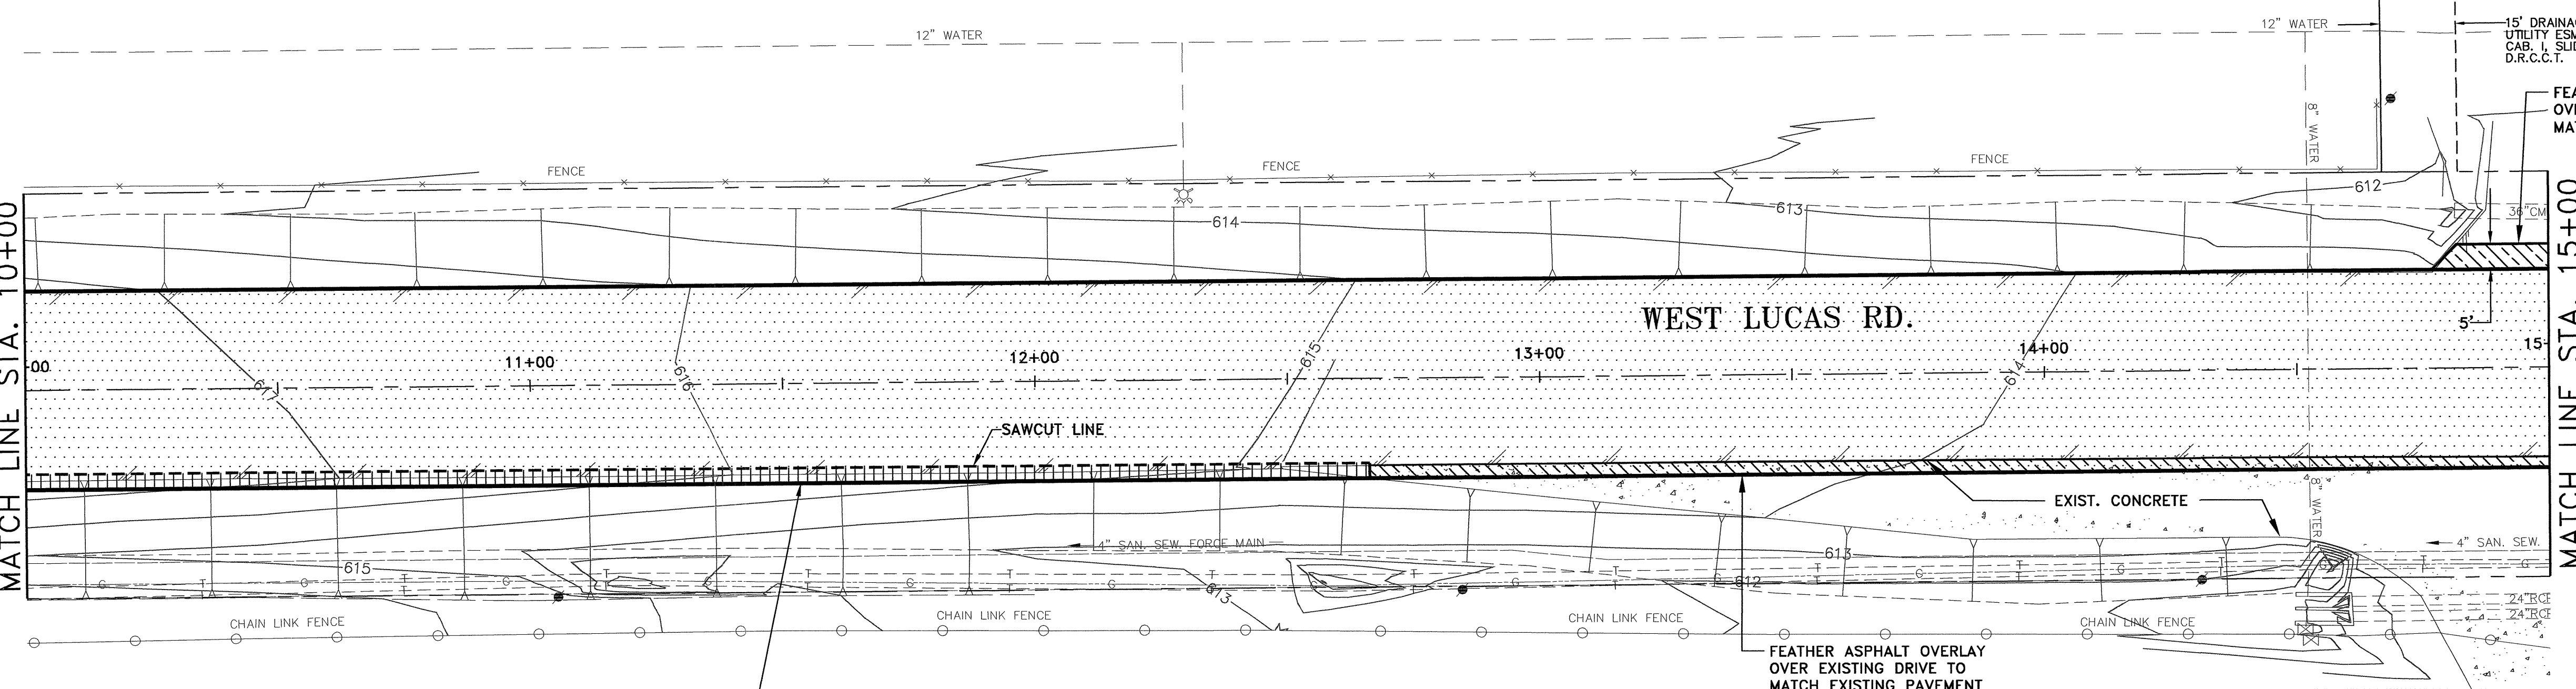

MATCH LINE STA. 15+00

!! CAUTION !!
THERE ARE EXISTING AND/OR PROPOSED UTILITIES IN PROJECT AREA. UTILITY INFORMATION SHOWN ON PLANS REPRESENTS APPROXIMATE LOCATIONS OF EXISTING UTILITIES AND IS NOT NECESSARILY ALL-INCLUSIVE. CONTRACTOR SHALL BE RESPONSIBLE FOR VERIFYING EXACT LOCATIONS OF ALL EXISTING UTILITIES AND SHALL BE REQUIRED TO PROTECT UTILITIES TO AVOID DAMAGE.
PRIOR TO ANY EXCAVATION, CONTRACTOR SHALL CONTACT DIG-TESS, TEXAS ONE CALL, LONE STAR NOTIFICATION AND OTHERS AS REQUIRED TO LOCATE EXISTING UTILITIES.
CONTRACTOR SHALL ALSO CONTACT APPROPRIATE CITY UTILITY DEPARTMENT FOR FIELD LOCATES OF MUNICIPAL INFRASTRUCTURE 48 HOURS PRIOR TO CONSTRUCTION.

- LEGEND:**
- OVERLAY - 1 1/2" TYPE 'D' HMAC SURFACE COURSE
 - FULL DEPTH RECONSTRUCTION
 - ASPHALT MILL AND OVERLAY TRANSITION
 - ASPHALT OVERLAY TAPER AT DRIVEWAYS

RECORD DRAWING
BASED ON CONTRACTOR MARKUPS,
NOT FIELD SURVEY.


OWNER:
LOVEJOY I.S.D.
VOL. 5261, PG. 4714
D.R.C.C.T.

NO.	DATE	REVISION	REVIEWED
6			
5			
4			
3			
2			
1			

DRAWN: BW2
 DESIGN: JFW
 REVIEWED: MRB
 SCALE: 1" = 20'
 DATE: APRIL 2013
 DWG. NAME: 1572PAVPLN01




BW2 Engineers, Inc.
 1919 S. Shiloh Road
 Suite 500, L.B. 27
 Garland, Texas 75042
 (972) 864-8200 (T) (972) 864-8220 (F)
 Firm Registration No. F-5290

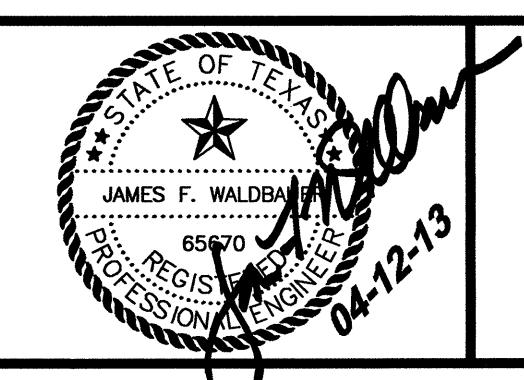

INTERSECTION IMPROVEMENTS
 LUCAS ROAD/COUNTRY CLUB ROAD
 PAVING PLAN - STA. 0+00 TO STA. 15+00
CITY OF LUCAS

SHEET NO. 7
 OF 32 SHEETS
 JOB NO. 12-1572

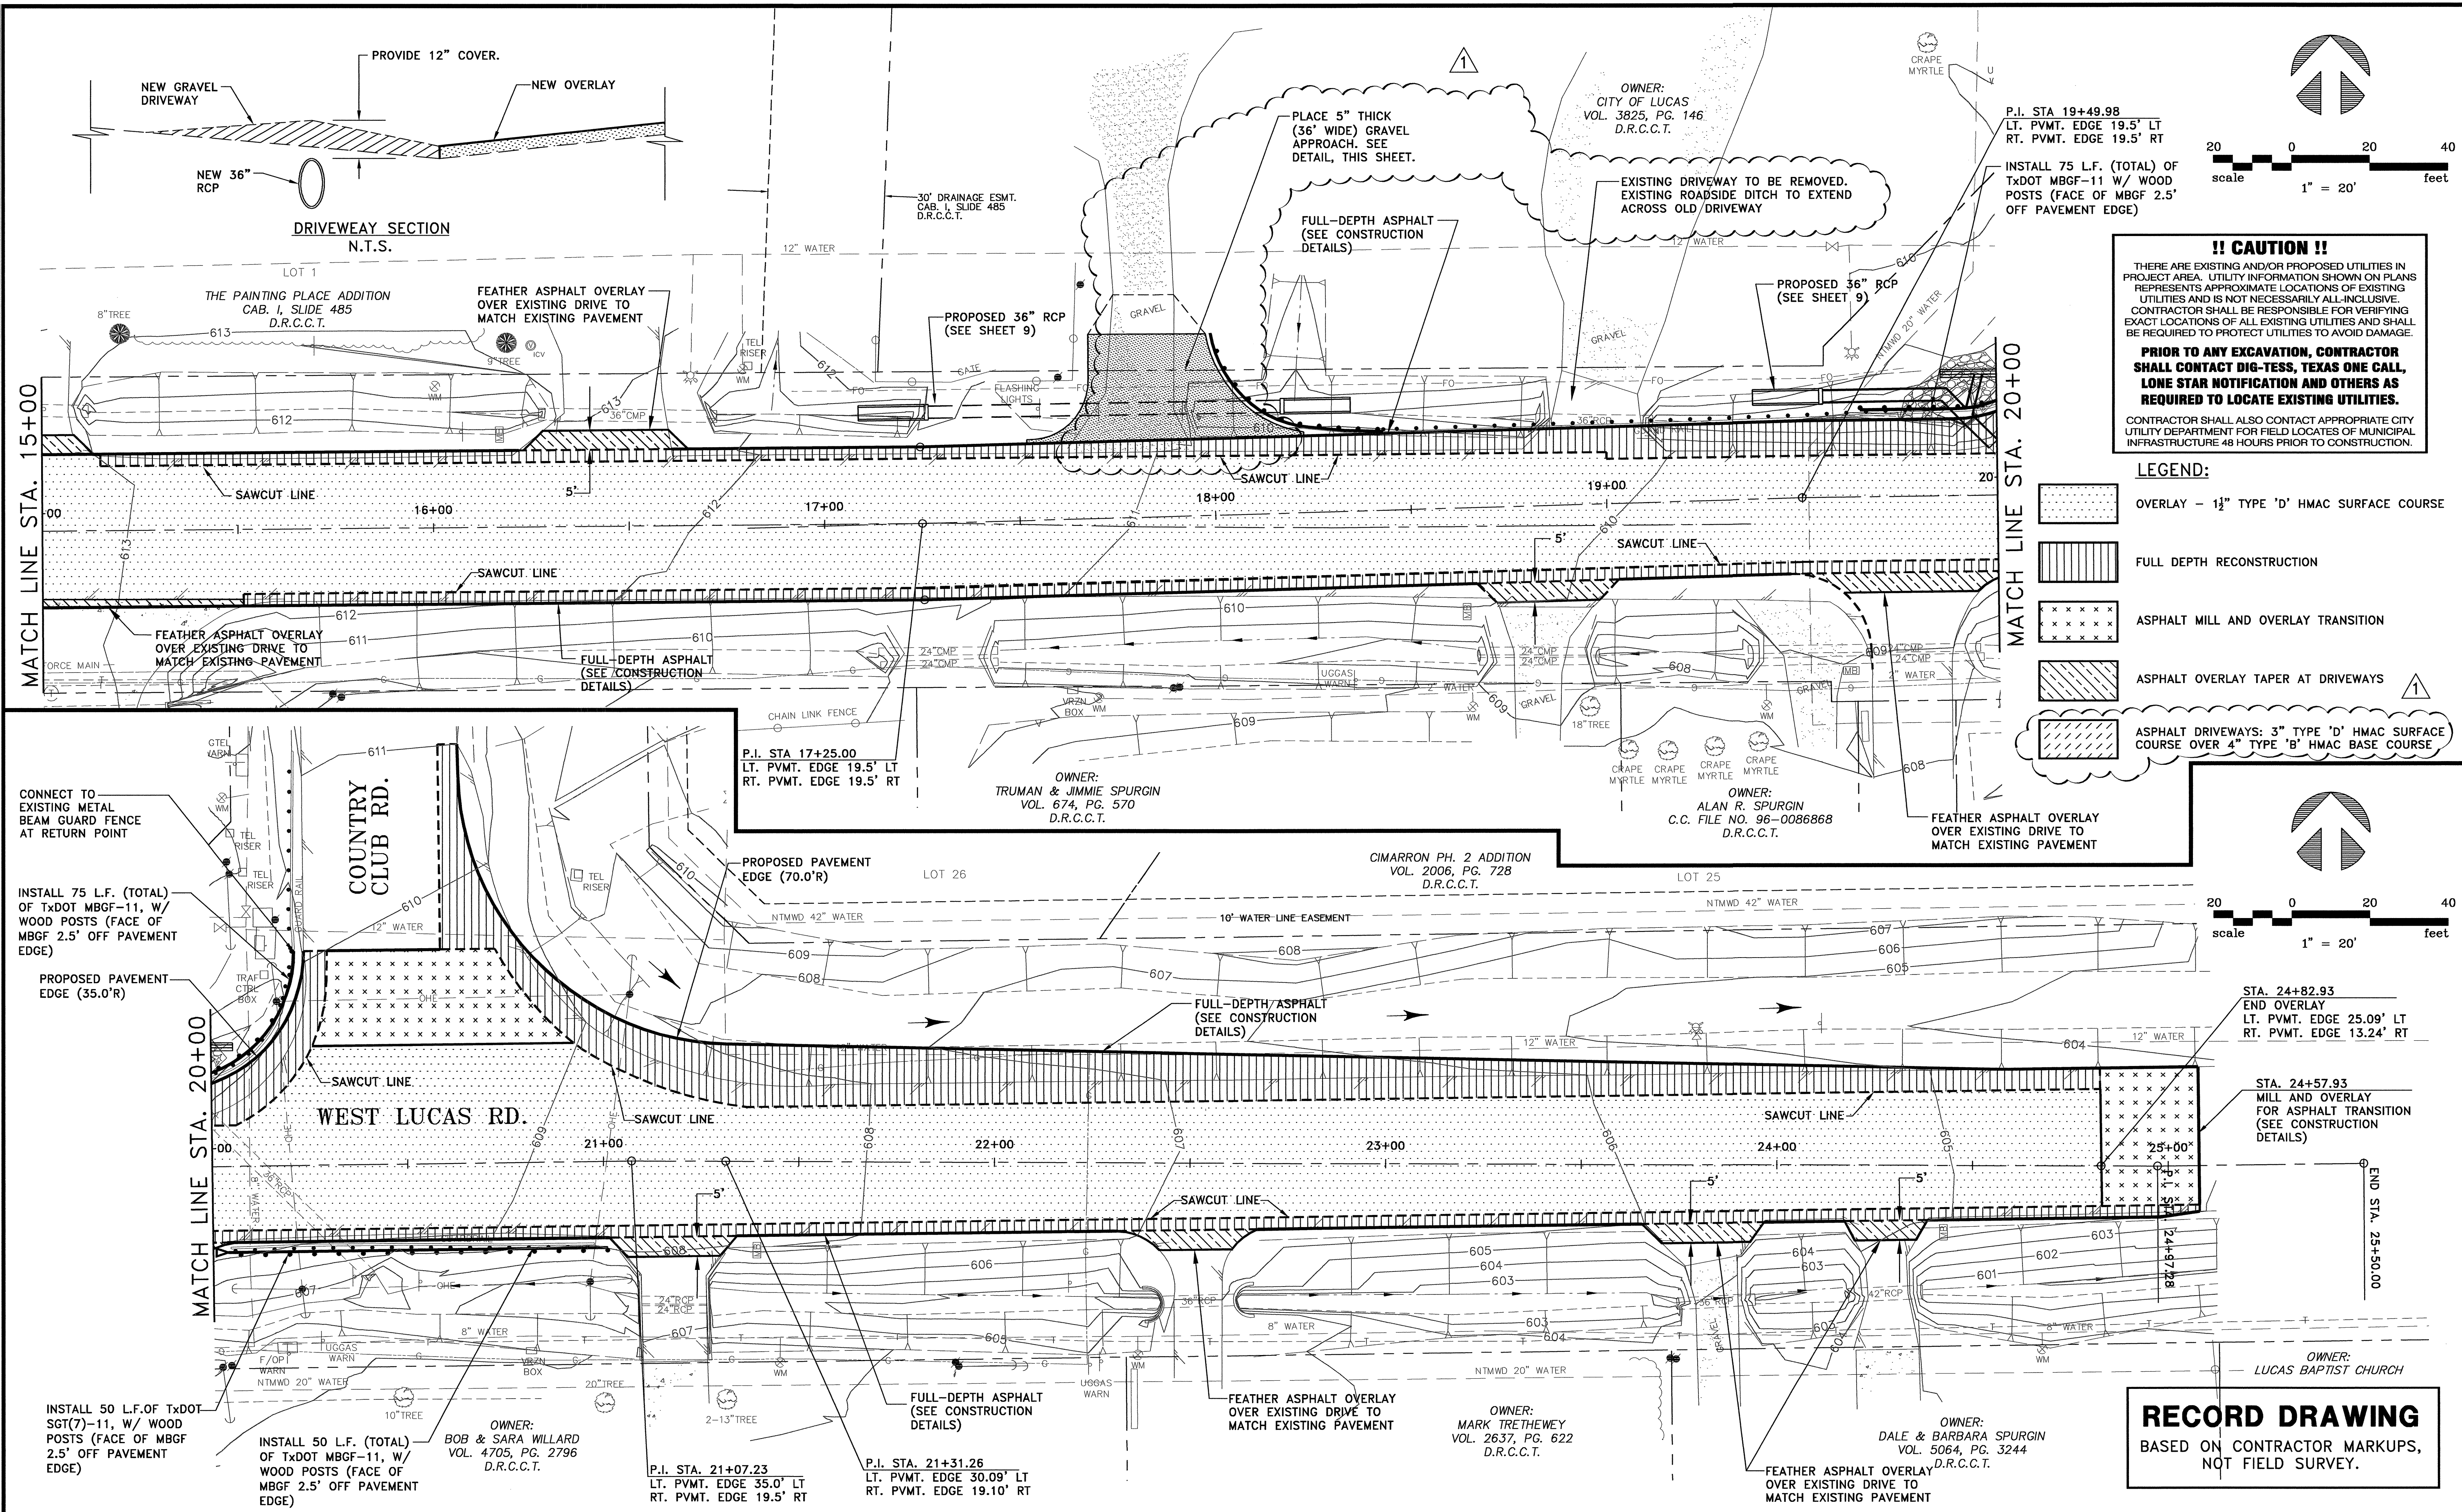

!! CAUTION !!
 THERE ARE EXISTING AND/OR PROPOSED UTILITIES IN PROJECT AREA. UTILITY INFORMATION SHOWN ON PLANS REPRESENTS APPROXIMATE LOCATIONS OF EXISTING UTILITIES AND IS NOT NECESSARILY ALL-INCLUSIVE. CONTRACTOR SHALL BE RESPONSIBLE FOR VERIFYING EXACT LOCATIONS OF ALL EXISTING UTILITIES AND SHALL BE REQUIRED TO PROTECT UTILITIES TO AVOID DAMAGE.
PRIOR TO ANY EXCAVATION, CONTRACTOR SHALL CONTACT DIG-TESS, TEXAS ONE CALL, LONE STAR NOTIFICATION AND OTHERS AS REQUIRED TO LOCATE EXISTING UTILITIES.
 CONTRACTOR SHALL ALSO CONTACT APPROPRIATE CITY UTILITY DEPARTMENT FOR FIELD LOCATES OF MUNICIPAL INFRASTRUCTURE 48 HOURS PRIOR TO CONSTRUCTION.

- LEGEND:**
- OVERLAY - 1 1/2" TYPE 'D' HMAC SURFACE COURSE
 - FULL DEPTH RECONSTRUCTION
 - ASPHALT MILL AND OVERLAY TRANSITION
 - ASPHALT OVERLAY TAPER AT DRIVEWAYS
 - ASPHALT DRIVEWAYS: 3" TYPE 'D' HMAC SURFACE COURSE OVER 4" TYPE 'B' HMAC BASE COURSE


RECORD DRAWING
 BASED ON CONTRACTOR MARKUPS,
 NOT FIELD SURVEY.

6			
5			
4			
3			
2			
1	07-15-13	REVISED PER CHANGE ORDER No. 1	JFW
NO.	DATE	REVISION	REVIEWED

DRAWN: BW2
 DESIGN: JFW
 REVIEWED: MRB
 SCALE: 1" = 20'
 DATE: JUNE 2013
 DWG. NAME: 1572PAVPLN01



BW2 Engineers, Inc.
 1919 S. Shiloh Road
 Suite 500, L.B. 27
 Garland, Texas 75042
 (972) 864-8200 (T) (972) 864-8220 (F)
 Firm Registration No. F-5290

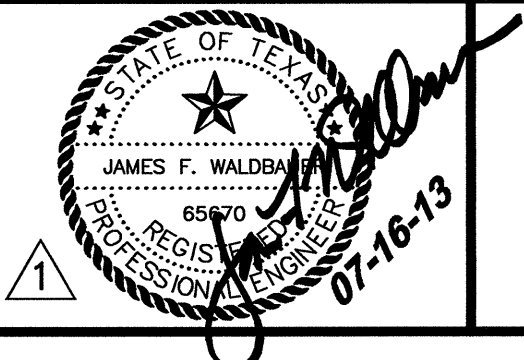

INTERSECTION IMPROVEMENTS
LUCAS ROAD/COUNTRY CLUB ROAD
 PAVING PLAN - STA. 15+00 TO STA. 25+50
CITY OF LUCAS

SHEET NO. 8
 OF 32 SHEETS
 JOB NO. 12-1572

!! CAUTION !!

THERE ARE EXISTING AND/OR PROPOSED UTILITIES IN PROJECT AREA. UTILITY INFORMATION SHOWN ON PLANS REPRESENTS APPROXIMATE LOCATIONS OF EXISTING UTILITIES AND IS NOT NECESSARILY ALL-INCLUSIVE. CONTRACTOR SHALL BE RESPONSIBLE FOR VERIFYING EXACT LOCATIONS OF ALL EXISTING UTILITIES AND SHALL BE REQUIRED TO PROTECT UTILITIES TO AVOID DAMAGE.




PRIOR TO ANY EXCAVATION, CONTRACTOR SHALL CONTACT DIG-TESS, TEXAS ONE CALL, LONE STAR NOTIFICATION AND OTHERS AS REQUIRED TO LOCATE EXISTING UTILITIES.

CONTRACTOR SHALL ALSO CONTACT APPROPRIATE CITY UTILITY DEPARTMENT FOR FIELD LOCATES OF MUNICIPAL INFRASTRUCTURE 48 HOURS PRIOR TO CONSTRUCTION.

THE PAINTING PLACE ADDITION
CAB. 1, SLIDE 485
D.R.C.C.T.

30' DRAINAGE ESMT.
CAB. 1, SLIDE 485
D.R.C.C.T.

OWNER:
CITY OF LUCAS
VOL. 3825, PG. 146
D.R.C.C.T.

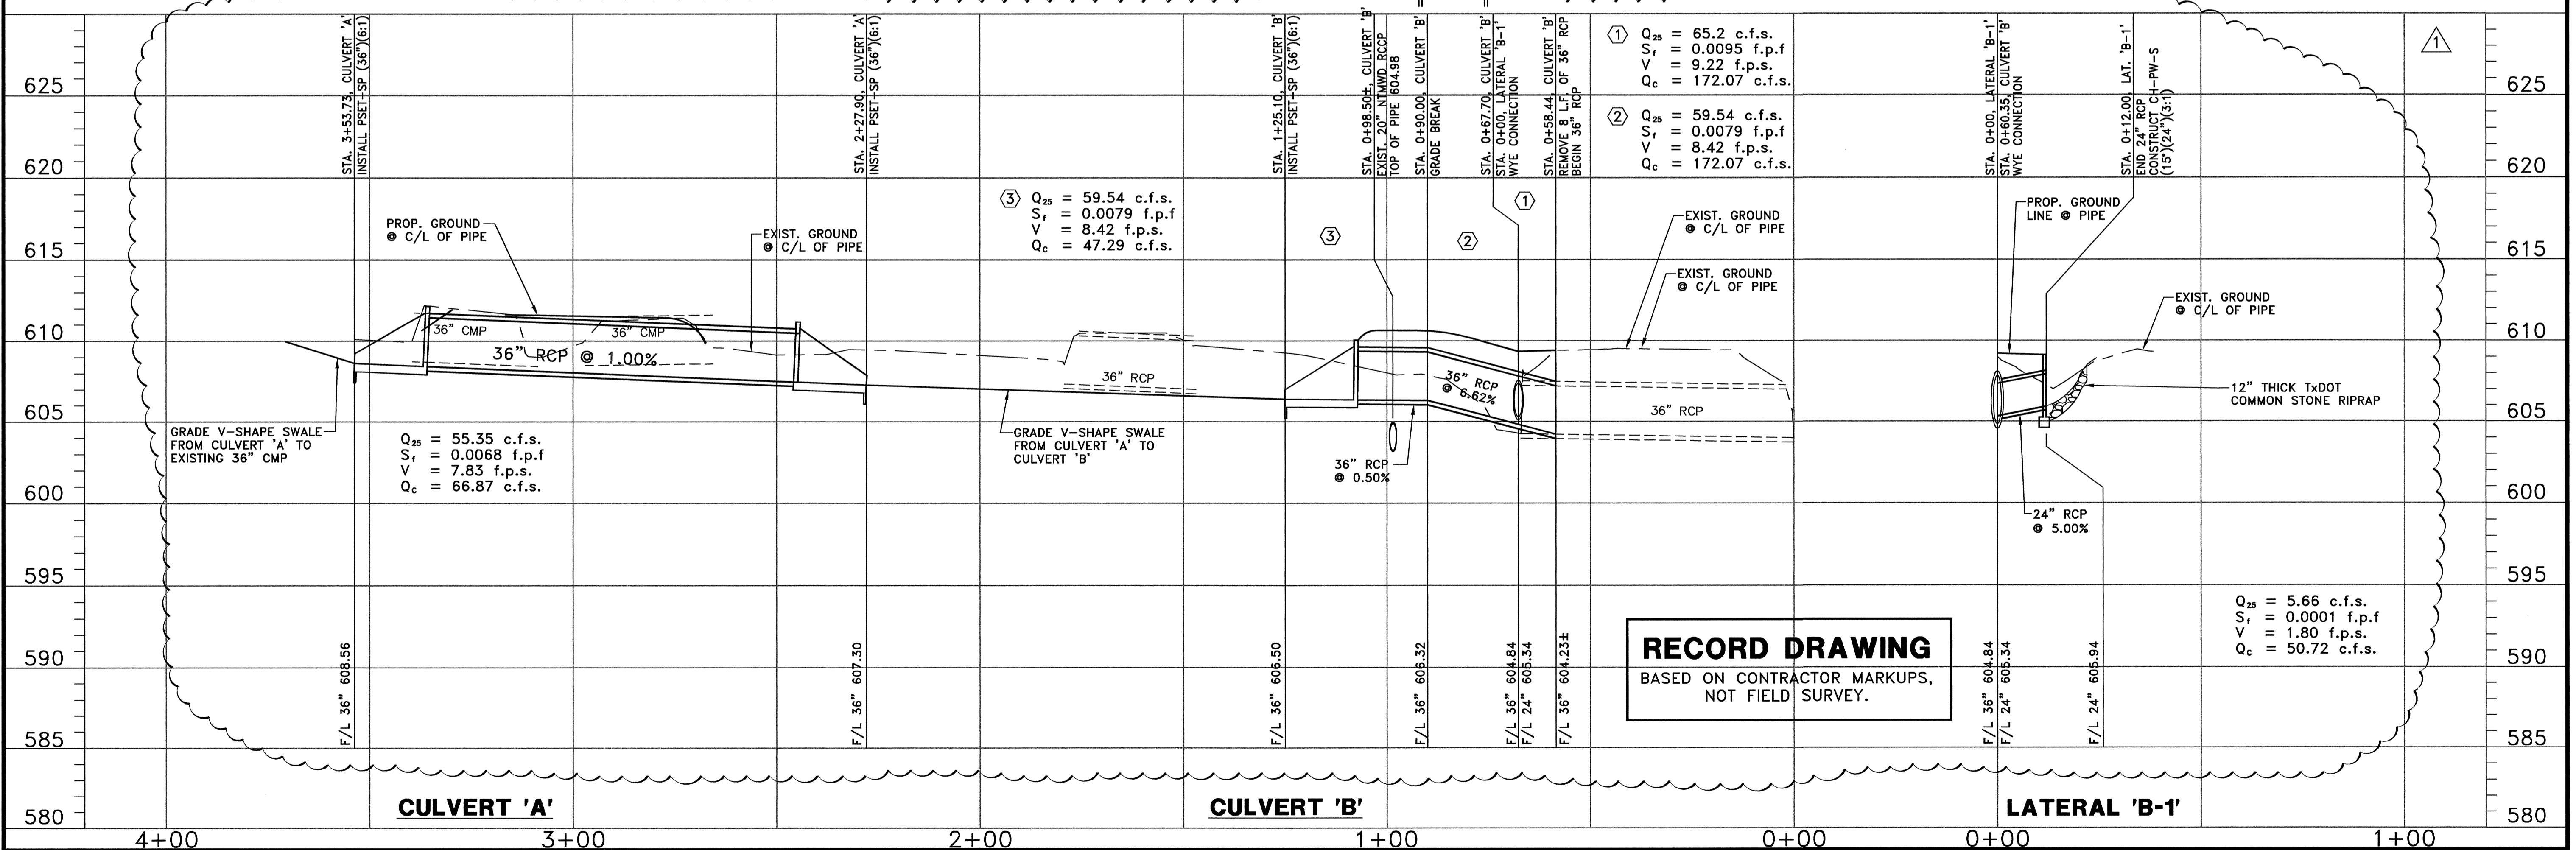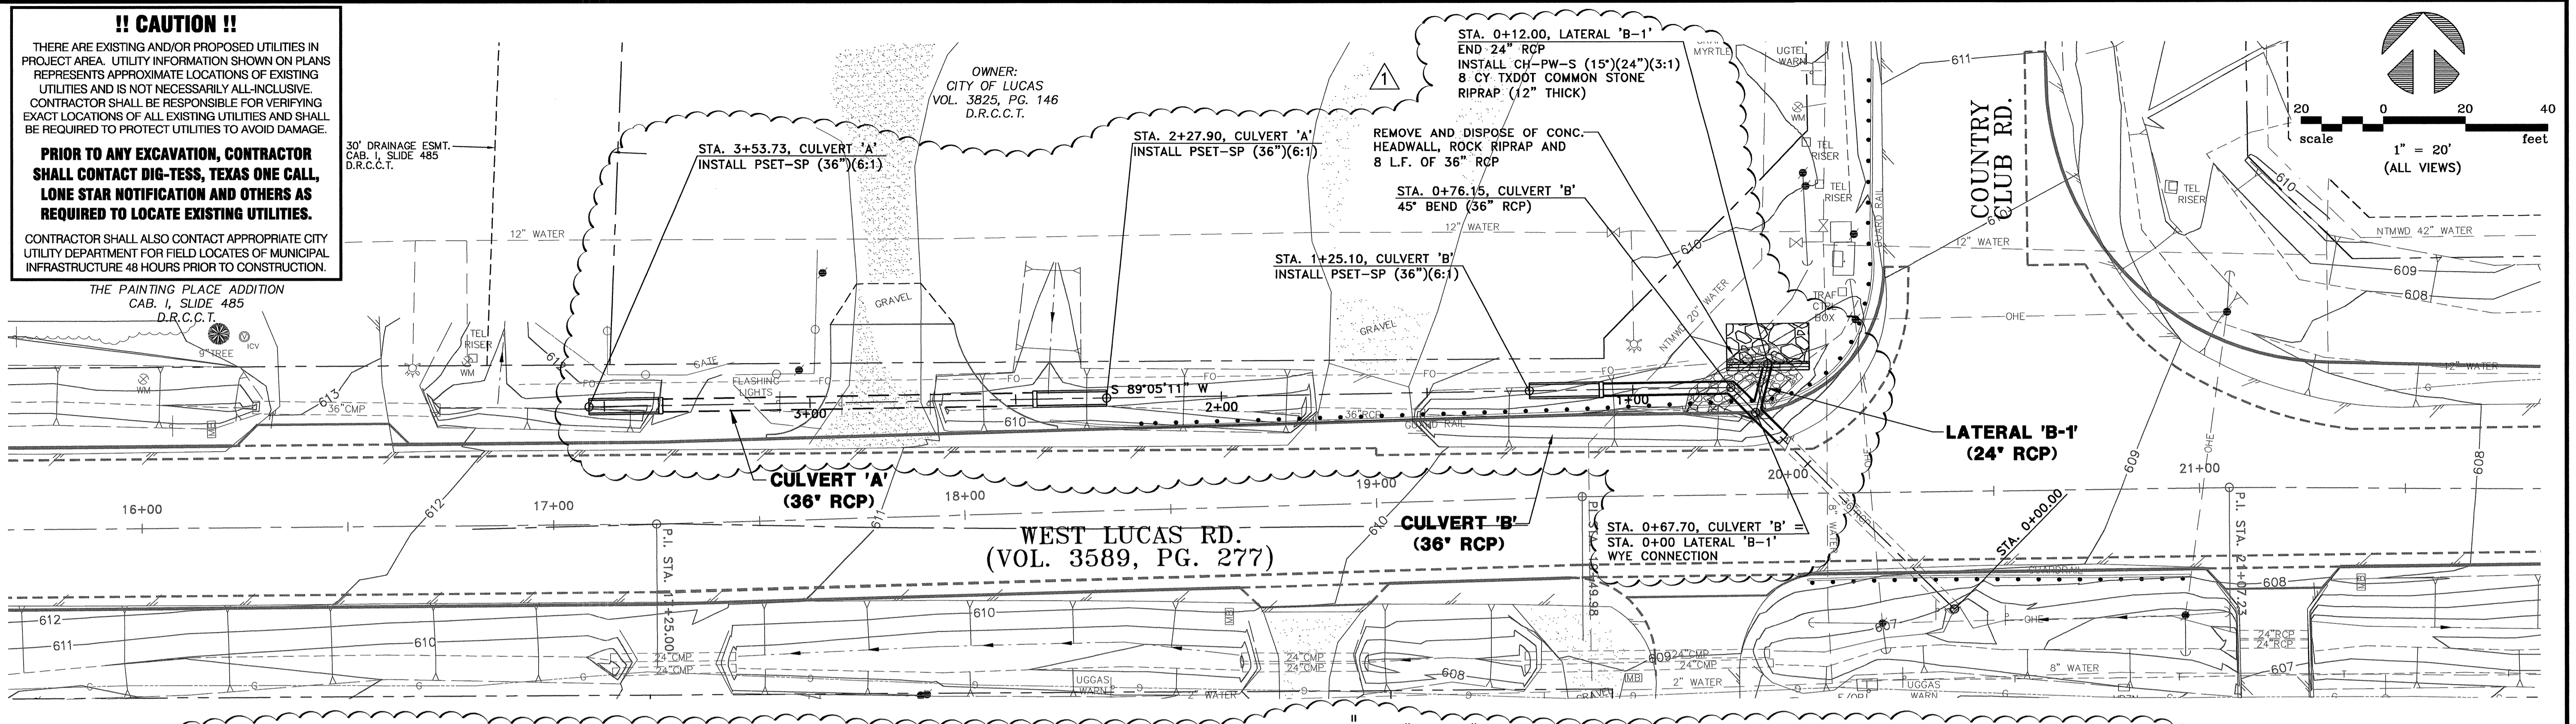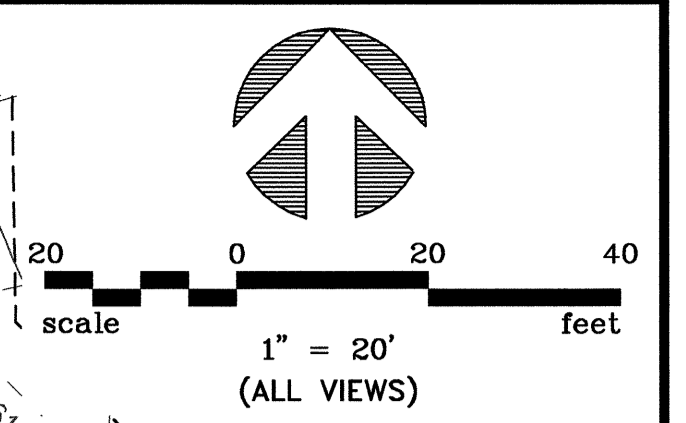


6			
5			
4			
3			
2			
1	06-18-13	REVISED PER CHANGE ORDER No. 1	JFW
NO.	DATE	REVISION	REVIEWED

DRAWN: _____ BW2
 DESIGN: _____ JFW
 REVIEWED: _____ MRB
 SCALE: (H)1"=20', (V)1"=5'
 DATE: _____ JUNE 2013
 DWG. NAME: 1572DRNPP01.DWG







BW2 Engineers, Inc.
 1919 S. Shiloh Road
 Suite 500, L.B. 27
 Garland, Texas 75042
 (972) 864-8200 (T) (972) 864-8220 (F)
 Firm Registration No. F-5290

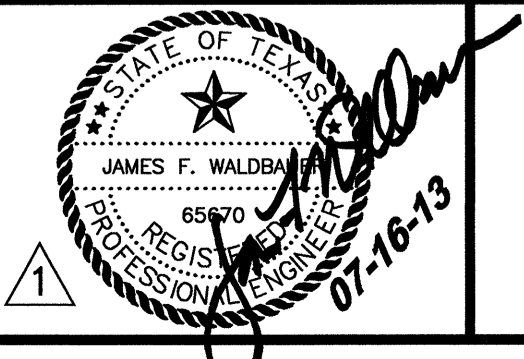

**INTERSECTION IMPROVEMENTS
 LUCAS ROAD/COUNTRY CLUB ROAD
 DRAINAGE PLAN AND PROFILE
 CITY OF LUCAS**

SHEET NO. 9
 OF 32 SHEETS
 JOB NO. 12-1572

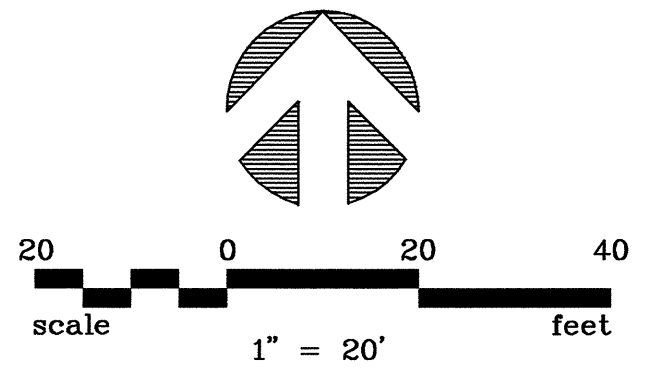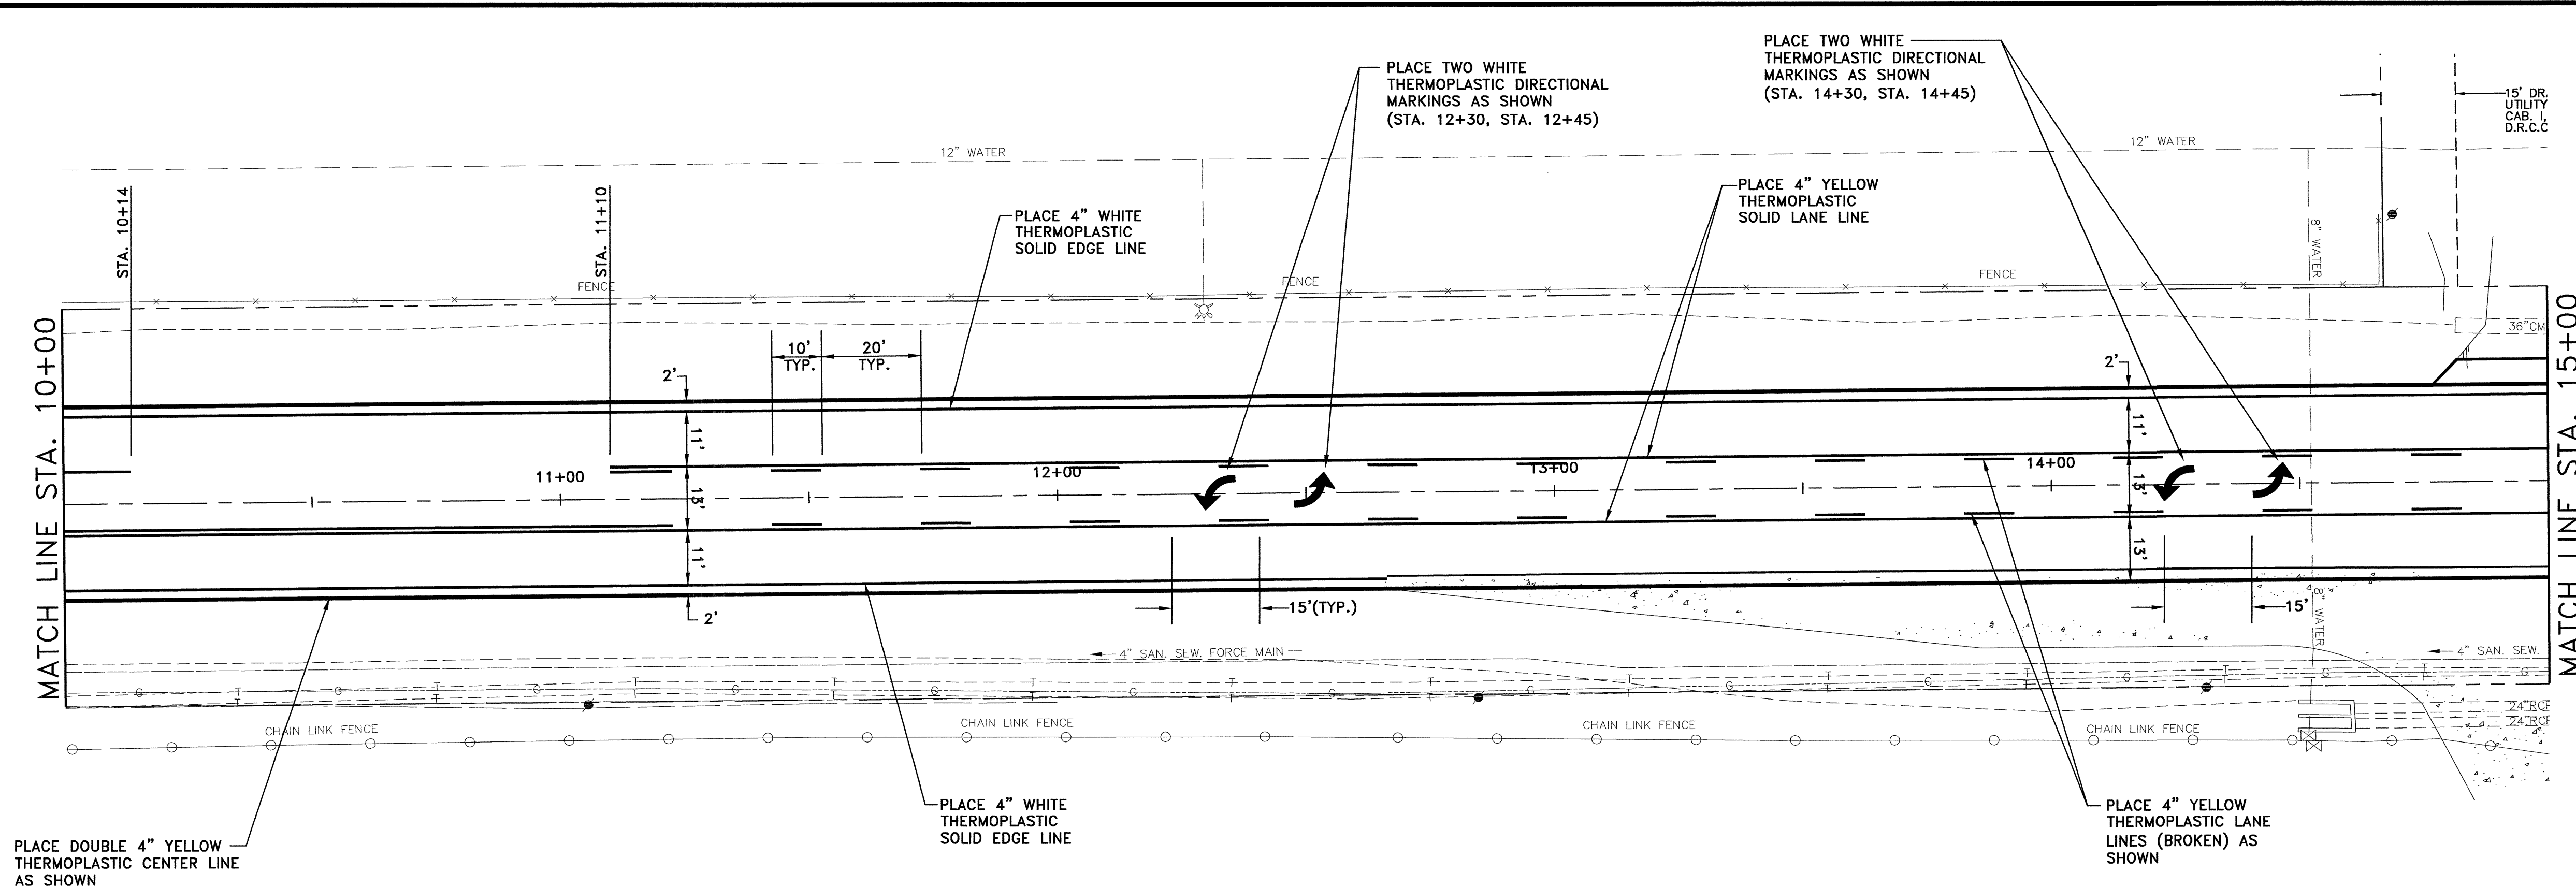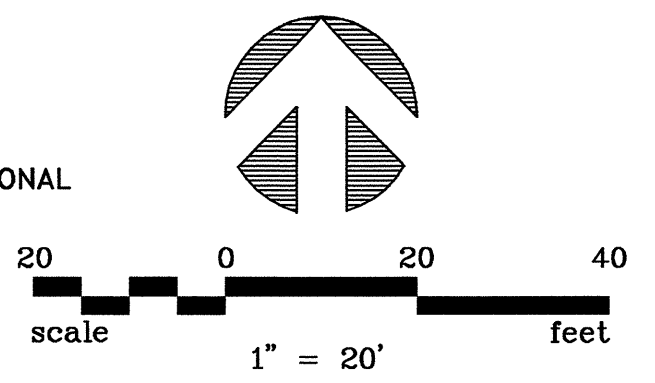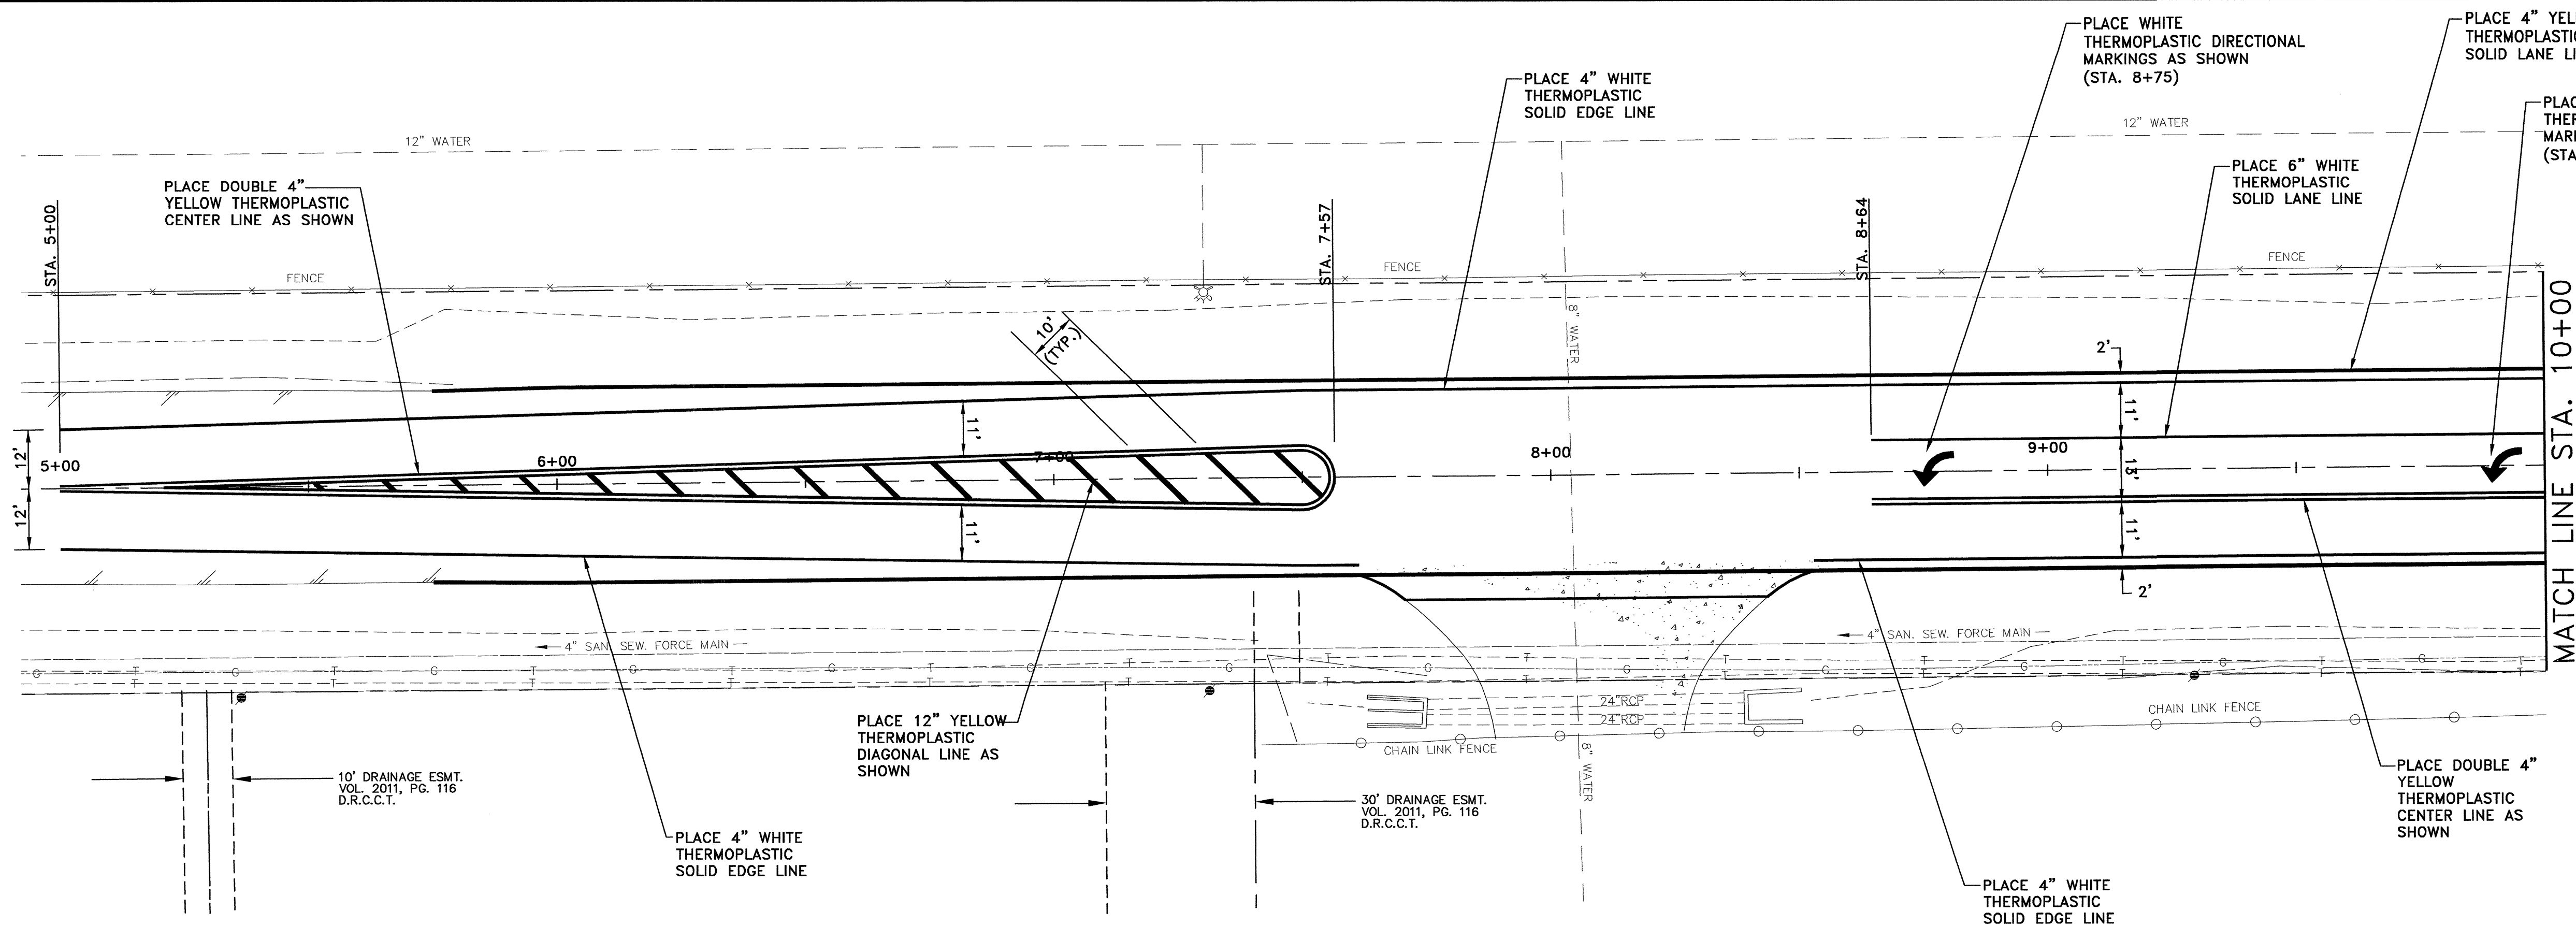


RECORD DRAWING
 BASED ON CONTRACTOR MARKUPS,
 NOT FIELD SURVEY.

6			
5			
4			
3			
2			
1	07-18-13	REVISED STRIPING	JFW
NO.	DATE	REVISION	REVIEWED

DRAWN: BW2
 DESIGN: JFW
 REVIEWED: MRB
 SCALE: 1" = 20'
 DATE: APRIL 2013
 DWG. NAME: 1572STRIP01







BW2 Engineers, Inc.
 1919 S. Shiloh Road
 Suite 500, L.B. 27
 Garland, Texas 75042
 (972) 864-8200 (T) (972) 864-8220 (F)
 Firm Registration No. F-5290

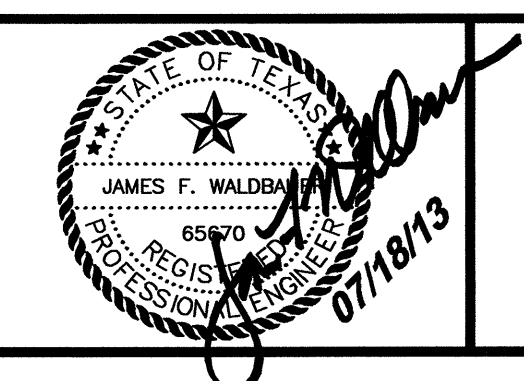

INTERSECTION IMPROVEMENTS
LUCAS ROAD/COUNTRY CLUB ROAD
 STRIPING PLAN - STA. 0+00 TO STA. 15+00
CITY OF LUCAS

SHEET NO. 10
 OF 32 SHEETS
 JOB NO. 12-1572

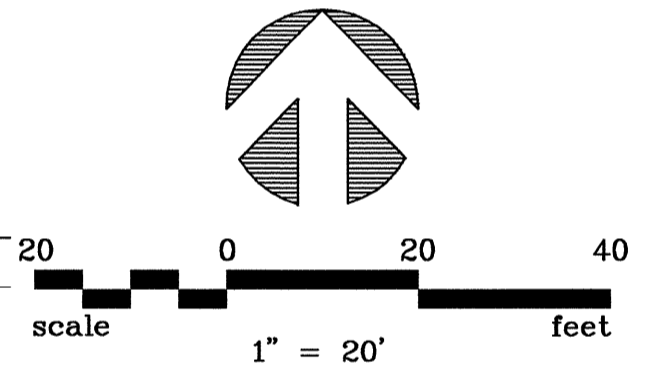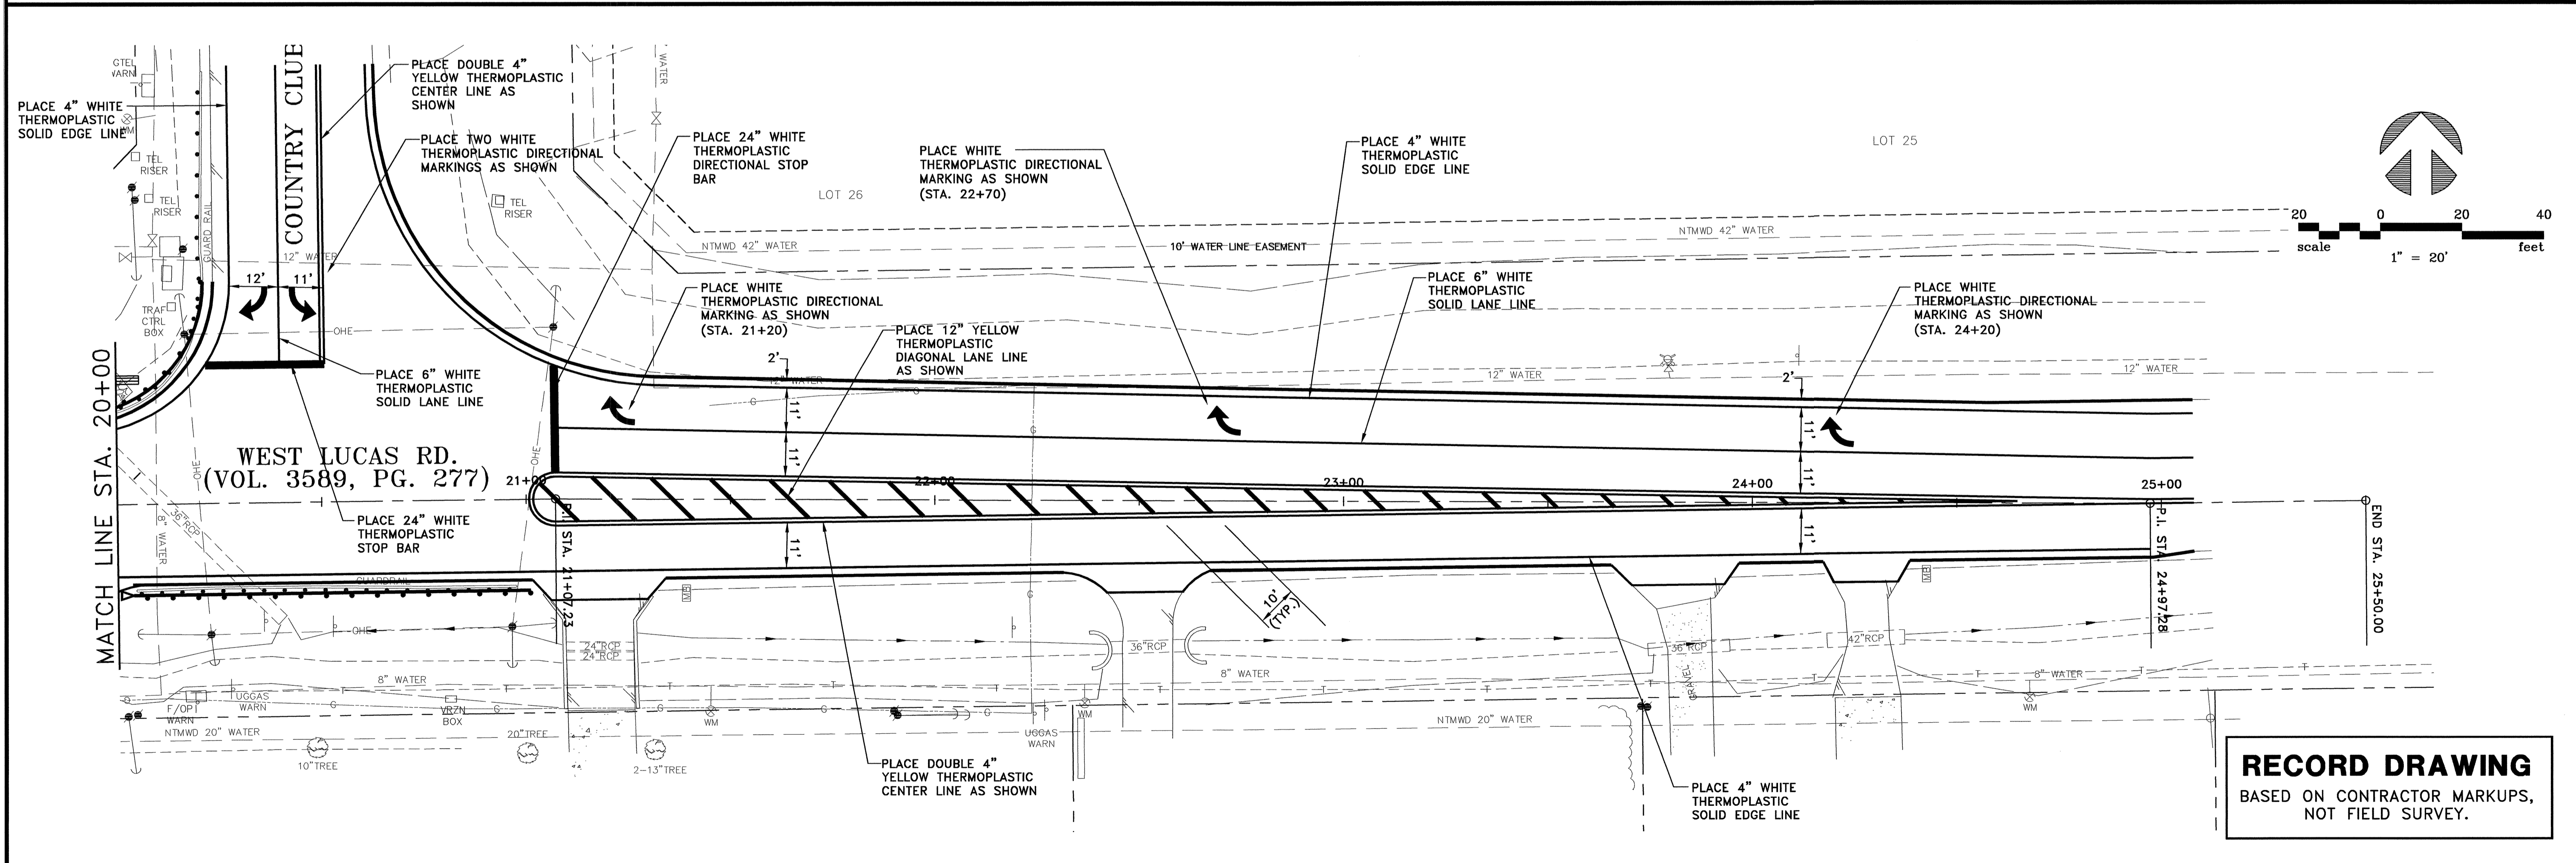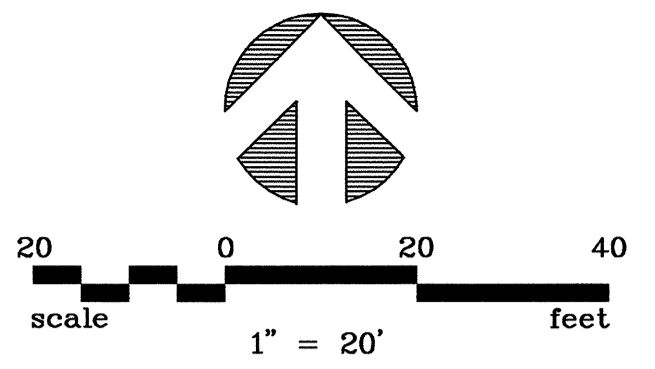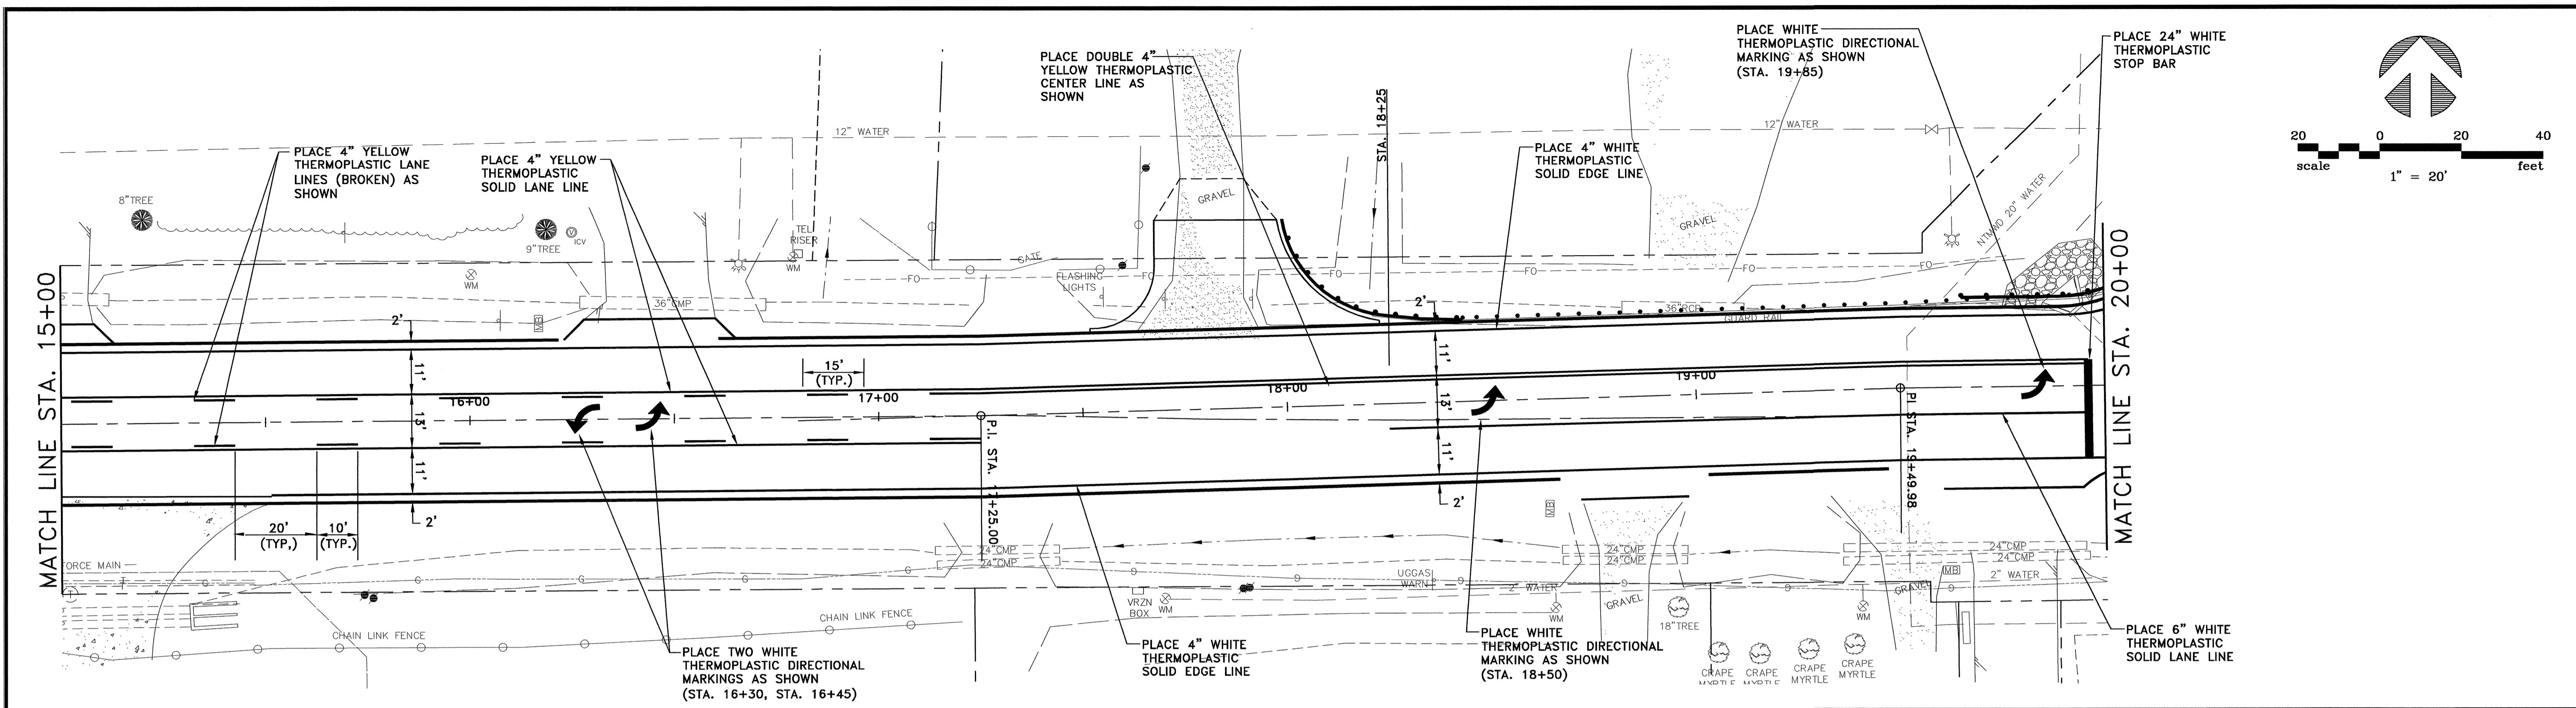


RECORD DRAWING
 BASED ON CONTRACTOR MARKUPS,
 NOT FIELD SURVEY.

6			
5			
4			
3			
2			
1	07-18-13	REVISED STRIPING	JFW
NO.	DATE	REVISION	REVIEWED

DRAWN: BW2
 DESIGN: JFW
 REVIEWED: MRB
 SCALE: 1" = 20'
 DATE: APRIL 2013
 DWG. NAME: 1572STRIP02




BW2 Engineers, Inc.
 1919 S. Shiloh Road
 Suite 500, L.B. 27
 Garland, Texas 75042
 (972) 864-8200 (T) (972) 864-8220 (F)
 Firm Registration No. F-5290

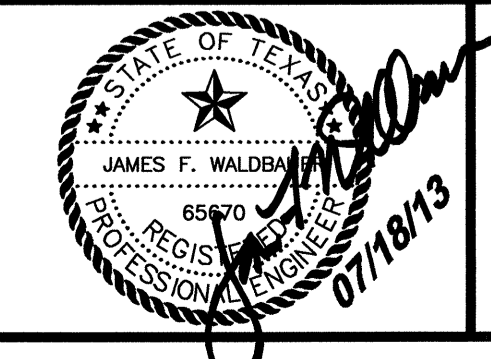

INTERSECTION IMPROVEMENTS
LUCAS ROAD/COUNTRY CLUB ROAD
 STRIPING PLAN - STA. 15+00 TO STA. 25+50
CITY OF LUCAS



SHEET NO. 11
 OF 32 SHEETS
 JOB NO. 12-1572

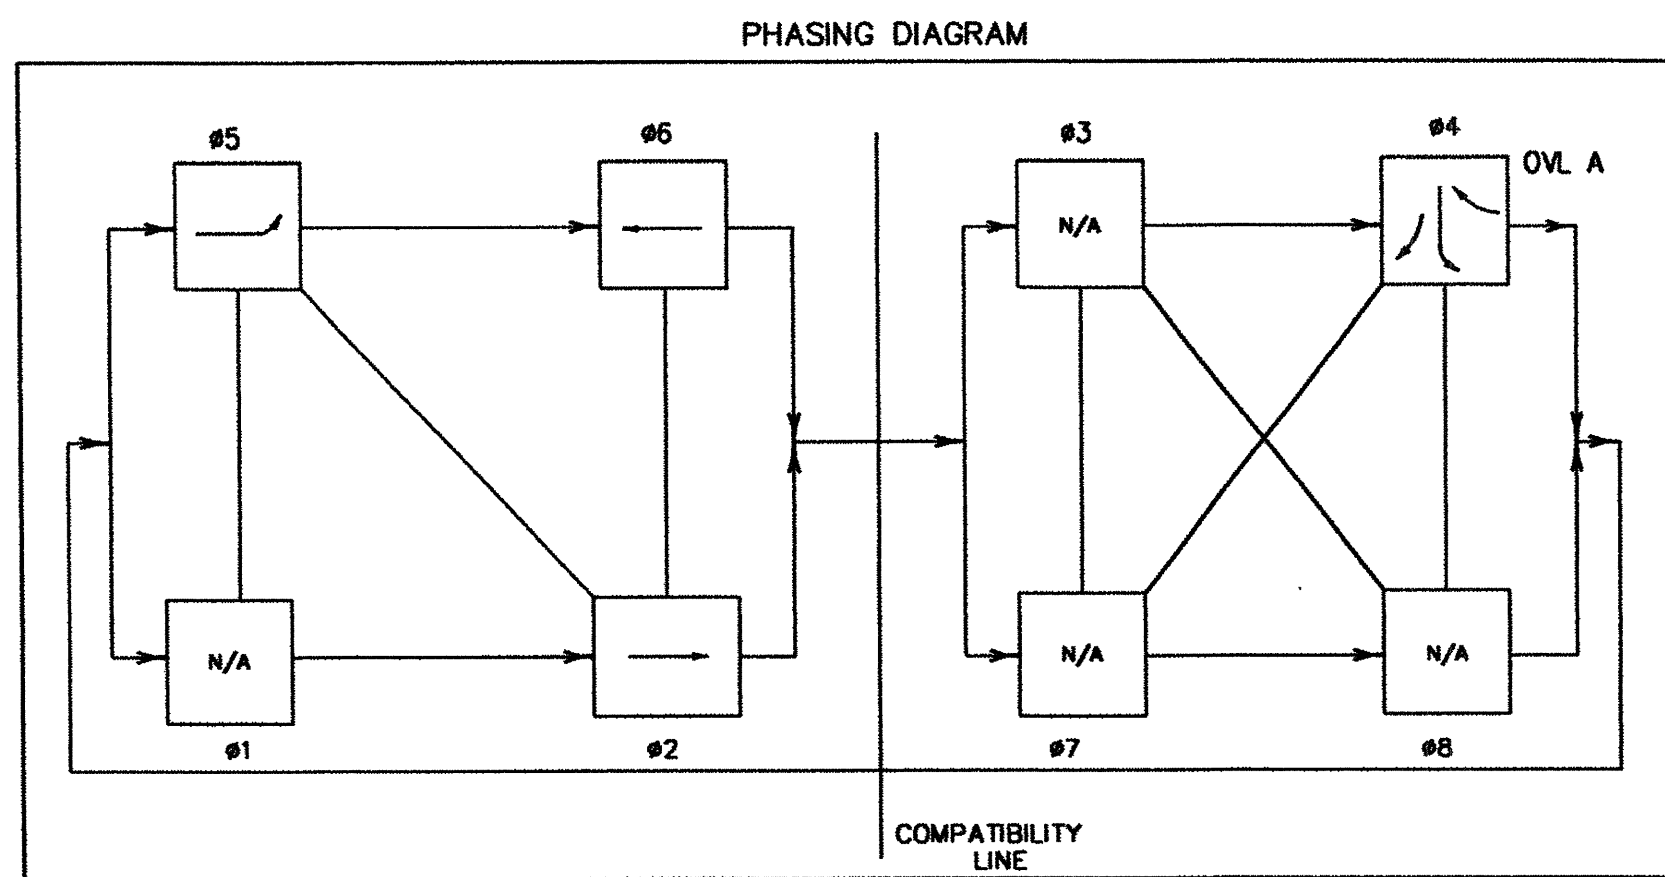

OVL A = MBRT #4

PAY ITEMS			
ITEM NO.	DESC. CODE	DESCRIPTION	QTY
618	2050	CONDT (RM) (1 1/2")	5 LF
680	2002	INST HWY TR SIG (ISO)	1 EA
682	2003	12" 5 SEC. BACKPLATE	1 EA
682	2022	12" LED GRN. ARROW	1 EA
682	2023	12" LED GRN. BALL	1 EA
682	2024	12" LED YEL. ARROW	1 EA
682	2025	12" LED YEL. BALL	1 EA
682	2027	12" LED RED BALL	1 EA
684	2033	TY A 14 AWG 7C CABLE	50 L.F.

- SIGNAL LEGEND**
- WOOD POLE (EXISTING)
 - TRAFFIC SIGNAL INDICATION USE IN PLACE
 - N TRAFFIC SIGNAL INDICATION NEW SIGNAL
 - R TRAFFIC SIGNAL INDICATION TO BE RELOCATED
 - R TRAFFIC SIGNAL INDICATION RELOCATED SIGNAL
 - ⬇ SPAN WIRE SUSPENDED SIGNAL
 - POLE MOUNTED NEW SIGNAL
 - SIGNAL GROUND BOX
 - TRAFFIC SIGNAL CONTROLLER (EXISTING)
 - 5 SIGNAL IDENTIFICATED NUMBER
 - R10-12 SIGN
 - Ø2 PHASE
 - STREET NAME SIGN

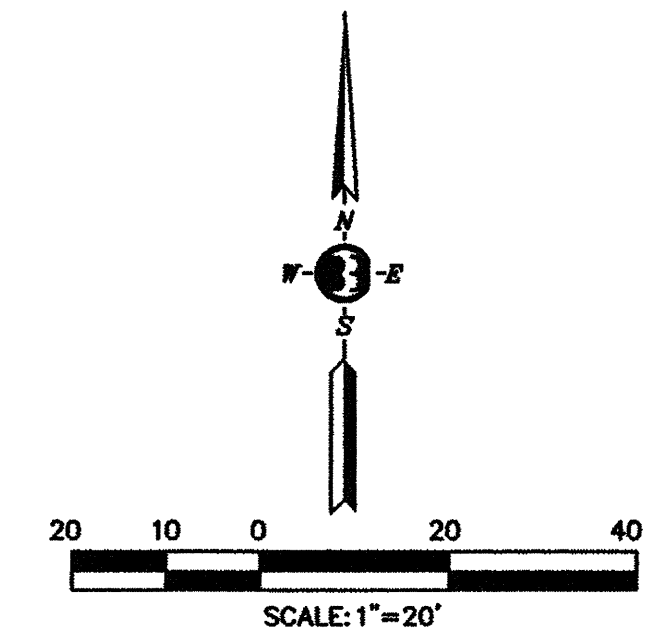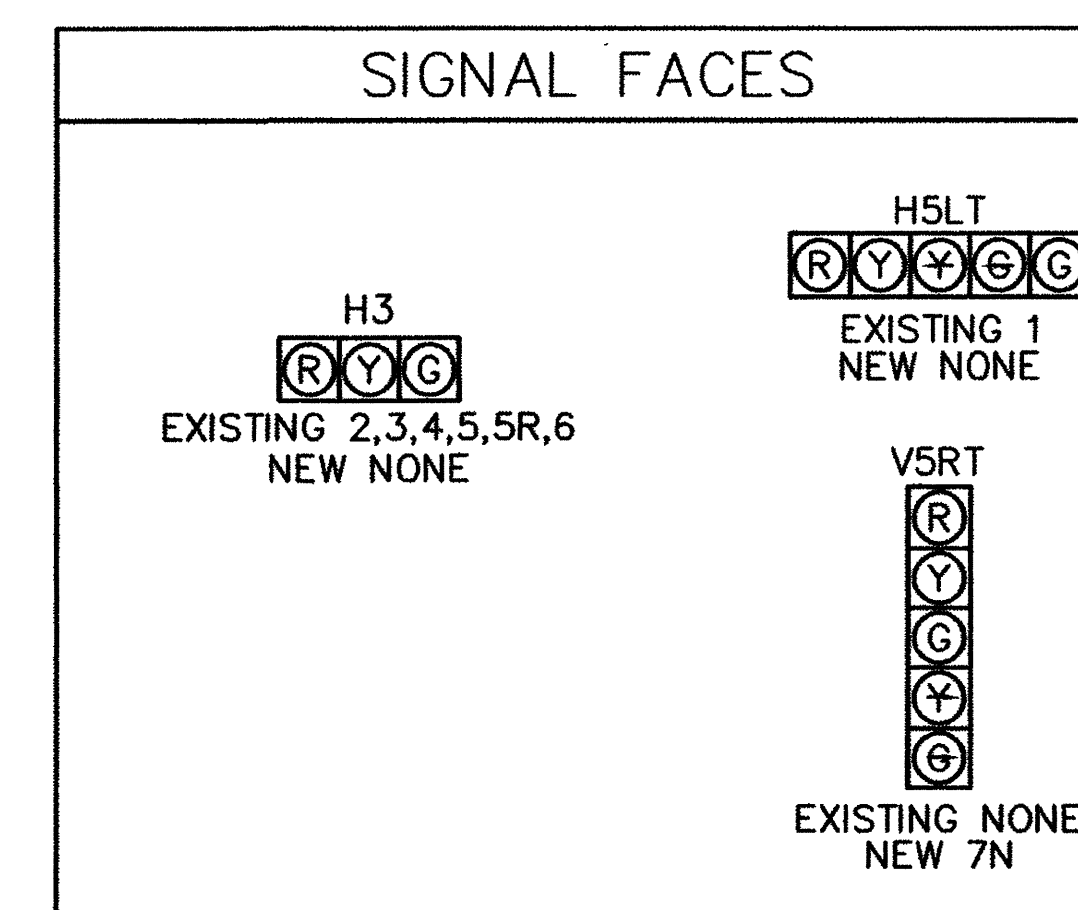

GENERAL NOTES:

ITEM 680

PROVIDE SUBMITTAL LITERATURE FOR ALL NEW TRAFFIC SIGNAL EQUIPMENT BEFORE INSTALLATION.

PROVIDE NEW LOAD SWITCH FOR OVERLAP "A" AND CONNECT ALL NEW FIELD WIRING TO THE CONTROLLER ASSEMBLY. THE DISTRICT SIGNAL SHOP WILL ASSIST IN DETERMINING HOW THE NEW SIGNAL CABLES ARE TO BE CONNECTED AND WILL ALSO PROGRAM THE CONTROLLER FOR OPERATION.

HAVE A QUALIFIED TECHNICIAN ON THE PROJECT SITE TO PLACE THE MODIFIED TRAFFIC SIGNAL INTO OPERATION.

USE QUALIFIED PERSONNEL TO RESPOND TO AND DIAGNOSE ALL TROUBLE CALLS DURING THE THIRTY-DAY TEST PERIOD. REPAIR ANY MALFUNCTION TO CONTRACTOR-SUPPLIED EQUIPMENT. PROVIDE THE ENGINEER WITH A LOCAL TELEPHONE NUMBER, NOT SUBJECT TO FREQUENT CHANGES AND AVAILABLE ON A 24-HOUR BASIS, FOR REPORTING TROUBLE CALLS. RESPONSE TIME TO REPORTED CALLS MUST BE LESS THAN 2 HOURS. MAKE APPROPRIATE REPAIRS WITHIN 24-HOURS. PLACE A LOGBOOK WITHIN THE CONTROLLER AND KEEP A RECORD OF EACH TROUBLE CALL REPORTED. NOTIFY THE ENGINEER OF EACH TROUBLE CALL. DO NOT CLEAR THE ERROR LOG IN THE CONFLICT MONITOR OR MMU DURING THE THIRTY-DAY TEST PERIOD WITHOUT APPROVAL.

SIGNAL HEADS 1 AND 2 ARE TO BE USED IN PLACE. THE STREET NAME SIGN LOCATED ADJACENT TO SIGNAL HEAD 2 PREVENTS THE RELOCATION OF EITHER SIGNAL HEAD TO THE SOUTH OF THEIR PRESENT LOCATIONS.

SIGNAL HEADS 3 AND 4 ARE TO BE USED IN PLACE.

SIGNAL HEAD 6 IS TO BE USED IN PLACE. SIGNAL HEAD 5 IS TO BE RELOCATED TO A POINT NOTED AS 5R WHICH IS 10' NORTH OF SIGNAL HEAD 6. THE EXCESS SIGNAL CABLE SHOULD BE COILED ON POLE T-3.

SIGNAL HEAD 7N IS A NEW 5-SECTION SIGNAL HEAD. NEW 7-CONDUCTOR CABLE SHALL BE RUN BETWEEN THE NEW SIGNAL HEAD AND THE CONTROLLER.

THE PHASING IN THE SIGNAL CONTROLLER SHALL BE MODIFIED TO ACCOMMODATE THE PHASING DEPICTED ON THIS SHEET.


THE STREET NAME SIGN FOR WESTBOUND TRAFFIC SHALL BE RELOCATED MIDWAY BETWEEN SIGNAL HEAD 5R AND SPAN WIRE POLE T-3 IN THE NORTHWEST CORNER.

ALL SIGNAL EQUIPMENT REMOVED FROM THIS INSTALLATION SHALL BE DELIVERED TO THE TXDOT DALLAS DISTRICT SIGNAL SHOP.

CONTACT THE TXDOT DALLAS DISTRICT SIGNAL SHOP AT 214-320-6682 AT LEAST 48 HOURS BEFORE DOING ANY WORK AT THIS LOCATION.

ITEM 682

PROVIDE ALUMINUM SIGNAL HEADS AND ALUMINUM TUBING IN THE FOLLOWING COLOR: FEDERAL YELLOW #13538 OF FEDERAL STANDARD 595. PROVIDE BACKPLATES AND THE INSIDE OF VISORS WITH A FLAT BLACK FINISH. PROVIDE VENTED BACKPLATES FOR ALL TRAFFIC SIGNAL HEADS. MOUNT SIGNAL HEADS LEVEL AND PLUMB AND AIMED AS DIRECTED.

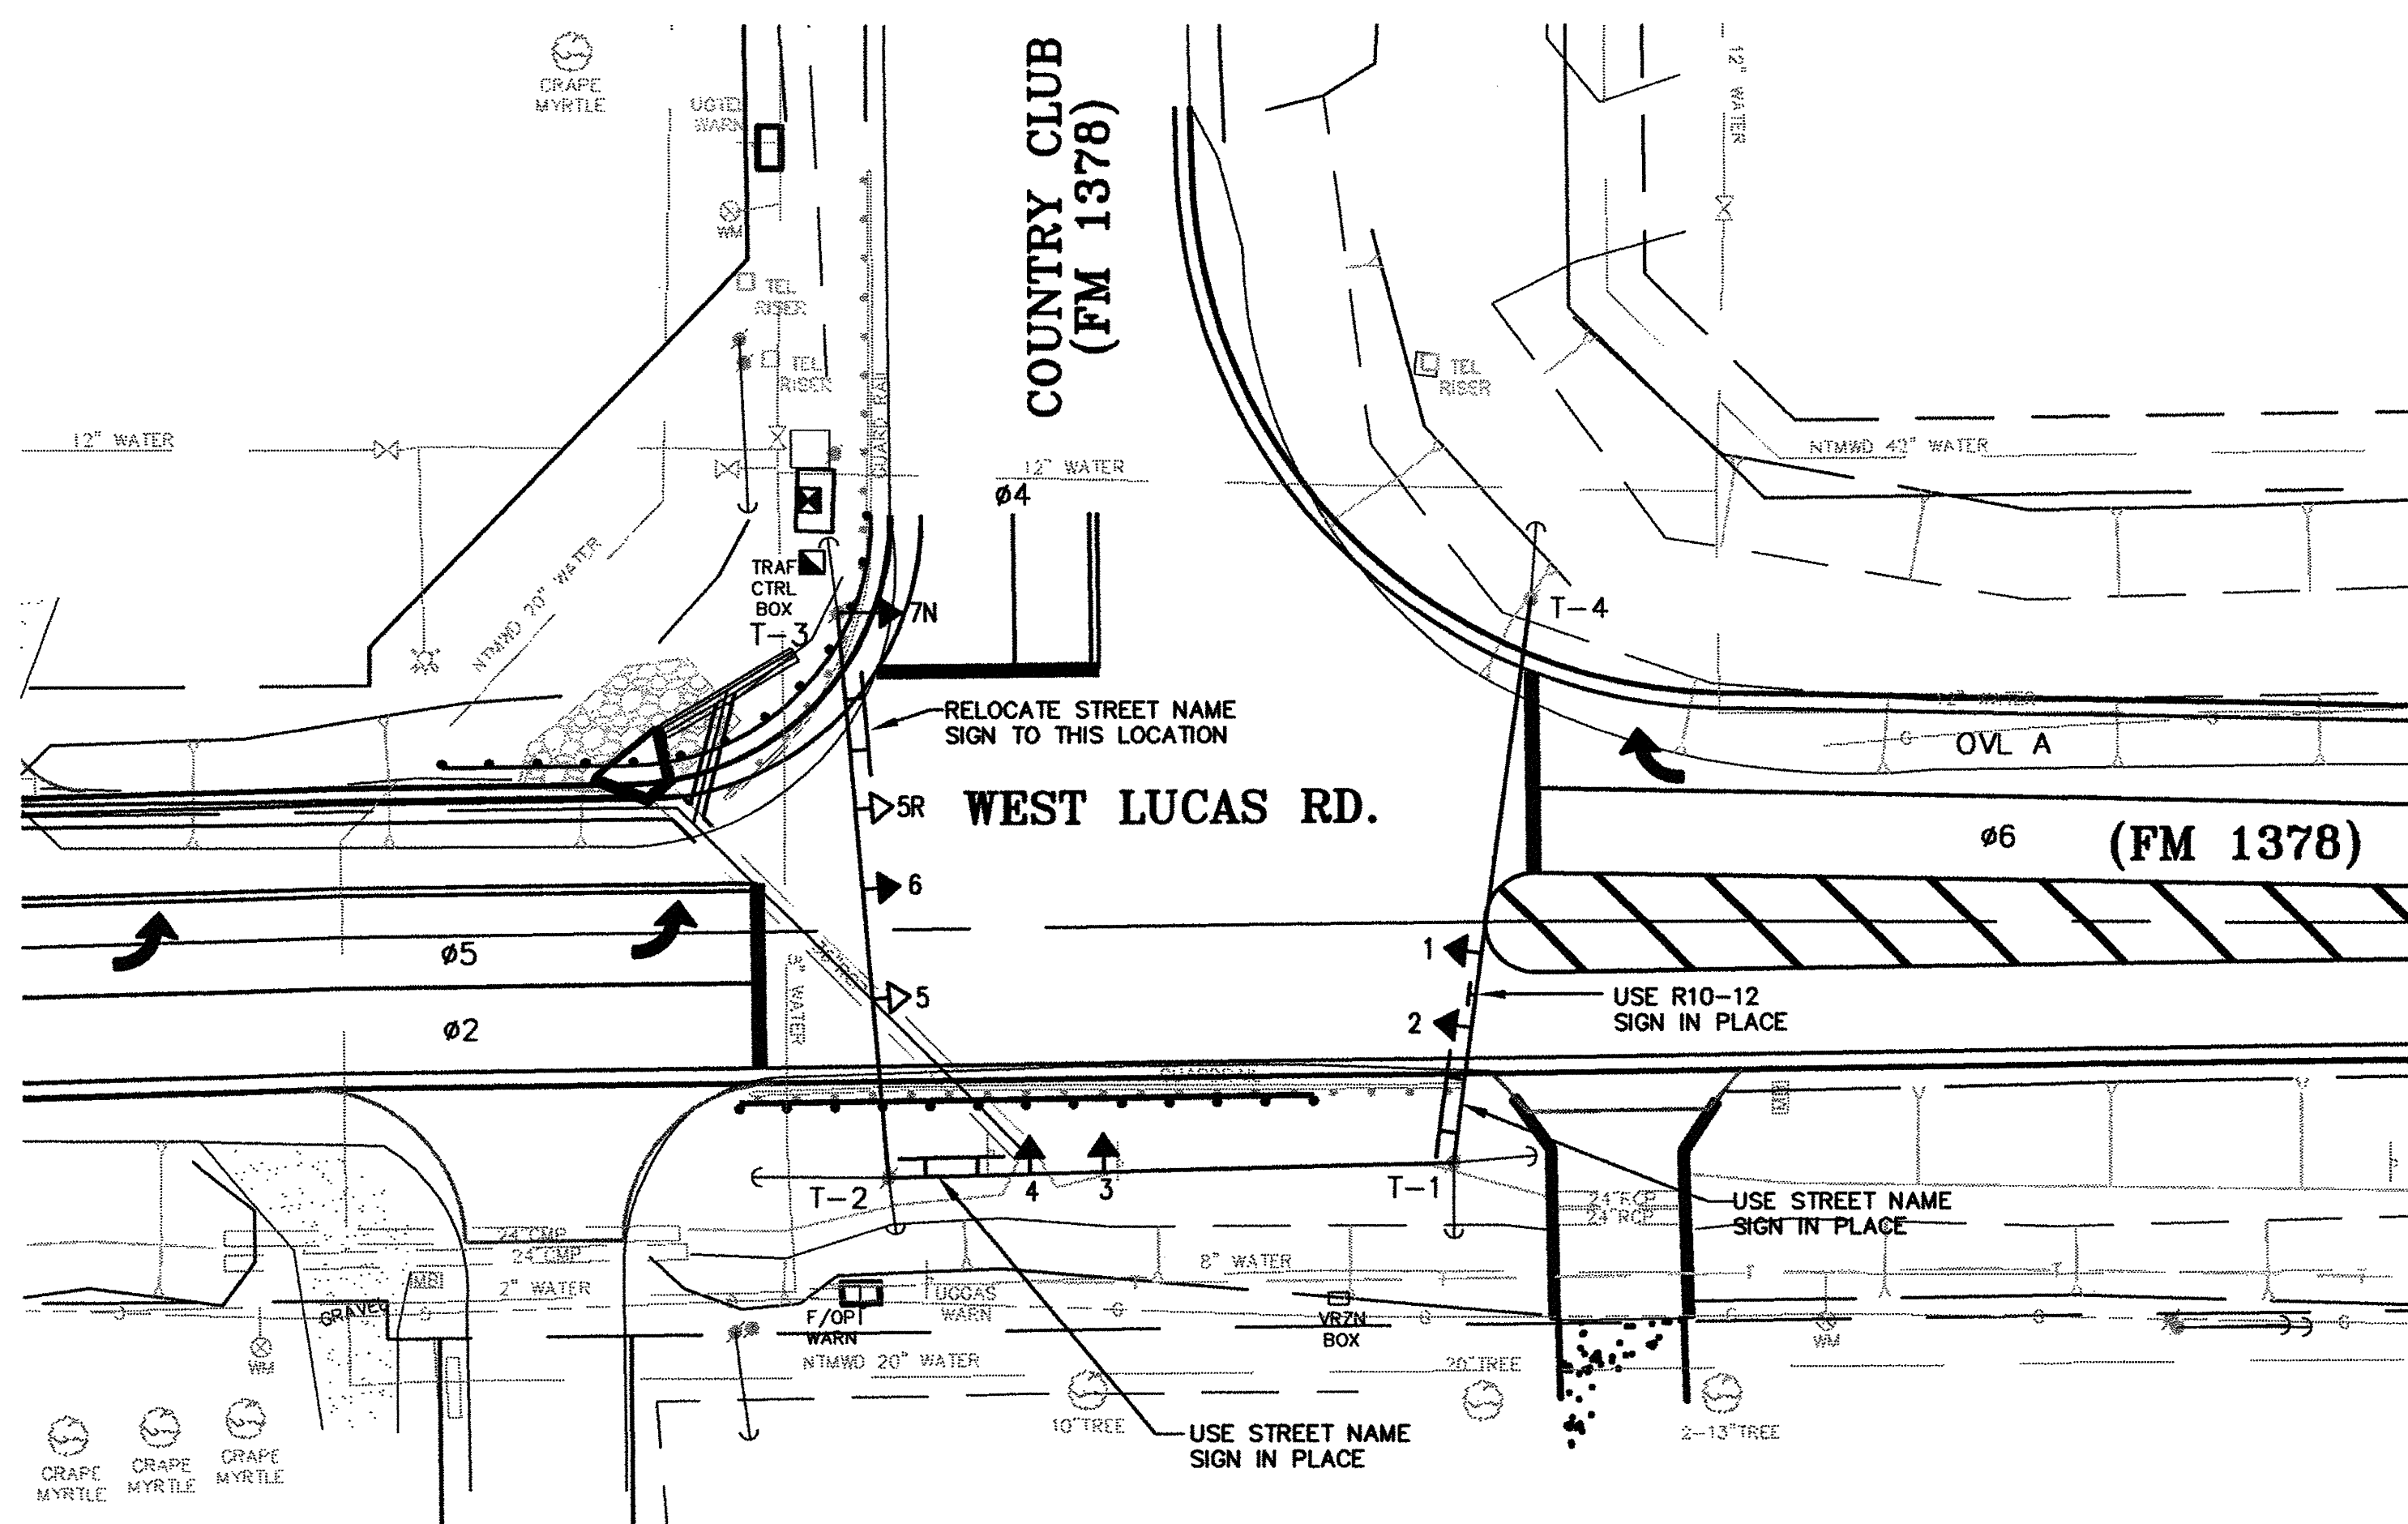

RECORD DRAWING
 BASED ON CONTRACTOR MARKUPS,
 NOT FIELD SURVEY.

The seal appearing on this document was authorized by Dannie R. Cummings, P.E. 60347. Alteration of a sealed document without proper notification to the responsible engineer is an offense under the Texas Engineering Practice Act.

Hlanis Corp 4-23-13

NO.	REVISIONS	DATE


TRAFFIC SIGNAL MODIFICATIONS
 COUNTRY CLUB RD & LUCAS (FM 1378) RD
 CITY OF LUCAS, TEXAS

Binkley & Barfield | C&P
 consulting engineers

1801 Gateway Blvd. Suite 101 Richardson, Texas 75080
 972.644.2800 Fax 972.644.2817 www.bbcp.com


Firm Registration #F-3185

DRAWN BY: BBCPI	DATE: 4/13	SCALE: 1"=20'	JOB NUMBER: BC13003	SHEET: 3
-----------------	------------	---------------	---------------------	----------

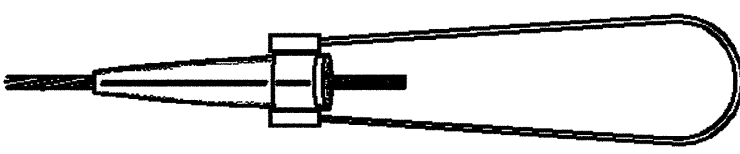

COMPRESSION FITTING

SOURCES:
RELIABLE ELECTRIC NO.5264
FARGO NO. OR EQUAL

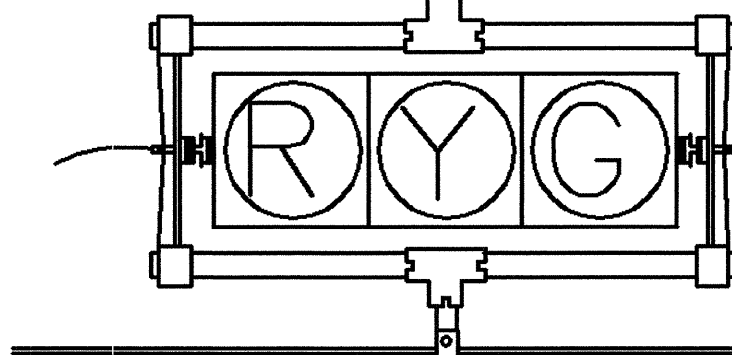


MULTI CONDUCTOR SIGNAL CABLE

RAIN LOOP REQUIRED.
AT EACH CABLE
ENTRY POINT


1/4" STRANDED STEEL CABLE

1/2" BLACK PLASTIC CABLE STRAPS OR
MESSENGER RINGS AT 12" CTRS.

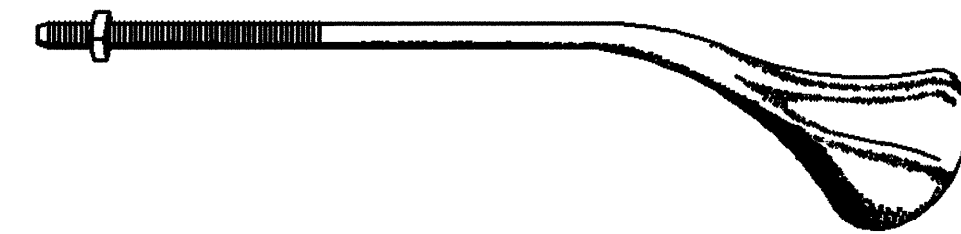


THIMBLEYE BOLT (Angle Type)

SOURCES:
HUBBELL POWER SYS. NO. 5016
MCLEAN POWER SYS. NO. J8154
OR EQUAL

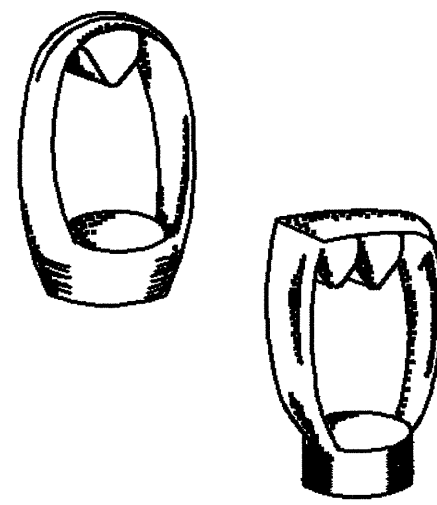

EYE NUTS (Twineye & tripeye)


SOURCES:
HUBBELL POWER SYS. NO. 6560 (TWIN), 6510 (SINGLE)
MCLEAN POWER SYS. NO. J6515 (TWIN), J6510 (SINGLE)
OR EQUAL

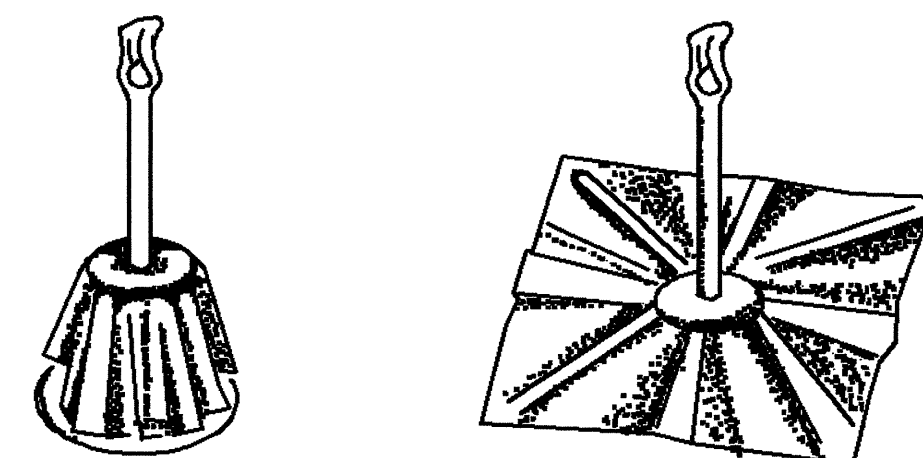

8-WAY ANCHOR

SOURCES:
HUBBELL POWER SYS. NO. 1283
MCLEAN POWER SYS. NO. J0283
OR EQUAL

LIFT PLATE

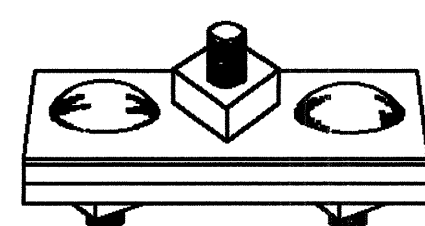


GUY CLAMP (3-Bolt)

6" HEAVY GUY CLAMP WITH 3-5/8"
BOLTS OR RELIABLE ELECTRIC
STRANDVISE WITH FLEXIBLE BAIL
(NO. 5264), FARGO STRANDVISE,
HUBBELL POWER SYS. NO. 6460,
OR EQUAL


PENTACHLOROPHENOL TREATED
40' SOUTHERN YELLOW PINE POLE
(CLASS 2)

HOLE DIA = POLE DIA
AT BOTTOM + 18"

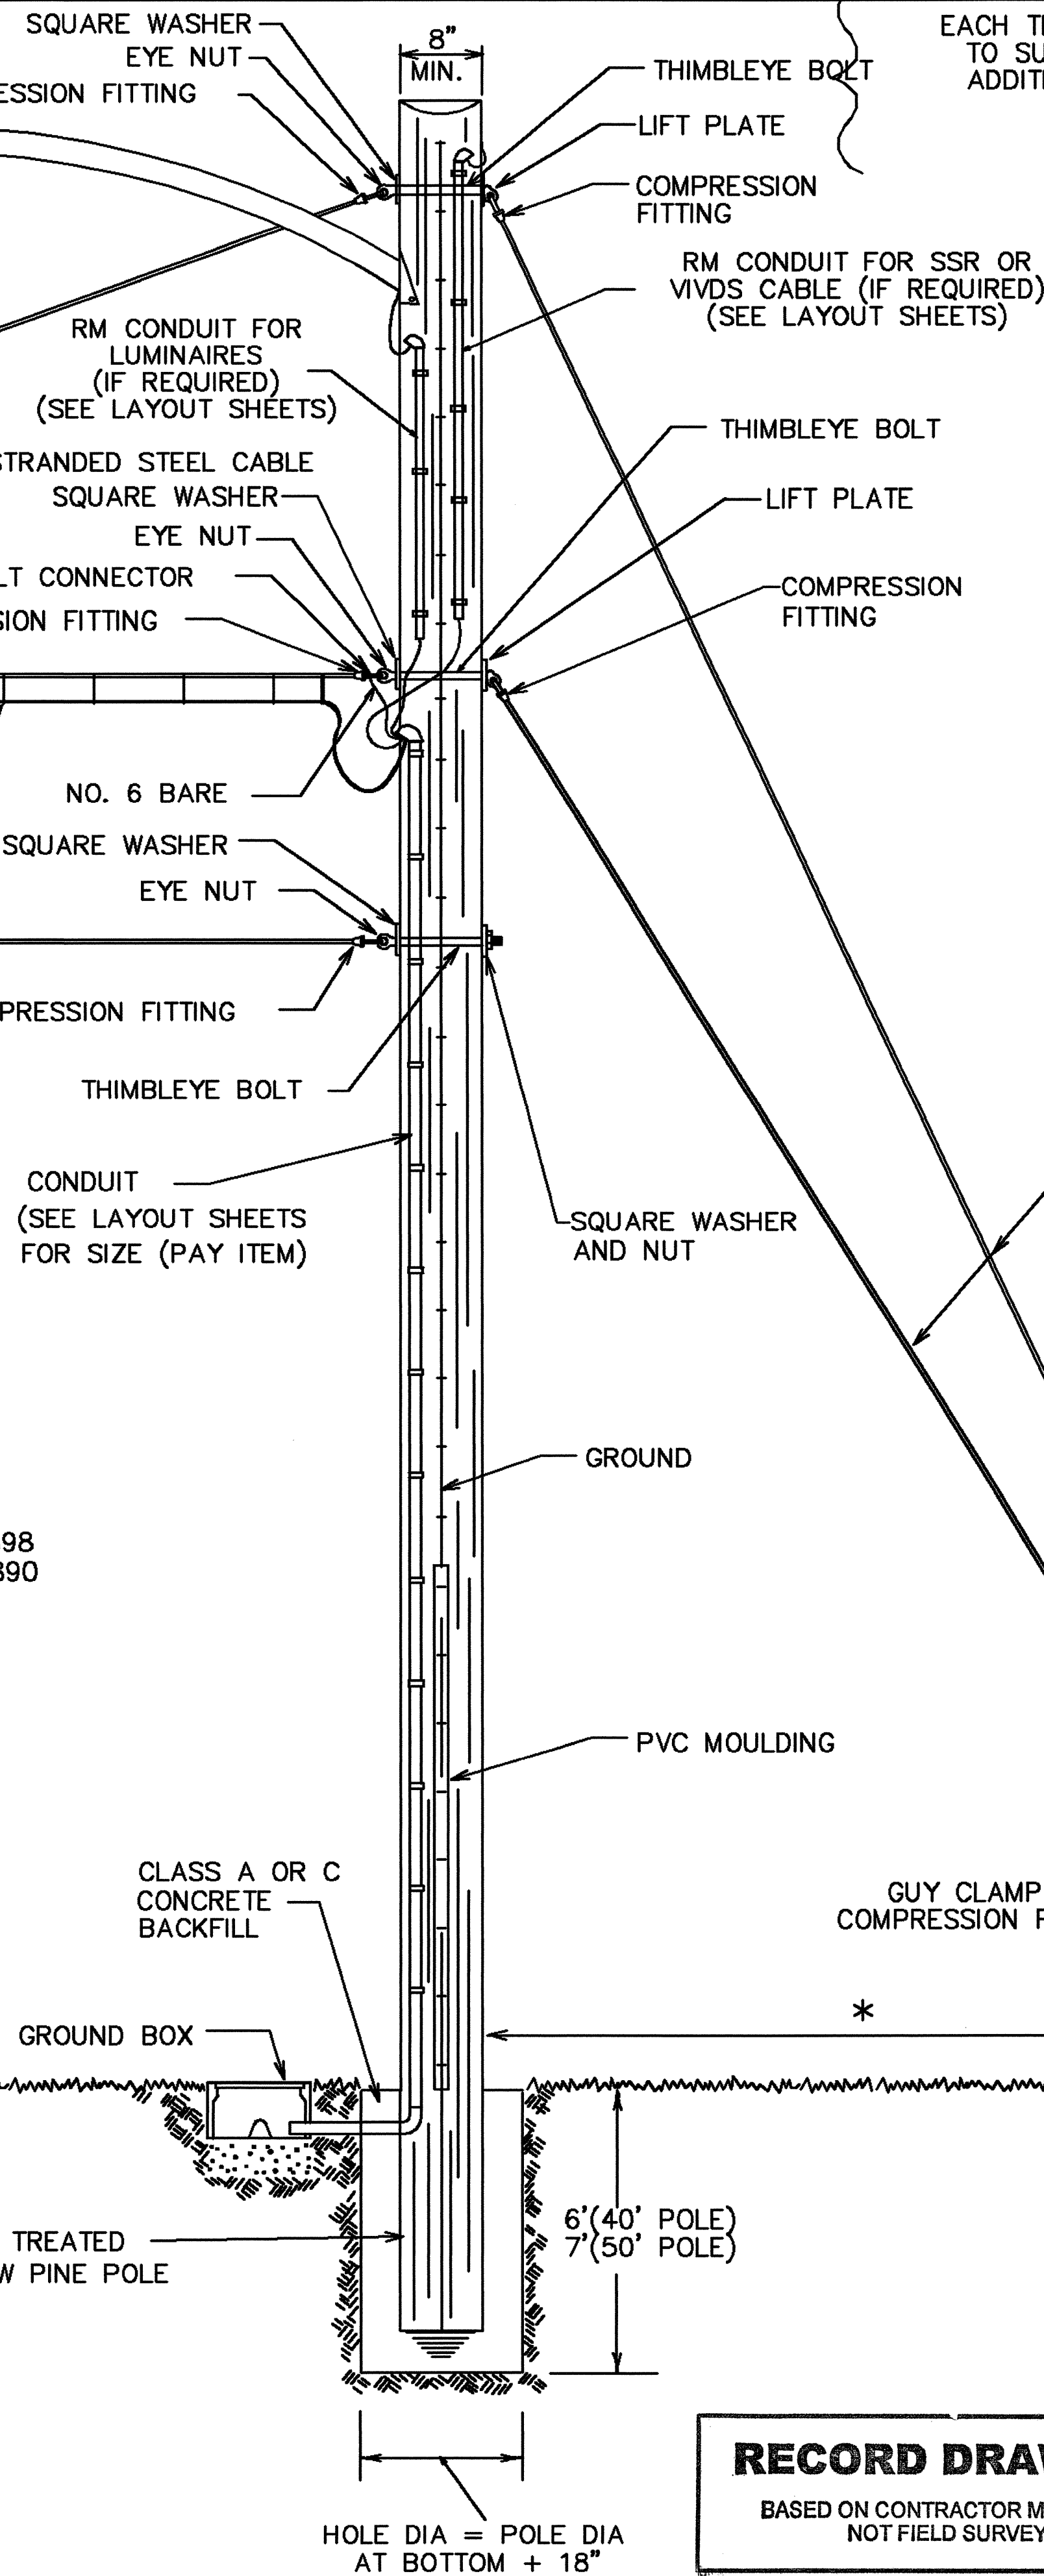

RECORD DRAWING
BASED ON CONTRACTOR MARKUPS,
NOT FIELD SURVEY.

CONSTRUCTION DETAILS FOR SPAN
WIRE MOUNTED TRAFFIC SIGNALS


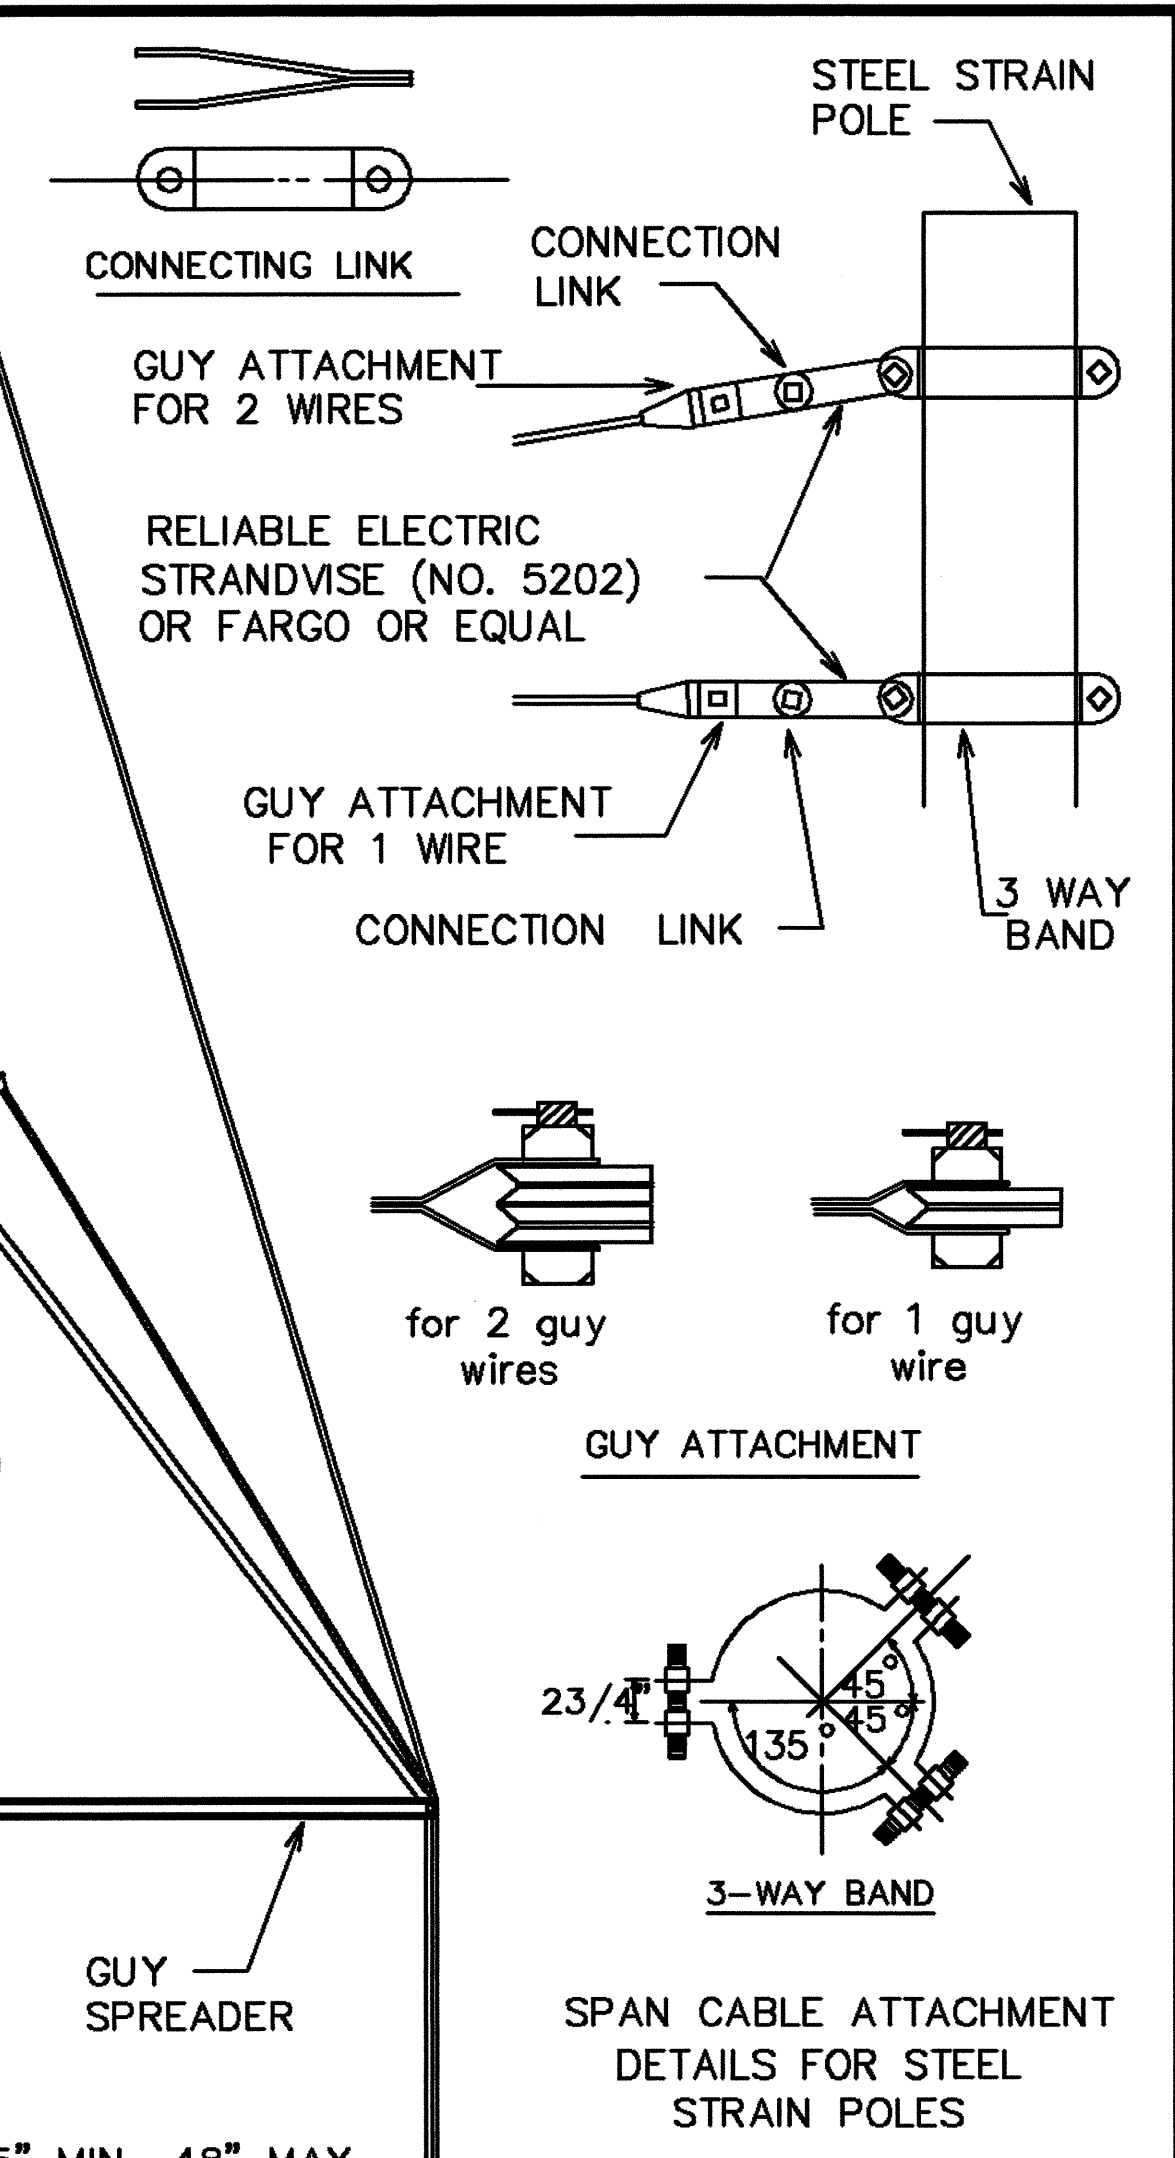


SHEET 1 OF 3
DALLAS DISTRICT STANDARD


FED. PROJ. DIVISION	FEDERAL AID PROJECT NO.	SHEET NO.
6		
STATE	STATE DIST. NO.	COUNTY
TEXAS	DAL	
CONT.	SECT.	JOB
		HIGHWAY NO.

BOTTOM TETHERED, SPAN WIRE
SIGNAL HEAD HARDWARE
ASSEMBLY (BACKPLATE NOT SHOWN)


ITEM	DESCRIPTION	QTY
1	SPAN WIRE CLAMP, IRON, W/ U-BOLTS	1
2	SPAN WIRE ADAPTER, ALUM W/ STAINLESS BUSHING	1
3	TEE HORIZONTAL SLIP, DIE CAST ALUM	2
4	SCREW, SET SQ HD, 1/4"-20 X 1/2", STAINLESS	6
5	TUBE, 1 1/2" X LENGTH, ALUM	2
6	TUBE CAP, 1 1/2", PLASTIC	4
7	SCREW, SET SQ HD, 5/16"-18 X 5/8", STAINLESS	8
8	CGB, 3/4" .55-.65, ZINC 1	1
9	CAST ARM, FOR HORIZONTAL MOUNTED SIGNAL, ALUM	2
10	GASKET, TRI-BOLT, 1/16" X 70 DURO NEOPRENE	2
11	WASHER, SLOTTED, ZINC 2	2
12	WASHER, LOCK SPLIT, 1/4", STAINLESS	6
13	BOLT, HEX HD, 1/4"-20 X 1 1/2", GRADE 5, STAINLESS	6
14	NIPPLE, ALLTHREAD, 1 1/2" NPS X 2.13", ALUM	1
15	SCREW, SET SQ HD, 1/4"-20 X 5/8", STAINLESS	1
16	BODY, 1 1/2", HANGER, ALUM	1
17	BOLT, HEX HD, 5/16"-18 X 1 1/2", STAINLESS	1
18	PLATE, TETHER, 1-HOLE, ALUM	1
19	WASHER, FENDER, 5/16", STAINLESS	1
20	WASHER, SPLIT LOCK, 5/16", STAINLESS	1
21	NUT, HEX HD, 5/16"-18, STAINLESS	1
22	CAP, EN-3/4, BLUE (FOR CGB)	1

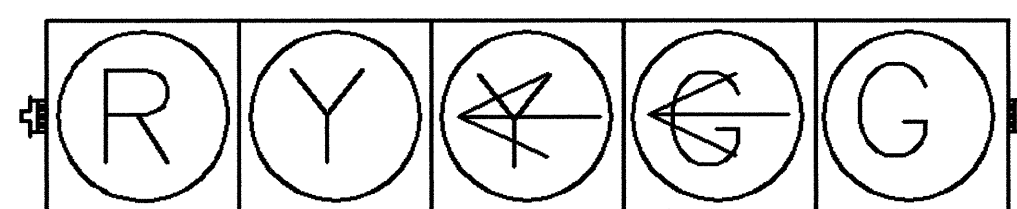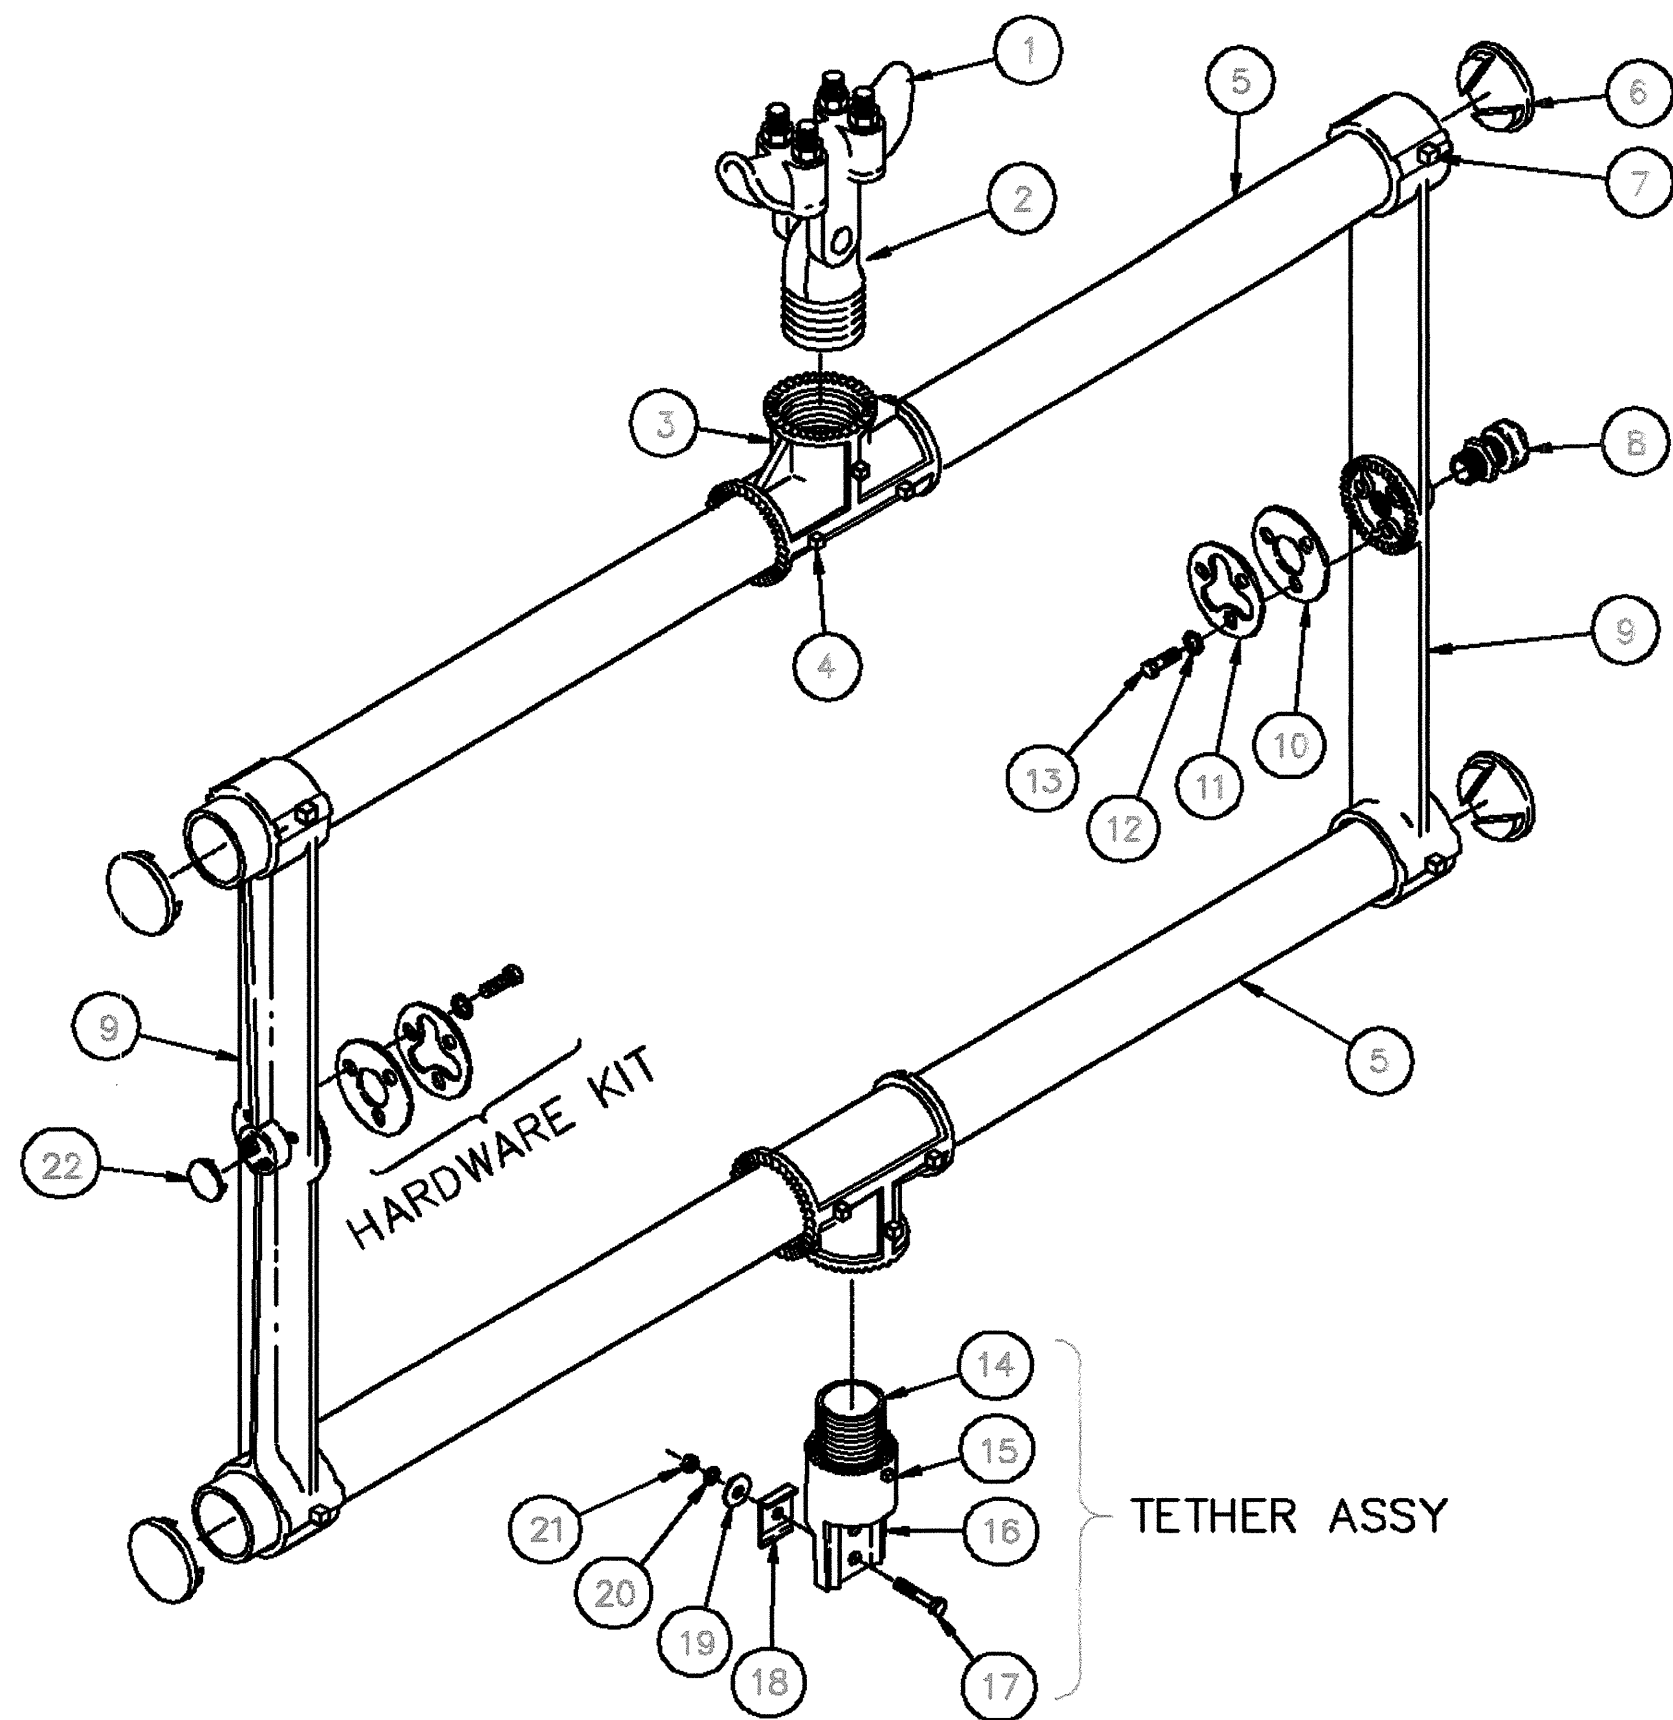


H5LT
TYPICAL SPAN WIRE
HORIZONTAL MOUNT
INSTALLATION

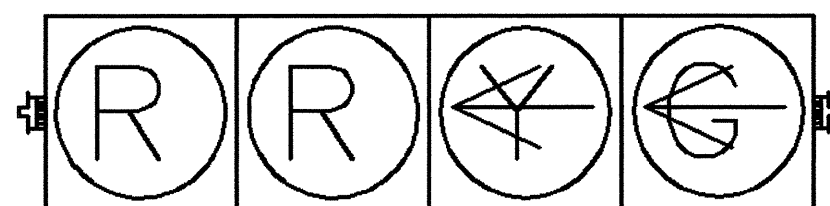


H4LT
TYPICAL SPAN WIRE
HORIZONTAL MOUNT
INSTALLATION

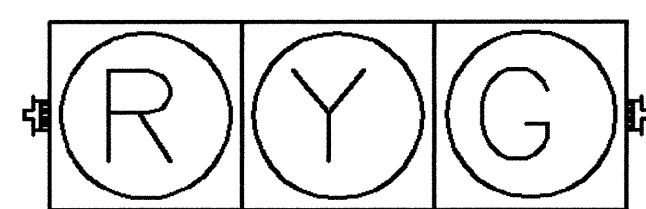


H3
TYPICAL SPAN WIRE
HORIZONTAL MOUNT
INSTALLATION

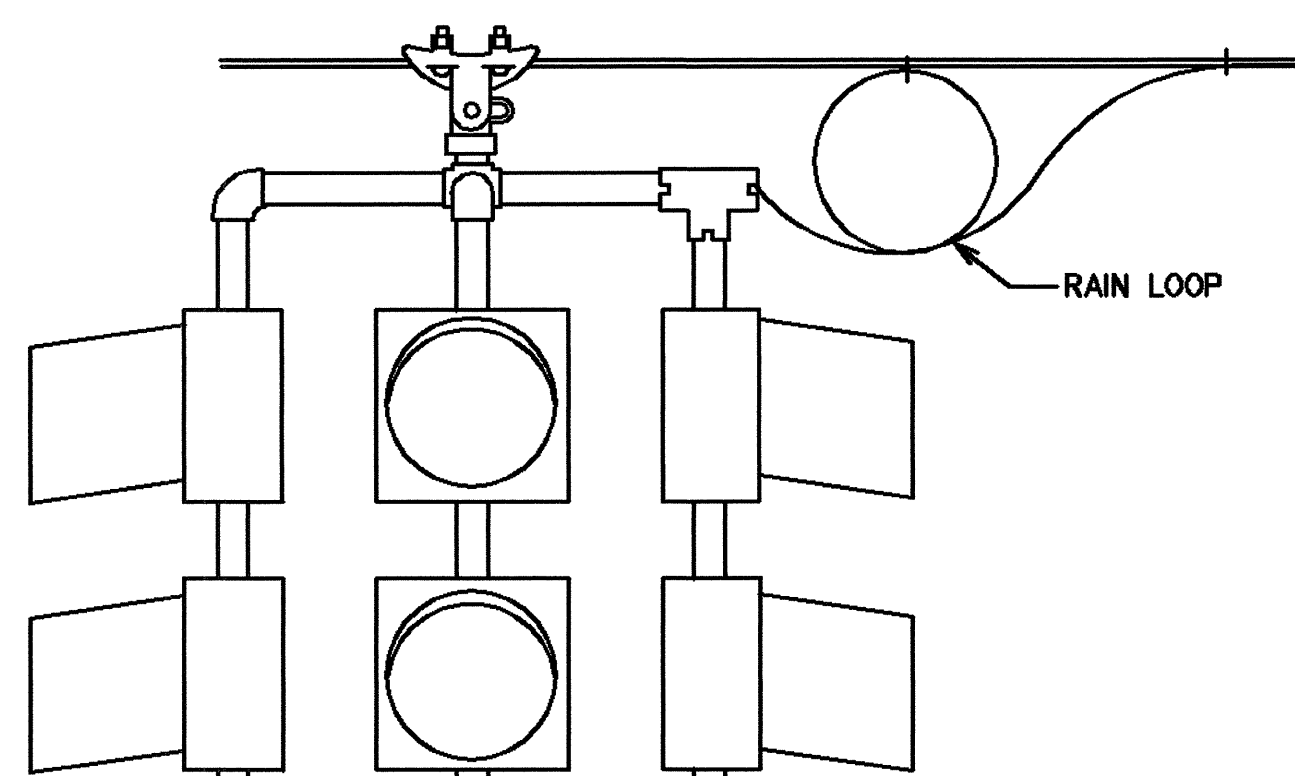


TYPICAL
FLASHING BEACON
INSTALLATION

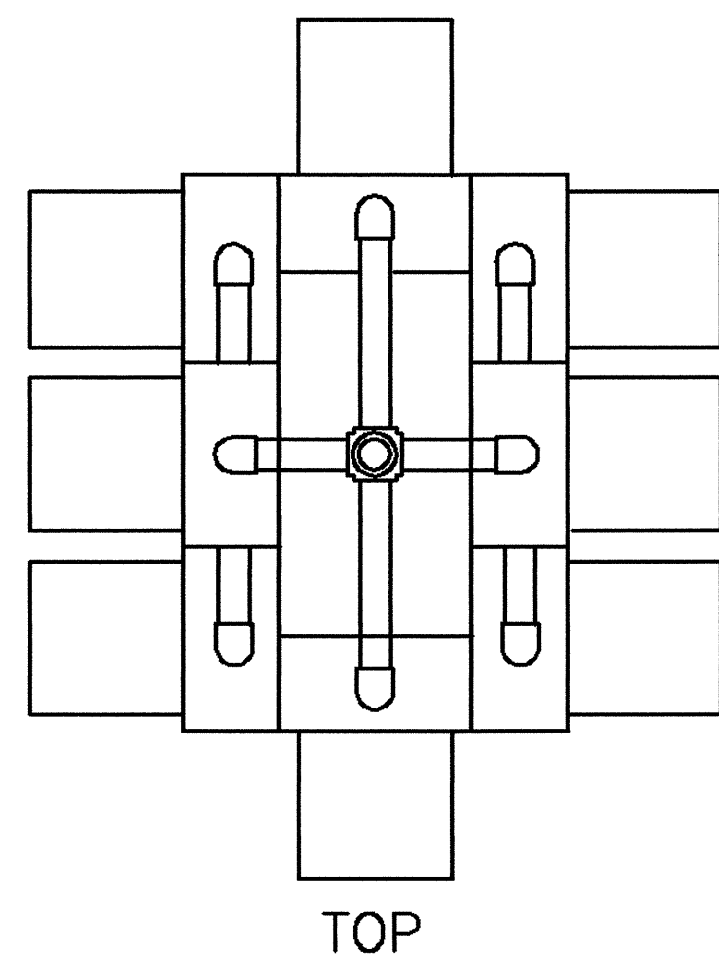


TOP

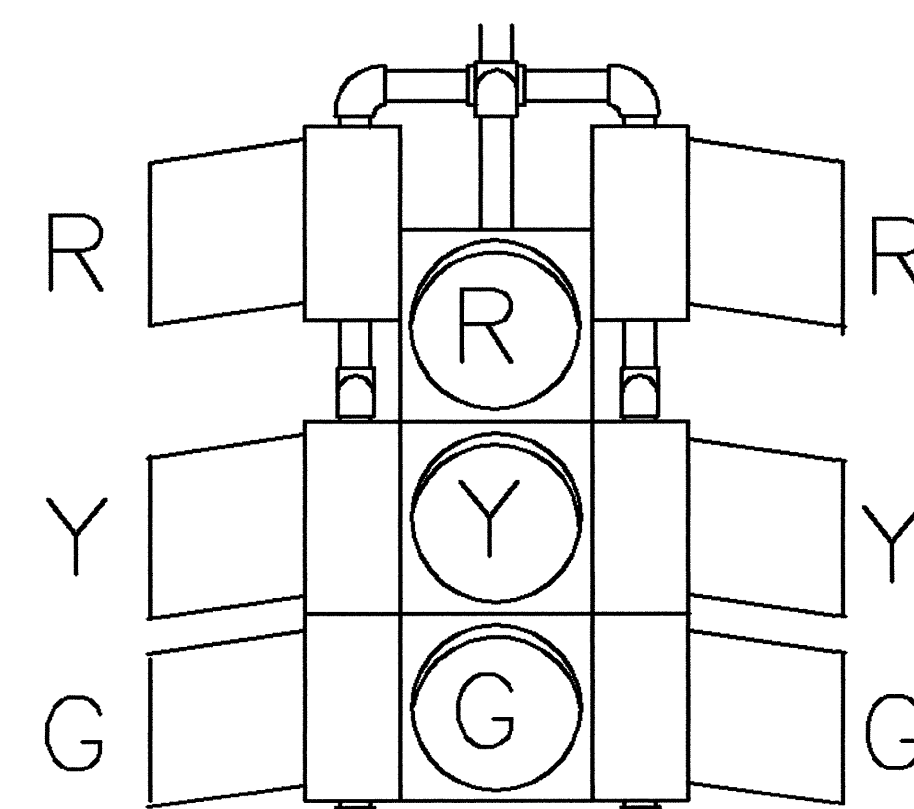


SIDES

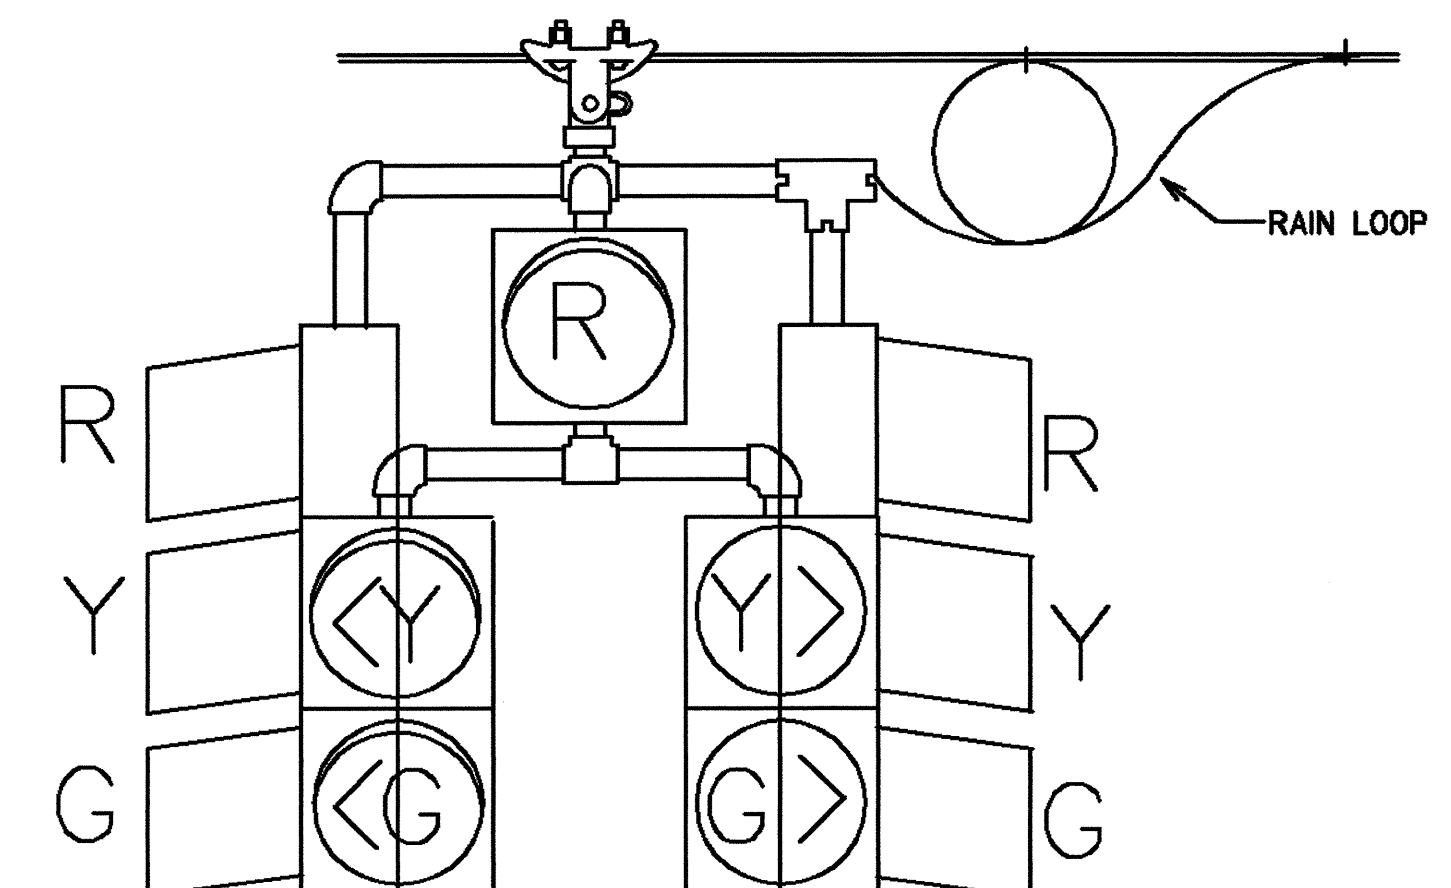

FRONT AND BACK

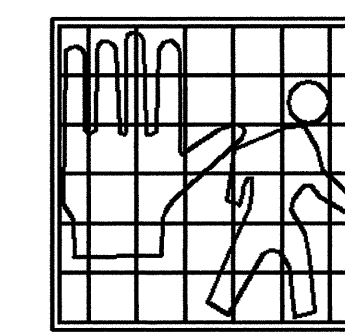

"EGGCRATE" VISOR PEDESTRIAN SIGNAL
WITH ONE-PIECE REFLECTOR

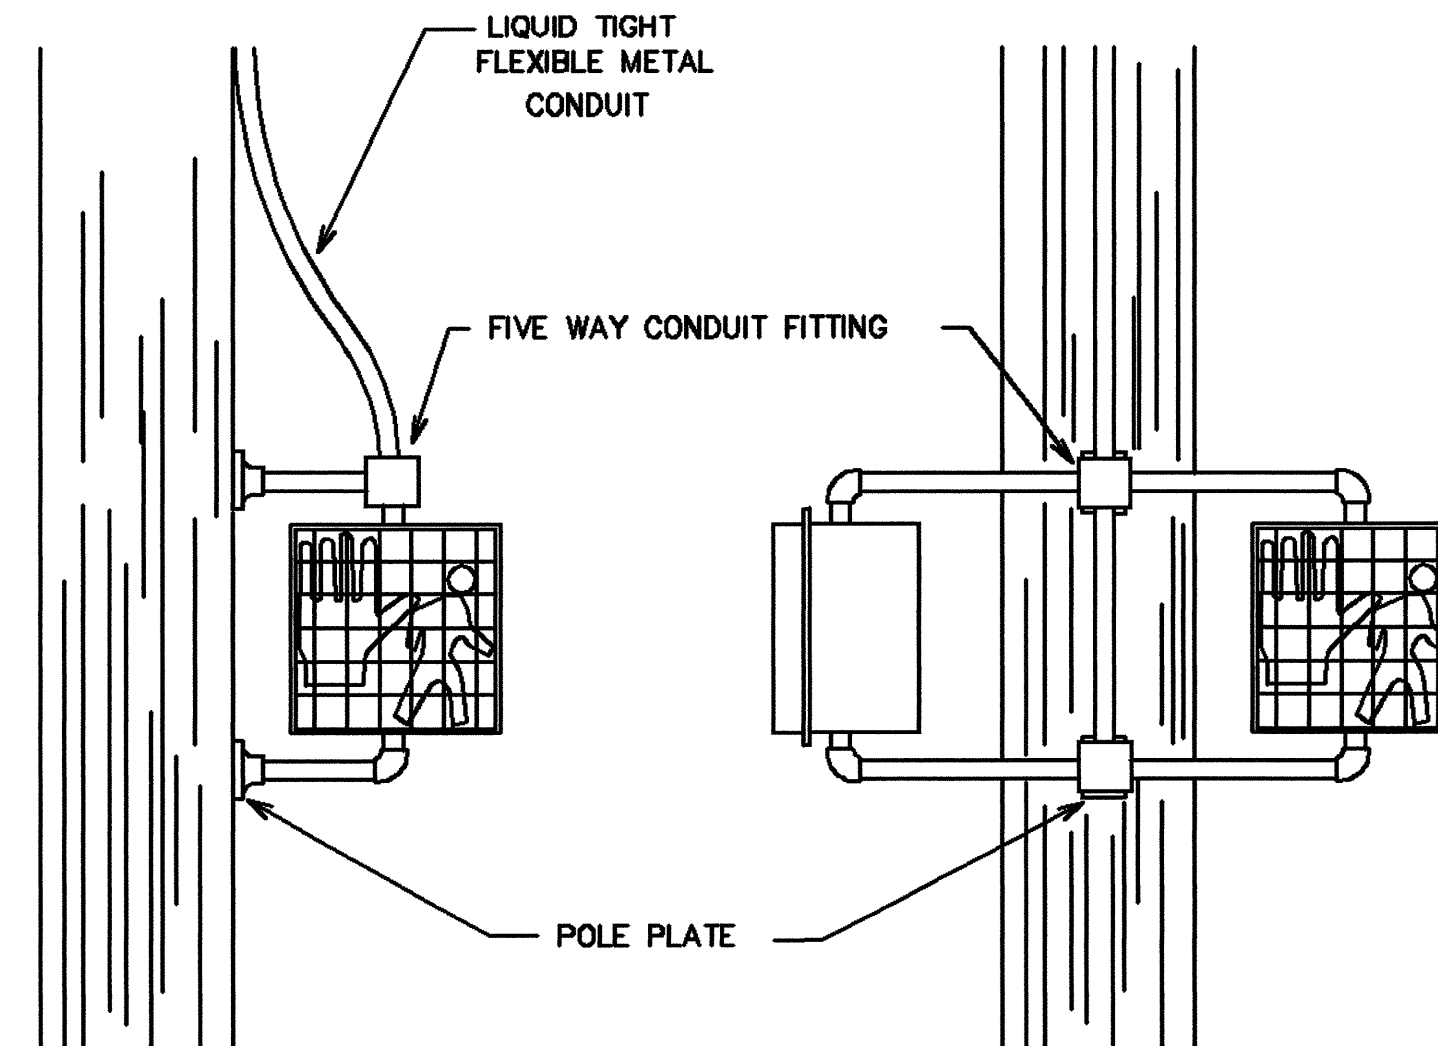


152A
ONE-WAY
ADJUSTABLE FACE SIGNAL FOR
WOOD POLE MOUNTING



143C
PLAN VIEW

SIGN R10-4bR
SIGN R10-4bL
9"X12"

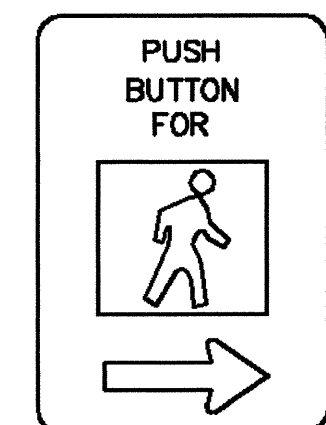





PEDESTRIAN PUSHBUTTON
SIGN DETAILS

RECORD DRAWING
BASED ON CONTRACTOR MARKUPS,
NOT FIELD SURVEY.

CONSTRUCTION DETAILS FOR SPAN
WIRE MOUNTED TRAFFIC SIGNALS



SHEET 2 OF 3
DALLAS DISTRICT STANDARD

FED. AID DIST. NO.	FEDERAL AID PROJECT NO.	SHEET NO.
6		
STATE	STATE DIST. NO.	COUNTY
TEXAS	DAL	
CONT.	SECT.	JOB HIGHWAY NO.

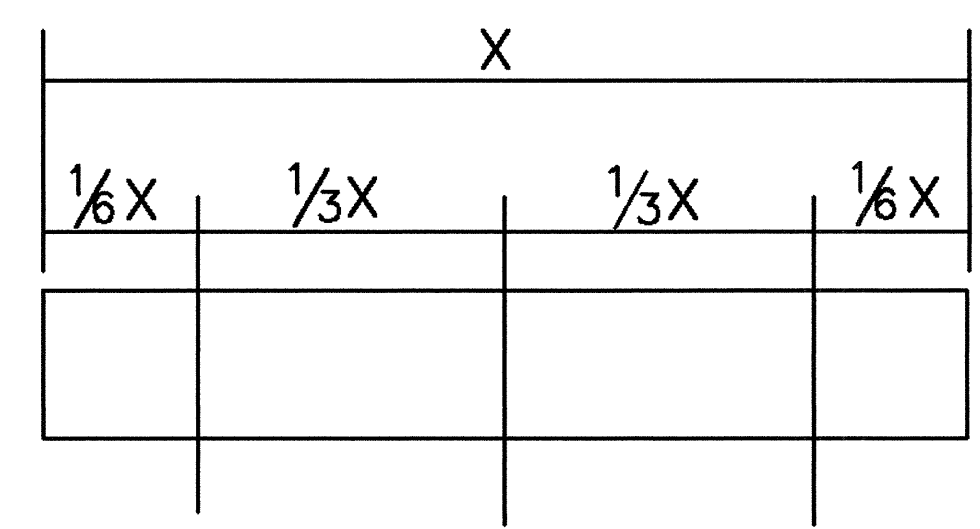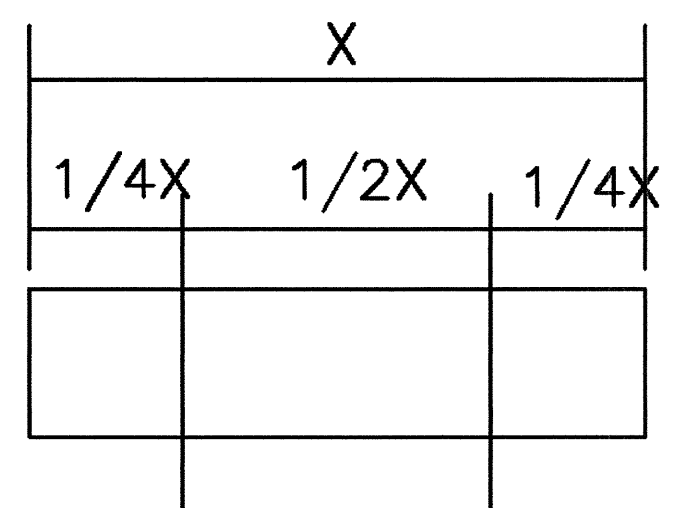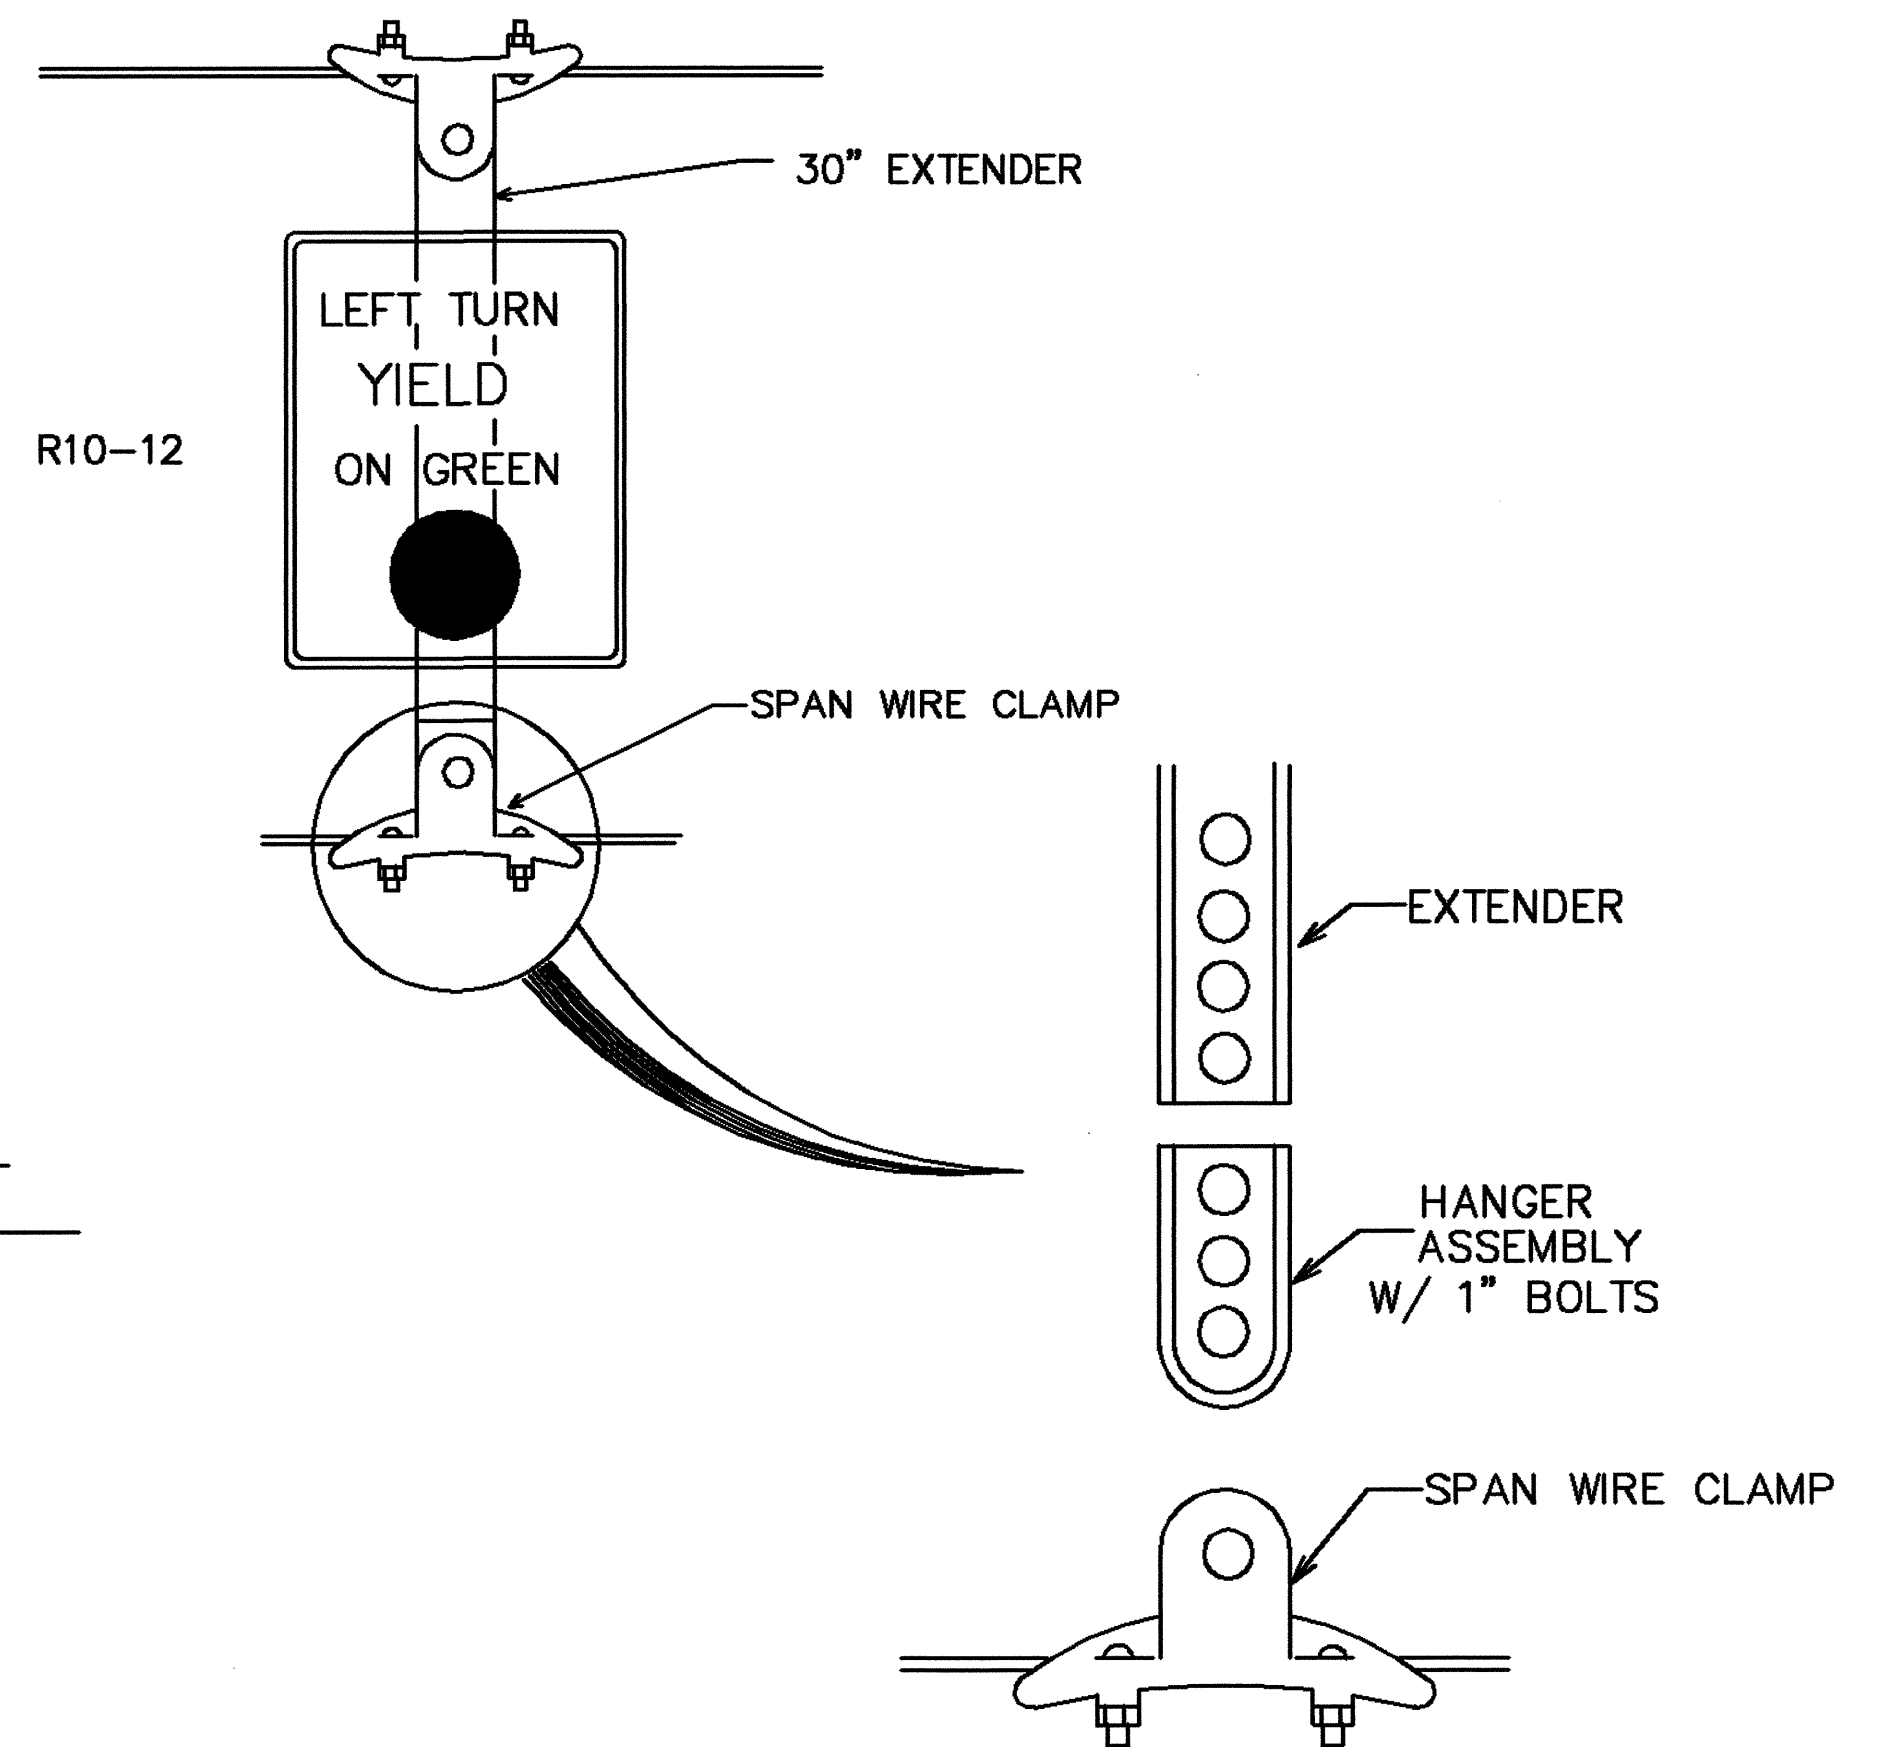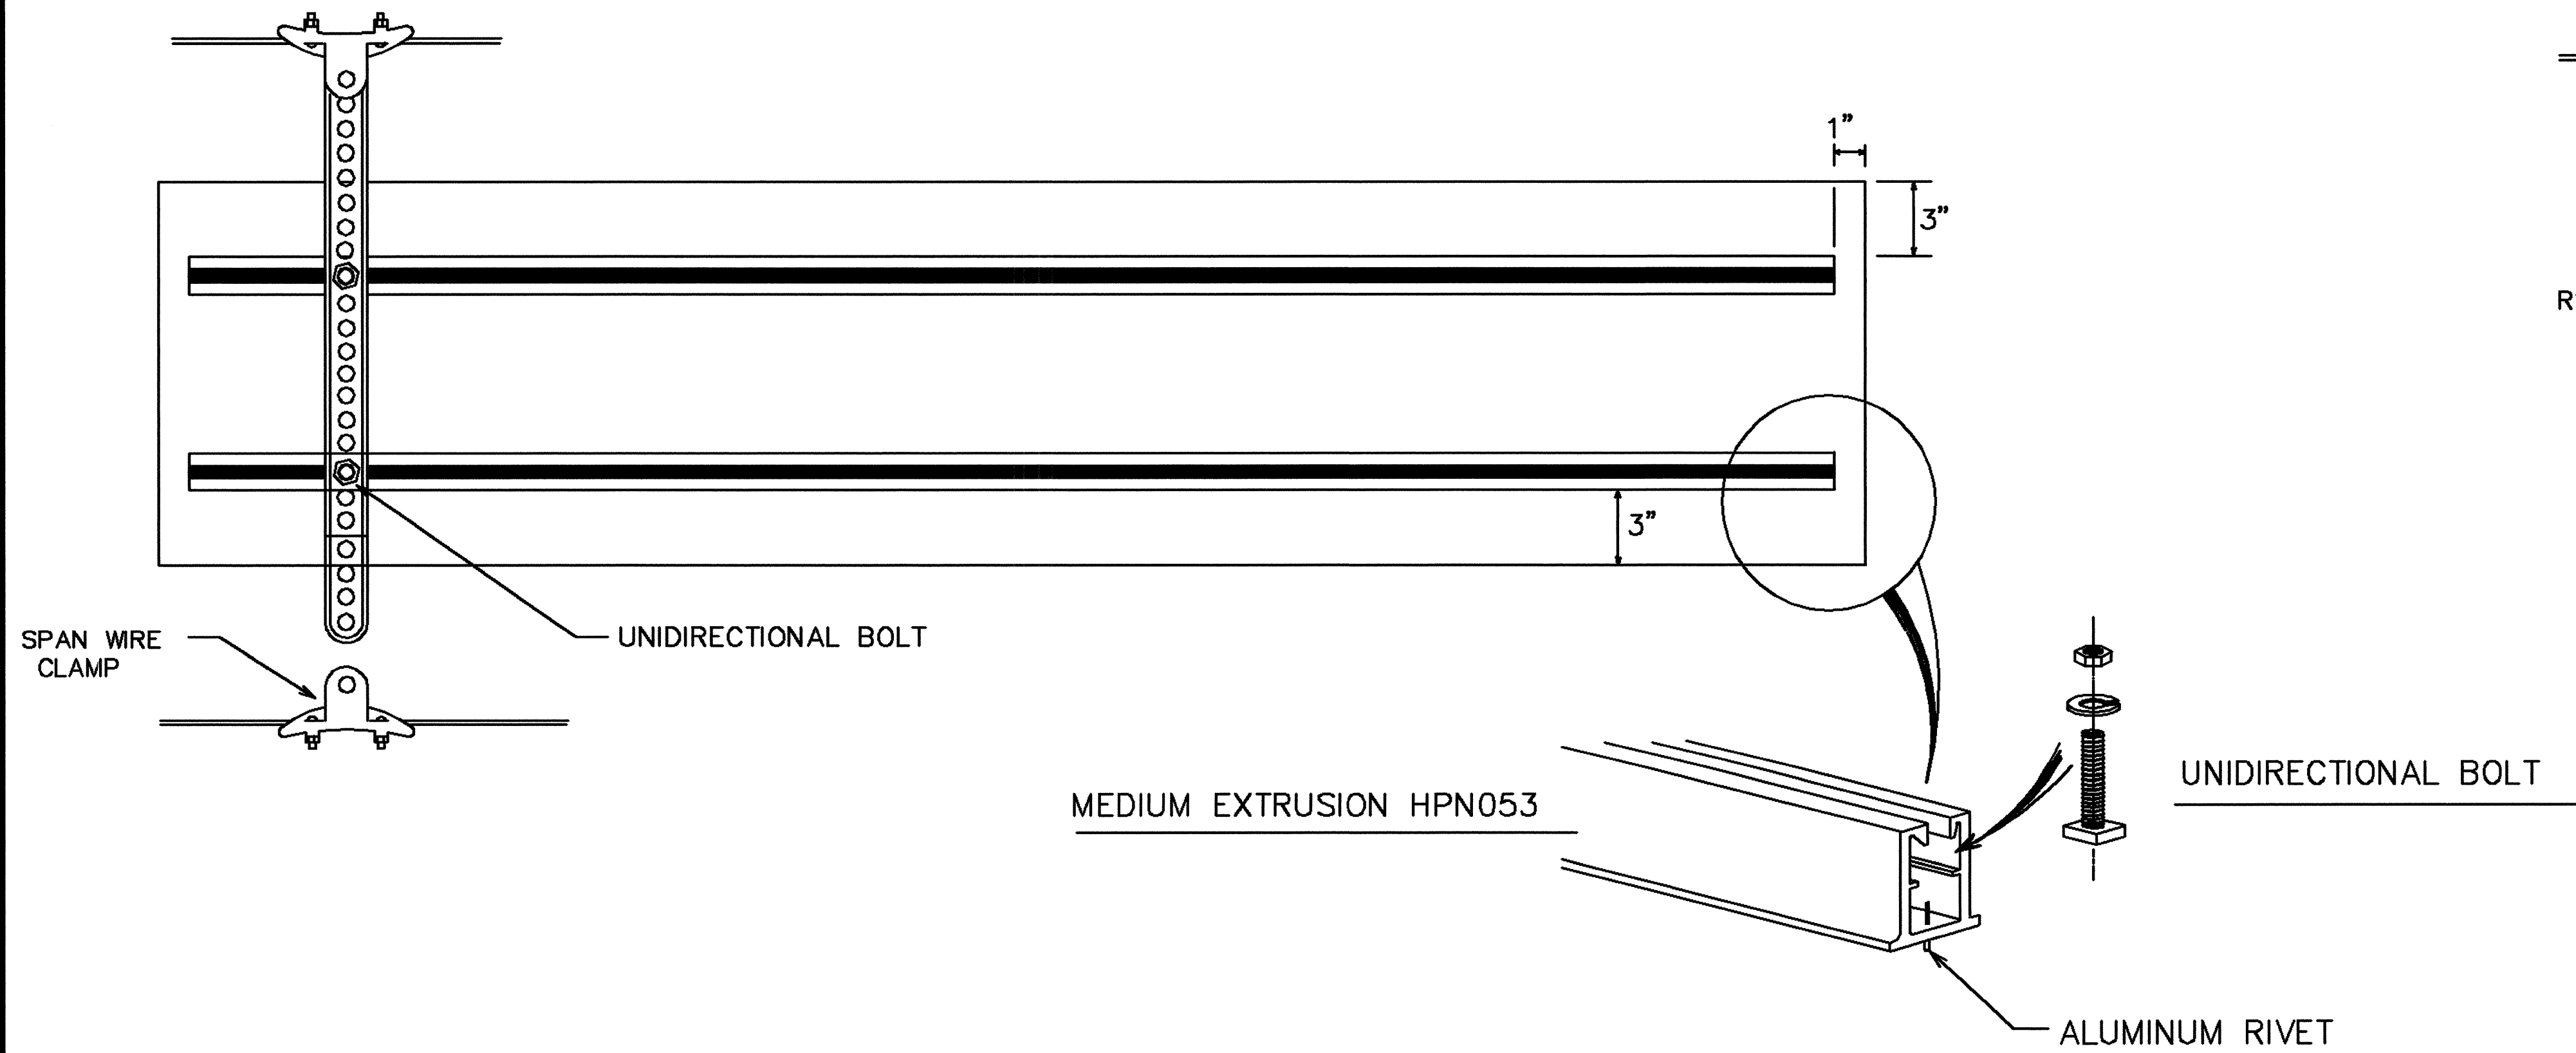

HANGER ASSEMBLY DETAILS

- NOTES: 1. BASED ON SIGN WIDTH, THE NUMBER OF VERTICAL SUPPORTS REQUIRED ARE AS FOLLOWS:
 3'-0" OR LESS - 1 SUPPORT REQUIRED
 >3'-0" UP TO 8'-0" - 2 SUPPORTS REQUIRED
 >8'-0" - 3 SUPPORTS REQUIRED
 SEE DIAGRAMS FOR SIGN SUPPORT SPACING
2. FOR STREET NAME SIGNS, EXTRUDED ALUMINUM SHALL BE MOUNTED FOR HORIZONTAL SUPPORT AS SHOWN.

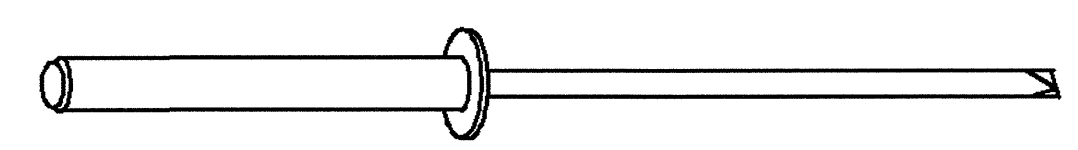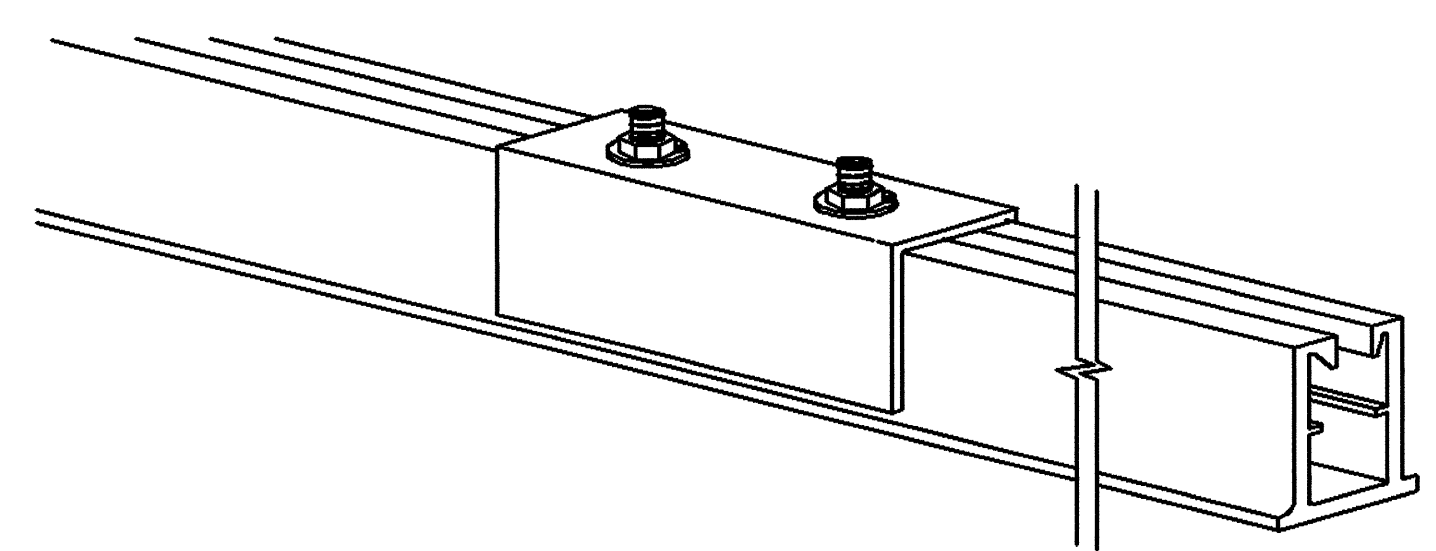

NOTE: ALUMINUM RIVETS SHALL BE USED TO ATTACH THE SIGN TO THE EXTRUDED ALUMINUM. SPACINGS OF RIVETS SHALL BE 6" O.C.

RECORD DRAWING
 BASED ON CONTRACTOR MARKUPS,
 NOT FIELD SURVEY.

CONSTRUCTION DETAILS FOR SPAN WIRE MOUNTED TRAFFIC SIGNALS

SHEET 3 OF 3
DALLAS DISTRICT STANDARD

FED. PROJ. DISTRICT	FEDERAL AID PROJECT NO.		SHEET NO.
6			
STATE	STATE DISTRICT	COUNTY	
TEXAS	DAL		
CONT.	SECT.	JOB	HIGHWAY NO.

The use of this standard is governed by the "Texas Engineering Practice Act". No warranty of any kind is made by TxDOT for any purpose whatsoever. TxDOT assumes no responsibility for the conversion of this standard to other formats or for incorrect results or damages resulting from its use.

DISCLAIMER:

Barricade and Construction (BC) Standard Sheets General Notes:

1. The Barricade and Construction Standard Sheets (BC sheets) are intended to show typical examples for placement of temporary traffic control devices, construction pavement markings, and typical work zone signs. The information contained in these sheets meet or exceed the requirements shown in the "Texas Manual on Uniform Traffic Control Devices" (TMUTCD).
2. The development and design of the Traffic Control Plan (TCP) is the responsibility of the Engineer.
3. The Contractor may propose changes to the TCP that are signed and sealed by a licensed professional engineer for approval. The Engineer may develop, sign and seal Contractor proposed changes.
4. The Contractor is responsible for installing and maintaining the traffic control devices as shown in the plans. The Contractor may not move or change the approximate location of any device without the approval of the Engineer.
5. Geometric design of lane shifts and detours should, when possible, meet the applicable design criteria contained in manuals such as the American Association of State Highway and Transportation Officials (AASHTO), "A Policy on Geometric Design of Highways and Streets", the TxDOT "Roadway Design Manual" or engineering judgment.
6. When projects abut, the Engineer(s) may omit the END ROAD WORK, TRAFFIC FINES DOUBLE, and other advance warning signs if the signing would be redundant and the work areas appear continuous to the motorists. If the adjacent project is completed first, the Contractor shall erect the necessary warning signs as shown on these sheets, the TCP sheets or as directed by the Engineer. The BEGIN ROAD WORK NEXT X MILES sign shall be revised to show appropriate work zone distance.
7. The Engineer may require duplicate warning signs on the median side of divided highways where median width will permit and traffic volumes justify the signing.
8. All signs shall be constructed in accordance with the details found in the "Standard Highway Sign Designs for Texas," latest edition. Sign details not shown in this manual shall be shown in the plans or the Engineer shall provide a detail to the Contractor before the sign is manufactured.
9. The temporary traffic control devices shown in the illustrations of the BC sheets are examples. As necessary, the Engineer will determine the most appropriate traffic control devices to be used.
10. As shown on BC(2), the OBEY WARNING SIGNS STATE LAW sign and the WORK ZONE TRAFFIC FINES DOUBLE sign with plaque shall be erected in advance of the CSJ limits. The BEGIN ROAD WORK NEXT X MILES, CONTRACTOR and END ROAD WORK signs shall be erected at or near the CSJ limits.
11. Except for devices required by Note 10, traffic control devices should be in place only while work is actually in progress or a definite need exists.
12. The Engineer has the final decision on the location of all traffic control devices.
13. Inactive equipment and work vehicles, including workers' private vehicles must be parked away from travel lanes. They should be as close to the right-of-way line as possible, or located behind a barrier or guardrail, or as approved by the Engineer.

Worker Safety Apparel Notes:

1. Workers on foot who are exposed to traffic or to construction equipment within the right-of-way shall wear high-visibility safety apparel meeting the requirements of ISEA "American National Standard for High-Visibility Apparel" labeled as ANSI 107-2004 standard performance for Class 2 or 3 risk exposure. Class 3 garments should be considered for high traffic volume work areas or night time work.

Only pre-qualified products shall be used. The "Compliant Work Zone Traffic Control Devices List" (CWZTCD) describes prequalified products and their sources and may be found on-line at the web address given below or by contacting:

Texas Department of Transportation
 Traffic Operations Division - TE
 Phone (512) 416-3134

WEB ADDRESSES FOR REFERENCED DOCUMENTS

Compliant Work Zone Traffic Control Devices List (CWZTCD)
<http://www.txdot.gov/publications/traffic.htm>

Texas Manual on Uniform Traffic Control Devices (TMUTCD)
<http://www.txdot.gov/publications/traffic.htm>

Standard Highway Sign Designs for Texas (SHSD)
<http://www.txdot.gov/publications/traffic.htm>

Traffic Engineering Standard Sheets
<http://www.txdot.gov/business/disclaim.htm>

Material Producer List
<http://www.txdot.gov/business/producer#list.htm>

Departmental Material Specifications (DMS)
<http://www.txdot.gov/services/construction/material#specifications/>

Roadway Design Manual
<http://www.txdot.gov/services/general#services/manuals.htm>



**BARRICADE AND CONSTRUCTION
 GENERAL NOTES
 AND REQUIREMENTS**


1 of 12 BC(1)-07

© TxDOT 11-4-02		01N TxDOT	01K TxDOT	01M TxDOT	01K TxDOT
4-03	REVISIONS	COUNT	SECT	JOB	HIGHWAY
9-07		DIST	COUNTY		SHEET NO.

DATE:
 FILE:

The use of this standard is governed by the "Texas Engineering Practice Act". No warranty of any kind is made by TxDOT for any purpose whatsoever. TxDOT assumes no responsibility for the consequences of any failure to conform to other standards or for incorrect results or damages resulting from its use.


TYPICAL LOCATION OF CROSSROAD SIGNS

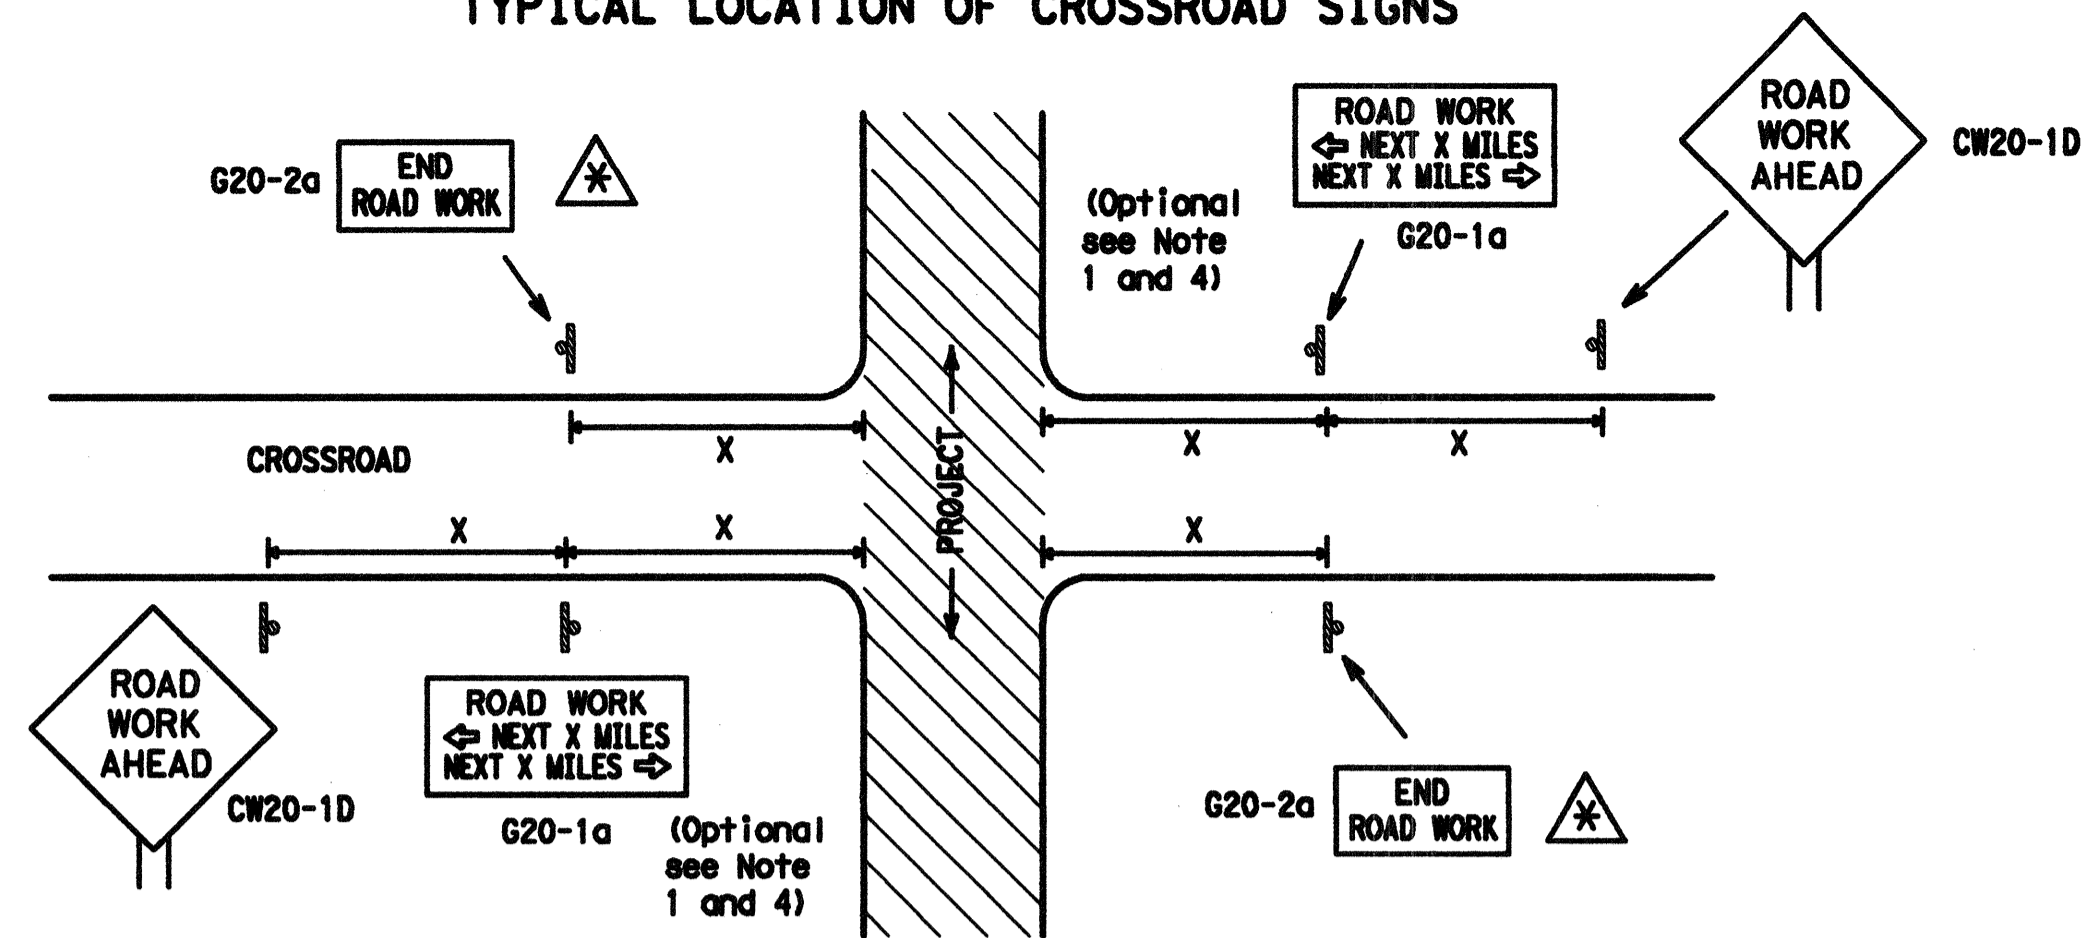

⚠ May be mounted on back of CW20-1D sign with approval of engineer. (See note 2 below)

- The typical minimum signing on a crossroad approach should be a CW20-1D ROAD WORK AHEAD sign and a G20-2a END ROAD WORK sign, unless noted otherwise in plans.
- The Engineer may use the reduced size 36" x 36" ROAD WORK AHEAD (CW20-1D) sign mounted back to back with the reduced size 36" x 18" END ROAD WORK (G20-2a) sign on low volume crossroads (see Note 4 under "Typical Construction Warning Sign Size and Spacing"). See the "Standard Highway Sign Designs for Texas" manual for sign details. The Engineer may omit the advance warning signs on low volume crossroads. The Engineer will determine whether a road is low volume. This information shall be shown in the plans.
- Based on existing field conditions, the Engineer/Inspector may require additional signs such as FLAGGER AHEAD, LOOSE GRAVEL, or other appropriate signs. When additional signs are required, these signs will be considered part of the minimum requirements. The Engineer/Inspector will determine the proper location and spacing of any sign not shown on the BC sheets, Traffic Control Plan sheets or the Work Zone Standard Sheets.
- The G20-1a sign shall be required at high volume crossroads to advise motorists of the length of construction in either direction from the intersection. The Engineer will determine whether a roadway is considered high volume.
- Additional traffic control devices may be shown elsewhere in the plans for higher volume crossroads.
- When work occurs in the intersection area, appropriate traffic control devices, as shown elsewhere in the plans or as determined by the Engineer/Inspector, shall be in place.

T-INTERSECTION

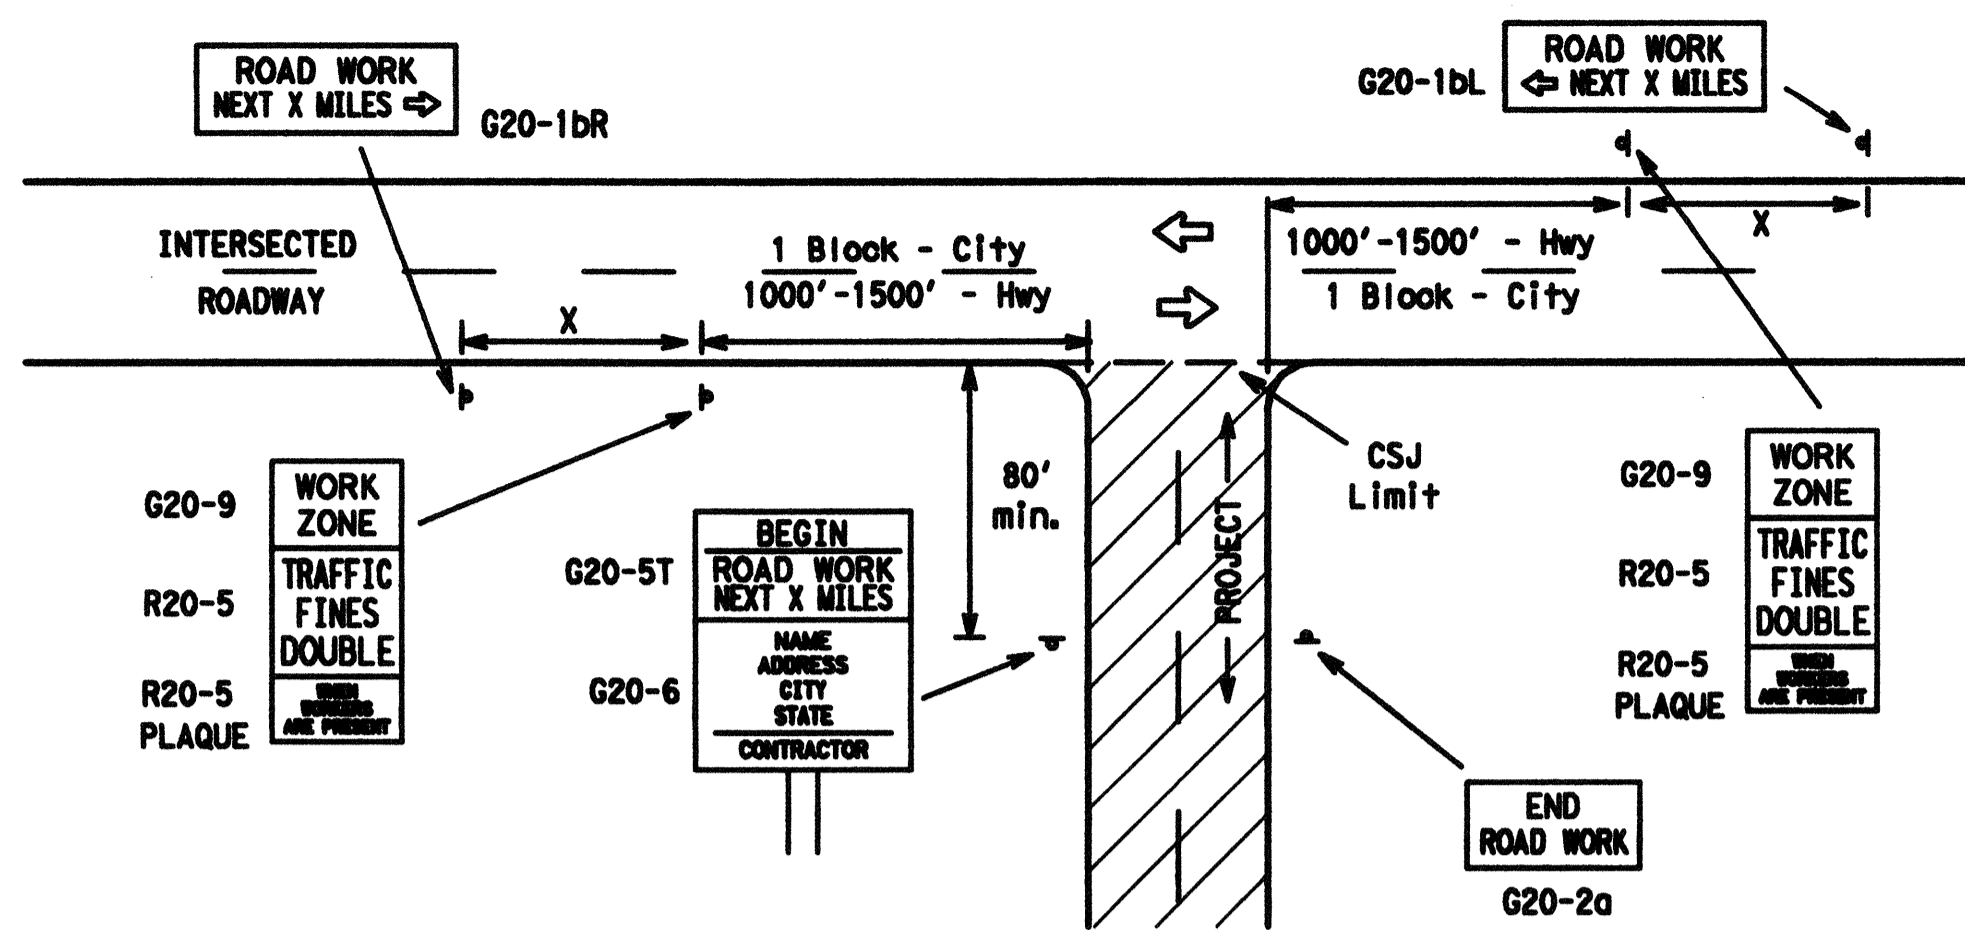

CSJ LIMITS AT T-INTERSECTION

- The Engineer will determine the types and location of any additional traffic control devices, such as a flagger and accompanying signs, or other signs, that should be used when work is being performed at or near an intersection.
- If construction closes the road at a T-intersection the Contractor shall place the G20-6 "Contractor Name" sign behind the Type III Barricades for the road closure (see BC(10) also). The G20-1bL and G20-1bR signs shall be replaced by the detour signing called for in the plans.

TYPICAL CONSTRUCTION WARNING SIGN SIZE AND SPACING ^{1,5,6}

Sign Number or Series	SIZE		SPACING	
	Conventional Road	Expressway/Freeway	Posted Speed MPH	Sign Spacing "X" Feet (Approx.)
CW20 CW21 CW22 CW23 CW25	48" x 48"	48" x 48"	30	120
CW1, CW2, CW7, CW8, CW9, CW11, CW14	36" x 36"	48" x 48"	35	160
CW3, CW4, CW5, CW6, CW8-3, CW10, CW12	48" x 48"	48" x 48"	40	240
			45	320
			50	400
			55	500 ²
			60	600 ²
			65	700 ²
			70	800 ²
			75	900 ²
			80	1000 ²
			*	* ³


* For typical sign spacings on divided highways, expressways and freeways, see Part 6 of the "Texas Manual on Uniform Traffic Control Devices" (TMUTCD) typical application diagrams or TCP Standard Sheets.

Δ Minimum distance from work area to first Advance Warning sign nearest the work area and/or distance between each additional sign.

General Notes:


- Special or larger size signs may be used as necessary.
- Distance between signs should be increased as required to have 1500 feet advance warning.
- Distance between signs should be increased as required to have 1/2 mile or more advance warning.
- 36" x 36" ROAD WORK AHEAD (CW20-1D) signs may be used on low volume crossroads at the discretion of the Engineer. See Note 2 under "Typical Location of Crossroad Signs".
- Only diamond shaped warning sign sizes are indicated.
- See sign size listing in "TMUTCD", Sign Appendix or the "Standard Highway Sign Designs for Texas" manual for complete list of available sign design sizes.

WORK AREAS IN MULTIPLE LOCATIONS WITHIN CSJ LIMITS

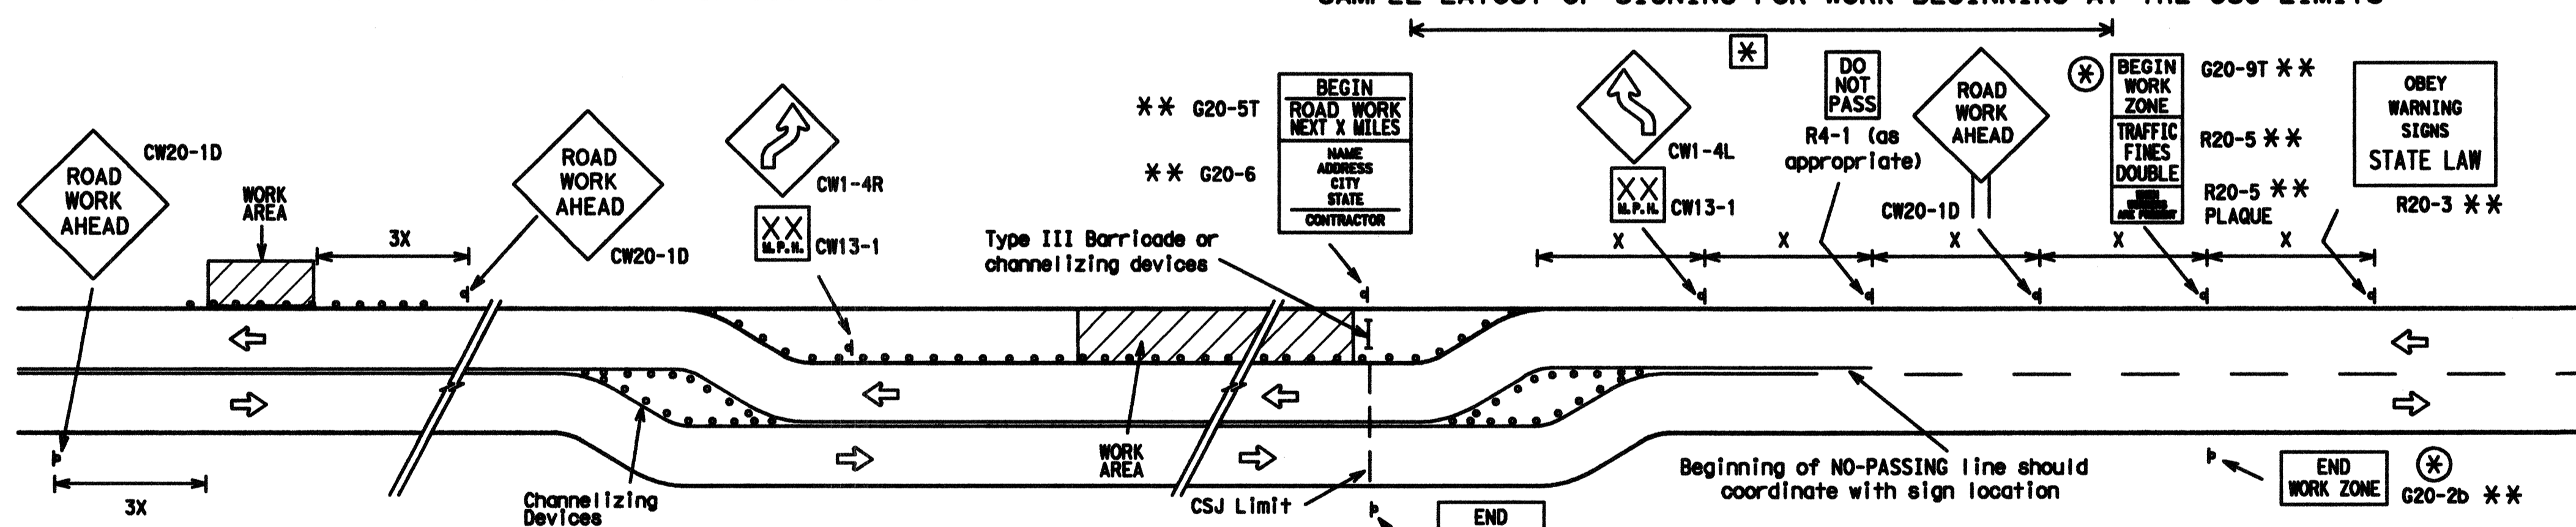


When extended distances occur between minimal work areas, the Engineer/Inspector should ensure additional Road Work Ahead (CW20-1D) signs are placed in advance of these work areas to remind drivers they are still within the project limits. See the applicable TCP sheets for exact location and spacing of signs and channelizing devices.

SAMPLE LAYOUT OF SIGNING FOR WORK BEGINNING AT THE CSJ LIMITS

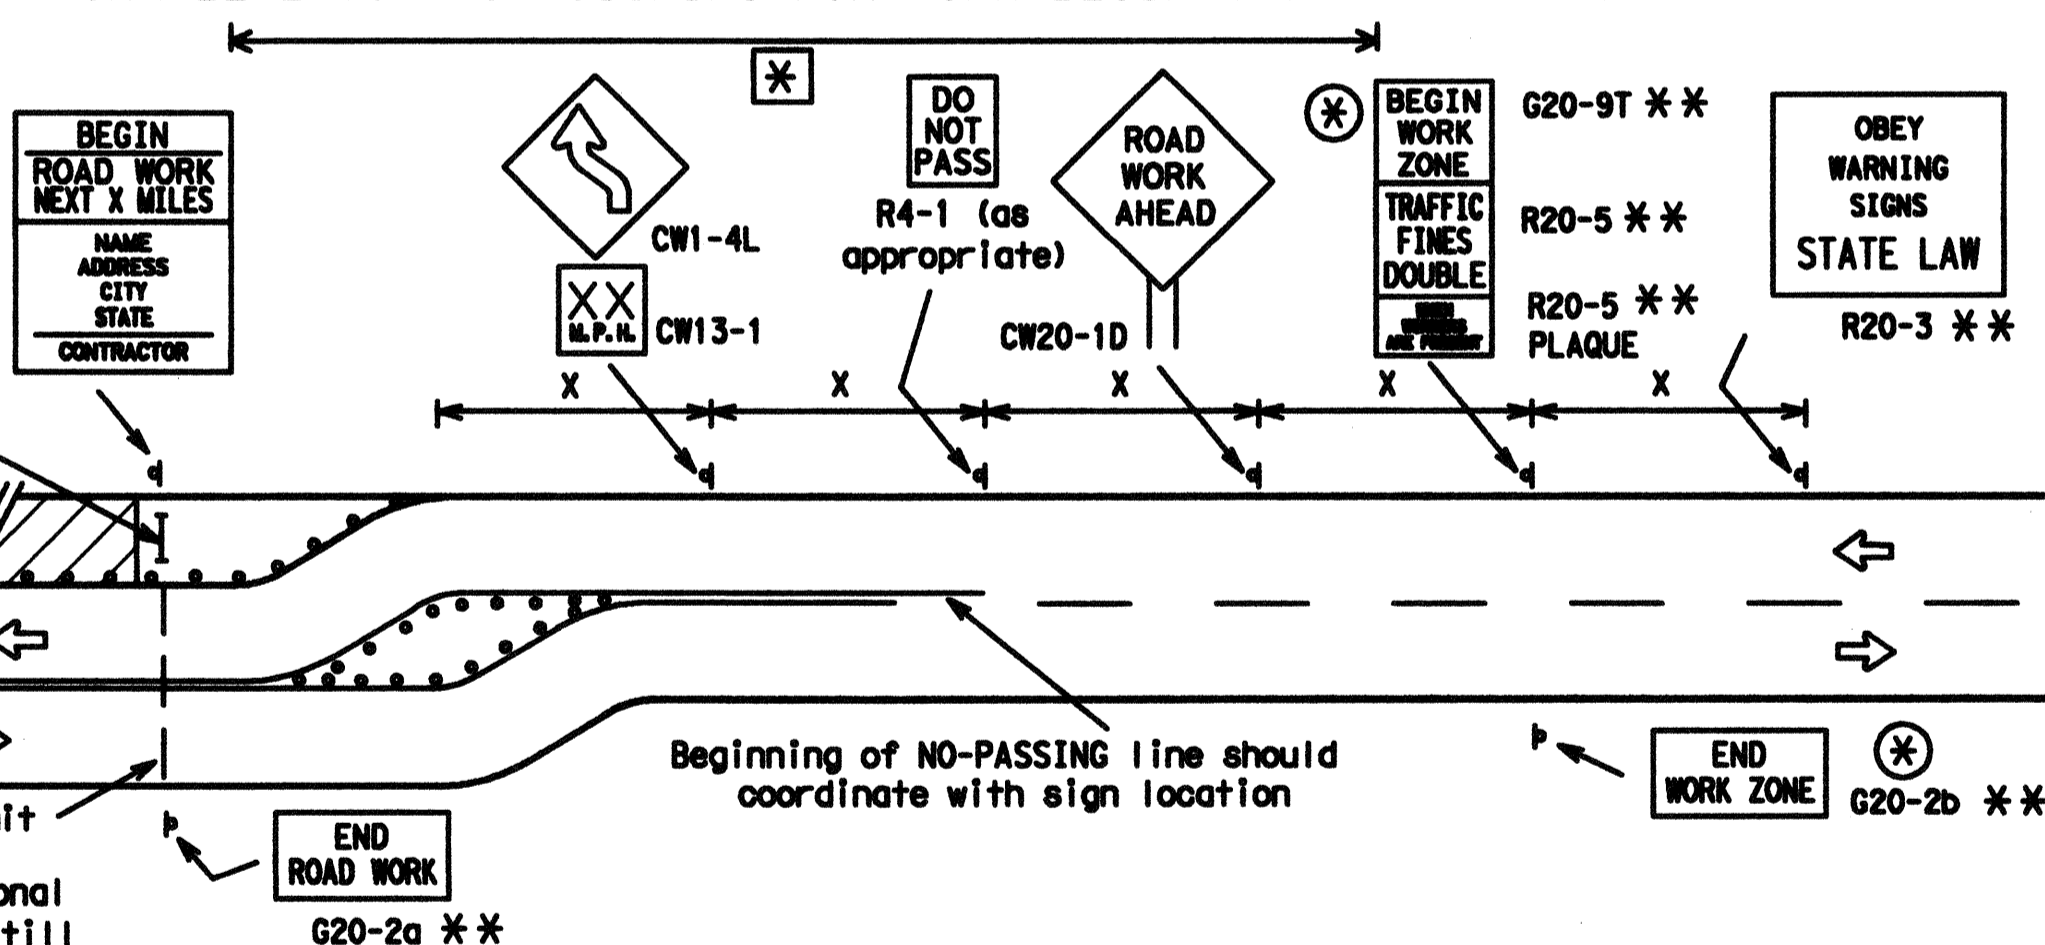

SAMPLE LAYOUT OF SIGNING FOR WORK BEGINNING DOWNSTREAM OF THE CSJ LIMITS

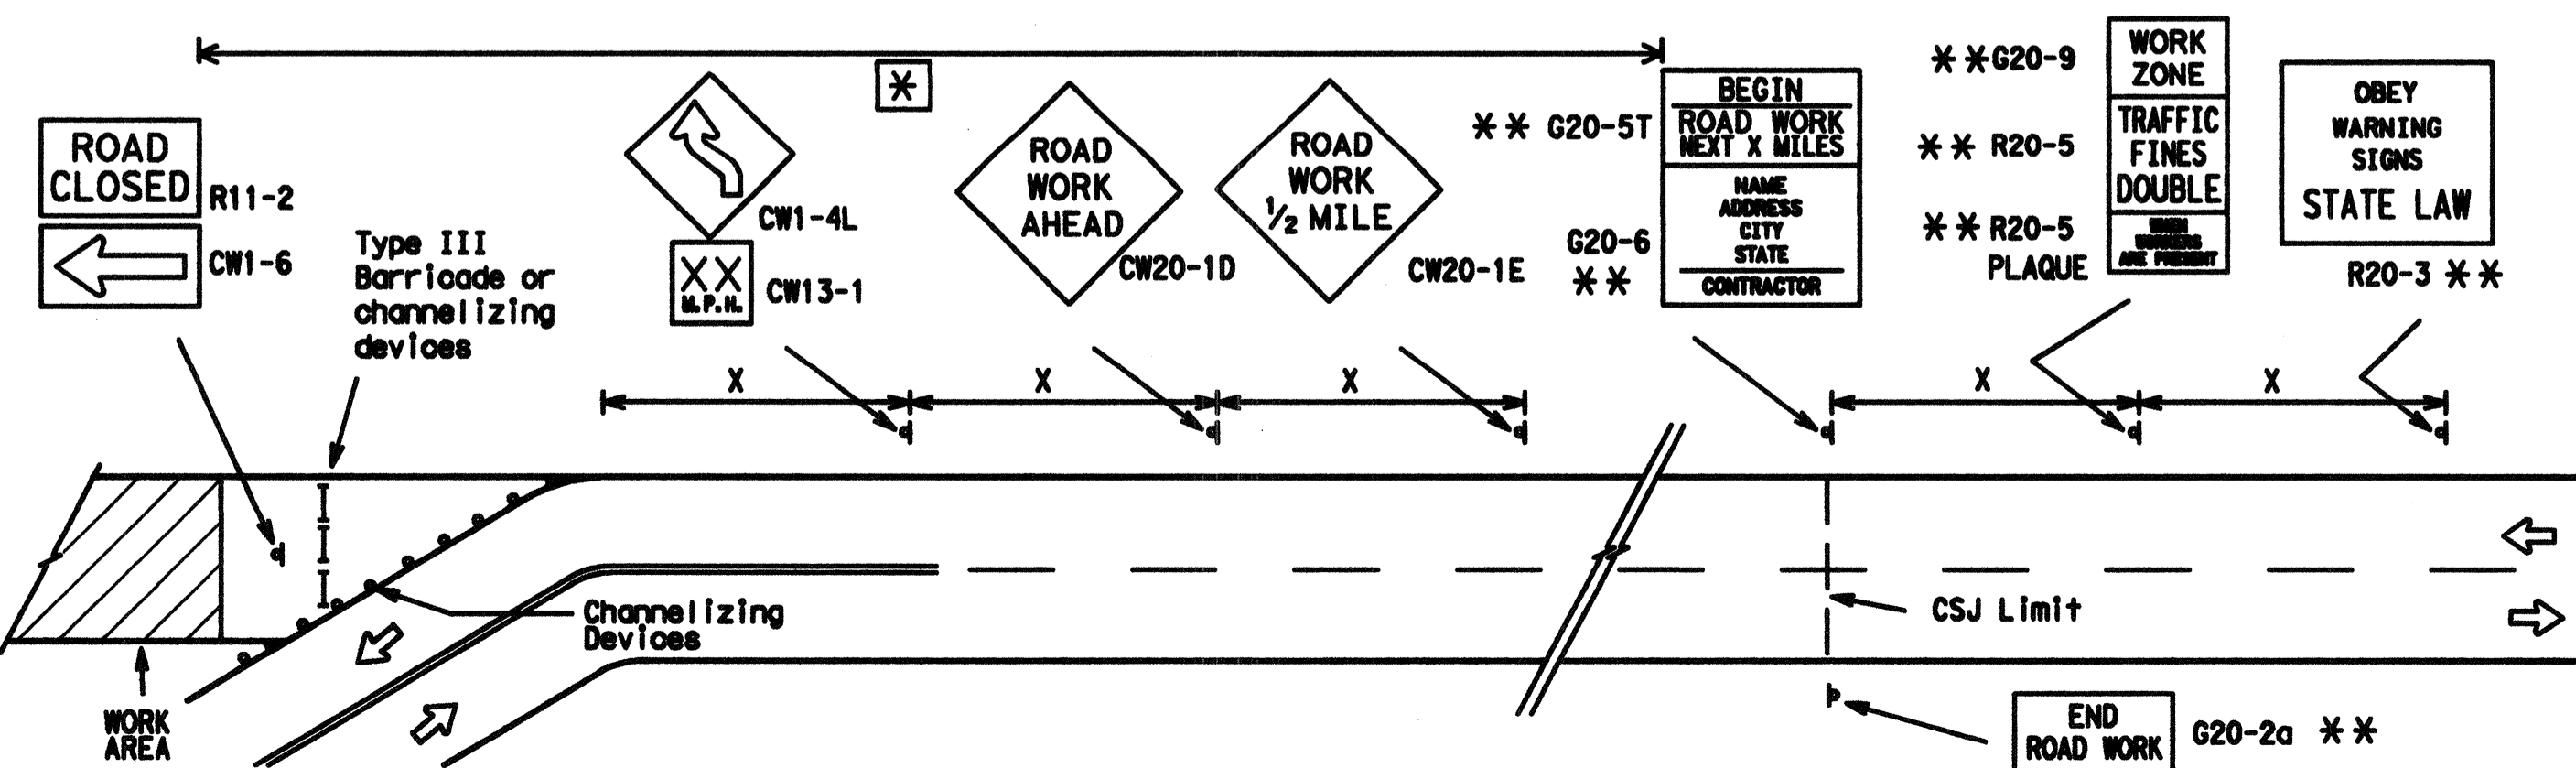

NOTES

The Contractor shall determine the appropriate distance to be placed on the G20-1 series signs and G20-5T sign for each specific project. This distance shall replace the "X" and shall be rounded to the nearest whole mile with the approval of the Engineer. No decimals shall be used.

⊗ The G20-9T and G20-2b shall be used when advance signs are required outside the CSJ Limits. They inform the motorist of entering or leaving a work zone where traffic fines may double if workers are present.

** Required CSJ Limit signing. See Note 10 on BC(1).

⊗ Area for placement of "ROAD WORK AHEAD" sign and other signs or devices as called for on the Traffic Control Plan.

LEGEND

- ⊗ sign
- Channelizing Devices
- I Type III Barricade
- X See Typical Construction Warning Sign Size and Spacing chart or the TMUTCD for sign spacing requirements.



R20-3
Legend/Border - Black
Background - White

Texas Department of Transportation
 Traffic Operations Division

BARRICADE AND CONSTRUCTION PROJECT LIMIT STANDARD

2 of 12 BC(2)-07


TxDOT 11-4-02	REV. NO.	DATE	BY	CHECKED	APPROVED	PROJECT	SHEET NO.
9-07	1	JUN	JUN				

TYPICAL APPLICATION OF WORK ZONE SPEED LIMIT SIGNS

Work zone speed limits shall be regulatory, established in accordance with the "Procedures for Establishing Speed Zones," and approved by the Texas Transportation Commission, or by City Ordinance when within Incorporated City Limits.

Reduced speeds should only be posted in the vicinity of work activity and not throughout the entire project.

Regulatory work zone speed signs (R2-1) shall be removed or covered during periods when they are not needed.

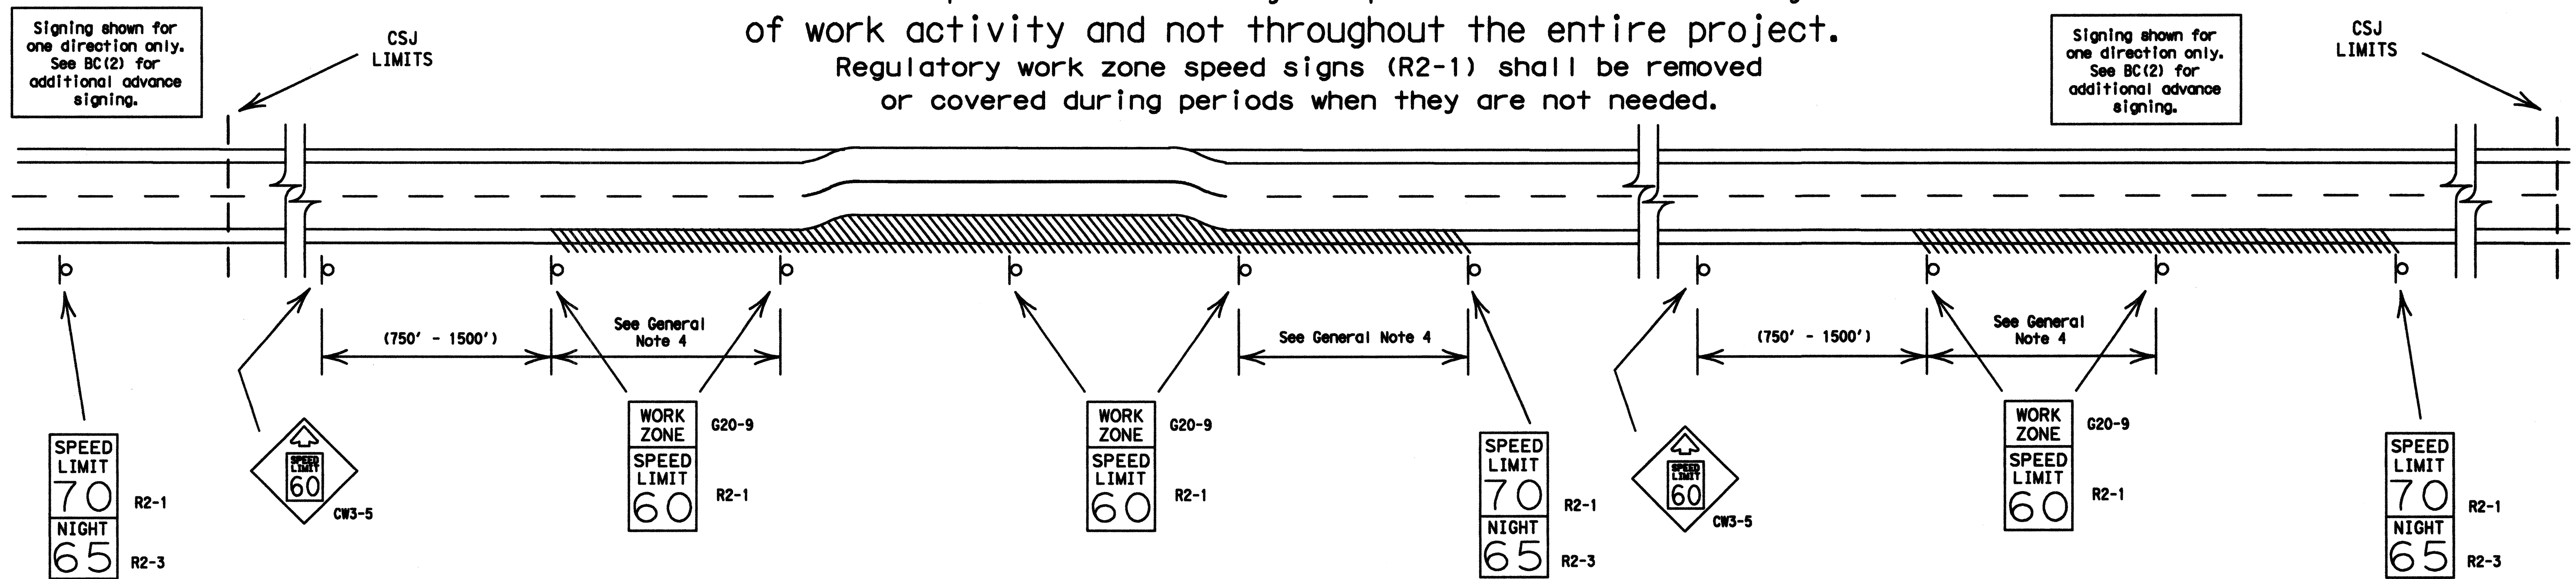

GUIDANCE FOR USE:

LONG/INTERMEDIATE TERM WORK ZONE SPEED LIMITS

This type of work zone speed limit should be included on the design of the traffic control plans when restricted geometrics with a lower design speed are present in the work zone and modification of the geometrics to a higher design speed is not feasible.

Long/Intermediate Term Work Zone Speed Limit signs, when approved as described above, should be posted and visible to the motorist when work activity is present. Work activity may also be defined as a change in the roadway that requires a reduced speed for motorists to safely negotiate the work area, including:

- rough road or damaged pavement surface
- substantial alteration of roadway geometrics (diversions)
- construction detours
- grade
- width
- other conditions readily apparent to the driver

As long as any of these conditions exist, the work zone speed limit signs should remain in place.

SHORT TERM WORK ZONE SPEED LIMITS

This type of work zone speed limit should be included on the design of the traffic control plans when workers or equipment are not behind concrete barrier, when work activity is within 15 feet of pavement edge or actually on the pavement.

Short Term Work Zone Speed Limit signs should be posted and visible to the motorists only when work activity is present. When work activity is not present, signs shall be removed or covered. (See Removing or Covering on BC(4)).

GENERAL NOTES:

- Regulatory work zone speed limits should be used only for sections of construction projects where speed control is of major importance.
- Regulatory work zone speed limit signs shall be placed on supports at a 7 foot minimum mounting height.
- Speed zone signs are illustrated for one direction of travel and are normally posted for each direction of travel.
- Frequency of work zone speed limit signs should be:
 - 40 mph and greater 0.2 to 2 miles
 - 35 mph and less 0.2 to 1 mile
- Regulatory speed limit signs shall have black legend and border on a white reflective background (See "Reflective Sheeting" on BC(4)).
- Fabrication, erection and maintenance of the CW3-5 sign, G20-9 plaque and the R2-1 and R2-3 signs shall not be paid for directly, but shall be considered subsidiary to Item 502.
- Turning signs from view, laying signs over or down will not be allowed, unless otherwise noted.
- Techniques that may help reduce traffic speeds include but are not limited to:
 - A. Law enforcement.
 - B. Flagger stationed next to sign.
 - C. Portable changeable message sign (PCMS).
 - D. Low-power (drone) radar transmitter.
 - E. Speed monitor trailers or signs.
- Speeds shown on details above are for illustration only. Work Zone Speed Limits should only be posted as approved for each project.

DISCLAIMER: The use of this standard is governed by the "Texas Engineering Practice Act." No warranty of any kind is made by TxDOT for any purpose whatsoever. TxDOT assumes no responsibility for the consequences of any use of this standard or for incorrect results or damages resulting from its use.

DATE: FILE:

 Texas Department of Transportation
Traffic Operations Division

BARRICADE AND CONSTRUCTION WORK ZONE SPEED LIMIT STANDARD


3 of 12

BC(3)-07

© TxDOT 11-4-02		DATE	BY	CHK	DATE	CHK	DATE
9-07	REVISIONS	DATE	BY	CHK	DATE	CHK	DATE

The use of this standard is governed by the "Texas Engineering Practice Act". No warranty of any kind is made by TxDOT for any purpose whatsoever. TxDOT assumes no responsibility for the conversion of this standard to other formats or for inaccuracies or damages resulting from its use.


TYPICAL MINIMUM CLEARANCES FOR LONG TERM AND INTERMEDIATE TERM SIGNS

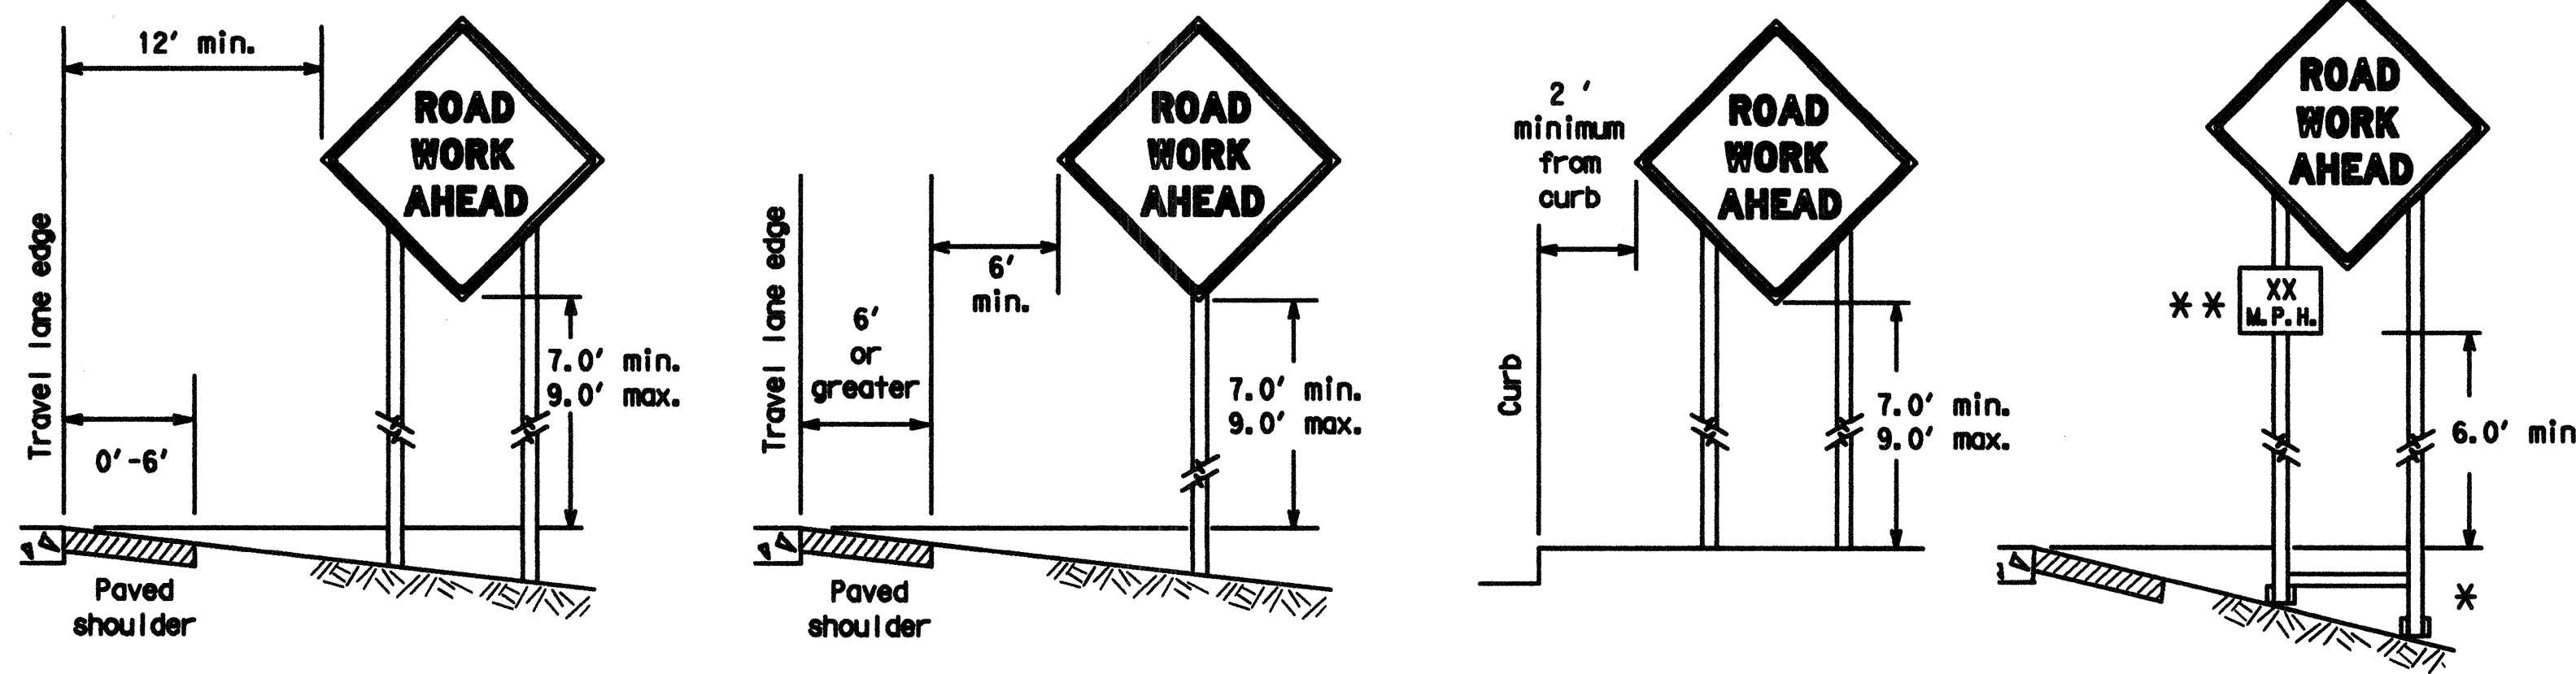

* When placing skid supports on unlevel ground, the leg post lengths must be adjusted so the sign appears straight and plumb. Objects shall NOT be placed under skids as a means of leveling.

** When plaques are placed on dual-leg supports, they should be attached to the upright nearest the travel lane. Supplemental plaques (advisory or distance) should not cover the surface of the parent sign.

ATTACHMENT FOR SIGN SUPPORTS

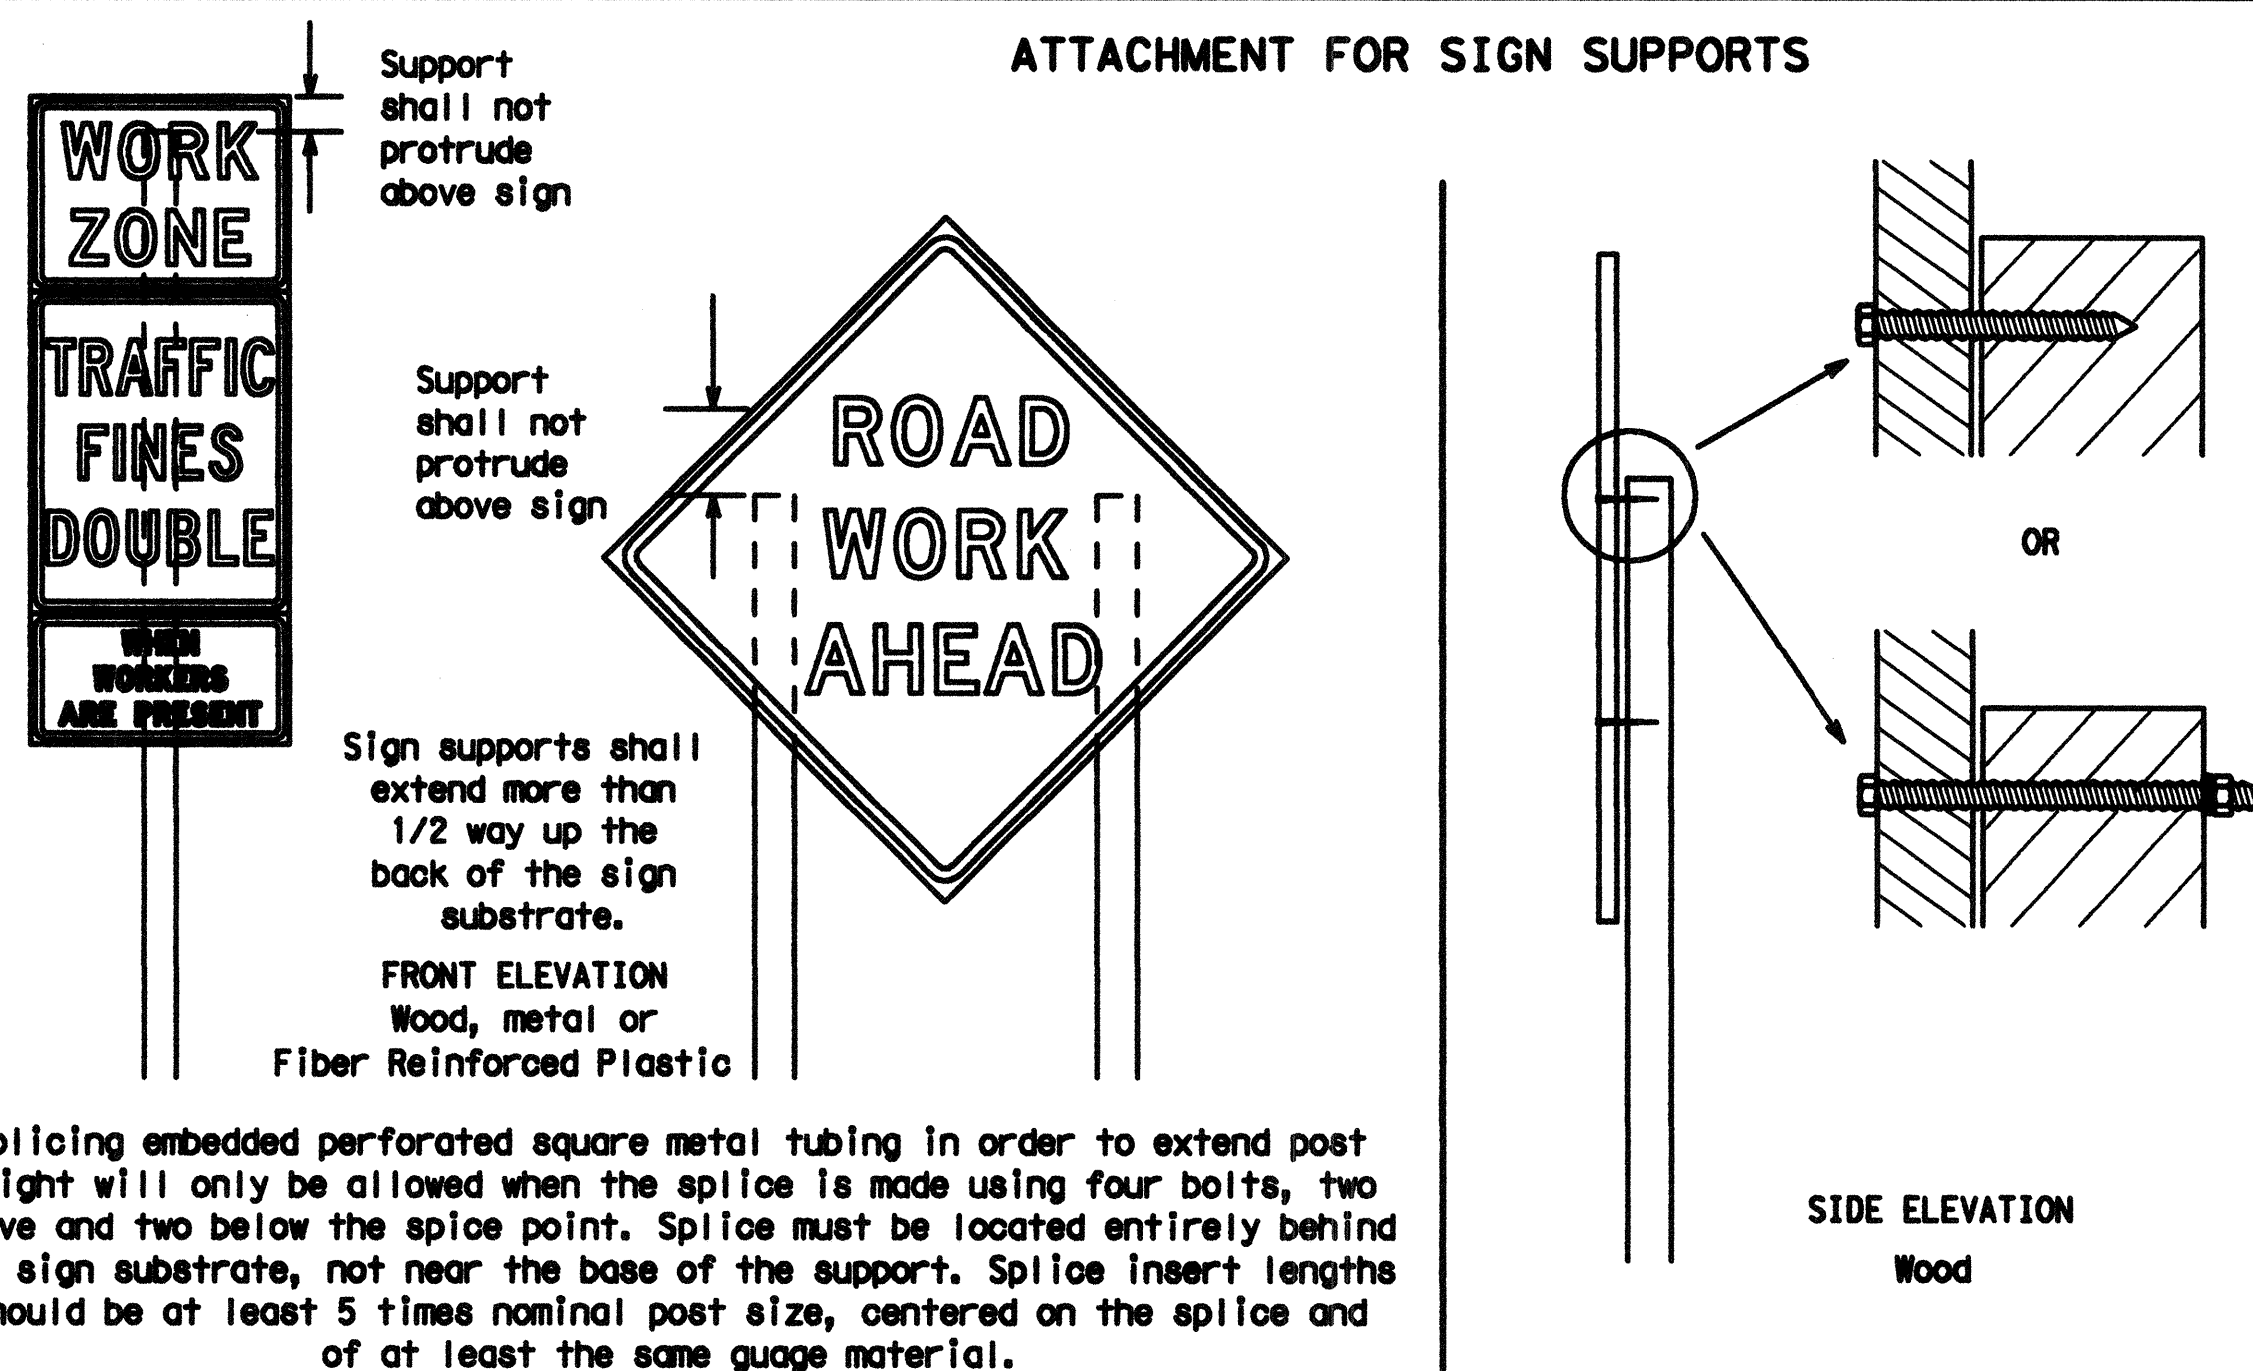

Attachment to wooden supports will be by bolts and nuts or screws. Use TxDOT's or manufacturer's recommended procedures for attaching sign substrates to other types of sign supports.

Nails will NOT be allowed.

Each sign shall be attached directly to the sign support. Multiple signs shall not be joined or spliced by any means. Wood supports shall not be extended or repaired by splicing or other means.

GENERAL NOTES FOR WORK ZONE SIGNS

- Contractor shall install and maintain signs in a straight and plumb condition and/or as directed by the Engineer.
 - Wooden sign posts shall be painted white.
 - Barriocades shall NOT be used as sign supports.
 - Nails shall NOT be used to attach signs to any support.
 - All signs shall be installed in accordance with the plans or as directed by the Engineer. Signs shall be used to regulate, warn, and guide the traveling public safely through the work zone.
 - The Contractor may furnish either the sign design shown in the plans or in the "Standard Highway Sign Designs for Texas" (SHSD). The Engineer/Inspector may require the Contractor to furnish other work zone signs that are shown in the TMUTCD but may have been omitted from the plans. Any variation in the plans shall be documented by written agreement between the Engineer and the Contractor's Responsible Person. All changes must be documented in writing before being implemented. This can include documenting the changes in the Inspector's TxDOT diary and having both the Inspector and Contractor initial and date the agreed upon changes.
 - The Contractor shall furnish sign supports listed in the "Compliant Work Zone Traffic Control Device List" (CWZTCD). The Contractor shall install the sign support in accordance with the manufacturer's recommendations. If there is a question regarding installation procedures, the Contractor shall furnish the Engineer a copy of the manufacturer's installation recommendations so the Engineer can verify the correct procedures are being followed.
 - The Contractor is responsible for installing signs on approved supports and replacing signs with damaged or cracked substrates and/or damaged or marred reflective sheeting as directed by the Engineer/Inspector.
 - Identification markings may be shown only on the back of the sign substrate. The maximum height of letters and/or company logos used for identification shall be 1 inch.
 - The Contractor shall replace damaged wood posts. New or damaged wood sign posts shall not be spliced.
- DURATION OF WORK** (as defined by the "Texas Manual on Uniform Traffic Control Devices" Part 6)
- The types of sign supports, sign mounting height, the size of signs, and the type of sign substrates can vary based on the type of work being performed. The Engineer is responsible for selecting the appropriate size sign for the type of work being performed. The Contractor is responsible for ensuring the sign support, sign mounting height and substrate meets manufacturer's recommendations in regard to crashworthiness and duration of work requirements.
 - Long-term stationary - work that occupies a location more than 3 days.
 - Intermediate-term stationary - work that occupies a location more than one daylight period up to 3 days, or nighttime work lasting more than one hour.
 - Short-term stationary - daytime work that occupies a location for more than 1 hour in a single daylight period.
 - Short, duration - work that occupies a location up to 1 hour.
 - Mobile - work that moves continuously or intermittently (stopping for up to approximately 15 minutes.)

SIGN MOUNTING HEIGHT

- The bottom of Long-term/Intermediate-term signs shall be at least 7 feet, but not more than 9 feet, above the paved surface, except as shown for supplemental plaques mounted below other signs.
- The bottom of Short-term/Short Duration signs shall be a minimum of 1 foot above the pavement surface but no more than 2 feet above the ground.
- Long-term/Intermediate-term Signs may be used in lieu of Short-term/Short Duration signing.
- Short-term/Short Duration signs shall be used only during daylight and shall be removed at the end of the workday, or raised to appropriate Long-term/Intermediate sign height.
- Regulatory signs shall be mounted at least 7 feet, but not more than 9 feet, above the paved surface regardless of work duration.

SIZE OF SIGNS

- The Engineer may allow the use of smaller size construction warning signs on secondary roads or city streets where speeds are low if the sign size is listed as an option on the "Typical Construction Warning Sign Size and Spacing" chart shown on BC(2).
- The Contractor shall furnish the sign sizes shown in plans, the BC Sheets, the TCP sheets or as directed by the Engineer.

SIGN SUBSTRATES

- The Contractor shall ensure the sign substrate is installed in accordance with the manufacturer's recommendations for the type of sign support that is being used. The CWZTCD lists each substrate that can be used on the different types and models of sign supports.
- "Mesh" type materials are NOT an approved sign substrate, regardless of the tightness of the weave.
- All wooden individual sign panels fabricated from 2 or more pieces shall have one or more plywood cleat, 1/2" thick by 6" wide, fastened to the back of the sign and extending fully across the sign. The cleat shall be attached to the back of the sign using wood screws that do not penetrate the face of the sign panel. The screws shall be placed on both sides of the splice and spaced at 6" centers. The Engineer may approve other methods of splicing the sign face.

REFLECTIVE SHEETING

- All signs shall be retroreflective and constructed of sheeting meeting the color and retro-reflectivity requirements of DMS-8300 for rigid signs or DMS-8310 for roll-up signs. The web address for DMS specifications is shown on BC(1).
- White sheeting, meeting the requirements of DMS-8300 Type C (High Specific Intensity), shall be used for signs with a white background.
- Orange sheeting, meeting the requirements of DMS-8300 Type E (Fluorescent Prismatic), shall be used for rigid signs with orange backgrounds.

SIGN LETTERS

- All sign letters and numbers shall be clear, and open rounded type uppercase alphabet letters as approved by the Federal Highway Administration (FHWA) and as published in the "Standard Highway Sign Design for Texas" manual. Signs, letters and numbers shall be of first class workmanship in accordance with Department Standards and Specifications.

REMOVING OR COVERING


- When sign messages may be confusing or do not apply, the signs shall be removed or completely covered.
- Long-term stationary or intermediate stationary signs installed on square metal tubing may be turned away from traffic 90 degrees when the sign message is not applicable. This type of sign support meets the crashworthiness standards regardless of the direction of impact. This technique may not be used for signs installed in the median of divided highways or near any intersections where the sign may be seen from approaching traffic.
- Signs installed on wooden skids shall not be turned at 90 degree angles to the roadway. These signs should be removed or completely covered when not required.
- When signs are covered, the material used shall be opaque, such as heavy mil black plastic, or other materials which will cover the entire sign face and maintain their opaque properties under automobile headlights at night, without damaging the sign sheeting.
- Burlap shall NOT be used to cover signs.
- Duct tape or other adhesive material shall NOT be affixed to a sign face. These materials can damage the retroreflectivity of sheeting.
- Signs and anchor stubs shall be removed and holes backfilled upon completion of work.

SIGN SUPPORT WEIGHTS

- Where sign supports require the use of weights to keep from turning over, the use of sandbags with dry, cohesionless sand is recommended.
- The sandbags will be tied shut to keep the sand from spilling and to maintain a constant weight.
- Rock, concrete, iron, steel or other solid objects shall not be permitted for use as sign support weights.
- Sandbags shall weigh a minimum of 35 lbs and a maximum of 50 lbs.
- Sandbags shall be made of a durable material that tears upon vehicular impact.
- Rubber (such as tire inner tubes) shall NOT be used for sandbags.
- Rubber ballasts designed for channelizing devices should not be used for ballast on portable sign supports. Sign supports designed and manufactured with rubber bases may be used when shown on the CWZTCD list.
- Sandbags shall only be placed along or laid over the base supports of the traffic control device and shall not be suspended above ground level or hung with rope, wire, chains or other fasteners. Sandbags shall be placed along the length of the skids to weigh down the sign support.
- Sandbags shall NOT be placed under the skid and shall not be used to level sign supports placed on slopes.

STOP/SLOW PADDLES

- STOP/SLOW paddles are the primary method to control traffic by flaggers. The STOP/SLOW paddle size should be 24" x 24" as detailed below.
- When used at night, the STOP/SLOW paddle shall be retroreflectORIZED.
- STOP/SLOW paddles may be attached to a staff with a minimum length of 6' to the bottom of the sign.
- Any lights incorporated into the STOP or SLOW paddle faces shall only be as specifically described in Section 6E.03 Hand Signaling Devices in the TMUTCD.

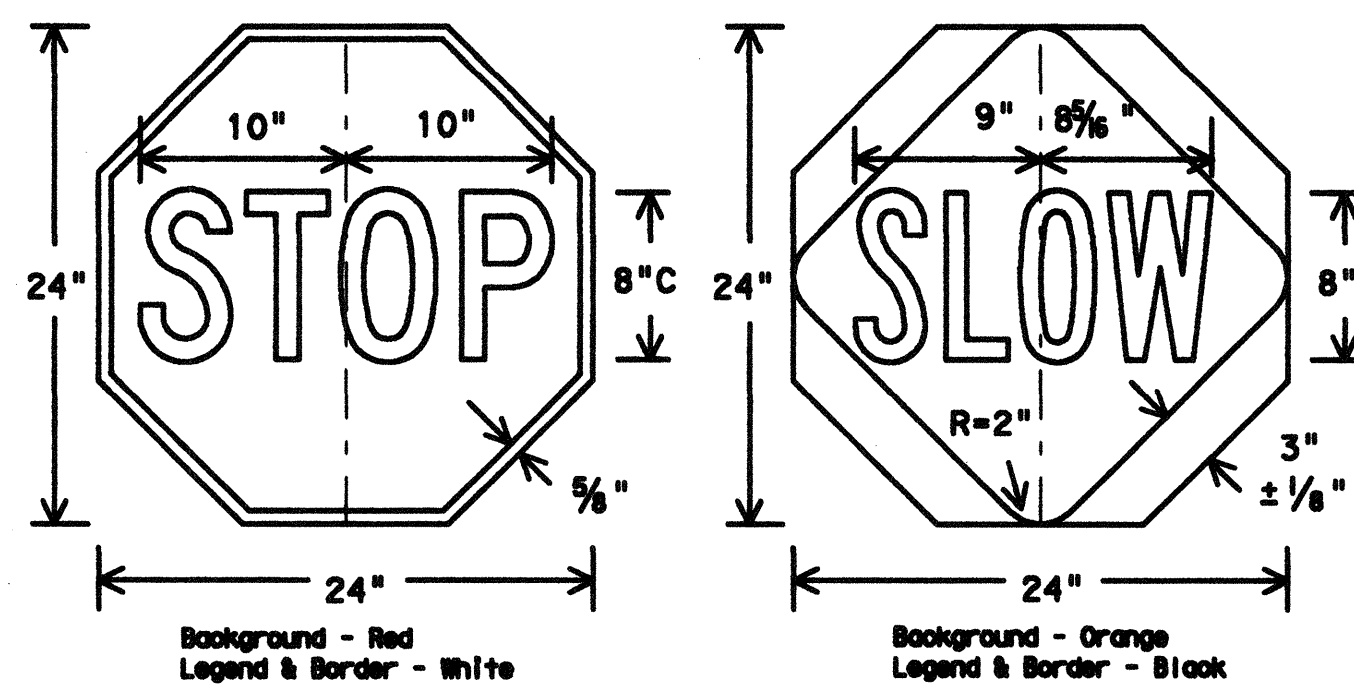

CONTRACTOR REQUIREMENTS FOR MAINTAINING PERMANENT SIGNS WITHIN THE PROJECT LIMITS

- Permanent signs are used to give notice of traffic laws or regulations, call attention to conditions that are potentially hazardous to traffic operations, show route designations, destinations, directions, distances, services, points of interest, and other geographical, recreational, or cultural information. Drivers proceeding through a work zone need the same, if not better route guidance as normally installed on a roadway without construction.
- When permanent regulatory or warning signs conflict with work zone conditions, remove or cover the permanent signs until the permanent sign message matches the roadway condition.
- When existing permanent signs are moved and relocated due to construction purposes, they shall be visible to motorists at all times.
- If existing signs are to be relocated on their original supports, they shall be installed on crashworthy bases as shown on the SMD Standard sheets. The signs shall meet the required mounting heights shown on the BC Sheets or the SMD Standards. This work should be paid for under the appropriate pay item for relocating existing signs.
- If permanent signs are to be removed and relocated using temporary supports, the Contractor shall use crashworthy supports as shown on the BC sheets or the CWZTCD. The signs shall meet the required mounting heights shown on the BC Sheets or the SMD Standards during construction. This work should be paid for under the appropriate pay item for relocating existing signs.
- Any sign or traffic control device that is struck or damaged by the Contractor or his/her construction equipment shall be replaced as soon as possible by the Contractor to ensure proper guidance for the motorists. This will be subsidiary to Item 502.



BARRICADE AND CONSTRUCTION TEMPORARY SIGN NOTES STANDARD

4 of 12


BC(4)-07

© TxDOT 11-4-02		REV. TxDOT	CKI TxDOT	DATE TxDOT	CKI TxDOT
9-07	REVISIONS	CUA.T	SECT	JUN	HIGHWAY
		DIST		COUNTY	SHEET NO.


The use of this standard is governed by the Texas Engineering Practice Act. No warranty of any kind is made by TxDOT for any purpose whatsoever. TxDOT assumes no responsibility for the design of any sign or for any damage resulting from its use.

SKID MOUNTED WOOD SIGN SUPPORTS

LONG/INTERMEDIATE TERM STATIONARY - PORTABLE SKID MOUNTED SIGN SUPPORTS □

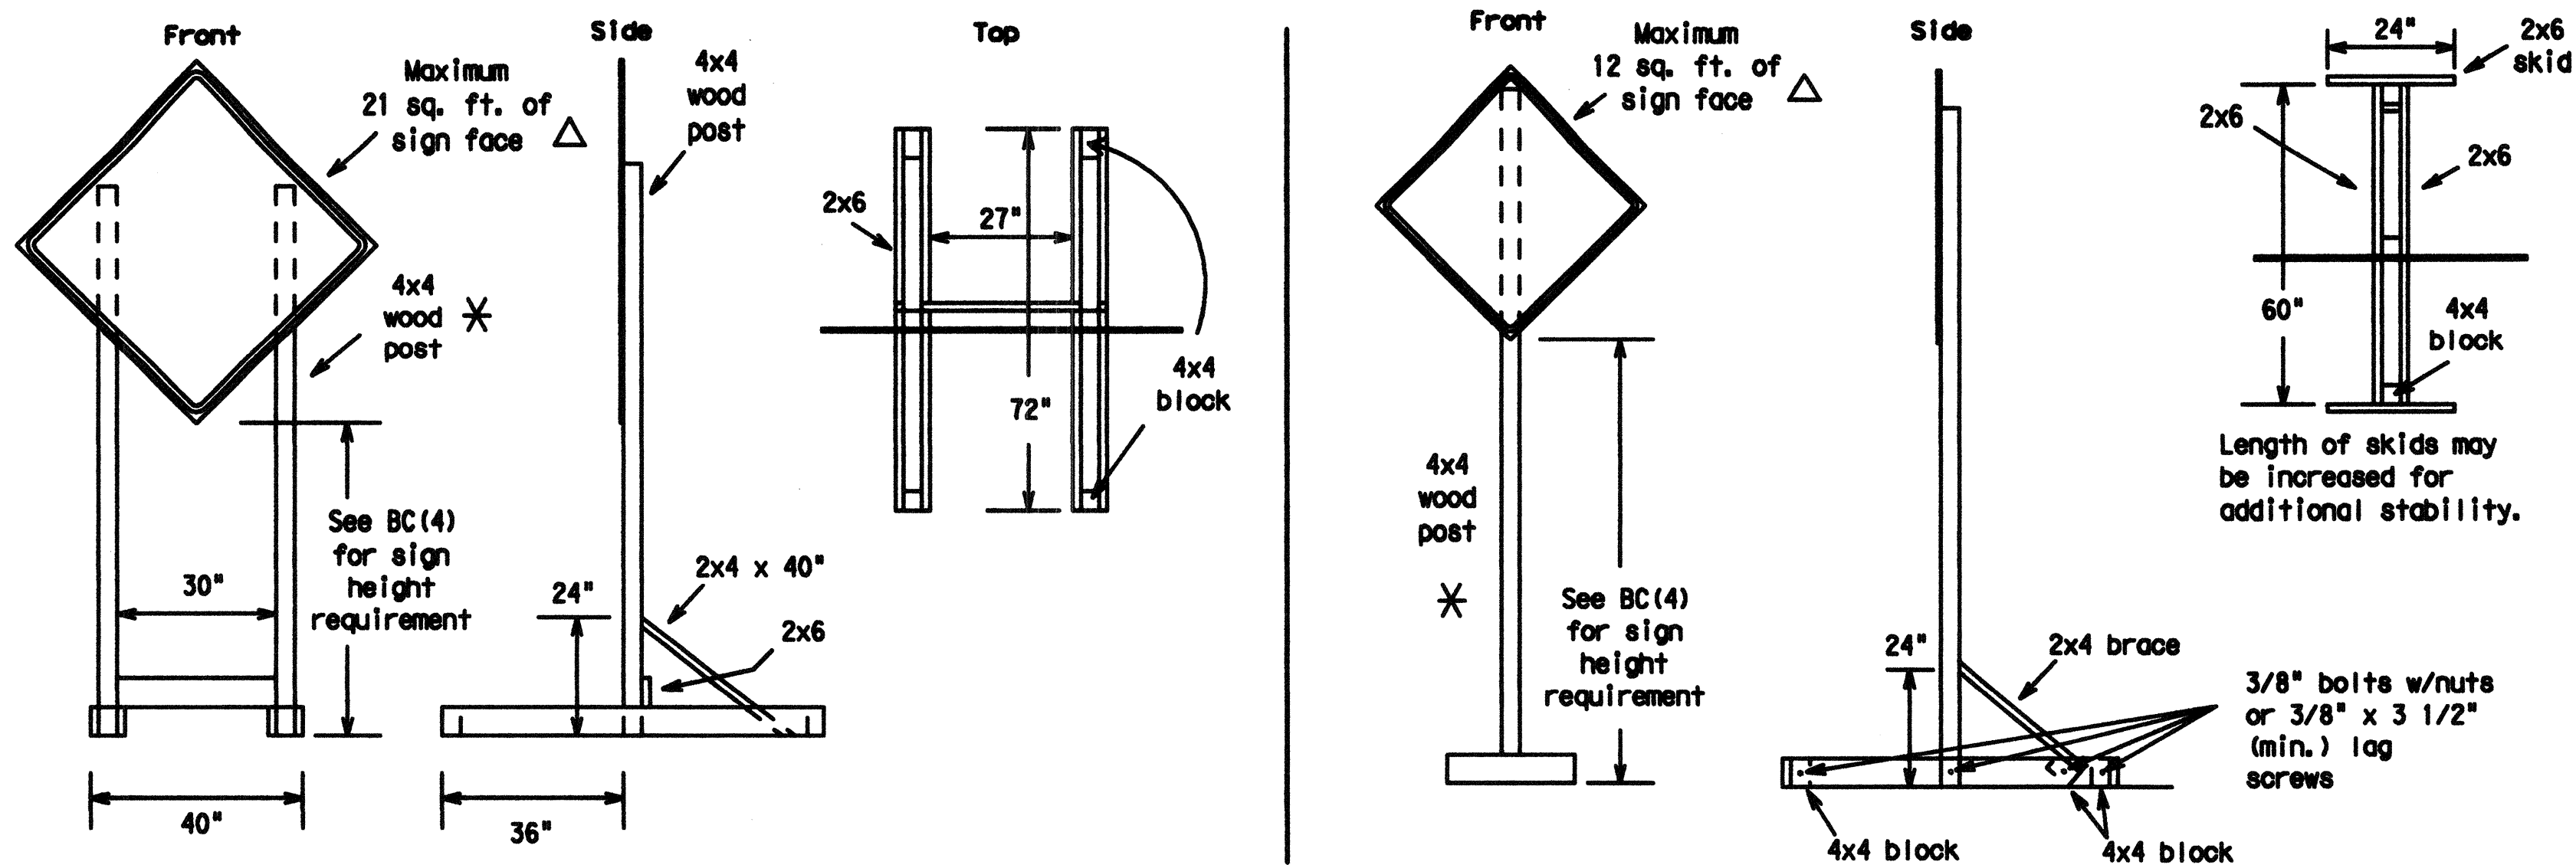


SKID MOUNTED PERFORATED SQUARE STEEL TUBING SIGN SUPPORTS

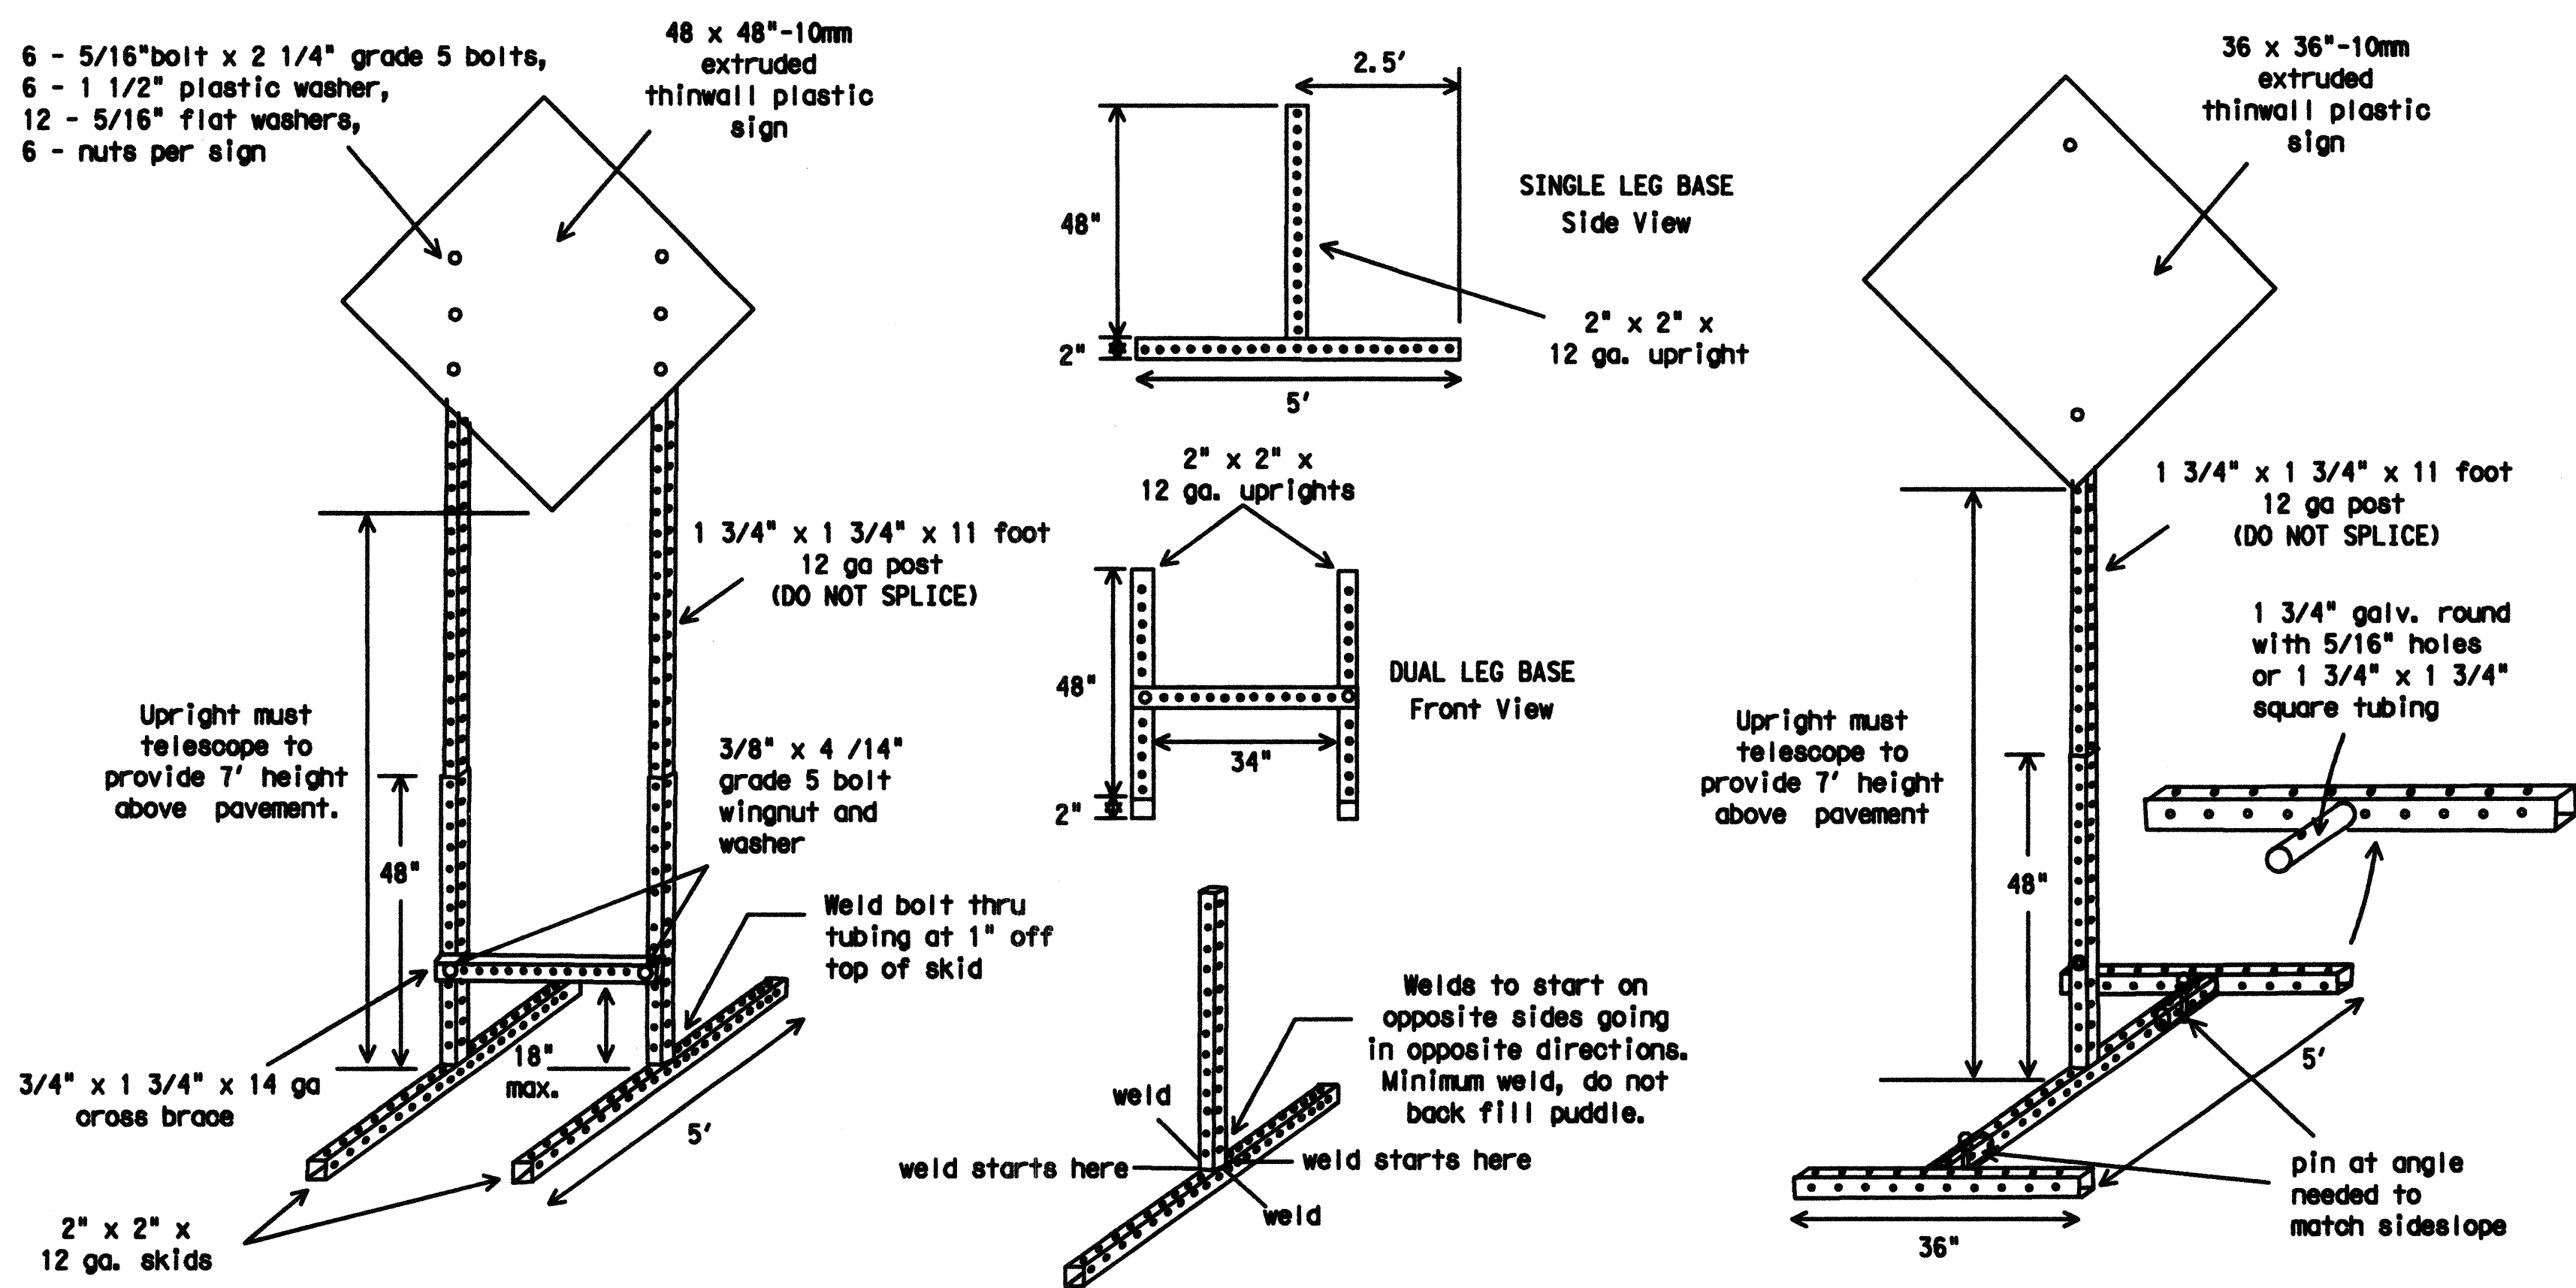

WEDGE ANCHORS

Both steel and plastic Wedge Anchor Systems as shown on the SMD Standard Sheets may be used as temporary sign supports for signs up to 10 square feet of sign face. They may be set in concrete or in sturdy soils if approved by the Engineer. (See web address for "Traffic Engineering Standard Sheets" on BC(1)).

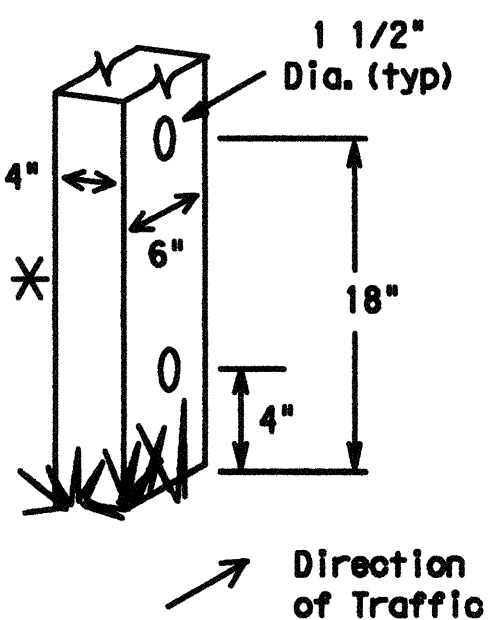


WOOD POST SYSTEM FOR GROUND MOUNTED SIGN SUPPORTS

Nominal Post Size	No. of Posts	Maximum Sq. feet of Sign Face	Minimum Soil Embedment	Drilled Hole(s) Required
4 x 4	1	12	36"	NO
4 x 4	2	21	36"	NO
4 x 6	1	21	36"	YES
4 x 6	2	36	36"	YES


GROUND MOUNTED SIGN SUPPORTS

Refer to the CWZTC and the manufacturer's installation procedure for each type sign support. The maximum sign square footage shall adhere to the manufacturer's recommendation. Two post installations can be used for larger signs.

PERFORATED SQUARE METAL TUBING

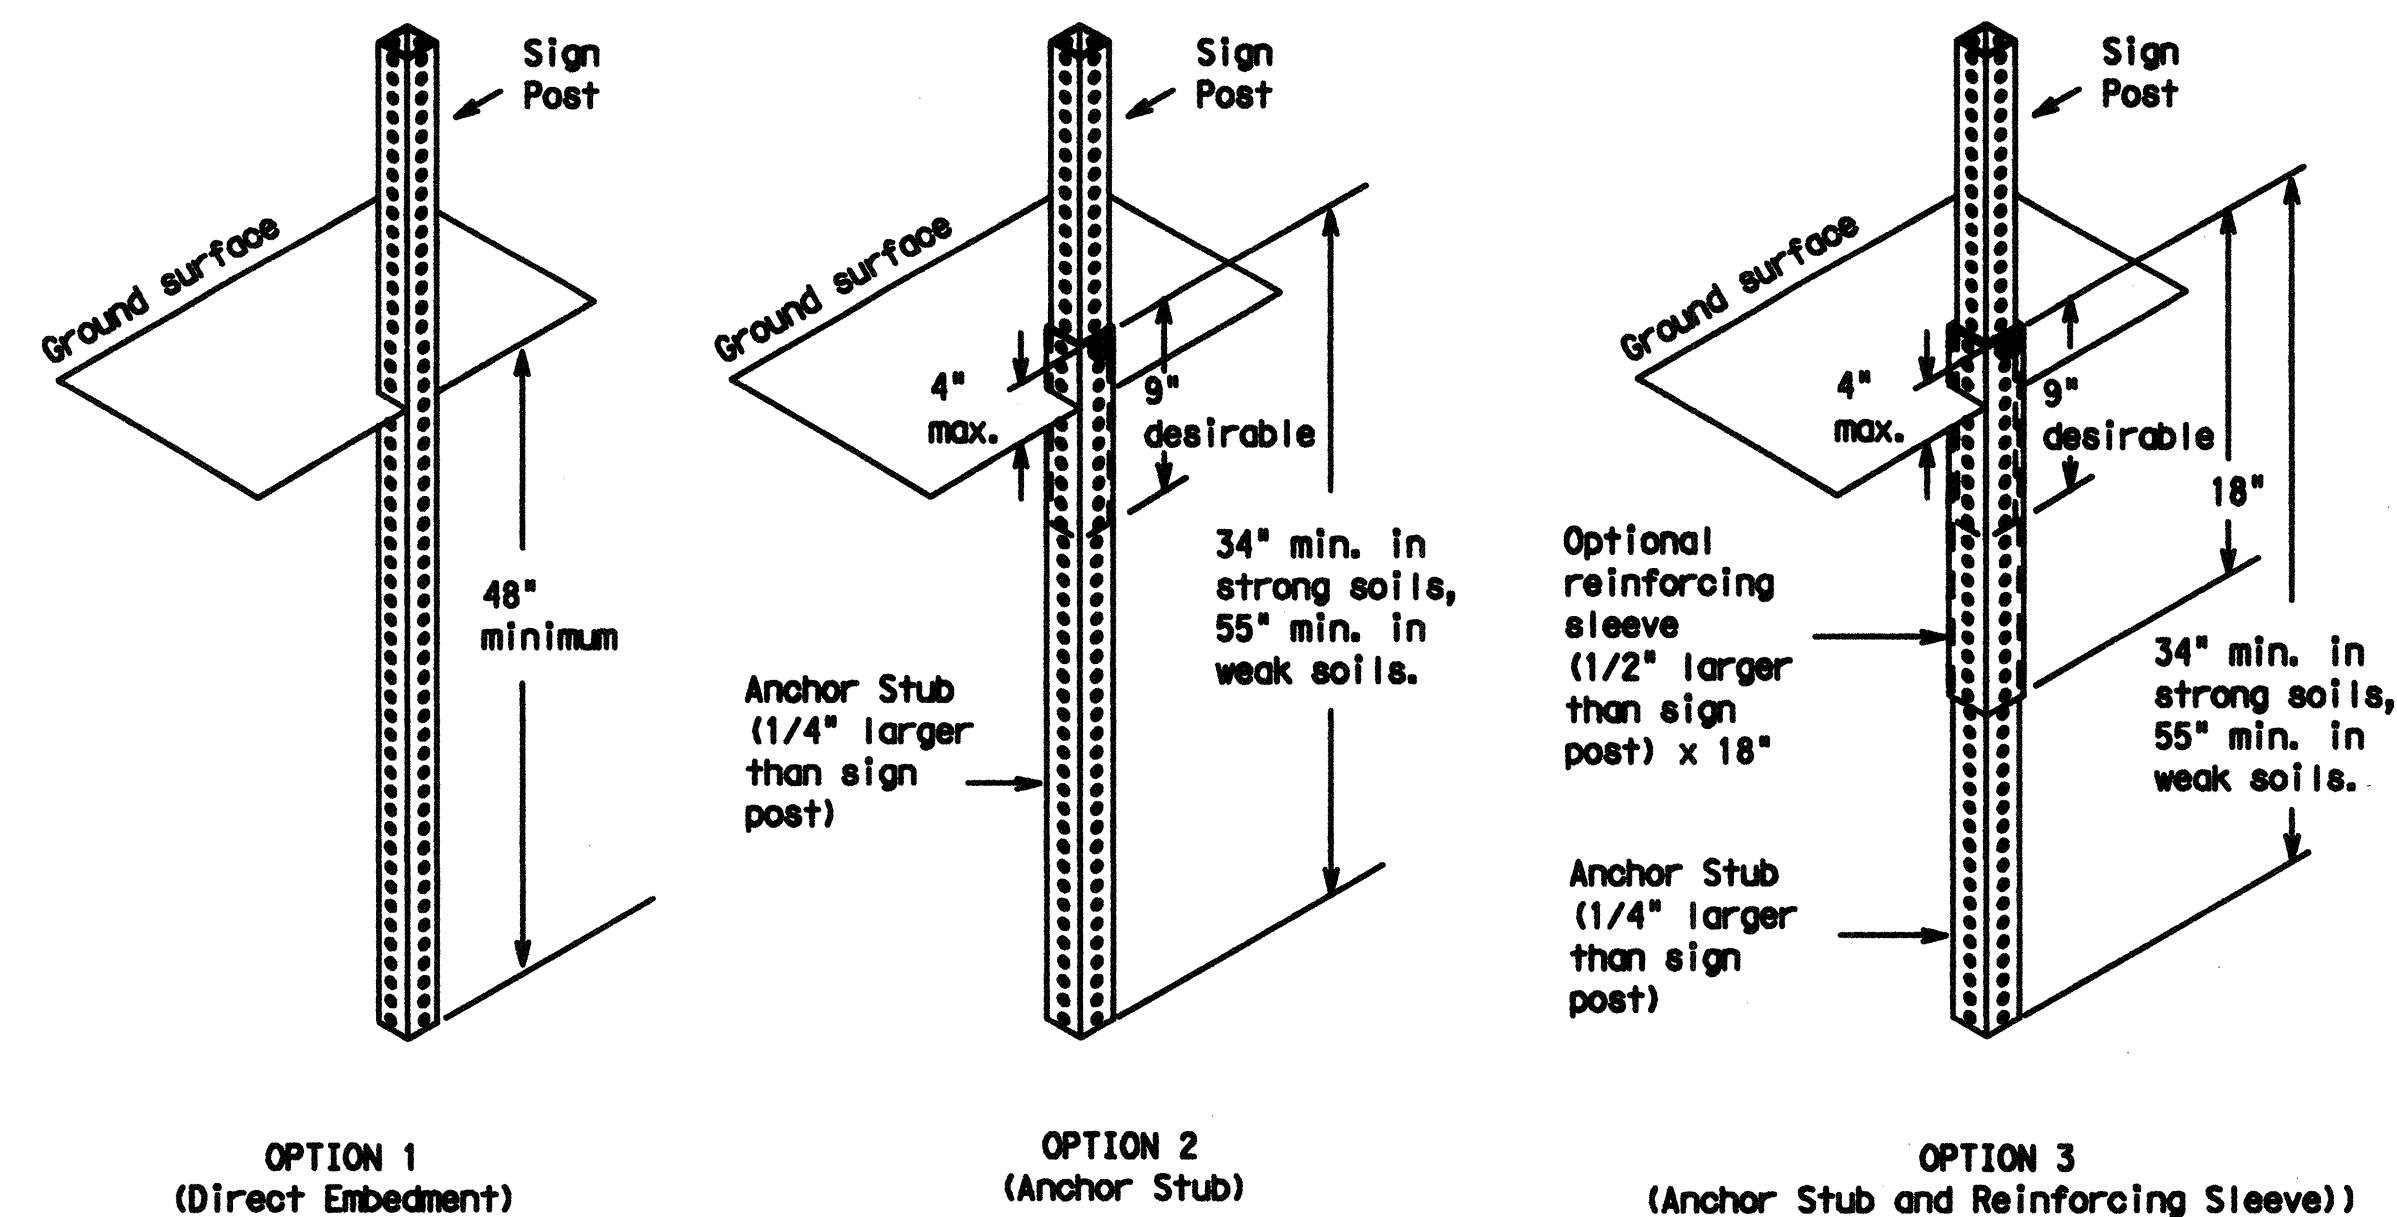

WING CHANNEL

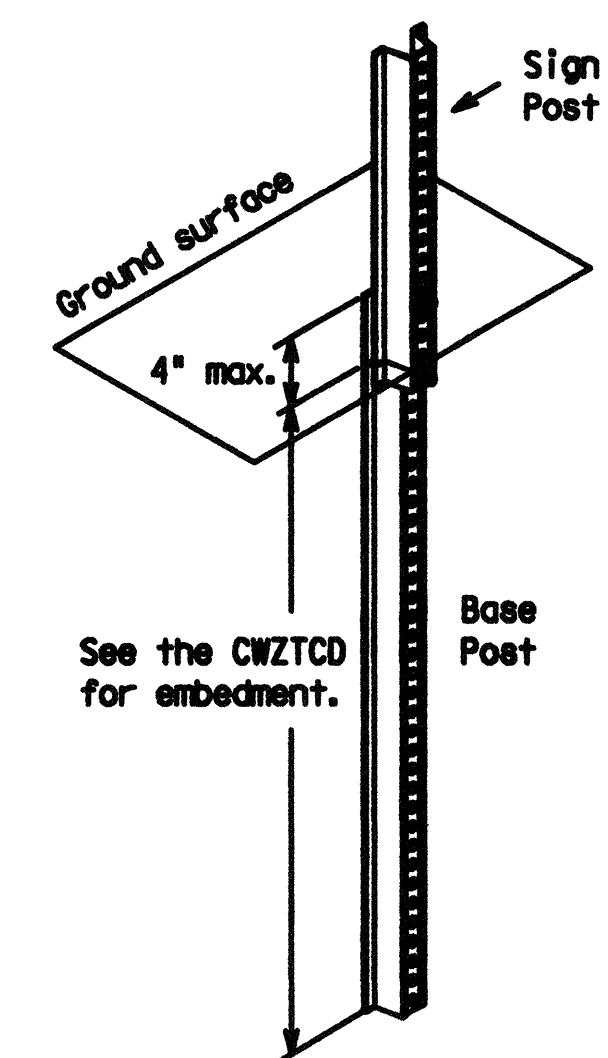

GENERAL NOTES

- Nails may be used in the assembly of wooden sign supports, but 3/8" bolts with nuts or 3/8" x 3 1/2" lag screws must be used on every joint for final connection.
- More details of approved Long/Intermediate and Short Term supports can be found on the CWZTC list. See BC(1) for website location.
- No more than 2 sign posts shall be placed within a 7 ft. circle, except for specific materials noted on the CWZTC List.
- When project is completed, all sign supports and foundations shall be removed from the project site. This will be considered subsidiary to Item 502.

□ See BC(4) for definition of "Work Duration."

✱ Wood sign posts MUST be one piece. Splicing will NOT be allowed. Posts shall be painted white.

△ See the CWZTC for the type of sign substrate that can be used for each approved sign support.

Texas Department of Transportation
 Traffic Operations Division

BARRICADE AND CONSTRUCTION TYPICAL SIGN SUPPORT STANDARD

5 of 12

BC(5)-07

© TxDOT 11-4-02	REV. TxDOT	CK1 TxDOT	CHK TxDOT	CK1 TxDOT
9-07	REVISIONS	DATE	SECT	JOB
				HIGHWAY
				SHEET NO.

The use of this standard is governed by the "Texas Engineering Practice Act". No warranty of any kind is made by TxDOT for any purpose whatsoever. TxDOT assumes no responsibility for the conversion of this standard to other formats or for incorrect results or damages resulting from its use.

DISCLAIMER:

DATE: FILE:

PORTABLE CHANGEABLE MESSAGE SIGNS

- The Engineer/Inspector shall approve all messages used on portable changeable message signs (PCMS).
- Messages on PCMS should contain no more than 8 words (about four to eight characters per word), not including simple words such as "TO," "FOR," "AT," etc.
- Messages should consist of a single phase, or two phases that alternate. Three-phase messages are not allowed. Each phase of the message should convey a single thought, and must be understood by itself.
- Use the word "EXIT" to refer to an exit ramp on a freeway; i.e., "EXIT CLOSED." Do not use the term "RAMP."
- Always use the route or interstate designation (IH, US, SH, FM) along with the number when referring to a roadway.
- When in use the bottom of a stationary PCMS message panel should be a minimum 7 feet above the roadway, where possible.
- The message term "WEEKEND" should be used only if the work is to start on Saturday morning and end by Sunday evening at midnight. Actual days and hours of work should be displayed on the PCMS if work is to begin on Friday evening and/or continue into Monday morning.
- The Engineer/Inspector may select one of two options which are available for displaying a two-phase message on a PCMS. Each phase may be displayed for either four seconds each or for three seconds each.
- Do not "flash" messages or words included in a message. The message should be steady burn or continuous while displayed.
- Do not present redundant information on a two-phase message; i.e., keeping two lines of the message the same and changing the third line.
- Do not use the word "Danger" in message.
- Do not display the message "LANES SHIFT LEFT" or "LANES SHIFT RIGHT" on a PCMS. Drivers do not understand the message.
- Do not display messages that scroll horizontally or vertically across the face of the sign.
- The following table lists abbreviated words and two-word phrases that are acceptable for use on a PCMS. Both words in a phrase must be displayed together. Words or phrases not on this list should not be abbreviated.
- PCMS character height should be at least 18 inches for trailer mounted units. They should be visible from at least 1/2 (.5) mile and the text should be legible from at least 720 feet. Truck mounted units must have a character height of 10 inches and must be legible from at least 400 feet.
- Each line of text should be centered on the message board rather than left or right justified.
- If disabled, the PCMS should default to an illegible display that will not alarm motorists and will only be used to alert workers that the PCMS has malfunctioned. A pattern such as a series of horizontal solid bars is appropriate.

Word or Phrase	Abb.	Word or Phrase	Abb.
Access Road	ACCS RD	Major	MAJ
Air Quality	AIR QLTY	Miles	MI
Alternate	ALT	Miles Per Hour	MPH
Avenue	AVE	Minor	MNR
Best Route	BEST RTE	Monday	MON
Boulevard	BLVD	Normal	NORM
Bridge	BRDG	North	N
Cannot	CANT	Northbound	(route) N
Center	CNTR	Parking	PKING
Construction Ahead	CONST AHEAD	Parking Lot	PRK LOT
Detour Route	DETOUR RTE	Road	RD
Do Not	DONT	Right Lane	RGT LN
East	E	Saturday	SAT
Eastbound	(route) E	Service Road	SERV RD
Emergency	EMER	Shoulder	SHLDR
Emergency Vehicle	EMER VEH	Slippery	SLIP
Entrance, Enter	ENT	South	S
Express Lanes	EXP LANE	Southbound	(route) S
Expressway	EXPWY	Speed	SPD
XXXX Feet	XXXX FT	Street	ST
Fog Ahead	FOG AHD	Sunday	SUN
Freeway	FRWY, FWY	Telephone	PHONE
Freeway Blocked	FWY BLKD	Temporary	TEMP
Friday	FRI	Thursday	THURS
Hazardous Driving	HAZ DRIVING	To Downtown	TO DWNTN
Hazardous Material	HAZMAT	Traffic	TRAF
High-Occupancy Vehicle	HOV	Travelers	TRVLRS
Highway	HWY	Tuesday	TUES
Hours	HR	Time Minutes	TIME MIN
Information	INFO	Upper Level	UPPR LVL
It Is	ITS	Vehicle	VEH
Junction	JCT	Warning	WARN
Left	LFT	Wednesday	WED
Left Lane	LFT LN	Weight Limit	WT LIMIT
Lane Closed	LN CLSD	West	W
Lower Level	LOWR LVL	Westbound	(route) W
Maintenance	MAINT	Wet Pavement	WET PVMT
		Will Not	WONT

Roadway designation * IH-number, US-number, SH-number, FM-number
 WHEN NOT IN USE, REMOVE THE PCMS FROM THE RIGHT-OF-WAY OR PLACE THE PCMS BEHIND BARRIER OR GUARDRAIL WITH SIGN PANEL TURNED PARALLEL TO TRAFFIC

RECOMMENDED PHASES AND FORMATS FOR PCMS MESSAGES DURING ROADWORK ACTIVITIES

(The Engineer may approve other messages not specifically covered here.)

Phase 1: Condition Lists

Road/Lane/Ramp Closure List		Other Condition List	
FREEWAY CLOSED X MILE	FRONTAGE ROAD CLOSED	ROADWORK XXX FT	ROAD REPAIRS XXXX FT
ROAD CLOSED AT SH XXX	SHOULDER CLOSED XXX FT	FLAGGER XXXX FT	LANE NARROWS XXXX FT
ROAD CLSD AT FM XXXX	RIGHT LN CLOSED XXX FT	RIGHT LN NARROWS XXXX FT	TWO-WAY TRAFFIC XX MILE
RIGHT X LANES CLOSED	RIGHT X LANES OPEN	MERGING TRAFFIC XXXX FT	CONST TRAFFIC XXX FT
CENTER LANE CLOSED	DAYTIME LANE CLOSURES	LOOSE GRAVEL XXXX FT	UNEVEN LANES XXXX FT
NIGHT LANE CLOSURES	I-XX SOUTH EXIT CLOSED	DETOUR X MILE	ROUGH ROAD XXXX FT
VARIOUS LANES CLOSED	EXIT XXX CLOSED X MILE	ROADWORK PAST SH XXXX	ROADWORK NEXT FRI-SUN
EXIT CLOSED	RIGHT LN TO BE CLOSED	BUMP XXXX FT	US XXX EXIT X MILES
MALL DRIVEWAY CLOSED	X LANES CLOSED TUE - FRI	TRAFFIC SIGNAL XXXX FT	LANES SHIFT *
XXXXXXXXX BLVD CLOSED			

* LANES SHIFT in Phase 1 must be used with STAY IN LANE in Phase 2.

Application Guidelines

- Only 1 or 2 phases are to be used on a PCMS.
- The 1st phase (or both) should be selected from the "Road/Lane/Ramp Closure List" and the "Other Condition List".
- A 2nd phase can be selected from the "Action to Take/Effect on Travel, Location, General Warning, or Advance Notice Phase Lists".
- A Location Phase is necessary only if a distance or location is not included in the first phase selected.
- If two PCMS are used in sequence, they must be separated by a minimum of 1000 ft. Each PCMS shall be limited to two phases, and should be understandable by themselves.
- For advance notice, when the current date is within seven days of the actual work date, calendar days should be replaced with days of the week. Advance notification should typically be for no more than one week prior to the work.

PCMS SIGNS WITHIN THE R.O.W. SHALL BE BEHIND GUARDRAIL OR CONCRETE BARRIER OR SHALL HAVE A MINIMUM OF FOUR (4) PLASTIC DRUMS PLACED PERPENDICULAR TO TRAFFIC ON THE UPSTREAM SIDE OF THE PCMS.

FULL MATRIX PCMS SIGNS

- When Full Matrix PCMS signs are used, the character height and legibility/visibility requirements shall be maintained as listed in Note 15 under "PORTABLE CHANGEABLE MESSAGE SIGNS" above.
- When symbol signs, such as the CW20-7a Flagger Symbol, are represented graphically on the Full Matrix PCMS sign and, with the approval of the Engineer, it shall maintain the legibility/visibility requirement listed above.
- A full matrix sign are represented graphically on the Full Matrix PCMS, they shall only supplement the use of the static sign represented, and shall not substitute for, or replace that sign.
- A full matrix PCMS may be used to simulate a flashing arrow panel provided it meets the visibility, flash rate and dimming requirements on BC(7), for the same size arrow.

Phase 2: Possible Component Lists

Action to Take/Effect on Travel List	Location List	Warning List	** Advance Notice List
MERGE RIGHT	AT FM XXXX	SPEED LIMIT XX MPH	TUE-FRI XX AM-X PM
DETOUR NEXT X EXITS	BEFORE RAILROAD CROSSING	MAXIMUM SPEED XX MPH	APR XX-X PM-X AM
USE EXIT XXX	NEXT X MILES	MINIMUM SPEED XX MPH	BEGINS MONDAY
STAY ON US XXX SOUTH	PAST US XXX EXIT	ADVISORY SPEED XX MPH	BEGINS MAY XX
TRUCKS USE US XXX N	XXXXXXXXX TO XXXXXXXX	RIGHT LANE EXIT	MAY X-X XX PM - XX AM
WATCH FOR TRUCKS	US XXX TO FM XXXX	USE CAUTION	NEXT FRI-SUN
EXPECT DELAYS		DRIVE SAFELY	XX AM TO XX PM
REDUCE SPEED XXX FT		DRIVE WITH CARE	NEXT TUE AUG XX
USE OTHER ROUTES			TONIGHT XX PM-XX AM
STAY IN LANE *			

** See Application Guidelines Note 6.

Wording Alternatives

- The words RIGHT, LEFT and ALL can be interchanged as appropriate.
- Roadway designations IH, US, SH, FM and LP can be interchanged as appropriate.
- EAST, WEST, NORTH and SOUTH (or abbreviations E, W, N and S) can be interchanged as appropriate.
- Highway names and numbers replaced as appropriate.
- ROAD, HIGHWAY and FREEWAY can be interchanged as needed.
- AHEAD may be used instead of distances if necessary.
- FT and MI, MILE and MILES interchanged as appropriate.
- AT, BEFORE and PAST interchanged as needed.
- Distances or AHEAD can be eliminated from the message if a location phase is used.

Texas Department of Transportation
Traffic Operations Division

BARRICADE AND CONSTRUCTION PORTABLE CHANGEABLE MESSAGE SIGN (PCMS) STANDARD

6 of 12 BC(6)-07

© TxDOT 11-4-02	Rev. TxDOT	Chg. TxDOT	Rev. TxDOT	Chg. TxDOT
9-07	REVISITONS	DATE	SECTION	HIGHWAY


The use of this standard is governed by the "Texas Engineering Practice Act". No warranty of any kind is made by TxDOT for any purpose whatsoever. TxDOT assumes no responsibility for the content or use of this standard or for incorrect results or damage resulting from its use.

DISCLAIMER:

BARRIER REFLECTORS FOR CONCRETE TRAFFIC BARRIER AND ATTENUATORS


- Barrier Reflectors shall be prequalified, and conform to the color and reflectivity requirements of DMS-8600. A list of prequalified Barrier Reflectors (Type C Delineators) can be found at the Material Producer List web address shown on BC(1).
- Color of Barrier Reflectors shall be as specified in the TMTUCD. The cost of the reflectors shall be considered subsidiary to Item 502.

CONCRETE TRAFFIC BARRIER (CTB)

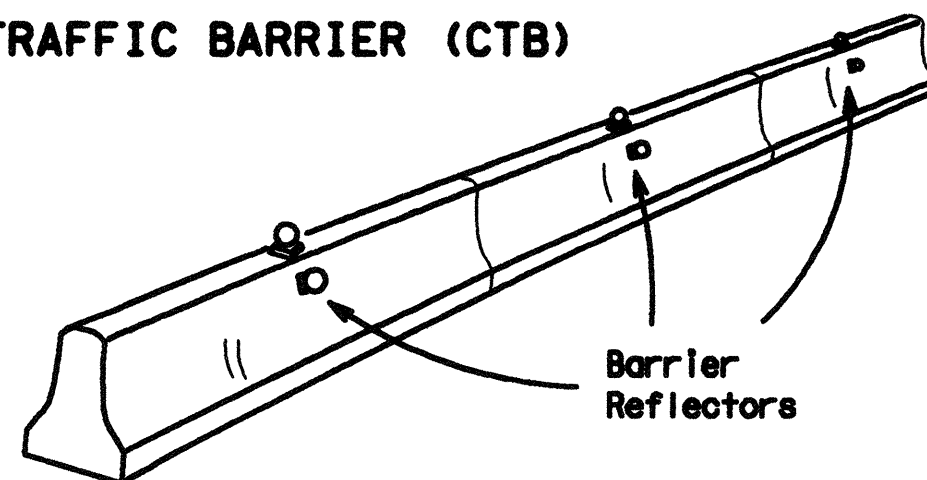


- Where traffic is on one side of the CTB, two (2) Barrier Reflectors shall be mounted in approximately the midsection of each section of CTB. An alternate mounting location is uniformly spaced at one end of each CTB. This will allow for attachment of a barrier grapple without damaging the reflector. The Barrier Reflector mounted on the side of the CTB shall be located directly below the reflector mounted on top of the barrier, as shown in the detail above.
- Where CTB separates two-way traffic, three barrier reflectors shall be mounted on each section of CTB. The reflector unit on top shall have two yellow reflective faces (Bi-Directional) while the reflectors on each side of the barrier shall have one yellow reflective face, as shown in the detail above.
- When CTB separates traffic traveling in the same direction, no barrier reflectors will be required on top of the CTB.
- Barrier Reflector units shall be yellow or white in color to match the edgeline being supplemented. Yellow Barrier Reflectors shall be made with Type E Fluorescent Prismatic Yellow Retroreflective Sheeting. White reflectors shall be made with Type D White Prismatic sheeting.
- Maximum spacing of Barrier Reflectors is forty (40) feet.
- Pavement markers or temporary flexible-reflective roadway marker tabs shall NOT be used as CTB delineation.
- Attachment of Barrier Reflectors to CTB shall be per manufacturer's recommendations.
- Missing or damaged Barrier Reflectors shall be replaced as directed by the Engineer.
- Single slope barriers shall be delineated as shown on the above detail.

LOW PROFILE CONCRETE BARRIER (LPCB)

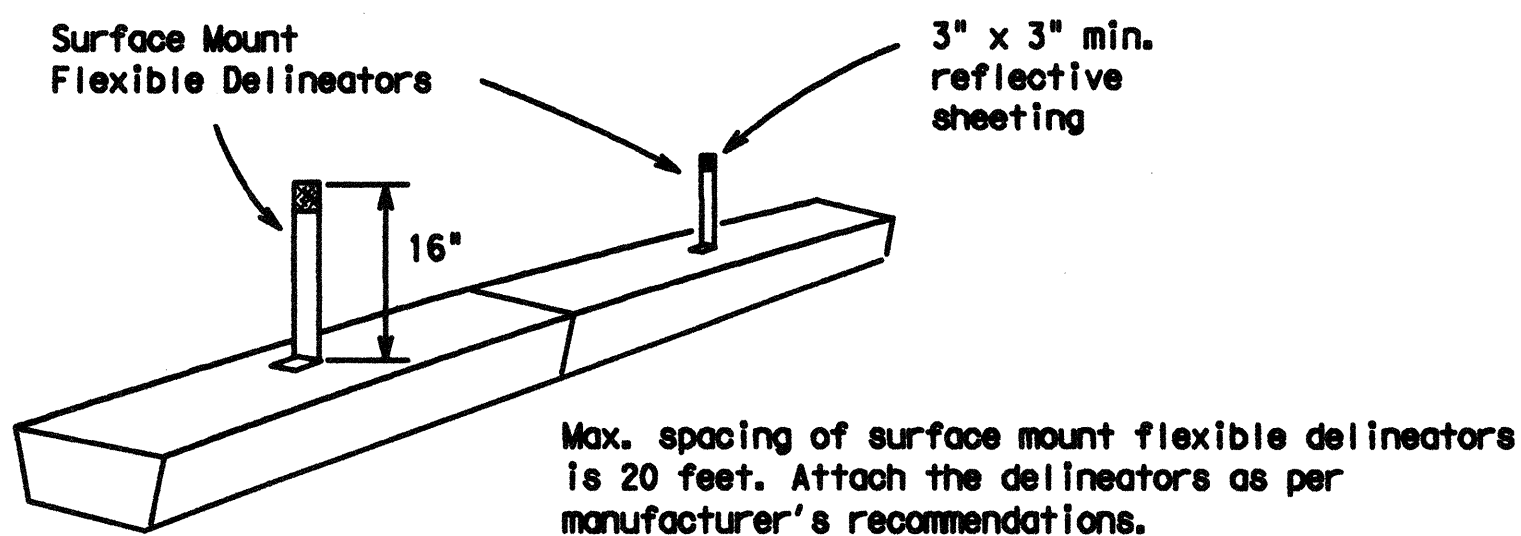

DELINEATION OF END TREATMENTS

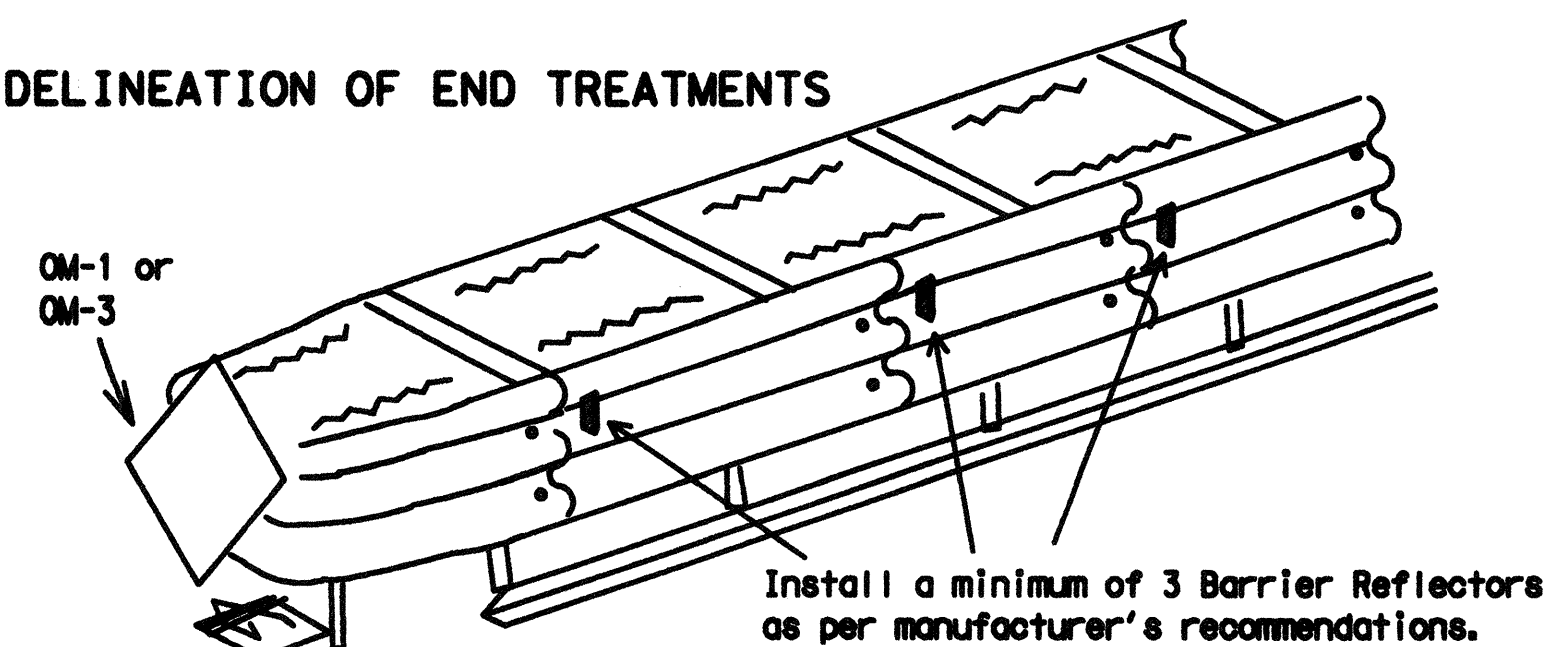


DELINEATION	APPROACHING TRAFFIC	
	BOTH SIDES	ONE SIDE
	OM-1	OM-3 or Vertical Panel

END TREATMENTS FOR CTB'S USED IN WORK ZONES



End treatments used on CTB's in work zones shall meet crashworthy standards as defined in the National Cooperative Highway Research Report 350. Refer to the CWZTCD List for approved end treatments and manufacturers.

TYPICAL FLASHING ARROW PANEL

Arrow Panels may be located behind channelizing devices in place for a shoulder taper or merging taper, otherwise they shall be delineated with four (4) channelizing devices placed perpendicular to traffic on the upstream side of traffic.

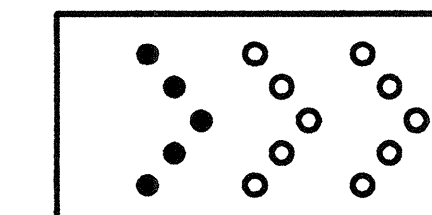


Sequential Chevron

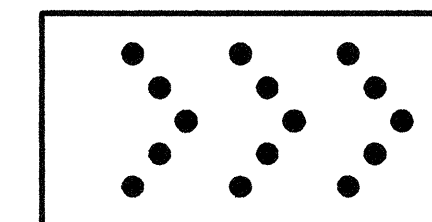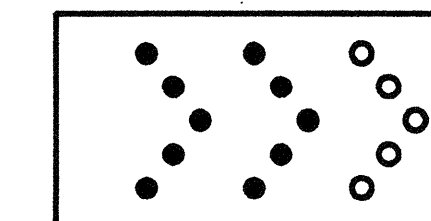


- The Flashing Arrow Panel should be used for all lane closures on multi-lane roadways, or slow moving maintenance or construction activities on the travel lanes.
- Flashing Arrow Panels should not be used on two-lane, two-way roadways, detours, diversions or work on shoulders unless the "CAUTION" display (see detail below) is used.
- The Engineer/Inspector shall choose all appropriate signs, barricades and/or other traffic control devices that should be used in conjunction with the Flashing Arrow Panel.
- The Flashing Arrow Panel should be able to display the following symbols:


Flashing RIGHT (LEFT) ARROW

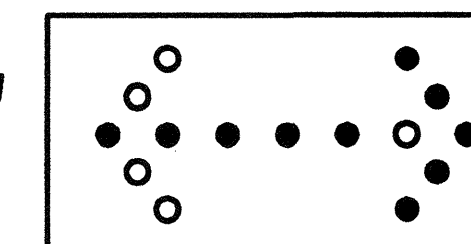

Flashing DOUBLE ARROW

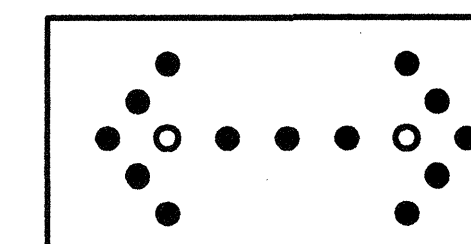

Flashing CAUTION

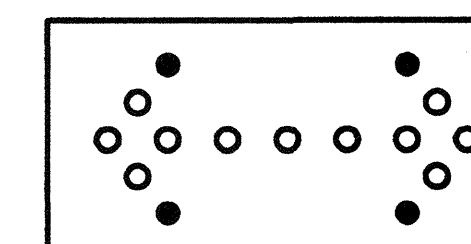

REQUIREMENTS

TYPE	MINIMUM SIZE	MINIMUM NUMBER OF PANEL LAMPS	MINIMUM VISIBILITY DISTANCE
B	30 x 60	13	3/4 mile
C	48 x 96	15	1 mile


ATTENTION: Flashing Arrow Panels shall be equipped with automatic dimming devices.

WHEN NOT IN USE, REMOVE THE ARROW PANEL FROM THE RIGHT-OF-WAY OR PLACE THE ARROW PANEL BEHIND CONCRETE TRAFFIC BARRIER OR GUARDRAIL.


- The "CAUTION" display consists of four corner lamps flashing simultaneously.
- The straight line caution display is NOT ALLOWED.
- The Flashing Arrow Panel shall be capable of minimum 50 percent dimming from rated lamp voltage. The flashing rate of the lamps shall not be less than 25 nor more than 40 flashes per minute.
- Minimum lamp "on time" shall be approximately 50 percent for the flashing arrow and equal intervals of 25 percent for each sequential phase of the flashing chevron.
- The sequential arrow display is NOT ALLOWED.
- The flashing arrow display is the TxDOT standard; however, the sequential Chevron display may be used during daylight operations.

- The Flashing Arrow Panel shall be mounted on a vehicle, trailer or other suitable support.
- A Flashing Arrow Panel SHALL NOT BE USED to laterally shift traffic.
- A full matrix PCMS may be used to simulate a Flashing Arrow Panel provided it meets visibility, flash rate and dimming requirements on this sheet for the same size arrow.
- Minimum mounting height of trailer mounted arrow panels should be 7 feet from roadway to bottom of panel.

WARNING LIGHTS

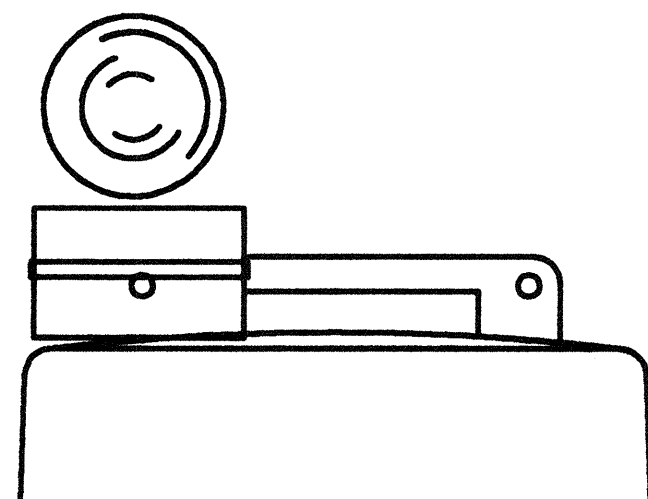

Type C Warning Light or approved substitute mounted adjacent to the travel way.

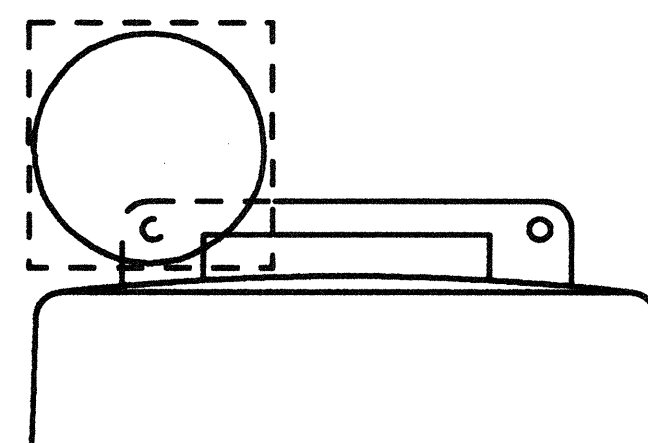

Warning reflector may be round or square. Must have a reflective surface area of at least 30 square inches.

- Warning lights shall meet the requirements of the TMTUCD.
- Warning lights shall NOT be installed on barricades.
- Type A-Low Intensity Flashing Warning Lights are commonly used with drums. They are intended to warn of or mark a potentially hazardous area. Their use shall be as indicated on this sheet and/or other sheets of the plans by the designation "FL". The Type A Warning Lights shall not be used with signs manufactured with Type E Sheeting (Fluorescent Prismatic) meeting the requirements of Departmental Material Specification DMS-8300.
- Type-C and Type D 360 degree Steady Burn Lights are intended to be used in a series for delineation to supplement other traffic control devices. Their use shall be as indicated on this sheet and/or other sheets of the plans by the designation "SB".
- The Engineer/Inspector or the plans shall specify the location and type of warning lights to be installed on the traffic control devices.
- When required by the Engineer, the Contractor shall furnish a copy of the warning lights certification. The warning light manufacturer will certify the warning lights meet the requirements of the latest ITE Purchase Specifications for Flashing and Steady-Burn Warning Lights.
- When used to delineate curves, Type-C and Type D Steady Burn Lights should only be placed on the outside of the curve, not the inside.

WARNING LIGHTS MOUNTED ON PLASTIC DRUMS

- Type A flashing warning lights are intended to warn drivers that they are approaching or are in a potentially hazardous area.
- Type A random flashing warning lights are not intended for delineation and shall not be used in a series.
- A series of sequential flashing warning lights placed on channelizing devices to form a merging taper may be used for delineation. If used, the successive flashing of the sequential warning lights should occur from the beginning of the taper to the end of the merging taper in order to identify the desired vehicle path. The rate of flashing for each light shall be 65 flashes per minute, plus or minus 10 flashes.
- Type C and D steady-burn warning lights are intended to be used in a series to delineate the edge of the travel lane on detours, on lane changes, on lane closures, and on other similar conditions.
- Type A, Type C and Type D warning lights shall be installed at locations as detailed on other sheets in the plans.
- Warning lights shall not be installed on a drum that has a sign, chevron or vertical panel.
- The maximum spacing for warning lights on drums should be identical to the channelizing device spacing.

WARNING REFLECTORS MOUNTED ON PLASTIC DRUMS AS A SUBSTITUTE FOR TYPE C (STEADY BURN) WARNING LIGHTS

- A warning reflector or approved substitute may be mounted on a plastic drum as a substitute for a Type C, steady burn warning light at the discretion of the Contractor unless otherwise noted in the plans.
- The warning reflector shall be yellow in color and shall be manufactured using a sign substrate approved for use with plastic drums listed on the CWZTCD.
- The warning reflector shall have a minimum retroreflective surface area (one-side) of 30 square inches.
- Round reflectors shall be fully reflectorized, including the area where attached to the drum.
- Square substrates must have a minimum of 30 square inches of reflectorized sheeting. They do not have to be reflectorized where it attaches to the drum.
- The side of the warning reflector facing approaching traffic shall have sheeting meeting the color and retroreflectivity requirements for DMS 8300-Type D (Non-fluorescent Prismatic).
- When used near two-way traffic, both sides of the warning reflector shall be reflectorized.
- The warning reflector should be mounted on the side of the handle nearest approaching traffic.
- The maximum spacing for warning reflectors should be identical to the channelizing device spacing requirements.

TRUCK-MOUNTED ATTENUATORS

- Truck-mounted attenuators (TMA) used on TxDOT facilities must meet the requirements outlined in the National Cooperative Highway Research Report No. 350 (NCHRP 350).
- Refer to the CWZTCD for the requirements of Level 2 or Level 3 TMAs.
- Refer to the dates shown in the CWZTCD to ensure that the TMA meets the age requirements and the crashworthiness criteria established by the Federal Highway Administration (FHWA) for TMAs.
- Refer to the CWZTCD for a list of approved TMAs.
- TMAs are required on freeways unless otherwise noted in the plans.
- A TMA should be used anytime that it can be positioned approximately 30 to 100 feet in advance of the area of crew exposure without adversely affecting the work performance.
- The only reason a TMA should not be required is when a work area is spread down the roadway and the work crew is an extended distance from the TMA.



BARRICADE AND CONSTRUCTION ARROW PANEL, REFLECTORS, WARNING LIGHTS & ATTENUATOR STANDARD

7 of 12


BC(7)-07

REV	DATE	BY	CHKD	REVISIONS
9-07	11-4-02			

The use of this standard is governed by the "Texas Engineering Practice Act". No warranty of any kind is made by TxDOT for any purpose whatsoever. TxDOT assumes no responsibility for the consequences of any use of this standard or for incorrect results or damages resulting from its use.

DISCLAIMER:

DATE:
FILE:

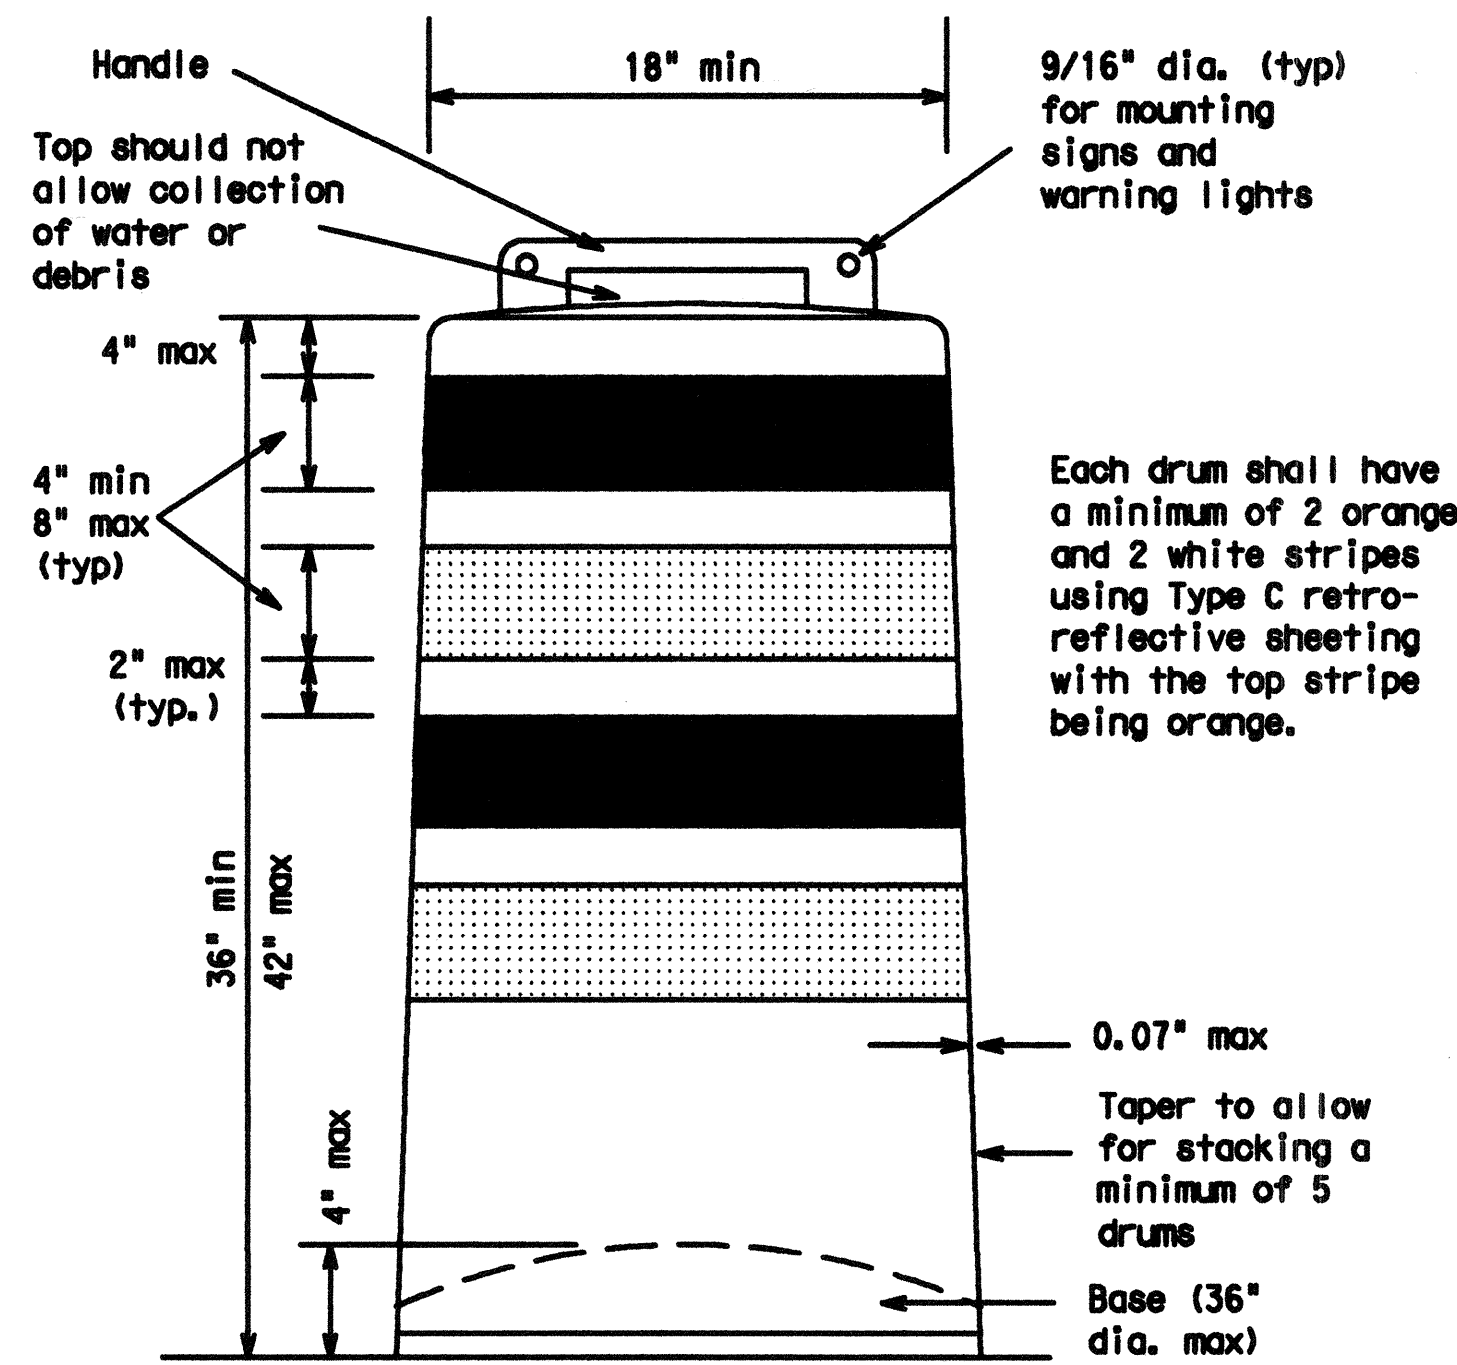

GENERAL NOTES

- For long term stationary work zones on freeways, drums shall be used as the primary channelizing device.
- For intermediate term stationary work zones on freeways, drums should be used as the primary channelizing device but may be replaced in tangent sections by vertical panels, or 42" two-piece cones. In tangent sections one-piece cones may be used with the approval of the Engineer but only if personnel are present on the project at all times to maintain the cones in proper position and location.
- For short term stationary work zones on freeways, drums are the preferred channelizing device but may be replaced in tapers, transitions and tangent sections by vertical panels, two-piece cones or one-piece cones as approved by the Engineer.
- Drums and all related items shall comply with the requirements of the current version of the "Texas Manual on Uniform Traffic Control Devices" (TMUTCD) and the "Compliant Work Zone Traffic Control Devices List" (CWZTCD).
- Drums, bases, and related materials shall exhibit good workmanship and shall be free from objectionable marks or defects that would adversely affect their appearance or serviceability.
- The Contractor shall have a maximum of 24 hours to replace any plastic drums identified for replacement by the Engineer/Inspector. The replacement device must be an approved device.

GENERAL DESIGN REQUIREMENTS

Prequalified plastic drums shall meet the following requirements:

- Plastic drums shall be a two-piece design; the "body" of the drum shall be the top portion and the "base" shall be the bottom.
- The body and base shall lock together in such a manner that the body separates from the base when impacted by a vehicle traveling at a speed of 20 MPH or greater but prevents accidental separation due to normal handling and/or air turbulence created by passing vehicles.
- Plastic drums shall be constructed of lightweight flexible, and deformable materials. The Contractor shall NOT use metal drums or single piece plastic drums as channelization devices or sign supports.
- Drums shall present a profile that is a minimum of 18 inches in width at the 36 inch height when viewed from any direction. The height of drum unit (body installed on base) shall be a minimum of 36 inches and a maximum of 42 inches.
- The top of the drum shall have a built-in handle for easy pickup and shall be designed to drain water and not collect debris. The handle shall have a minimum of two widely spaced 9/16 inch diameter holes to allow attachment of a warning light, warning reflector unit or approved compliant sign.
- The exterior of the drum body shall have a minimum of four alternating orange and white retroreflective circumferential stripes not less than 4 inches nor greater than 8 inches in width. Any non-reflectORIZED space between any two adjacent stripes shall not exceed 2 inches in width.
- Bases shall have a maximum width of 36 inches, a maximum height of 4 inches, and a minimum of two footholds of sufficient size to allow base to be held down while separating the drum body from the base.
- Plastic drums shall be constructed of ultra-violet stabilized, orange, high-density polyethylene (HDPE) or other approved material.


- Drum body shall have a minimum unballasted weight of 7.7 lbs. and maximum unballasted weight of 11 lbs. The wall of the drum body shall be a minimum of 0.07 inch in thickness. Weight of any drum supplied shall not vary more than 0.5 lb. from that of the prequalified sample.
- Drum and base shall be marked with manufacturer's name and model number.

RETROREFLECTIVE SHEETING

- The stripes used on drums shall be constructed of sheeting meeting the color and retroreflectivity requirements of Departmental Materials Specification DMS-8300, "Flat Surface Reflective Sheeting." High Specific Intensity (Type C) retroreflective sheeting shall be supplied unless otherwise specified in the plans.
- The sheeting shall be suitable for use on and shall adhere to the drum surface such that, upon vehicular impact, the sheeting shall remain adhered in-place and exhibit no delaminating, cracking, or loss of retroreflectivity other than that loss due to abrasion of the sheeting surface.


BALLAST

- Unballasted bases shall be large enough to hold up to 50 lbs. of sand. This base, when filled with the ballast material, should weigh between 35 lbs (minimum) and 50 lbs (maximum). The ballast may be sand in one to three sandbags separate from the base, sand in a sand-filled plastic base, or other ballasting devices as approved by the Engineer. Stacking of sandbags will be allowed, however height of sandbags above pavement surface may not exceed 12 inches.
- Bases with built-in ballast shall weigh between 40 lbs. and 50 lbs. Built-in ballast can be constructed of an integral crumb rubber base or a solid rubber base.
- The ballast shall not be heavy objects, water, or any material that would become hazardous to motorists, pedestrians, or workers when the drum is struck by a vehicle.
- When used in regions susceptible to freezing, drums shall have drainage holes in the bottoms so that water will not collect and freeze becoming a hazard when struck by a vehicle.
- Ballast shall not be placed on top of drums.
- Adhesives may be used to secure base of drums to pavement.

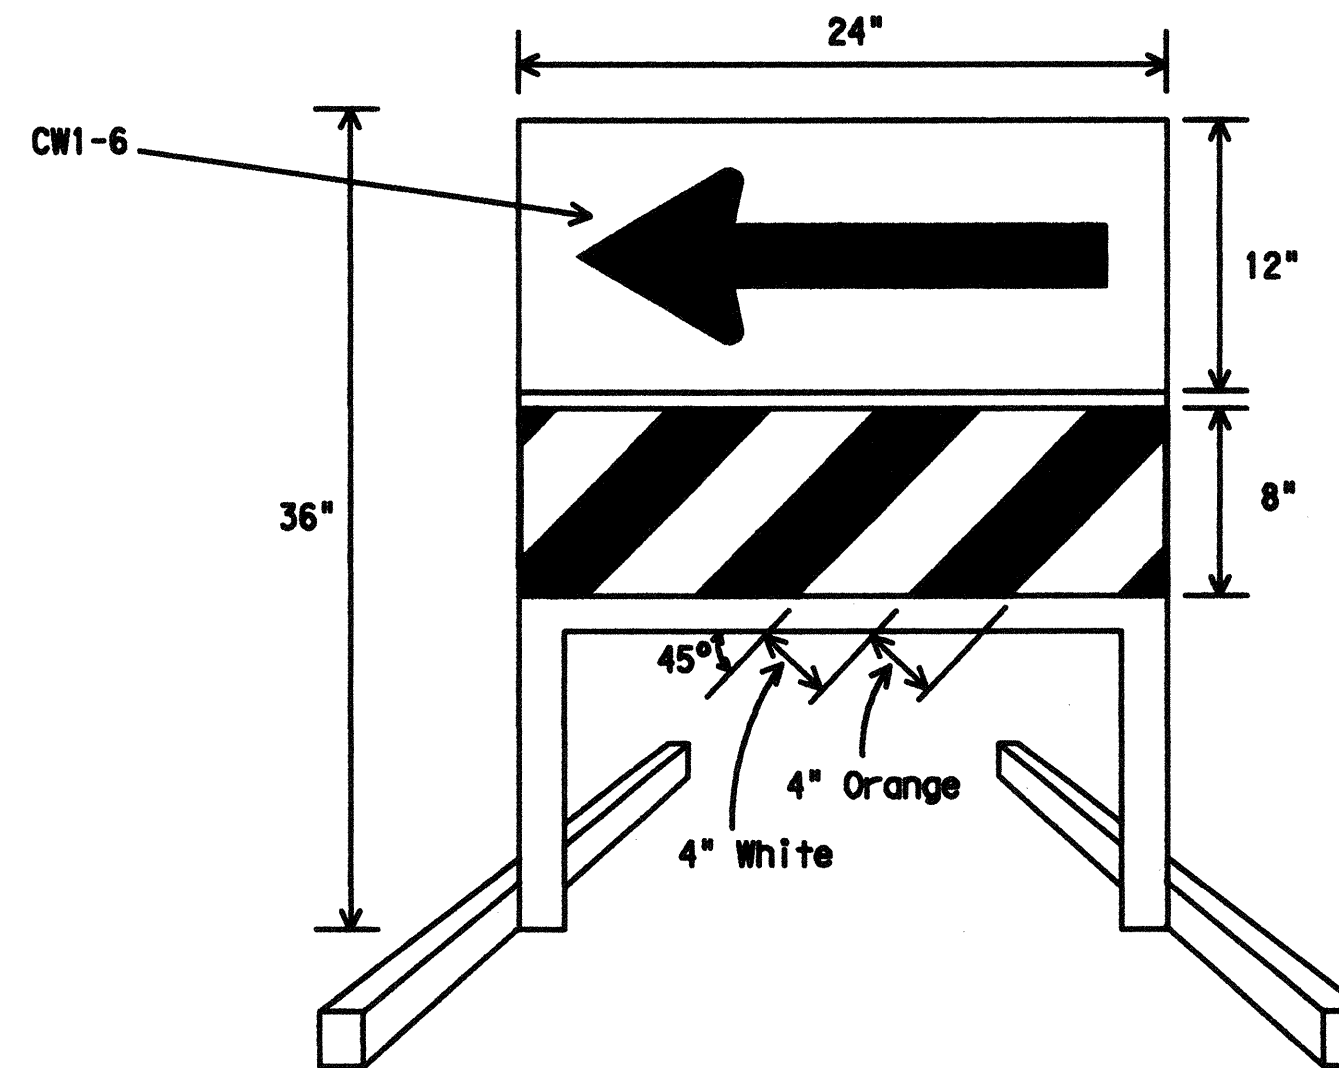


DIRECTION INDICATOR BARRICADE

- The Direction Indicator Barricade may be used in tapers, transitions, and other areas where specific directional guidance to drivers is necessary.
- If used, the Direction Indicator Barricade should be used in series to direct the driver through the transition and into the intended travel lane.
- The Direction Indicator Barricade shall consist of One-Direction Large Arrow (CW1-6) sign in the size shown with a black arrow on a background of Type E Fluorescent Prismatic Orange above a rail with Type C High Specific Intensity retroreflective sheeting in alternation 4" white and orange stripes sloping downward at an angle of 45 degrees in the direction road users are to pass.
- Double arrows on the Direction Indicator Barricade will not be allowed.
- Approved manufacturers are shown on the CWZTCD List. Ballast shall be as approved by the manufacturers instructions.

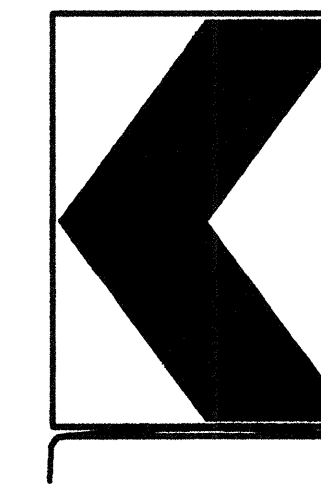

18" x 24" Sign
(Maximum Sign Dimension)
Chevron CW1-8, Opposing Traffic Lane Divider, Driveway sign D70a, Keep Right R4 series or other signs as approved by Engineer

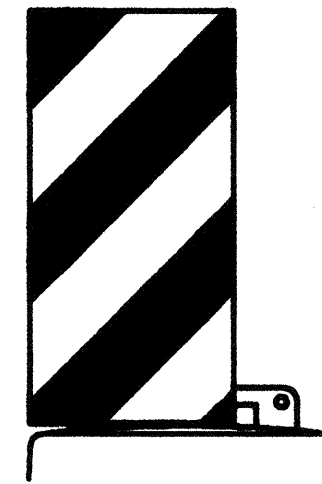

12" x 24" Vertical Panel
mount with diagonal stripes sloping down towards travel way

Plywood, Aluminum or Metal sign substrates shall NOT be used on plastic drums

SIGNS, CHEVRONS, AND VERTICAL PANELS MOUNTED ON PLASTIC DRUMS

- Signs used on plastic drums shall be manufactured using substrates listed on the CWZTCD.
- Chevrons and other work zone signs with an orange background shall be manufactured with Type E (Fluorescent Prismatic) sheeting meeting the color and retroreflectivity requirements of DMS-8300, "Sign Face Material," unless otherwise specified in the plans.
- Vertical Panels shall be manufactured with orange and white sheeting meeting the requirements of DMS-8300 Type C (High Specific Intensity). Diagonal stripes on Vertical Panels shall slope down toward the intended traveled lane.
- Other sign messages (text or symbolic) may be used as approved by the Engineer. Sign dimensions shall not exceed 18 inches in width or 24 inches in height.
- Signs shall be installed using a 1/2 inch bolt (nominal) and nut, two washers, and one locking washer for each connection.
- Mounting bolts and nuts shall be fully engaged and adequately torqued. Bolts should not extend more than 1/2 inch beyond nuts.
- Chevrons may be placed on drums on the outside of curves, on merging tapers or on shifting tapers. When used in these locations they may be placed on every drum or spaced not more than on every third drum. A minimum of three (3) should be used at each location called for in the plans.
- R9-9, R9-10, R9-11 and R9-11a Sidewalk Closed signs which are 24 inches wide may be mounted on plastic drums, with approval of the Engineer.



BARRICADE AND CONSTRUCTION CHANNELIZING DEVICES STANDARD

8 of 12



BC(8)-07

© TxDOT 11-4-02	REVISED	DATE	BY	DESCRIPTION
4-03	9-07			
		DIST	COUNTY	SHEET NO.

The use of this standard is governed by the "Texas Engineering Practice Act". No warranty of any kind is made by TxDOT for any purpose whatsoever. TxDOT assumes no responsibility for the conversion of this standard to other formats or for inaccuracies or damages resulting from its use.


DISCLAIMER:

CHANNELIZING DEVICES

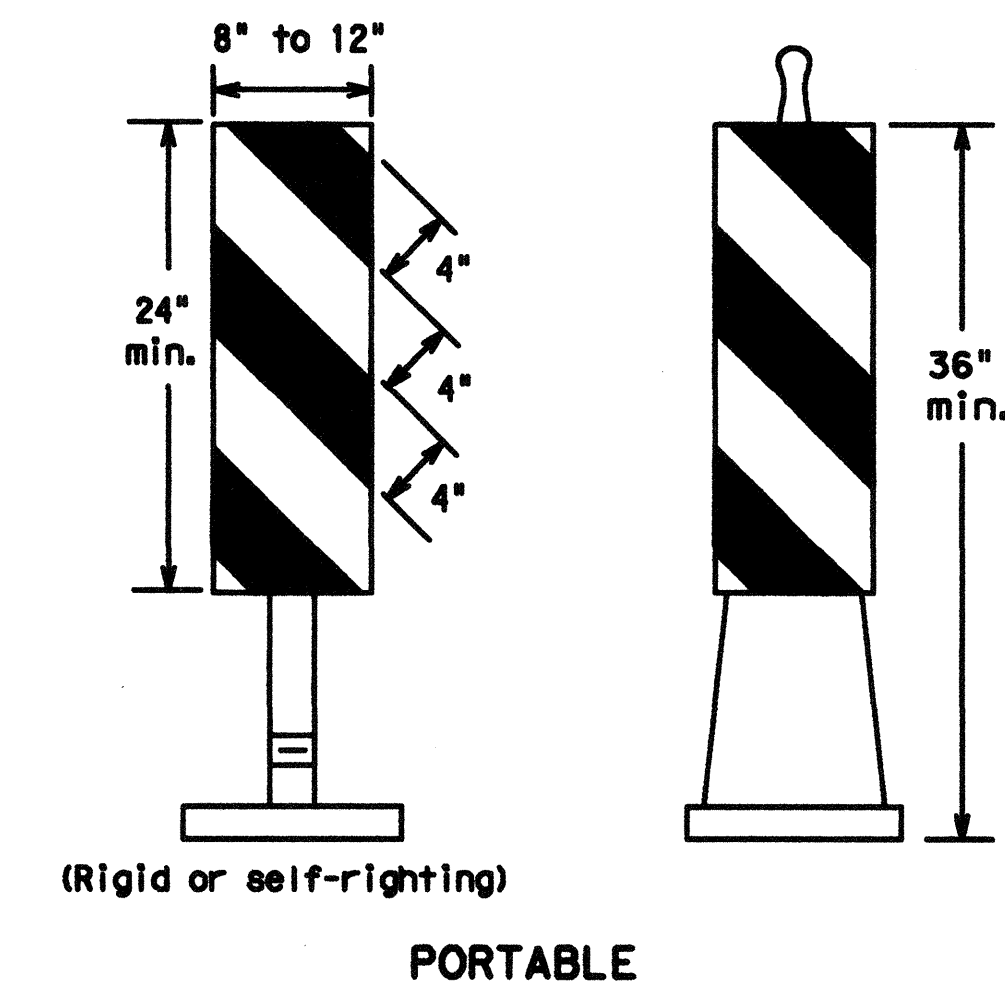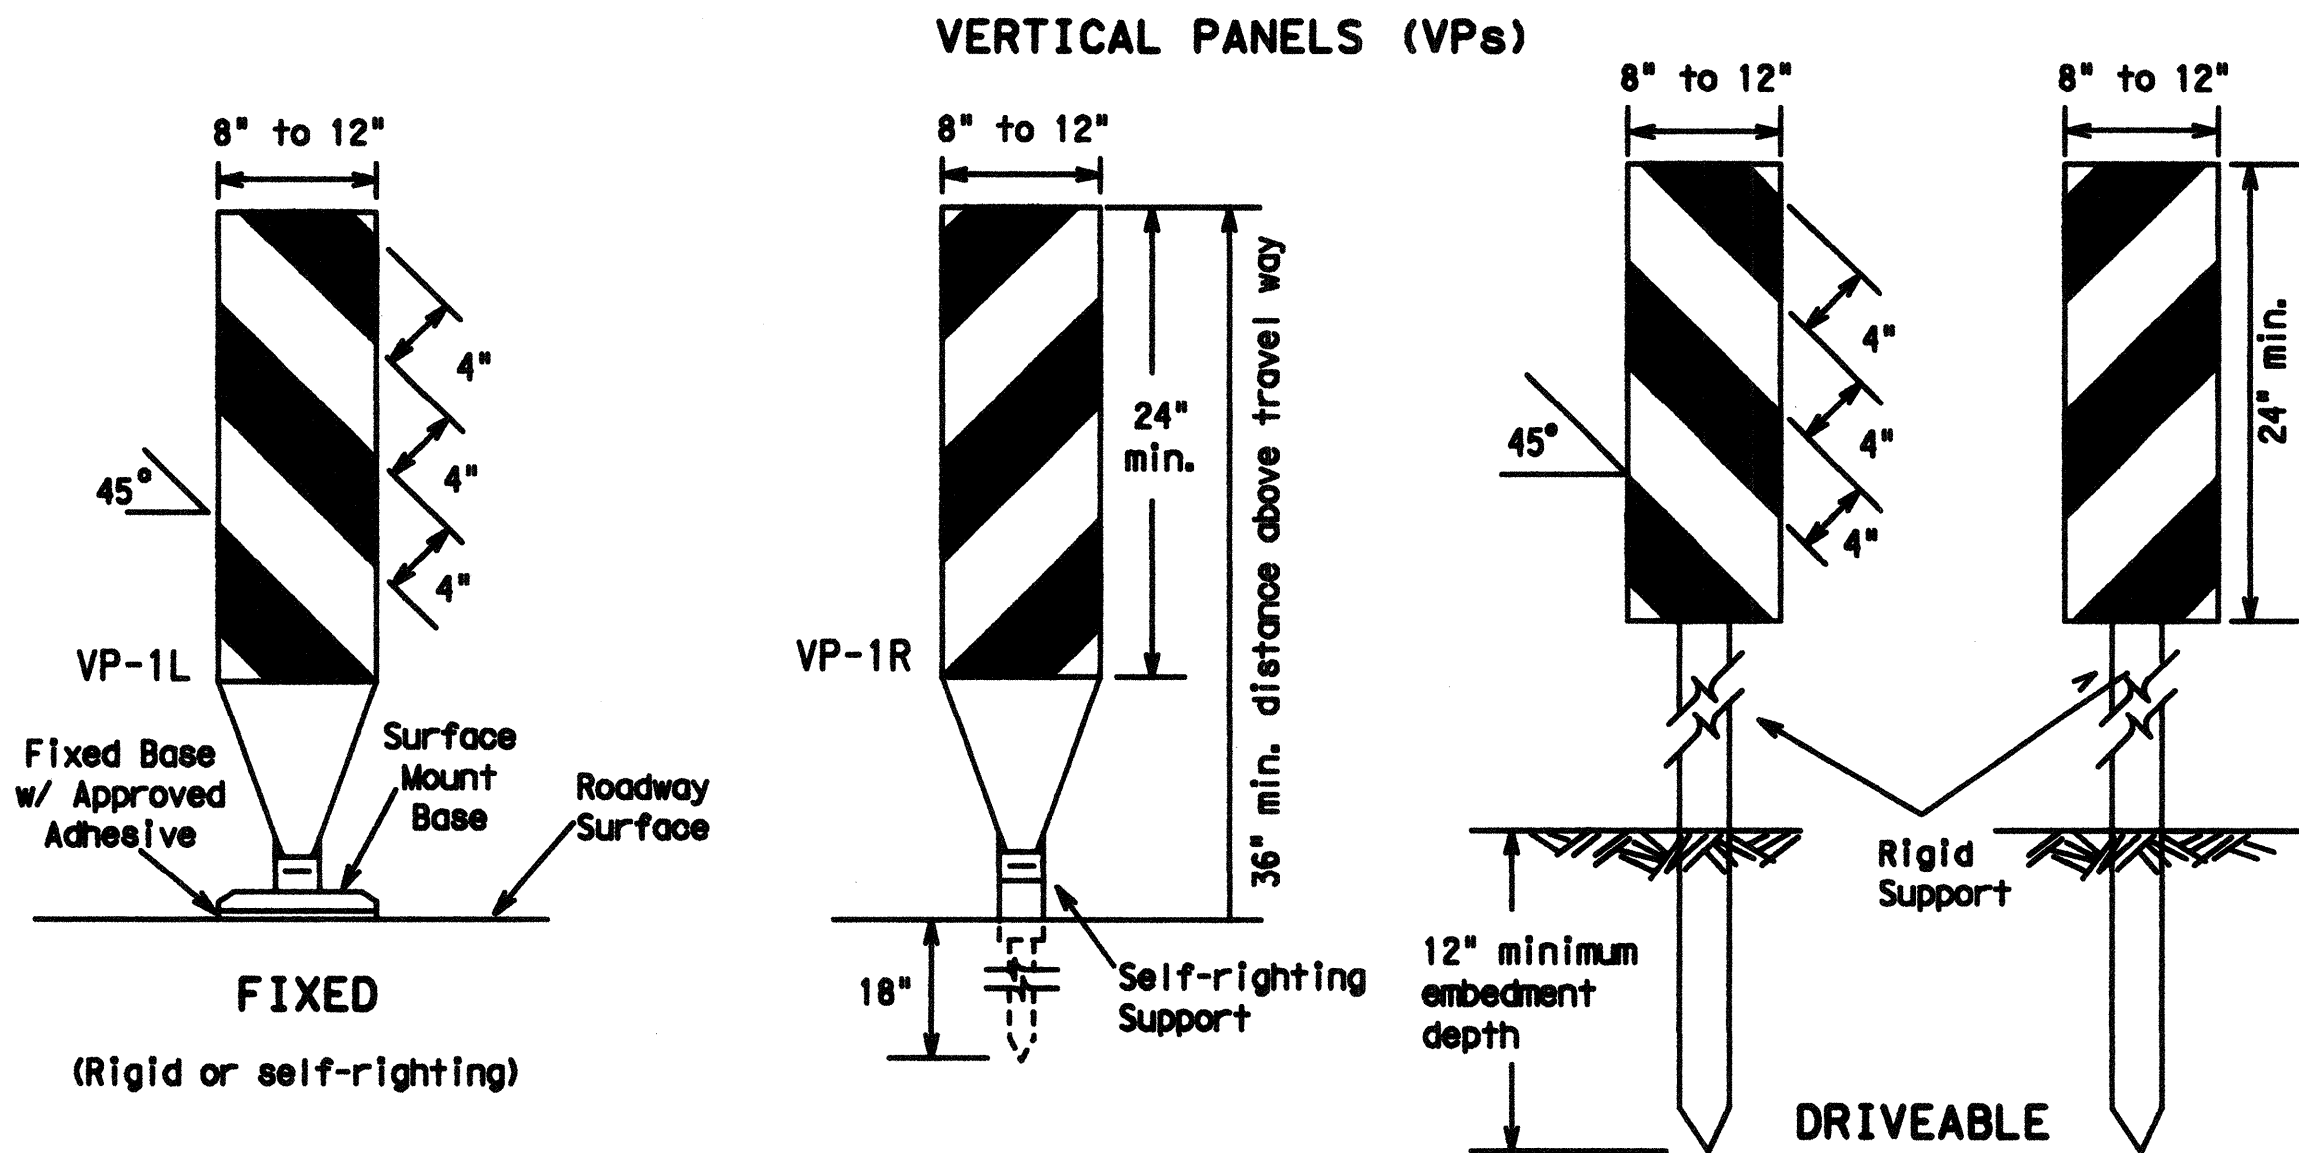

- Vertical Panels (VP's) are normally used to channelize traffic or divide opposing lanes of traffic.
- VP's may be used in daytime or nighttime situations. They may be used at the edge of shoulder drop-offs and other areas such as lane transitions where positive daytime and nighttime delineation is required. The Engineer/Inspector shall refer to the Roadway Design Manual Appendix B "Treatment of Pavement Drop-offs in Work Zones" for additional guidelines on the use of VP's for drop-offs.
- VP's should be mounted back to back if used at the edge of cuts adjacent to two-way lane roadways. Stripes are to be reflective orange and reflective white and should always slope downward toward the travel lane.
- VP's used on expressways and freeways or other high speed roadways, shall have a minimum of 270 square inches of retroreflective area facing traffic.
- Self-righting supports are available with portable base. See "Compliant Work Zone Traffic Control Devices List" (CWZTCD).
- Sheeting for the VP's shall be retroreflective Type C (High Specific Intensity) conforming to Departmental Material Specification DMS-8300, unless noted otherwise.
- Where the height of reflective material on the vertical panel is greater than 36 inches, a panel stripe of 6 inches shall be used.

CHEVRONS

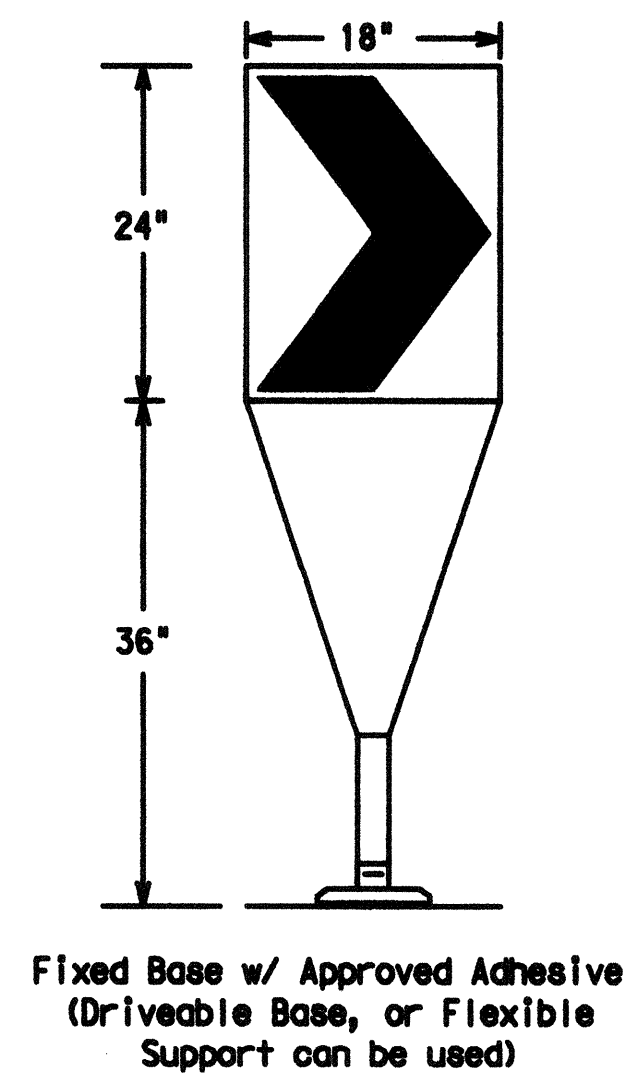


- The chevron shall be a vertical rectangle with a minimum size of 12 by 18 inches.
- Chevrons are intended to give notice of a sharp change of alignment with the direction of travel and provide additional emphasis and guidance for vehicle operators with regard to changes in horizontal alignment of the roadway.
- Chevrons, when used, shall be erected on the outside of a sharp curve or turn, or on the far side of an intersection. They shall be in line with and at right angles to approaching traffic. Spacing should be such that the motorist always has three in view, until the change in alignment eliminates its need.
- To be effective, the chevron should be visible for at least 500 feet.
- Chevrons shall be orange with a black nonreflective legend. Sheeting for the chevron shall be retroreflective Type E (Fluorescent Prismatic) conforming to Departmental Material Specification DMS-8300, unless noted otherwise. The legend shall be black vinyl non-reflective decal sheeting meeting the requirements of DMS-8300.
- For Long Term Stationary use on tapers or transitions on freeways and divided highways self-righting chevrons may be used to supplement plastic drums but not to replace plastic drums.

GENERAL NOTES:

- Work Zone channelizing devices illustrated on this sheet may be installed in close proximity to traffic and are suitable for use on high or low speed roadways. The Engineer/Inspector shall ensure that spacing and placement is uniform and in accordance with the "Texas Manual on Uniform Traffic Control Devices" (TMUTCD).
- Channelizing devices shown on this sheet may have a driveable, fixed or portable base. The requirement for self-righting channelizing devices must be specified in the General Notes or other plan sheets.
- Channelizing devices on self-righting supports should be used in work zone areas where channelizing devices are frequently impacted by errant vehicles or vehicle related wind gusts making alignment of the channelizing devices difficult to maintain. Locations of these devices shall be detailed elsewhere in the plans. These devices shall conform to the TMUTCD and the "Compliant Work Zone Traffic Control Devices List" (CWZTCD).
- The Contractor shall maintain devices in a clean condition and replace damaged, nonreflective, faded, or broken devices and bases as required by the Engineer/Inspector. The Contractor shall be required to maintain proper device spacing and alignment.
- Portable bases shall be fabricated from virgin and/or recycled rubber. The portable bases shall weigh approximately 35 lbs.
- Pavement surfaces shall be prepared in a manner that ensures proper bonding between the adhesives, the fixed mount bases and the pavement surface. Adhesives shall be prepared and applied according to the manufacturer's recommendations.
- The installation and removal of channelizing devices shall not cause detrimental effects to the final pavement surfaces, including pavement surface discoloration or surface integrity. Driveable bases shall not be permitted on final pavement surfaces. The Engineer/Inspector shall approve all application and removal procedures of fixed bases.
- Examples on this sheet are commonly used channelizing devices in work zones. For other devices, refer to the CWZTCD.

OPPOSING TRAFFIC LANE DIVIDERS (OTLD)

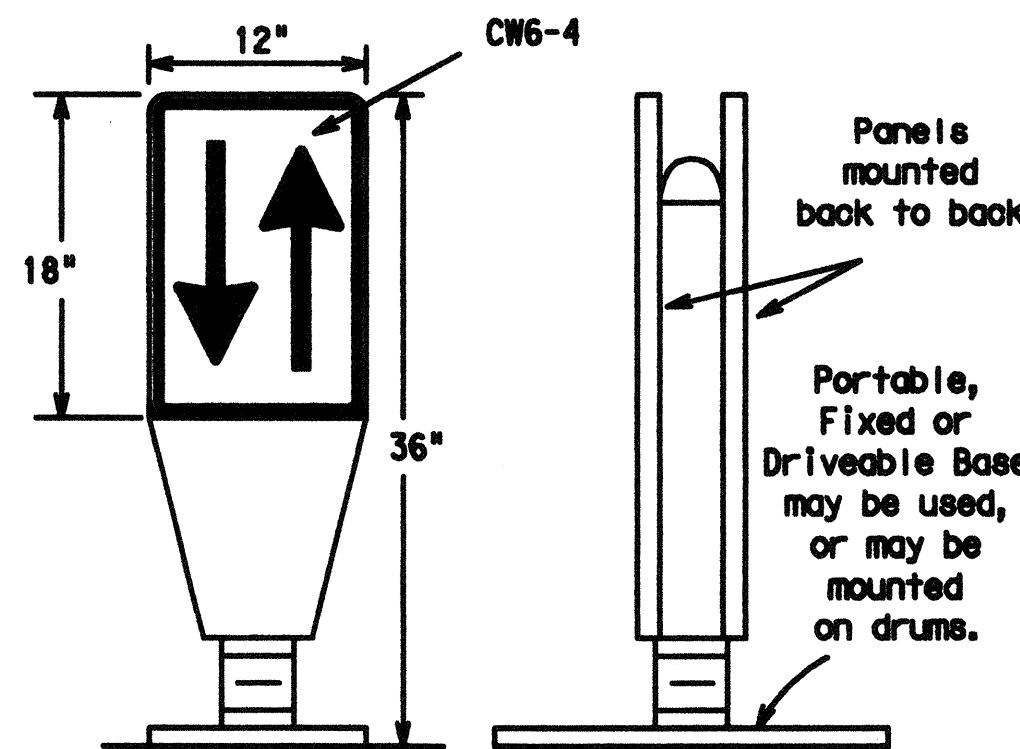


- Opposing Traffic Lane Dividers (OTLD) are delineation devices designed to convert a normal one-way roadway section to two-way operation. OTLD's are used on temporary centerlines. The upward and downward arrows on the sign's face indicate the direction of traffic on either side of the divider. The base is secured to the pavement with an adhesive or rubber weight to minimize movement caused by a vehicle impact or wind gust.
- The OTLD may be used in combination with simple tubular markers or VPs.
- Spacing between the OTLD shall not exceed 500 feet. Tubular markers or VPs placed between the OTLD's should not exceed 100 foot spacing.
- The OTLD shall be orange with a black non-reflective legend. Sheeting for the OTLD shall be retroreflective Type E (Fluorescent Prismatic) conforming to Departmental Material Specification DMS-8300, unless noted otherwise. The legend shall be black vinyl non-reflective decal sheeting meeting the requirements of DMS-8300.

Posted Speed	Formula	Minimum Desirable Taper Lengths *X*			Suggested Maximum Spacing of Channelizing Devices	
		10' Offset	11' Offset	12' Offset	On a Taper	On a Tangent
30	$L = \frac{WS^2}{60}$	150'	165'	180'	30'	60' - 75'
35		205'	225'	245'	35'	70' - 90'
40	L=WS	265'	295'	320'	40'	80' - 100'
45		450'	495'	540'	45'	90' - 110'
50		500'	550'	600'	50'	100' - 125'
55		550'	605'	660'	55'	110' - 140'
60		600'	660'	720'	60'	120' - 150'
65		650'	715'	780'	65'	130' - 165'
70		700'	770'	840'	70'	140' - 175'
75		750'	825'	900'	75'	150' - 185'
80	800'	880'	960'	80'	160' - 195'	

X Taper lengths have been rounded off.
 L=Length of Taper (FT.) W=Width of Offset (FT.)
 S=Posted Speed (MPH)

HOLLOW OR WATER BALLASTED SYSTEMS USED AS LONGITUDINAL CHANNELIZING DEVICES OR BARRIERS

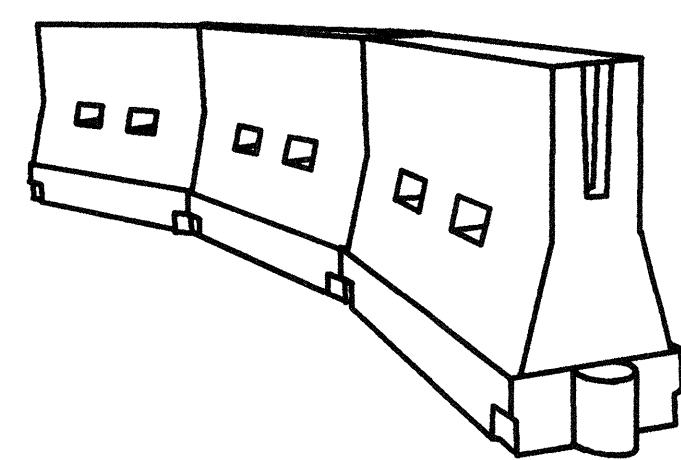

LONGITUDINAL CHANNELIZING DEVICES


- Longitudinal channelizing devices are crashworthy, lightweight, deformable devices that are highly visible, have good target value and can be connected together. They are not designed to contain or redirect a vehicle on impact.
- Longitudinal channelizing devices may be used instead of a line of cones or drums.
- Longitudinal channelizing devices shall be placed in accordance to application and installation requirements specific to the device, and used only when shown on the CWZTCD list.
- Longitudinal channelizing devices should not be used to provide positive protection for obstacles, pedestrians or workers.
- Longitudinal channelizing devices shall be retroreflective, or supplemented with retroreflective delineation as required for temporary barriers on BC(7)-07.

WATER BALLASTED SYSTEMS USED AS BARRIERS

- Water ballasted systems used as barriers shall not be used solely to channelize road users, but also to protect the work space per the appropriate NCHRP 350 crashworthiness requirements based on roadway speed and barrier application.
- Water ballasted systems used to channelize vehicular traffic shall be supplemented with retroreflective delineation or channelizing devices to improve daytime/nighttime visibility. They may also be supplemented with pavement markings.
- Water ballasted systems used as barriers shall be placed in accordance to application and installation requirements specific to the device, and used only when shown on the CWZTCD list.
- Water ballasted systems used as barriers should not be used for a merging taper except in low speed (less than 45 MPH) urban areas. When used on a taper in a low speed urban area, the taper shall be delineated and the taper length should be designed to optimize road user operations considering the available geometric conditions.
- When water ballasted systems used as barriers have blunt ends exposed to traffic, they should be attenuated as per manufacturer recommendations or flared to point outside the clear zone.

If used to channelize pedestrians, longitudinal channelizing devices or water ballasted systems must have a continuous detectable bottom for users of long canes and the top of the unit shall be not less than 32 inches in height.

VERTICAL PANELS & OPPOSING TRAFFIC LANE DIVIDERS SEPARATING TWO-WAY TRAFFIC (Typical application)

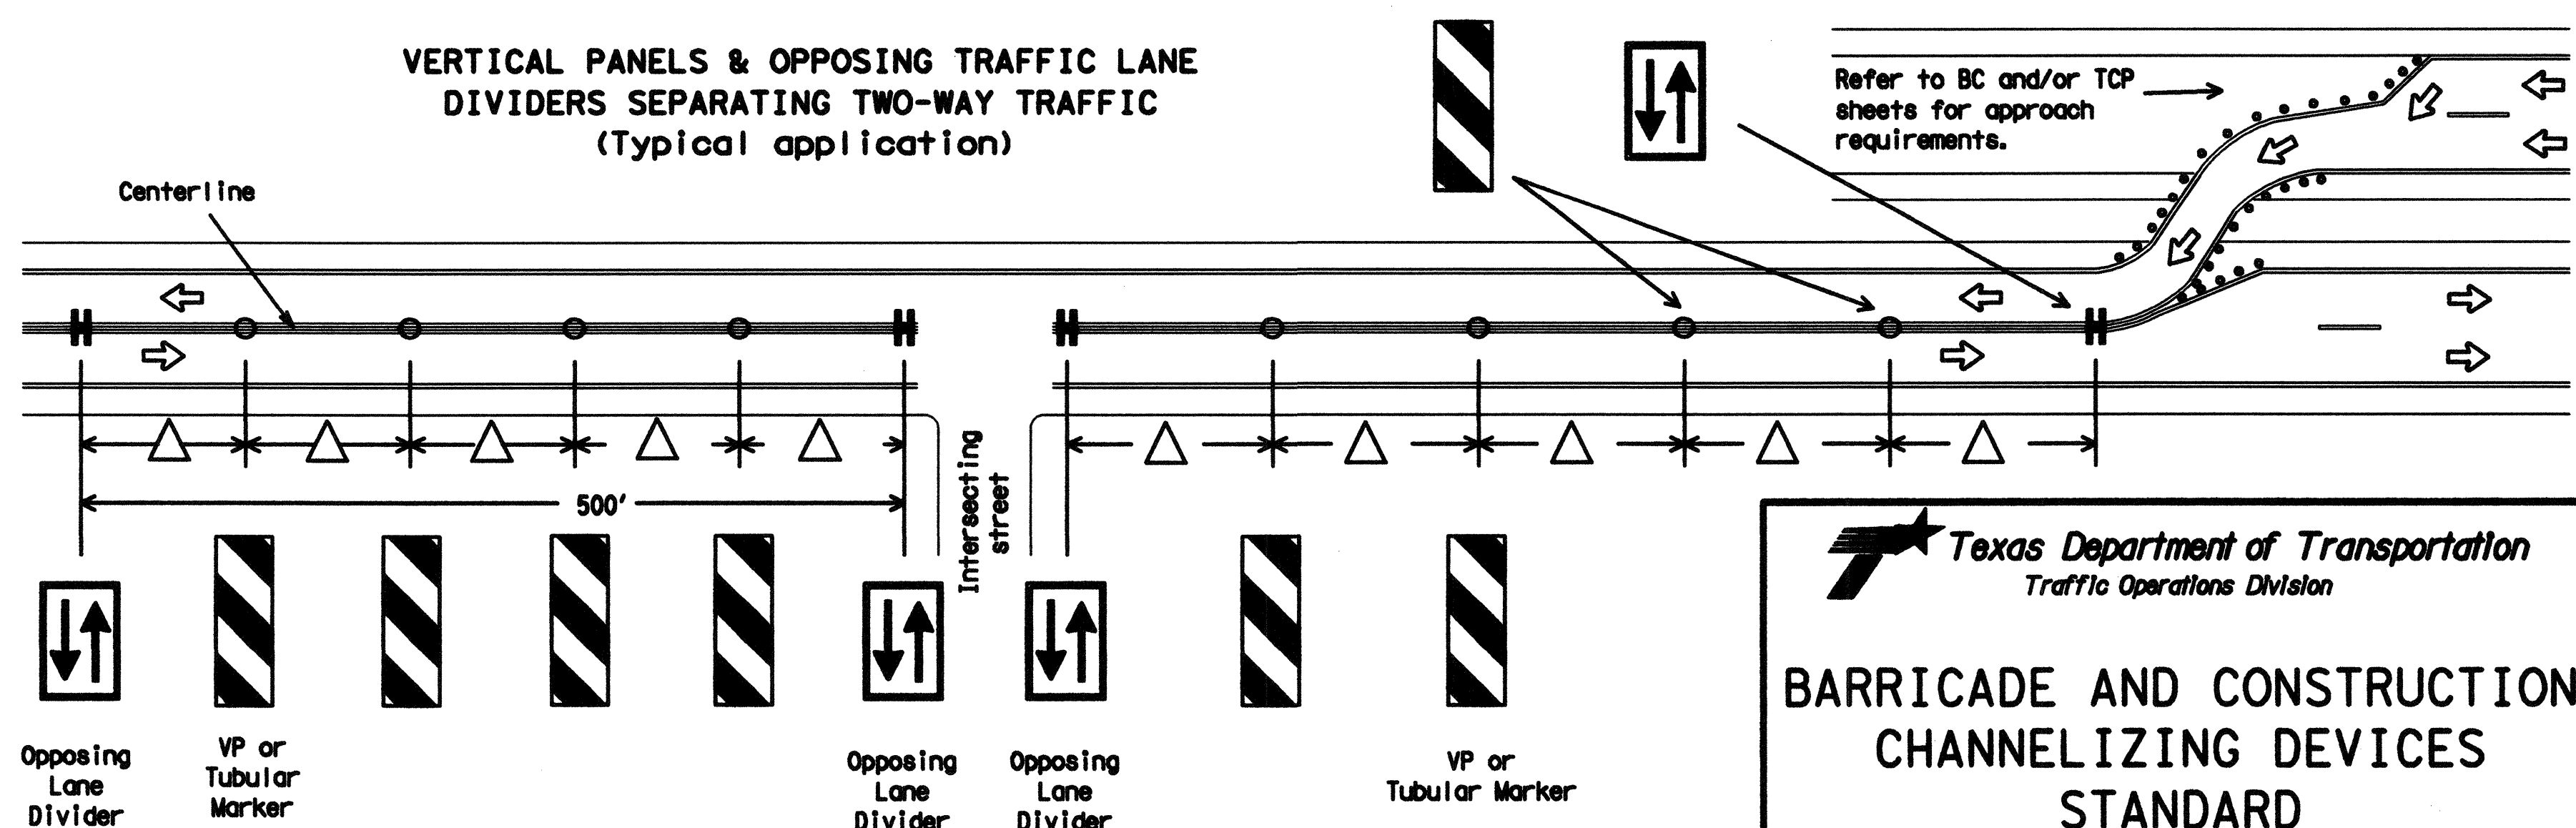

△ Spacing between the VP's or tubular markers shall not exceed 100 feet. On roadways with speeds less than 45 MPH, spacing between the tubular markers or VP's shall be as shown on the channelizing spacing table shown on this page. If the table shows spacing greater than 100 feet based on the roadway speed, then use a maximum of 100 feet spacing between the tubular markers or VP's. Every fifth channelizing device shall be an OTLD, except when the OTLD must be spaced closer to accommodate an intersection. Spacing between the OTLD shall not exceed 500 feet.

Texas Department of Transportation

 Traffic Operations Division

BARRICADE AND CONSTRUCTION CHANNELIZING DEVICES STANDARD

9 of 12 BC(9)-07

© TxDOT 11-4-02	01/1 TxDOT	02/1 TxDOT	03/1 TxDOT	04/1 TxDOT
9-07	REVISIONS	01/1 TxDOT	02/1 TxDOT	03/1 TxDOT
	DATE	SECTION	JOB	HIGHWAY
			COUNTY	SHEET NO.

DATE: FILE:

The use of this standard is governed by the "Texas Engineering Practice Act". No warranty of any kind is made by TxDOT for any purpose whatsoever. TxDOT assumes no responsibility for the consequences of any failure to follow the provisions of this standard or for incorrect results or damages resulting from its use.


DISCLAIMER:

TYPE III BARRICADES


1. Refer to the Compliant Work Zone Traffic Control Devices List (CWZTCD) for details of the Type III Barricades and a list of all materials used in the construction of Type III Barricades.
2. Type III Barricades shall be used at each end of construction projects closed to all traffic.
3. Barricades extending across a roadway should have stripes that slope downward in the direction toward which traffic must turn in detouring. When both right and left turns are provided, the chevron striping may slope downward in both directions from the center of the barricade. Where no turns are provided at a closed road striping should slope downward in both directions toward the center of roadway.
4. Striping of rails, for the right side of the roadway, should slope downward to the left. For the left side of the roadway, striping should slope downward to the right.
5. Identification markings may be shown only on the back of the barricade rails. The maximum height of letters and/or company logos used for identification shall be 1".
6. Barricades shall not be placed parallel to traffic unless an adequate clear zone is provided.
7. Warning lights shall NOT be installed on barricades.
8. Where barricades require the use of weights to keep from turning over, the use of sandbags with dry, cohesionless sand is recommended. The sandbags will be tied shut to keep the sand from spilling and to maintain a constant weight. Sand bags shall not be stacked in a manner that covers any portion of a barricade rails reflective sheeting. Rock, concrete, iron, steel or other solid objects will NOT be permitted. Sandbags should weigh a minimum of 35 lbs and a maximum of 50 lbs. Sandbags shall be made of a durable material that tears upon vehicular impact. Rubber (such as tire inner tubes) shall not be used for sandbags. Sandbags shall only be placed along or upon the base supports of the device and shall not be suspended above ground level or hung with rope, wire, chains or other fasteners.
9. Sheeting for barricades shall be retroreflective Type C (High Specific Intensity) conforming to Departmental Material Specification DMS-8300 unless otherwise noted.

Barricades shall NOT be used as a sign support.


TYPICAL STRIPING DETAIL FOR BARRICADE RAIL

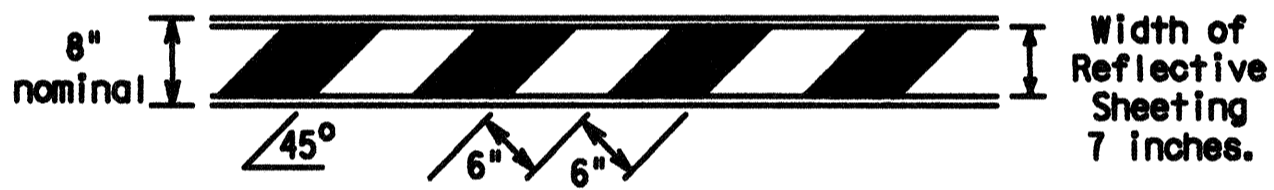


TYPICAL PANEL DETAIL FOR SKID OR POST TYPE BARRICADES

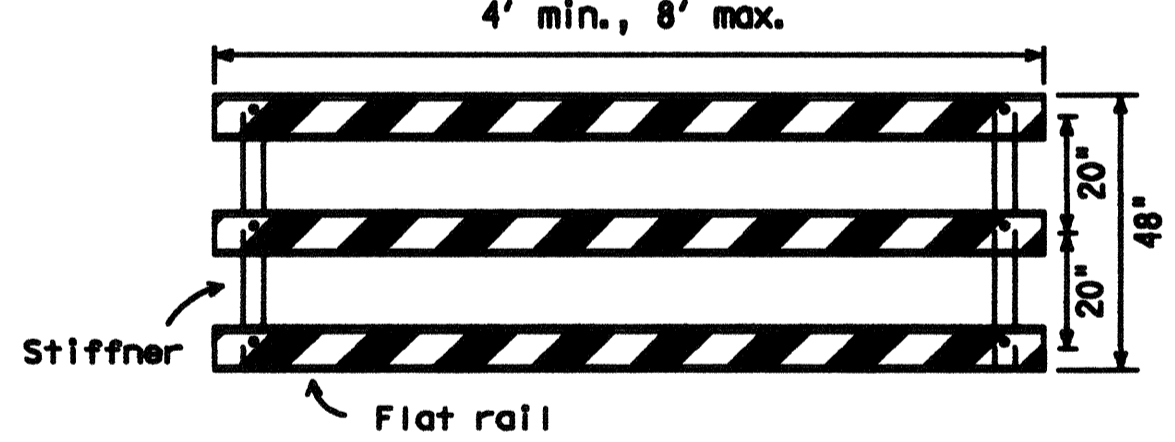


TYPE III BARRICADE (POST AND SKID) TYPICAL APPLICATION

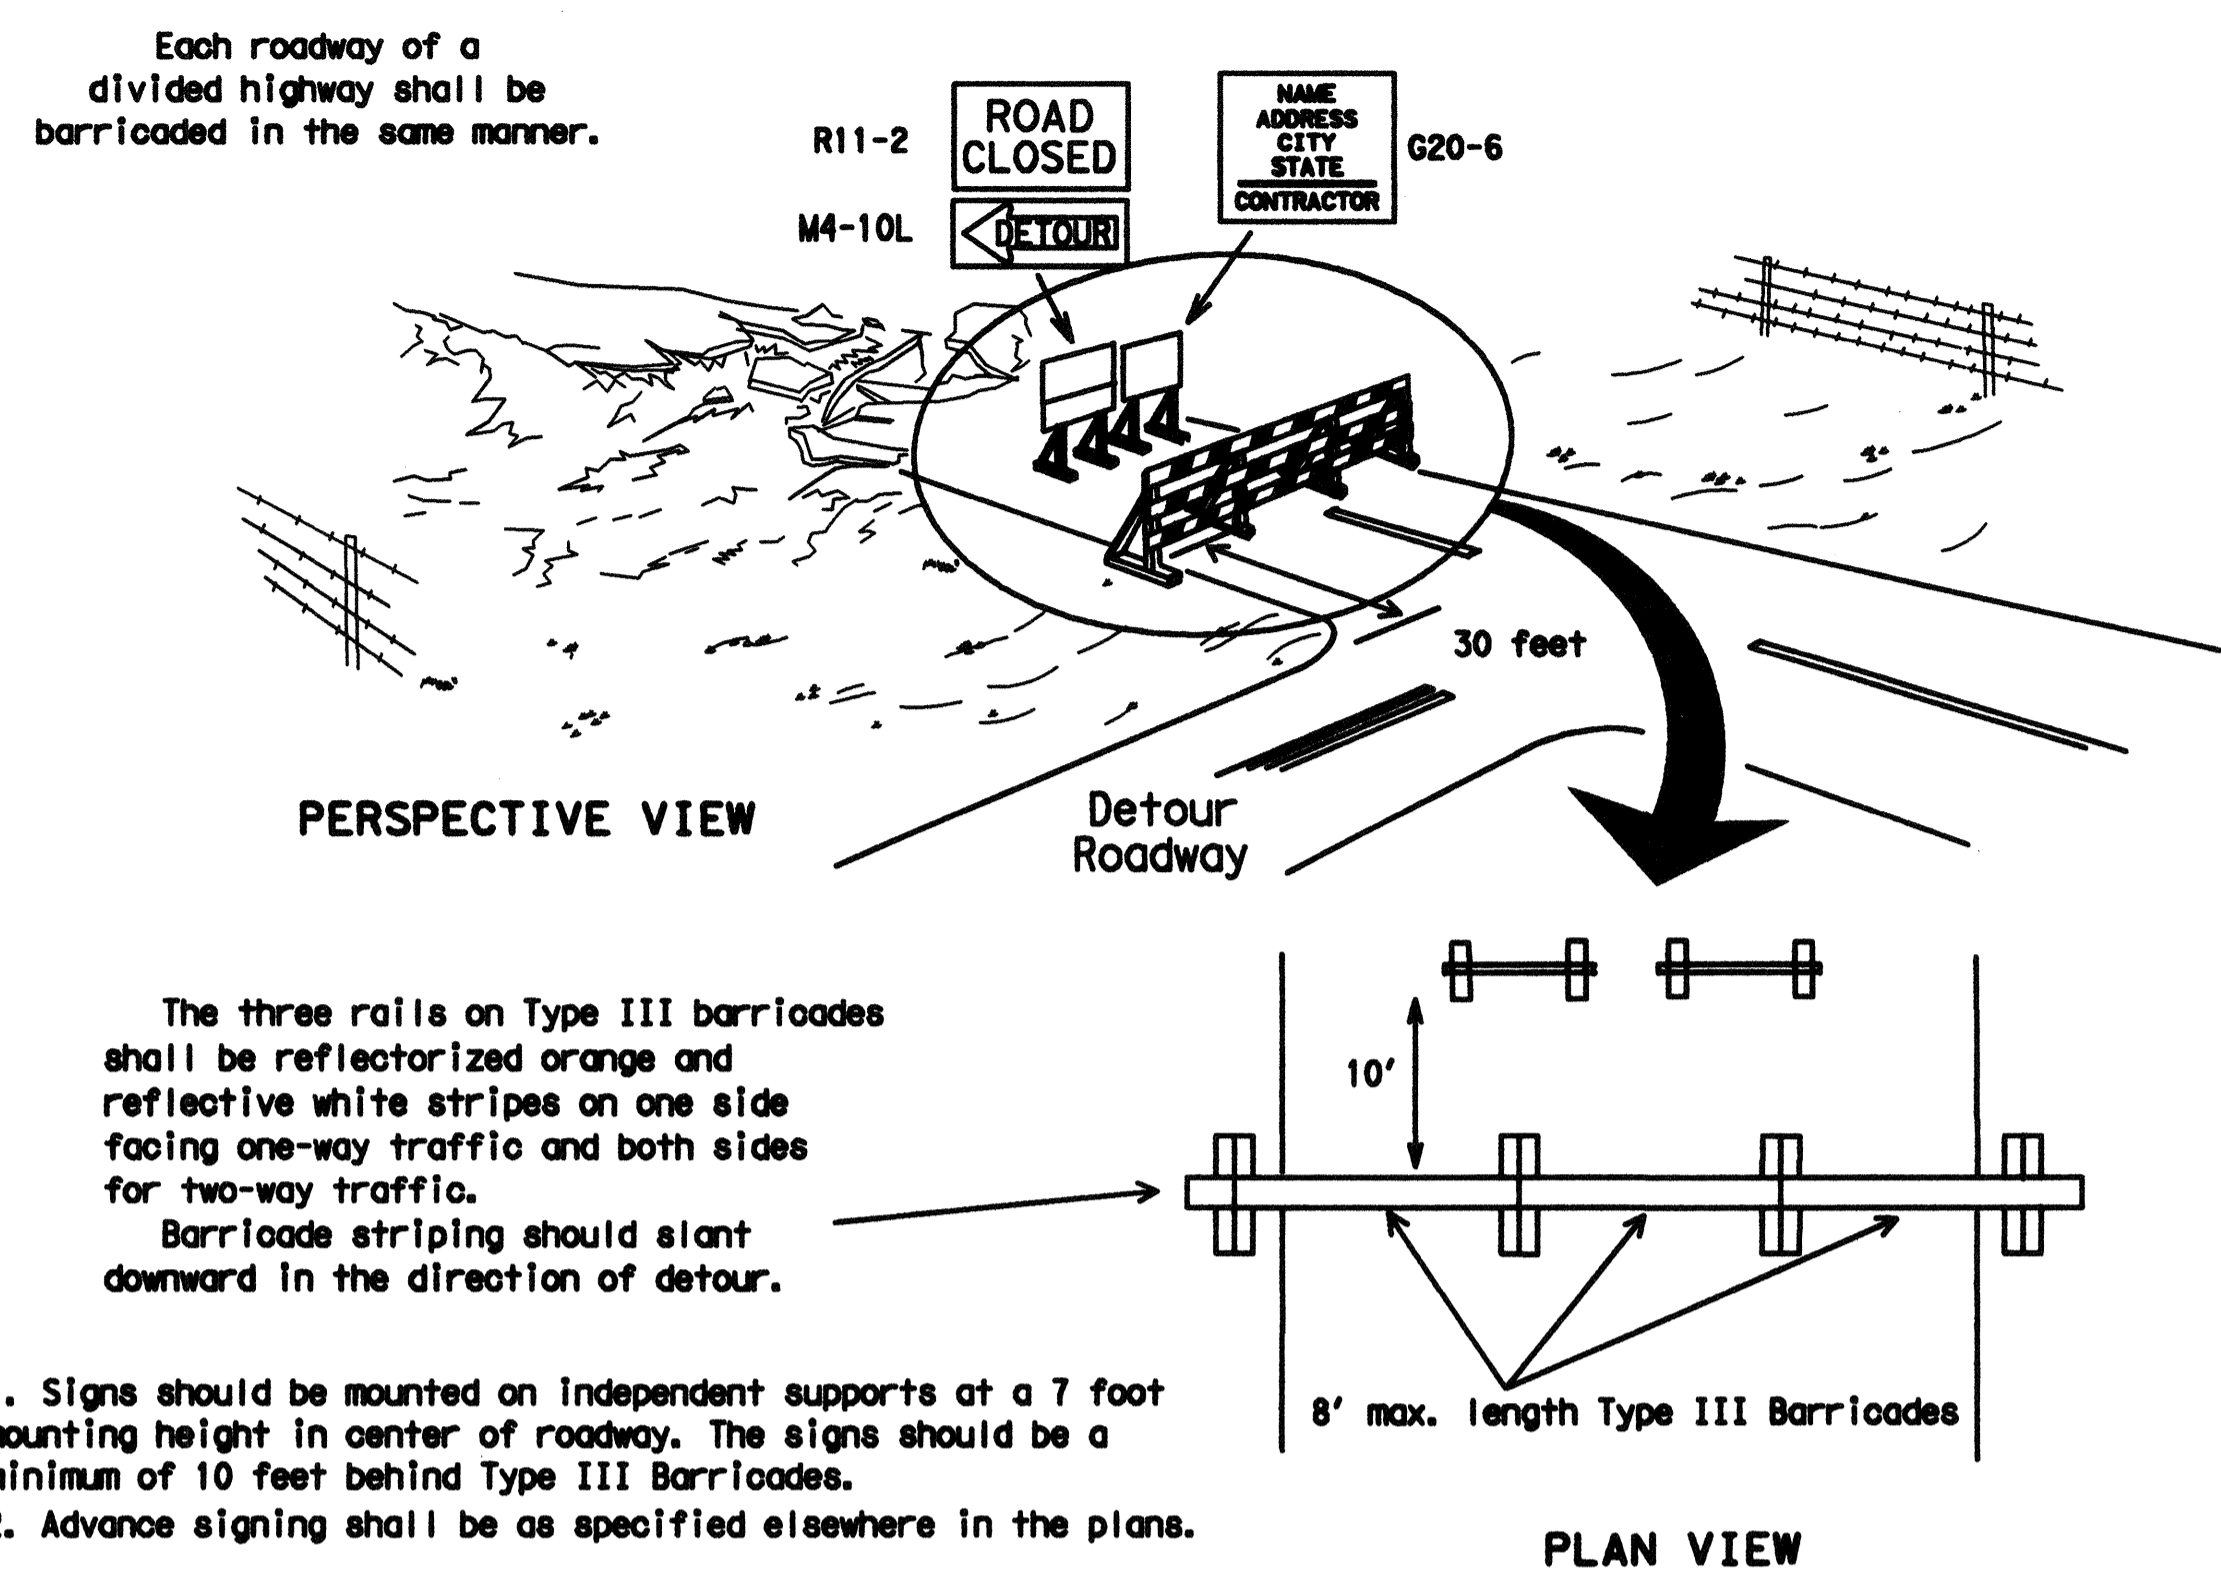


CULVERT WIDENING OR OTHER ISOLATED WORK WITHIN THE PROJECT LIMITS

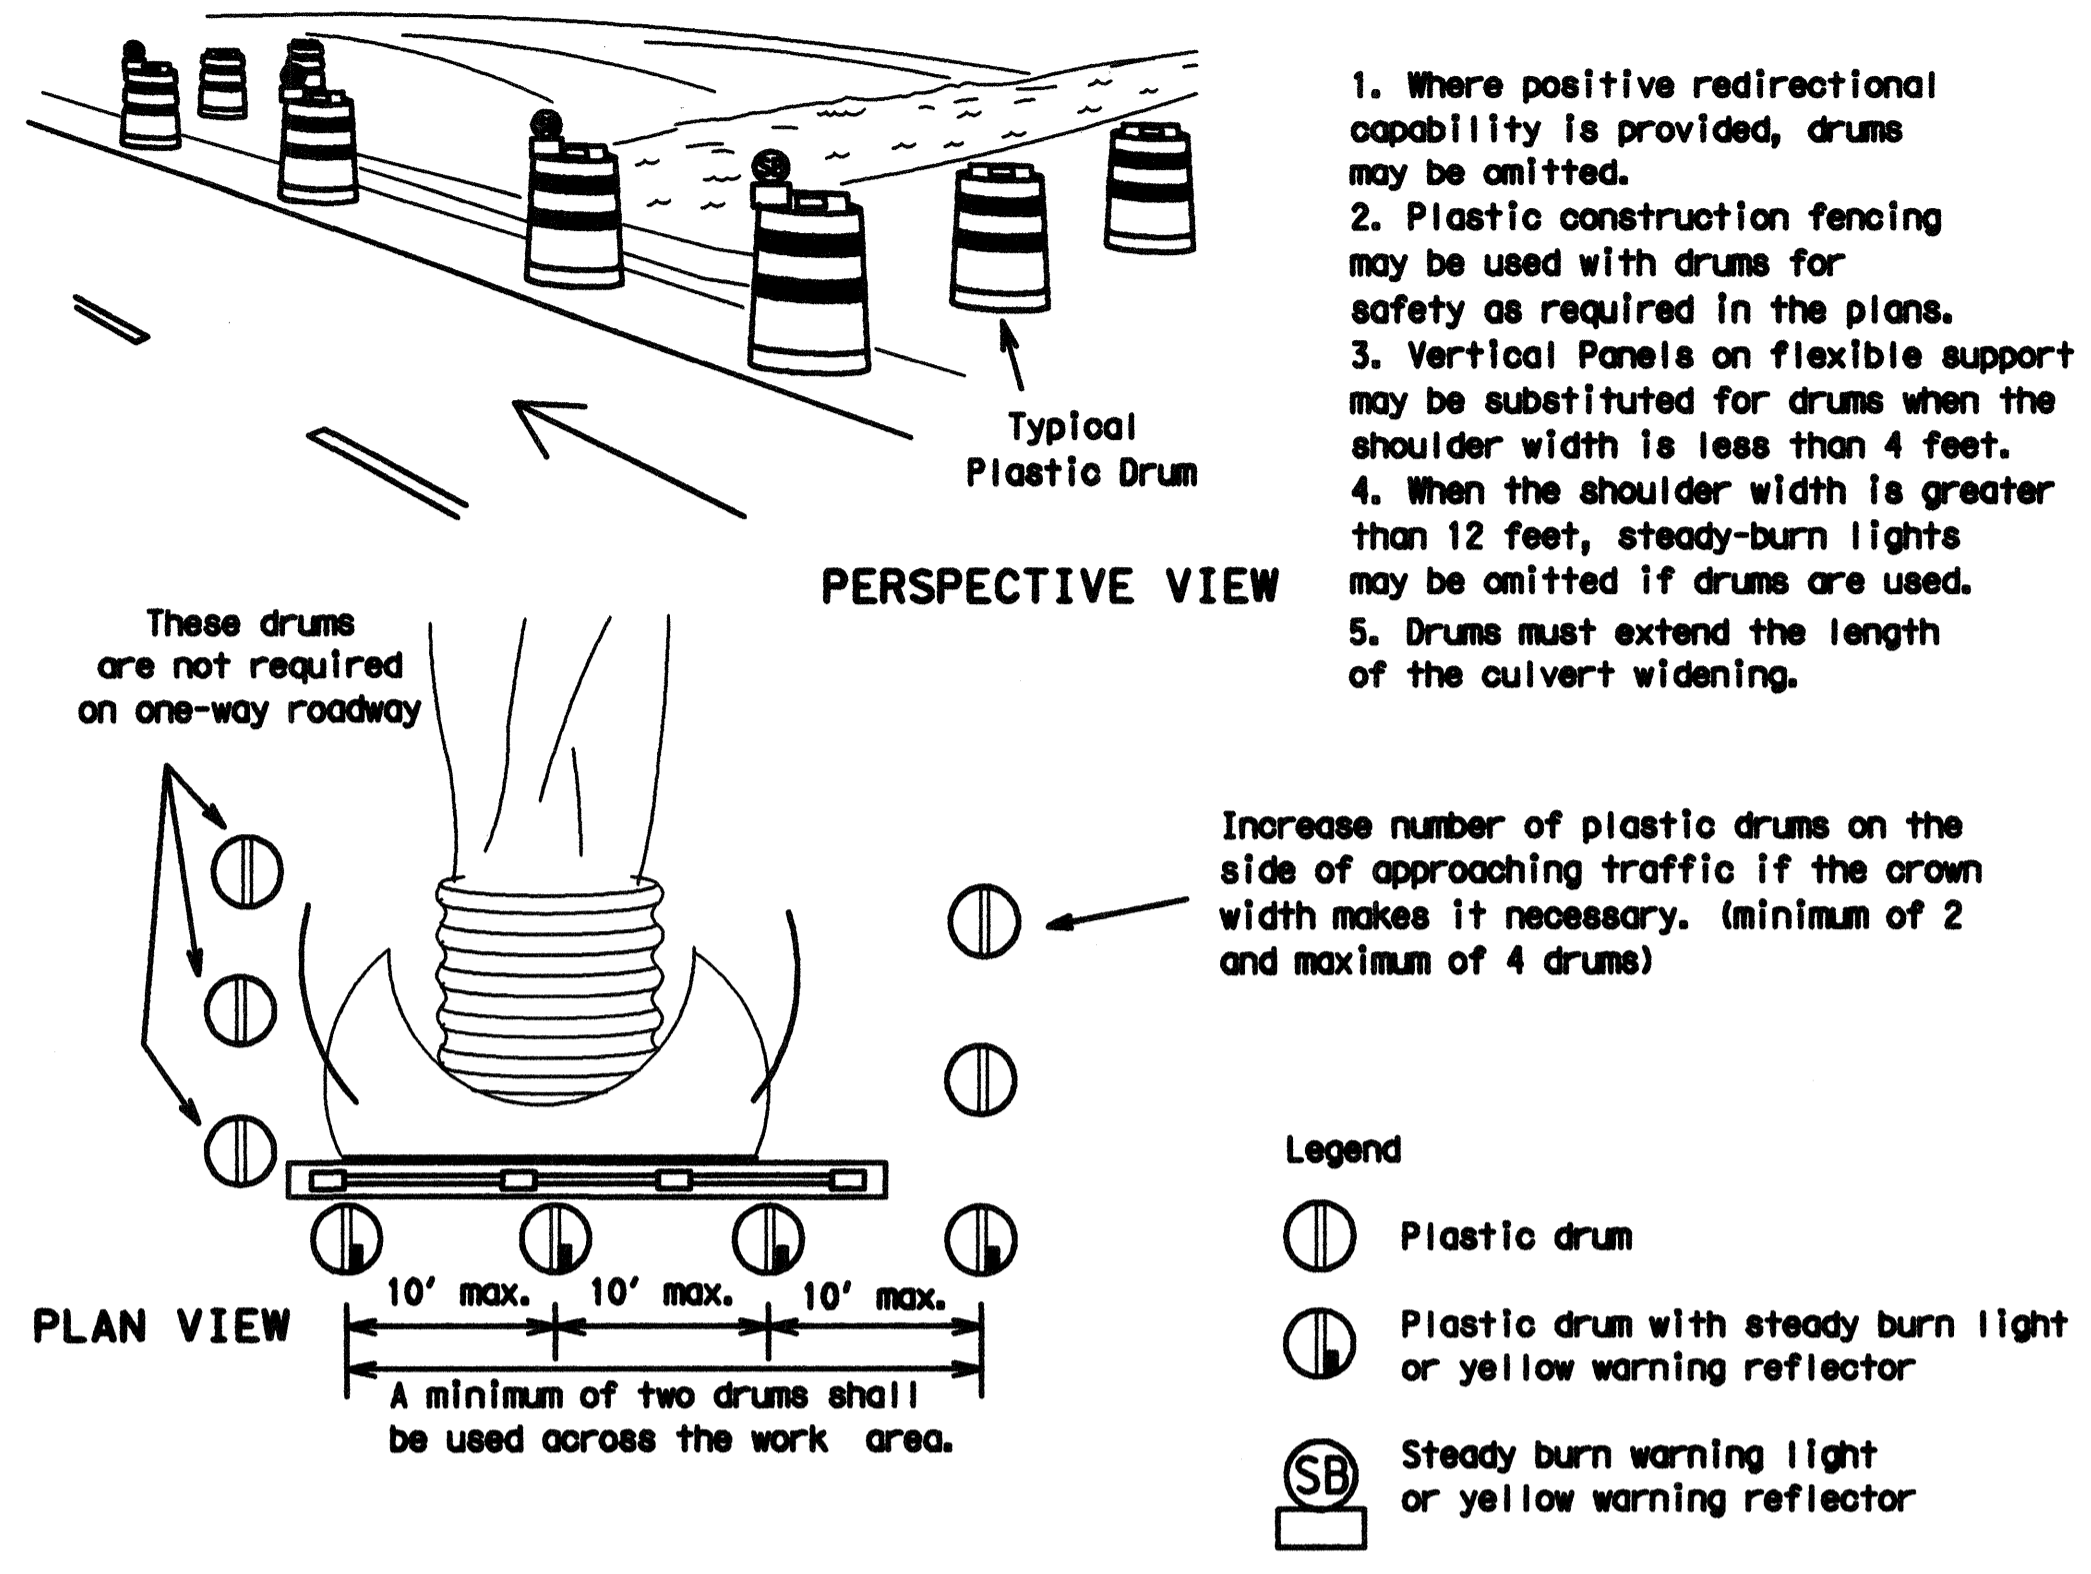

CONES

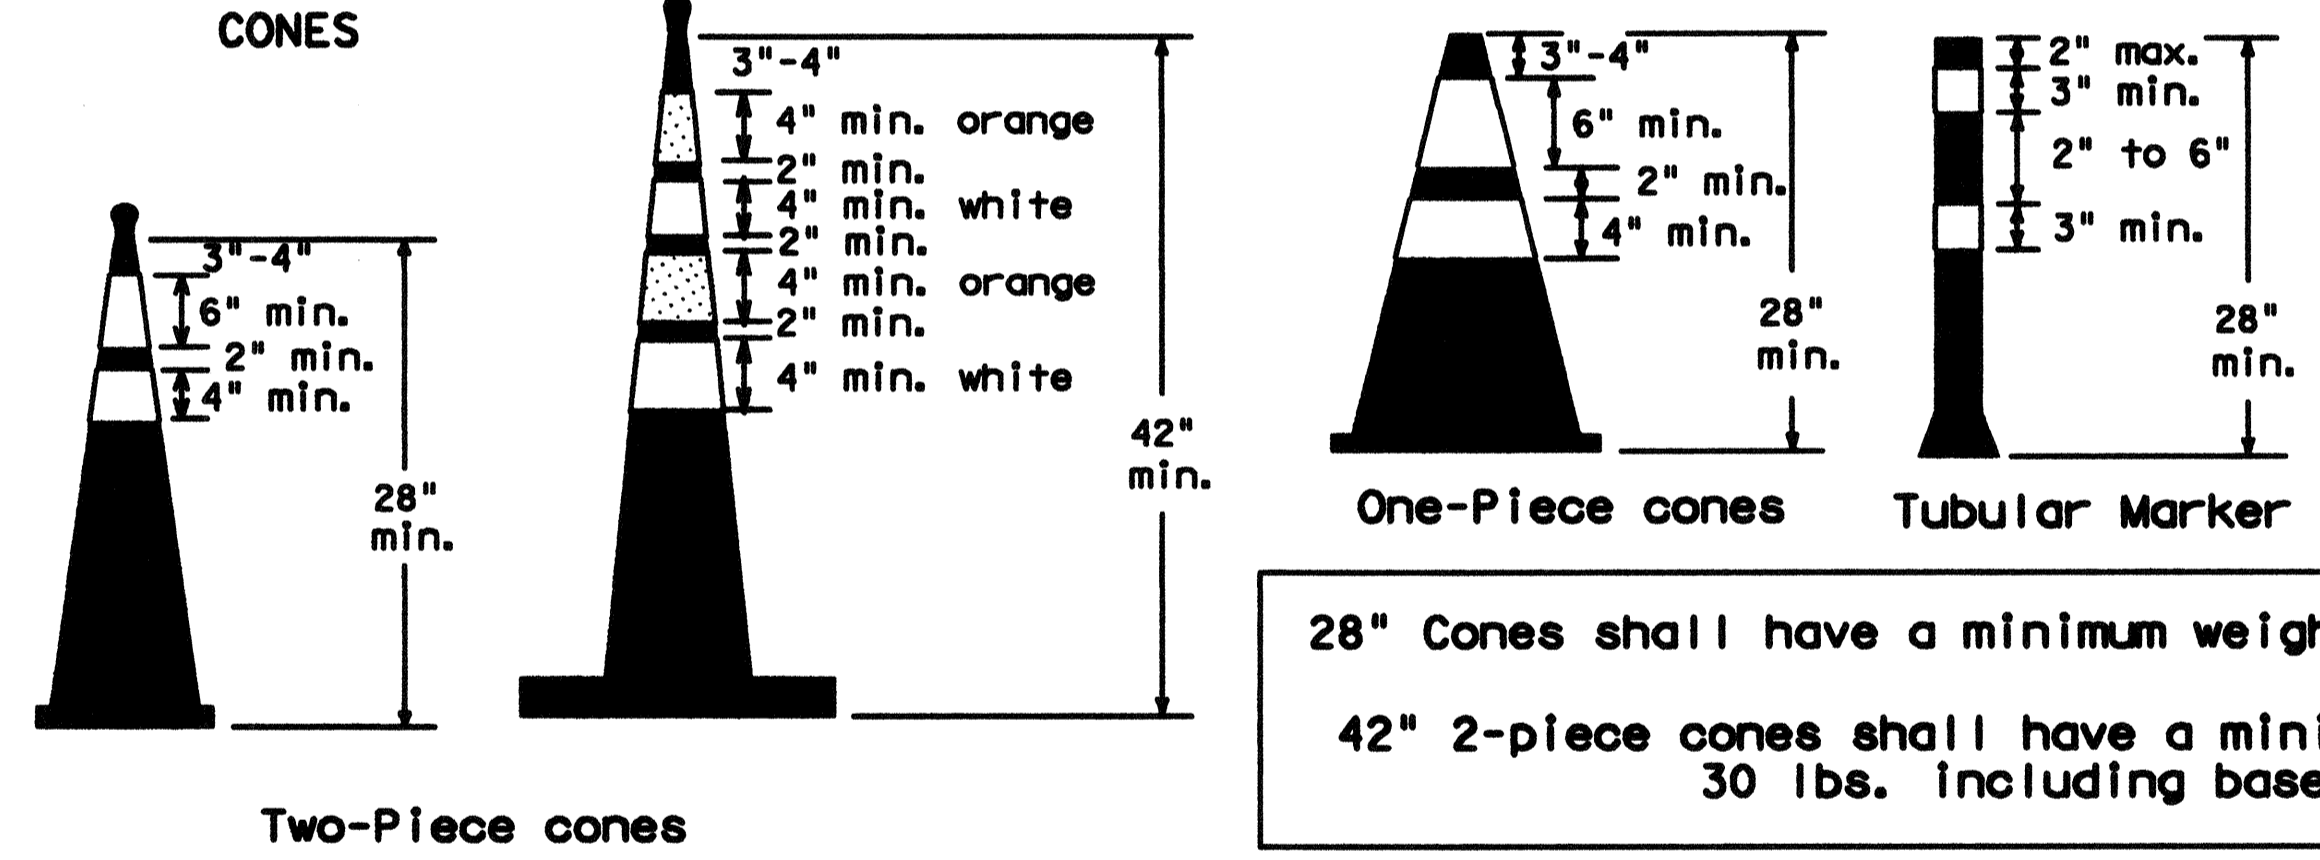


28" Cones shall have a minimum weight of 9 1/2 lbs.
 42" 2-piece cones shall have a minimum weight of 30 lbs. including base.

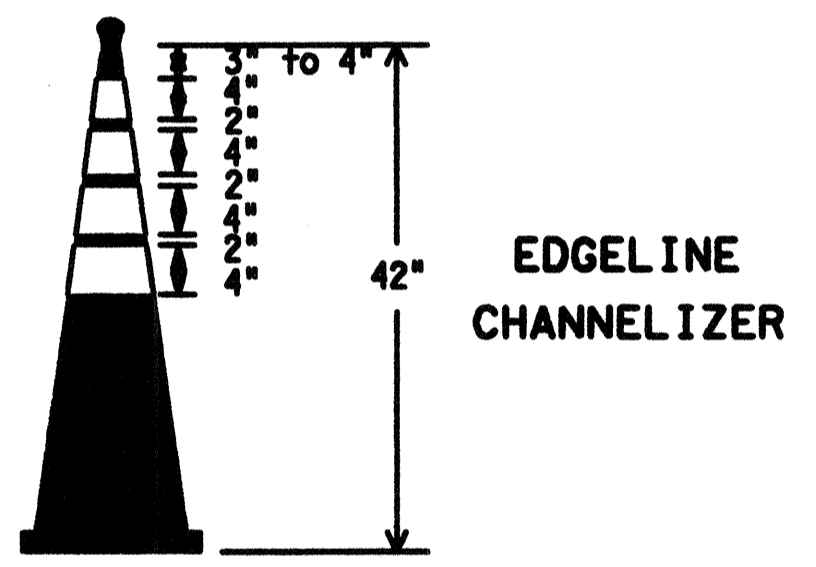

1. This device is intended only for use in place of a vertical panel to channelize traffic by indicating the edge of the travel lane. It is not intended to be used in transitions or tapers.
2. This device shall not be used to separate lanes of traffic (opposing or otherwise) or warn of objects.
3. This device is based on a 42 inch, two-piece cone with an alternate striping pattern: four 4 inch retroreflective bands, with an approximate 2 inch gap between bands. The color of the band should correspond to the color of the edgeline (yellow for left edgeline, white for right edgeline) for which the device is substituted or for which it supplements. The reflectorized bands shall be retroreflective Type C encapsulated bead (High Specific Intensity) conforming to Departmental Material Specification DMS-8300, unless otherwise noted.
4. The base must weigh a minimum of 30 lbs.

TRAFFIC CONTROL FOR MATERIAL STOCKPILES

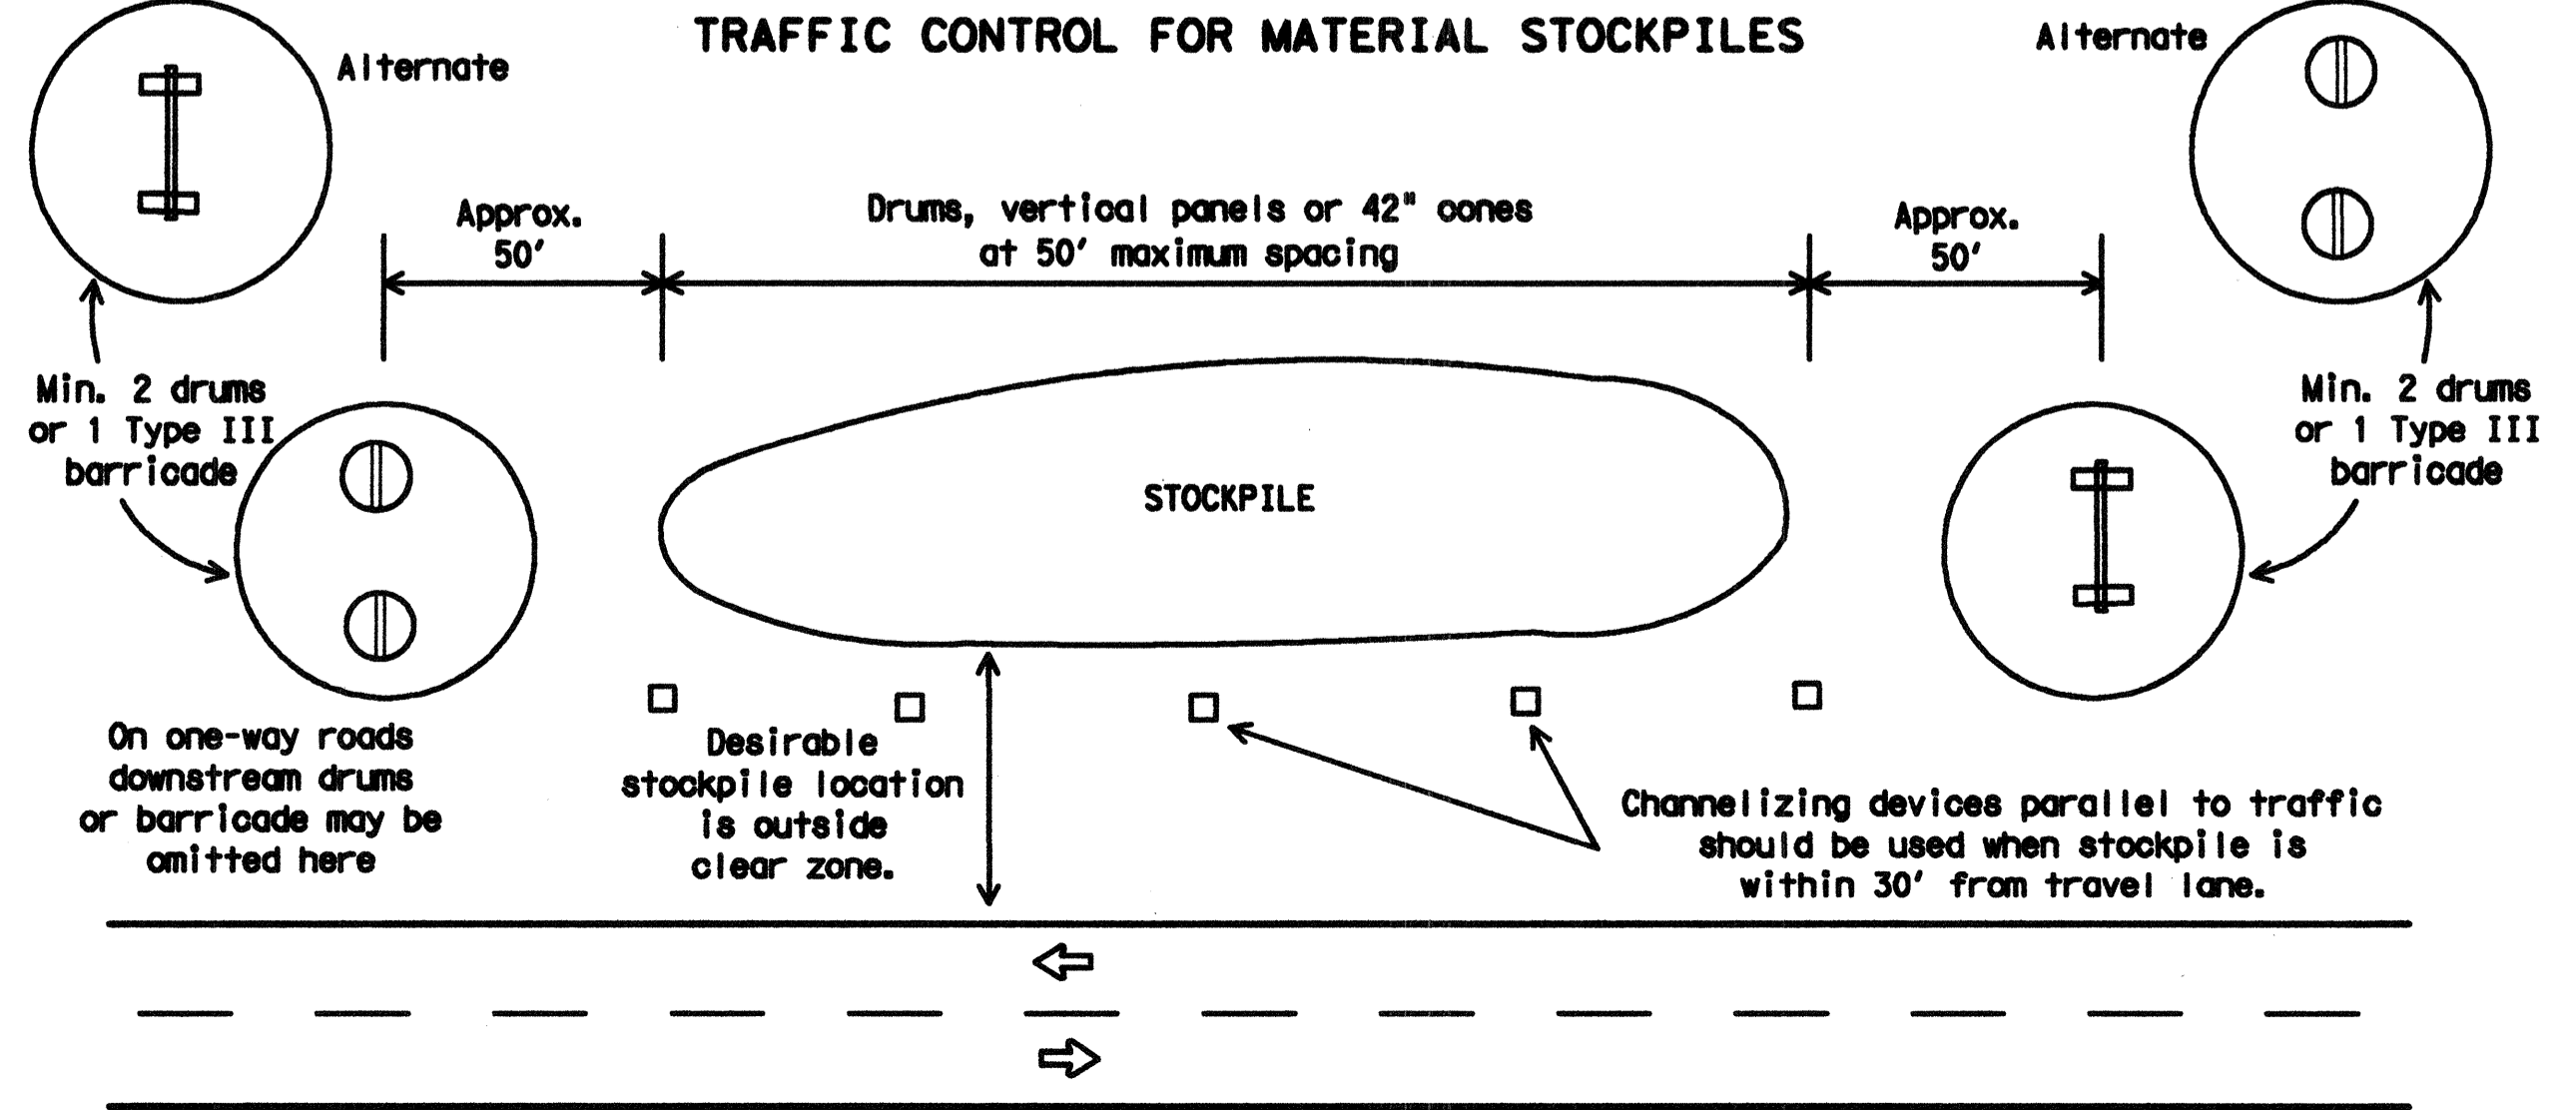

1. Traffic cones and tubular markers shall be a minimum of 28 inches in height when used either on freeways or at nighttime.
2. Cones or tubular markers shall be predominantly orange, fluorescent red-orange, or fluorescent yellow-orange. They should be kept clean and bright for maximum visibility.
3. Cones used only for daytime operations do not require the reflectorized bands.
4. Cones and tubular markers used for nighttime operations shall be reflectorized. Reflectorized material shall have a smooth, sealed outer surface that displays the same approximate color during the day and night. The reflectorized bands shall be retroreflective Type C (High Specific Intensity) conforming to Departmental Material Specification DMS-8300, unless otherwise noted.
5. When used at night, appropriate personnel shall ensure that cones and tubular markers remain in their proper location and in an upright position.
6. Reflectorization of 28" cones shall consist of a minimum 6 inch band placed at least 3 inches but not more than 4 inches from the top, supplemented by a minimum 4 inch band spaced a minimum of 2 inches below the 6 inch band.
7. Reflectorization of 42" cones shall be provided by alternating 4 to 6" orange and white stripes with orange on top.
8. Reflectorization of tubular markers shall be a minimum of two 3 inch bands placed a maximum of 2 inches from the top with a maximum of 6 inches between bands.
9. One-piece cones or tubular markers are generally suitable for temporary usage (up to 8 hours) with other channelization devices such as vertical panels, drums or two-piece cones for long term usage. Care should be taken to ensure they remain in their proper location and in an upright position.
10. Cones or tubular markers used on each project shall be of the same size and shape. The handle may be designed as a hook or other shape, fabricated from non-rigid materials similar to the cone material, and may extend up to a maximum of 8 inches above the top of cone. Length of the handle shall not be considered with regard to the overall height of the cone.
11. The handle may be designed as a hook or other shape, fabricated from non-rigid materials similar to the cone material, and may extend up to a maximum of 8 inches above the top of cone. Length of the handle shall not be considered with regard to the overall height of the cone.

Texas Department of Transportation
 Traffic Operations Division

BARRICADE AND CONSTRUCTION CHANNELIZING DEVICES STANDARD

10 of 12 BC(10)-07

© TxDOT 11-4-02		TXDOT	CK1 TXDOT	091 TXDOT	CK1 TXDOT
9-07	REVISIONS	CHG	SECT	JUS	HIGHWAY
		POST	COUNTY		SHEET NO.

DATE: FILE:

The use of this standard is governed by the "Texas Engineering Practice Act". No warranty of any kind is made by TxDOT for any purpose whatsoever. TxDOT assumes no responsibility for the consequences of this standard or for incorrect results or damages resulting from its use.

DISCLAIMER:

DATE:
FILE:

WORK ZONE PAVEMENT MARKINGS

GENERAL

1. The Contractor shall be responsible for maintaining work zone and existing pavement markings, in accordance with the standard specifications and special provisions, on all roadways open to traffic within the CSJ limits unless otherwise stated in the plans.
2. Color, patterns and dimensions shall be in conformance with the "Texas Manual on Uniform Traffic Control Devices" (TMUTCD).
3. Additional supplemental pavement marking details may be found in the plans or specifications.
4. Pavement markings shall be installed in accordance with the TMUTCD and as shown on the plans.
5. When short term markings are required on the plans, short term markings shall conform with the TMUTCD, the plans and details as shown on the Standard Plan Sheet WZ (STPM).
6. When standard pavement markings are not in place and the roadway is opened to traffic, DO NOT PASS signs shall be erected to mark the beginning of the sections where passing is prohibited and PASS WITH CARE signs at the beginning of sections where passing is permitted.
7. All work zone pavement markings shall be installed in accordance with Item 662, "Work Zone Pavement Markings."

RAISED PAVEMENT MARKERS

1. Raised pavement markers are to be placed according to the patterns on BC(12).
2. All raised pavement markers used for work zone markings shall meet the requirements of Item 672, "RAISED PAVEMENT MARKERS" and Departmental Material Specification DMS-4200 or DMS-4300.

PREFABRICATED PAVEMENT MARKINGS

1. Removable prefabricated pavement markings shall meet the requirements of DMS-8241.
2. Non-removable prefabricated pavement markings (foil back) shall meet the requirements of DMS-8240.


MAINTAINING WORK ZONE PAVEMENT MARKINGS

1. The Contractor will be responsible for maintaining work zone pavement markings within the work limits.
2. Work zone pavement markings shall be inspected in accordance with the frequency and reporting requirements of work zone traffic control device inspections as required by Form 599.
3. The markings should provide a visible reference for a minimum distance of 300 feet during normal daylight hours and 160 feet when illuminated by automobile low-beam headlights at night, unless sight distance is restricted by roadway geometrics.
4. Markings failing to meet this criteria within the first 30 days after placement shall be replaced at the expense of the Contractor as per Specification Item 662.

REMOVAL OF PAVEMENT MARKINGS

1. Pavement markings that are no longer applicable, could create confusion or direct a motorist toward or into the closed portion of the roadway, shall be removed or obliterated before the roadway is opened to traffic.
2. The above shall not apply to detours in place for less than two weeks, where flaggers and/or sufficient channelizing devices are used in lieu of markings to outline the detour route.
3. Pavement markings shall be removed to the fullest extent possible, so as not to leave a discernable marking. This shall be by any method approved by TxDOT Specification Item 677 for "Eliminating Existing Pavement Markings and Markers".
4. The removal of pavement markings may require resurfacing or seal coating portions of the roadway.
5. Subject to the approval of the Engineer, any method that proves to be successful on a particular type pavement may be used.
6. Blast cleaning may be used but will not be required unless specifically shown in the plans.
7. Over-painting of the markings SHALL NOT BE permitted.
8. Removal of raised pavement markers shall be as directed by the Engineer.
9. Removal of existing pavement markings and markers will be paid for directly in accordance with Item 677, "ELIMINATING EXISTING PAVEMENT MARKINGS AND MARKERS," unless otherwise stated in the plans.
10. Black-out marking tape may be used to cover conflicting existing markings for periods less than two weeks when approved by the Engineer.

Temporary Flexible-Reflective Roadway Marker Tabs

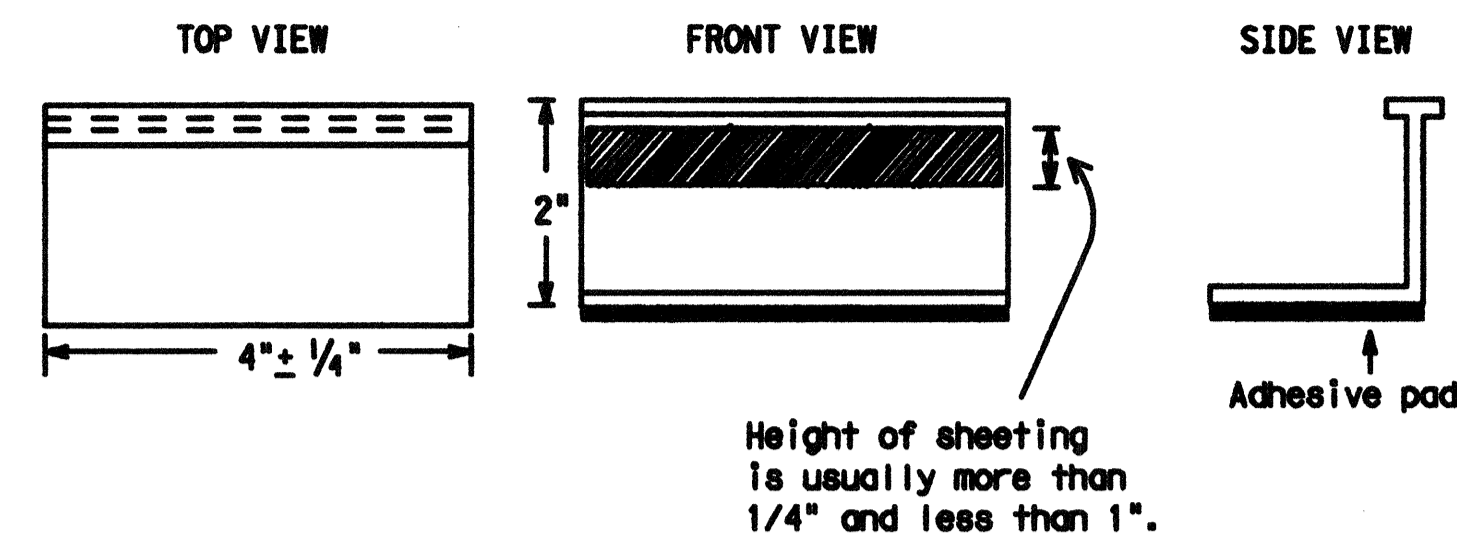

**STAPLES OR NAILS SHALL NOT BE USED TO SECURE
TEMPORARY FLEXIBLE-REFLECTIVE ROADWAY MARKER
TABS TO THE PAVEMENT SURFACE**

1. Temporary flexible-reflective roadway marker tabs used as guidemarks shall meet the requirements of DMS-8242.
2. Tabs detailed on this sheet are to be inspected and accepted by the Engineer or designated representative. Sampling and testing is not normally required, however at the option of the Engineer, either "A" or "B" below may be imposed to assure quality before placement on the roadway.
 - A. Select five (5) or more tabs at random from each lot or shipment and submit to the Construction Division, Materials and Pavement Section to determine specification compliance.
 - B. Select five (5) tabs and perform the following test. Affix five (5) tabs at 24 inch intervals on an asphaltic pavement in a straight line. Using a medium size passenger vehicle or pickup, run over the markers with the front and rear tires at a speed of 35 to 40 miles per hour, four (4) times in each direction. No more than one (1) out of the five (5) reflective surfaces shall be lost or displaced as a result of this test.
3. Small design variances may be noted between tab manufacturers.
4. See Standard Sheet WZ (STPM) for tab placement on new pavements. See Standard Sheet TCP(7-1) for tab placement on seal coat work.

Raised Pavement Markers used as Guidemarks

1. Raised pavement markers used as guidemarks shall be from the approved product list, and meet the requirements of DMS-4200.
2. All temporary construction raised pavement markers provided on a project shall be of the same manufacturer.
3. Adhesive for guidemarks shall be bituminous material hot applied or butyl rubber pad for all surfaces, or thermoplastic for concrete surfaces.

Guidemarks shall be designated as:
 YELLOW - (two amber reflective surfaces with yellow body).
 WHITE - (one silver reflective surface with white body).

DEPARTMENTAL MATERIAL SPECIFICATIONS

PAVEMENT MARKERS (REFLECTORIZED)	DMS-4200
TRAFFIC BUTTONS	DMS-4300
EPOXY AND ADHESIVES	DMS-6100
BITUMINOUS ADHESIVE FOR PAVEMENT MARKERS	DMS-6130
PREFABRICATED PAVEMENT MARKINGS-PERMANENT	DMS-8240
PREFABRICATED PAVEMENT MARKINGS-REMOVABLE	DMS-8241
TEMPORARY FLEXIBLE-REFLECTIVE ROADWAY MARKER TABS	DMS-8242

A list of prequalified reflective raised pavement markers, non-reflective traffic buttons, roadway marker tabs and other pavement markings can be found at the Material Producer List web address shown on BC(11).



BARRICADE AND CONSTRUCTION PAVEMENT MARKINGS STANDARD


11 of 12

BC(11)-07


© TxDOT February 1998				DATE	BY	CHKD	APPD
2-98	REVISIONS	CURT	SECT	JUS			HIGHWAY
1-02							
11-02							
9-07					COUNTY		SHEET NO.

PAVEMENT MARKING PATTERNS


CENTER LINE & NO-PASSING ZONE BARRIER LINES FOR TWO-LANE, TWO-WAY HIGHWAYS

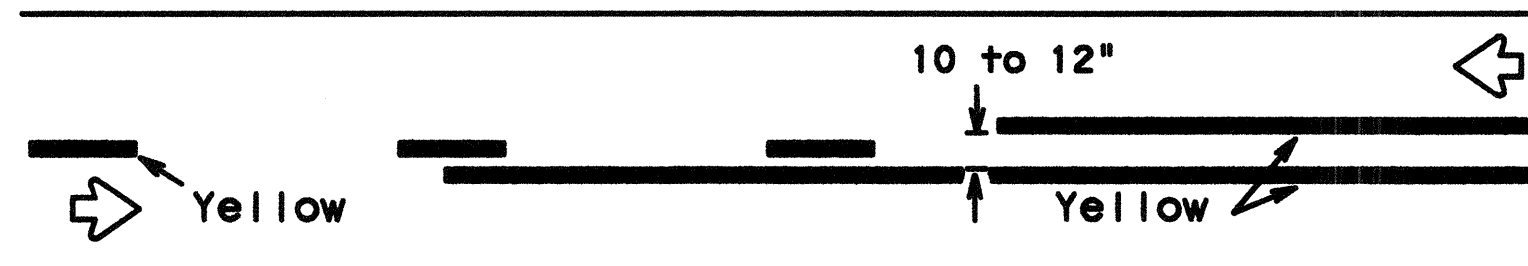


REFLECTORIZED PAVEMENT MARKINGS - PATTERN A

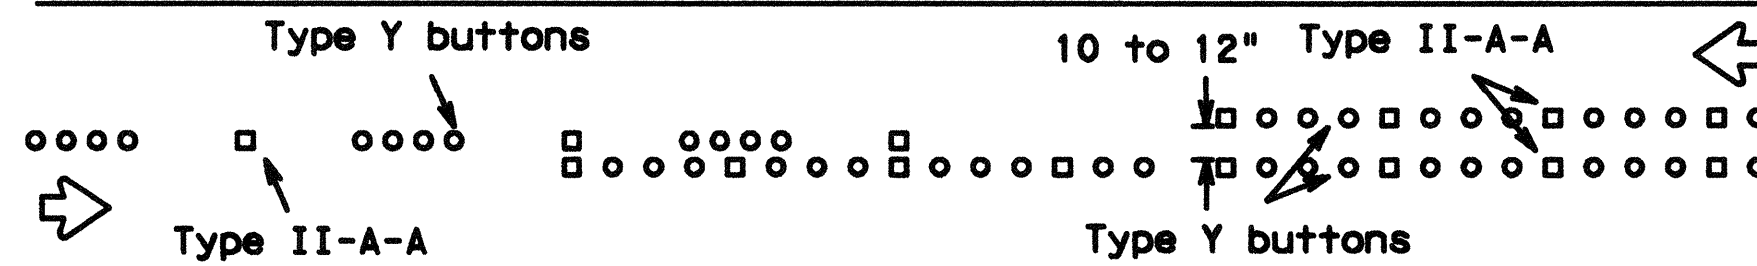

RAISED PAVEMENT MARKERS - PATTERN A

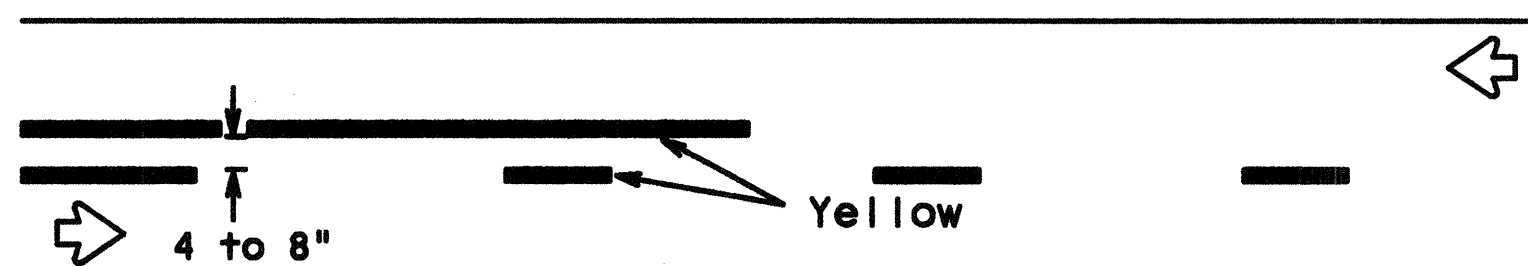


REFLECTORIZED PAVEMENT MARKINGS - PATTERN B

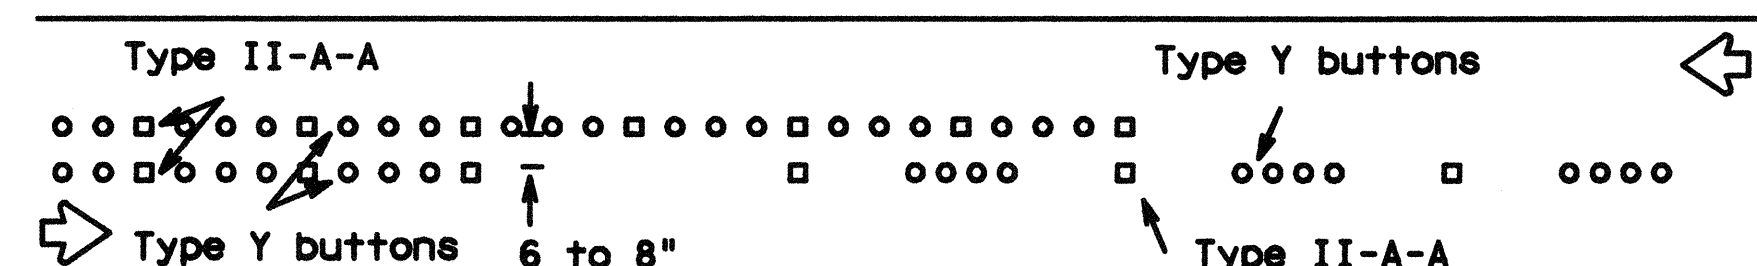


RAISED PAVEMENT MARKERS - PATTERN B

Pattern A is the TXDOT Standard, however Pattern B may be used if approved by the Engineer. Prefabricated markings may be substituted for reflectorized pavement markings.


EDGE & LANE LINES FOR DIVIDED HIGHWAY

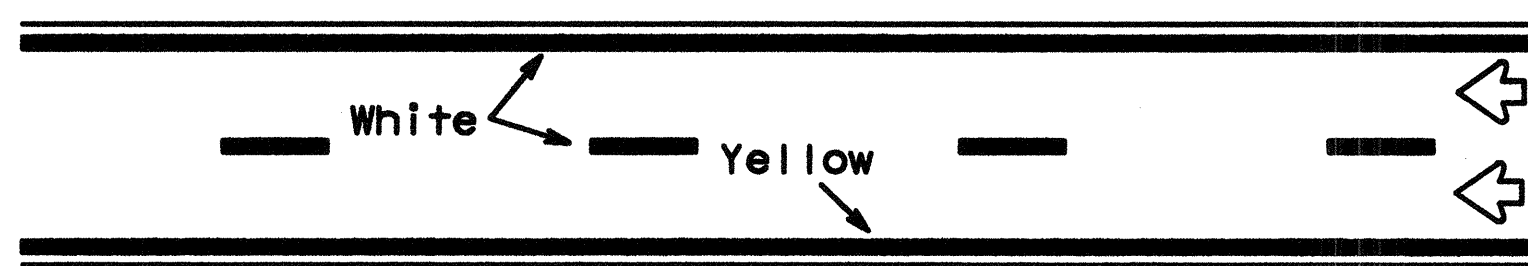


REFLECTORIZED PAVEMENT MARKINGS

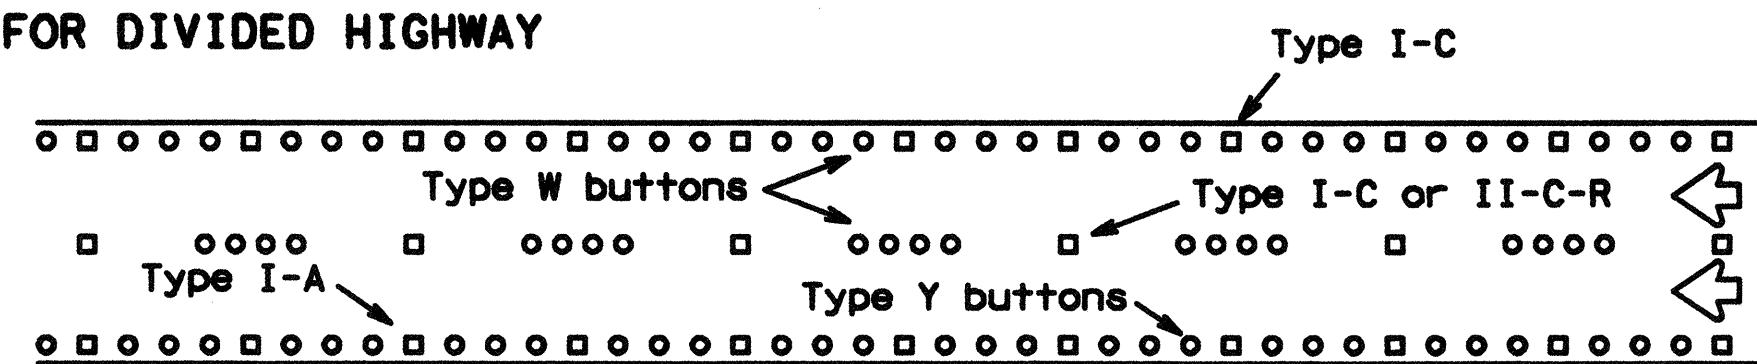

RAISED PAVEMENT MARKERS

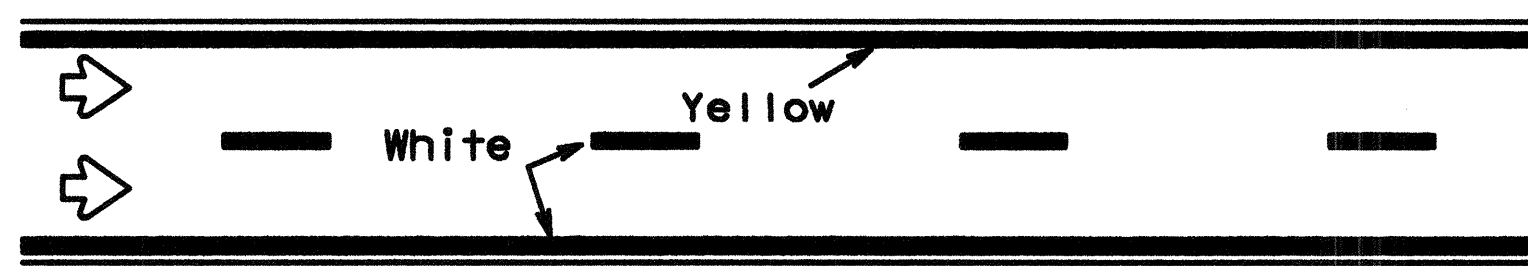


REFLECTORIZED PAVEMENT MARKINGS

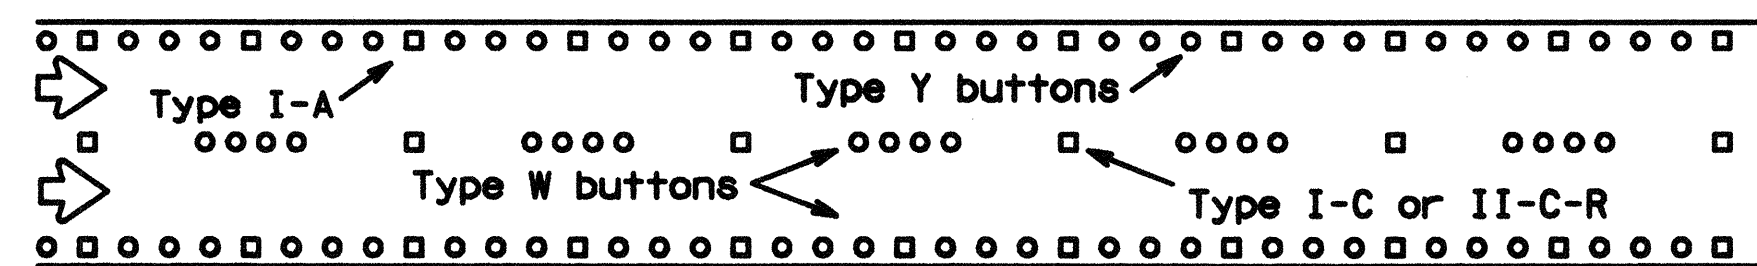


RAISED PAVEMENT MARKERS

Prefabricated markings may be substituted for reflectorized pavement markings.


LANE & CENTER LINES FOR MULTILANE UNDIVIDED HIGHWAYS

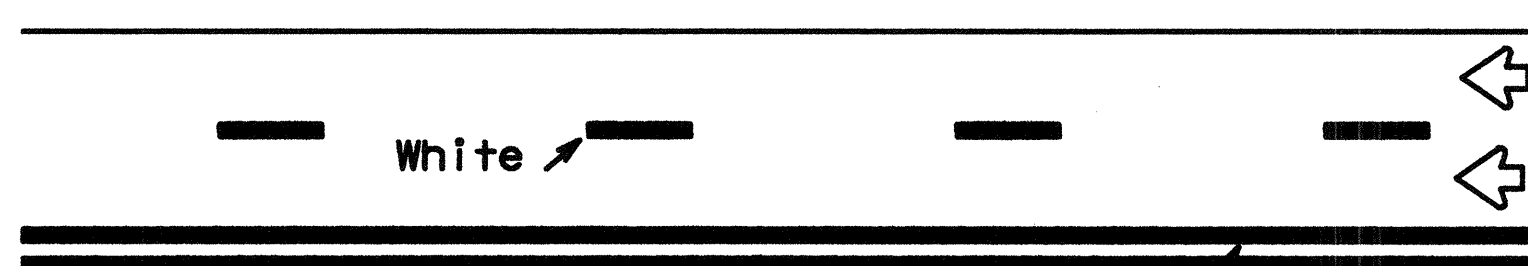


REFLECTORIZED PAVEMENT MARKINGS

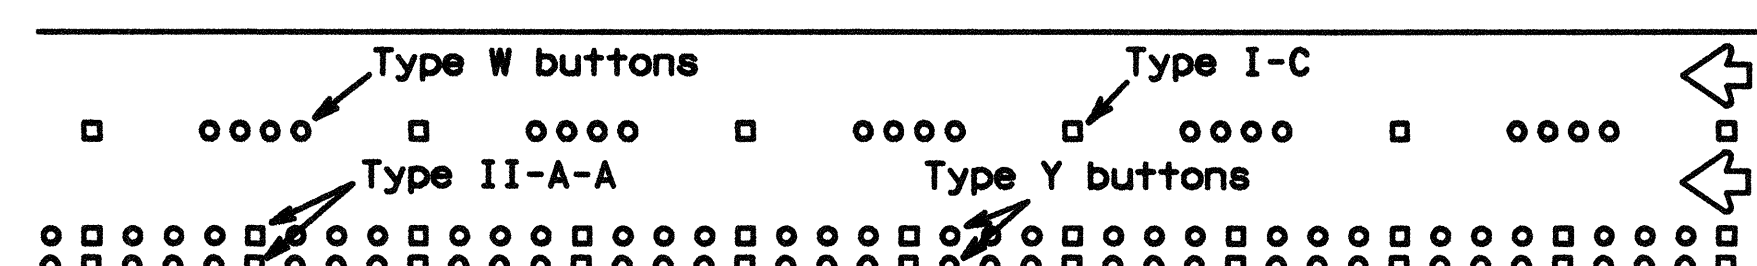

RAISED PAVEMENT MARKERS

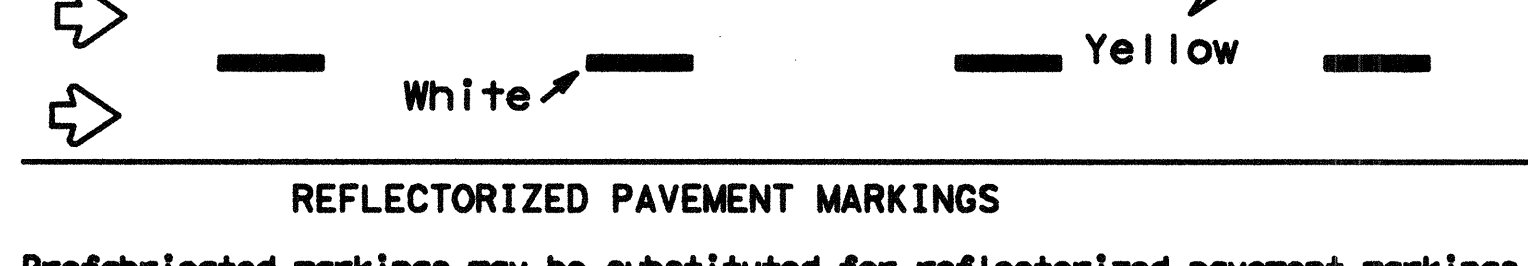


REFLECTORIZED PAVEMENT MARKINGS

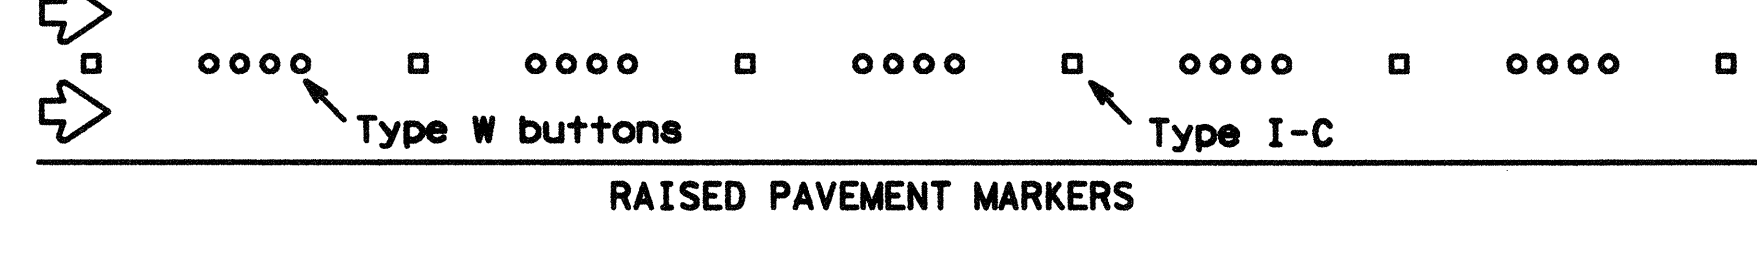


RAISED PAVEMENT MARKERS

Prefabricated markings may be substituted for reflectorized pavement markings.


TWO-WAY LEFT TURN LANE

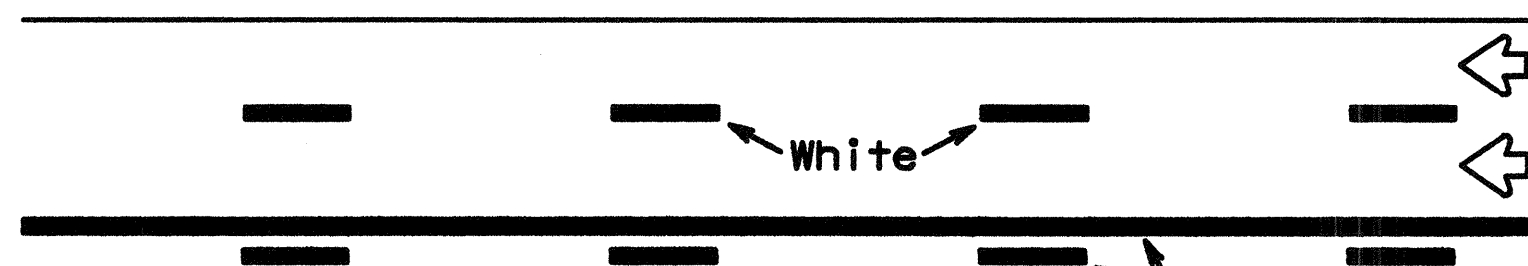


REFLECTORIZED PAVEMENT MARKINGS

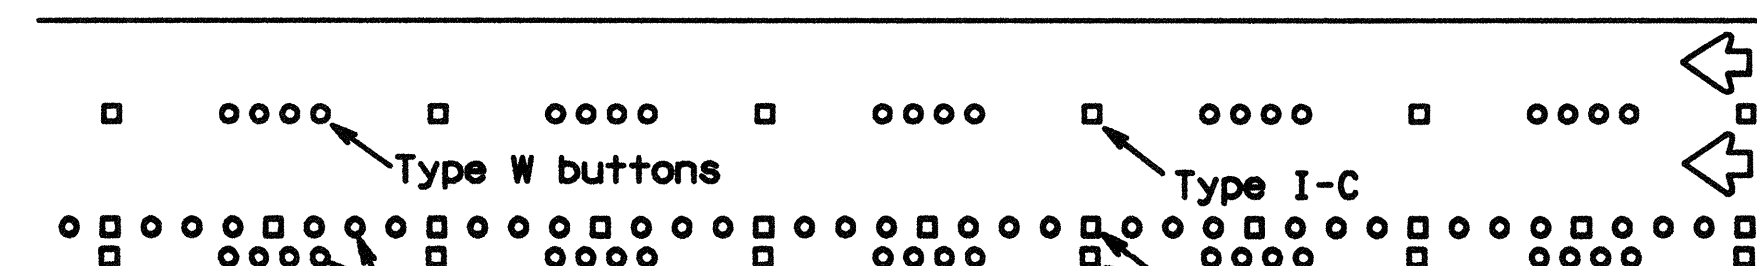

RAISED PAVEMENT MARKERS

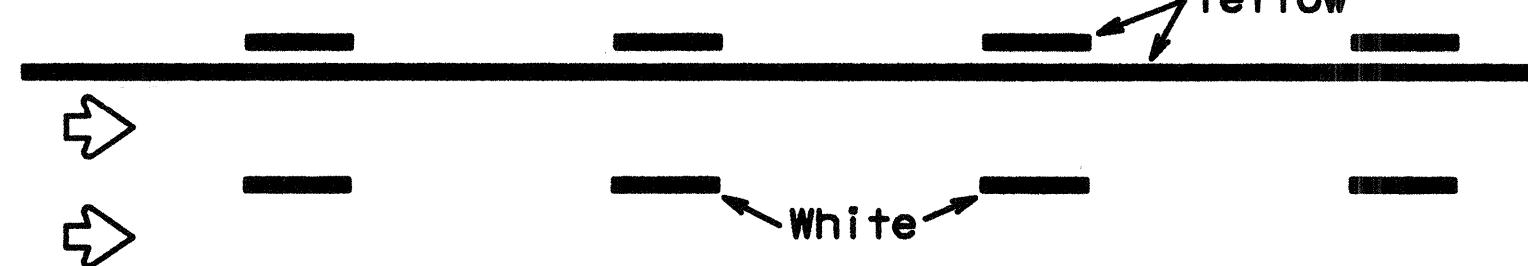


REFLECTORIZED PAVEMENT MARKINGS

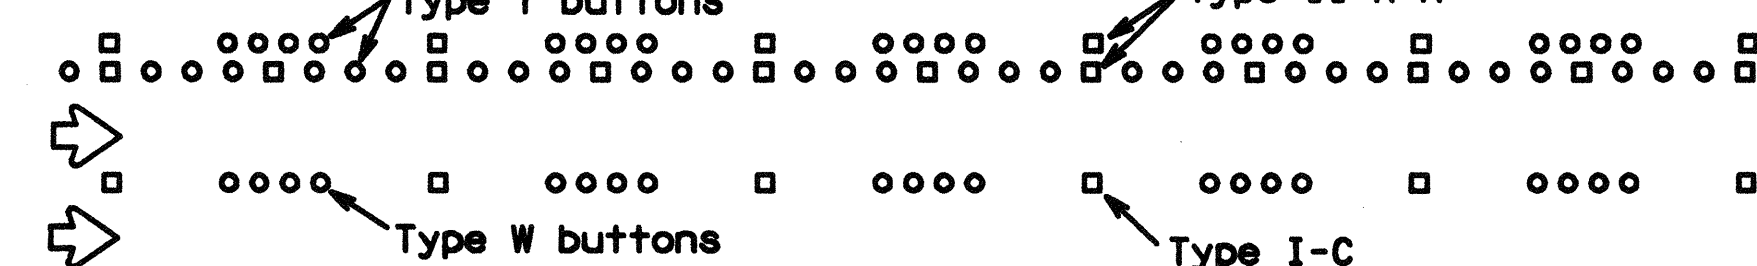



RAISED PAVEMENT MARKERS

Prefabricated markings may be substituted for reflectorized pavement markings.

STANDARD WORK ZONE PAVEMENT MARKINGS DETAILS

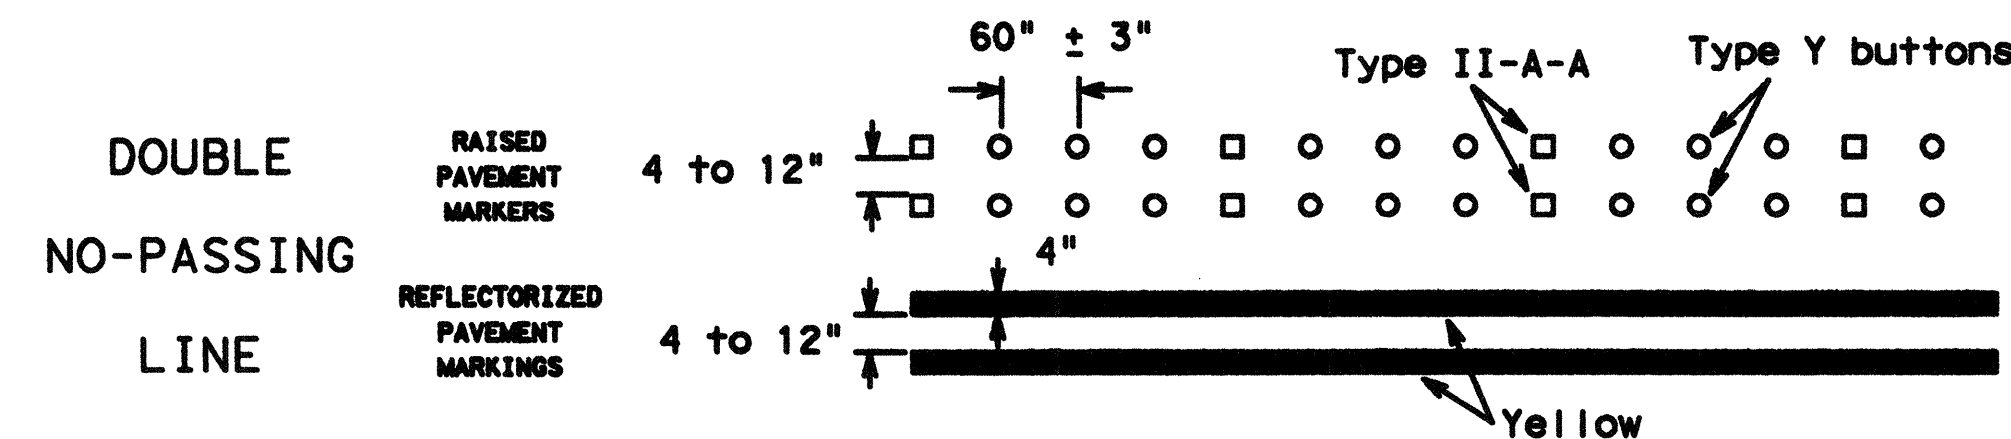


SOLID LINES

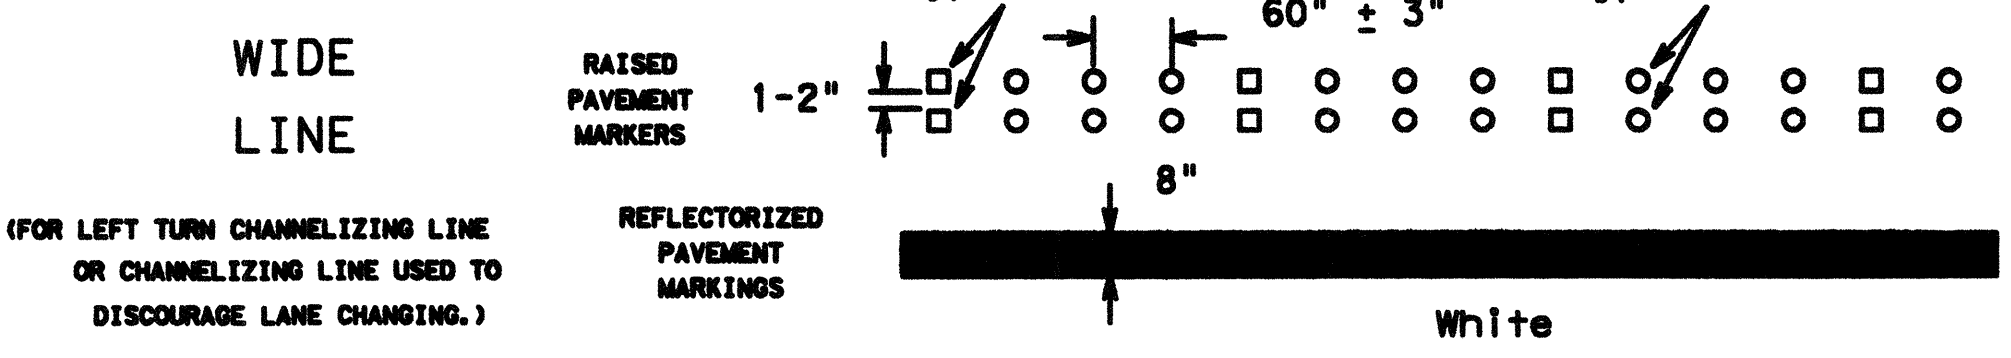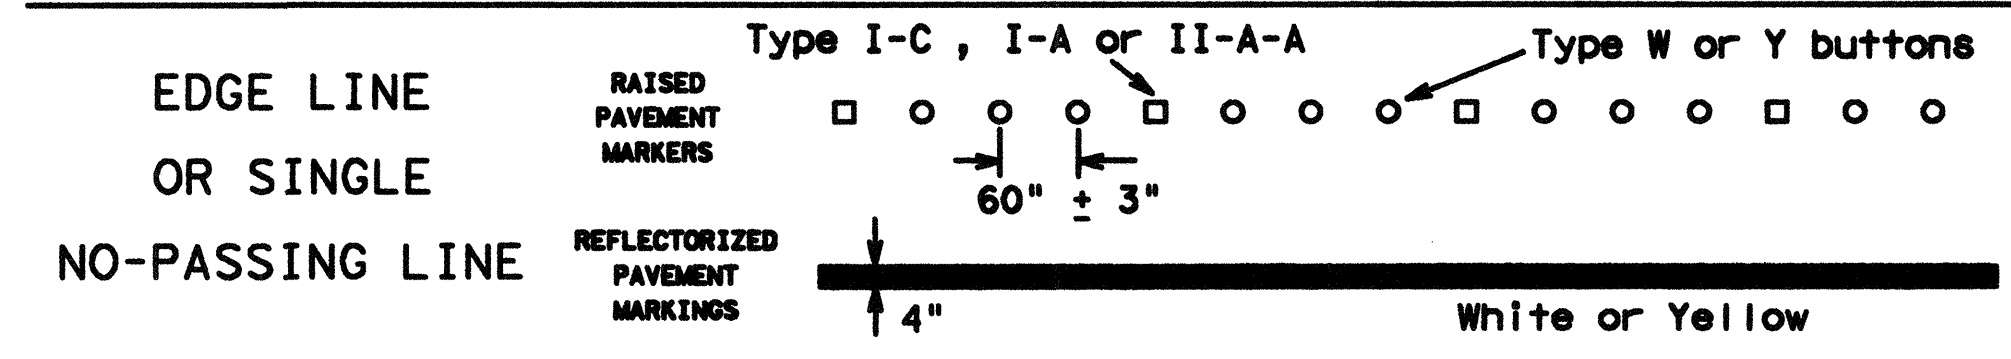


BROKEN LINE

(FOR CENTER LINE OR LANE LINE.)

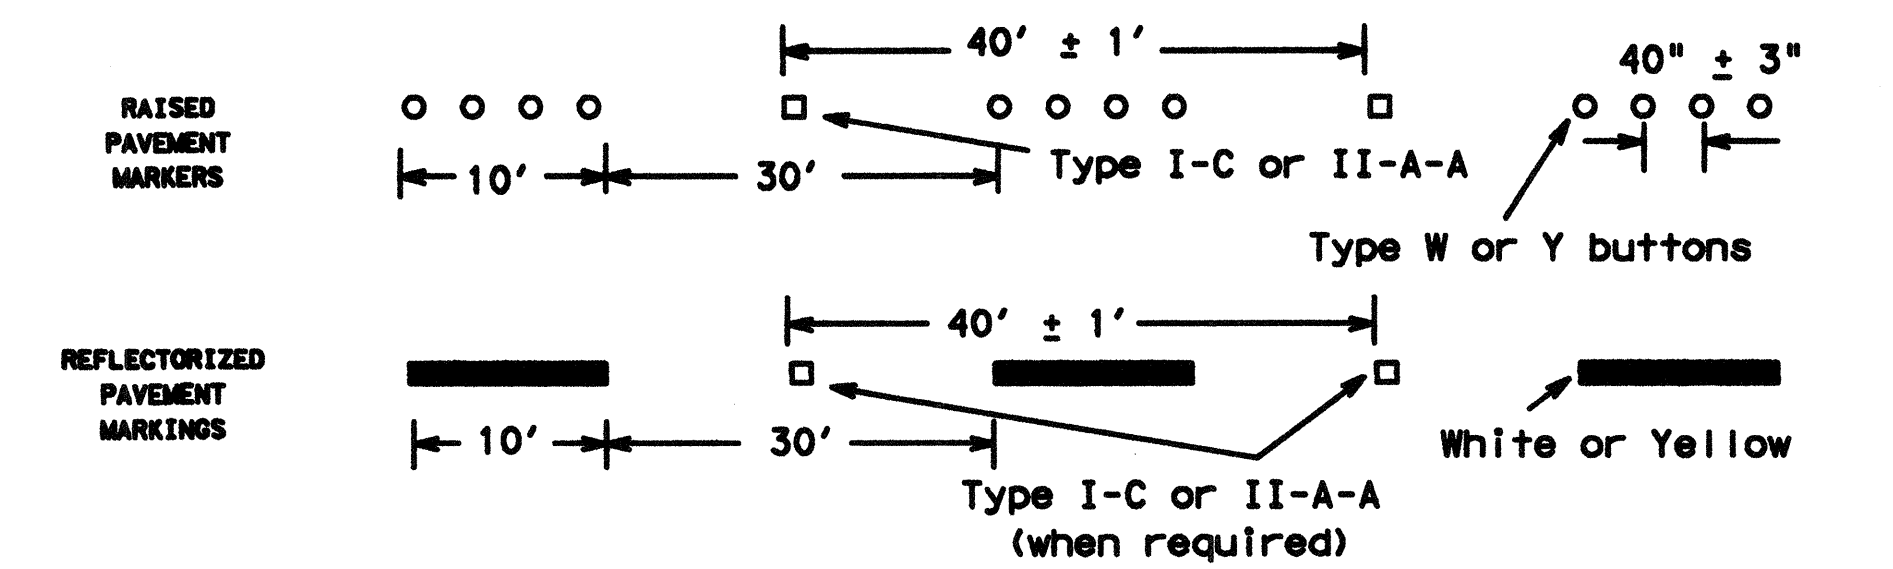

REMOVABLE MARKINGS WITH RAISED PAVEMENT MARKERS

If raised pavement markers are used to supplement REMOVABLE markings, the markers shall be applied to the top of the tape at the approximate mid length of tape used for broken lines or at 20 foot spacing for solid lines. This allows an easier removal of raised pavement markers and tape.

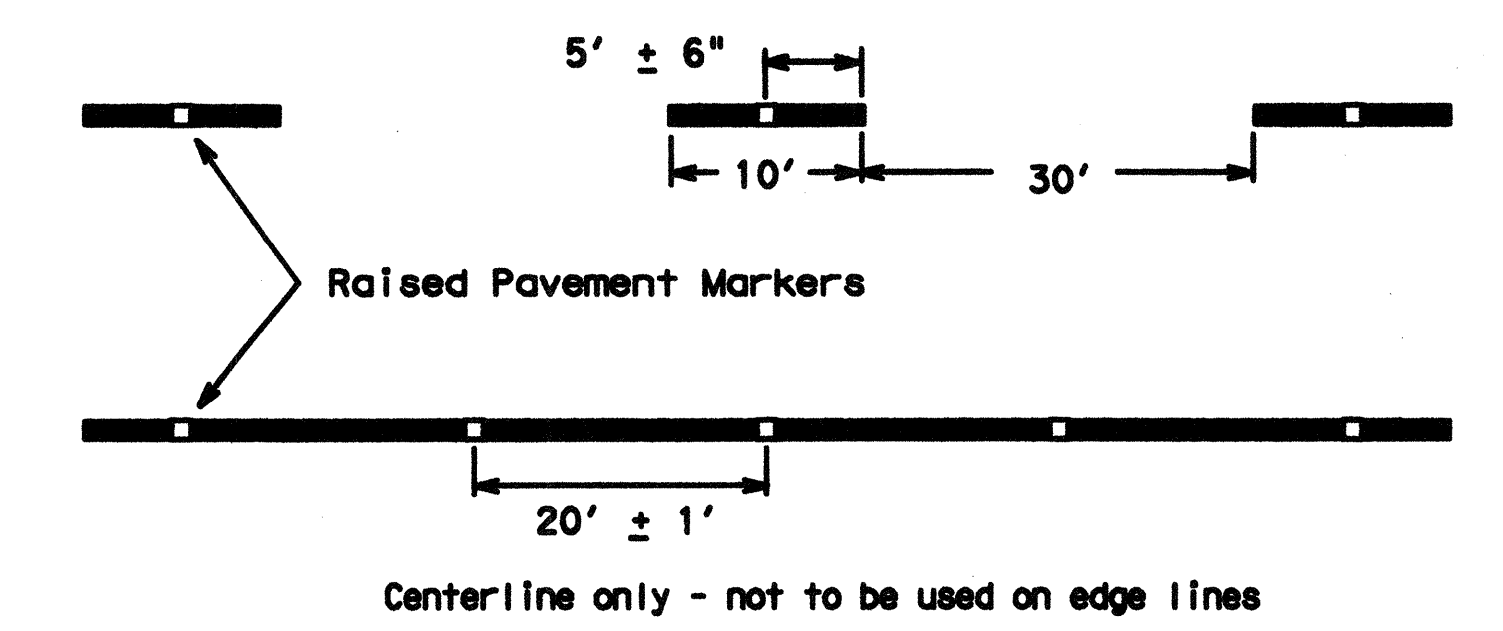

Raised pavement markers used as standard pavement markings shall be from the approved products list and meet the requirements of Item 672 "RAISED PAVEMENT MARKERS."



BARRICADE AND CONSTRUCTION PAVEMENT MARKING PATTERNS STANDARD


12 of 12 BC(12)-07

© TxDOT February 1998	TXDOT	TXDOT	TXDOT	TXDOT
1-97	REVISONS	CUA/T	SECT	JUS
2-98				HIGHWAY
11-02				
9-07				
			COUNTY	SHEET NO.

DISCLAIMER: The use of this standard is governed by the "Texas Engineering Practice Act". No warranty of any kind is made by TXDOT for any purpose whatsoever. TXDOT assumes no responsibility for the conversion of this standard to other formats or for incorrect results or damages resulting from its use.


DATE: FILE:

DISCLAIMER: The use of this standard is governed by the "Texas Engineering Practice Act". No warranty of any kind is made by TxDOT for any purpose whatsoever. TxDOT assumes no responsibility for the correct sign of this standard or for incorrect results or damages resulting from its use.

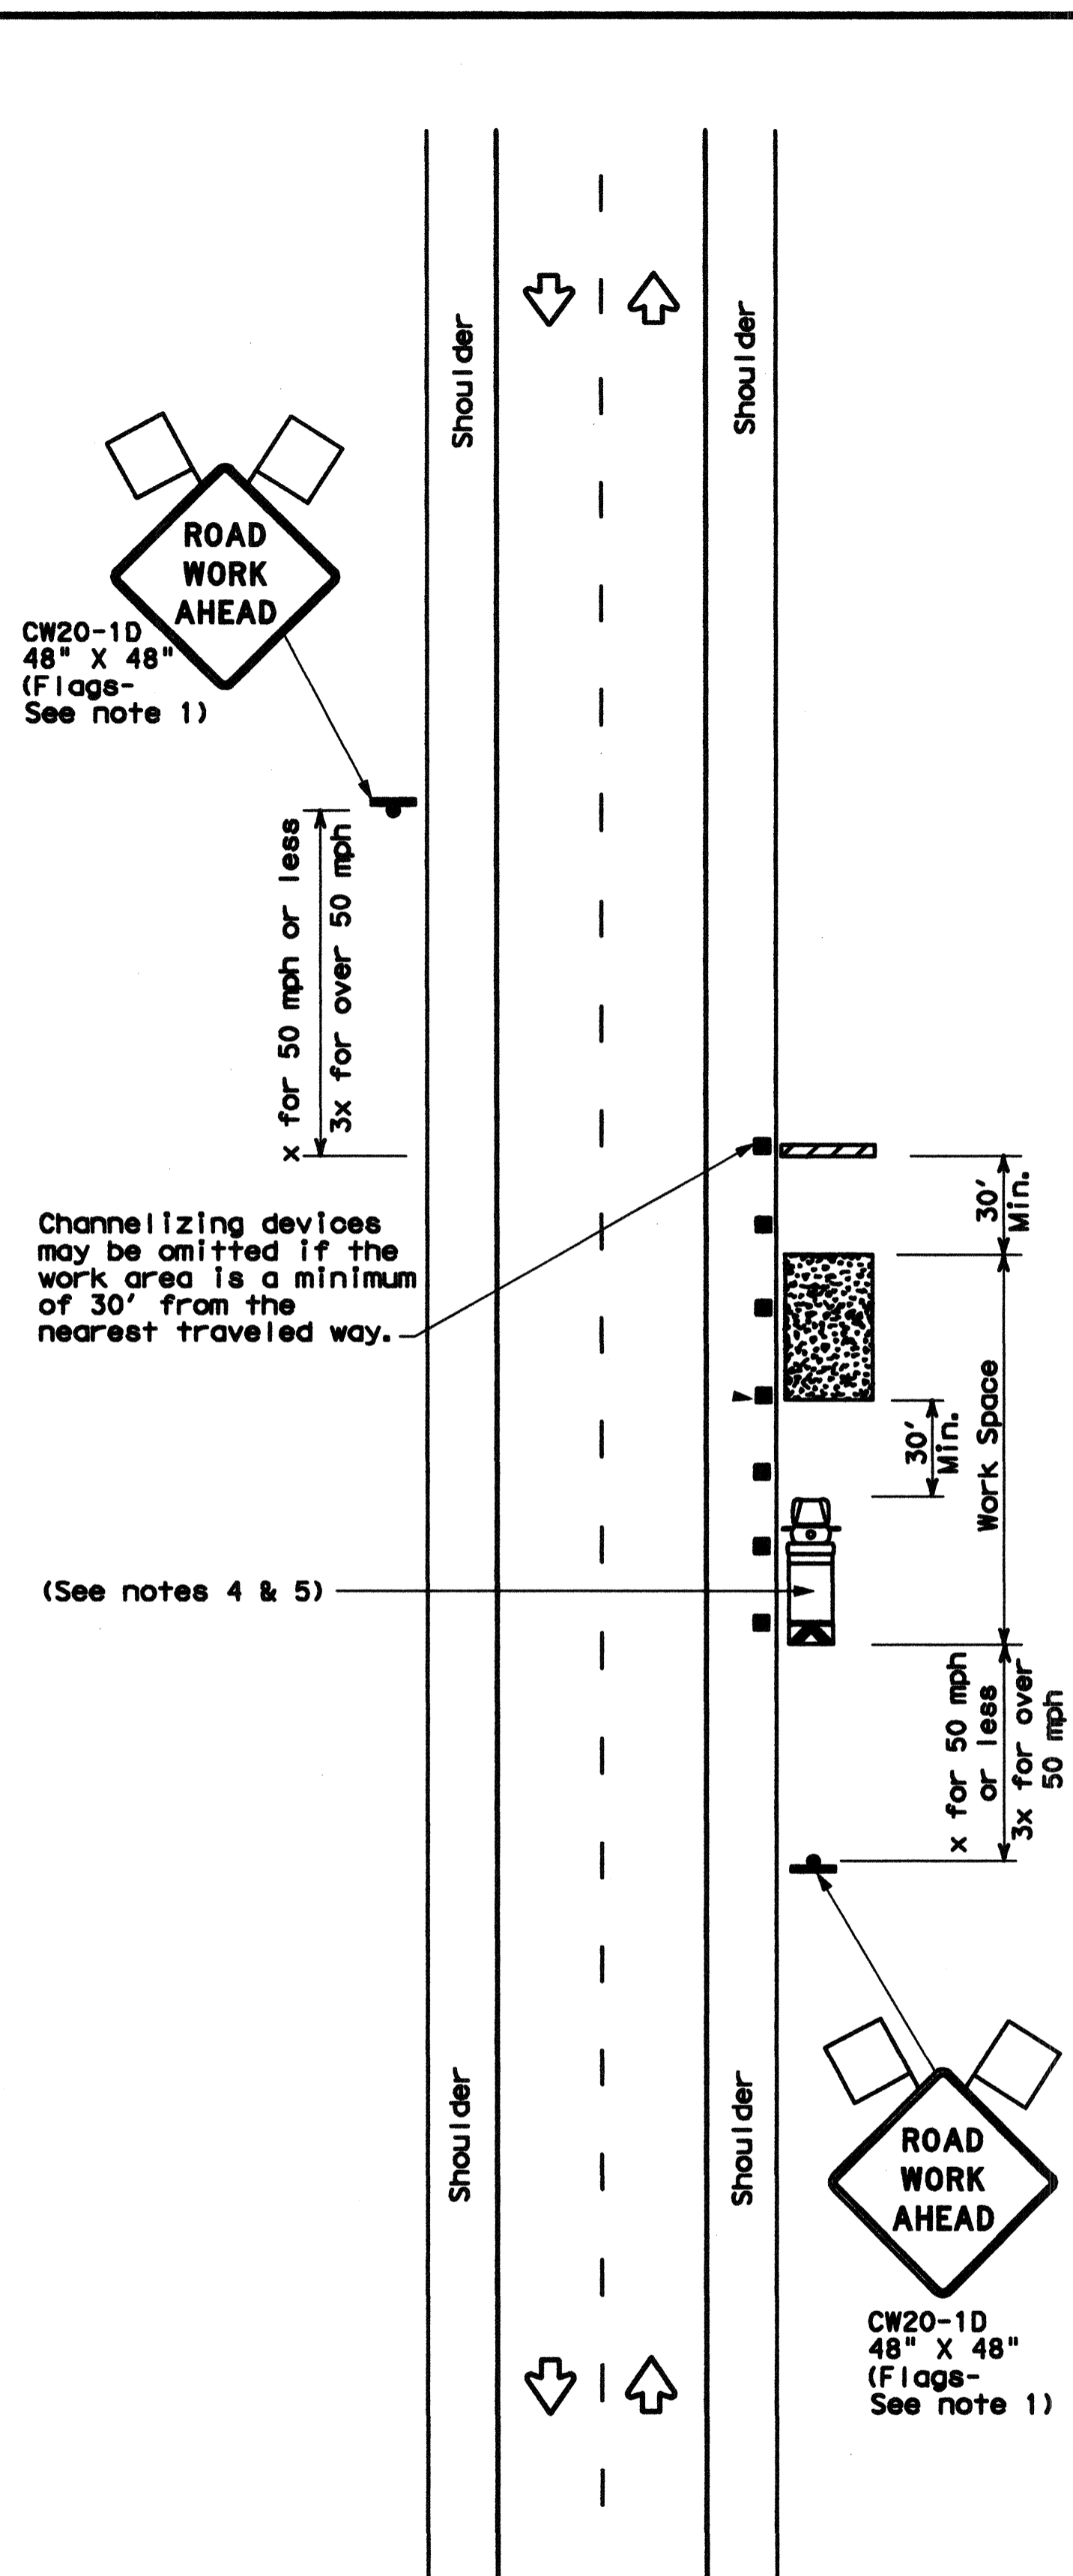


TCP (2-1a)

WORK SPACE NEAR SHOULDER
Conventional Roads

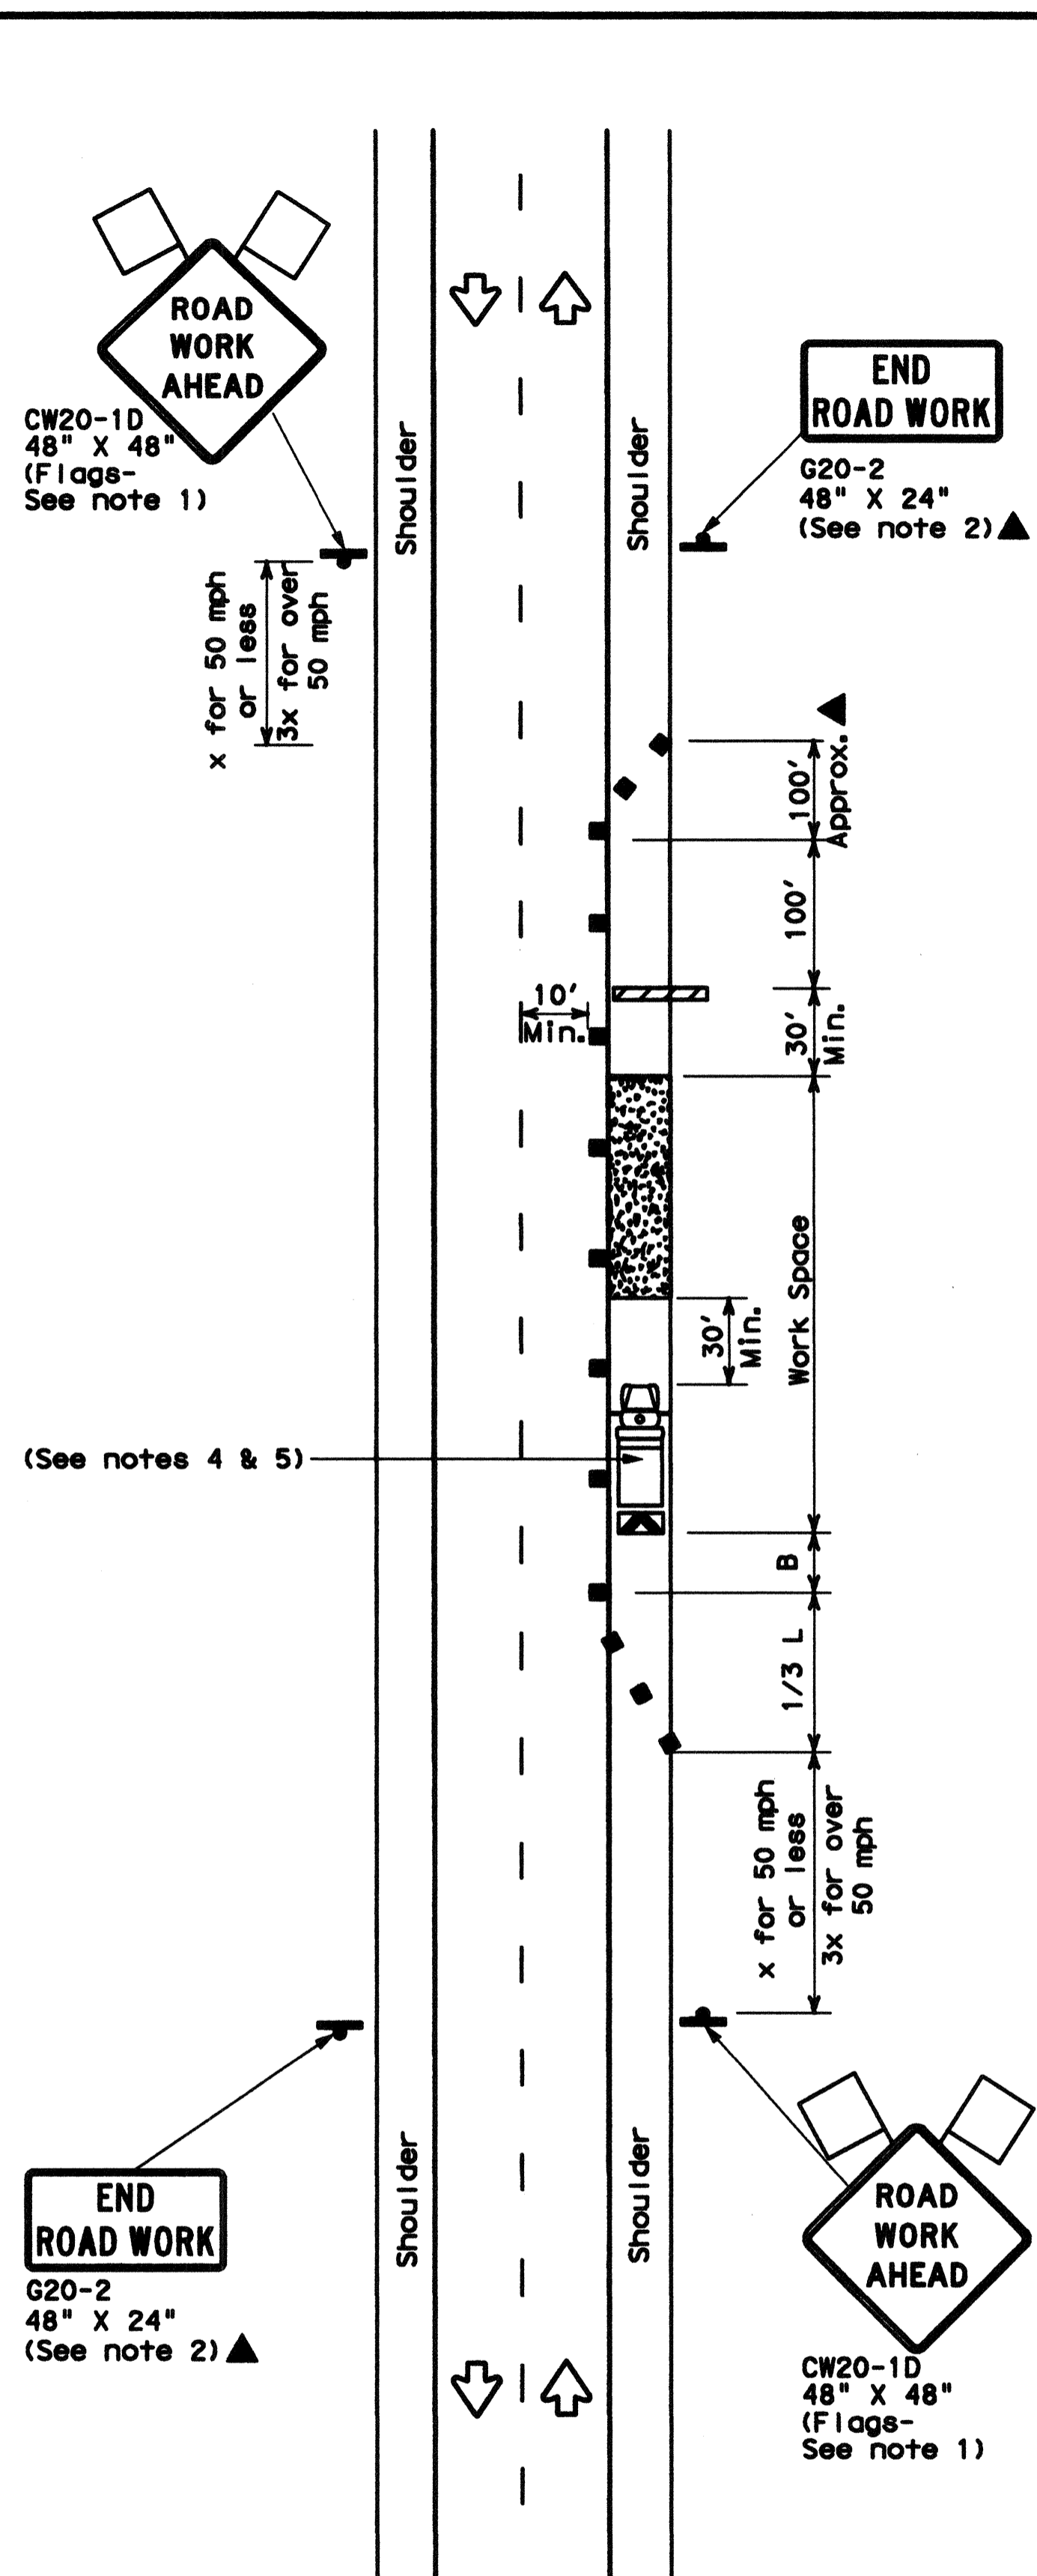

TCP (2-1b)

WORK SPACE ON SHOULDER
Conventional Roads

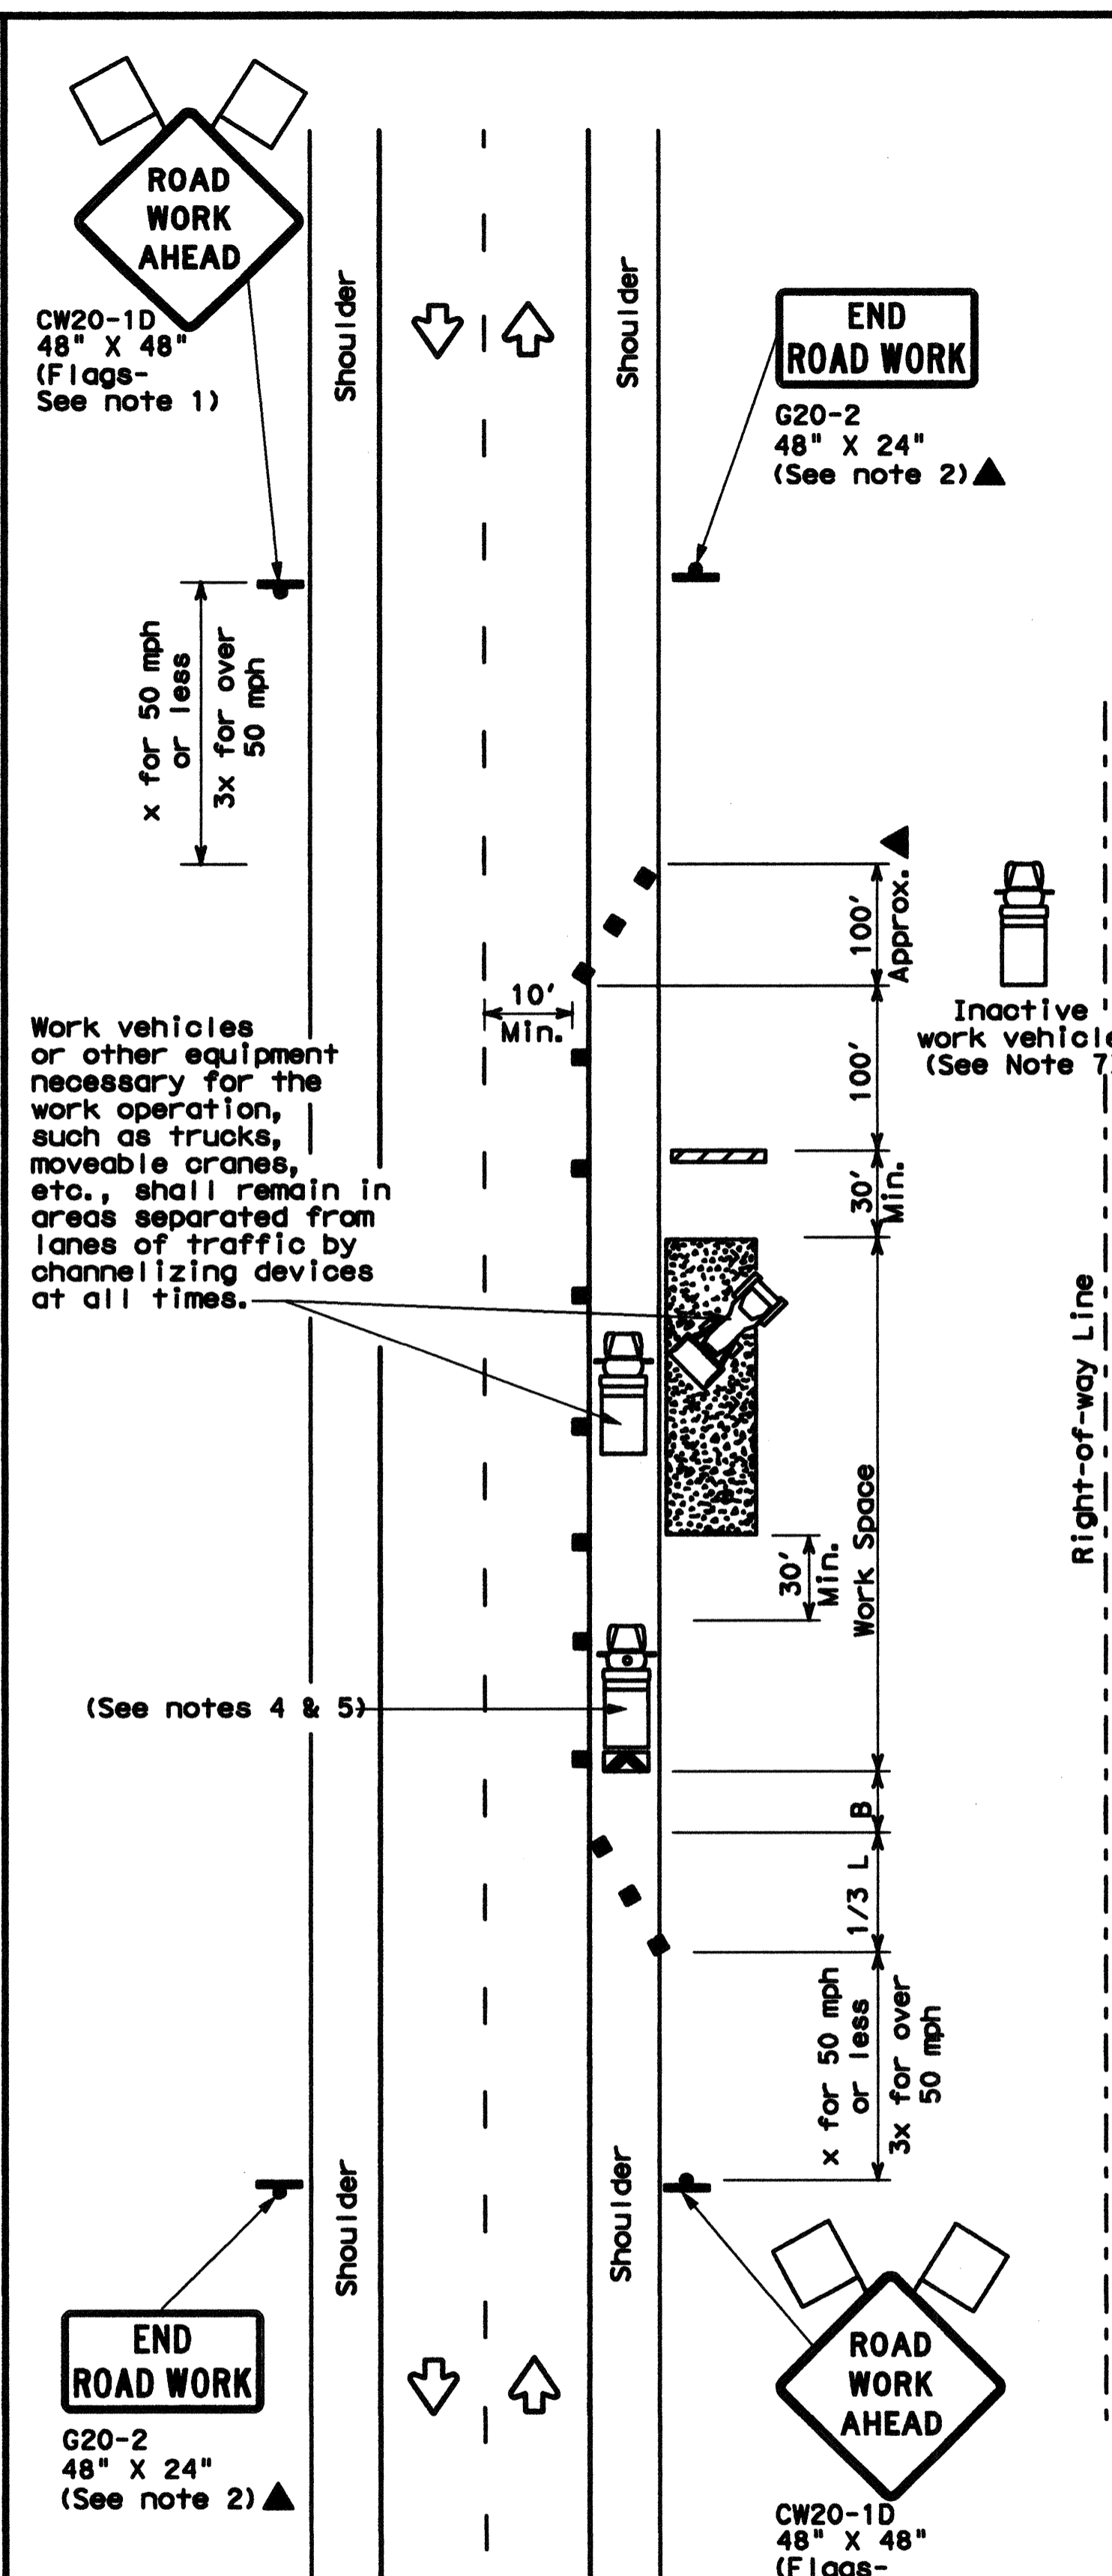

TCP (2-1c)

WORK VEHICLES ON SHOULDER
Conventional Roads

LEGEND			
	Type 3 Barricade		Channelizing Devices
	Heavy Work Vehicle		Truck Mounted Attenuator (TMA)
	Trailer Mounted Flashing Arrow Board		Portable Changeable Message Sign (PCMS)
	Sign		Traffic Flow
	Flag		Flagger

Posted Speed *	Formula	Minimum Desirable Taper Lengths **			Suggested Maximum Spacing of Channelizing Devices		Minimum Sign Spacing "x" Distance	Suggested Longitudinal Buffer Space "B"
		10' Offset	11' Offset	12' Offset	On a Taper	On a Tangent		
30	L = WS ² / 60	150'	165'	180'	30'	60'	120'	90'
35		205'	225'	245'	35'	70'	160'	120'
40	L = WS	265'	295'	320'	40'	80'	240'	155'
45		450'	495'	540'	45'	90'	320'	195'
50	L = WS	500'	550'	600'	50'	100'	400'	240'
55		550'	605'	660'	55'	110'	500'	295'
60	L = WS	600'	660'	720'	60'	120'	600'	350'
65		650'	715'	780'	65'	130'	700'	410'
70	L = WS	700'	770'	840'	70'	140'	800'	475'
75		750'	825'	900'	75'	150'	900'	540'

* Conventional Roads Only
 ** Taper lengths have been rounded off.
 L=Length of Taper (FT) W=Width of Offset (FT) S=Posted Speed (MPH)

TYPICAL USAGE				
MOBILE	SHORT DURATION	SHORT TERM STATIONARY	INTERMEDIATE TERM STATIONARY	LONG TERM STATIONARY
	✓	✓	✓	✓

- GENERAL NOTES**
- Flags attached to signs where shown, are REQUIRED.
 - All traffic control devices illustrated are REQUIRED, except those denoted with the triangle symbol may be omitted when stated in the plans, or for routine maintenance work, when approved by the Engineer.
 - Stockpiled material should be placed a minimum of 30 feet from nearest traveled way.
 - Shadow Vehicle with TMA and high intensity rotating, flashing, oscillating or strobe lights. A Shadow Vehicle with a TMA should be used anytime it can be positioned 30 to 100 feet in advance of the area of crew exposure without adversely affecting the performance or quality of the work. If workers are no longer present but road or work conditions require the traffic control to remain in place, Type 3 Barricades or other channelizing devices may be substituted for the Shadow Vehicle and TMA.
 - Additional Shadow Vehicles with TMAs may be positioned off the paved surface, next to those shown in order to protect a wider work space.
 - See TCP(5-1) for shoulder work on divided highways, expressways and freeways.
 - Inactive work vehicles or other equipment should be parked near the right-of-way line and not parked on the paved shoulder.
 - CW21-5 "SHOULDER WORK" signs may be used in place of CW21-1D "ROAD WORK AHEAD" signs for shoulder work on conventional roadways.

For construction or maintenance contract work, specific project requirements for shadow vehicles can be found in the project GENERAL NOTES for Item 502, Barricades, Signs and Traffic Handling.

Texas Department of Transportation
Traffic Operations Division


TRAFFIC CONTROL PLAN
CONVENTIONAL ROAD
SHOULDER WORK

TCP (2-1)-12


© TxDOT December 1985		DN: TxDOT	CK: TxDOT	DN: TxDOT	CK: TxDOT
REVISIONS		CONT	SECT	JOB	HIGHWAY
2-94	2-12				
8-95					
1-97		DIST	COUNTY		SHEET NO.
4-98					

DATE: FILE:

DISCLAIMER: The use of this standard is governed by the "Texas Engineering Practice Act". No warranty of any kind is made by TxDOT for any purpose whatsoever. TxDOT assumes no responsibility for the consequences of its use or for inaccuracy or for incorrect results or damages resulting from its use.

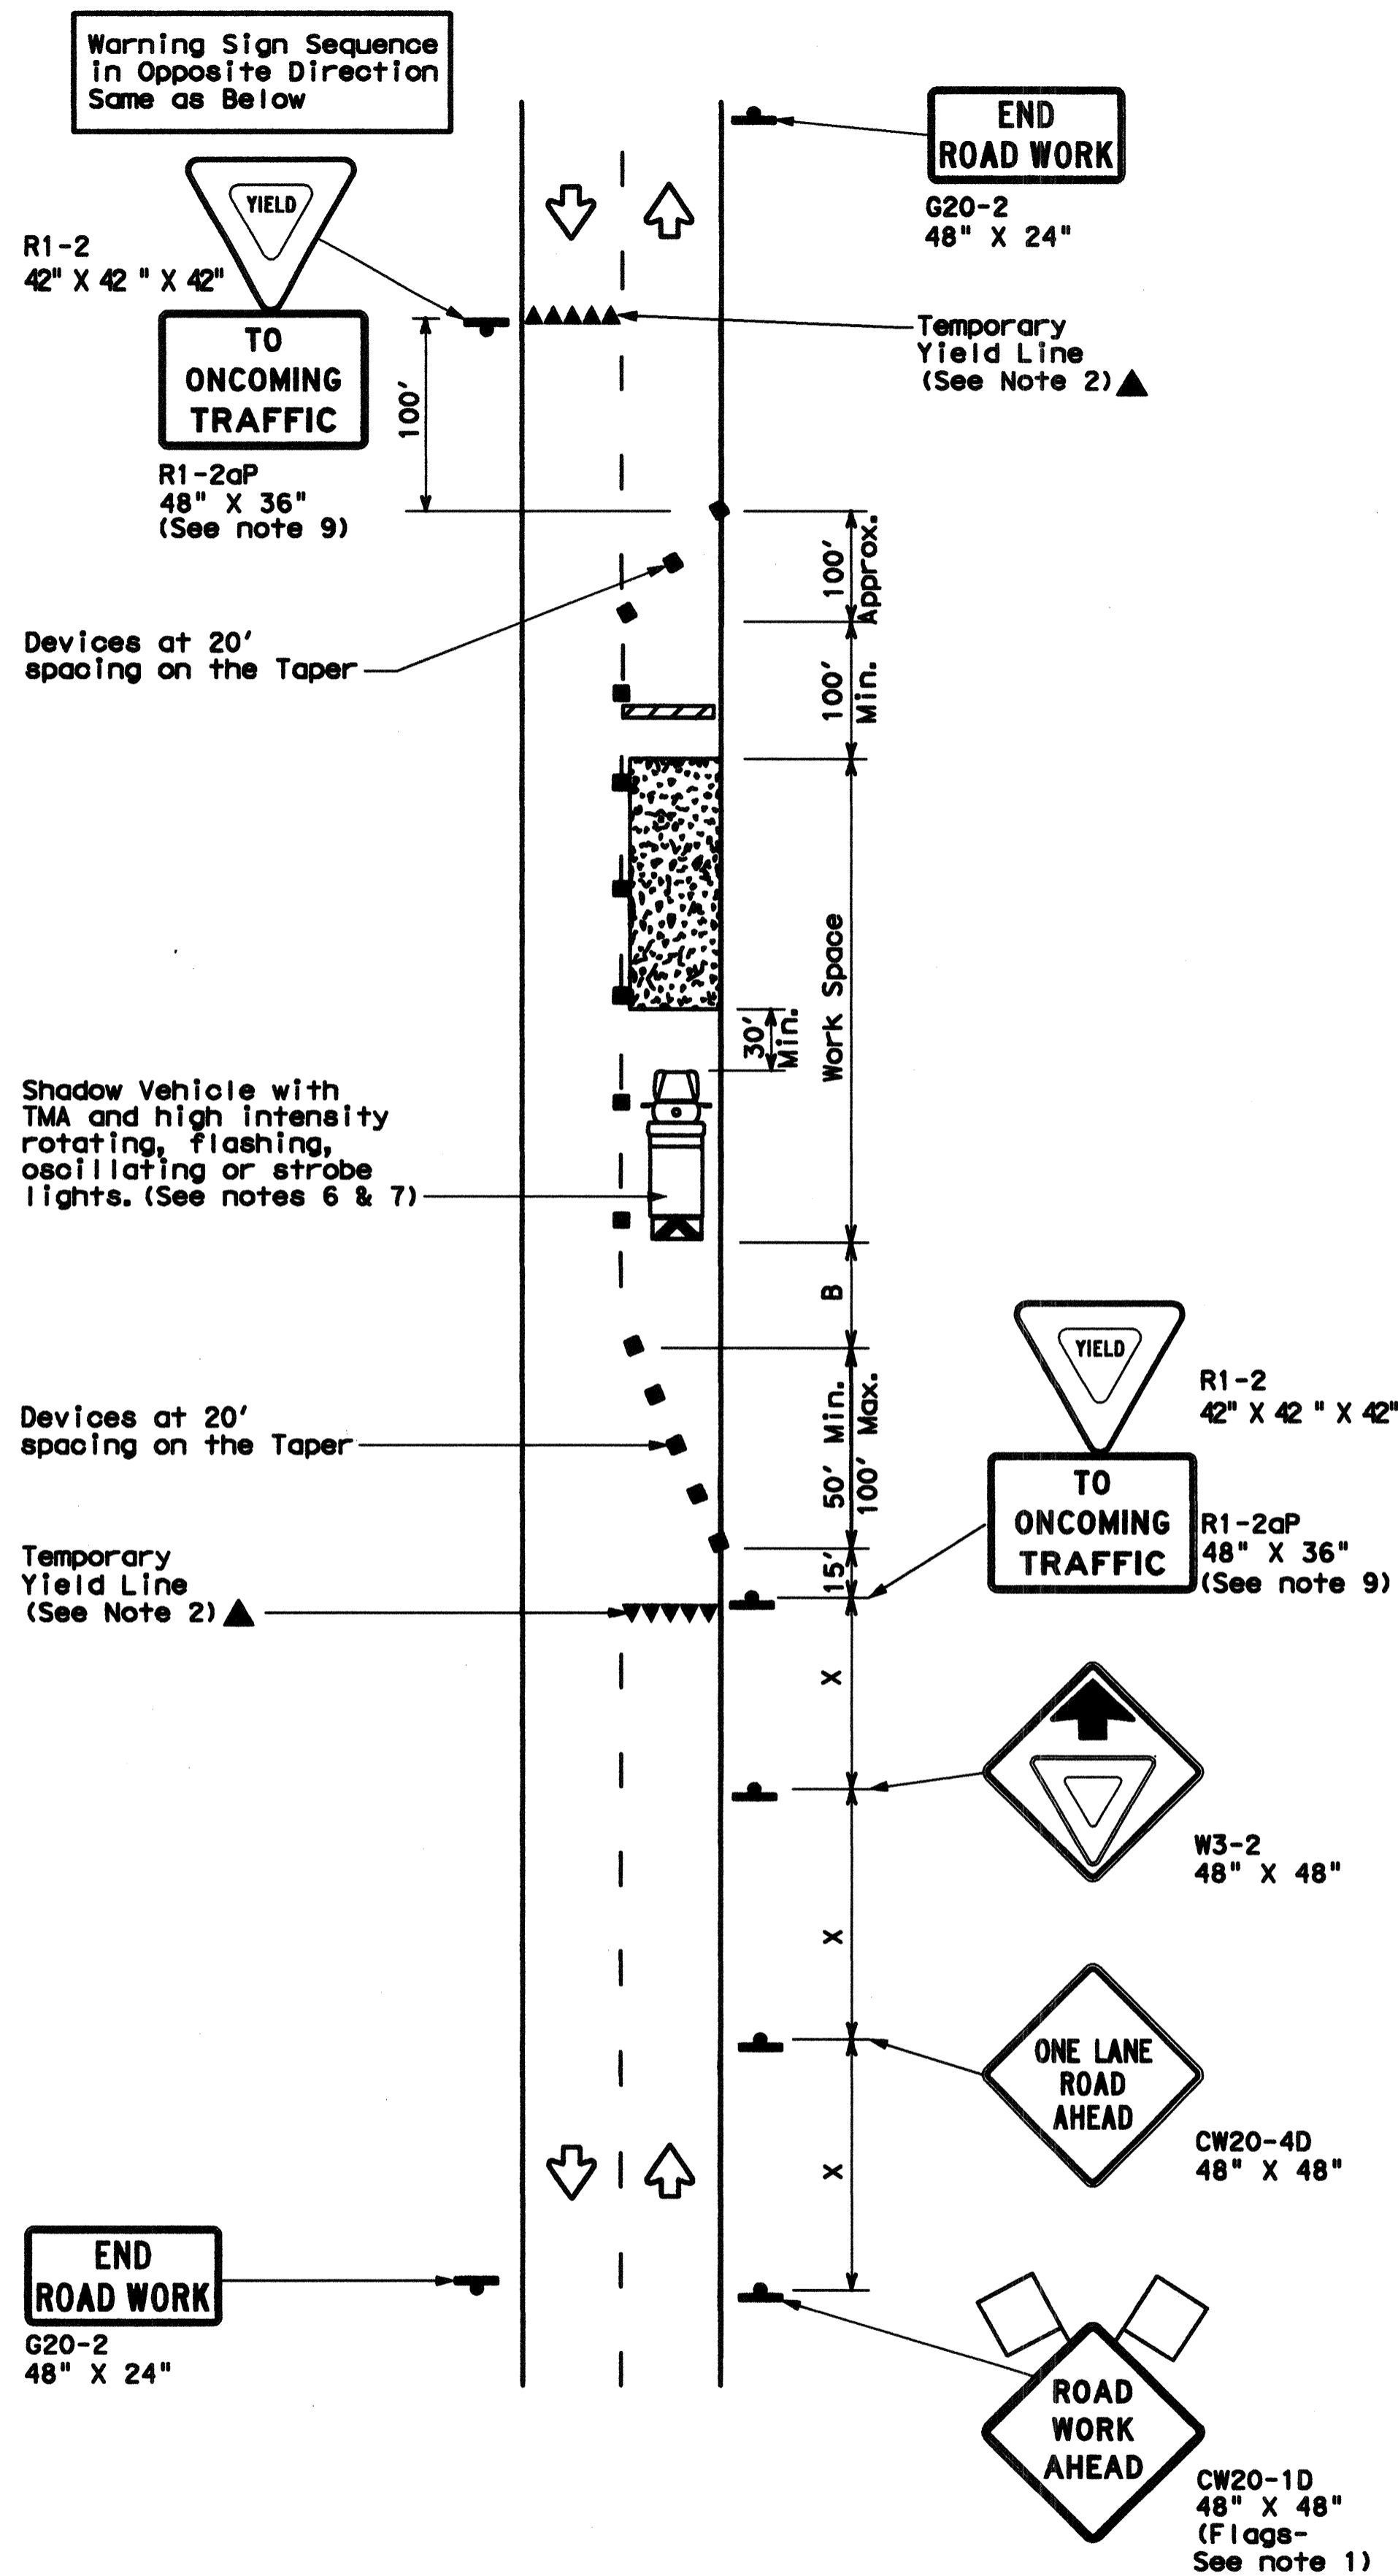

TCP (2-2a)
2-LANE ROADWAY WITHOUT PAVED SHOULDERS
ONE LANE TWO-WAY
CONTROL WITH YIELD SIGNS
(Less than 2000 ADT - See Note 9)

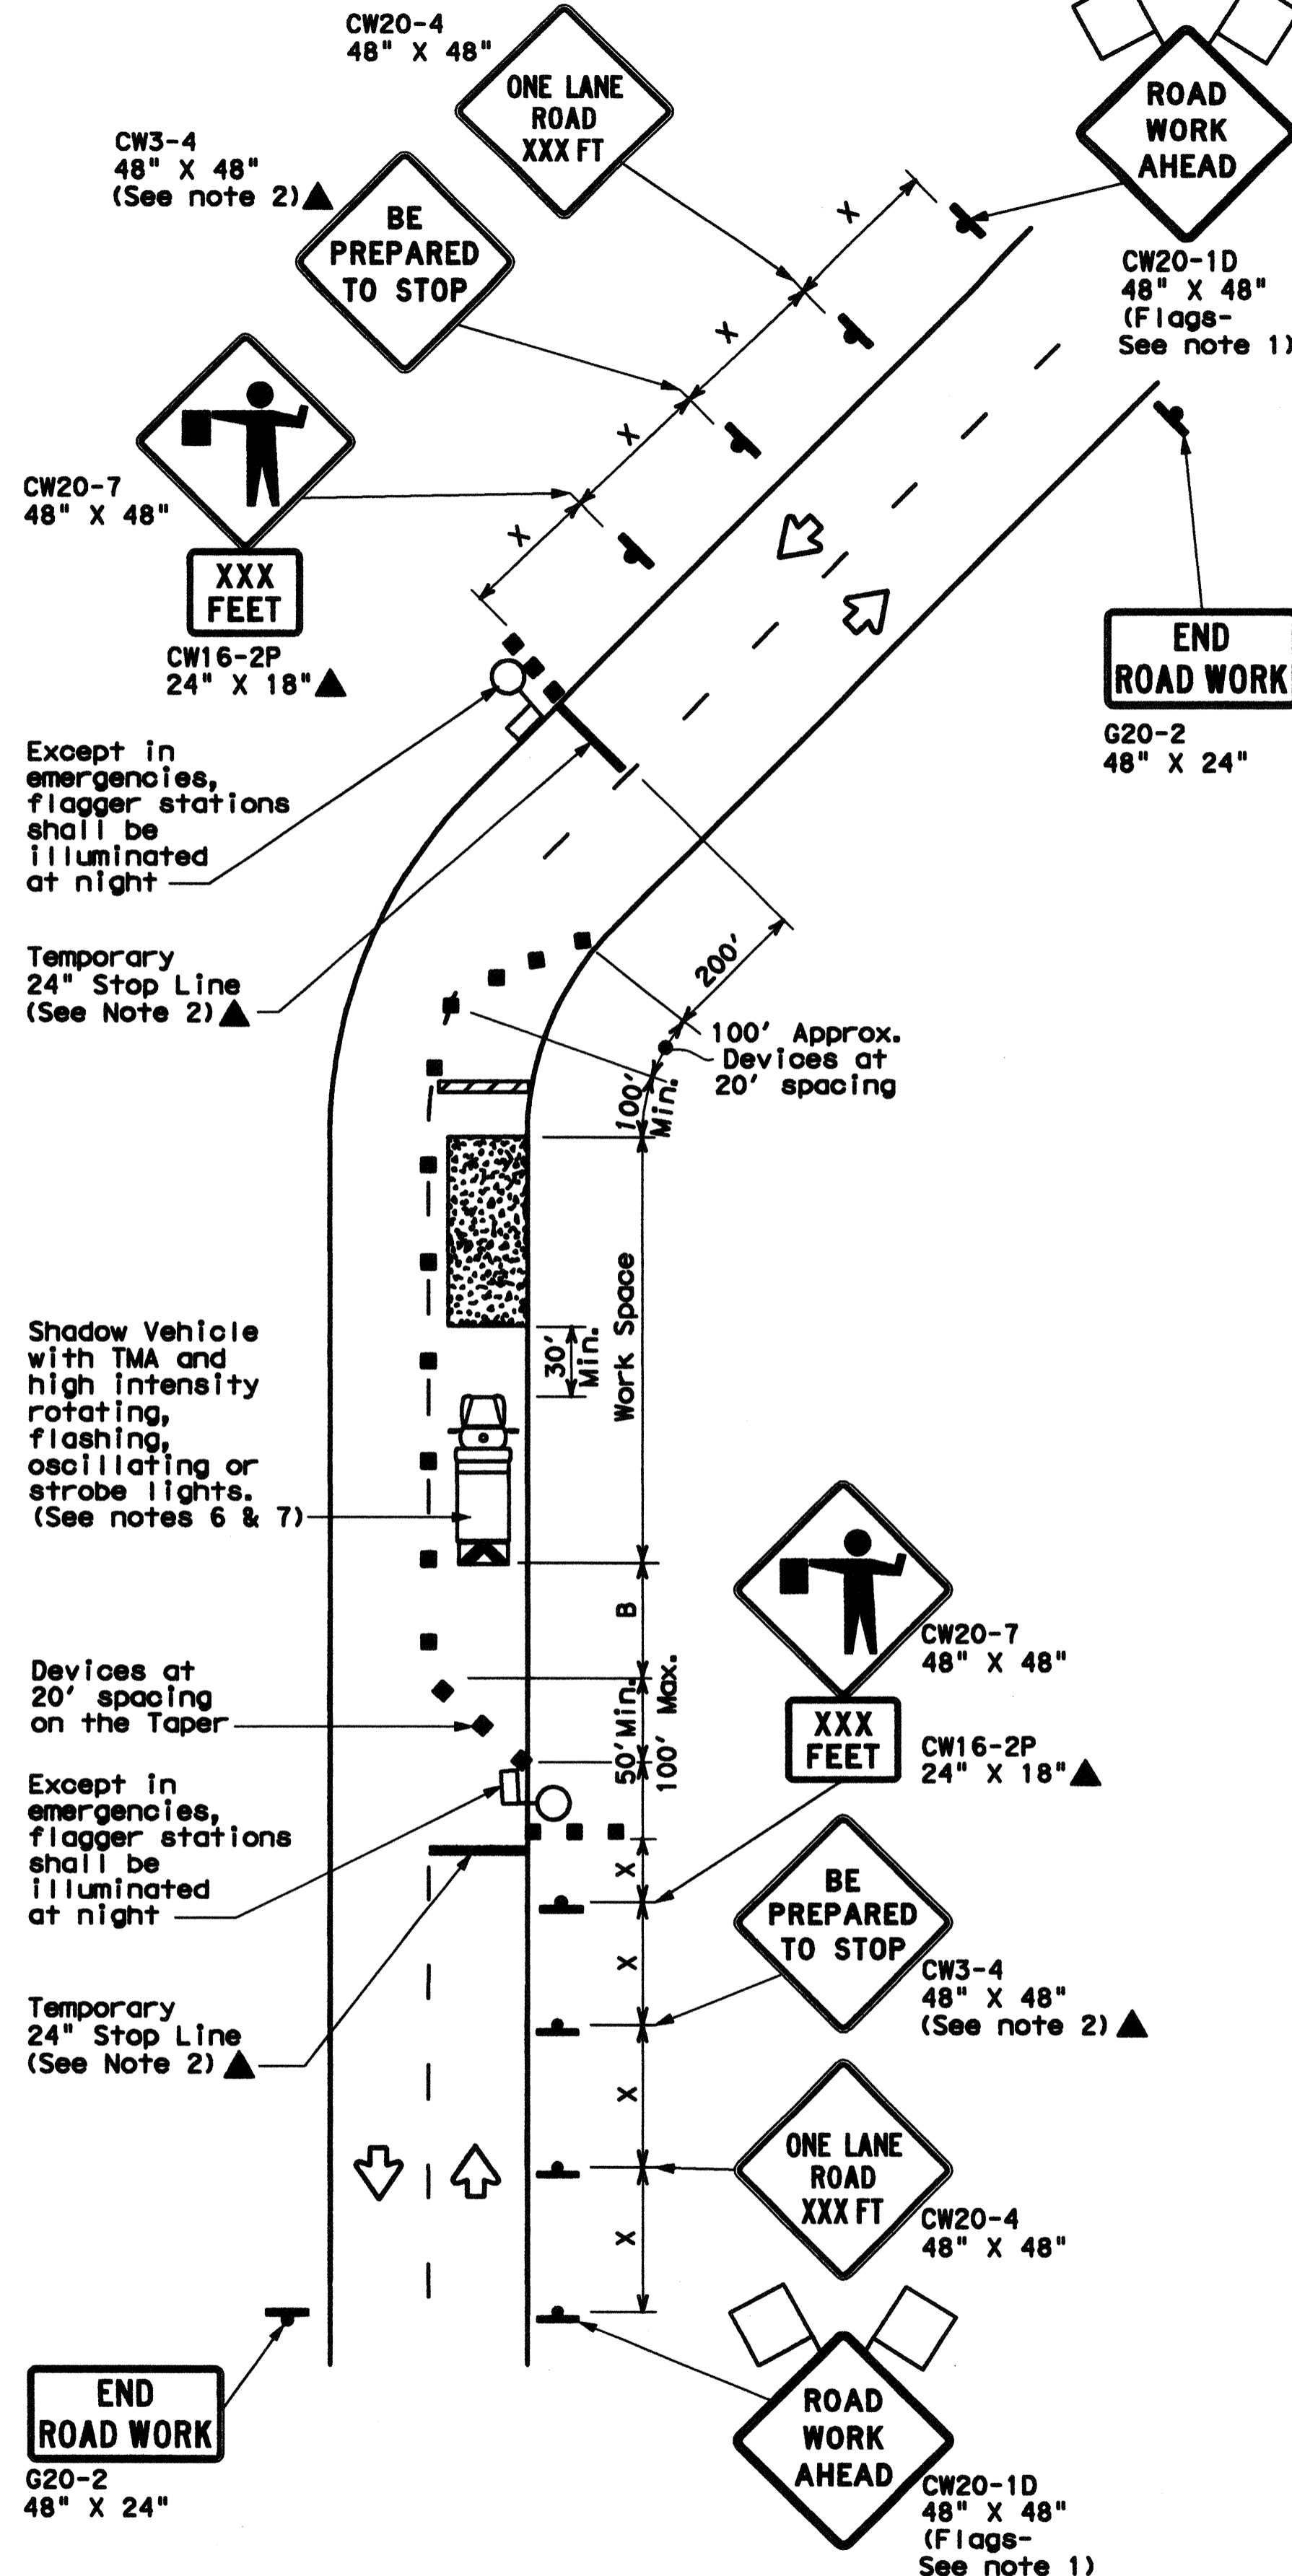

TCP (2-2b)
2-LANE ROADWAY WITHOUT PAVED SHOULDERS
ONE LANE TWO-WAY
CONTROL WITH FLAGGERS

LEGEND			
	Type 3 Barricade		Channelizing Devices
	Heavy Work Vehicle		Truck Mounted Attenuator (TMA)
	Trailer Mounted Flashing Arrow Board		Portable Changeable Message Sign (PCMS)
	Sign		Traffic Flow
	Flag		Flagger

Posted Speed *	Formula	Minimum Desirable Taper Lengths **			Suggested Maximum Spacing of Channelizing Devices		Minimum Sign Spacing "x" Distance	Suggested Longitudinal Buffer Space "B"	Stopping Sight Distance
		10' Offset	11' Offset	12' Offset	On a Taper	On a Tangent			
30	$L = \frac{WS^2}{60}$	150'	165'	180'	30'	60'	120'	90'	200'
35		205'	225'	245'	35'	70'	160'	120'	250'
40		265'	295'	320'	40'	80'	240'	155'	305'
45	L=WS	450'	495'	540'	45'	90'	320'	195'	360'
50		500'	550'	600'	50'	100'	400'	240'	425'
55		550'	605'	660'	55'	110'	500'	295'	495'
60		600'	660'	720'	60'	120'	600'	350'	570'
65		650'	715'	780'	65'	130'	700'	410'	645'
70		700'	770'	840'	70'	140'	800'	475'	730'
75		750'	825'	900'	75'	150'	900'	540'	820'

* Conventional Roads Only
** Taper lengths have been rounded off.
L=Length of Taper(FT) W=Width of Offset(FT) S=Posted Speed(MPH)

TYPICAL USAGE				
MOBILE	SHORT DURATION	SHORT TERM STATIONARY	INTERMEDIATE TERM STATIONARY	LONG TERM STATIONARY
	✓	✓	✓	

GENERAL NOTES

- Flags attached to signs where shown, are REQUIRED.
- All traffic control devices illustrated are REQUIRED, except those denoted with the triangle symbol may be omitted when stated elsewhere in the plans, or for routine maintenance work, when approved by the Engineer.
- The CW3-4 "BE PREPARED TO STOP" sign may be installed after the CW20-4 "ONE LANE ROAD XXX FT" sign, but proper sign spacing shall be maintained.
- Flaggers should use two-way radios or other methods of communication to control traffic.
- Length of work space should be based on the ability of flaggers to communicate.
- A Shadow Vehicle with a TMA should be used anytime it can be positioned 30 to 100 feet in advance of the area of crew exposure without adversely affecting the performance or quality of the work. If workers are no longer present but road or work conditions require the traffic control to remain in place, Type 3 Barricades or other channelizing devices may be substituted for the Shadow Vehicle and TMA. If workers are no longer present but road or work conditions require the traffic control to remain in place, Type 3 Barricades or other channelizing devices may be substituted for the Shadow Vehicle and TMA.
- Additional Shadow Vehicles with TMAs may be positioned off the paved surface, next to those shown in order to protect a wider work space.

TCP (2-2a)

- The R1-2 "YIELD" sign traffic control may be used on projects with approaches that have adequate sight distance. For projects in urban areas, work space should be no longer than one half city block. In rural areas, roadways with less than 2000 ADT, work space should be no longer than 400 feet.
- The R1-2aP "YIELD TO ONCOMING TRAFFIC" sign shall be placed on a support at a 7 foot minimum mounting height.

TCP (2-2b)

- Channelizing devices on the center line may be omitted when a pilot car is leading traffic and approved by the Engineer.
- If the work space is located near a horizontal or vertical curve, the buffer distances should be increased in order to maintain stopping sight distance to the flagger and a queue of stopped vehicles. (See table above).
- Flaggers should use 24" STOP/SLOW paddles to control traffic. Flags should be limited to emergency situations.

For construction or maintenance contract work, specific project requirements for shadow vehicles can be found in the project GENERAL NOTES for Item 502, Barricades, Signs and Traffic Handling.

Texas Department of Transportation
Traffic Operations Division



TRAFFIC CONTROL PLAN
ONE-LANE TWO-WAY
TRAFFIC CONTROL

TCP (2-2) - 12

© TxDOT December 1985		DN: TxDOT	CK: TxDOT	DW: TxDOT	CK: TxDOT
REVISIONS		CONT	SECT	JOB	HIGHWAY
8-95	2-12				
1-97					
4-98					
3-03					
DIST		COUNTY		SHEET NO.	

DISCLAIMER: The use of this standard is governed by the "Texas Engineering Practice Act". No warranty of any kind is made by TxDOT for any purpose whatsoever. TxDOT assumes no responsibility for the conversion of this standard to other formats or for inaccuracies or damages resulting from its use.

PAGE 1

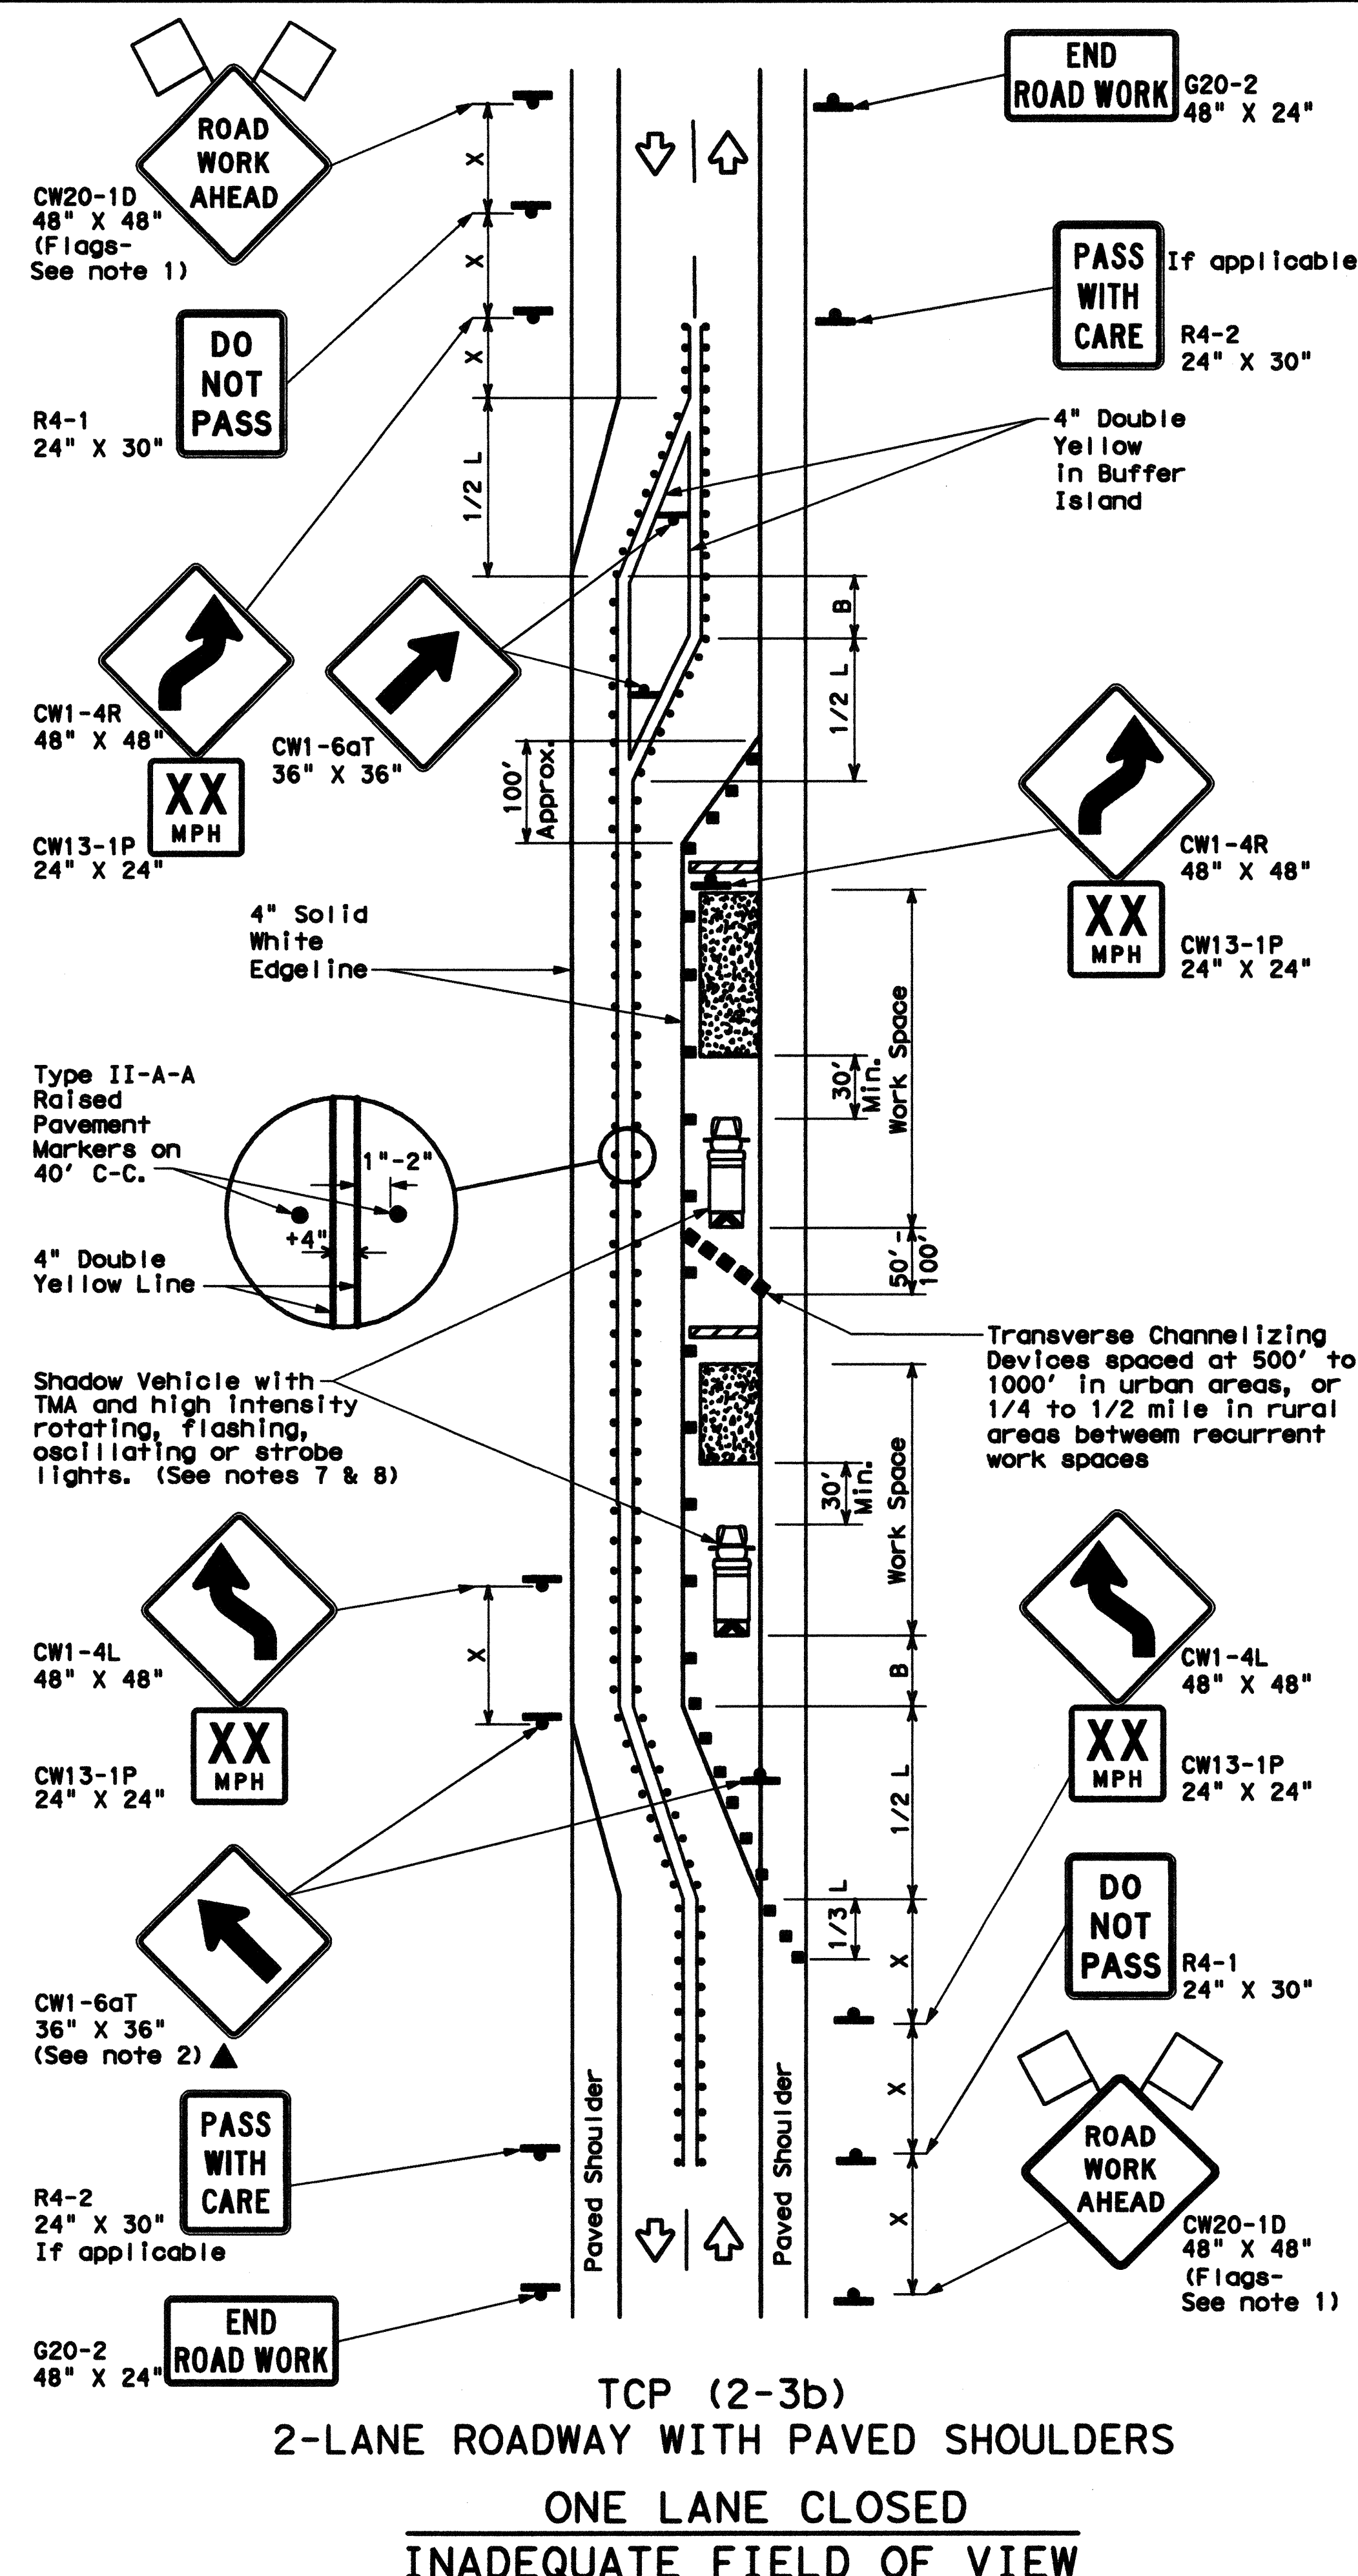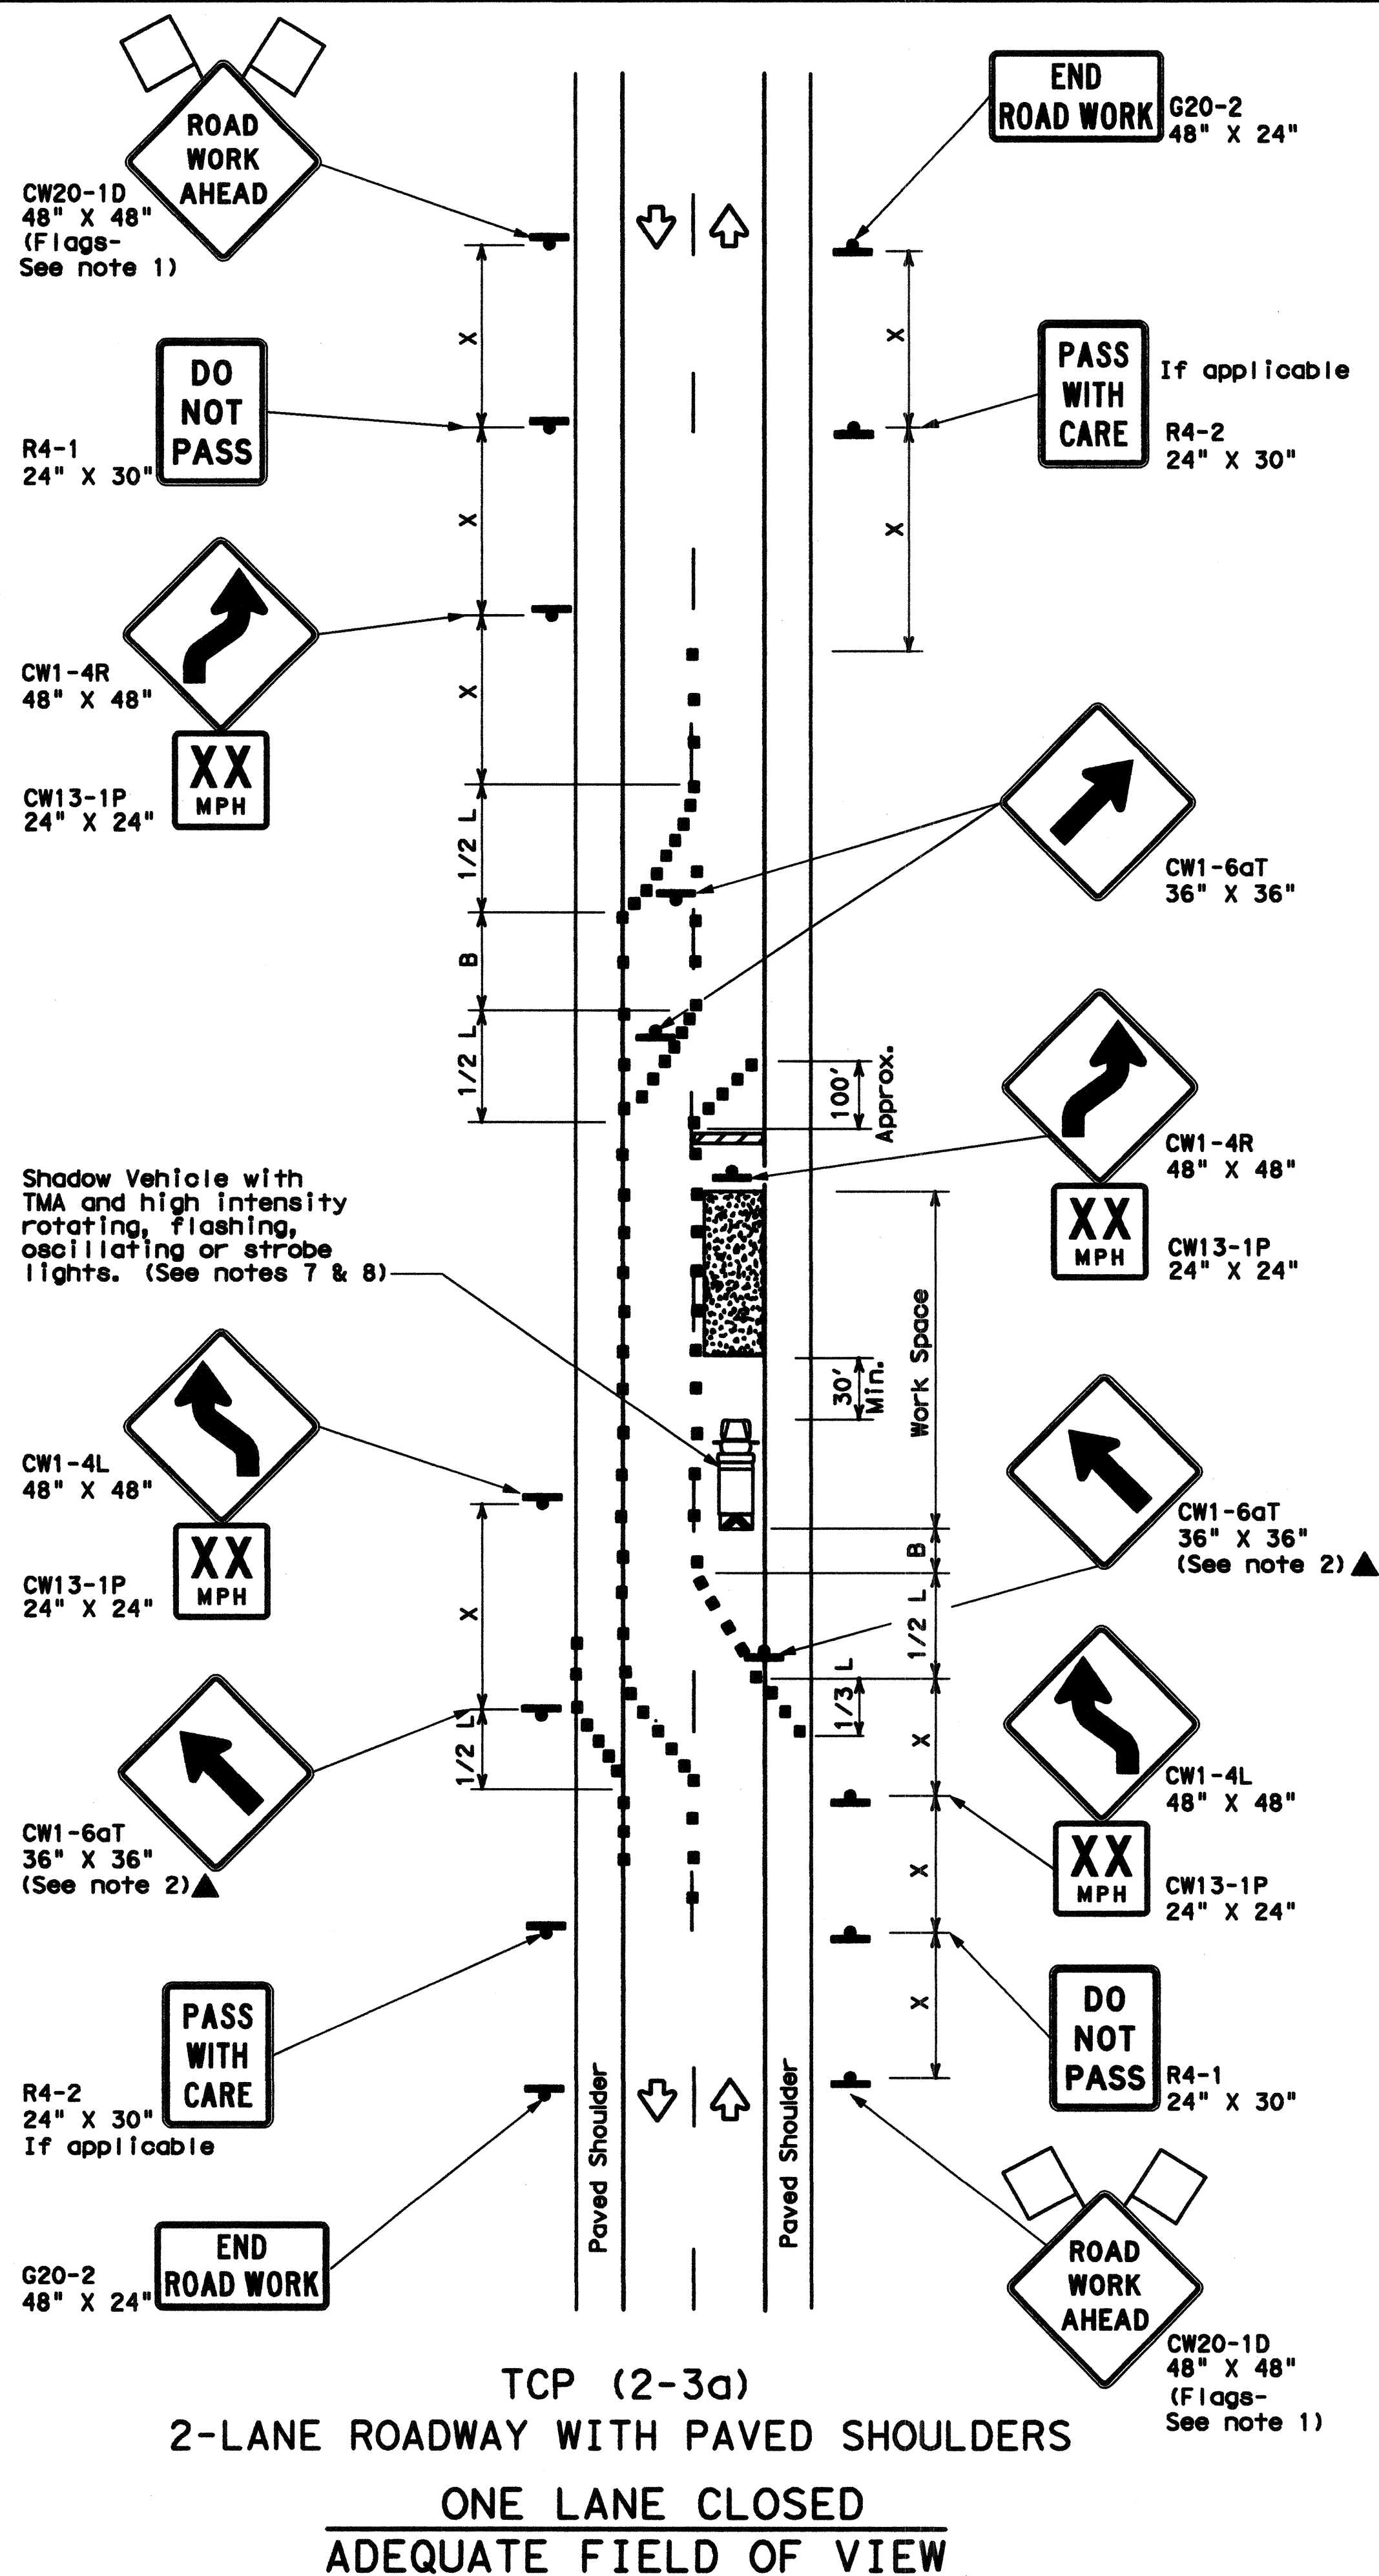

LEGEND			
	Type 3 Barricade		Channelizing Devices
	Heavy Work Vehicle		Truck Mounted Attenuator (TMA)
	Trailer Mounted Flashing Arrow Board		Raised Pavement Markers Ty II-AA
	Sign		Traffic Flow
	Flag		Flagger

Posted Speed *	Formula	Minimum Desirable Taper Lengths **			Suggested Maximum Spacing of Channelizing Devices		Minimum Sign Spacing "X" Distance	Suggested Longitudinal Buffer Space "B"
		10' Offset	11' Offset	12' Offset	On a Taper	On a Tangent		
30	L = WS ² / 60	150'	165'	180'	30'	60'	120'	90'
35		205'	225'	245'	35'	70'	160'	120'
40	L = WS	265'	295'	320'	40'	80'	240'	155'
45		450'	495'	540'	45'	90'	320'	195'
50	L = WS	500'	550'	600'	50'	100'	400'	240'
55		550'	605'	660'	55'	110'	500'	295'
60	L = WS	600'	660'	720'	60'	120'	600'	350'
65		650'	715'	780'	65'	130'	700'	410'
70	L = WS	700'	770'	840'	70'	140'	800'	475'
75		750'	825'	900'	75'	150'	900'	540'

* Conventional Roads Only
 ** Taper lengths have been rounded off.
 L=Length of Taper (FT) W=Width of Offset (FT) S=Posted Speed (MPH)

TYPICAL USAGE				
MOBILE	SHORT DURATION	SHORT TERM STATIONARY	INTERMEDIATE TERM STATIONARY	LONG TERM STATIONARY
			✓	✓
				TCP (2-3b) ONLY

- GENERAL NOTES**
- Flags attached to signs where shown, are REQUIRED.
 - All traffic control devices illustrated are REQUIRED, except those denoted with the triangle symbol may be omitted when stated elsewhere in the plans, or for routine maintenance work, when approved by the Engineer.
 - When work space will be in place less than three days existing pavement markings may remain in place. Channelizing devices shall be used to separate traffic.
 - Flagger control should NOT be used unless roadway conditions or heavy traffic volume require additional emphasis to safely control traffic. Flagger should be positioned at end of traffic queue.
 - The R4-1 "DO NOT PASS," R4-2 "PASS WITH CARE" and construction regulatory speed zone signs may be installed within CW20-1D "ROAD WORK AHEAD" signs. Proper spacing of signs shall be maintained.
 - Conflicting pavement marking shall be removed for long term projects.
 - A Shadow Vehicle with a TMA should be used anytime it can be positioned 30 to 100 feet in advance of the area of crew exposure without adversely affecting the performance or quality of the work. If workers are no longer present but road or work conditions require the traffic control to remain in place, Type 3 Barricades or other channelizing devices may be substituted.
 - Additional Shadow Vehicles with TMAs may be positioned off the paved surface, next to those shown in order to protect a wider work space.
- TCP (2-3a)**
- Conflicting pavement markings shall be removed for long-term projects. For shorter durations where traffic is directed over a yellow centerline, channelizing devices which separate two-way traffic should be spaced on tapers at 20' or 15' if posted speeds are 35 mph or slower, and for tangent sections, at 1/2(S) where S is the speed in mph. This tighter device spacing is intended for the area of the conflicting markings, not the entire work zone.

For construction or maintenance contract work, specific project requirements for shadow vehicles can be found in the project GENERAL NOTES for Item 502, Barricades, Signs and Traffic Handling.

Texas Department of Transportation
Traffic Operations Division


TRAFFIC CONTROL PLAN TRAFFIC SHIFTS ON TWO-LANE ROADS

TCP (2-3) - 12


© TxDOT December 1985				
DN: TxDOT	CK: TxDOT	DW: TxDOT	CK: TxDOT	
REVISIONS				
8-95	2-12	CONT	SECT	JOB
1-97				HIGHWAY
4-98		DIST	COUNTY	SHEET NO.
3-03				

163


DISCLAIMER: The use of this standard is governed by the "Texas Engineering Practice Act". No warranty of any kind is made by TxDOT for any purpose whatsoever. TxDOT assumes no responsibility for the conversion of this standard to other formats or for incorrect results or damages resulting from its use.

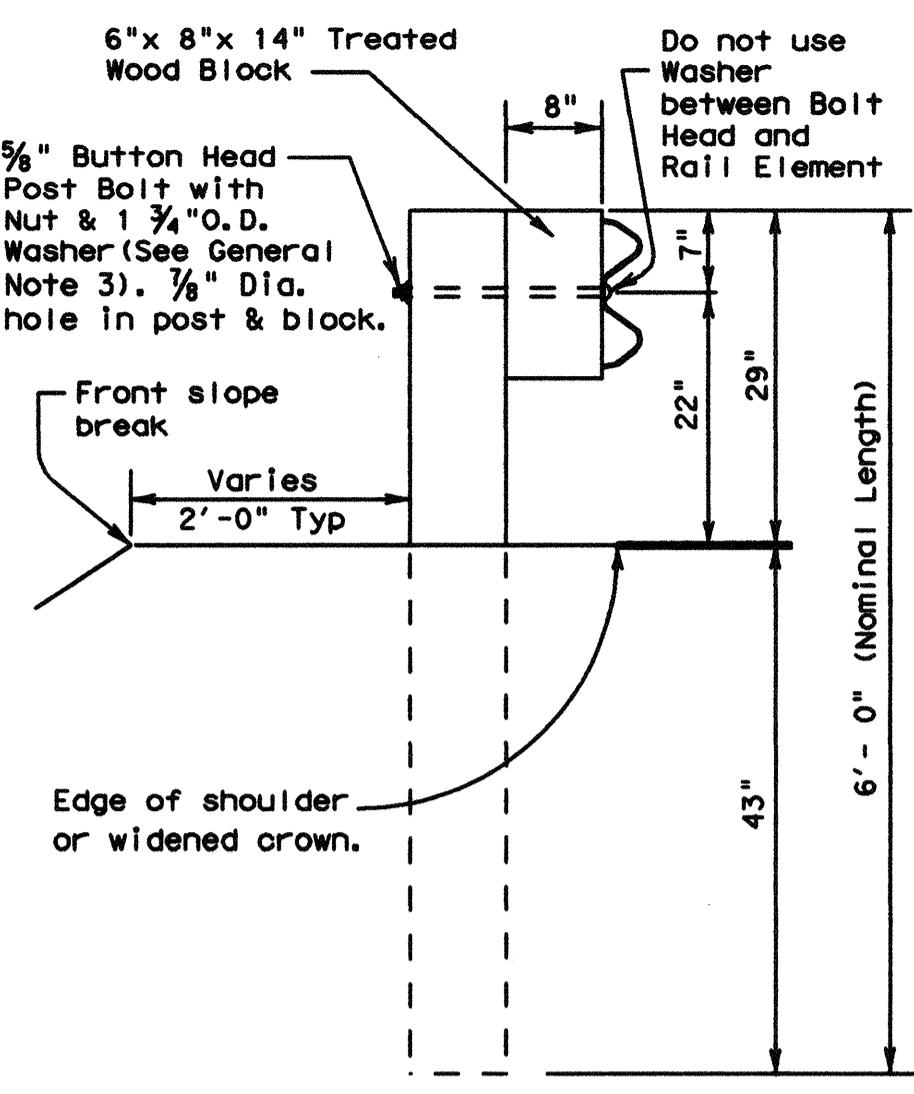

TYPICAL POST

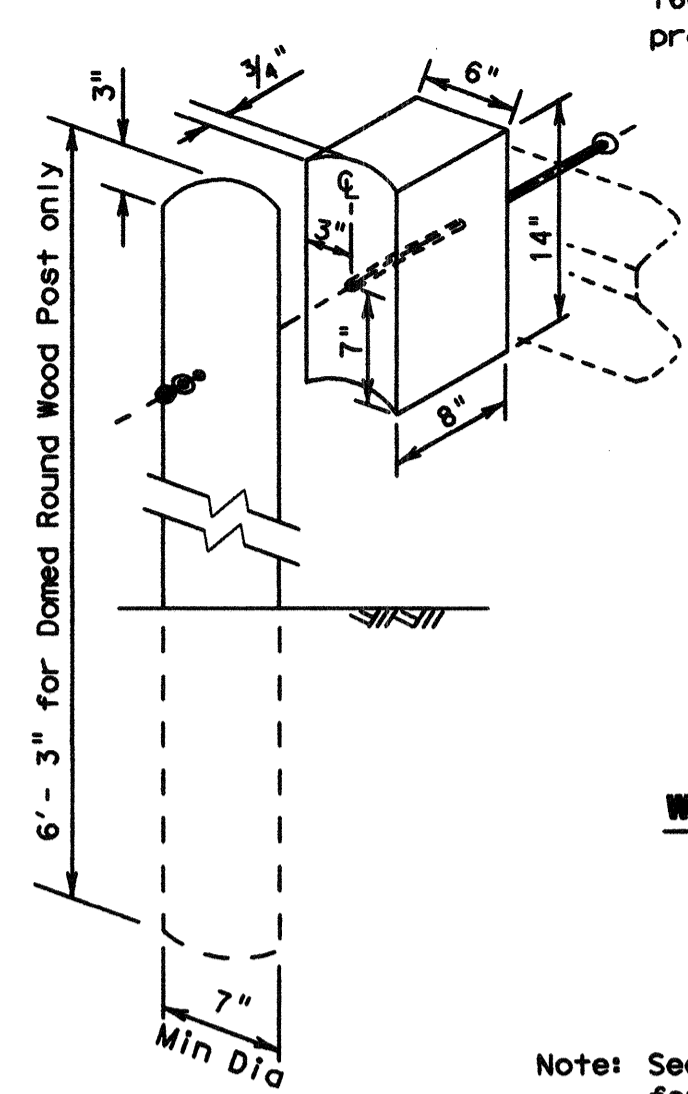


WOOD BLOCK TO ROUND WOOD POST

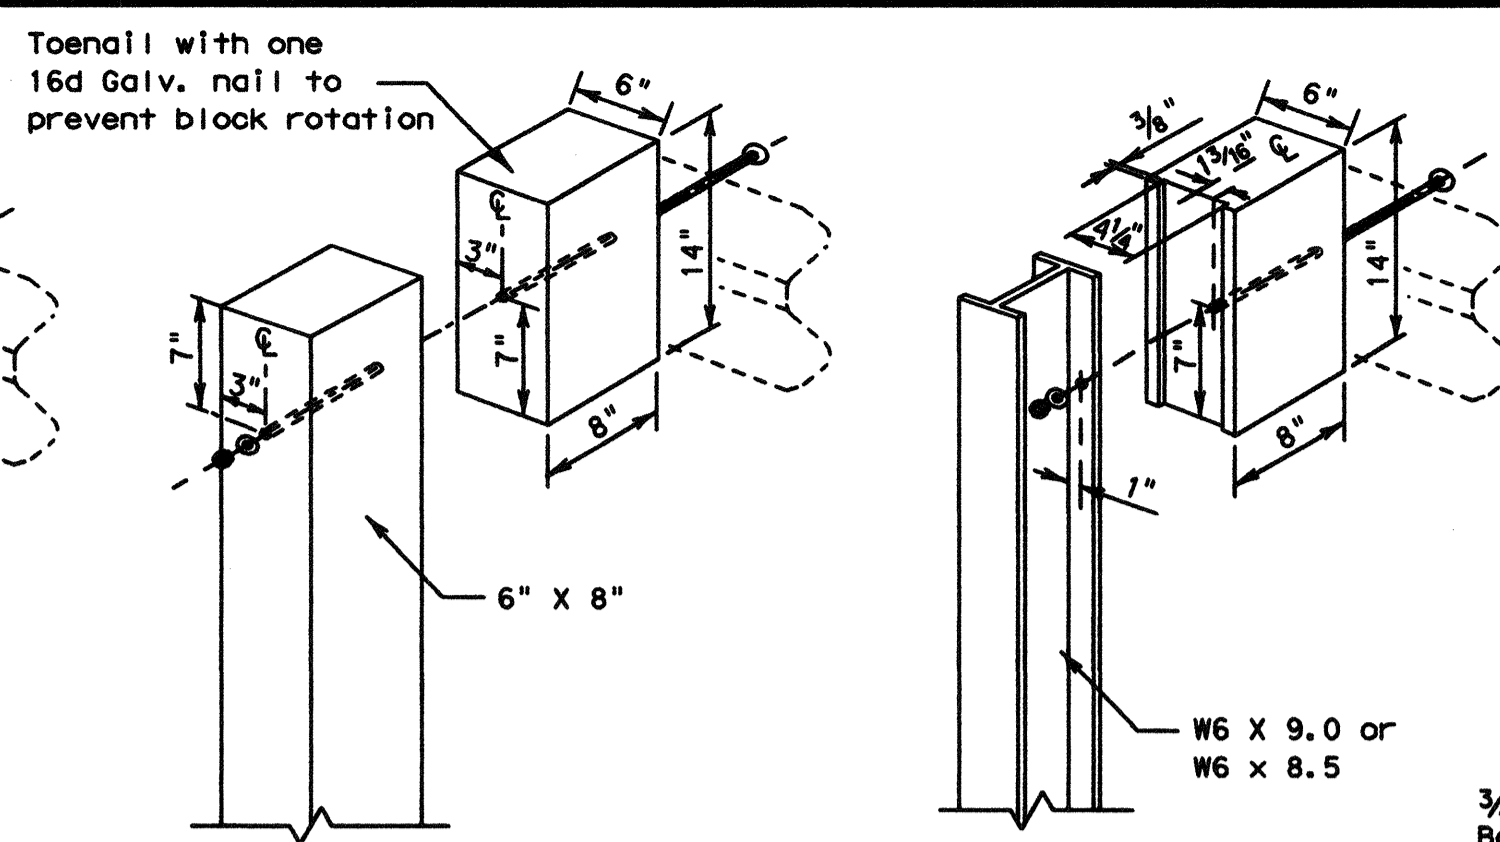


WOOD BLOCK TO RECTANGULAR WOOD POST

WOOD BLOCK TO STEEL POST

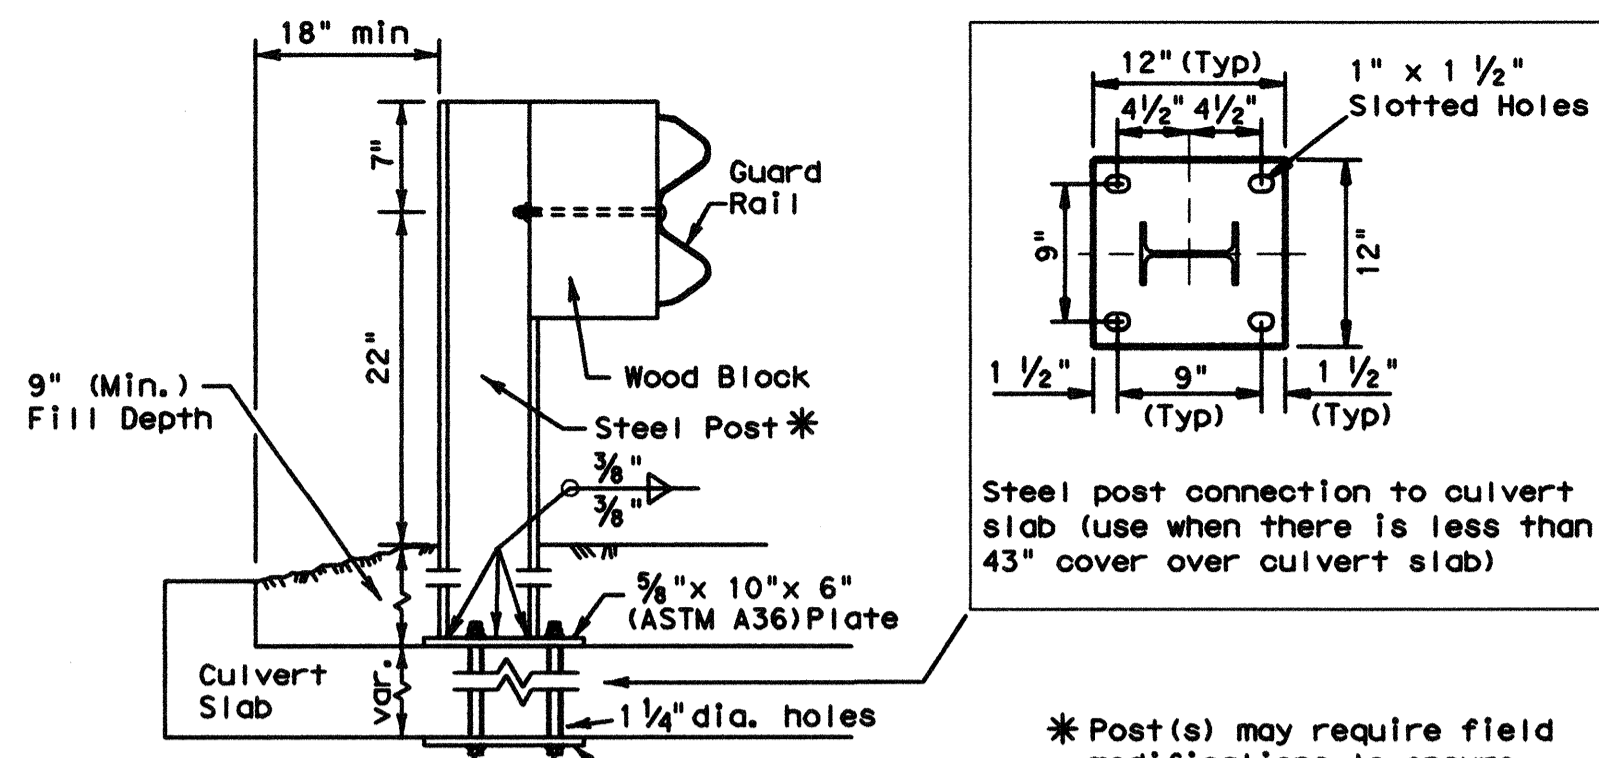


*** LOW FILL CULVERT POST**
 FOR USE ON NON-BRIDGE CLASS CULVERTS ONLY

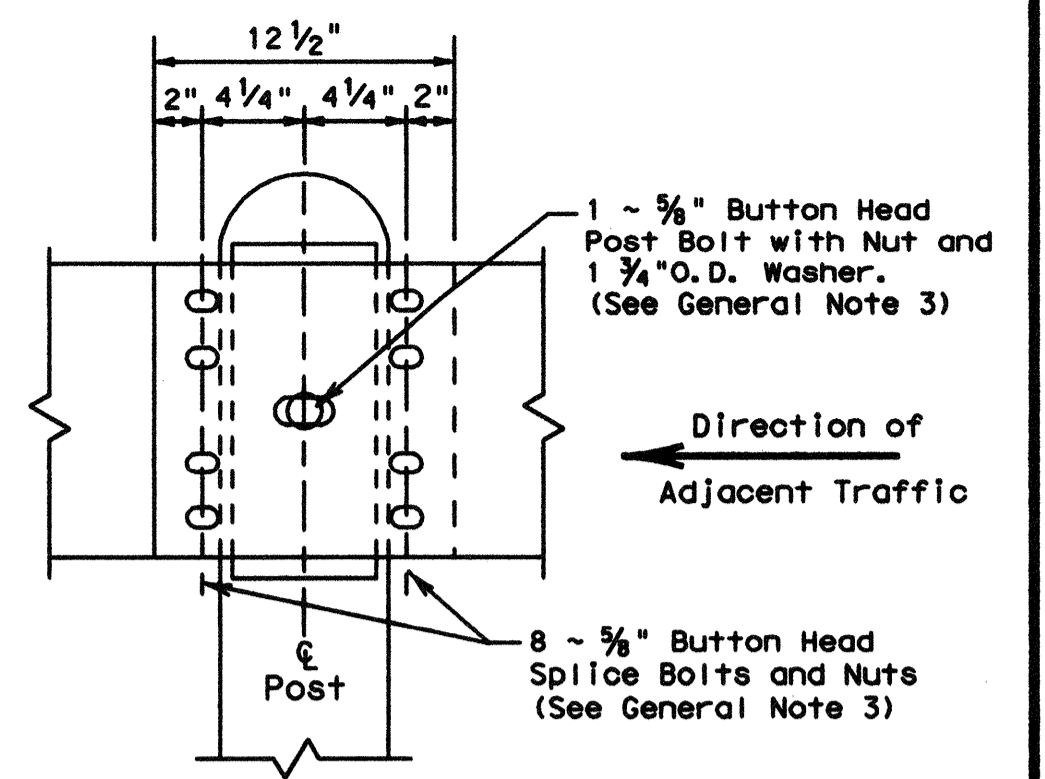


RAIL SPLICE DETAIL

GENERAL NOTES


- The type of post (round wood post, rectangular wood post, or steel post) will be shown elsewhere in the plans. The exact position of MBSG shall be shown elsewhere in the plans or as directed by the Engineer. Steel posts to be galvanized in accordance with Item 445, "Galvanizing."
- Rail element shall meet the requirements of Item 540, "Metal Beam Guard Fence" except as modified on the plans. The Contractor may furnish rail elements of 12 1/2 or 25 foot nominal lengths.
- Button head "post" bolts (ASTM A307) shall be of sufficient length to extend through the full thickness of the nut (ASTM A563) and Type A (1 3/4" O.D.) washer and not more than 1" beyond it. Button head "splice" bolts (ASTM A307) are 5/8" x 1 1/4" (or 2" long at triple rail splices) with a 5/8" double recessed nut (ASTM A563).
- Fittings (bolts, nuts, and washers) shall be galvanized in accordance with Item 445, "Galvanizing." Fittings shall be subsidiary to the bid item.
- Crown shall be widened to accommodate the Metal Beam Guard Fence.
- The lateral approach to the guard fence, shall have a slope rate of not more than 1V:10H.
- Unless otherwise shown in the plans, guard fence placed in the vicinity of curbs shall be positioned so that the face of curb is located directly below or behind the face of the block. Rail placed over curbs shall be installed so that the post bolt is located approximately 21 inches above the gutter pan or roadway surface.
- If solid rock is encountered within 0 to 18" of the finished grade, drill a 22" dia. hole, 24" into the rock, or drill two 12" dia. front to back overlapping holes, 24" into the rock. If solid rock is encountered below 18", drill a 12" dia. hole, 12" into the rock or to the standard embedment depth, whichever is less. Any excess post length, after meeting these depths, may be field cut to ensure proper guardrail mounting height. Backfill with a cohesionless material.
- Posts shall not be set in concrete, of any depth.
- Special fabrication will be required at installations having a curvature of less than 150 ft. radius.
- The terminal anchor section (TAS) post shall be set in Class A concrete (unless otherwise shown in the plans) in accordance with Item 421, "Hydraulic Cement Concrete." Concrete shall be subsidiary to the bid item requiring construction of the terminal anchor section (TAS). Terminal anchor post to be galvanized in accordance with Item 445, "Galvanizing."
- Unless otherwise shown in the plans, a composite material post and/or block that meets the requirements of DMS-7210, "Composite Material Posts and Blocks for Metal Beam Guard Fence" may be substituted for posts and/or blocks of similar dimensions. The Construction Division, TxDOT maintains a Material Producer List (MPL) for producers of materials conforming to DMS-7210. Only producers on the MPL can furnish composite material posts and/or blocks.

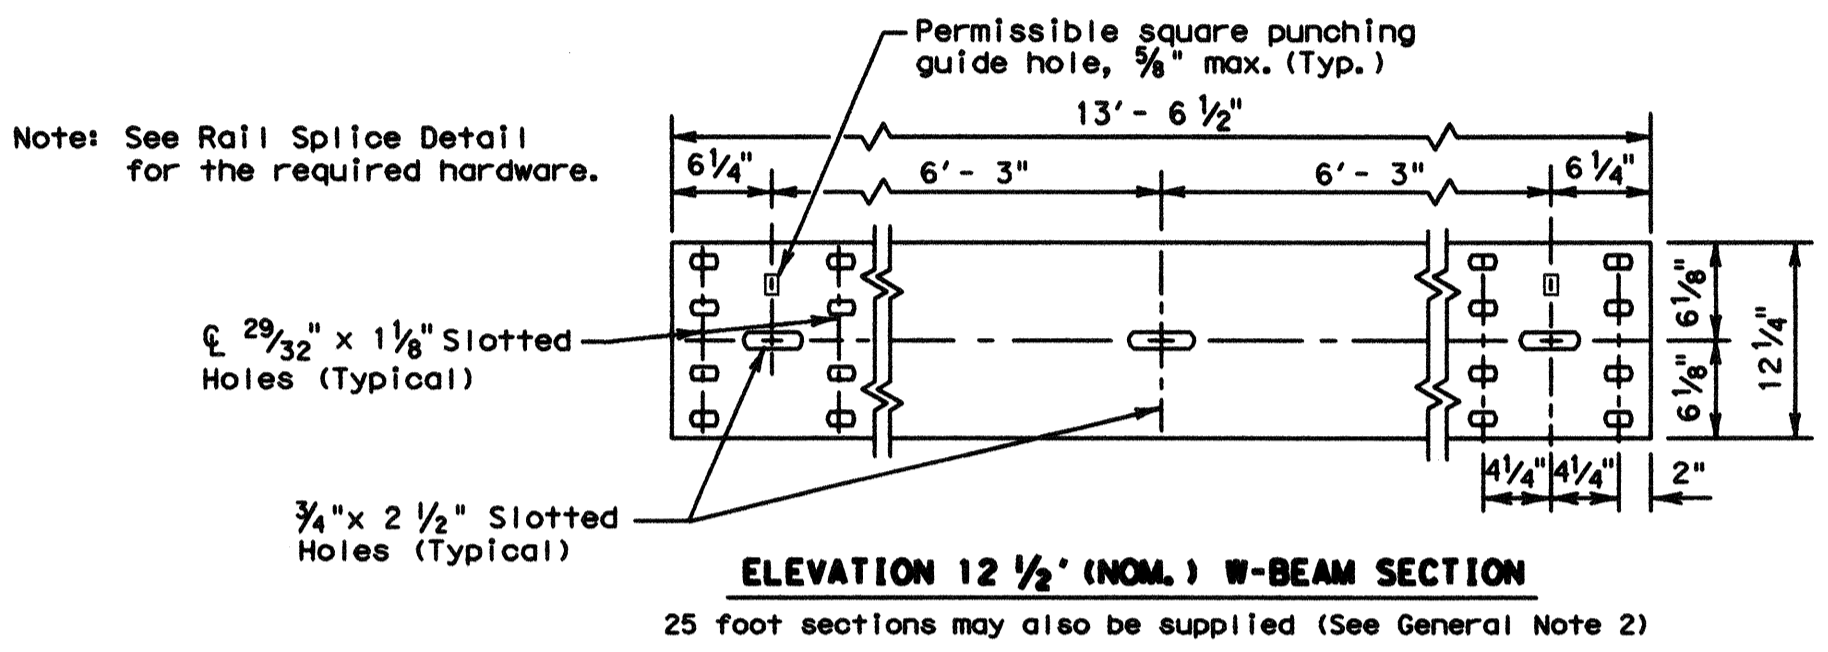

ELEVATION 12 1/2' (NOM.) W-BEAM SECTION
 25 foot sections may also be supplied (See General Note 2)

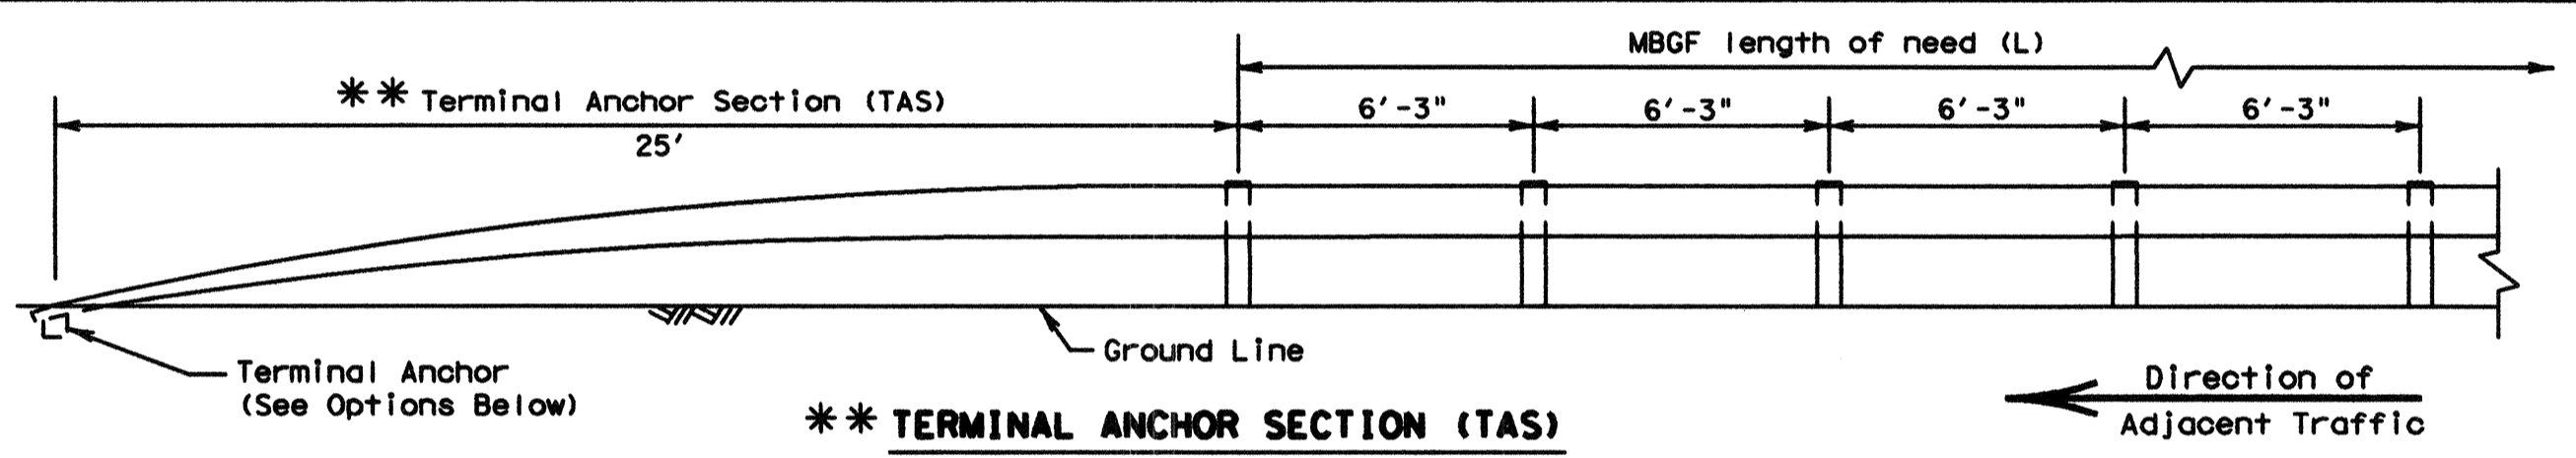


**** TERMINAL ANCHOR SECTION (TAS)**
 Terminal anchor sections are only for downstream use, when located outside the horizontal clearance area of opposing traffic.

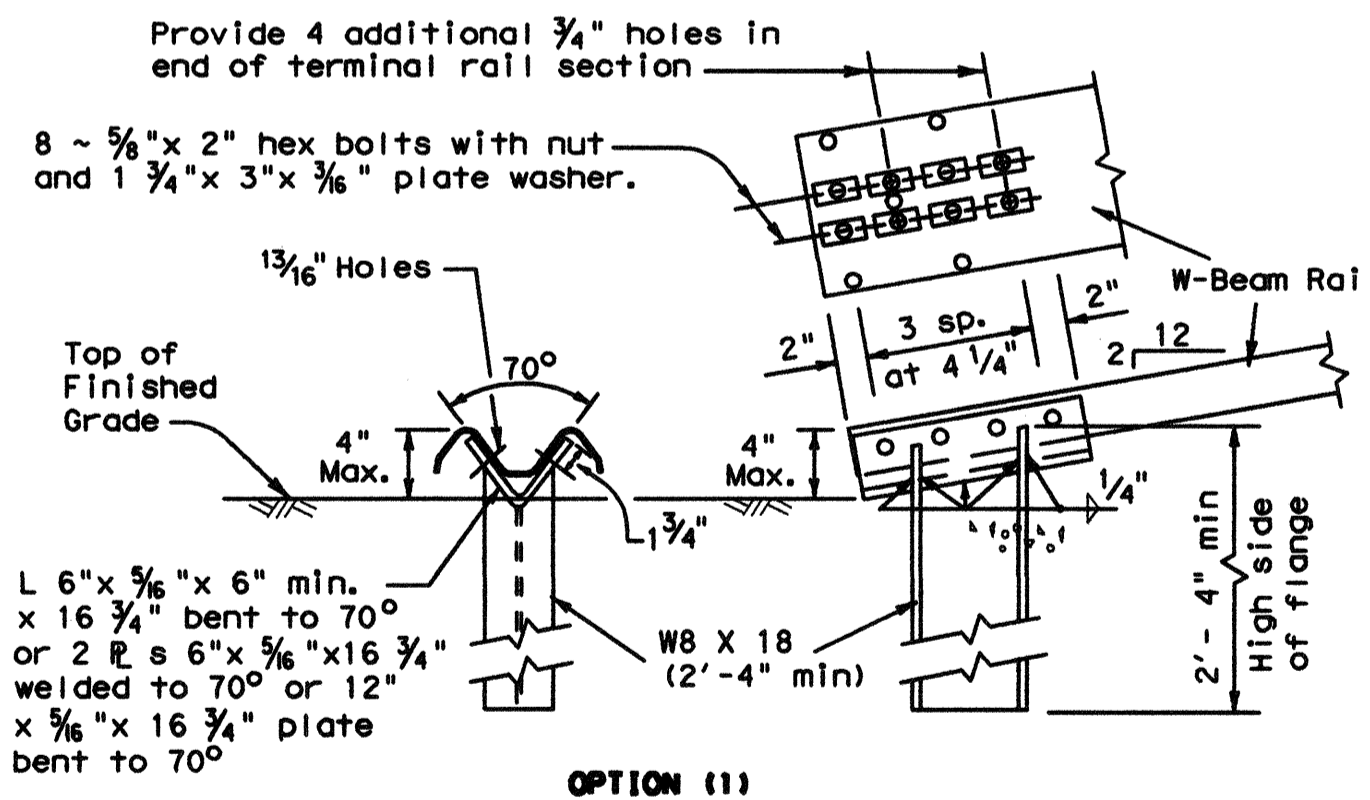

OPTION (1)

Note: This anchor post requires four additional 3/4" holes (shop or field) in the rail member with eight 5/8" hex bolts with nut and plate washer.

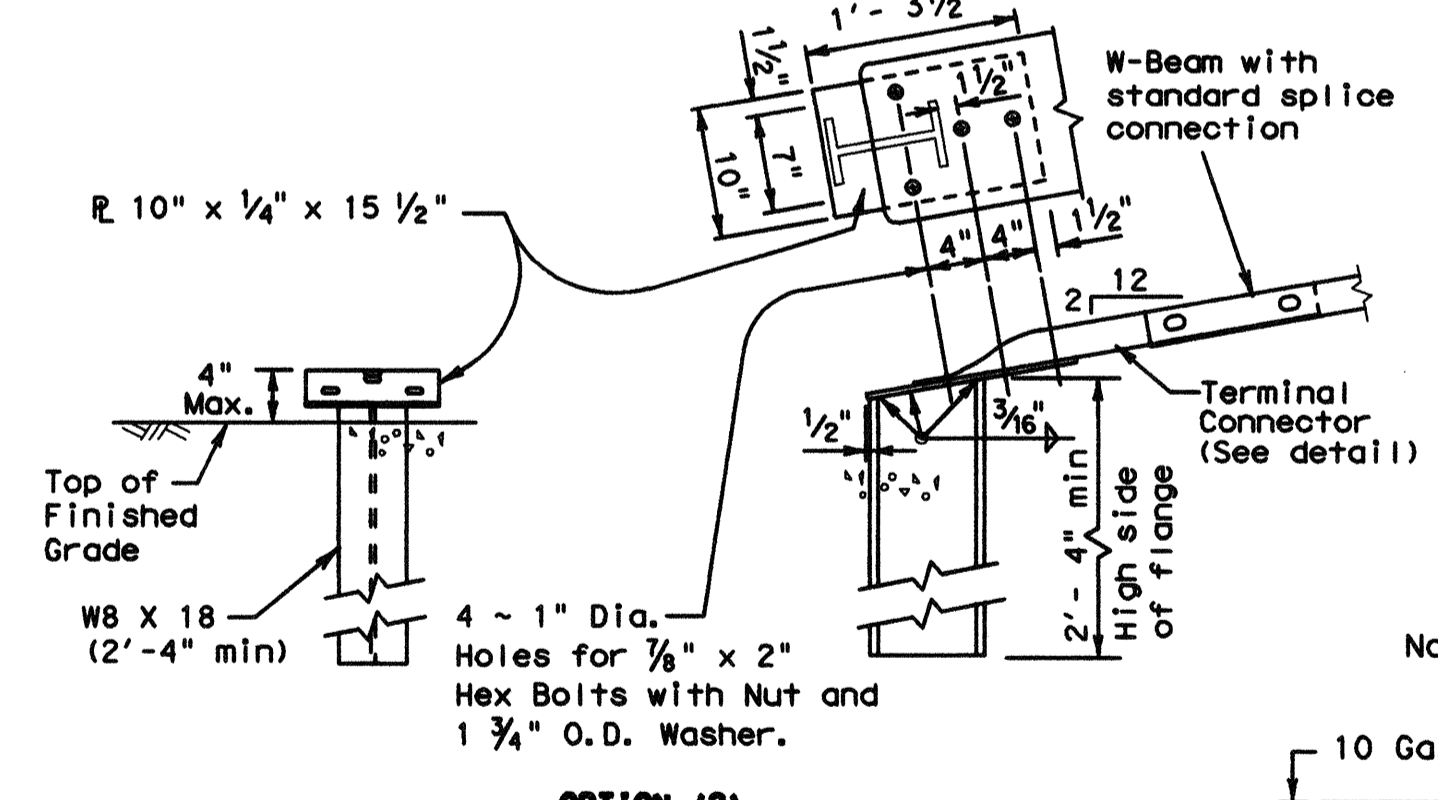


OPTION (2)


Note: This anchor post requires the use of the 10 ga. terminal connector with four 7/8" hex bolts with nut and washer.

TERMINAL ANCHOR POST OPTIONS
 (See General Note 11)


Notes:
 Either concrete anchor may be used with either post option above. No construction joint is allowed in the concrete anchor. Terminal rail may be bolted to post and in twist position prior to placing concrete anchor. If concrete anchor is precast, the area should be compacted as directed by the Engineer, when placed in the field.

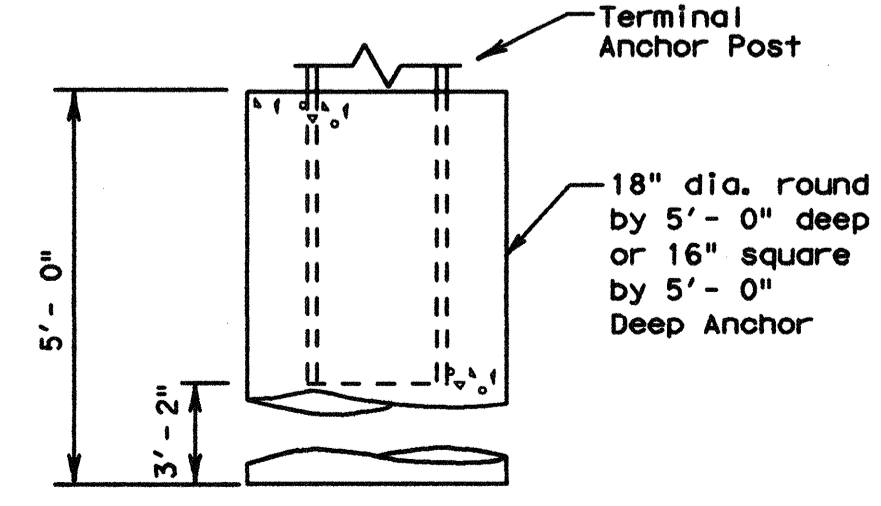

TERMINAL CONCRETE ANCHOR OPTIONS
 (See General Note 11)

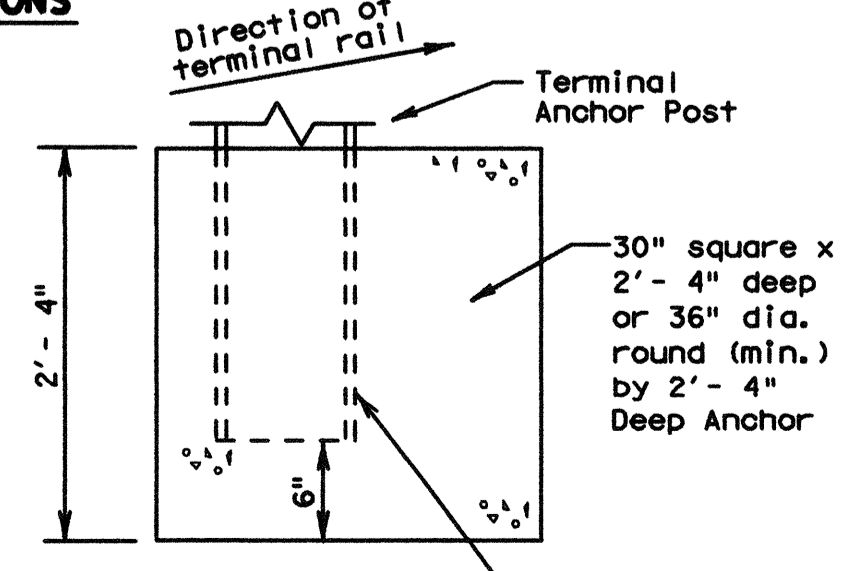

Place face of post approx. on center of anchor

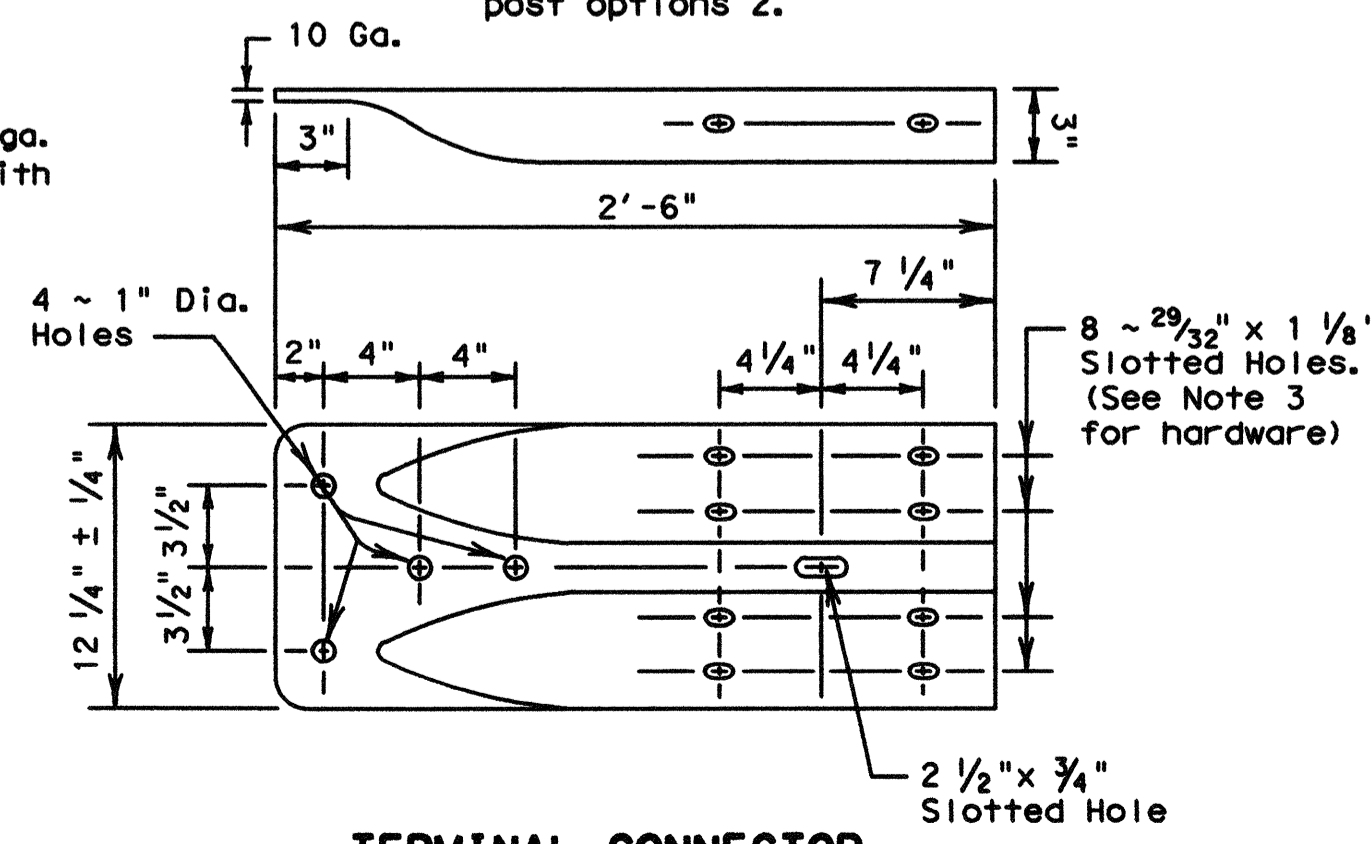

TERMINAL CONNECTOR

For connection hardware to concrete rails, see the MBSG transition standards.




METAL BEAM GUARD FENCE

MBGF-11


FILE: mbgf11.dgn	DN: TxDOT	CK: AM	DN: BD	CK: VP
© TxDOT July 1994	CONT	SECT	JOB	HIGHWAY
12-2011	REVISIONS		DIST	COUNTY
				SHEET NO.

DATE: FILE:

DISCLAIMER: The use of this standard is governed by the "Texas Engineering Practice Act". No warranty of any kind is made by TxDOT for any purpose whatsoever. TxDOT assumes no responsibility for the conversion of this standard to other formats or for incorrect results or damages resulting from its use.


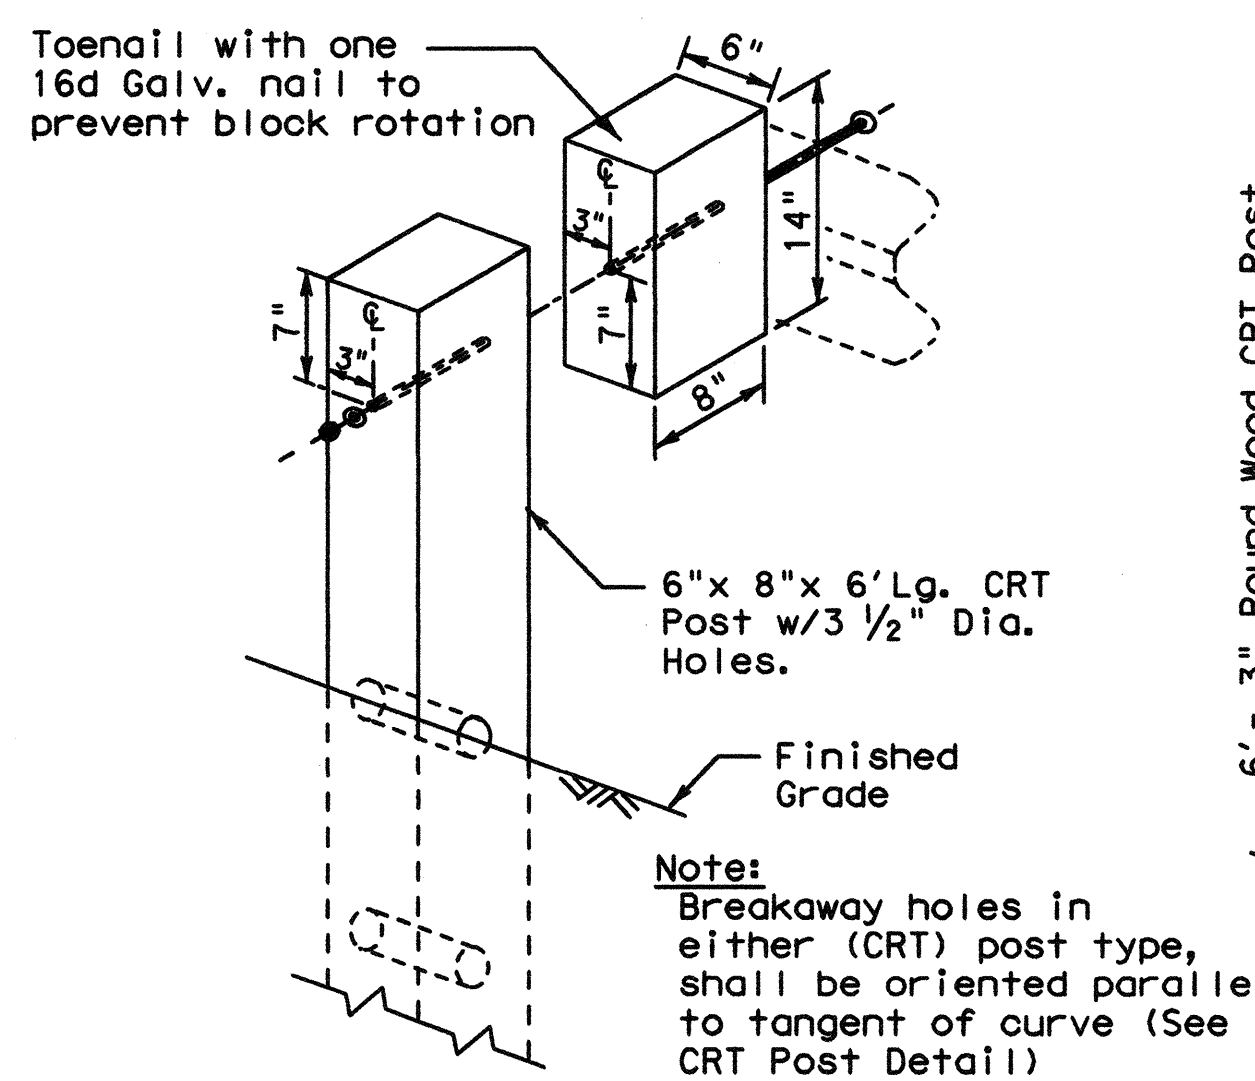


WOOD BLOCK TO RECTANGULAR WOOD (CRT) POST
Showing the required 3 1/2" Dia. holes.

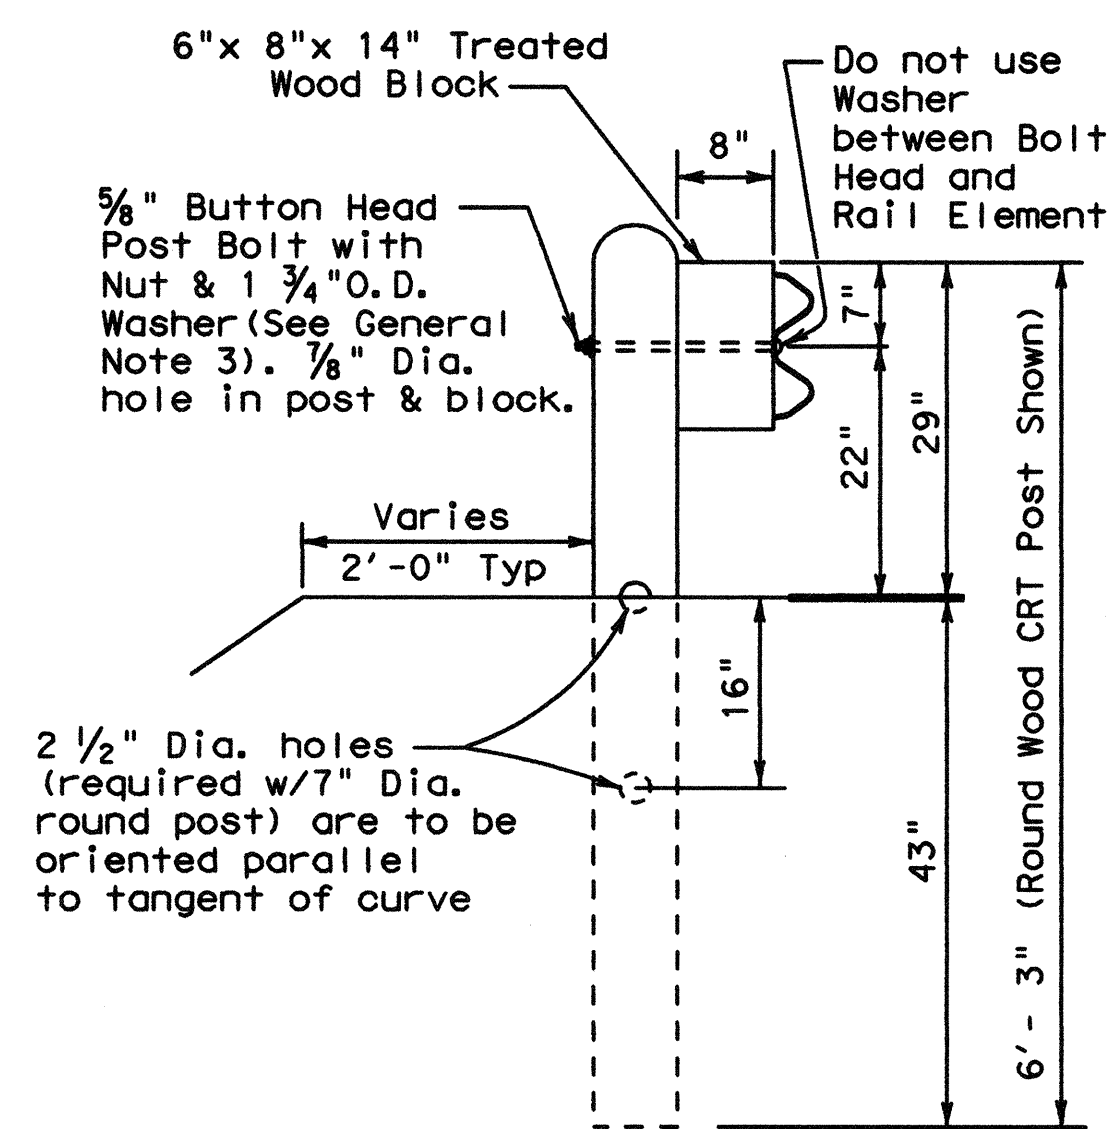


(CRT) POST DETAIL CONTROLLED RELEASE TERMINAL POST

Two or more wood CRT post(s) are required at any radius installation located at intersecting roadways or driveways.

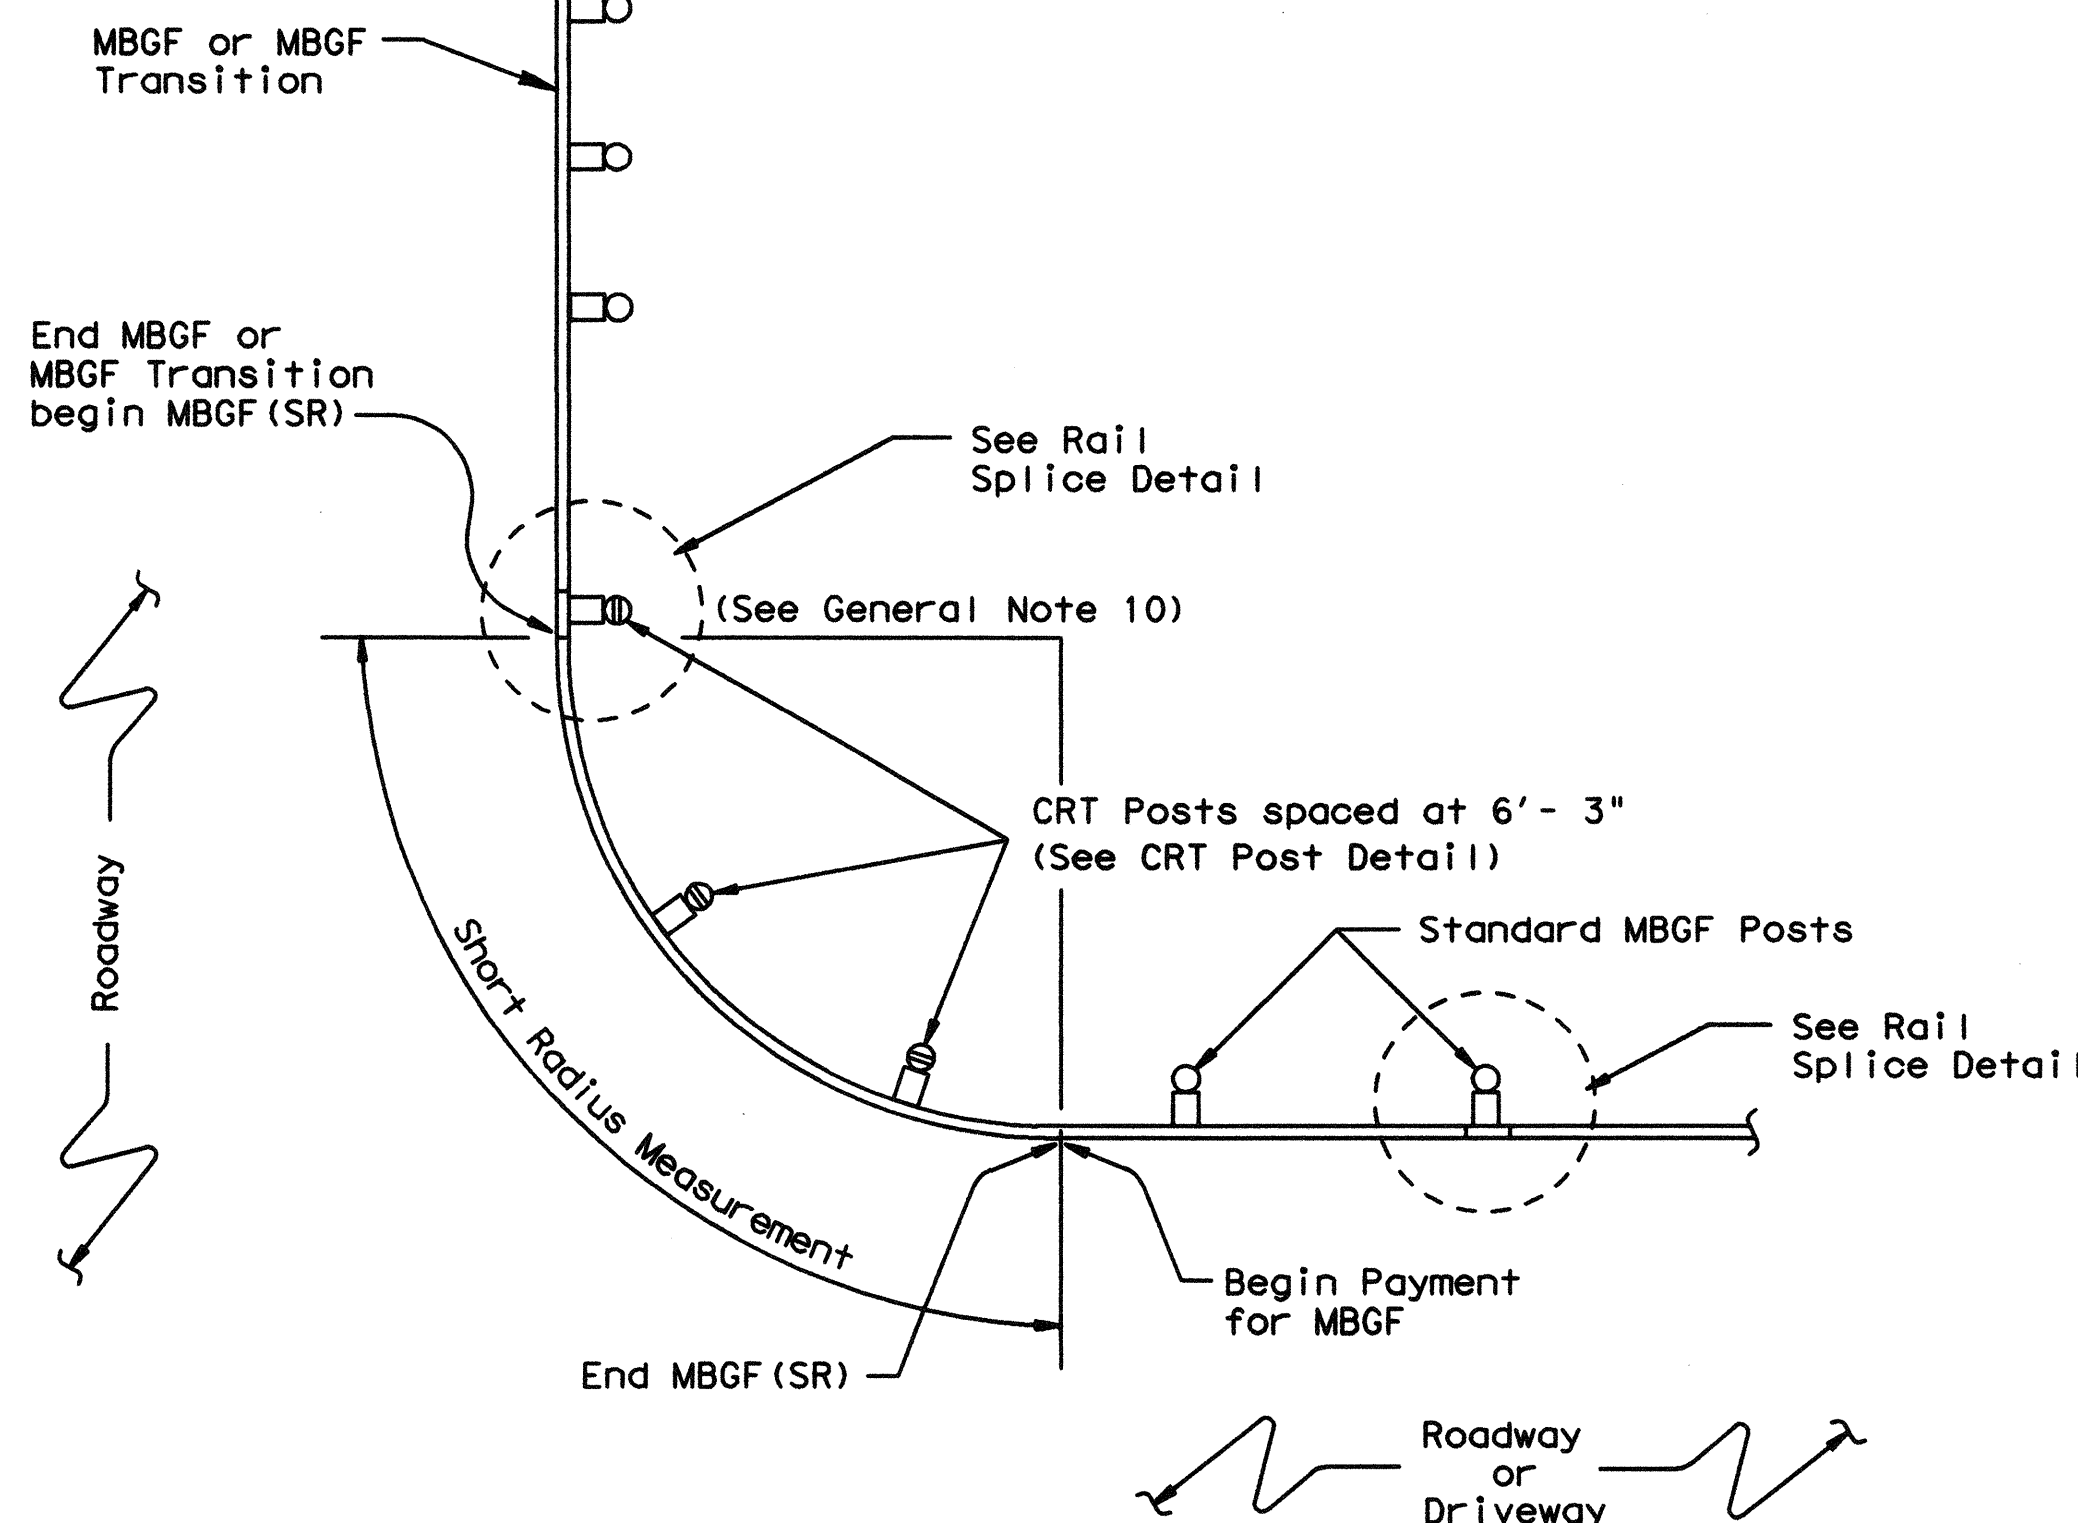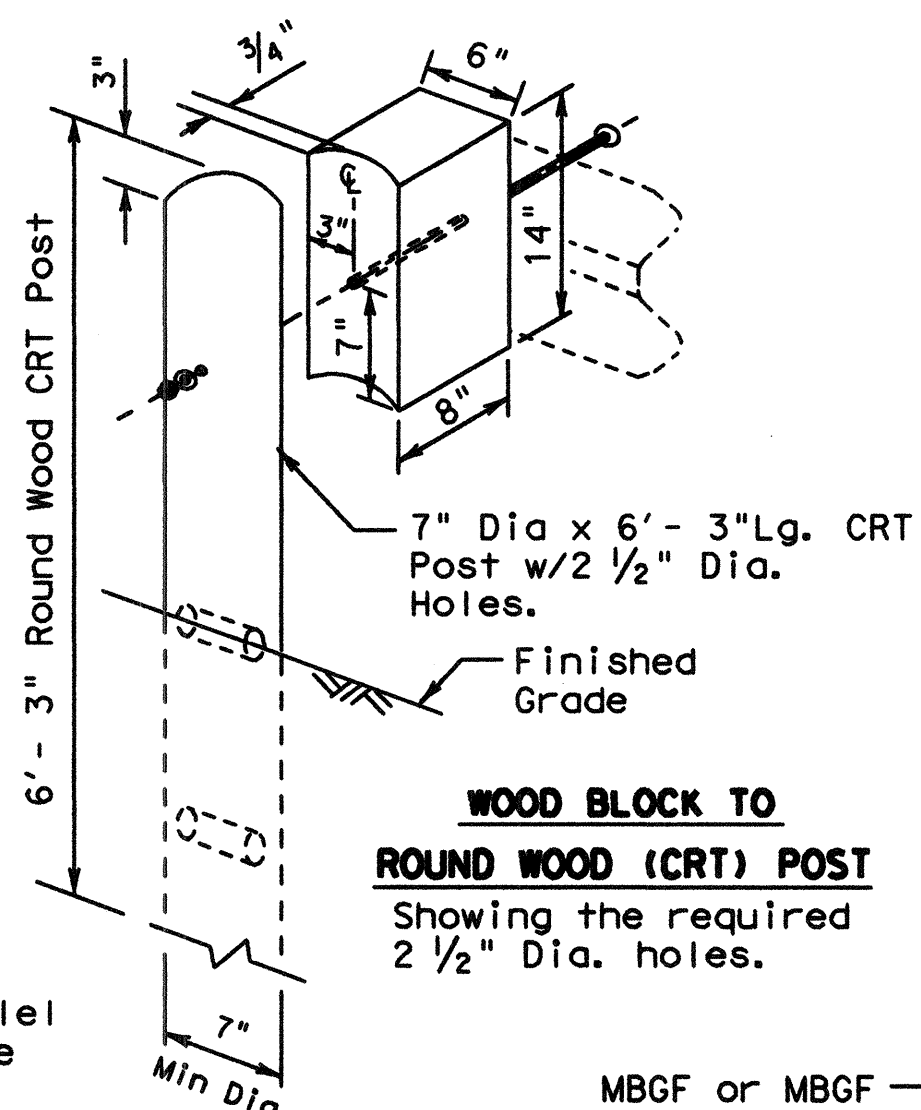

PLAN VIEW SHOWING TYPICAL RADIUS


The required radius is shown elsewhere on the plans.

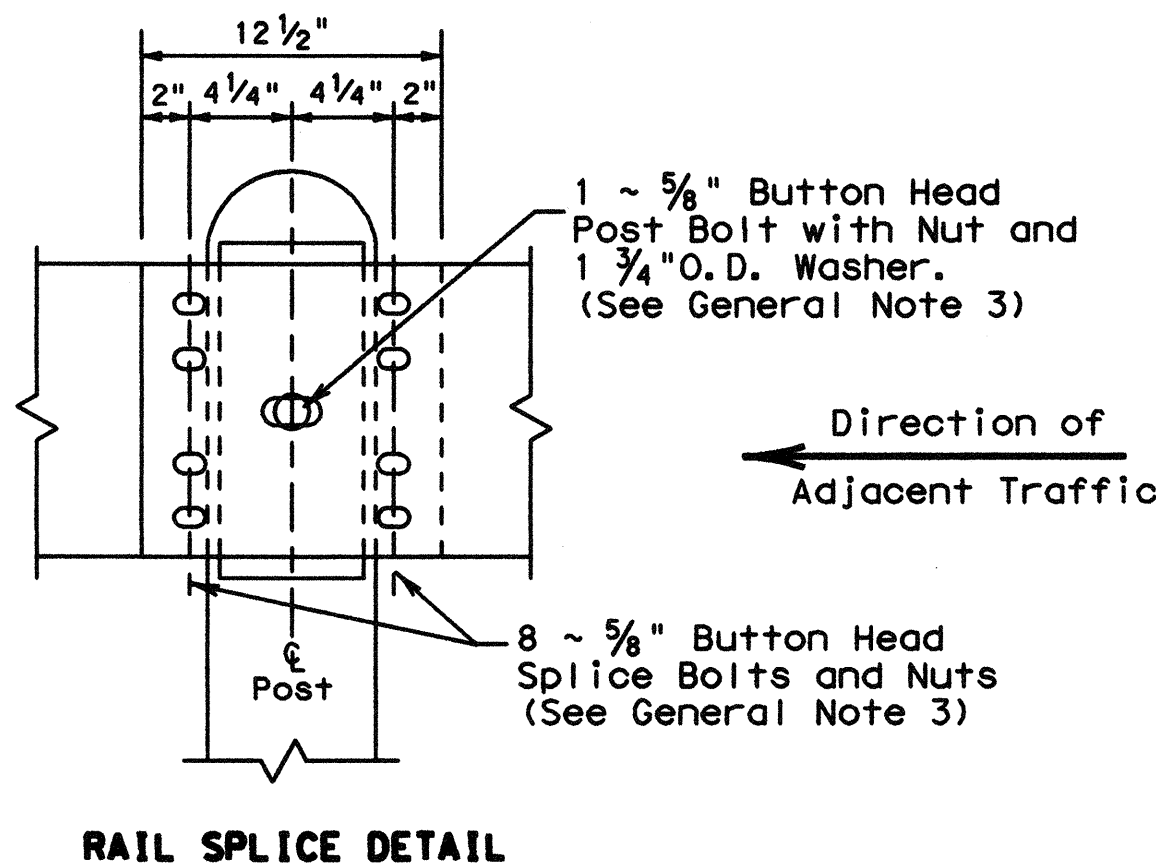

RAIL SPLICE DETAIL

GENERAL NOTES

1. The type of (CRT) post (round wood post, or rectangular wood post) will be shown elsewhere in the plans. The exact position of MBGF shall be shown elsewhere in the plans or as directed by the Engineer.
2. Steel posts are not permitted at CRT post positions.
3. Rail element shall meet the requirements of Item 540, "Metal Beam Guard Fence" except as modified on the plans. The Contractor may furnish rail elements of 12 1/2 or 25 foot nominal lengths.
4. Button head "post" bolts (ASTM A307) shall be of sufficient length to extend through the full thickness of the nut (ASTM A563) and Type A (1 3/4" O.D.) washer and not more than 1" beyond it. Button head "splice" bolts (ASTM A307) are 5/8" x 1 1/4" (or 2" long at triple rail splices) with a 5/8" double recessed nut (ASTM A563).
5. Fittings (bolts, nuts, and washers) shall be galvanized in accordance with Item 445, "Galvanizing." Fittings shall be subsidiary to the bid item.
6. Crown shall be widened to accommodate the Metal Beam Guard Fence.
7. The lateral approach to the guard fence, shall have a slope rate of not more than 1V:10H.
8. Unless otherwise shown in the plans, guard fence placed in the vicinity of curbs shall be positioned so that the face of curb is located directly below or behind the face of the block. Rail placed over curbs shall be installed so that the post bolt is located approximately 21 inches above the gutter pan or roadway surface.
9. If solid rock is encountered within 0 to 18" of the finished grade, drill a 22" dia. hole, 24" into the rock, or drill two 12" dia. front to back overlapping holes, 24" into the rock. If solid rock is encountered below 18", drill a 12" dia. hole, 12" into the rock or to the standard embedment depth, whichever is less. Any excess post length, after meeting these depths, may be field cut to ensure proper guardrail mounting height. Backfill with a cohesionless material.
10. Guardrail posts shall not be set in concrete, of any depth.
11. Special rail fabrication will be required at installations having a curvature of less than 150 ft. radius. The required radius shall be shown on the plans.
12. The terminal anchor section (TAS) post shall be set in Class A concrete (unless otherwise shown in the plans) in accordance with Item 421, "Hydraulic Cement Concrete." Concrete shall be subsidiary to the bid item requiring construction of the terminal anchor section (TAS). Terminal anchor post to be galvanized in accordance with Item 445, "Galvanizing."
13. Unless otherwise shown in the plans, a composite material post and/or block that meets the requirements of DMS-7210, "Composite Material Posts and Blocks for Metal Beam Guard Fence" may be substituted for posts and/or blocks of similar dimensions. The Construction Division, TxDOT maintains a Material Producer List (MPL) for producers of materials conforming to DMS-7210. Only producers on the MPL can furnish composite material posts and/or blocks.


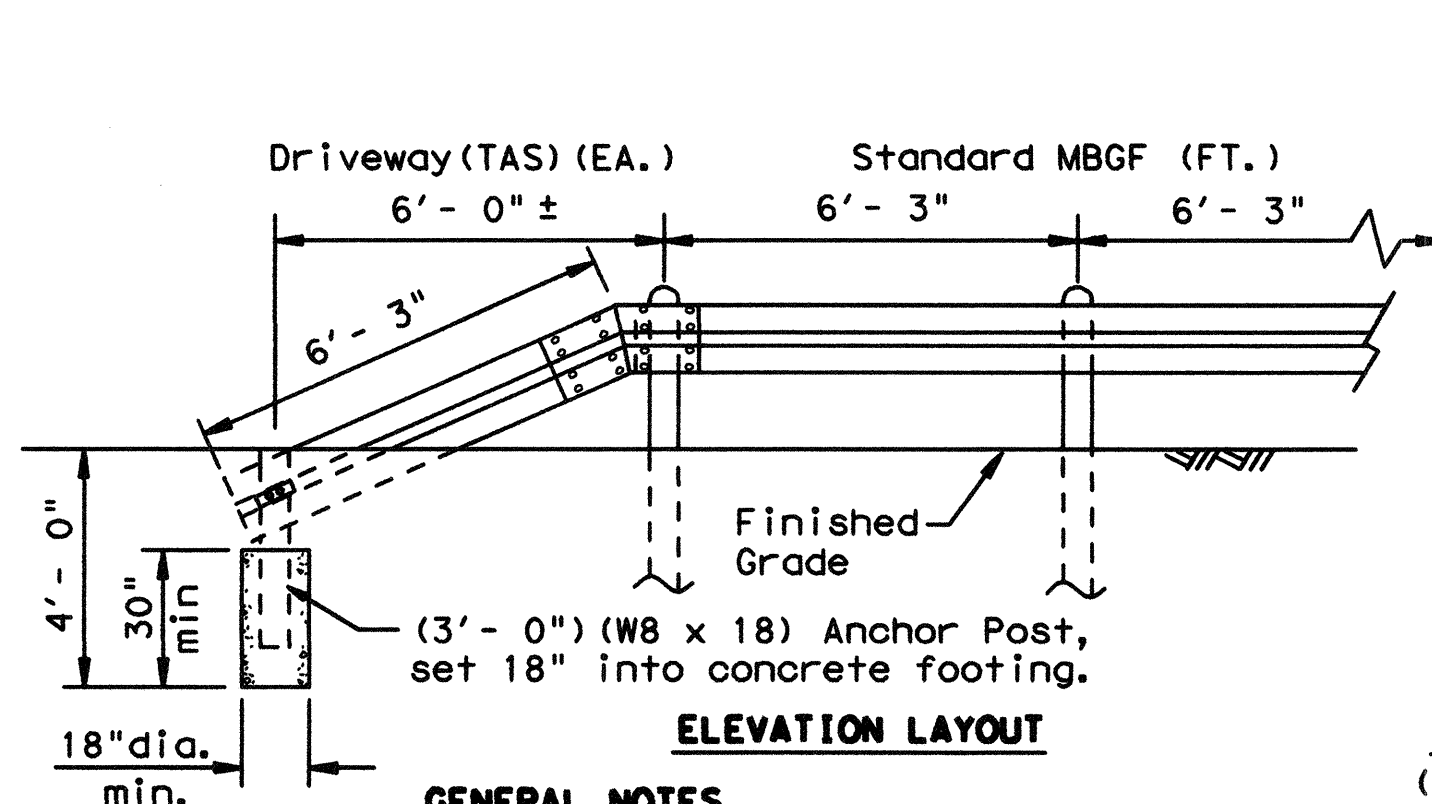


GENERAL NOTES

1. The "Driveway" Terminal Anchor Section is ONLY to be used within driveway locations, where the ROW is limited and a standard 25 ft. (TAS) Terminal Anchor Section, is too long.
2. Terminal anchor post shall be set in Class A concrete.
3. All steel shall be galvanized after fabrication in accordance with Item 445, "Galvanizing."

"DRIVEWAY" TERMINAL ANCHOR SECTION

Only for use within driveway locations, where a standard (TAS) Terminal Anchor Section can not be installed.

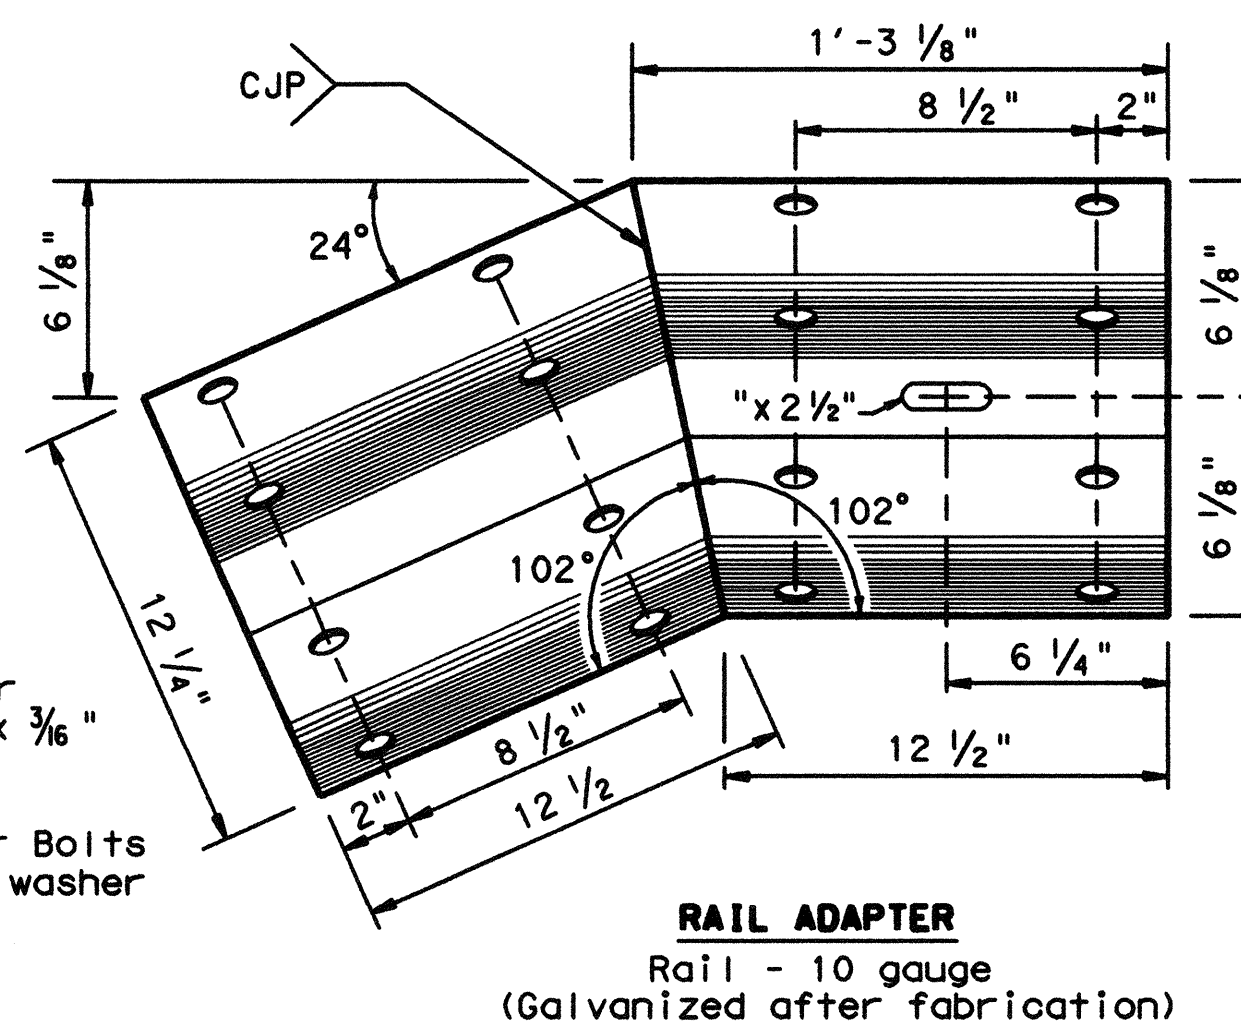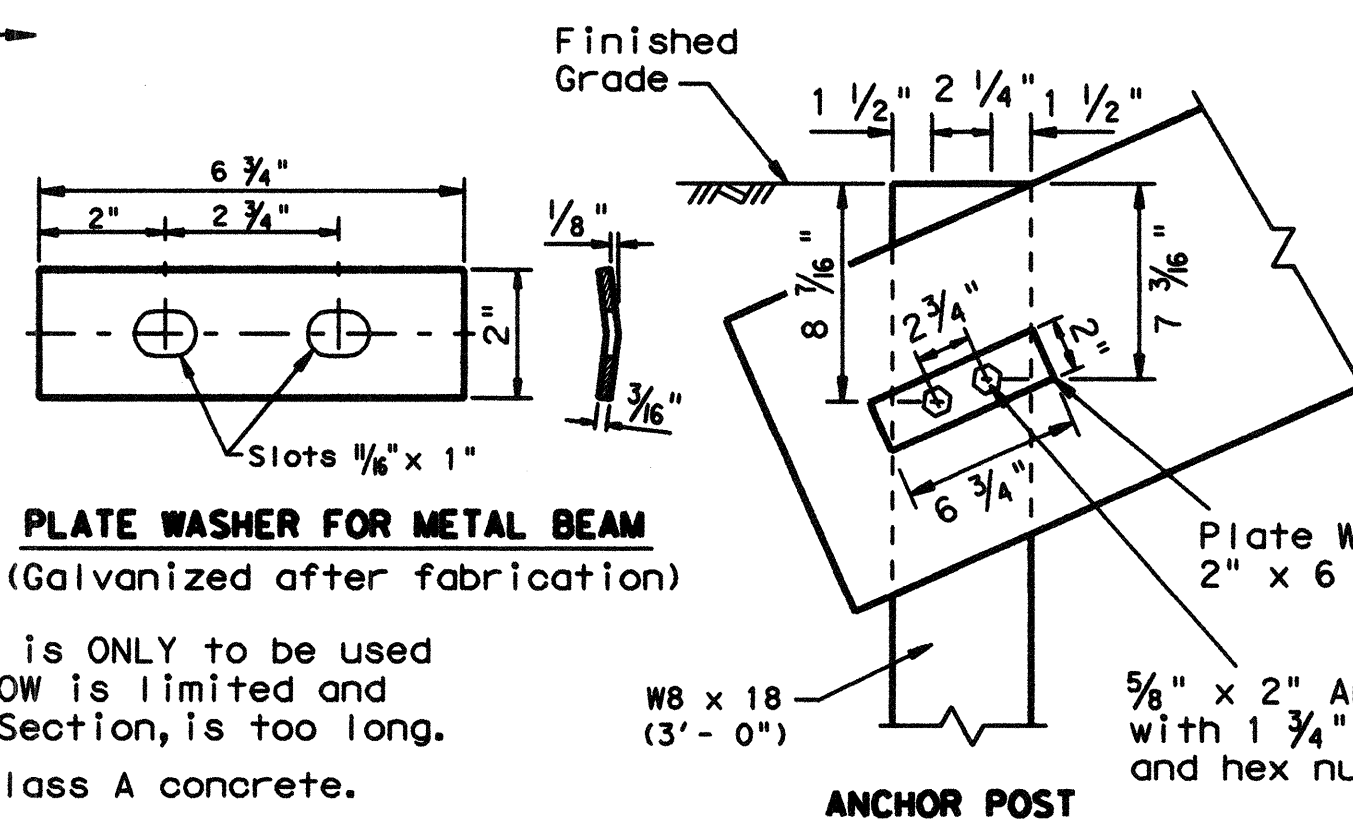

Texas Department of Transportation

Design Division Standard




METAL BEAM GUARD FENCE (SHORT RADIUS) MBGF (SR) - 11

FILE: mbgfsr11.dgn	DW: TxDOT	CK: AM	DW: BD	CK: VP
© TxDOT June 2010	CONT	SECT	JOB	HIGHWAY
12-2011	DIST	COUNTY	SHEET NO.	

DATE: FILE:


DISCLAIMER: The use of this standard is governed by the "Texas Engineering Practice Act". No warranty of any kind is made by TxDOT for any purpose whatsoever. TxDOT assumes no responsibility for the conversion of this standard to other formats or for incorrect results or damages resulting from its use.

DATE: FILE:

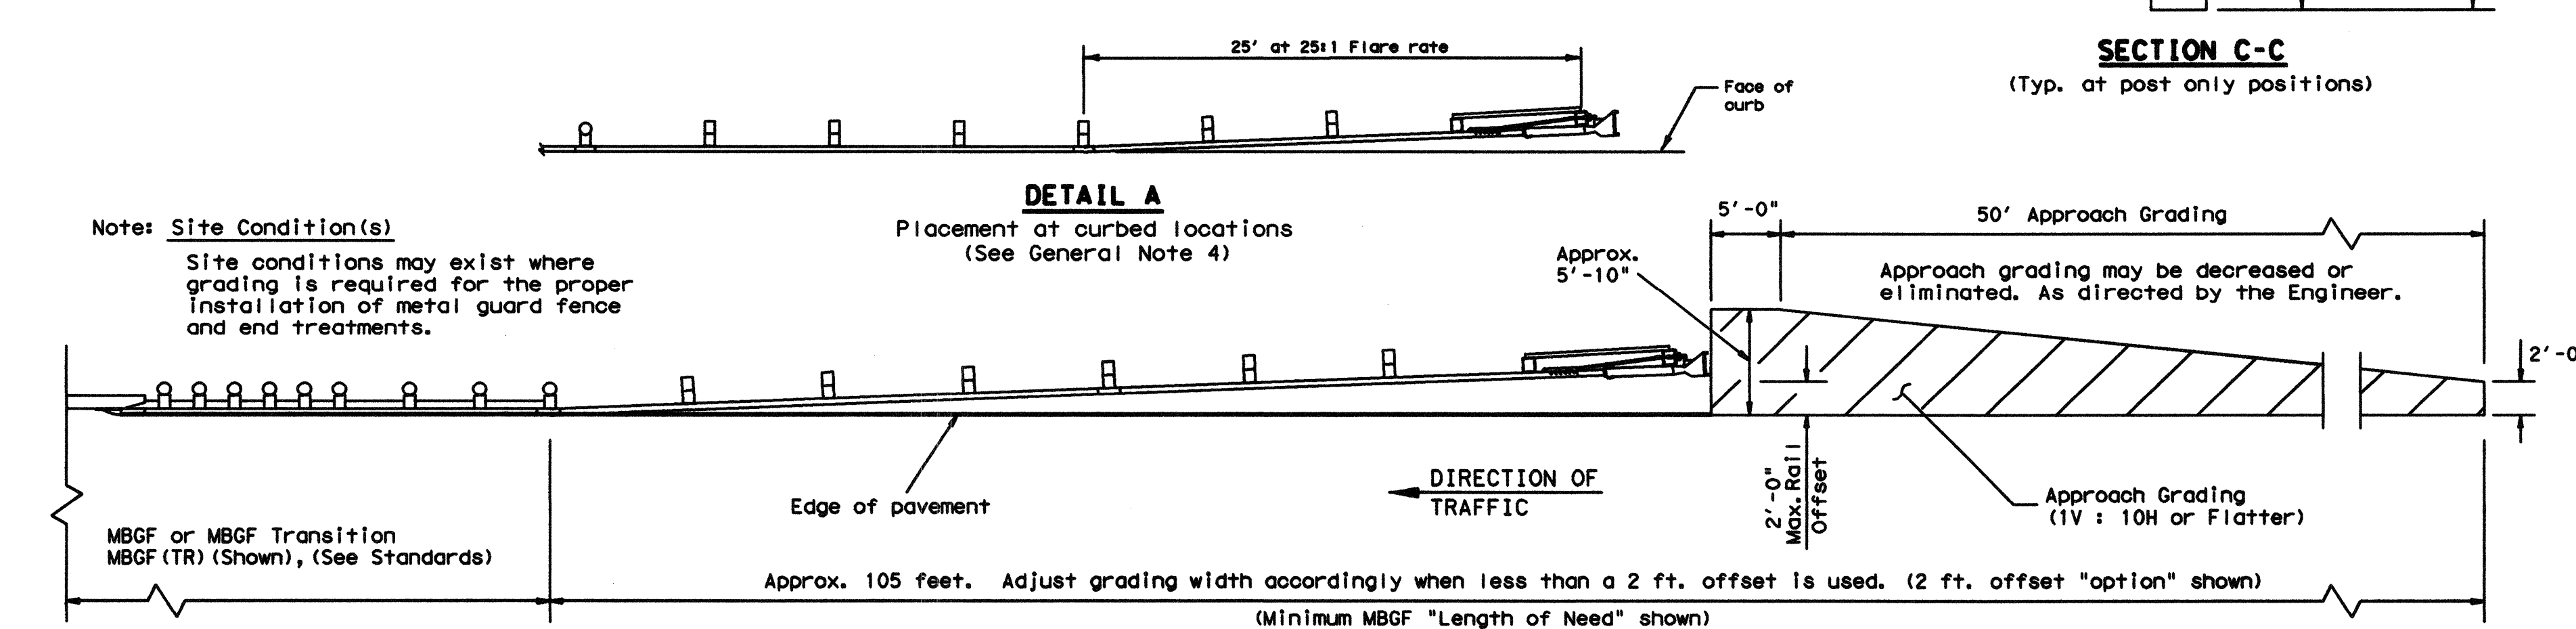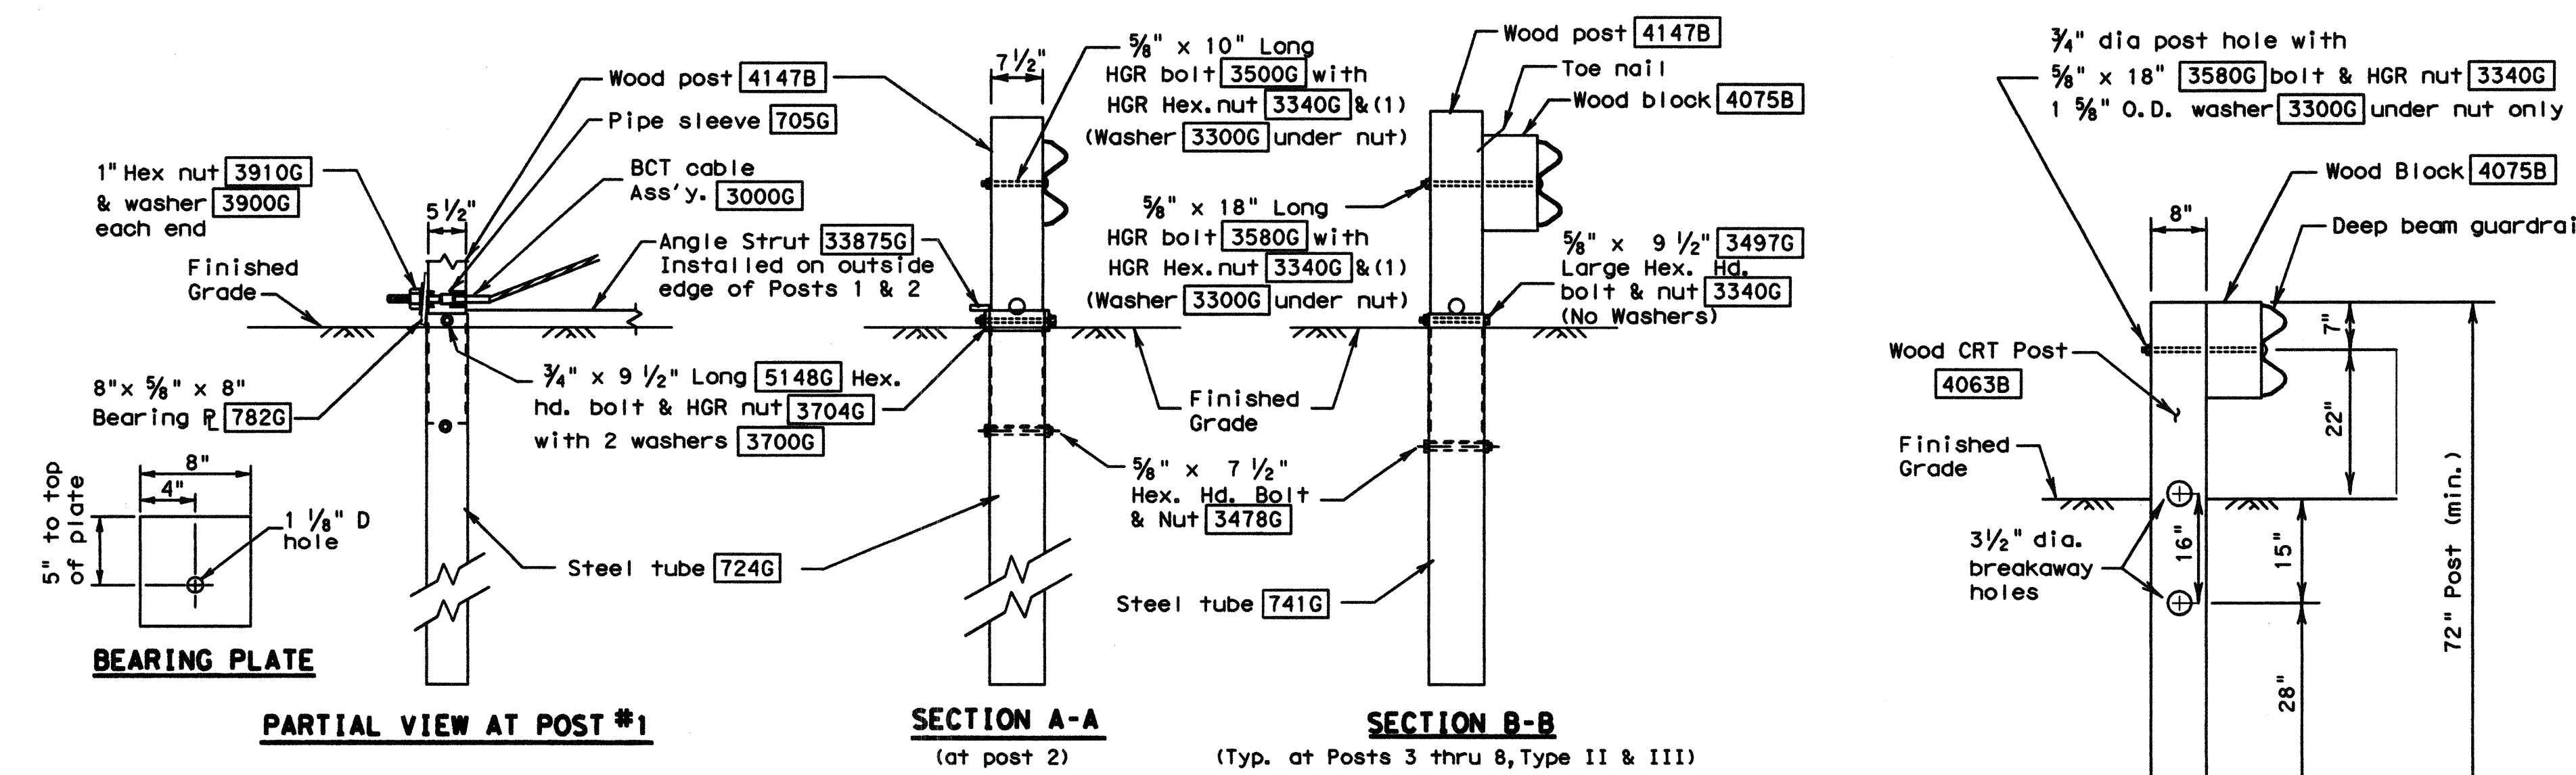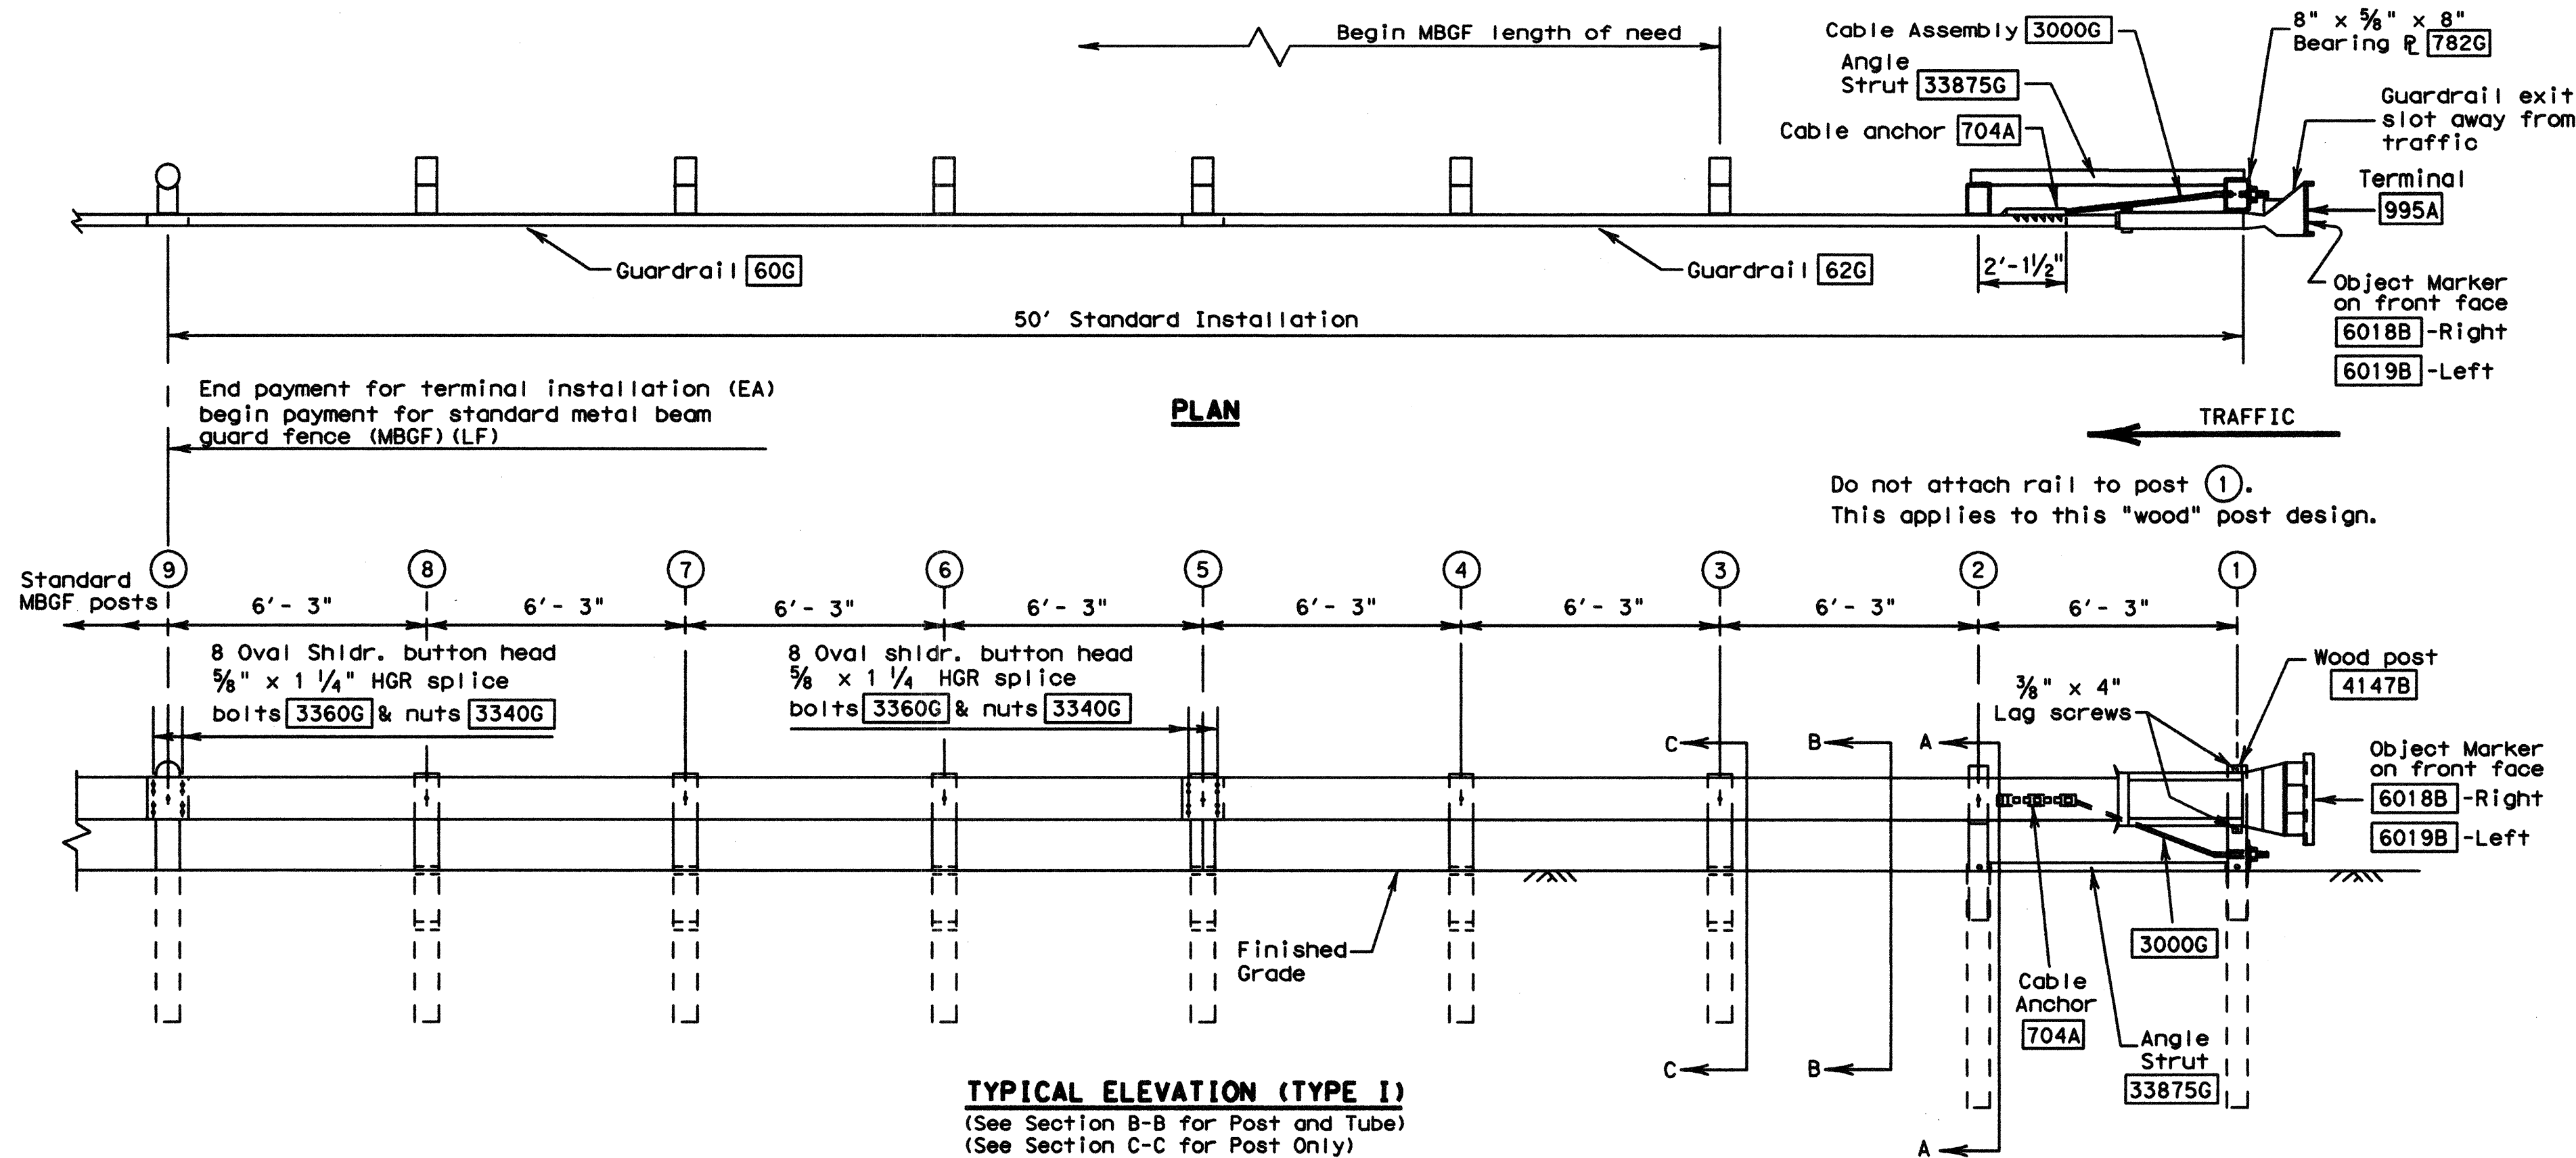

- GENERAL NOTES**
- The Type of SGT unit will be specified elsewhere in the plans. Numbers in circles indicate post position. The Type of SGT unit chosen is a maintenance consideration and does not affect the systems performance.

Post & Tube Options		Post Only	
Type I Posts	① thru ②	Posts ③ thru ⑧	
Type II Posts	① thru ④	Posts ⑤ thru ⑧	
Type III Posts	① thru ⑧	None	
 - SGT's placed within the "minimum" 150 ft. radius, shall be installed straight. Standard rail elements may be installed within the radius, without special fabrication.
 - All bolts, nuts, cable assemblies, cable anchors, steel tubes & bearing plates shall be galvanized.
 - At non-curved locations, a flare rate of 25:1 may be used over the first 50 ft. of the system to prevent the terminal head from encroaching on the shoulder. The flare may be decreased or eliminated for specific installations, if directed by the Engineer. At curved locations, a flare rate of 25:1 shall be used beginning at post number 5 and ending at post number 1.
 - The steel tubes shall not protrude more than 4 inches above ground. Site grading may be necessary to meet this requirement.
 - The steel tubes may be driven with an approved driving head. They shall not be driven with the wood post in the tube. If the steel tubes are placed in drilled holes, the backfill material must be satisfactorily compacted to prevent tube settlement.
 - If solid rock is encountered. See the manufacturer's installation manual for the proper installation guidance.
 - The breakaway cable assembly must be taut. A locking device, (vice grips or channel lock pliers) should be used to prevent the cable from twisting when tightening the nuts.
 - The wood blocks shall be "toe nailed" to the rectangular wood posts to prevent them from turning when the wood shrinks.
 - For curb installations, the soil tubes and posts shall be installed at the proper ground elevation behind the curb. The posts will then require field drilling new holes to accommodate the rail to post connection hole to maintain the proper height of the rail above the gutter pan. The excess post length above the rail will be removed if directed by the Engineer.
 - An object marker shall be installed on the front of the impact head as detailed on D&OM(VIA).
 - A special site evaluation should be considered, prior to using this end treatment where there is less than 25 feet between the extrusion side of the end treatment and any adjacent driving lane.

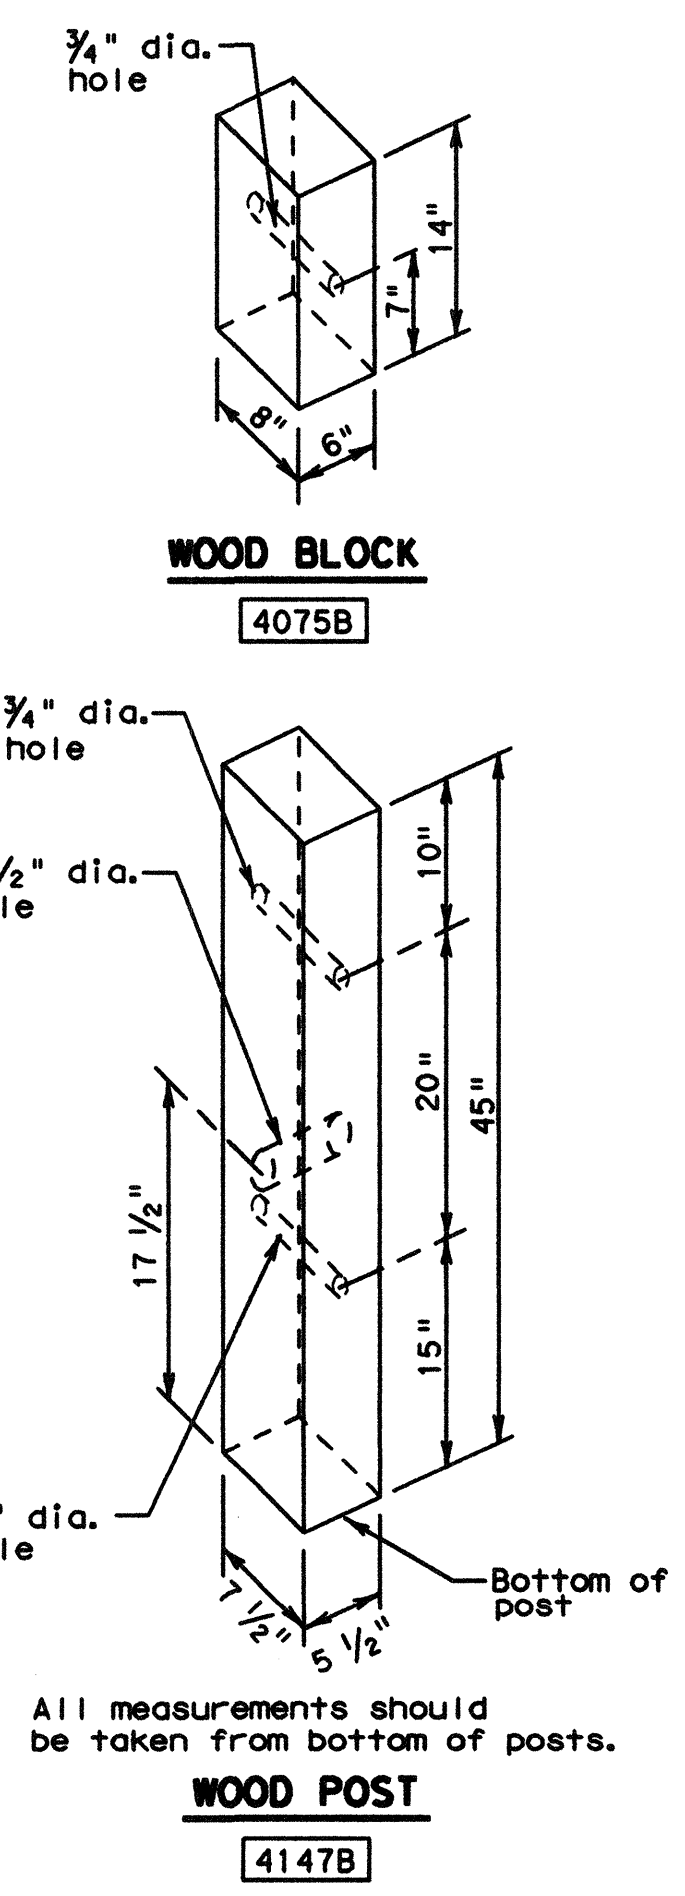

POST & TUBE OPTIONS	
Type I Posts	① thru ②
Type II Posts	① thru ④
Type III Posts	① thru ⑧

BILL OF MATERIAL				
Code #	POST & TUBE OPTIONS			DESCRIPTION
	Type I Qty.	Type II Qty.	Type III Qty.	
62G	1	1	1	#1 Deep Beam Guardrail (12 Ga) at 25'
60G	1	1	1	#2 Deep Beam Guardrail (12 Ga) at 25'
724G	2	2	2	Steel Tube - 6"x 8"x 72"x 1/8" min
741G	0	2	6	Steel Tube - 6" x 8" x 54" x 1/8" min
4147B	2	4	8	Wood Posts - 5 1/2" x 7 1/2" x 45"
4063B	6	4	0	Wood CRT Posts - 6" x 8" x 72"
4075B	6	6	6	Wood Block - 6" x 8" x 14"
705G	1	1	1	Pipe Sleeve - 2" std. pipe x 5 1/2"
782G	1	1	1	Bearing Plate - 8" x 8" x 5/8"
704A	1	1	1	Cable Anchor
3000G	1	1	1	Cable Assembly (3/4" x 78")
33875G	1	1	1	Angle Strut
995A	1	1	1	ET-2000 Plus Guardrail Terminal

HARDWARE				
5148G	2	2	2	3/4" x 9 1/2" Hex Hd (Top of tubes 1&2)A325
3300G	7	7	7	5/8" Washers
3478G	2	4	8	5/8" x 7 1/2" Hex Bolt
3500G	1	1	1	5/8" x 10" Post Bolt (Post 2 of LET)
3580G	6	6	6	5/8" x 18" HGR Post Bolt (posts ③ thru ⑧)
3360G	16	16	16	5/8" x 1 1/4" HGR Splice Bolt
3340G	25	27	31	5/8" HGR Nut (16-spl, 7-posts)
4228G	2	2	2	3/4" x 4" Lag Screw
3910G	2	2	2	1" Hex Nut (Anchor Cable)
3900G	2	2	2	1" Washer (Anchor Cable)
6018B	1	1	1	Right - Object Marker
6019B	1	1	1	Left - Object Marker
3700G	4	4	4	3/4" Washer
3704G	2	2	2	3/4" Heavy Hex Nut
3497G	0	2	6	5/8" x 9 1/2" Hex Hd (Top of Tubes 3-8)A307

Texas Department of Transportation
Design Division Standard

SINGLE GUARDRAIL TERMINAL (ET-2000 PLUS) (WOOD POST) SGT (7) - 11

FILE: sgt712.dgn	DN: TxDOT	CK: AM	DW: BD	CK: VP
© TxDOT April 1997	CONT	SECT	JOB	HIGHWAY
12-2011	DIST	COUNTY	SHEET NO.	

TABLE OF VARIABLE DIMENSIONS AND QUANTITIES FOR ONE HEADWALL ④


SLOPE OF PIPE, D	15 Degrees						30 Degrees						45 Degrees					
	Values for one Pipe			Values to be added for each add'l Pipe			Values for one Pipe			Values to be added for each add'l Pipe			Values for one Pipe			Values to be added for each add'l Pipe		
	W	Reinf (Lbs)	Conc (CY)	W	Reinf (Lbs)	Conc (CY)	W	Reinf (Lbs)	Conc (CY)	W	Reinf (Lbs)	Conc (CY)	W	Reinf (Lbs)	Conc (CY)	W	Reinf (Lbs)	Conc (CY)
12"	9'-4"	124	1.1	1'-9 3/4"	15	0.2	10'-5"	130	1.2	2'-0"	16	0.2	12'-9"	159	1.5	2'-5 3/4"	17	0.3
15"	10'-7"	136	1.3	2'-3"	17	0.2	11'-10"	159	1.5	2'-6"	18	0.2	14'-6"	191	1.8	3'-0 3/4"	20	0.3
18"	11'-11"	165	1.5	2'-9"	19	0.3	13'-3"	174	1.7	3'-1"	29	0.3	16'-3"	207	2.1	3'-9 1/4"	33	0.4
21"	13'-2"	203	1.9	3'-2 1/4"	31	0.4	14'-9"	233	2.1	3'-6 3/4"	33	0.4	18'-0"	276	2.6	4'-4 1/4"	36	0.5
24"	14'-6"	240	2.1	3'-8 1/4"	34	0.4	16'-2"	251	2.4	4'-1 3/4"	36	0.5	19'-10"	318	2.9	5'-0 3/4"	39	0.6
27"	15'-9"	258	2.5	4'-0 3/4"	38	0.5	17'-7"	292	2.8	4'-6 1/4"	39	0.6	21'-7"	342	3.4	5'-6 1/4"	44	0.7
30"	17'-1"	297	2.8	4'-5 3/4"	40	0.6	19'-1"	311	3.1	5'-0"	42	0.6	23'-4"	388	3.8	6'-1 3/4"	47	0.8
33"	18'-5"	320	3.3	4'-9 3/4"	43	0.6	20'-6"	358	3.6	5'-4 3/4"	46	0.7	25'-1"	439	4.4	6'-7 1/4"	51	0.9
36"	19'-8"	401	4.0	5'-3"	47	0.9	21'-11"	422	4.5	5'-10 3/4"	50	0.9	26'-10"	517	5.5	7'-2 1/4"	55	1.2
42"	22'-3"	476	5.0	6'-0 3/4"	53	1.1	24'-10"	528	5.6	6'-8 3/4"	56	1.2	30'-5"	634	6.9	8'-3"	76	1.4
48"	25'-11"	577	6.6	6'-9 3/4"	60	1.3	28'-10"	637	7.3	7'-7 1/4"	79	1.5	35'-4"	791	9.0	9'-3 3/4"	88	1.8
54"	28'-6"	711	7.8	7'-9"	83	1.6	31'-9"	781	8.7	8'-8"	87	1.8	38'-11"	958	10.7	10'-7 1/4"	97	2.2
60"	31'-1"	805	9.2	8'-6 1/4"	91	1.9	34'-8"	881	10.2	9'-6 1/4"	97	2.1	42'-5"	1113	12.5	11'-8"	124	2.6
66"	33'-8"	907	10.6	9'-0 3/4"	98	2.1	37'-6"	1028	11.8	10'-1 1/4"	102	2.4	46'-0"	1235	14.5	12'-4 1/4"	132	2.9
72"	36'-3"	1071	12.1	9'-8"	105	2.4	40'-5"	1207	13.5	10'-9 1/4"	110	2.6	49'-6"	1446	16.6	13'-2 1/4"	141	3.2
12"	13'-6"	178	1.6	1'-9 3/4"	15	0.2	15'-0"	189	1.8	2'-0"	15	0.2	18'-5"	237	2.2	2'-5 3/4"	17	0.2
15"	15'-3"	212	1.9	2'-3"	17	0.2	17'-0"	223	2.1	2'-6"	17	0.3	20'-10"	276	2.6	3'-0 3/4"	20	0.3
18"	17'-1"	231	2.3	2'-9"	19	0.3	19'-1"	259	2.5	3'-1"	29	0.3	23'-4"	318	3.1	3'-9 1/4"	32	0.4
21"	18'-11"	306	2.7	3'-2 1/4"	31	0.4	21'-1"	339	3.0	3'-6 3/4"	33	0.4	25'-10"	413	3.7	4'-4 1/4"	36	0.5
24"	20'-8"	345	3.1	3'-8 3/4"	35	0.4	23'-1"	384	3.5	4'-1 3/4"	36	0.5	28'-3"	462	4.2	5'-0 3/4"	40	0.6
27"	22'-6"	376	3.7	4'-0 3/4"	38	0.5	25'-1"	438	4.1	4'-6 1/4"	39	0.6	30'-9"	522	5.0	5'-6 1/4"	44	0.7
30"	24'-4"	422	4.1	4'-5 3/4"	40	0.6	27'-2"	466	4.6	5'-0"	42	0.6	33'-3"	578	5.6	6'-1 3/4"	47	0.8
33"	26'-2"	476	4.8	4'-10"	43	0.6	29'-2"	522	5.3	5'-4 3/4"	46	0.7	35'-9"	644	6.5	6'-7 1/4"	51	0.9
36"	27'-11"	590	5.9	5'-3 1/4"	47	0.8	31'-2"	645	6.6	5'-10 3/4"	50	0.9	38'-2"	787	8.0	7'-2 1/4"	56	1.2
42"	31'-7"	684	7.3	6'-0 1/4"	53	1.1	35'-3"	776	8.2	6'-8 3/4"	56	1.2	43'-2"	933	10.0	8'-3"	79	1.4
48"	36'-9"	880	9.6	6'-9 3/4"	61	1.3	41'-0"	953	10.7	7'-7 1/4"	81	1.5	50'-2"	1166	13.1	9'-3 3/4"	88	1.8
54"	40'-5"	1065	11.4	7'-9"	85	1.6	45'-0"	1185	12.7	8'-8"	89	1.8	55'-2"	1435	15.5	10'-7 1/4"	97	2.2
60"	44'-0"	1224	13.3	8'-6 1/4"	93	1.9	49'-1"	1356	14.8	9'-6 1/4"	96	2.1	60'-1"	1627	18.2	11'-8"	124	2.6
66"	47'-7"	1357	15.4	9'-1"	98	2.1	53'-1"	1497	17.2	10'-1 1/4"	103	2.3	65'-1"	1834	21.1	12'-4 1/4"	130	2.9
72"	51'-3"	1624	17.7	9'-8"	105	2.3	57'-2"	1787	19.7	10'-9 1/4"	109	2.6	70'-0"	2210	24.1	13'-2 1/4"	139	3.2
12"	17'-7"	232	2.1	1'-9 3/4"	15	0.2	19'-8"	259	2.4	2'-0"	16	0.2	24'-0"	314	2.9	2'-5 3/4"	18	0.2
15"	19'-11"	272	2.5	2'-3"	17	0.2	22'-3"	301	2.8	2'-6"	18	0.3	27'-3"	361	3.5	3'-0 3/4"	21	0.3
18"	22'-3"	313	3.0	2'-9"	19	0.3	24'-10"	344	3.3	3'-1"	29	0.3	30'-5"	427	4.0	3'-9 1/4"	32	0.4
21"	24'-7"	407	3.6	3'-2 1/4"	31	0.4	27'-5"	446	4.0	3'-6 3/4"	33	0.4	33'-7"	549	4.9	4'-4 1/4"	36	0.5
24"	26'-11"	455	4.1	3'-8 3/4"	35	0.4	30'-0"	499	4.5	4'-1 3/4"	36	0.5	36'-9"	609	5.6	5'-0 3/4"	40	0.6
27"	29'-3"	514	4.8	4'-0 3/4"	38	0.5	32'-7"	562	5.4	4'-6 1/4"	40	0.6	39'-11"	703	6.6	5'-6 1/4"	43	0.7
30"	31'-7"	568	5.4	4'-5 3/4"	40	0.6	35'-3"	620	6.0	5'-0"	42	0.6	43'-2"	768	7.4	6'-1 3/4"	49	0.8
33"	33'-11"	634	6.2	4'-10"	43	0.7	37'-10"	710	7.0	5'-4 3/4"	46	0.7	46'-4"	848	8.5	6'-7 1/4"	52	0.9
36"	36'-3"	776	7.7	5'-3"	48	0.9	40'-5"	868	8.6	5'-10 3/4"	49	0.9	49'-6"	1058	10.6	7'-2 1/4"	56	1.1
42"	40'-11"	921	9.6	6'-0 1/4"	53	1.0	45'-7"	1022	10.7	6'-8 3/4"	57	1.2	55'-10"	1262	13.1	8'-3"	78	1.4
48"	47'-7"	1152	12.6	6'-10"	61	1.3	53'-1"	1268	14.0	7'-7 1/4"	80	1.5	65'-1"	1579	17.2	9'-3 3/4"	86	1.8
54"	52'-3"	1416	14.9	7'-9 1/4"	86	1.6	58'-4"	1589	16.6	8'-8"	89	1.8	71'-5"	1916	20.4	10'-7 1/4"	95	2.2
60"	56'-11"	1606	17.5	8'-6 3/4"	92	1.9	63'-6"	1798	19.5	9'-6 1/4"	95	2.1	77'-9"	2184	23.9	11'-8"	122	2.6
66"	61'-7"	1811	20.2	9'-0 3/4"	97	2.1	68'-8"	2011	22.5	10'-1 1/4"	101	2.4	84'-2"	2464	27.6	12'-4 1/4"	131	2.9
72"	66'-3"	2142	23.2	9'-8"	104	2.4	73'-11"	2371	25.9	10'-9 1/4"	108	2.6	90'-6"	2929	31.7	13'-2 1/4"	138	3.2
12"	25'-11"	342	3.1	1'-9 3/4"	15	0.2	28'-10"	374	3.5	2'-0"	16	0.2	35'-4"	456	4.3	2'-5 3/4"	17	0.2
15"	29'-3"	390	3.7	2'-3"	17	0.2	32'-7"	442	4.2	2'-6"	18	0.2	39'-11"	549	5.1	3'-0 3/4"	20	0.3
18"	32'-7"	459	4.4	2'-9"	20	0.3	36'-4"	515	4.9	3'-1"	29	0.3	44'-7"	629	6.0	3'-9 1/4"	33	0.4
21"	36'-0"	608	5.3	3'-2 1/4"	31	0.4	40'-2"	660	5.9	3'-6 3/4"	33	0.4	49'-2"	823	7.2	4'-4 1/4"	38	0.5
24"	39'-4"	672	6.0	3'-8 3/4"	35	0.4	43'-11"	748	6.7	4'-1 3/4"	36	0.5	53'-9"	920	8.2	5'-0 3/4"	42	0.6
27"	42'-8"	770	7.1	4'-0 3/4"	38	0.5	47'-8"	852	8.0	4'-6 1/4"	41	0.5	58'-4"	1039	9.7	5'-6 1/4"	45	0.7
30"	46'-1"	839	8.0	4'-5 3/4"	40	0.6	51'-5"	949	8.9	5'-0"	44	0.6	62'-11"	1154	10.9	6'-1 3/4"	48	0.8
33"	49'-5"	947	9.2	4'-10"	45	0.7	55'-2"	1040	10.3	5'-4 3/4"	48	0.7	67'-6"	1284	12.6	6'-7 1/4"	50	0.9
36"	52'-10"	1151	11.4	5'-3"	49	0.8	58'-11"	1287	12.7	5'-10 3/4"	51	1.0	72'-1"	1575	15.6	7'-2 1/4"	55	1.1
42"	59'-6"	1365	14.2	6'-0 1/4"	55	1.0	66'-5"	1522	15.8	6'-8 3/4"	57	1.2	81'-4"	1867	19.4	8'-3"	76	1.4
48"	69'-4"	1729	18.5	6'-10"	59	1.3	77'-4"	1934	20.7	7'-7 1/4"	79	1.5	94'-9"	2360	25.3	9'-3 3/4"	86	1.8
54"	76'-1"	2130	22.0	7'-9 1/4"	83	1.6	84'-10"	2370	24.6	8'-8"	87	1.8	103'-11"	2904	30.1	10'-7 1/4"	95	2.2
60"	82'-10"	2414	25.8	8'-6 3/4"	90	1.9	92'-5"	2673	28.8	9'-6 1/4"	94	2.1	113'-2"	3286	35.3	11'-8"	122	2.6
66"	89'-7"	2712	29.9	9'-0 3/4"	96	2.1	99'-11"	3030	33.3	10'-1 1/4"	101	2.4	122'-4"	3689	40.8	12'-4 1/4"	130	2.9
72"	96'-3"	3210	34.2	9'-8"	102	2.4	107'-5"	3572	38.2	10'-9 1/4"	108	2.6	131'-6"	4364	46.8	13'-2 1/4"	139	3.2

TABLE OF CONSTANT DIMENSIONS


DIA OF PIPE, D	G	K	H	T	E
12"	9"	1'-0"	2'-8"	9"	1'-9"
15"	11"	1'-0"	2'-11"	9"	1'-9"
18"	1'-2"	1'-0"	3'-2"	9"	1'-9"
21"	1'-4"	1'-0"	3'-5"	9"	2'-0"
24"	1'-7"	1'-0"	3'-8"	9"	2'-0"
27"	1'-8"	1'-0"	3'-11"	9"	2'-3"
30"	1'-10"	1'-0"	4'-2"	9"	2'-3"
33"	1'-11"	1'-0"	4'-5"	9"	2'-6"
36"	2'-1"	1'-0"	4'-8"	1'-0"	2'-6"
42"	2'-4"	1'-0"	5'-2"	1'-0"	2'-9"
48"	2'-7"	1'-3"	5'-11"	1'-0"	3'-0"
54"	3'-0"	1'-3"	6'-5"	1'-0"	3'-3"
60"	3'-3"	1'-3"	6'-11"	1'-0"	3'-6"
66"	3'-3"	1'-3"	7'-5"	1'-0"	3'-9"
72"	3'-4"	1'-3"	7'-11"	1'-0"	4'-0"

TABLE OF REINFORCING STEEL ④

Bar	Size	Spa	No.
A1	# 5	~	2
A2	# 5	1'-6"	~
E	# 5	~	2
F	# 5	1'-0"	~

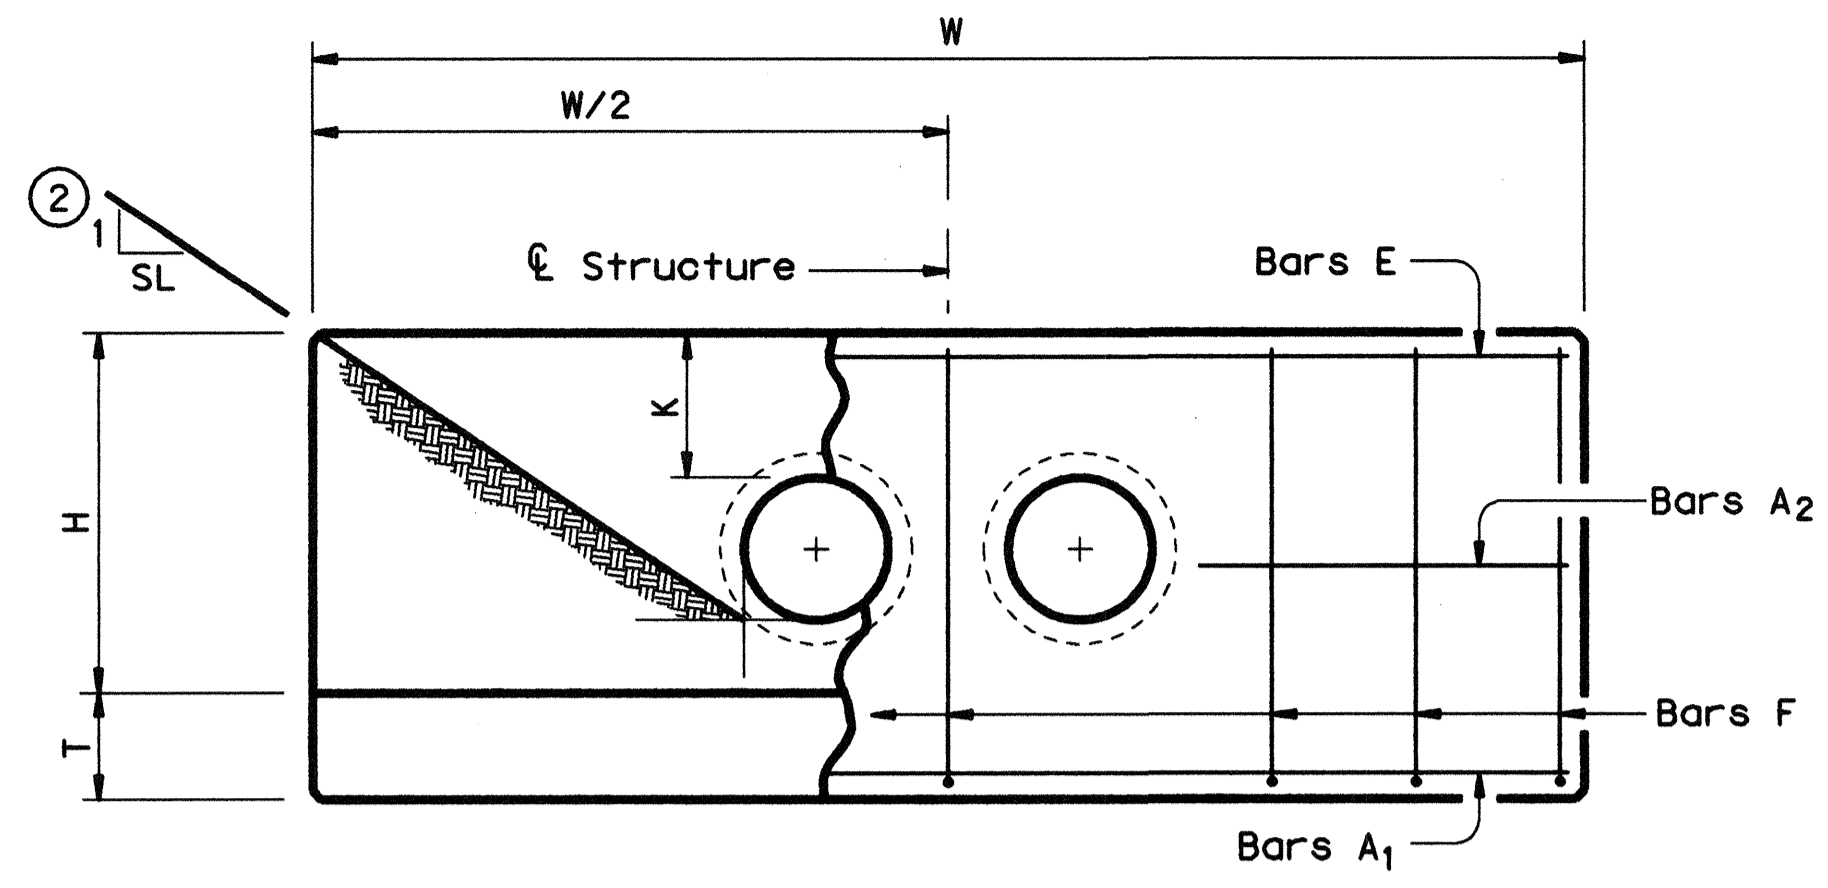


ELEVATION

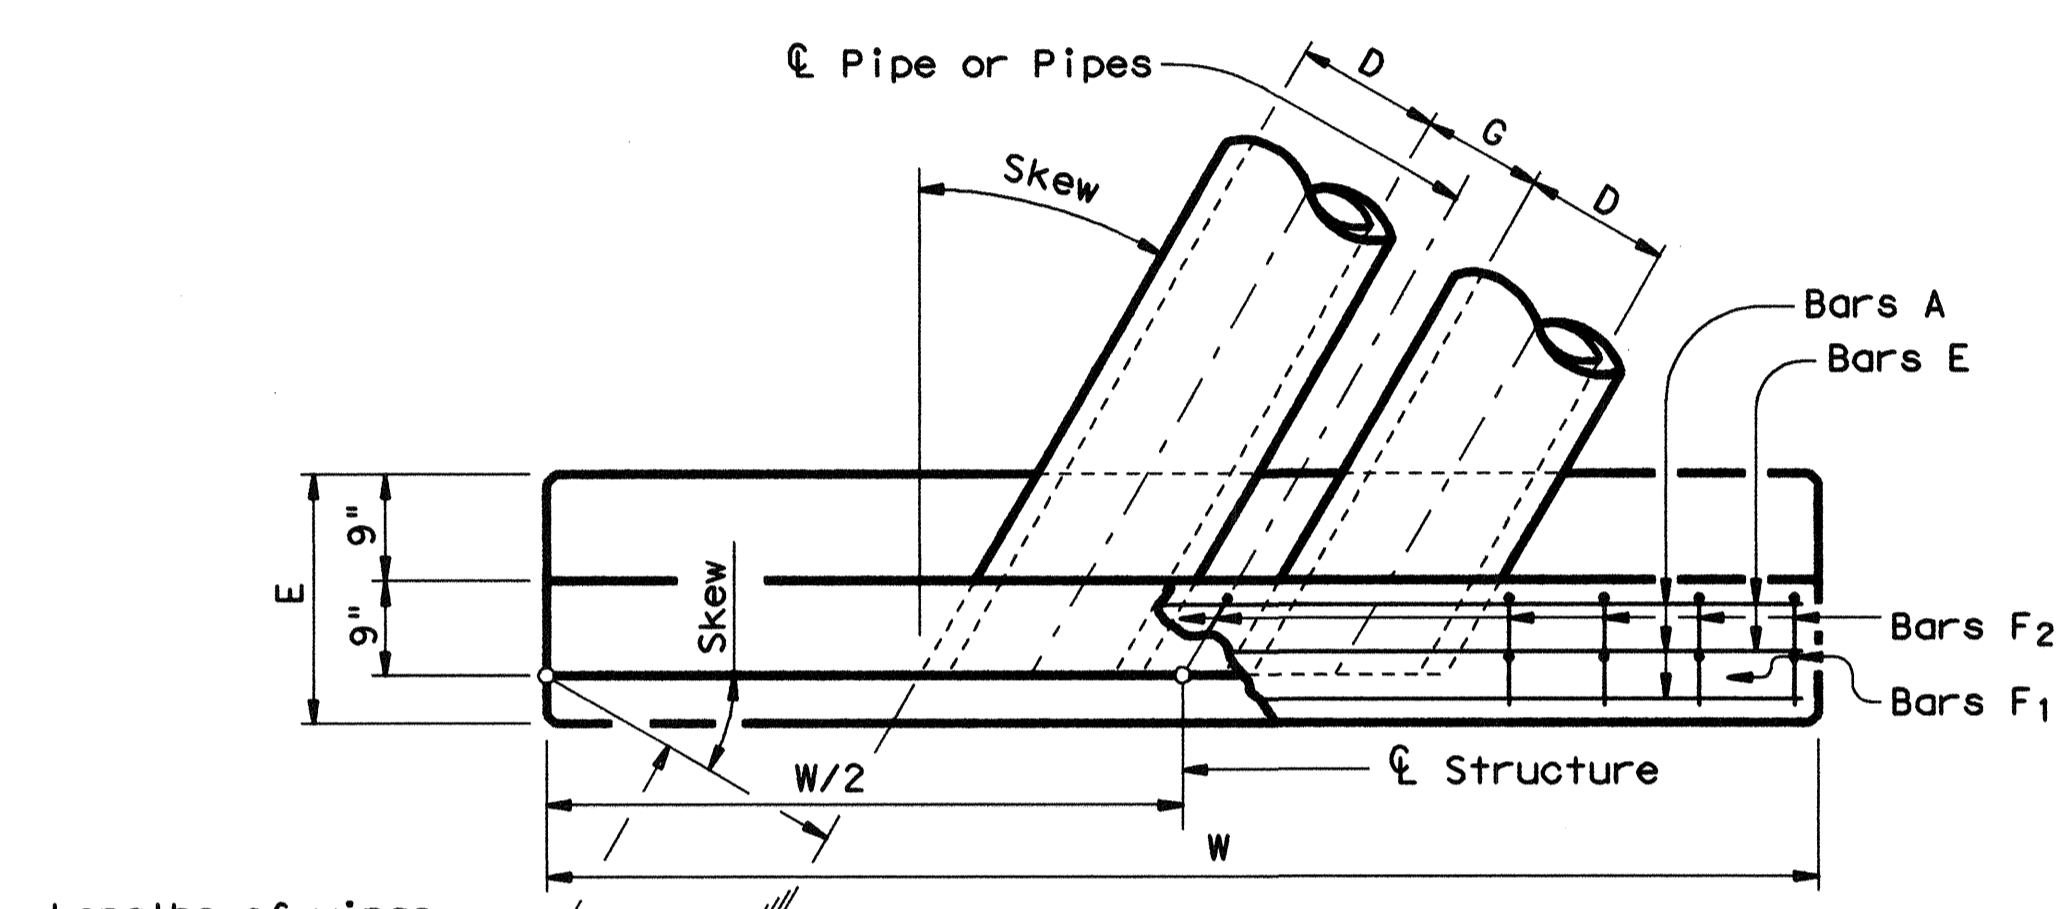


PLAN OF SKEWED PIPES

Showing 30° Skew
Lengths of wings based on SL:1 Slope along this line.

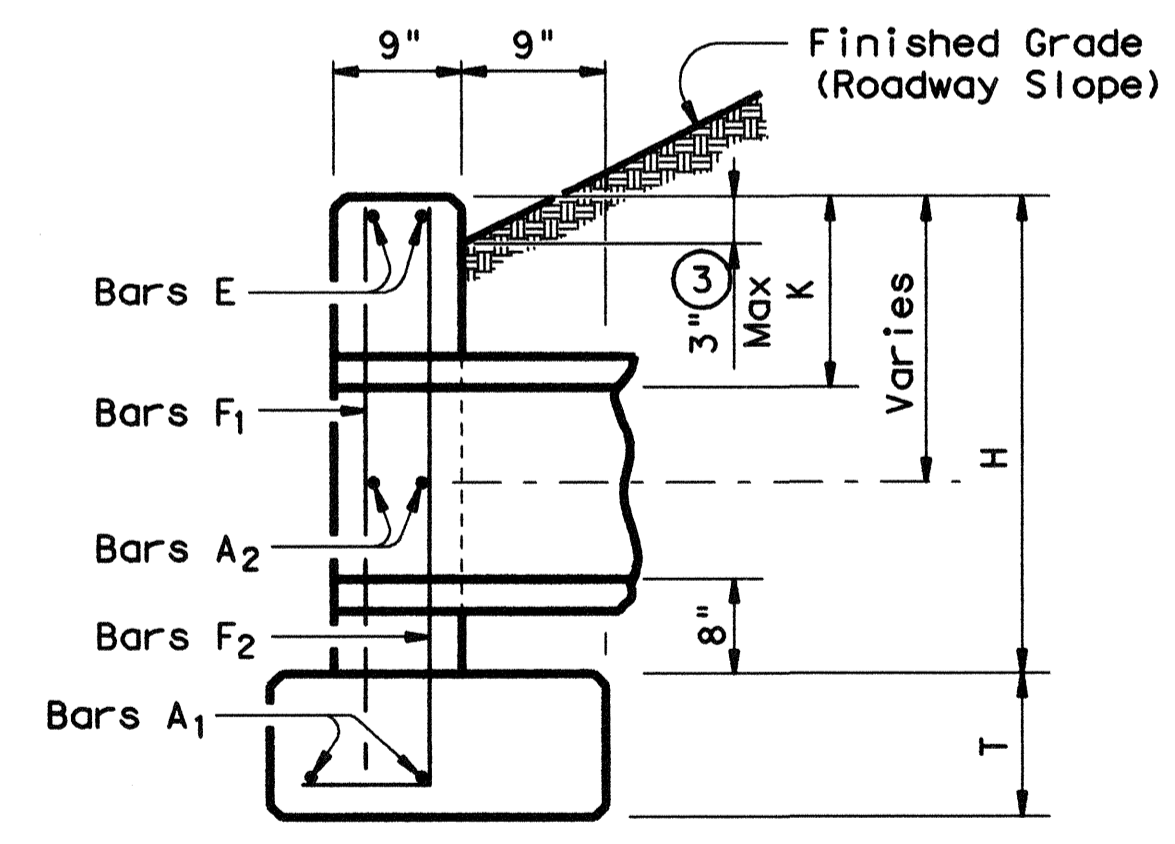


SECTION

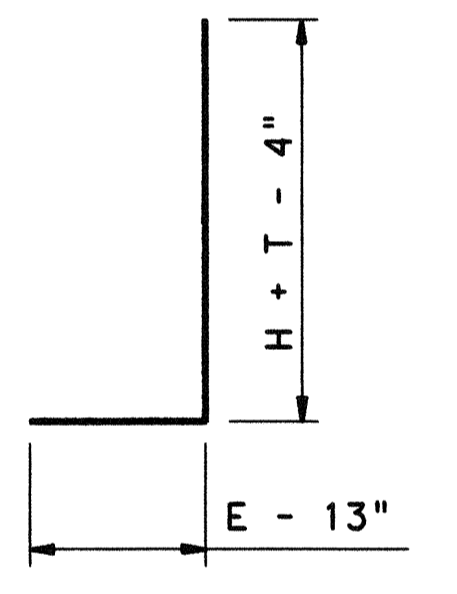


GENERAL NOTES:
 Designed according to AASHTO LRFD Specifications.
 Reinforcing steel shall be placed with the center of the outside layer of bars 2" from the surface of the concrete.
 All reinforcing steel shall be Grade 60.

DISCLAIMER: The use of this standard is governed by the "Texas Engineering Practice Act". No warranty of any kind is made by TxDOT for any purpose whatsoever. TxDOT assumes no responsibility for the conversion of this standard to other formats or for incorrect results or damages resulting from its use.


LEVELS DISPLAYED
ACC:

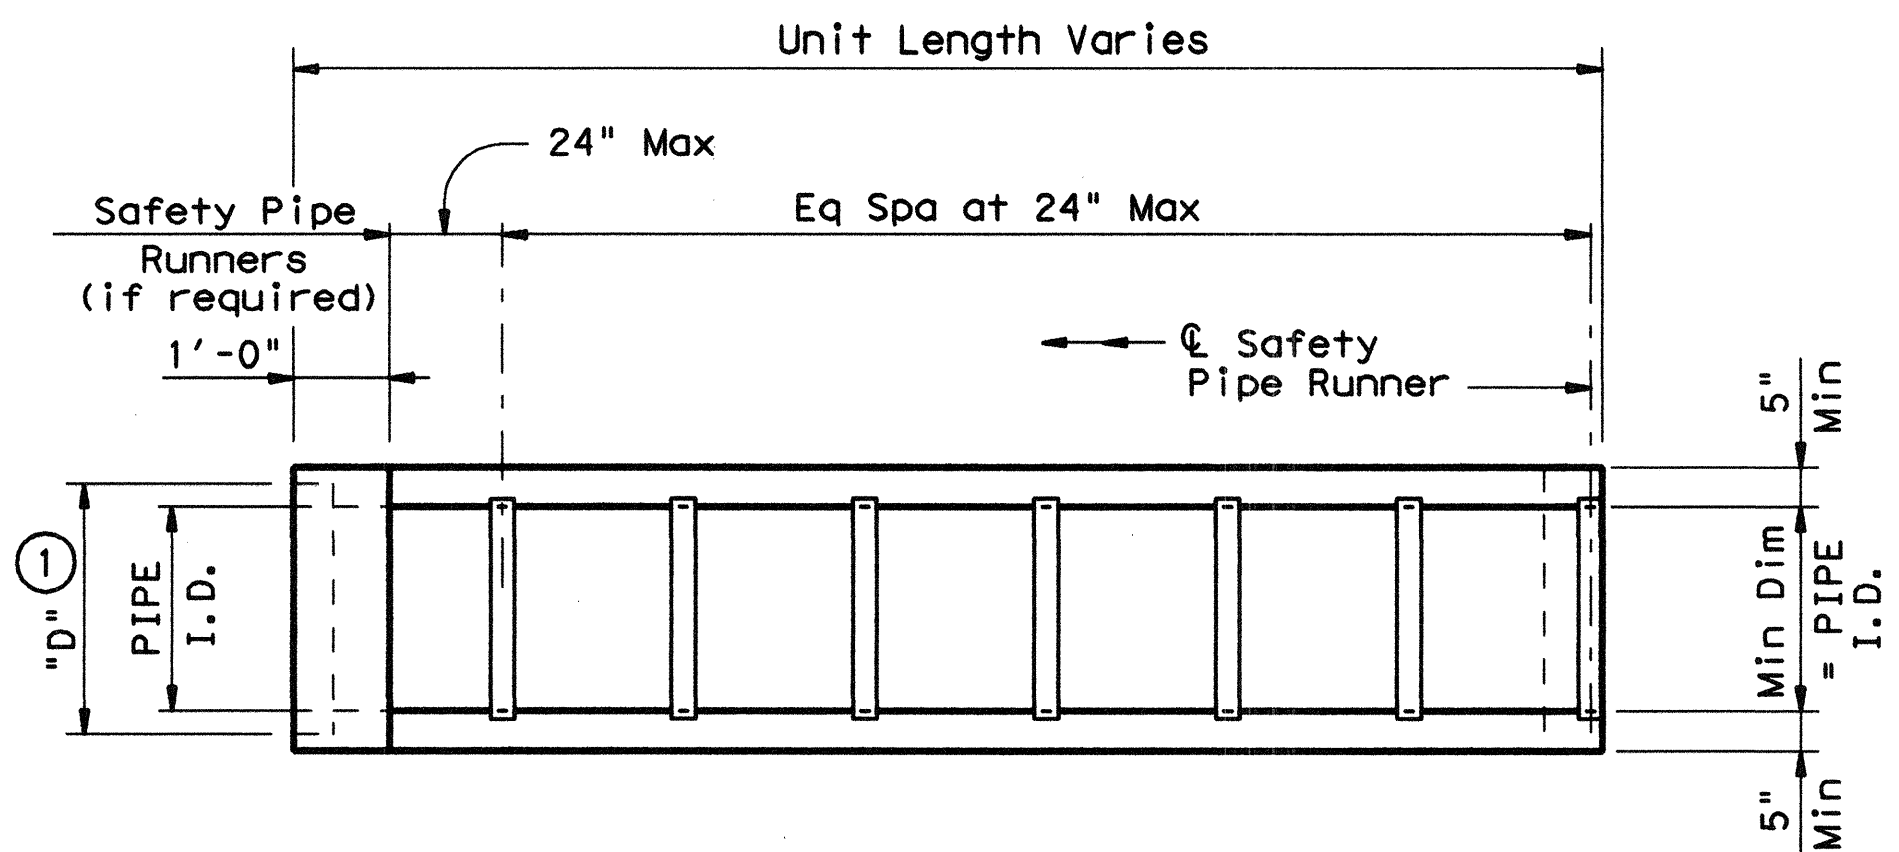

PLAN

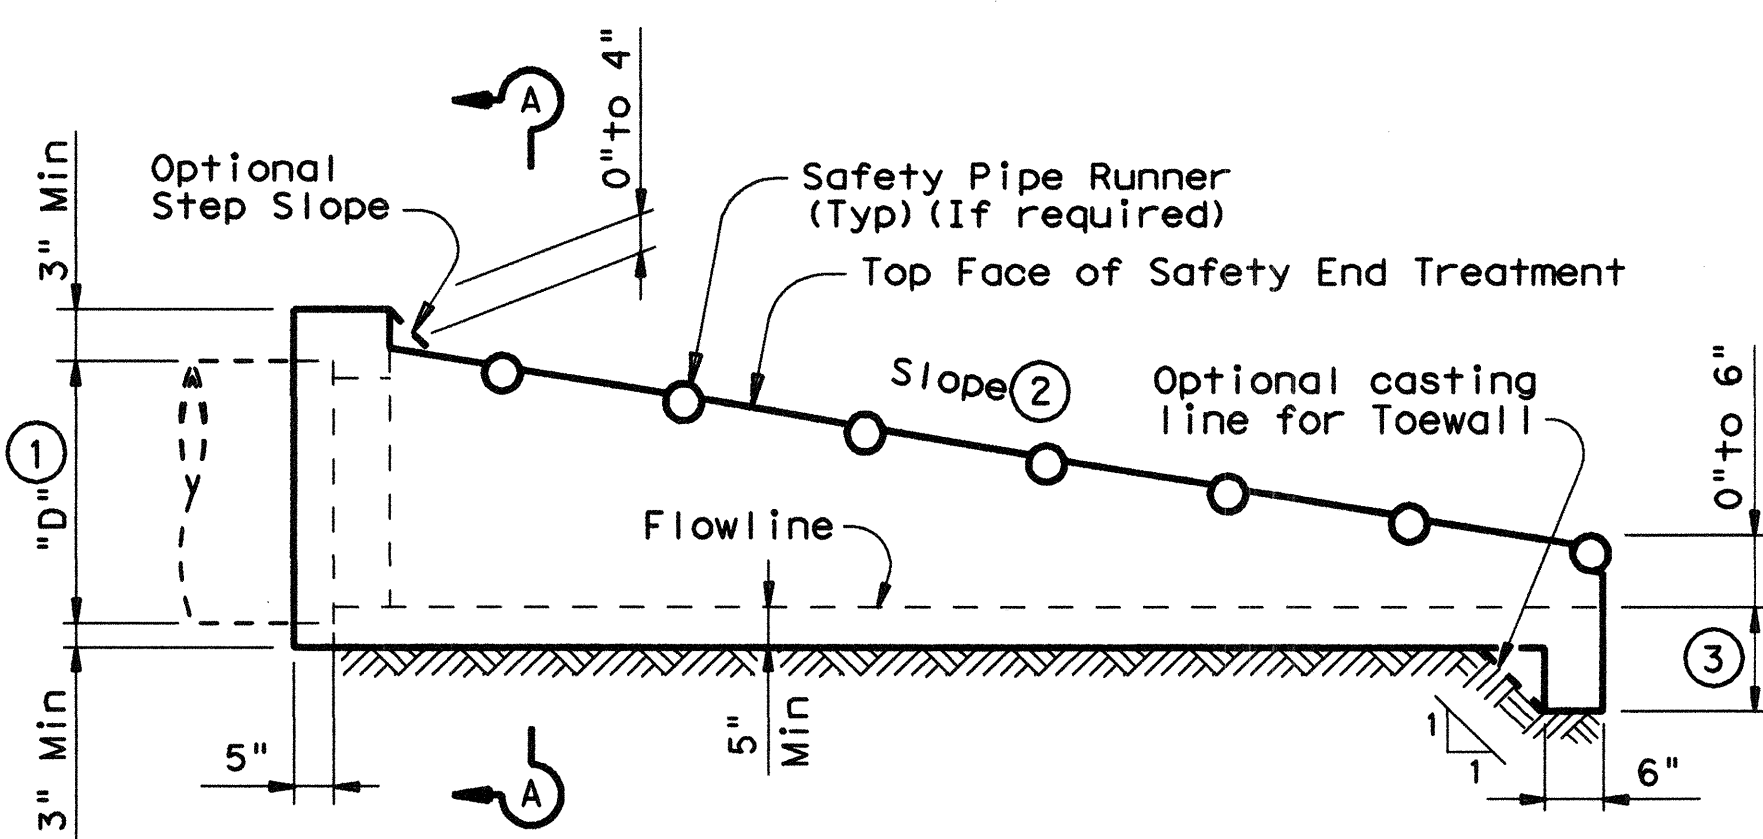


LONGITUDINAL ELEVATION

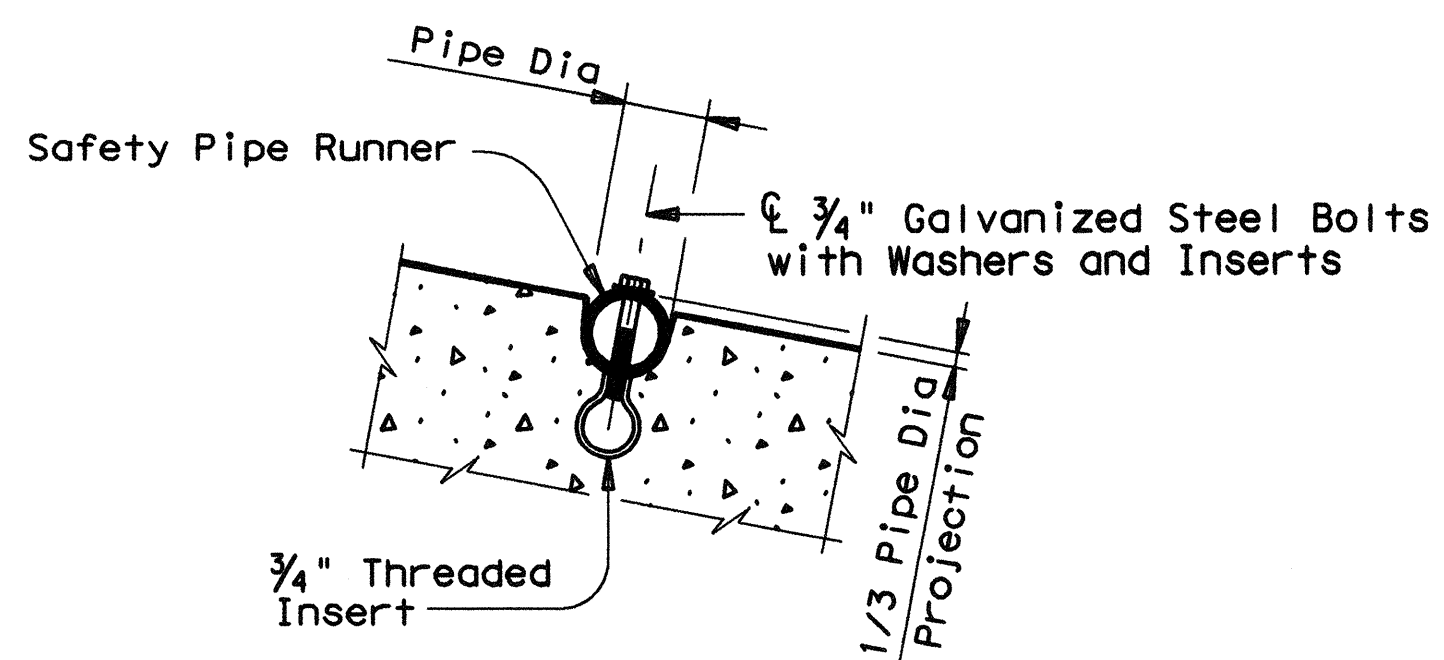


INSTALLATION DETAIL FOR SAFETY PIPE RUNNERS

(If required)

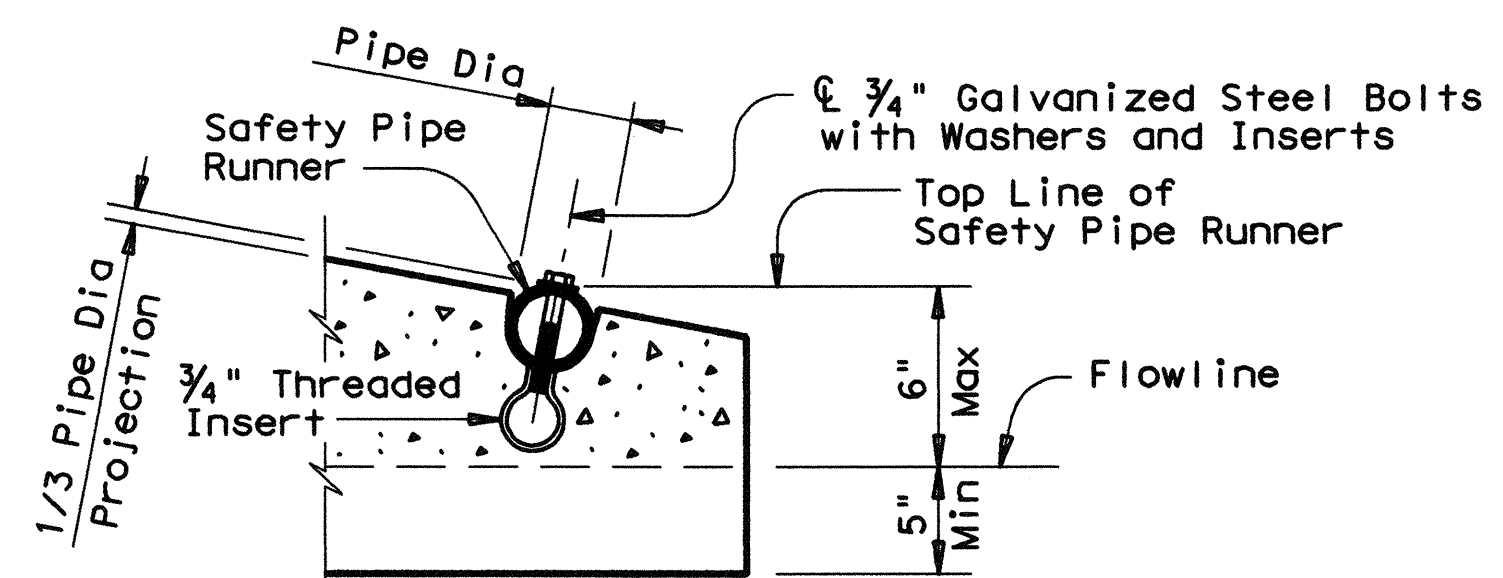


OPTION A

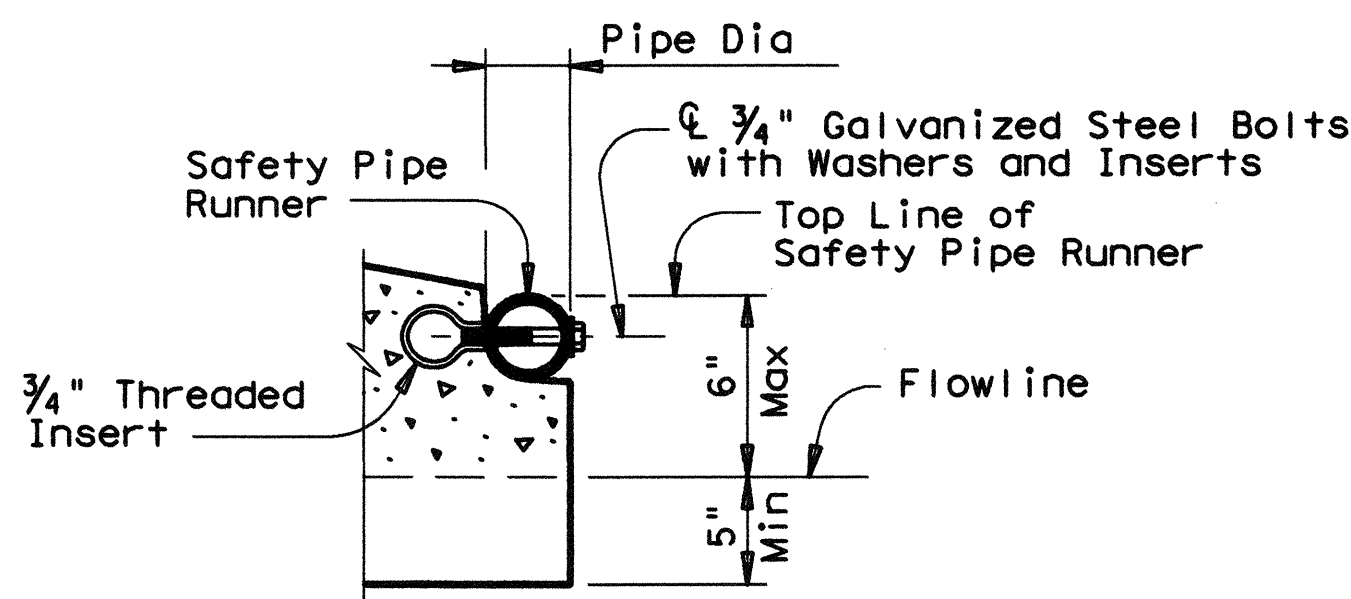

OPTION B

END DETAILS FOR INSTALLATION OF SAFETY PIPE RUNNERS


(If required)

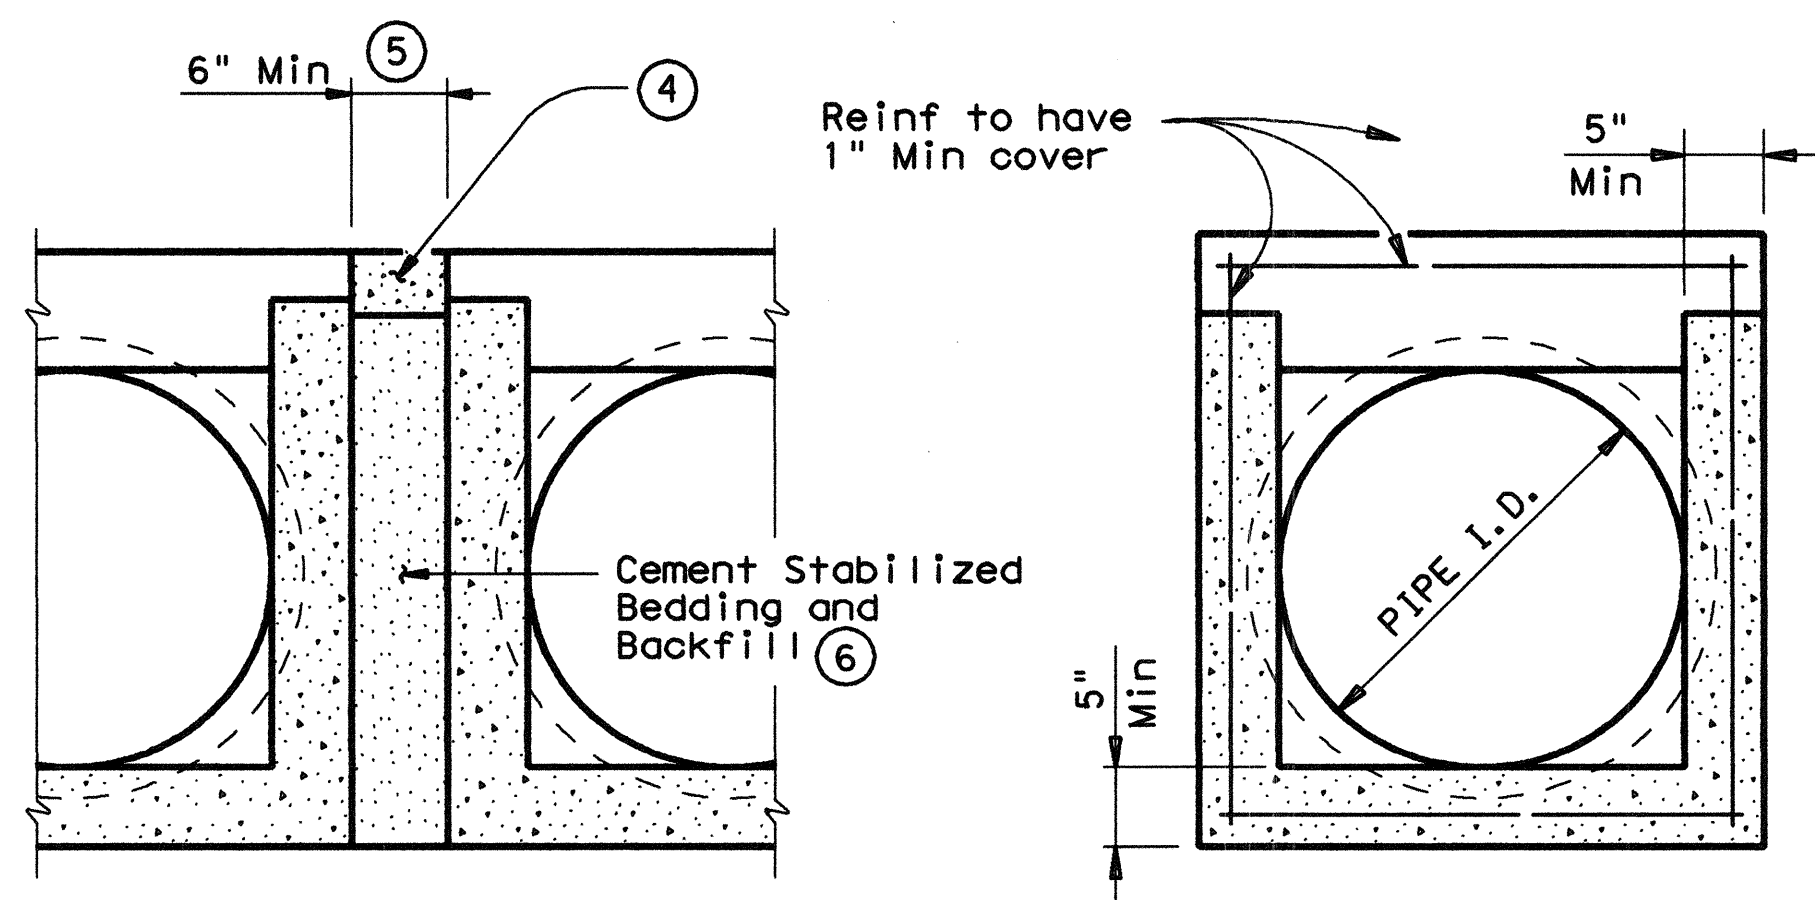


MULTIPLE PIPE INSTALLATION

OPTION WITH SQUARE BOTTOM

SECTION A-A

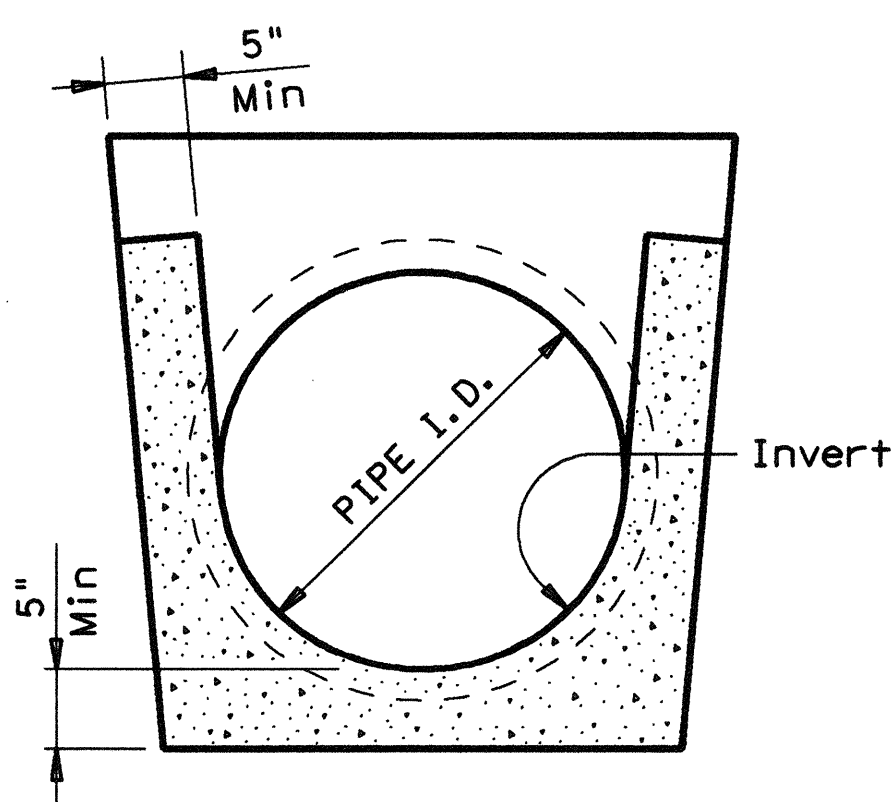

OPTION WITH INVERT BOTTOM

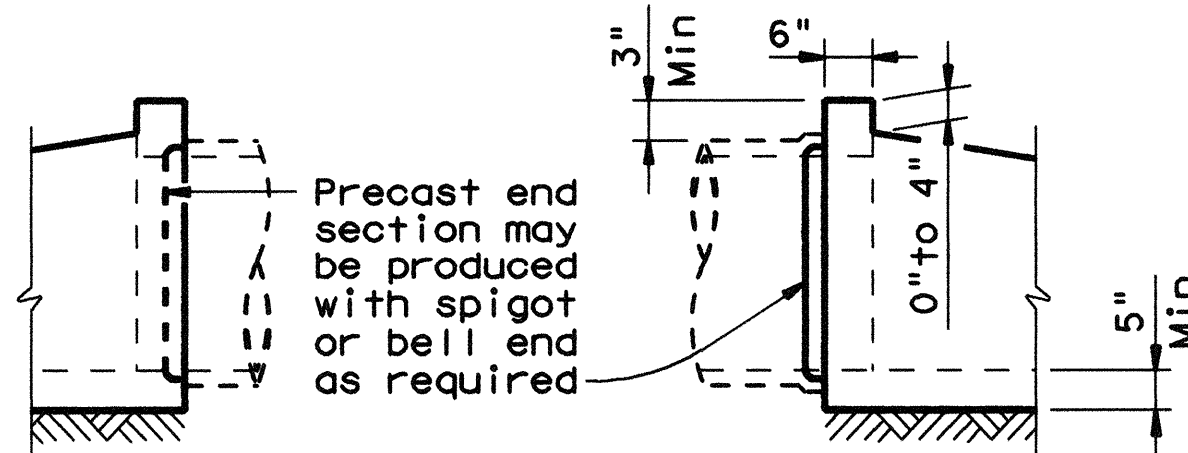

OPTIONAL JOINT

(Showing joint between RCP and Precast Safety End Treatment)

PIPE I.D.	PIPE WALL "B" THICKNESS	"D" ①	MAXIMUM SLOPE	MINIMUM LENGTH OF UNIT	PIPE RUNNERS REQUIRED		REQUIRED PIPE RUNNER SIZES		
					SINGLE PIPE	MULTIPLE PIPE	NOMINAL DIA.	O.D.	I.D.
12"	2"	17"	6:1	4'-9"	No	Yes, for >2 pipes	3" STD	3.500"	3.068"
15"	2 1/4"	20 1/2"	6:1	6'-5"	No	Yes, for >2 pipes	3" STD	3.500"	3.068"
18"	2 1/2"	24"	6:1	8'-0"	No	Yes, for >2 pipes	3" STD	3.500"	3.068"
24"	3"	31"	6:1	11'-3"	No	Yes, for >2 pipes	3" STD	3.500"	3.068"
30"	3 1/2"	38 1/2"	6:1	14'-8"	No	Yes	4" STD	4.500"	4.026"
36"	4"	45 1/2"	6:1	17'-11"	Yes	Yes	4" STD	4.500"	4.026"
42"	4 1/2"	52 1/2"	6:1	21'-2"	Yes	Yes	4" STD	4.500"	4.026"

- ① Dimension "D" is based on ASTM C-76, Class III, Wall "B" thickness. If any other wall thickness is used, dimension "D" must be adjusted accordingly.
- ② Slope as shown elsewhere in the plans. Slope of 6:1 or flatter is required for vehicle safety.
- ③ Toewall to be used only when dimension is shown elsewhere in the plans.
- ④ The top 4" of void between Precast End Treatments shall be filled with concrete Riprap and shall be considered subsidiary to Safety End Treatment.
- ⑤ Clear distance between pipes shall be adjusted to provide for the minimum distance between safety end treatments.
- ⑥ Cement stabilized bedding and backfill shall be in accordance with the Item, "Excavation and Backfill for Structures". Bedding and backfill shall be considered subsidiary to the Item "Safety End Treatment". When concrete riprap is specified around the safety end treatment, backfill shall be as directed by Engineer.

GENERAL NOTES:

Precast safety end treatment for reinforced concrete pipe may be used for TYPE II end treatment as specified in Item "Safety End Treatment".
When Precast Safety End Treatment is used as a Contractor's alternate to mitered RCP, Riprap will not be required unless noted otherwise on the plans.
Synthetic fibers listed on the "Fibers for Concrete" Material Producer List (MPL) may be used in lieu of steel reinforcing in riprap concrete unless noted otherwise.
Manufacture of this product shall conform to requirements of Item "Safety End Treatment" except as noted below:
A. Minimum reinforcing shall be #4 at 6" (Grade 40) or #4 at 9" (Grade 60) each way or 6 x 6 - W12 x W12 or 5 x 5 - W10 x W10 welded wire fabric.
B. Concrete for precast (steel formed) sections shall be Class "C" with a minimum compressive strength of 3600 psi.
At the option and expense of the Contractor the next larger size of Safety End Treatment may be furnished; as long as the "D" dimension cast is that of the required size of pipe.
Pipe Runners are designed for a traversing load of 10,000 Lbs at yield as recommended by Research Report 280-2F, "Safety Treatment of Roadside Parallel-Drainage Structures", Texas Transportation Institute, March 1981.
Pipe Runners shall conform to the requirements of ASTM A53 (Type E or S, Grade B), ASTM A500 (Grade B), or API 5LX52.
All steel components except reinforcing, shall be galvanized after fabrication. Galvanizing damaged during transport or construction shall be repaired in accordance with the specifications.

Texas Department of Transportation
Bridge Division

PRECAST SAFETY END TREATMENT TYPE II - PARALLEL DRAINAGE

PSET-SP

FILE: psetspse.dgn	DN: RLW	CK: KLR	DW: JTR	CK: GAF
© TxDOT February 2010	DISTRICT	FEDERAL AID PROJECT	SHEET	
REVISIONS				
11-10: Add note for synthetic fibers.				
COUNTY	CONTROL	SECT	JOB	HIGHWAY