
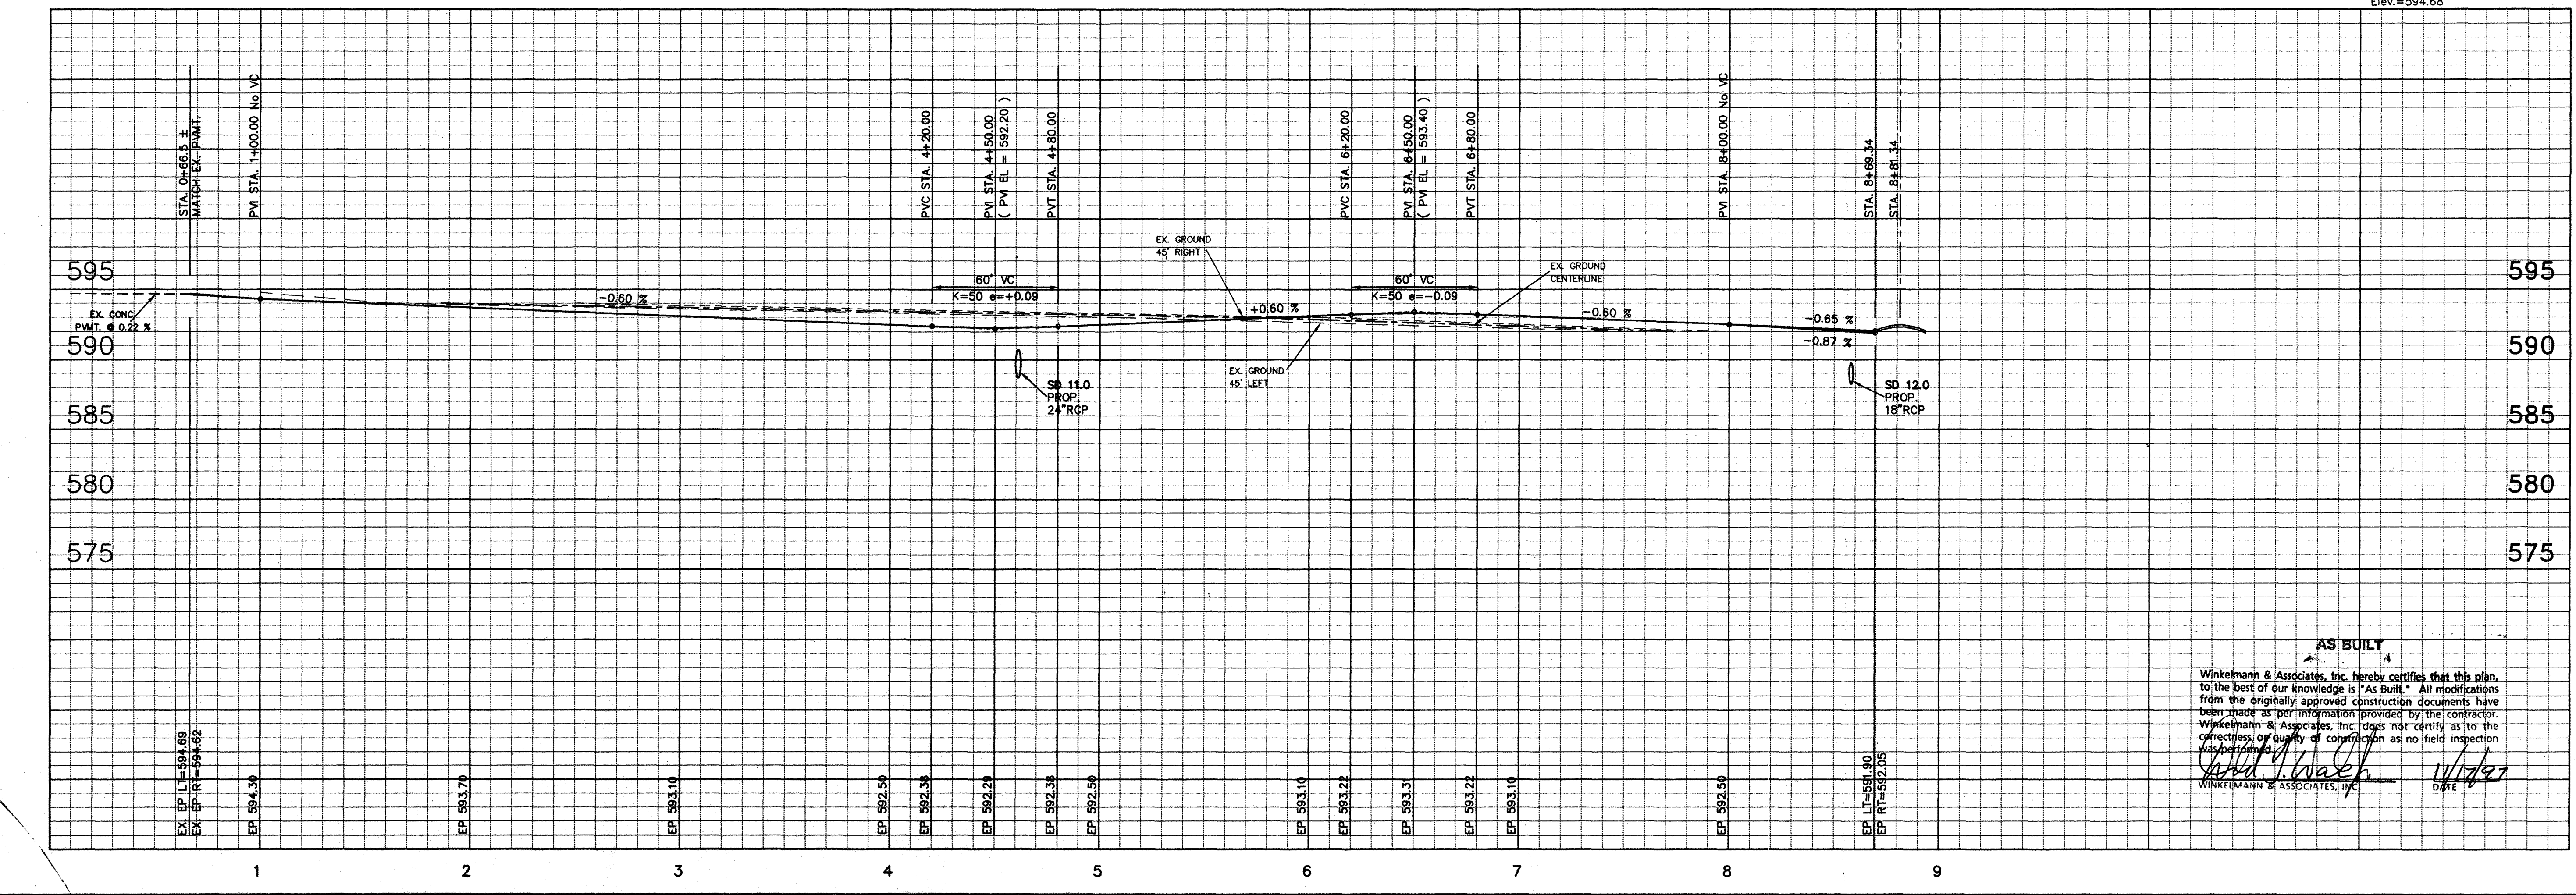


C:\GEO\Drawing Files\23401\234-pp11 Mon Apr 28 01:29:03 1997

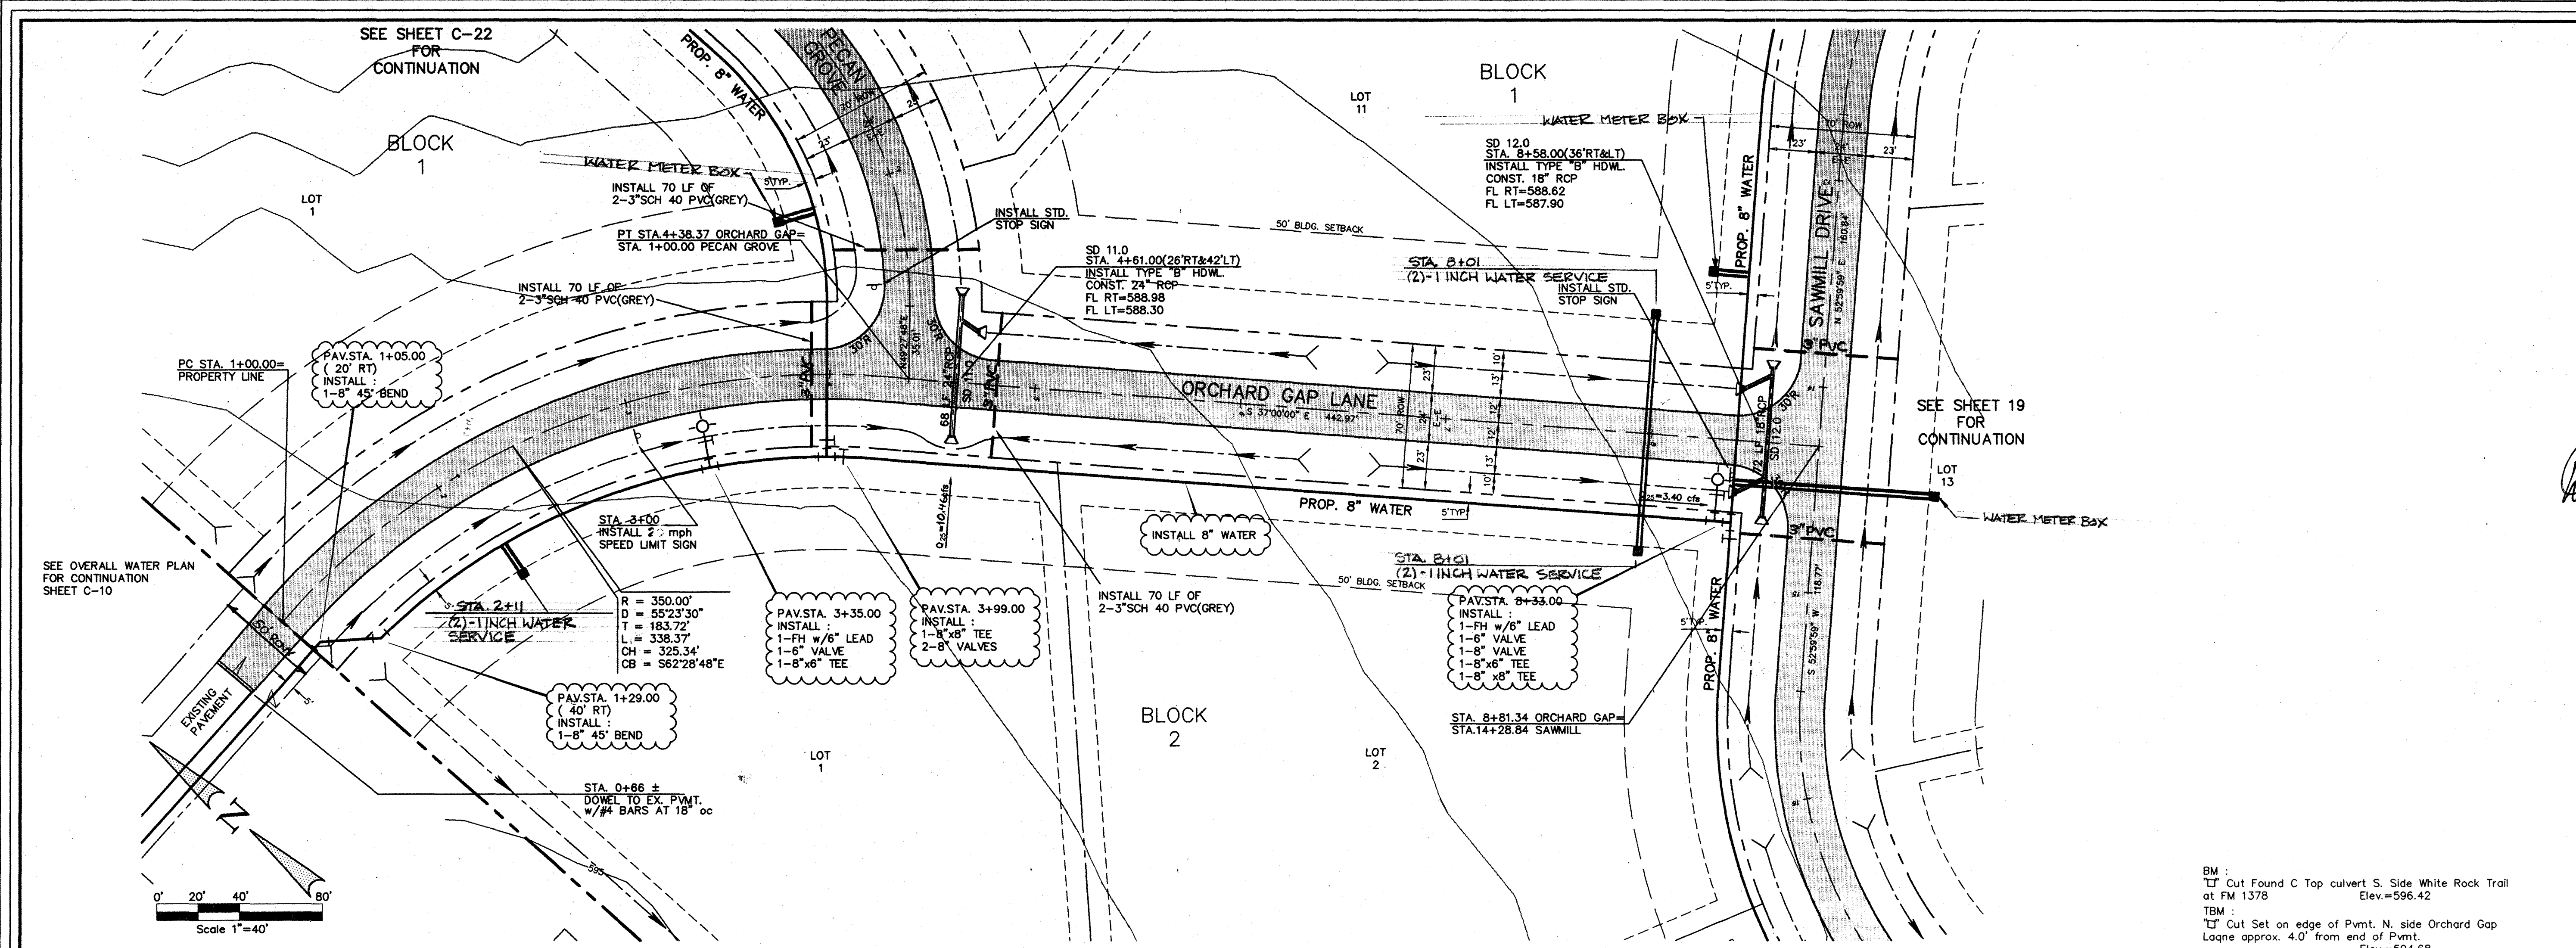

**AS BUILT**  
 Winkelman & Associates, Inc. hereby certifies that this plan, to the best of our knowledge is "As Built." All modifications from the originally approved construction documents have been made as per information provided by the contractor. Winkelman & Associates, Inc. does not certify as to the correctness or quality of construction as no field inspection was performed.  
 [Signature] DATE 4/24/97  
 WINKELMANN & ASSOCIATES, INC.

**Winkelman & Associates, Inc.**  
 CONSULTING CIVIL ENGINEERS & SURVEYORS  
 718 WEST ARAPAHO, STE. 100  
 RICHARDSON, TEXAS 75080  
 (972) 783-8888

JOHN W. KIRBY SURVEY, ABSTRACT NO. 506  
 CITY OF LUCAS  
 COLLIN COUNTY, TEXAS  
 UNITED STANDARD REALTY MORTGAGE CORPORATION  
 718 WEST ARAPAHO, STE. 100  
 RICHARDSON, TEXAS 75080  
 (972) 783-8888

PAVING, WATER & DRAINAGE PLAN  
 ORCHARD GAP LANE  
 STA. 1+00 TO STA. 8+81.34

Scale: H: 1"=40' Date: 4/24/97  
 Designed By: DFW  
 Drawn By: TJC  
 Checked By: DFW  
 File: 234-PP11.DWG  
 Project No.: 23401.01

**SHEET C-21**