

# CONSTRUCTION PLANS FOR SADDLEBROOK PHASE I CITY OF LUCAS COLLIN COUNTY, TEXAS

**DEVELOPER:**


SADDLEBROOK ESTATES, LTD  
TWO TURTLE CREEK  
3838 OAK LAWN AVE., SUITE 1212  
DALLAS, TEXAS 75219  
(214) 522-4945

**OWNER:**

THE SKORBURG COMPANY  
TWO TURTLE CREEK  
3838 OAK LAWN AVE., SUITE 1212  
DALLAS, TEXAS 75219  
(214) 522-4945

**ENGINEER:**

JONES & BOYD, INC.  
16800 DALLAS PARKWAY, SUITE 240  
DALLAS, TEXAS 75248  
(972) 248-7676

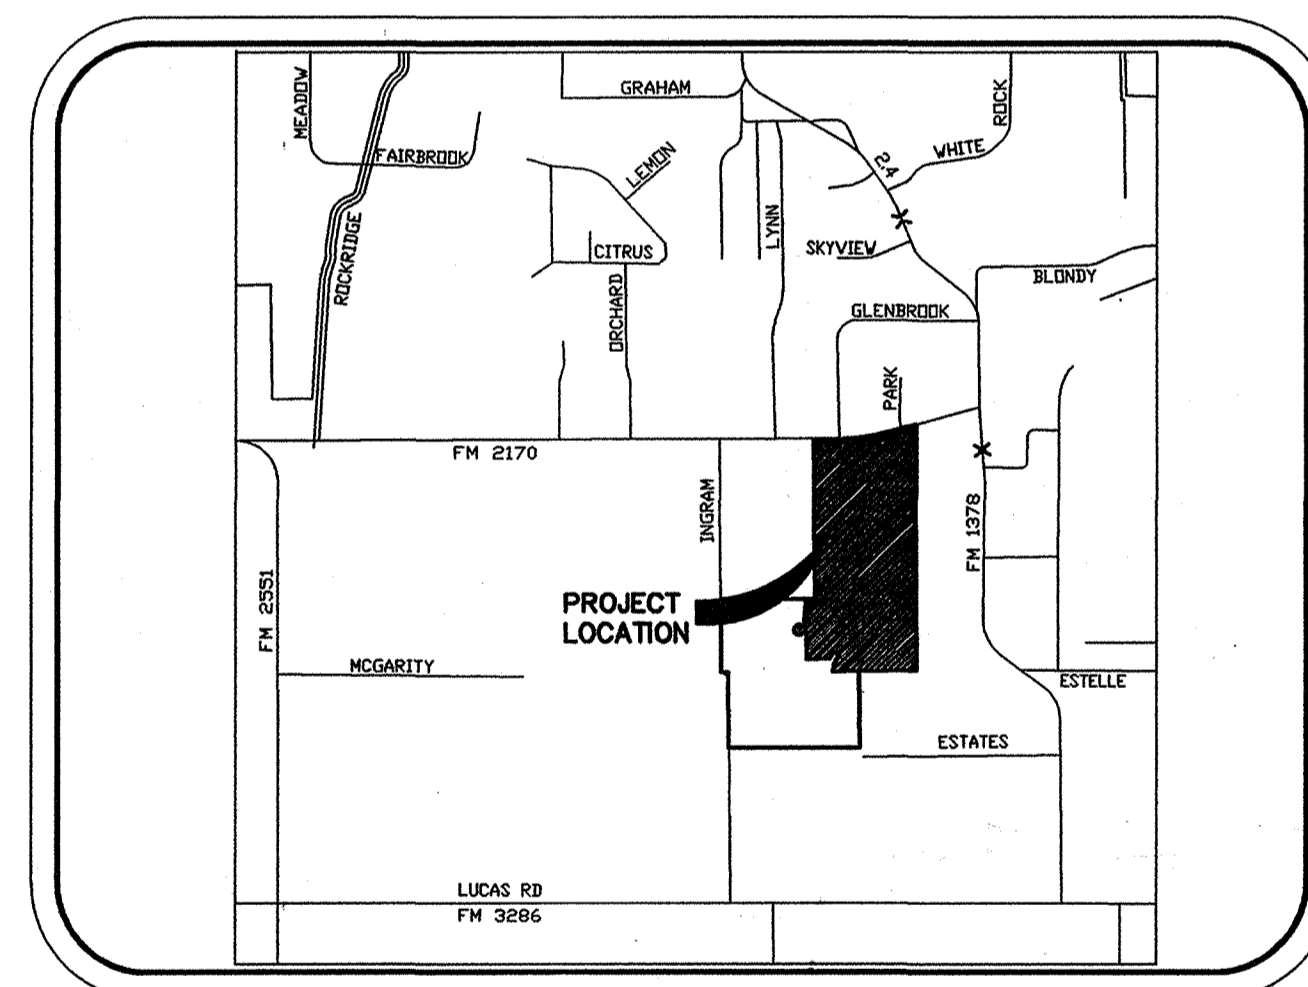

LOCATION MAP  
NOT TO SCALE

NTMWD NOTES

1. North Texas Municipal Water District (NTMWD) 42-inch and 20-inch water transmission pipelines are located within the limits of the construction.
2. Operation of heavy earthmoving equipment, compaction equipment or heavy construction equipment, such as concrete trucks, shall be restricted to specific crossing points across NTMWD easements, as approved by the NTMWD. The crossings shall be designated and verified to provide a minimum of five feet of cover.
3. To assure that placing of significant loads over the NTMWD pipeline does not damage the existing pipeline, no materials shall be stockpiled on the NTMWD easement, without authorization from the NTMWD. If the contractor desires to use NTMWD's easement for stockpile of materials, contact NTMWD Engineering at (972) 442-5405 so your plans for use of NTMWD's easement can be reviewed.
4. In areas where the cover between the top of the NTMWD pipeline and the bottom of the sub-grade is three (3) feet or less, it is requested that the sub-grade preparation be deleted and thickened pavement section be used to limit construction activities over the pipeline.
5. Crossing of the NTMWD easement with other utilities, such as TV cable, phone, gas and electric, shall be coordinated with the NTMWD to avoid damage to the NTMWD facilities.
6. Outdoor lighting, landscaping, screening walls or other facilities shall not be installed in NTMWD easements without written approval of the NTMWD.
7. Unless otherwise shown or required a minimum of one-foot clearance shall be provided for all utilities crossing the NTMWD pipelines.
8. The contractor shall contact NTMWD Engineering at (972) 442-5405 at least 48 hours prior to performing any work in the vicinity of the NTMWD facilities.
9. Water and Sewer lines crossing the NTMWD easements shall be installed in compliance with the Rules and Regulations for Public Water Systems, Paragraphs 290.44 (e), Location of Water Lines.
10. Septic systems are not permitted within NTMWD easements.
11. Excavation adjacent to NTMWD pipelines, manholes and other appurtenances to install proposed improvements shall be performed so that the manholes, pipelines or appurtenances are not displaced or damaged. Any damage to the manholes, pipelines or appurtenances shall be repaired to the satisfaction of the NTMWD. Further, any cost for repair of damage to the manholes, pipelines or appurtenances resulting from construction by the developer or contractor will be the responsibility for the developer.

GENERAL NOTES:

1. ALL MATERIALS AND INSTALLATION SHALL BE IN ACCORDANCE WITH STANDARD SPECIFICATIONS FOR PUBLIC WORKS CONSTRUCTION FOR NORTH CENTRAL TEXAS PUBLISHED BY NCTCOG WITH CITY OF LUCAS REVISIONS. THESE SPECIFICATIONS SHALL BE MADE PART OF THESE PLANS. ALL WORK SHALL BE INSPECTED BY THE CITY OF LUCAS PUBLIC WORKS INSPECTORS.
2. ALL CONSTRUCTION WITHIN TEXAS DEPARTMENT OF TRANSPORTATION RIGHT-OF-WAY SHALL USE MATERIALS AND INSTALLATION THAT IS ALSO IN ACCORDANCE WITH TxDOT STANDARD SPECIFICATIONS AND DETAILS. ALL WORK WITHIN TxDOT RIGHT-OF-WAY SHALL BE INSPECTED BY TxDOT INSPECTORS.
3. ALL CONSTRUCTION WITHIN NORTH TEXAS MUNICIPAL WATER DISTRICT EASEMENTS SHALL BE INSTALLED IN ACCORDANCE WITH N.T.M.W.D. SPECIFICATIONS AS LISTED ON THESE PLANS. N.T.M.W.D. SHALL BE CONTACTED PRIOR TO BEGINNING ANY WORK WITHIN N.T.M.W.D. EASEMENT AREAS.
4. CONTRACTOR SHALL NOTIFY CITY OF ALLEN PUBLIC WORKS DEPARTMENT PRIOR TO BEGINNING ANY WORK WITHIN CITY OF ALLEN EASEMENT AREAS.
4. EXISTING UTILITIES SHOWN ON THESE PLANS WERE TAKEN FROM EXISTING RECORDS. CONTRACTOR SHALL FIELD VERIFY LOCATION AND DEPTH OF ALL EXISTING UTILITIES PRIOR TO CONSTRUCTION.
5. CONTRACTOR SHALL VERIFY ALL TIE IN ELEVATIONS SHOWN ON THE PLANS.

**INDEX**

SHEET NO.	DESCRIPTION
1-3	FINAL PLAT
4-9, 9A	PAVING PLANS
10-12, 12A	GRADING PLANS
13	TYPICAL SECTIONS: BERMS & SWALES
14	EROSION CONTROL PLAN
15, 15A	DRAINAGE DESIGN THEORY
16	DRAINAGE AREA MAP - ROADWAY CULVERTS
17	DRAINAGE AREA MAP - DRIVEWAY CULVERTS
18	STORM SEWER CALCULATIONS
19	ROADWAY CULVERT PROFILES
20A-20C	DRAINAGE CHANNEL PLAN & PROFILES
21-22, 22A	WATER SYSTEM PLANS
23-24	OFFSITE 12" WATER LINE
25-26	TxDOT STANDARD DETAILS


BENCHMARKS:


1. "T" 1/2" IR, W of Ingram Rd. +- 1025' N of N edge of Lucas Rd. +- 6' E of fence.  
Elev. 637.08
2. "T" 1/2" IR, E of Ingram Rd. +- 2850' N of N edge of Lucas Rd. +- 28' E & 37' N of fence corner.  
Elev. 639.20

RECORD DRAWING  
THIS DRAWING HAS BEEN REVISED  
TO REFLECT THE ACTUAL  
CONSTRUCTION DETAILS AS  
CONTAINED IN THE RECORDS OF THE  
CONTRACTOR. ELEVATIONS SHOWN ON  
THIS PLAN WERE NOT FIELD VERIFIED.

JONES & BOYD, INC.  
BY: *[Signature]*  
DATE: 7/22/01

The seal appearing on this document was authorized by Thomas K. Juhn, P.E. 81799 on Feb. 14, 2001. Alteration of a sealed document without proper notification to the responsible engineer is an offense under the Texas Engineering Practice Act.

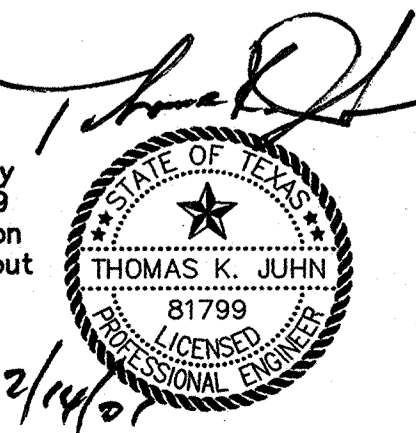

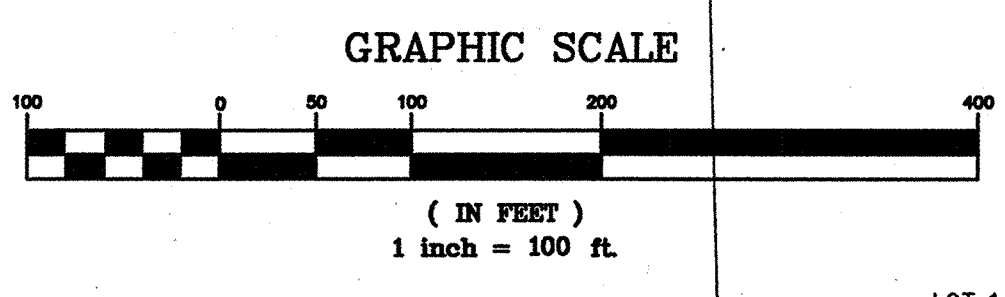

INGRAM ROAD (CO. RD. 262)

CO. RD. 262

LINE	BEARING	LENGTH
L1	N45°41'28"W	7.18'
L2	S48°48'59"E	7.34'
L3	S48°18'19"W	1.13'
L4	N38°22'11"E	5.19'
L5	N48°23'56"W	8.98'
L6	S89°18'34"W	10.36'
L7	S48°32'04"W	144.26'
L8	N75°38'54"W	189.38'
L9	S73°42'11"E	193.41'
L10	S00°01'48"W	135.90'
L11	S00°14'40"W	230.78'
L12	S00°16'20"E	162.80'
L13	S89°18'34"W	142.46'
L14	S37°31'45"W	111.91'
L15	S37°31'45"W	109.85'
L16	S89°18'34"W	132.61'
L17	S00°16'20"E	384.19'
L18	S00°08'16"E	188.14'
L19	N54°34'16"E	261.83'
L20	N54°34'16"E	247.67'
L21	S00°08'16"E	265.22'
L22	S00°29'10"W	91.20'
L23	S00°14'40"W	633.37'
L24	S89°42'57"W	117.10'
L25	S89°42'58"W	453.70'
L26	S89°18'34"W	283.35'

CURVE	DELTA	RADIUS	LENGTH	TANGENT	CHORD BEARING	CHORD
C1	13°43'57"	380.00	91.08	45.76	N07°33'25"W	90.88
C2	15°58'48"	785.00	212.92	107.15	S08°38'51"E	212.23
C3	32°44'28"	565.00	322.88	155.97	N00°16'01"W	318.48
C4	13°44'36"	565.00	135.52	68.09	N09°48'57"W	135.20
C5	18°59'52"	565.00	187.34	94.54	N06°38'17"E	186.48
C6	16°47'39"	635.00	186.13	93.74	S07°42'23"W	185.48
C7	90°00'00"	55.00	86.39	55.00	S45°41'26"E	77.78
C8	48°12'38"	335.00	270.18	142.82	S86°12'18"W	282.92
C9	90°00'00"	55.00	86.39	55.00	N44°18'34"E	77.78
C10	48°47'14"	465.00	404.08	215.78	N85°47'50"W	391.47
C11	90°00'00"	55.00	86.39	55.00	N44°18'34"E	77.78
C12	51°07'06"	335.00	298.88	160.21	S63°46'01"W	289.07
C13	4°54'30"	335.00	28.70	14.36	S40°38'43"W	28.69
C14	163°22'54"	65.00	185.35	445.08	S41°46'18"E	128.54
C15	90°00'00"	20.00	31.42	20.00	N44°18'34"E	28.28
C16	82°44'41"	415.00	60.82	30.52	N05°33'47"W	60.87
C17	11°05'17"	100.00	19.35	9.71	S03°33'29"E	19.32
C18	16°24'33"	200.00	57.28	28.84	N06°13'07"W	57.08
C19	131°31'13"	200.00	48.15	23.18	S21°02'00"E	48.05
C20	20°38'01"	100.00	36.02	18.21	N17°18'32"W	35.82
C21	8°19'01"	345.00	38.04	19.04	N03°50'57"W	38.02
C22	90°00'00"	20.00	31.42	20.00	N44°18'34"E	28.28
C23	178°48'58"	65.00	204.00	-	N44°18'34"E	130.00
C24	90°00'00"	55.00	86.39	55.00	N44°18'34"E	77.78
C25	90°00'00"	55.00	86.39	55.00	S44°18'34"W	77.78
C26	90°00'00"	20.00	31.42	20.00	S44°18'34"W	28.28
C27	180°04'20"	65.00	204.29	-	S43°12'51"W	130.00
C28	15°58'48"	800.00	222.66	112.05	S08°38'51"E	221.94
C29	15°58'48"	730.00	203.18	102.25	S08°38'51"E	202.52
C30	10°31'19"	600.00	110.19	55.25	N11°22'35"W	110.03
C31	32°44'28"	530.00	302.86	155.69	N00°16'01"W	298.76
C32	15°31'35"	600.00	162.59	81.80	N08°20'28"E	162.10
C33	16°47'39"	670.00	196.39	98.80	S07°42'23"W	195.69
C34	16°47'39"	600.00	175.87	88.57	S07°42'23"W	175.24
C35	153°27'42"	65.00	174.10	275.63	N51°48'39"W	126.53
C36	90°00'00"	20.00	31.42	20.00	S45°41'26"E	28.28
C37	90°00'00"	20.00	31.42	20.00	N44°18'34"E	28.28
C38	182°56'32"	65.00	207.54	-	N43°37'46"E	129.96
C39	40°12'46"	370.00	259.68	135.45	S89°12'10"W	254.39
C40	51°07'06"	300.00	267.66	143.47	S63°46'01"W	258.67
C41	48°47'14"	500.00	434.47	232.02	N85°47'50"W	420.93
C42	48°47'14"	430.00	373.65	199.54	N85°47'50"W	362.00
C43	284°50'31"	65.00	334.49	-	N00°41'28"W	70.00

FARM-TO-MARKET NO. 2170

20' WATER MAIN ESMT TO THE CITY OF ALLEN  
VOLUME 863, PAGE 232

DR. L.W. BARNETT  
VOL. 92-0024492

ALLEN ISD  
VOL. 1454, PG. 527


ALLEN ISD  
VOL. 1002, PG. 128

POINT OF BEGINNING

MATCH LINE

MATCH LINE

A=15°26'40"  
R=1959.08  
L=528.08  
T=265.65  
C.B.=N81°14'32"E  
Chd.=526.49

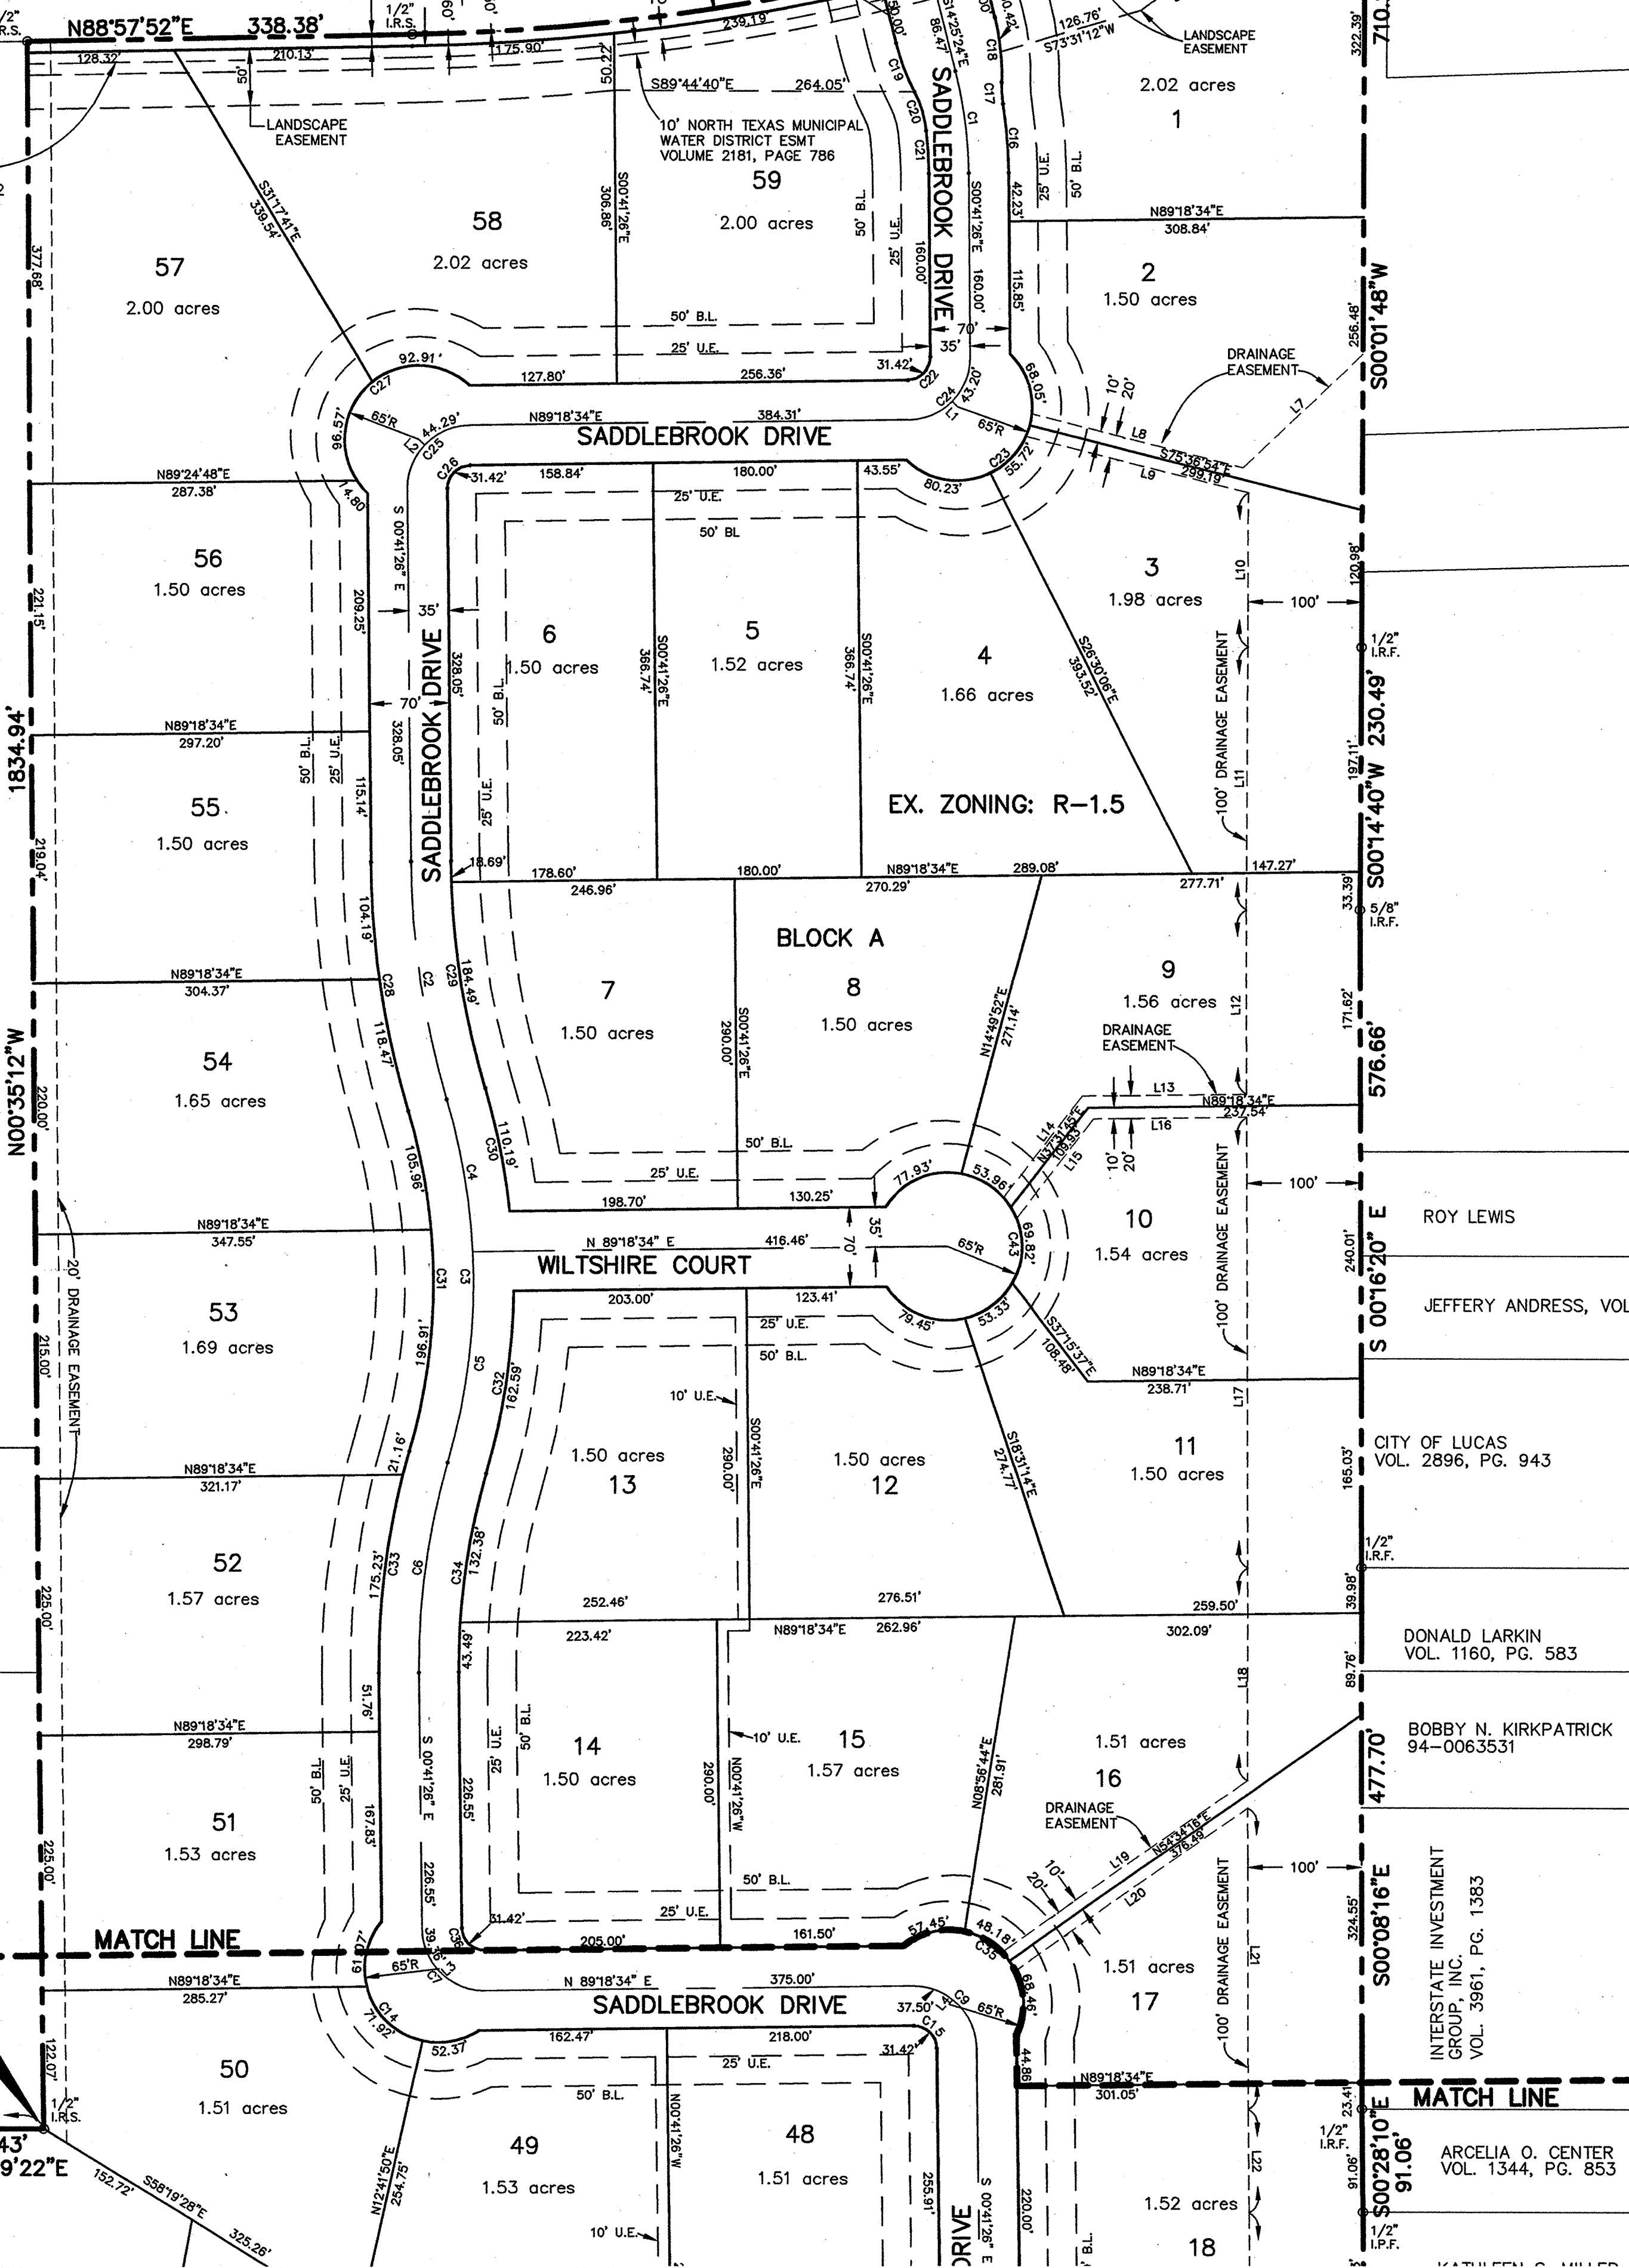

CITY OF ALLEN  
VOL. 819, PG. 4

SARAH JEAN COLSTON  
92-0092458

NANCY D. FISHER  
94-0034179

KENNETH E. JONES & WIFE  
DOROTHY E. JONES  
VOL. 699, PG. 759

ROY LEWIS

JEFFERY ANDRESS, VOL. 4450, PG. 2615

CITY OF LUCAS  
VOL. 2896, PG. 943

DONALD LARKIN  
VOL. 1160, PG. 583

BOBBY N. KIRKPATRICK  
94-0063531

INTERSTATE INVESTMENT  
CORPORATION  
VOL. 3961, PG. 1383

ARCELIA O. CENTER  
VOL. 1344, PG. 853

GENERAL NOTES:

- BEARINGS BASED ON THE RECORDED PLAT OF TRAVIS RANCH ESTATES, CAB. K, PG. 840 COLLIN COUNTY PLAT RECORDS. NORTHEAST LINE OF SAID ADDITION HELD AS N00°37'31"W.
- 1/2" IRON RODS SET AT ALL LOT CORNERS, UNLESS OTHERWISE NOTED.
- NO PORTION OF SUBJECT PROPERTY LIES WITHIN THE 100 YEAR FLOOD PLAIN PER F.I.R.M. MAP NO. 48085C0455-G PUBLISHED BY F.E.M.A. DATED JANUARY 19, 1996.
- LANDSCAPE EASEMENTS AND DRAINAGE EASEMENTS TO BE MAINTAINED BY THE HOMEOWNERS ASSOCIATION.
- THE NTMWD EASEMENT RESTRICTS CONSTRUCTION OF PERMANENT STRUCTURES SUCH AS FOUNDATIONS, WALLS, POOLS, AND PERMANENT STORAGE BUILDINGS. ITEMS SUCH AS DRIVEWAYS, FENCES, SPRINKLER SYSTEMS AND NORMAL LANDSCAPING PLANS THAT ENCOACH ON THE NTMWD EASEMENTS ARE ALLOWED. HOWEVER, THE NTMWD ASSUMES NO RESPONSIBILITY FOR DAMAGES RESULTING FROM THE NEED TO REPAIR OR MAINTAIN THE NTMWD PIPELINES. FURTHER, ANY COST FOR REPAIR FOR DAMAGE TO THE PIPELINES RESULTING FROM CONSTRUCTION BY THE DEVELOPER, CONTRACTOR OR OWNER WILL BE THE RESPONSIBILITY OF THE DEVELOPER, CONTRACTOR OR OWNER.
- DEVELOPER TO INSTALL LANDSCAPED SUBDIVISION ENTRANCE SIGN IN MEDIAN ISLAND ON SADDLEBROOK DRIVE AT F.M. 2170. PER CITY OF LUCAS REQUIREMENTS. SIGN AND LANDSCAPING TO BE MAINTAINED BY THE HOMEOWNER'S ASSOCIATION.

**FINAL PLAT**  
**SADDLEBROOK ESTATES, PHASE I**  
73.565 ACRES OUT OF  
J. GRAYUM SURVEY, ABSTRACT NO. 354  
J. SNIDER SURVEY, ABSTRACT NO. 824  
CITY OF LUCAS  
COLLIN COUNTY, TEXAS

**SADDLEBROOK ESTATES, LTD.** OWNER  
c/o The Skorbung Company  
Two Turtle Creek  
3838 Oak Lawn Ave., suite 1212  
Dallas, Texas 75219  
**JONES & BOYD, INC.** SURVEYOR/ENGINEER  
16800 Dallas Parkway, Suite 240  
Dallas, Texas 75248

**LEGEND**  
L.R.F. IRON ROD FOUND  
L.R.S. IRON ROD SET  
B.L. BUILDING LINE  
U.E. UTILITY EASEMENT

WLU H:\Projects\SK403\Draw\SK403P1.dwg 8/1/01 10:33 am

GRAPHIC SCALE

( IN FEET )  
1 inch = 100 ft.

ALLEN ISD  
VOL. 1002, PG. 128

LEGEND

- I.R.F. IRON ROD FOUND
- I.R.S. IRON ROD SET
- B.L. BUILDING LINE
- U.E. UTILITY EASEMENT

BEARINGS BASED ON THE RECORDED PLAT OF TRAVIS RANCH ESTATES, CAB. K, PG. 840 COLLIN COUNTY PLAT RECORDS, NORTHEAST LINE OF SAID ADDITION HELD AS N00°37'31"W.

THE SPARKS TRUST  
VOL. 1696, PG. 50

30' STRIP TO COLLIN COUNTY  
VOL. 2343, PG. 221, D.R.C.C.T.

CO. RD. NO 224

77.46'  
N89°52'23"W

30' STRIP TO COLLIN COUNTY  
VOL. 2343, PG. 221, D.R.C.C.T.

TRAVIS RANCH RD.

POINT OF COMMENCING

LOT 18

MEADOW HILLS DEVELOPMENT, L.P.  
VOL. 4143, PG. 4158

FUTURE PHASE II

SADDLEBROOK ESTATES, LTD.  
VOL. 4785, PG. 3278

POINT OF BEGINNING

$\Delta=294^{\circ}43'25''$   
 $R=65.00$   
 $L=334.35$   
 $C.B.=N01^{\circ}31'53''E$   
 $Chd.=70.11$

$\Delta=3^{\circ}46'42''$   
 $R=430.00$   
 $L=28.36$   
 $T=14.18$   
 $C.B.=N83^{\circ}03'58''W$   
 $Chd.=28.35$

$\Delta=14^{\circ}41'30''$   
 $R=370.00$   
 $L=94.87$   
 $T=47.70$   
 $C.B.=S30^{\circ}50'43''W$   
 $Chd.=94.61$

$\Delta=37^{\circ}48'21''$   
 $R=300.00$   
 $L=197.95$   
 $T=102.73$   
 $C.B.=N19^{\circ}17'17''E$   
 $Chd.=194.38$

$N04^{\circ}33'09''E$   
 $322.59'$

$N00^{\circ}41'26''W$   
 $294.09'$

$S89^{\circ}18'34''W$   
 $264.44'$

$S89^{\circ}18'34''W$   
 $300.72'$

$S89^{\circ}42'57''W$   
 $654.55'$

103.43'  
N89°59'22"E

$N04^{\circ}33'09''E$   
 $322.59'$

$N00^{\circ}41'26''W$   
 $294.09'$

$S89^{\circ}18'34''W$   
 $264.44'$

$S89^{\circ}18'34''W$   
 $300.72'$

$S89^{\circ}42'57''W$   
 $654.55'$

$S89^{\circ}18'34''W$   
 $264.44'$

$S89^{\circ}18'34''W$   
 $300.72'$

$S89^{\circ}42'57''W$   
 $654.55'$

$S89^{\circ}18'34''W$   
 $264.44'$

$S89^{\circ}18'34''W$   
 $300.72'$

$S89^{\circ}42'57''W$   
 $654.55'$

$S89^{\circ}18'34''W$   
 $264.44'$

$S89^{\circ}18'34''W$   
 $300.72'$

MATCH LINE

SADDLEBROOK DRIVE

MATCH LINE

BRIARDALE DRIVE

SADDLEBROOK DRIVE

SADDLEBROOK DRIVE

ESTATES ROAD

TR. 9

TR. 8

TR. 10

TR. 11

TR. 12

TR. 13

RANCH ESTATES SUBDIVISION  
VOL. 653, PG. 464

NOTE: 1/2" IRON RODS SET AT ALL LOT CORNERS,  
UNLESS OTHERWISE NOTED.

FINAL PLAT

SADDLEBROOK ESTATES, PHASE I

73.565 ACRES OUT OF  
J. GRAYUM SURVEY, ABSTRACT NO. 354  
J. SNIDER SURVEY, ABSTRACT NO. 824  
CITY OF LUCAS  
COLLIN COUNTY, TEXAS

SADDLEBROOK ESTATES, LTD.

OWNER

c/o The Skarburg Company  
Two Turtle Creek  
3838 Oak Lawn Ave., suite 1212  
Dallas, Texas 75219

(214) 522-1945

JONES & BOYD, INC.

SURVEYOR/ENGINEER

16800 Dallas Parkway, Suite 240  
Dallas, Texas 75248

(972)248-7676

40 LOTS

AUGUST 1, 2001

Sheet 2 of 3

Filed for Record in:  
Collin County, McKinney TX  
Honorable Helen Starnes  
Collin County Clerk  
On Sep 12, 2001  
At 9:41am  
Doc/Num : 2001- 0114657  
Recording/Type: PL  
Receipt #: 30800 36.00

11/95

OWNER'S CERTIFICATION

WHEREAS Saddlebrook Estates Ltd., a Texas limited partnership, is the owner of a 73.565 acre tract of land out of the J. Grayum Survey, Abstract No. 354, and the J. Snider Survey, Abstract No. 824, being located in the City of Lucas, Collin County, Texas, being part of that 123,510 acre tract of land described in Deed to Saddlebrook Estates, Ltd. as recorded in Volume 4785, Page 3278, Collin County Deed Records, and being more particularly described as follows:

COMMENCING at a one-half inch iron rod set for corner, said point being the southwest corner of said 123,510 acre tract, said point also being the northwest corner of a tract of land described in Deed to Meadow Hills Development, L.P., as recorded in Volume 4143, Page 4158, Collin County Deed Records, said point also being in the east line of a 30 foot strip of land conveyed to Collin County, Texas by Deed recorded in Volume 2343, Page 221, Collin County Deed Records;

THENCE North 00 degrees 37 minutes 31 seconds West, 865.35 feet along the east line of said 30 foot strip to a "P-K" nail set for corner, said point being in the north line of said 30 foot strip of land, said point also being in the north right-of-way line of McGarity Road-County Road 224 (45 foot R.O.W.);

THENCE North 89 degrees 52 minutes 23 seconds West, 77.46 feet along the north line of said McGarity Road to a one-half inch iron rod set for corner, said point being the southeast corner of a called 40 acre tract of land described in Deed to The Sparks Trust as recorded in Volume 1696, Page 50, Collin County Deed Records;

THENCE North 00 degrees 17 minutes 01 seconds West, 846.39 feet to a "P-K" nail set for corner, said point being the southwest corner of a called 9,8336 acre tract of land described in Deed to Allen Independent School District as recorded in Volume 1002, Page 128, Collin County Deed Records;

THENCE North 89 degrees 59 minutes 22 seconds East, passing at 980.38 feet a one-half inch iron rod set, continuing for a total distance of 1,083.81 feet, along the south line of said 9,8336 acre tract to a one-half inch iron rod set for the POINT OF BEGINNING;

THENCE North 00 degrees 35 minutes 12 seconds West, 1,834.94 feet along the east line of said 9,8336 acre tract and along the east line of a called 4,919 acre tract described in Deed to Allen Independent School District as recorded in Volume 1454, Page 527, Collin County Deed Records, and along the east line of a called 13,285 acre tract described in Deed to Dr. L.W. Barnett and wife as recorded in Document No. 92-0024482, Collin County Deed Records, to a one-half inch iron rod set for corner in the south right-of-way line of F.M. 2170-Estates Parkway (105 foot R.O.W.);

THENCE along the south line of said F.M. 2170 as follows:  
North 88 degrees 37 minutes 52 seconds East, 338.38 feet to a one-half inch iron rod set for corner;

Northeasterly, 528.08 feet along a curve to the left having a radius of 1,959.08, a central angle of 15 degrees 26 minutes 40 seconds, a tangent of 265.65 feet, and a chord bearing and distance of North 81 degrees 14 minutes 32 seconds East, 526.49 feet to a one-half inch iron rod set for corner;

North 73 degrees 31 minutes 12 seconds East, 328.09 feet to a one-half inch iron rod set for corner, said point being the northwest corner of a tract of land described in Deed to Sarah Jean Colston as recorded in Document No. 92-0092458, Collin County Deed Records;

THENCE South 00 degrees 01 minutes 48 seconds West, 710.28 feet along the west line of said Colston tract and along the west line of a called 2.00 acre tract described in Deed to Nancy D. Fisher as recorded in Document No. 94-0034179, Collin County Deed Records, and along the west line of a called 20.00 acre tract of land described in Deed to Kenneth E. Jones and wife as recorded in Volume 689, Page 759, Collin County Deed Records, to a one-half inch iron rod found for corner;

THENCE South 00 degrees 14 minutes 40 seconds West, 230.49 feet continuing along the west line of said Jones tract to a five-eighths inch iron rod found for corner;

THENCE South 00 degrees 16 minutes 20 seconds East, 576.86 feet, continuing along the west line of said Jones tract and along the west line of a tract of land conveyed to Roy Lewis, and also along the West line of a tract of land conveyed to Jeffery Andress as described in Deed recorded in 4450, Page 2615, Collin County Deed Records, and also along the west line of a called 2,996 acre tract of land described in Deed to the City of Lucas as recorded in Volume 2896, Page 943, Collin County Deed Records, to a one-half inch iron rod found for corner, being the northwest corner of a called 1.50 acre tract of land described in Deed to Donald Larkin and wife as recorded in Volume 1160, Page 583, Collin County Deed Records;

THENCE South 00 degrees 08 minutes 16 seconds East, 477.70 feet along the west line of said Larkin tract and along the west line of a called 2.00 acre tract of land described in Deed to Bobby N. Kirkpatrick as recorded on Document No. 94-0083531, Collin County Deed Records, and also along the west line of a called 4.365 acre tract of land described in Deed to Interstate Investment Group, Inc. as recorded in Volume 3961, Page 1383, Collin County Deed Records, to a one-half inch iron rod found for corner, being the northwest corner of a called 1.50 acre tract described in Deed to Arcelia O. Center as recorded in Volume 1344, Page 853, Collin County Deed Records;

THENCE South 00 degrees 28 minutes 10 seconds East, 91.08 feet along the west line of said Center tract to a one-half inch iron rod found for corner, being the northwest corner of a tract of land described in Deed to Kathleen S. Miller as recorded in Document No. 96-0029521, Collin County Deed Records;

THENCE South 00 degrees 17 minutes 48 seconds East, 752.09 feet along the west line of said Miller tract, and along the west line of called 1.50 acre tract of land described in Deed to George Paul Milligan and wife as recorded in Volume 3075, Page 55, Collin County Deed Records, also along the west line of a tract of land conveyed to Vada Cleveland, also along the west line of a called 8.691 acre tract described in Deed to Bryma, Inc. as recorded in Document No. 96-0047682, Collin County Deed Records, to a one-half inch iron rod set for the southwest corner of said Bryma tract, being in the north line of Ranch Estates Subdivision as recorded in Volume 653, Page 4, Collin County Deed Records.

THENCE South 89 degrees 42 minutes 57 seconds West, 654.55 feet along the north line of said Ranch Estates to a one-half inch iron rod set for corner, being the northwest corner of said Ranch Estates;

THENCE South 89 degrees 18 minutes 34 seconds West, 300.72 feet to a one-half inch iron rod set for corner;

THENCE Northeasterly, 197.95 feet along a curve to the right having a radius of 300.00 feet, a central angle of 37 degrees 49 minutes 21 seconds, a tangent of 102.73 feet, and a chord bearing and distance of North 19 degrees 17 minutes 17 seconds East, 194.38 feet to a one-half inch iron rod set for corner;

THENCE North 51 degrees 48 minutes 32 seconds West, 70.00 feet to a one-half inch iron rod set for corner;

THENCE Southwesterly, 94.87 feet along a curve to the left having a radius of 370.00 feet, a central angle of 14 degrees 41 minutes 30 seconds, a tangent of 47.70 feet, and a chord bearing and distance of South 30 degrees 50 minutes 43 seconds West, 94.61 feet to a one-half inch iron rod set for corner;

THENCE South 89 degrees 18 minutes 34 seconds West, 264.44 feet to a one-half inch iron rod set for corner;

THENCE North 00 degrees 41 minutes 26 seconds West, 294.09 feet to a one-half inch iron rod set for corner;

THENCE Northwesterly, 28.36 feet along a curve to the left having a radius of 430.00 feet, a central angle of 03 degrees 46 minutes 42 seconds, a tangent of 14.18 feet, and a chord bearing and distance of North 83 degrees 03 minutes 58 seconds West, 28.35 feet to a one-half inch iron rod set for corner;

THENCE Northeasterly, 334.35 feet along a curve to the right having a radius of 65.00 feet, a central angle of 294 degrees 43 minutes 25 seconds, and a chord bearing and distance of North 01 degree 31 minutes 53 seconds East, 70.11 feet to a one-half inch iron rod set for corner;

THENCE North 04 degrees 33 minutes 09 seconds East, 322.59 feet to a one-half inch iron rod set for corner in the south line of aforementioned 9,8336 acre tract;

THENCE North 89 degrees 59 minutes 22 seconds East, 103.43 feet to the POINT OF BEGINNING and containing 7,204,489 square feet or 73,565 acres of land.

OWNERS' DEDICATION

KNOW ALL MEN BY THESE PRESENTS:

That Saddlebrook Estates, Ltd., a Texas limited partnership, acting by and through the undersigned authorities, does hereby adopt this plat designating the hereinabove described property as SADDLEBROOK ESTATES, PHASE I, an addition to the City of Lucas, Texas, and do hereby dedicate to the public use forever the rights-of-way, streets, easements and alleys shown thereon.

This plat approved subject to all platting ordinances, rules, regulations, and resolutions of the City of Lucas, Texas. Sidewalks shall be constructed by the homebuilder in accordance with the requirements of the City of Lucas, Texas.

WITNESS my hand this 8 day of August 2001.

Saddlebrook Estates, Ltd.  
By: Saddlebrook Estates, G.P. Corporation

Title: Richard M. Scarborough, President

STATE OF TEXAS  
COUNTY OF DALLAS

Before me, the undersigned authority, a Notary Public in and for the said County and State on this day personally appeared Richard M. Scarborough known to me to be the person whose name is subscribed to the foregoing instrument and acknowledged to me that he executed the same in the capacity therein stated.

Given under my hand and seal this 8th day of August 2001.




Kelli L. Burns  
Notary Public in and for the State of Texas

SURVEYOR'S CERTIFICATION

KNOW ALL MEN BY THESE PRESENTS:

That I, Dan B. Ramsey, Surveyor, hereby certify that I have prepared this plat from an actual and accurate survey of the land, and that the corner monuments shown thereon were properly placed under my personal supervision in accordance with the subdivision regulations of the City of Lucas, Texas.

Dan B. Ramsey, R.P.L.S. No. 4172

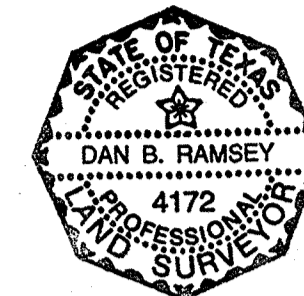


STATE OF TEXAS  
COUNTY OF DALLAS

BEFORE ME, the undersigned authority in and for the State of Texas, on this day personally appeared DAN B. RAMSEY, known to me to be the person whose name is subscribed to the foregoing instrument and acknowledged to me that he executed the same for the purposes and consideration therein expressed and in the capacity therein stated.

GIVEN UNDER MY HAND AND SEAL OF OFFICE this 3rd day of August 2001.

Cathy L. Cunningham  
Notary Public in and for the State of Texas

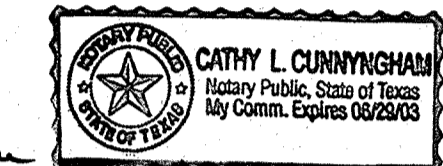

"RECOMMENDED FOR APPROVAL"

Chairman, Planning & Zoning Committee  
CITY OF LUCAS, TEXAS

8/23/01  
DATE

"APPROVED"

T. Phelps  
MAYOR  
CITY OF LUCAS, TEXAS

8-28-01  
DATE


"ATTEST"

Ruth Wilkison  
CITY SECRETARY  
CITY OF LUCAS, TEXAS

8/28/01  
DATE






Filed for Record in:  
Collin County, McKinney TX  
Honorable Helen Starnes  
Collin County Clerk  
On Sep 12 2001  
At 9:41am  
Doc/Num : 2001- 0114857  
Recording/Type: PL 36.00  
Receipt #: 38000

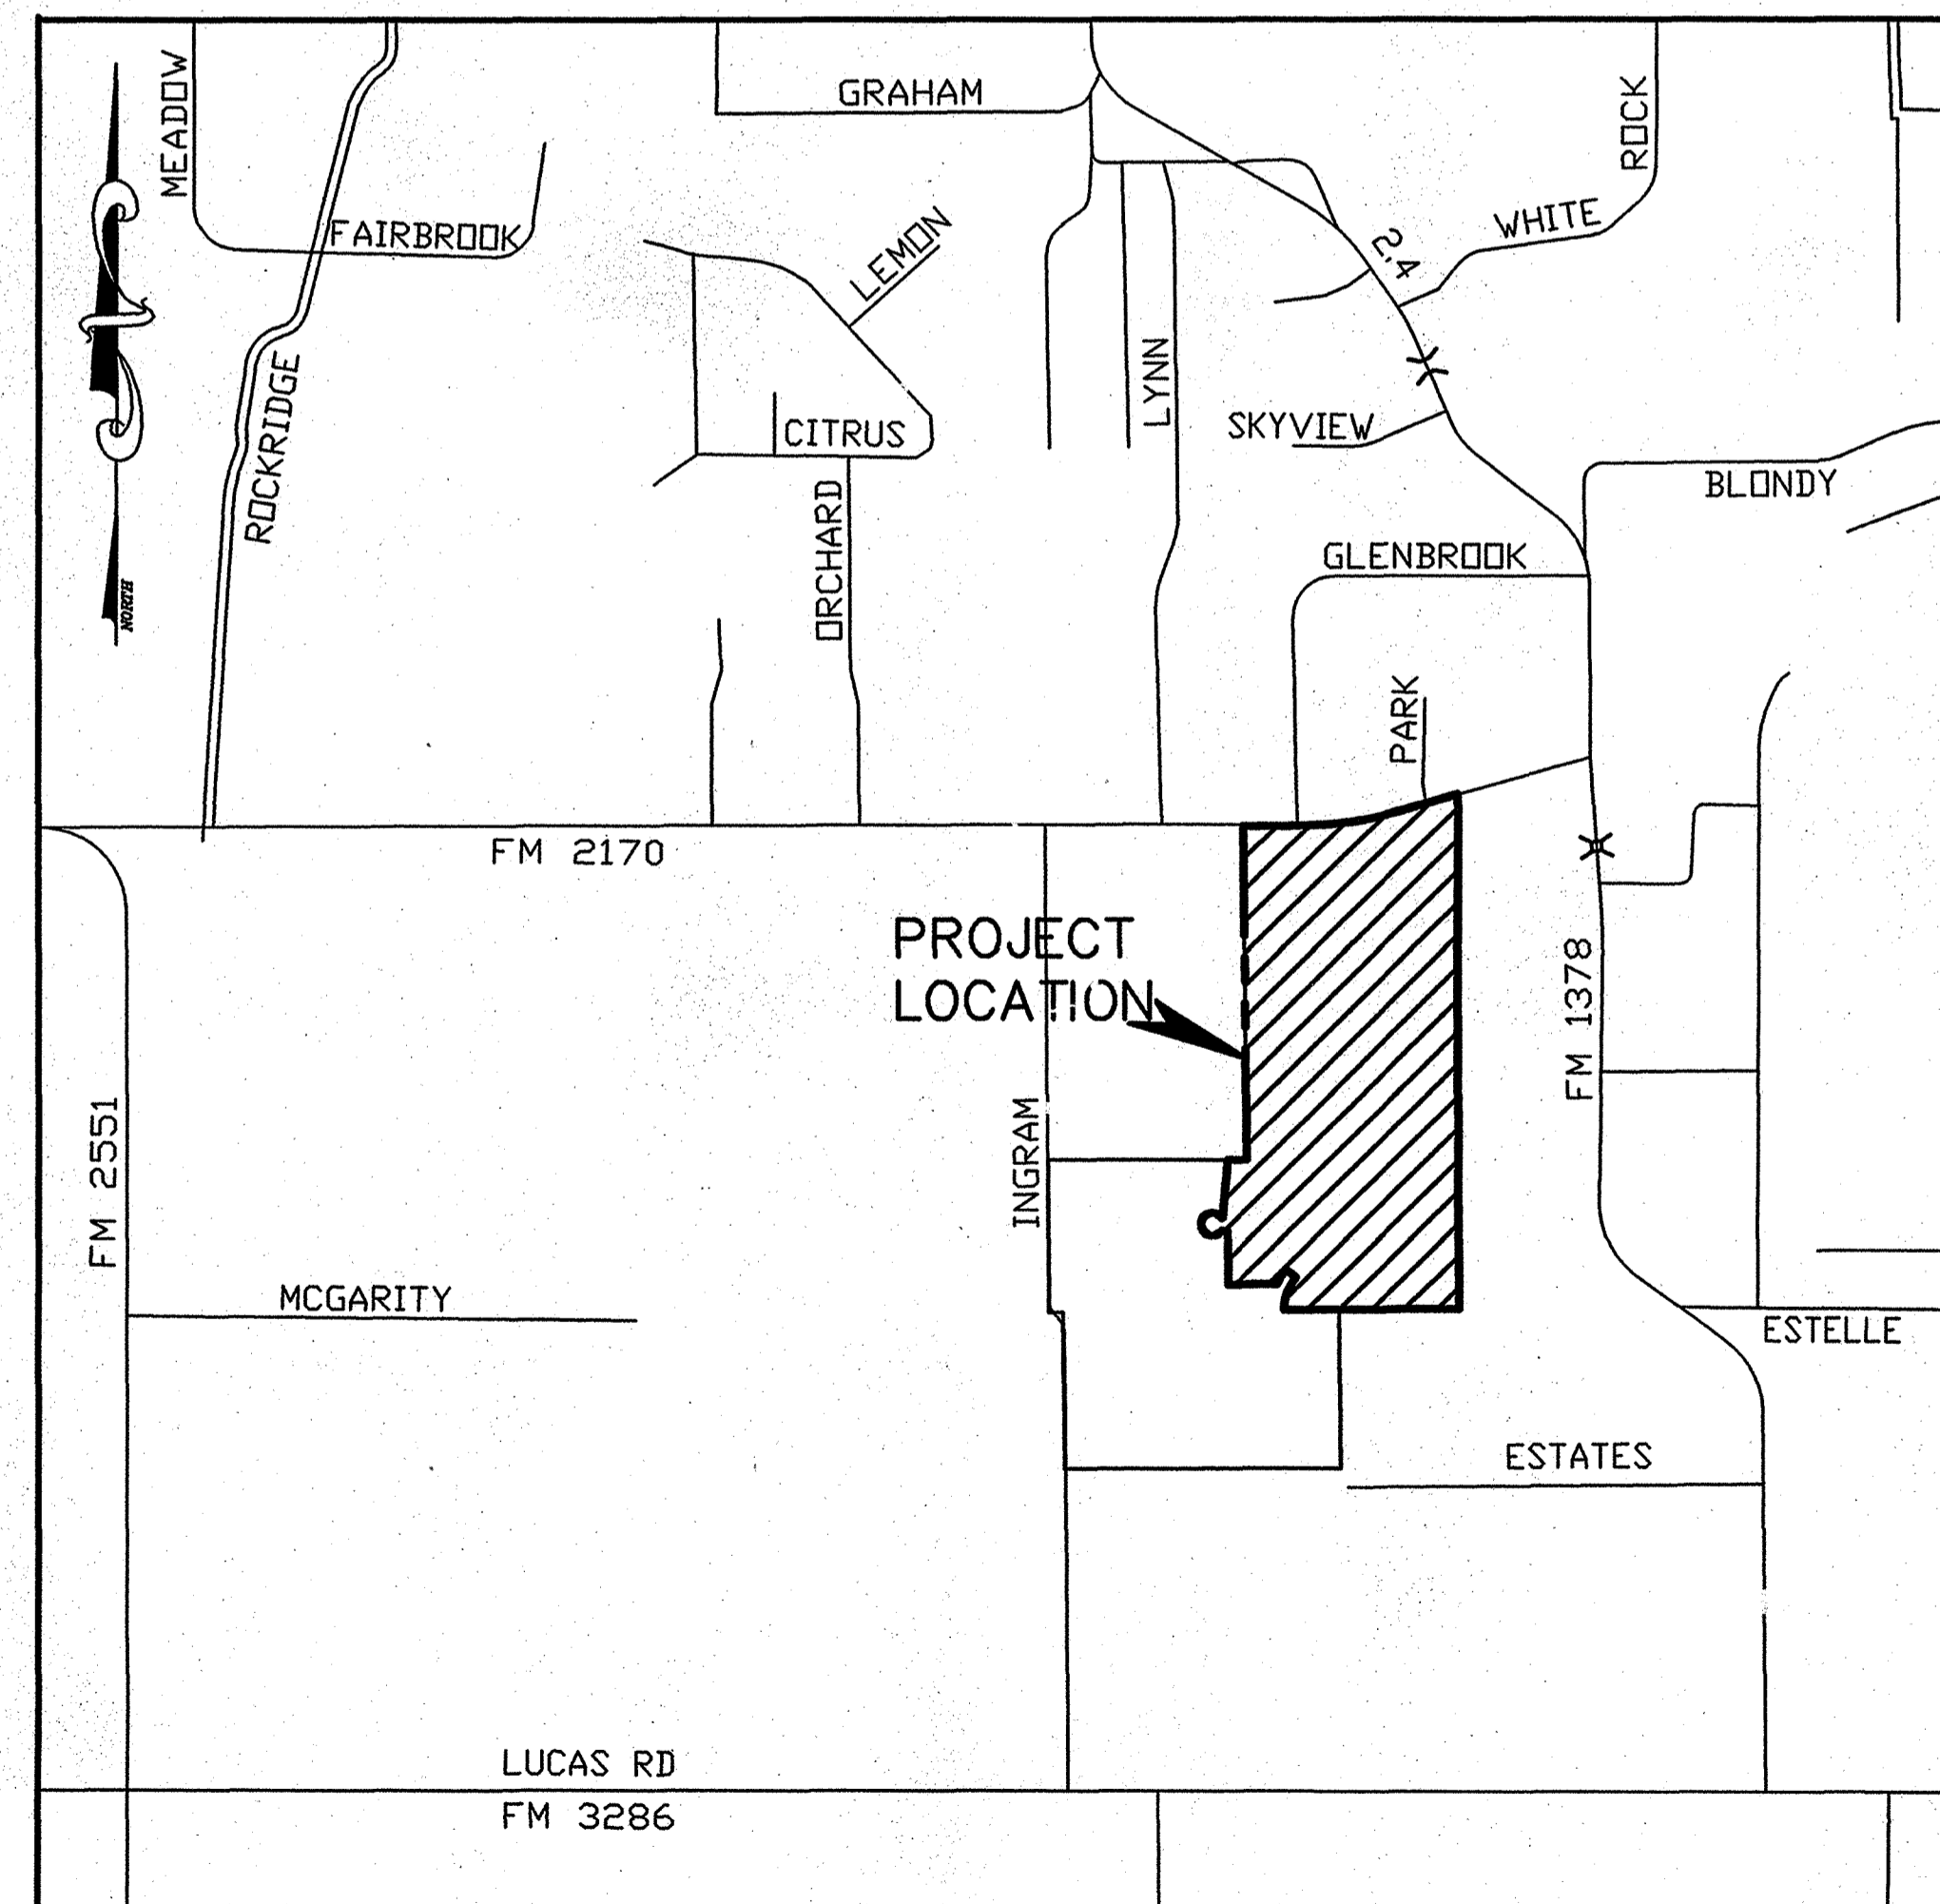

LOCATION MAP  
1" = 1000'

FINAL PLAT  
SADDLEBROOK ESTATES, PHASE I  
73.565 ACRES OUT OF  
J. GRAYUM SURVEY, ABSTRACT NO. 354  
J. SNIDER SURVEY, ABSTRACT NO. 824  
CITY OF LUCAS  
COLLIN COUNTY, TEXAS


SADDLEBROOK ESTATES, LTD. OWNER  
c/o The Skorburg Company (214) 522-1945  
Two Turtle Creek  
3838 Oak Lawn Ave., suite 1212  
Dallas, Texas 75219  
JONES & BOYD, INC. SURVEYOR/ENGINEER  
16800 Dallas Parkway, Suite 240 (972)248-7676  
Dallas, Texas 75248

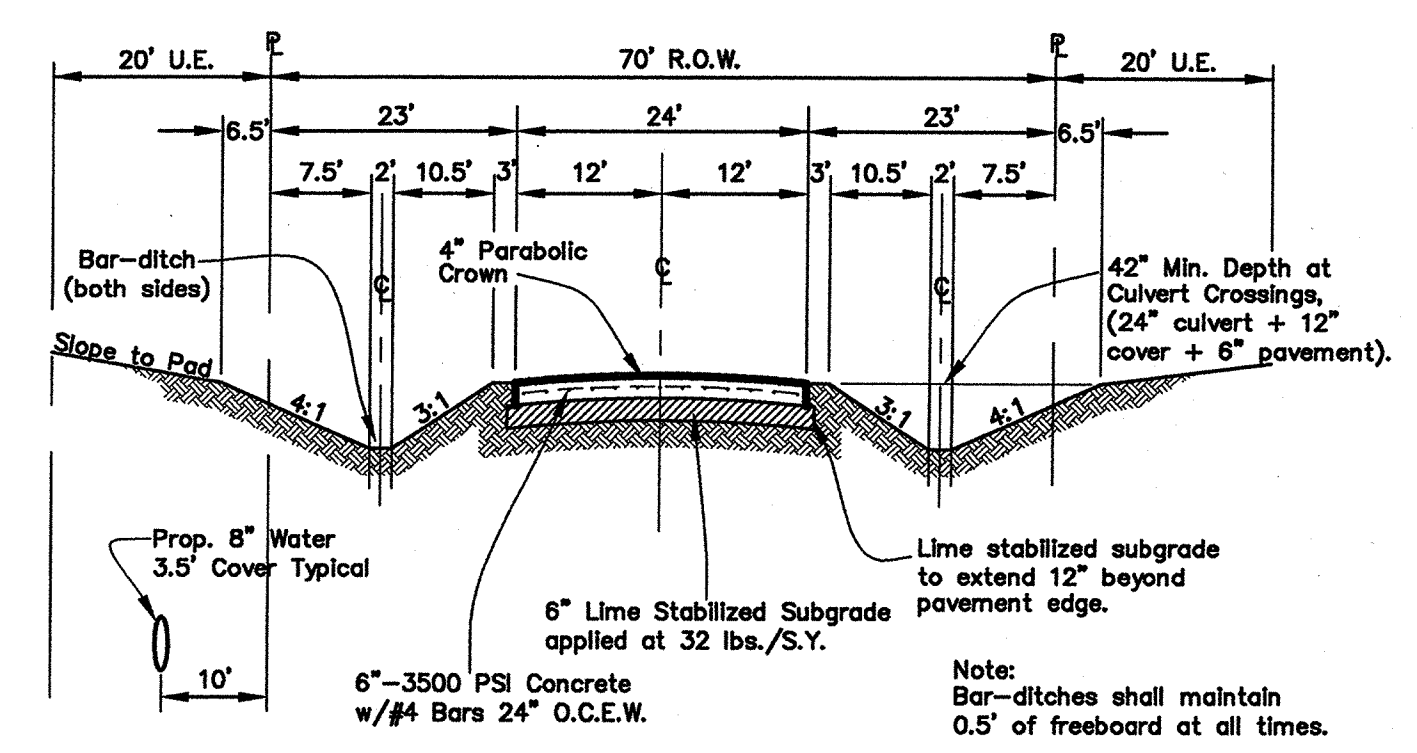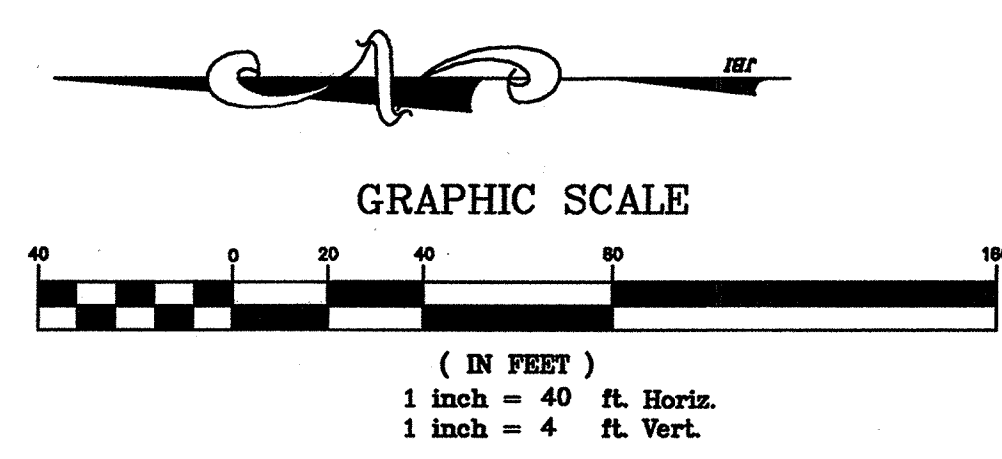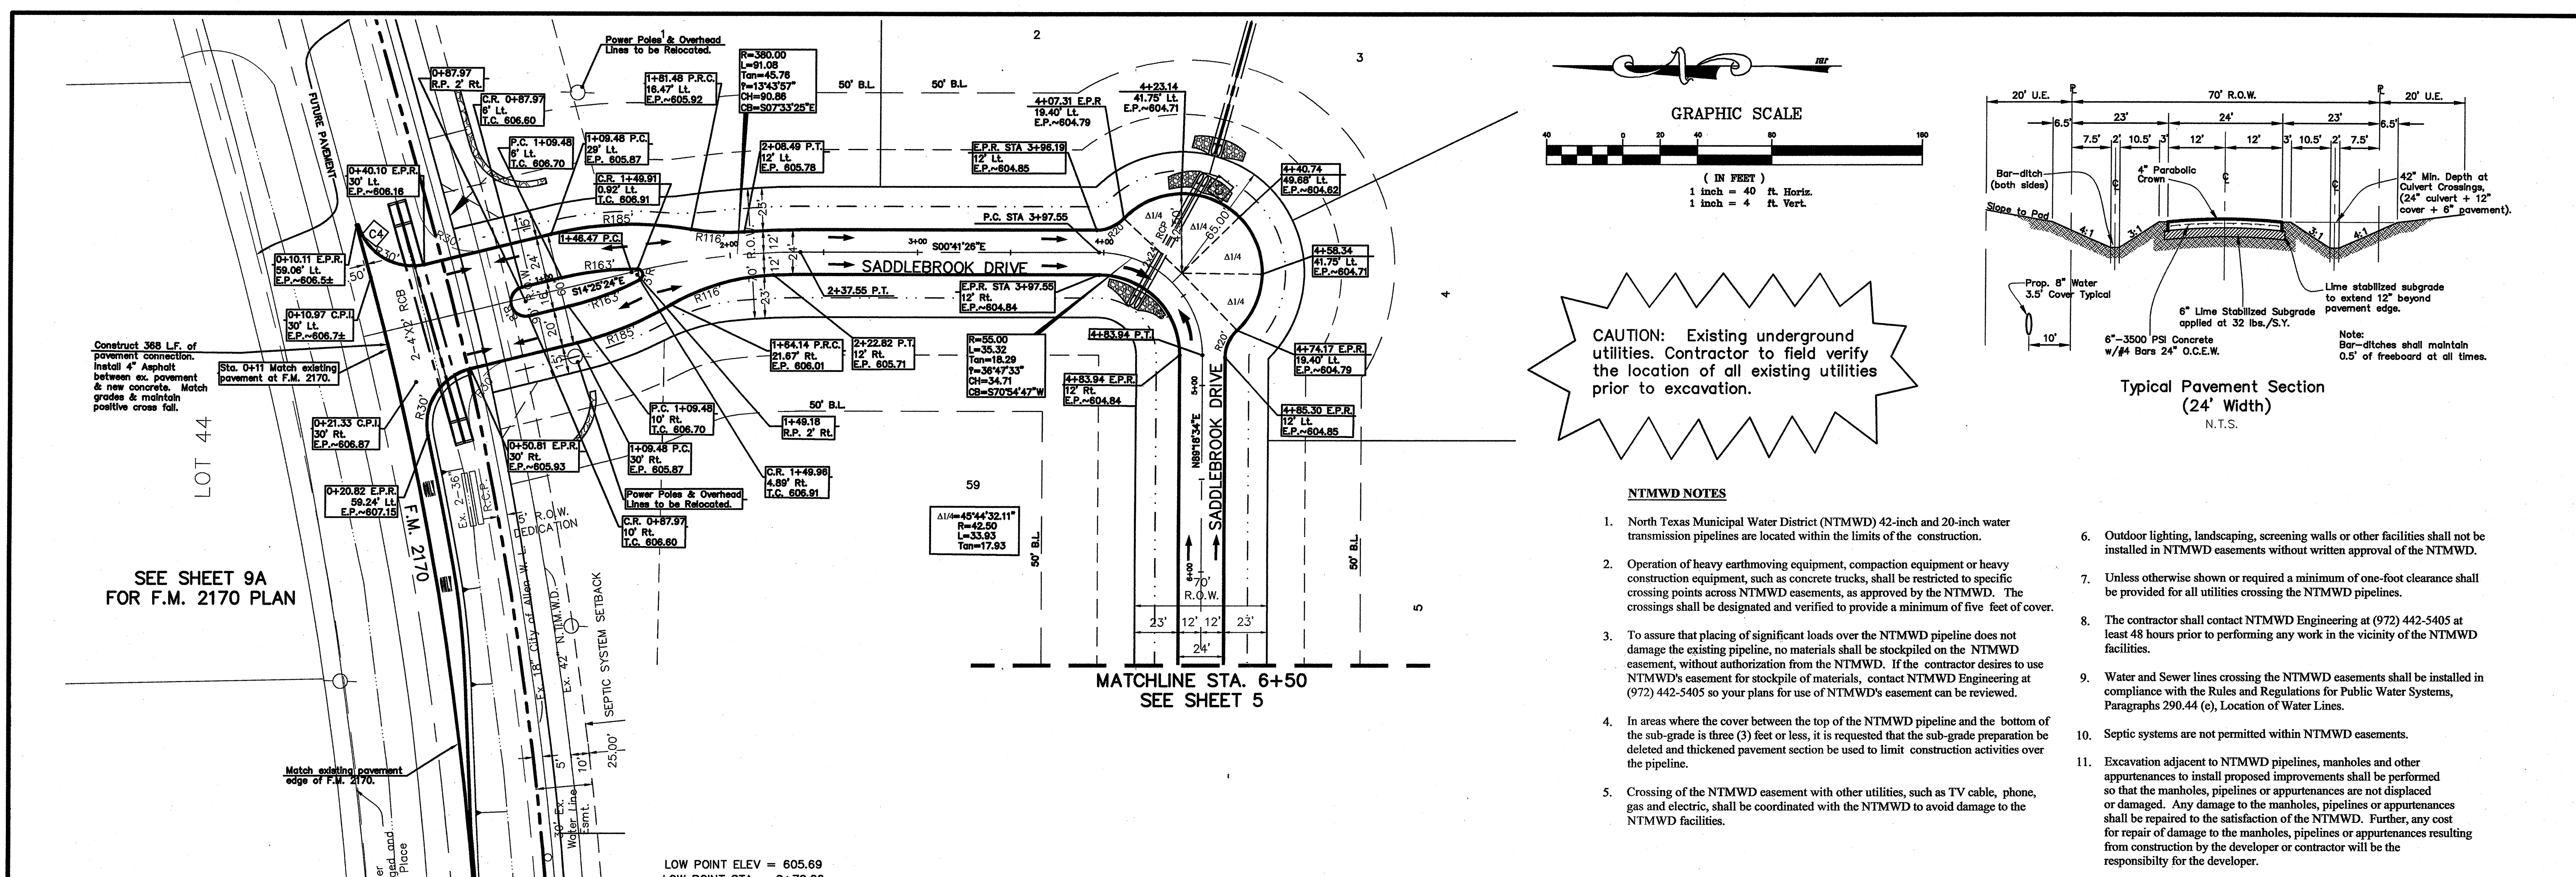

**CAUTION:** Existing underground utilities. Contractor to field verify the location of all existing utilities prior to excavation.

**NTMWD NOTES**

- North Texas Municipal Water District (NTMWD) 42-inch and 20-inch water transmission pipelines are located within the limits of the construction.
- Operation of heavy earthmoving equipment, compaction equipment or heavy construction equipment, such as concrete trucks, shall be restricted to specific crossing points across NTMWD easements, as approved by the NTMWD. The crossings shall be designated and verified to provide a minimum of five feet of cover.
- To assure that placing of significant loads over the NTMWD pipeline does not damage the existing pipeline, no materials shall be stockpiled on the NTMWD easement, without authorization from the NTMWD. If the contractor desires to use NTMWD's easement for stockpile of materials, contact NTMWD Engineering at (972) 442-5405 so your plans for use of NTMWD's easement can be reviewed.
- In areas where the cover between the top of the NTMWD pipeline and the bottom of the sub-grade is three (3) feet or less, it is requested that the sub-grade preparation be deleted and thickened pavement section be used to limit construction activities over the pipeline.
- Crossing of the NTMWD easement with other utilities, such as TV cable, phone, gas and electric, shall be coordinated with the NTMWD to avoid damage to the NTMWD facilities.
- Outdoor lighting, landscaping, screening walls or other facilities shall not be installed in NTMWD easements without written approval of the NTMWD.
- Unless otherwise shown or required a minimum of one-foot clearance shall be provided for all utilities crossing the NTMWD pipelines.
- The contractor shall contact NTMWD Engineering at (972) 442-5405 at least 48 hours prior to performing any work in the vicinity of the NTMWD facilities.
- Water and Sewer lines crossing the NTMWD easements shall be installed in compliance with the Rules and Regulations for Public Water Systems, Paragraphs 290.44 (e), Location of Water Lines.
- Septic systems are not permitted within NTMWD easements.
- Excavation adjacent to NTMWD pipelines, manholes and other appurtenances to install proposed improvements shall be performed so that the manholes, pipelines or appurtenances are not displaced or damaged. Any damage to the manholes, pipelines or appurtenances shall be repaired to the satisfaction of the NTMWD. Further, any cost for repair of damage to the manholes, pipelines or appurtenances resulting from construction by the developer or contractor will be the responsibility for the developer.

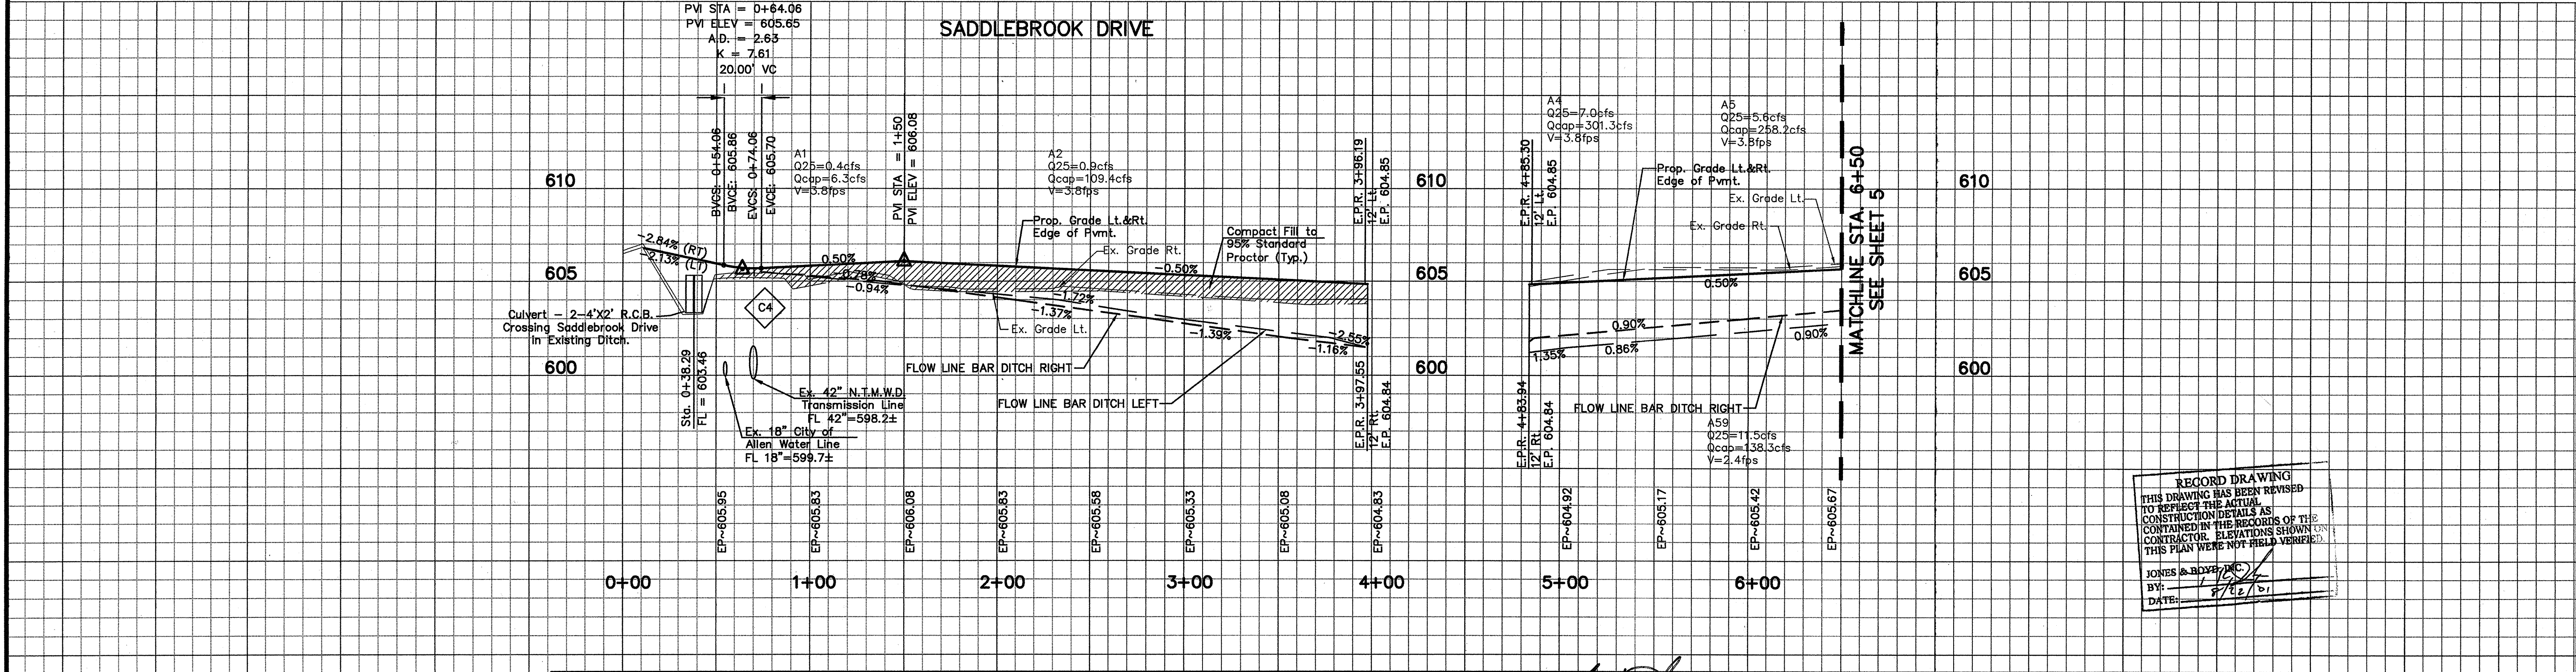

**BENCHMARKS:**

- 1/2" IR, W of Ingram Rd. +- 1025' N of N edge of Lucas Rd. +- 6' E of fence. Elev. 637.08
- 1/2" IR, E of Ingram Rd. +- 2650' N of N edge of Lucas Rd. +- 28' E & 37' N of fence corner. Elev. 639.20

NO.	REVISIONS DURING CONSTRUCTION	BY	DATE	NO.	REVISIONS DURING PLAN REVIEW	BY	DATE
1	Revise entrance pavement for Saddlebrook Drive.	JMW	2/14/01	1	Cont. Saddlebrook through site. Adjust stationing.	JMW	12/05/00
2				2	Add Right Turn Lane & Revise Culvert.	CMG	12/19/00
3				3	Added to NTMWD NOTES & EXISTING W.L. TO PROFILE	CMG	01/08/01
4				4	Revised Per City Comments	SSC	12/22/00

The seal appearing on this document was authorized by Thomas K. Juhn, P.E. 81799 on Feb. 14, 2001. Alteration of a sealed document without proper notification to the responsible engineer is an offense under the Texas Engineering Practice Act.


**Jones & Boyd, Inc.**  
 16800 Dallas Parkway, Suite 240  
 Dallas, Texas 75248  
 Tel: 972-248-7676  
 Fax: 972-248-1414

**PAVING PLAN & PROFILE**  
**SADDLEBROOK DRIVE (0+00 to 6+50)**  
**SADDLEBROOK**  
 City of Lucas, Collin County, Texas


PROJECT NO. SK403  
 SHEET NO. 4

Plot Info: Drawing: H:\Projects\SK403.dwg SK403P.dwg 2/7/01 10:49 am Plotted By: JMW Plot date: 2/6/01 Plot time: 11:06 am

SEE SHEET 4  
MATCHLINE STA. 6+50

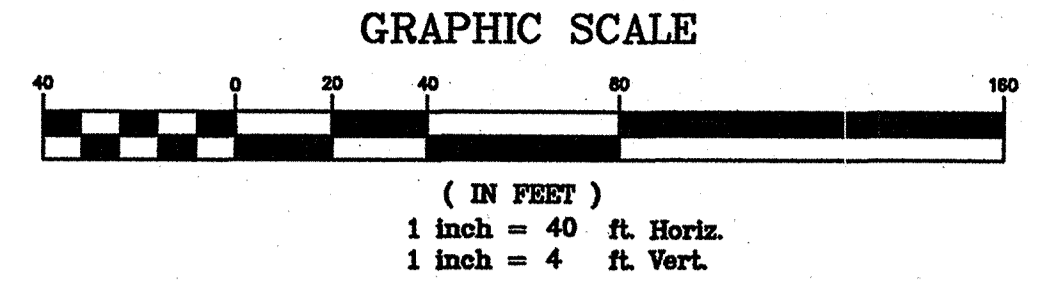


**CAUTION:** Existing underground utilities. Contractor to field verify the location of all existing utilities prior to excavation.

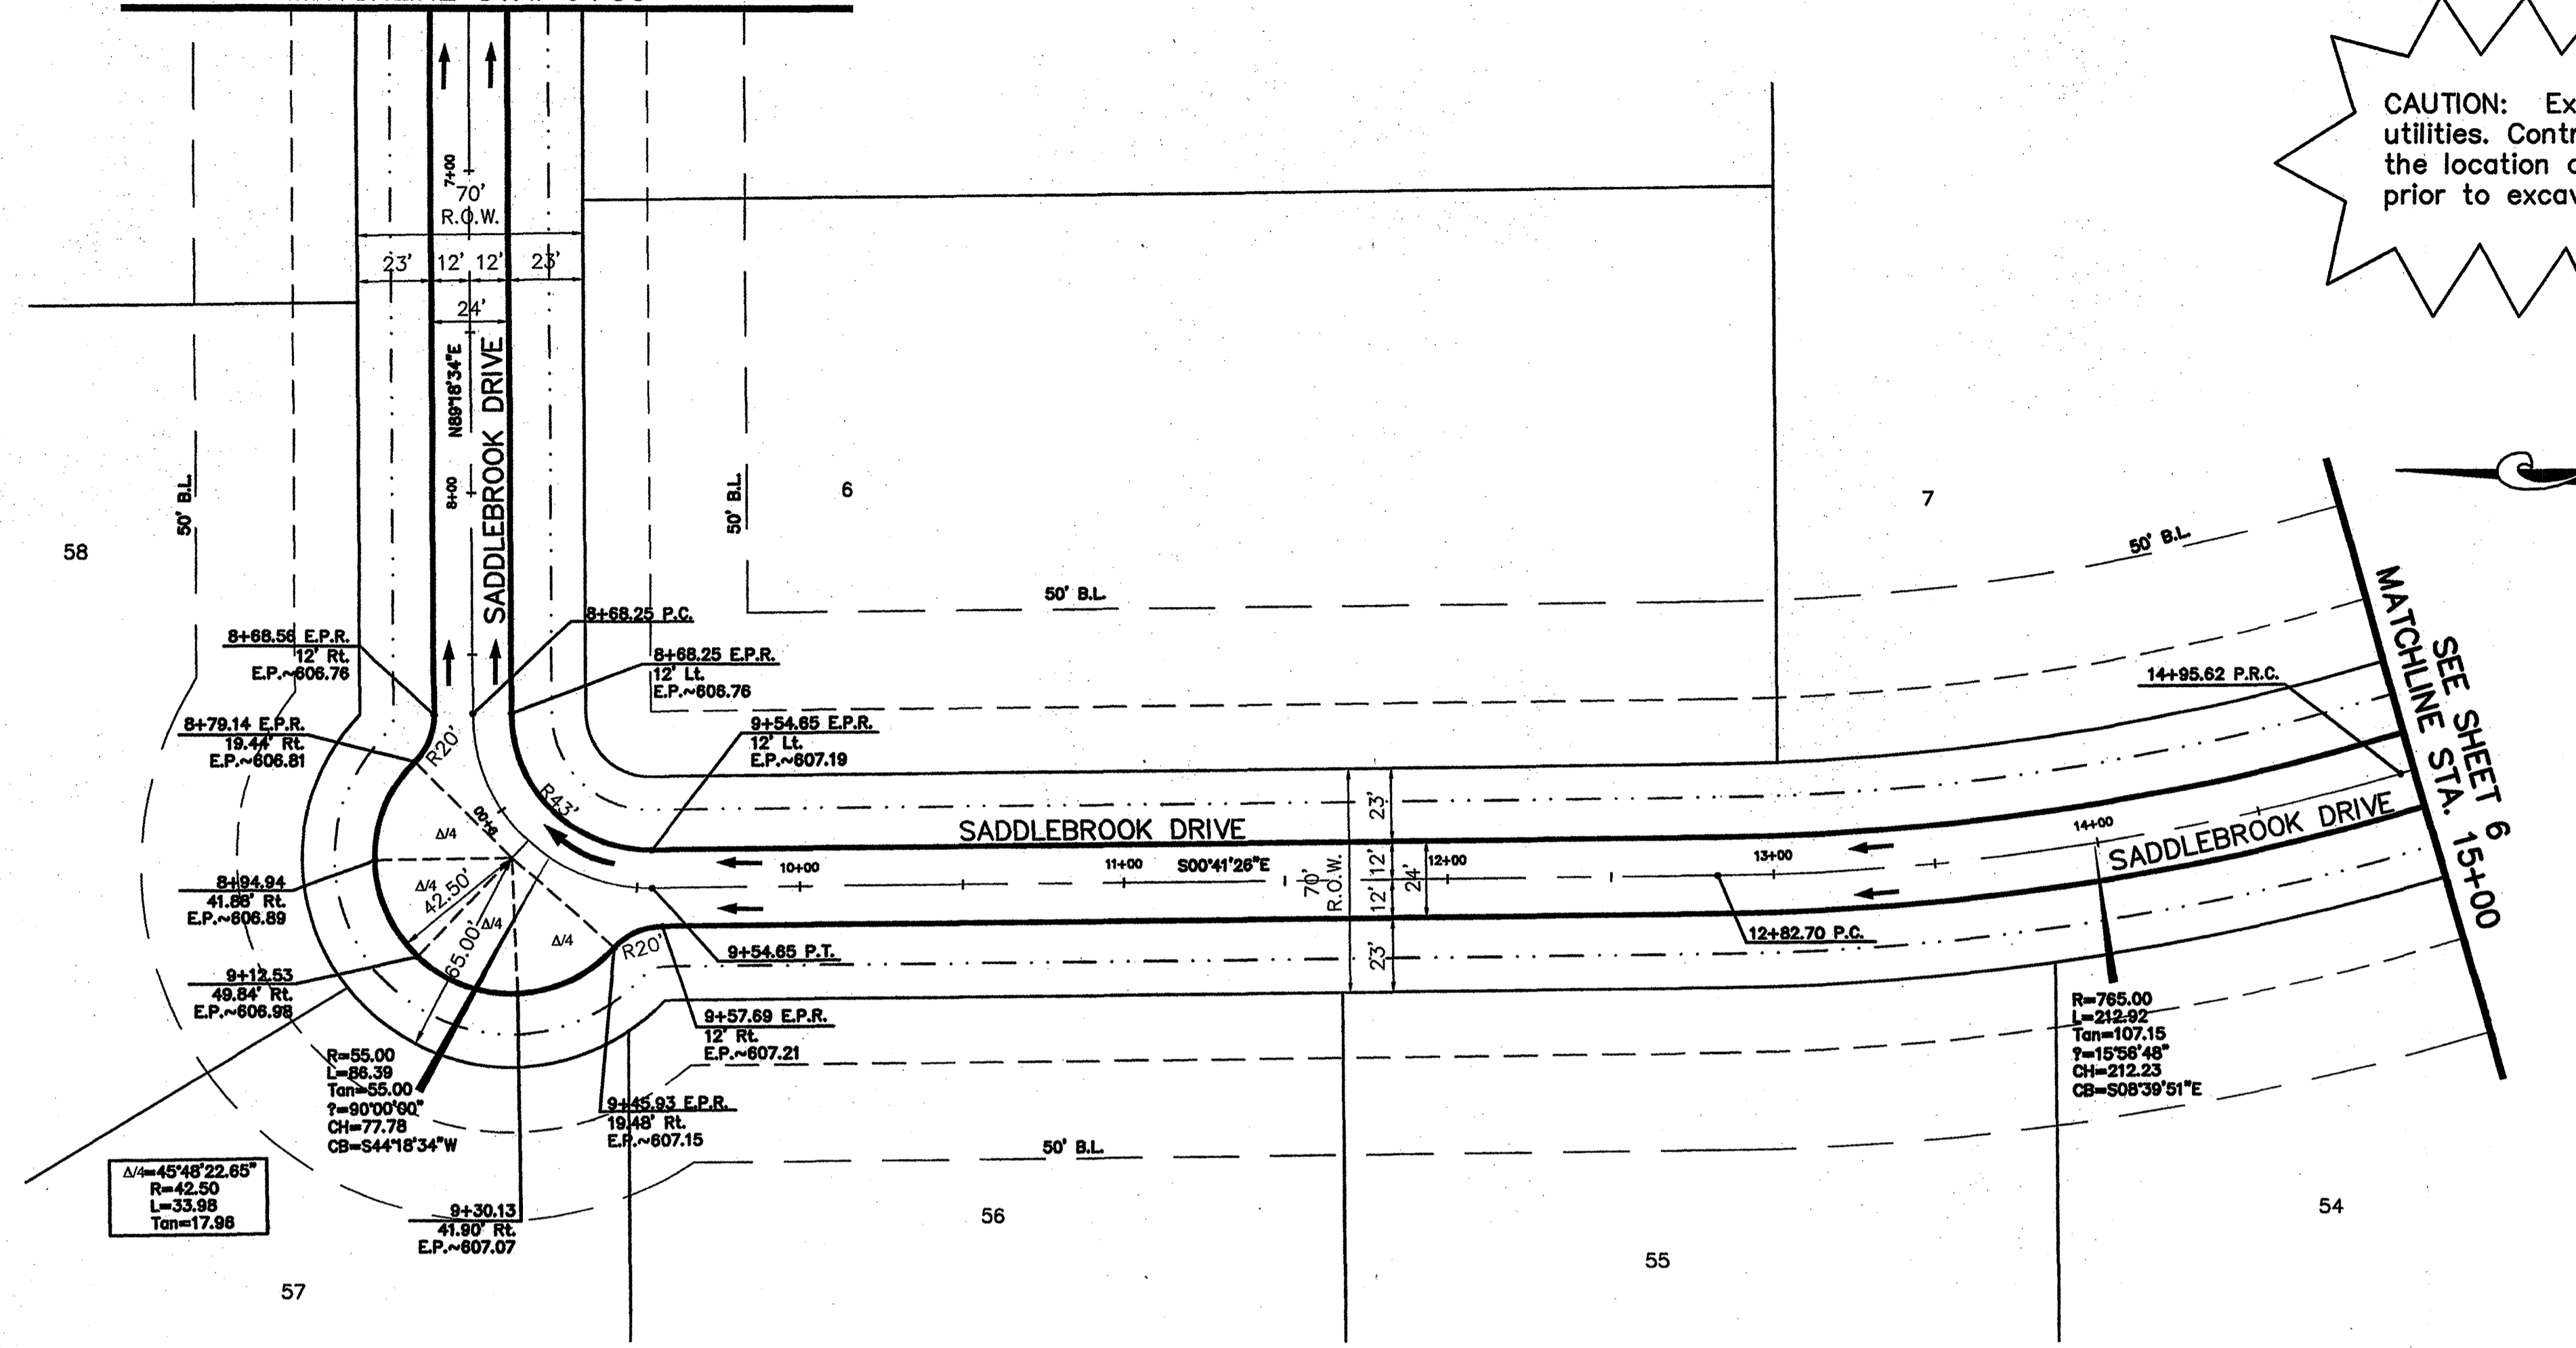

- NTMWD NOTES**
- North Texas Municipal Water District (NTMWD) 42-inch and 20-inch water transmission pipelines are located within the limits of the construction.
  - Operation of heavy earthmoving equipment, compaction equipment or heavy construction equipment, such as concrete trucks, shall be restricted to specific crossing points across NTMWD easements, as approved by the NTMWD. The crossings shall be designated and verified to provide a minimum of five feet of cover.
  - To assure that placing of significant loads over the NTMWD pipeline does not damage the existing pipeline, no materials shall be stockpiled on the NTMWD easement without authorization from the NTMWD. If the contractor desires to use NTMWD's easement for stockpile of materials, contact NTMWD Engineering at (972) 442-5405 so your plans for use of NTMWD's easement can be reviewed.
  - In areas where the cover between the top of the NTMWD pipeline and the bottom of the sub-grade is three (3) feet or less, it is requested that the sub-grade preparation be deleted and thickened pavement section be used to limit construction activities over the pipeline.
  - Crossing of the NTMWD easement with other utilities, such as TV cable, phone, gas and electric, shall be coordinated with the NTMWD to avoid damage to the NTMWD facilities.
  - Outdoor lighting, landscaping, screening walls or other facilities shall not be installed in NTMWD easements without written approval of the NTMWD.
  - Unless otherwise shown or required a minimum of one-foot clearance shall be provided for all utilities crossing the NTMWD pipelines.
  - The contractor shall contact NTMWD Engineering at (972) 442-5405 at least 48 hours prior to performing any work in the vicinity of the NTMWD facilities.
  - Water and Sewer lines crossing the NTMWD easements shall be installed in compliance with the Rules and Regulations for Public Water Systems, Paragraphs 290.44 (e), Location of Water Lines.
  - Septic systems are not permitted within NTMWD easements.
  - Excavation adjacent to NTMWD pipelines, manholes and other appurtenances to install proposed improvements shall be performed so that the manholes, pipelines or appurtenances are not displaced or damaged. Any damage to the manholes, pipelines or appurtenances shall be repaired to the satisfaction of the NTMWD. Further, any cost for repair of damage to the manholes, pipelines or appurtenances resulting from construction by the developer or contractor will be the responsibility for the developer.

SADDLEBROOK DRIVE

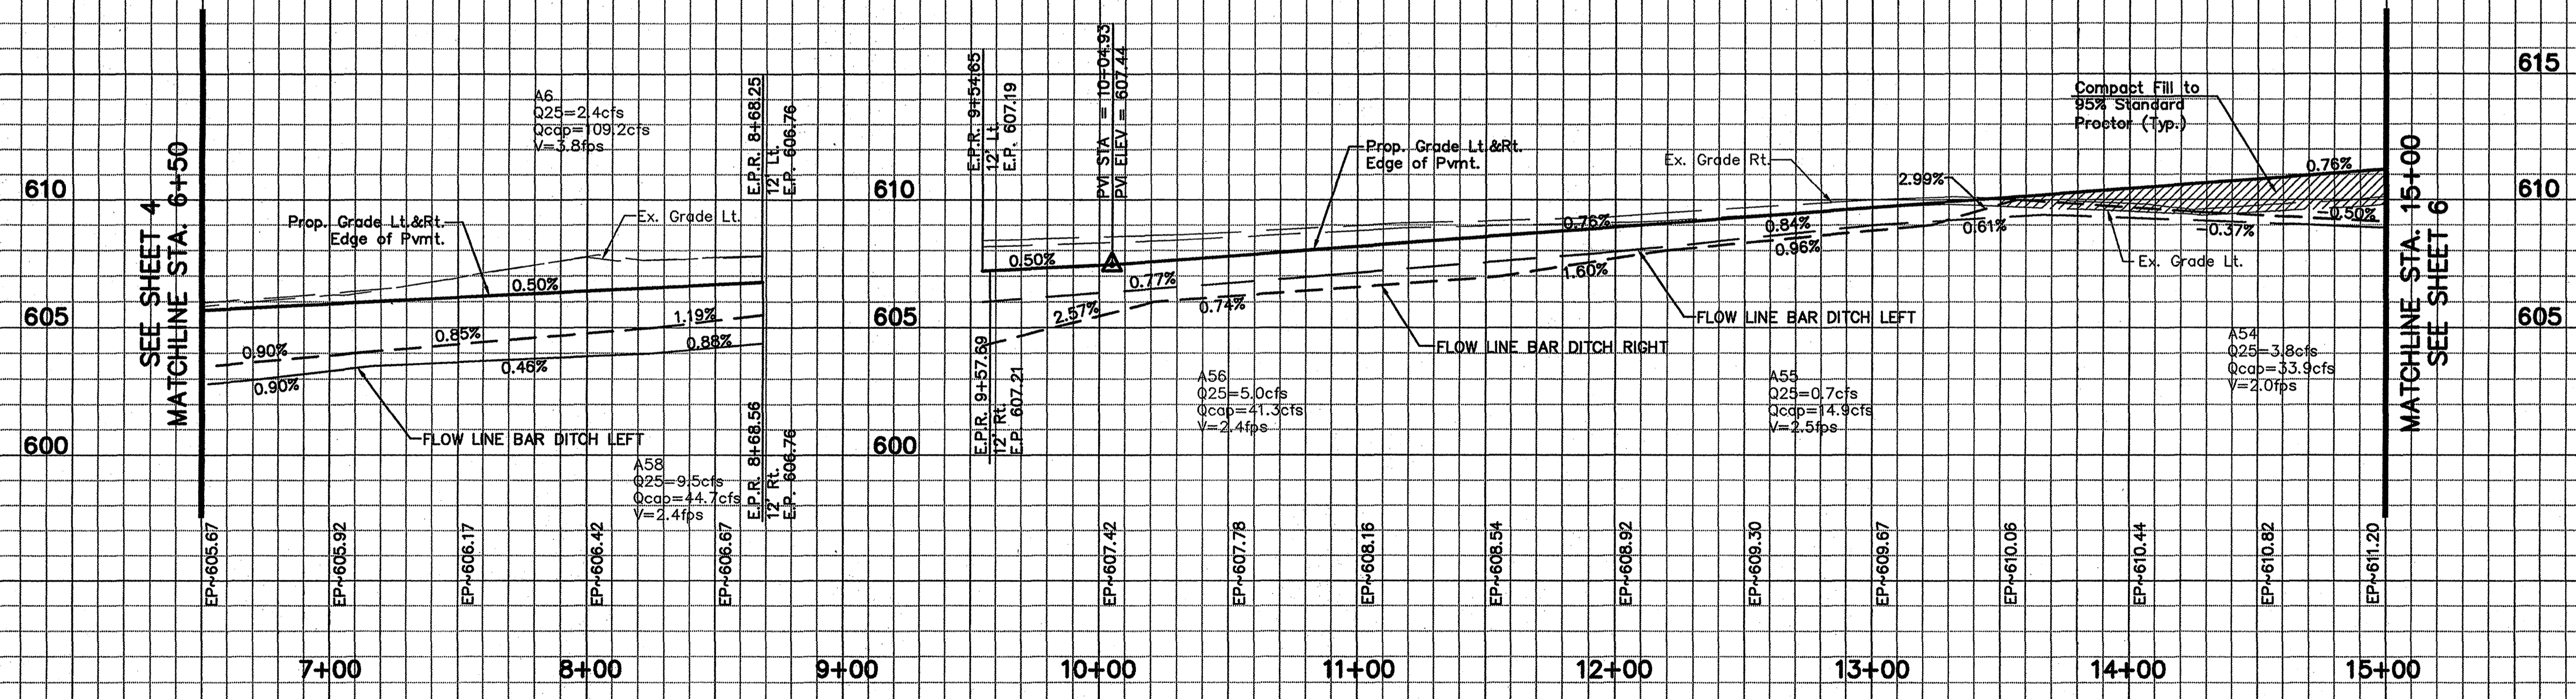


RECORD DRAWING  
THIS DRAWING HAS BEEN REVISED TO REFLECT THE ACTUAL CONSTRUCTION DETAILS AS CONTAINED IN THE RECORDS OF THE CONTRACTOR. REVISIONS SHOWN ON THIS PLAN WERE NOT FIELD VERIFIED.  
JONES & BOYD, INC.  
BY: [Signature]  
DATE: 8/12/04

- BENCHMARKS:**
- "T" 1/2" IR, W of Ingram Rd. +- 1025' N of N edge of Lucas Rd. +- 5' E of fence. Elev. 637.08
  - "T" 1/2" IR, E of Ingram Rd. +- 2650' N of N edge of Lucas Rd. +- 28' E & 37' N of fence corner. Elev. 639.20

NO.	REVISIONS DURING CONSTRUCTION	BY	DATE	NO.	REVISIONS DURING PLAN REVIEW	BY	DATE
				2	ADDED NOTES TO NTMWD NOTES	CMG	01/08/04
				1	Cont. Saddlebrook through site. Adjust stationing.	JMW	12/05/00

The seal appearing on this document was authorized by Thomas K. Juhn, P.E. 81799 on Jan. 08, 2001. Alteration of a sealed document without proper notification to the responsible engineer is an offense under the Texas Engineering Practice Act.

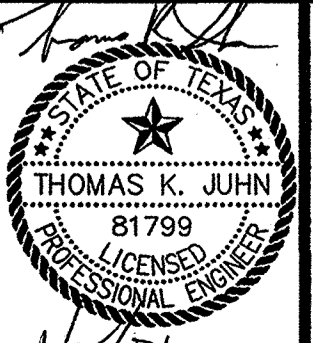


**Jones & Boyd, Inc.**  
16800 Dallas Parkway, Suite 240  
Dallas, Texas 75248  
Tel: 972-248-7676  
Fax: 972-248-1414

**PAVING PLAN & PROFILE**  
**SADDLEBROOK DRIVE (6+50 to 15+00)**  
**SADDLEBROOK**  
City of Lucas, Collin County, Texas

PROJECT NO. SK403  
SHEET NO. 5

Plot time: 12:08 pm  
Plotted by: to  
Drawing: H:\Projects\SK403\dwg\SK403PV.dwg  
12/18/00 1:17 pm


GRAPHIC SCALE

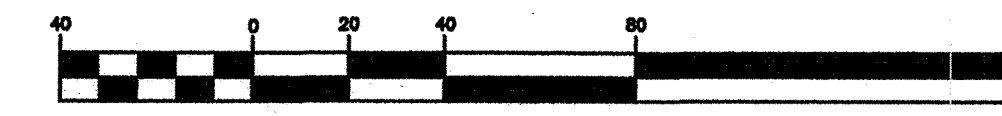

CAUTION: Existing underground utilities. Contractor to field verify the location of all existing utilities prior to excavation.

SEE SHEET 7  
MATCHLINE STA 25+00


SEE SHEET 9

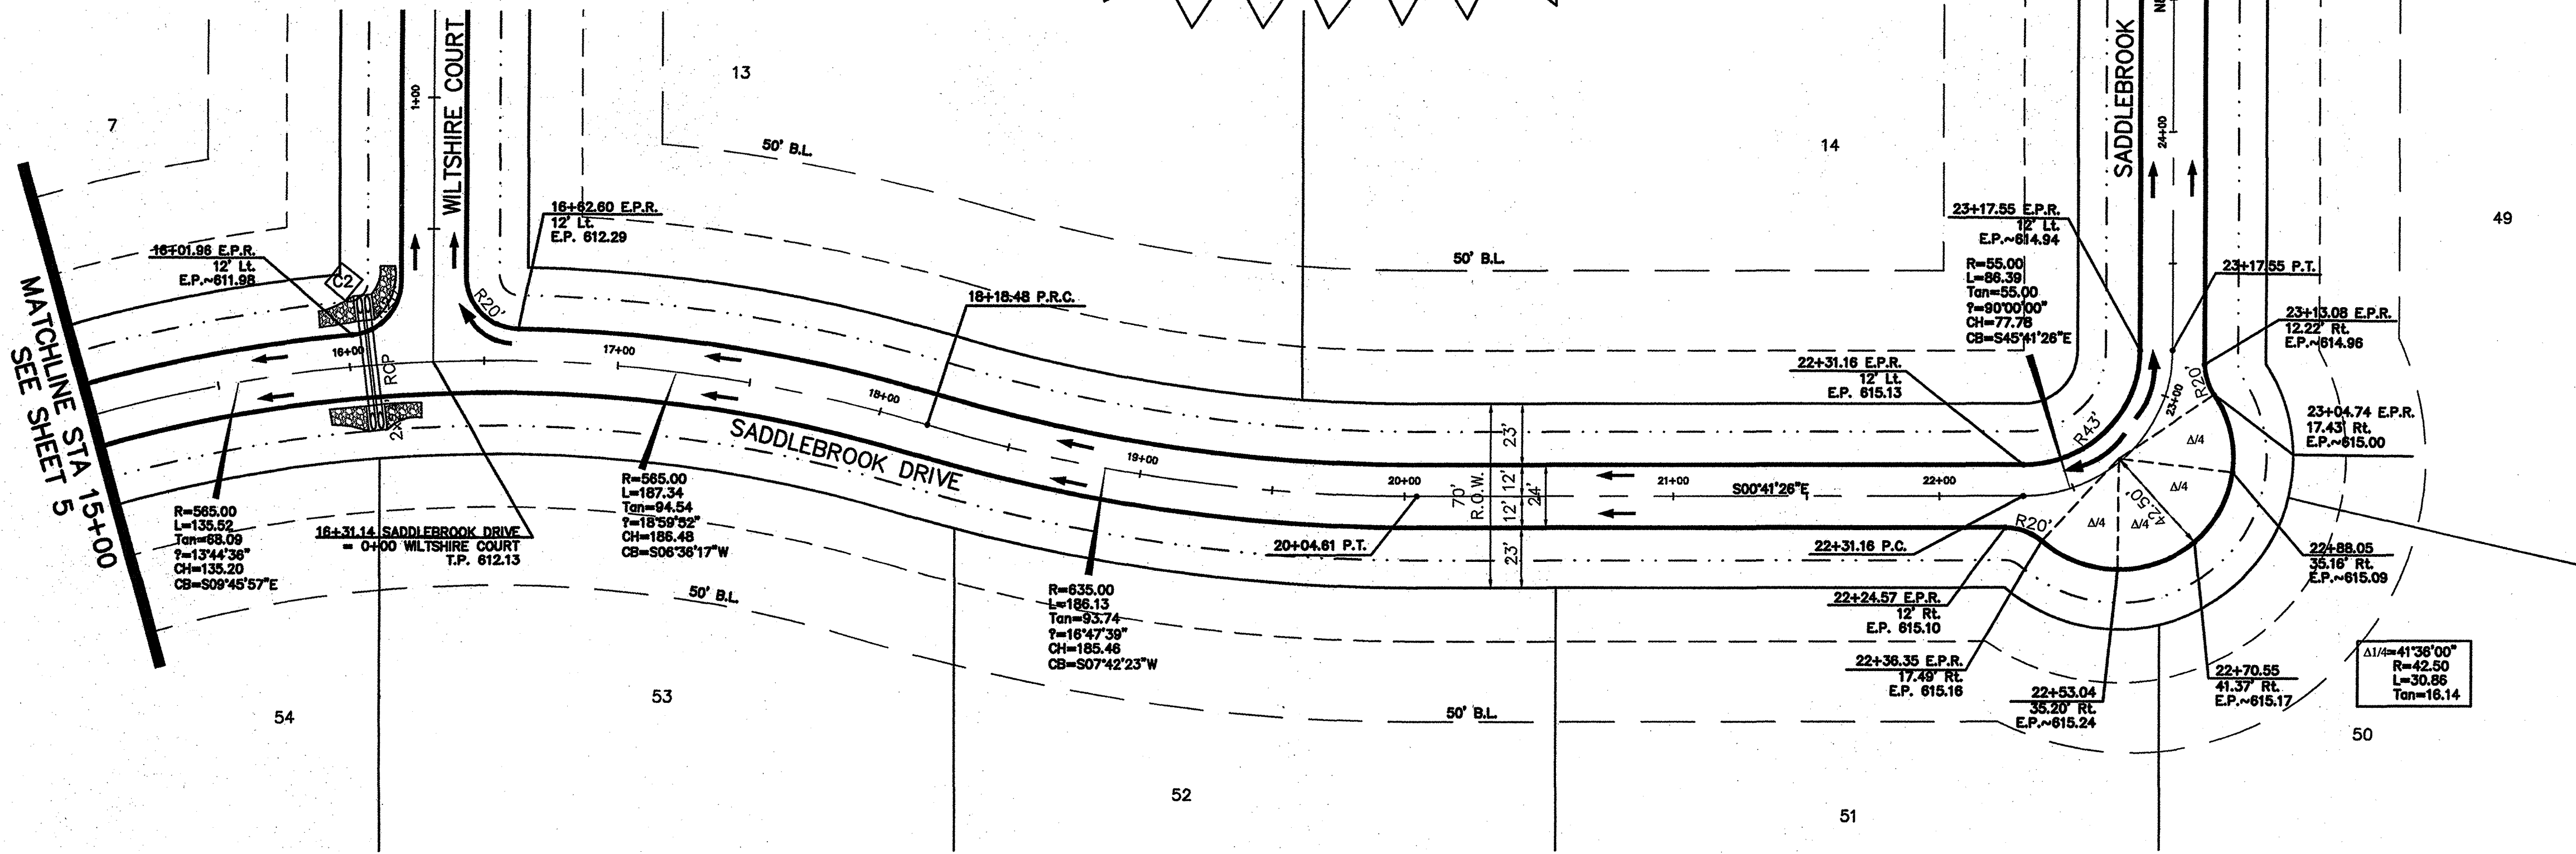

NTMWD NOTES

- North Texas Municipal Water District (NTMWD) 42-inch and 20-inch water transmission pipelines are located within the limits of the construction.
- Operation of heavy earthmoving equipment, compaction equipment or heavy construction equipment, such as concrete trucks, shall be restricted to specific crossing points across NTMWD easements, as approved by the NTMWD. The crossings shall be designated and verified to provide a minimum of five feet of cover.
- To assure that placing of significant loads over the NTMWD pipeline does not damage the existing pipeline, no materials shall be stockpiled on the NTMWD easement, without authorization from the NTMWD. If the contractor desires to use NTMWD's easement for stockpile of materials, contact NTMWD Engineering at (972) 442-5405 so your plans for use of NTMWD's easement can be reviewed.
- In areas where the cover between the top of the NTMWD pipeline and the bottom of the sub-grade is three (3) feet or less, it is requested that the sub-grade preparation be deleted and thickened pavement section be used to limit construction activities over the pipeline.
- Crossing of the NTMWD easement with other utilities, such as TV cable, phone, gas and electric, shall be coordinated with the NTMWD to avoid damage to the NTMWD facilities.
- Outdoor lighting, landscaping, screening walls or other facilities shall not be installed in NTMWD easements without written approval of the NTMWD.
- Unless otherwise shown or required a minimum of one-foot clearance shall be provided for all utilities crossing the NTMWD pipelines.
- The contractor shall contact NTMWD Engineering at (972) 442-5405 at least 48 hours prior to performing any work in the vicinity of the NTMWD facilities.
- Water and Sewer lines crossing the NTMWD easements shall be installed in compliance with the Rules and Regulations for Public Water Systems, Paragraphs 290.44 (e), Location of Water Lines.
- Septic systems are not permitted within NTMWD easements.
- Excavation adjacent to NTMWD pipelines, manholes and other appurtenances to install proposed improvements shall be performed so that the manholes, pipelines or appurtenances are not displaced or damaged. Any damage to the manholes, pipelines or appurtenances shall be repaired to the satisfaction of the NTMWD. Further, any cost for repair of damage to the manholes, pipelines or appurtenances resulting from construction by the developer or contractor will be the responsibility for the developer.

SADDLEBROOK DRIVE

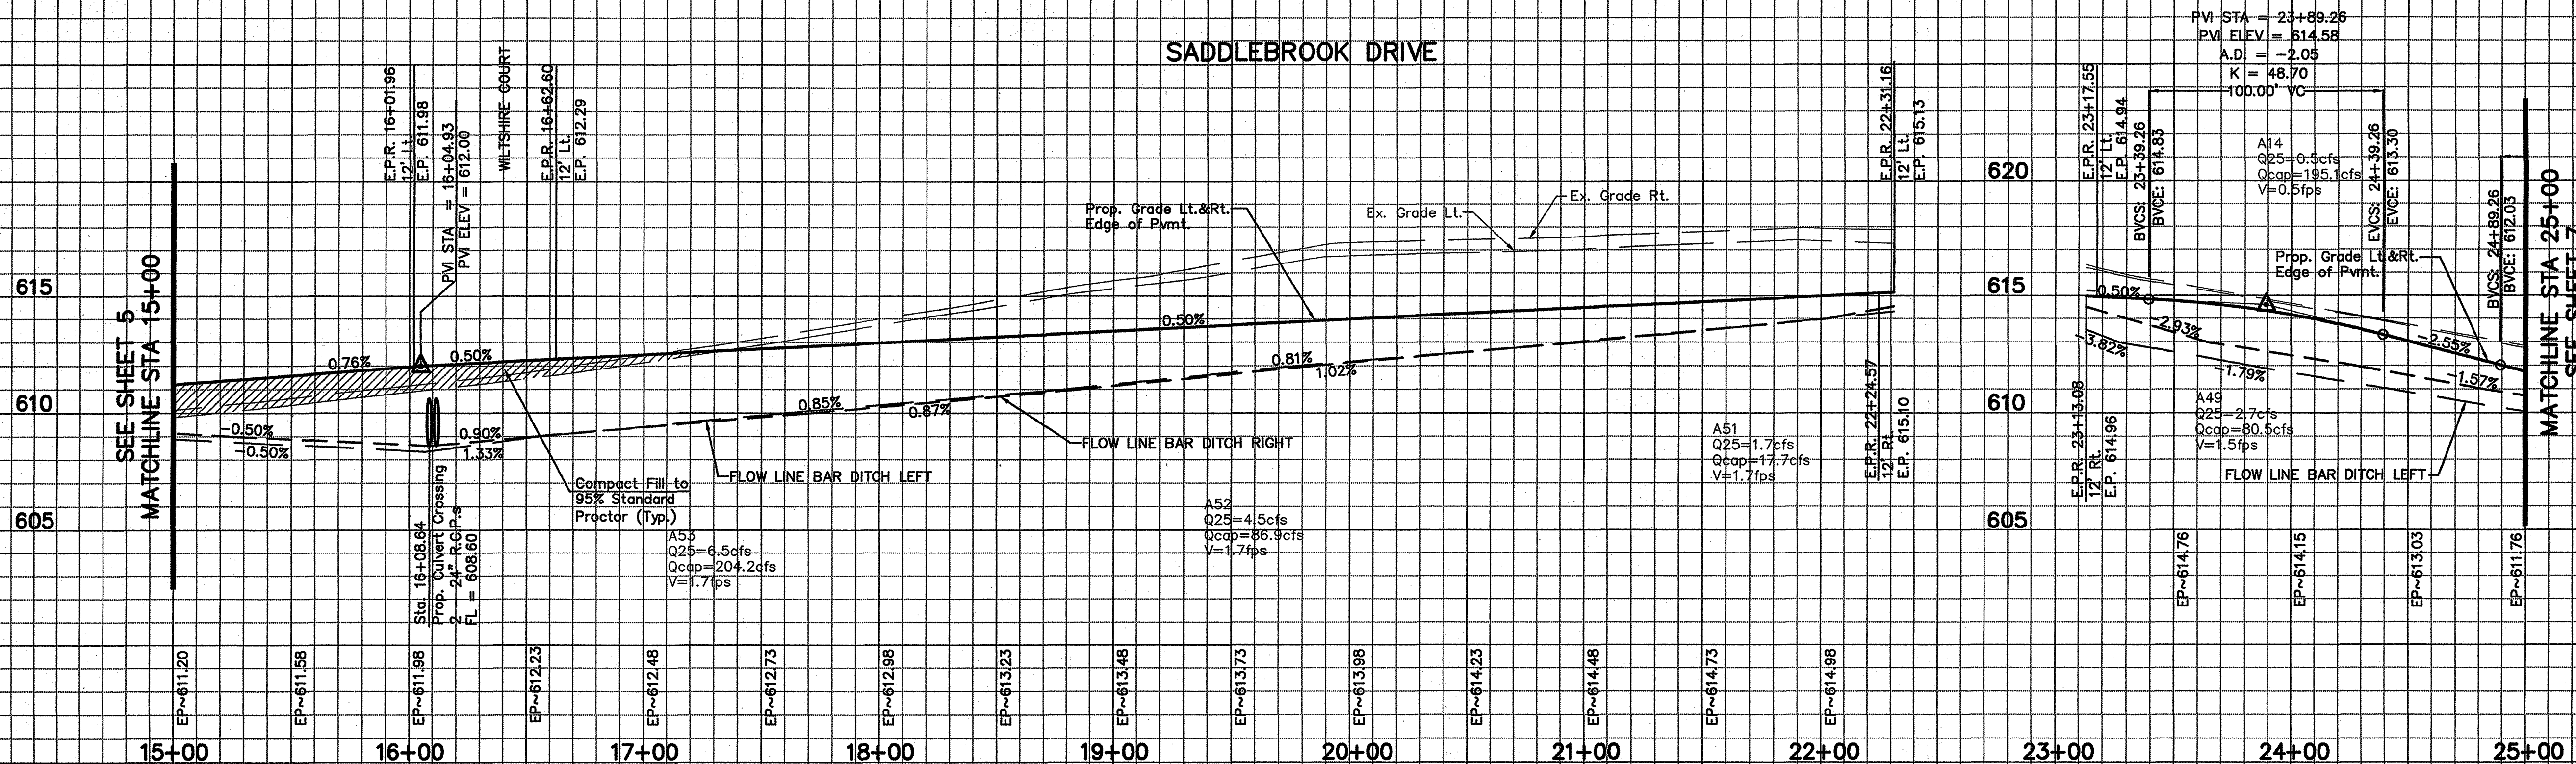


RECORD DRAWING  
THIS DRAWING HAS BEEN REVISED TO REFLECT THE ACTUAL CONSTRUCTION DETAILS AS CONTAINED IN THE RECORDS OF THE CONTRACTOR. ELEVATIONS SHOWN ON THIS PLAN WERE NOT FIELD VERIFIED.  
BY: JONES & BOYD, INC.  
DATE: 12/17/00

BENCHMARKS:

- 1" 1/2" IR, W of Ingram Rd. +- 1025' N of N edge of Lucas Rd. +- 6' E of fence. Elev. 637.08
- 1" 1/2" IR, E of Ingram Rd. +- 2650' N of N edge of Lucas Rd. +- 28' E & 37' N of fence corner. Elev. 639.20

NO.	REVISIONS DURING CONSTRUCTION	BY	DATE	NO.	REVISIONS DURING PLAN REVIEW	BY	DATE
2	ADDED NOTES TO NTMWD NOTES	CMG	01/08/01	1	Cont. Saddlebrook through site. Adjust stationing.	JMW	12/05/00

The seal appearing on this document was authorized by Thomas K. Juhn, P.E. 81799 on Jan. 08, 2001. Alteration of a sealed document without proper notification to the responsible engineer is an offense under the Texas Engineering Practice Act.


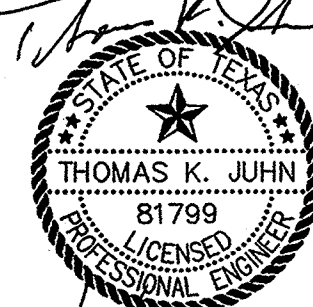


**Jones & Boyd, Inc.**  
16800 Dallas Parkway, Suite 240  
Dallas, Texas 75248  
Tel: 972-248-7676  
Fax: 972-248-1414

**PAVING PLAN & PROFILE**  
**SADDLEBROOK DRIVE (15+00 to 25+00)**  
**SADDLEBROOK**  
City of Lucas, Collin County, Texas


PROJECT NO. SK403  
SHEET NO. 6

Plot time: 12/08 pm  
Plot date: 12/18/00  
Plotter: jk403p.dwg  
Drawing: H:\Projects\SK403\dwg\SK403P.dwg

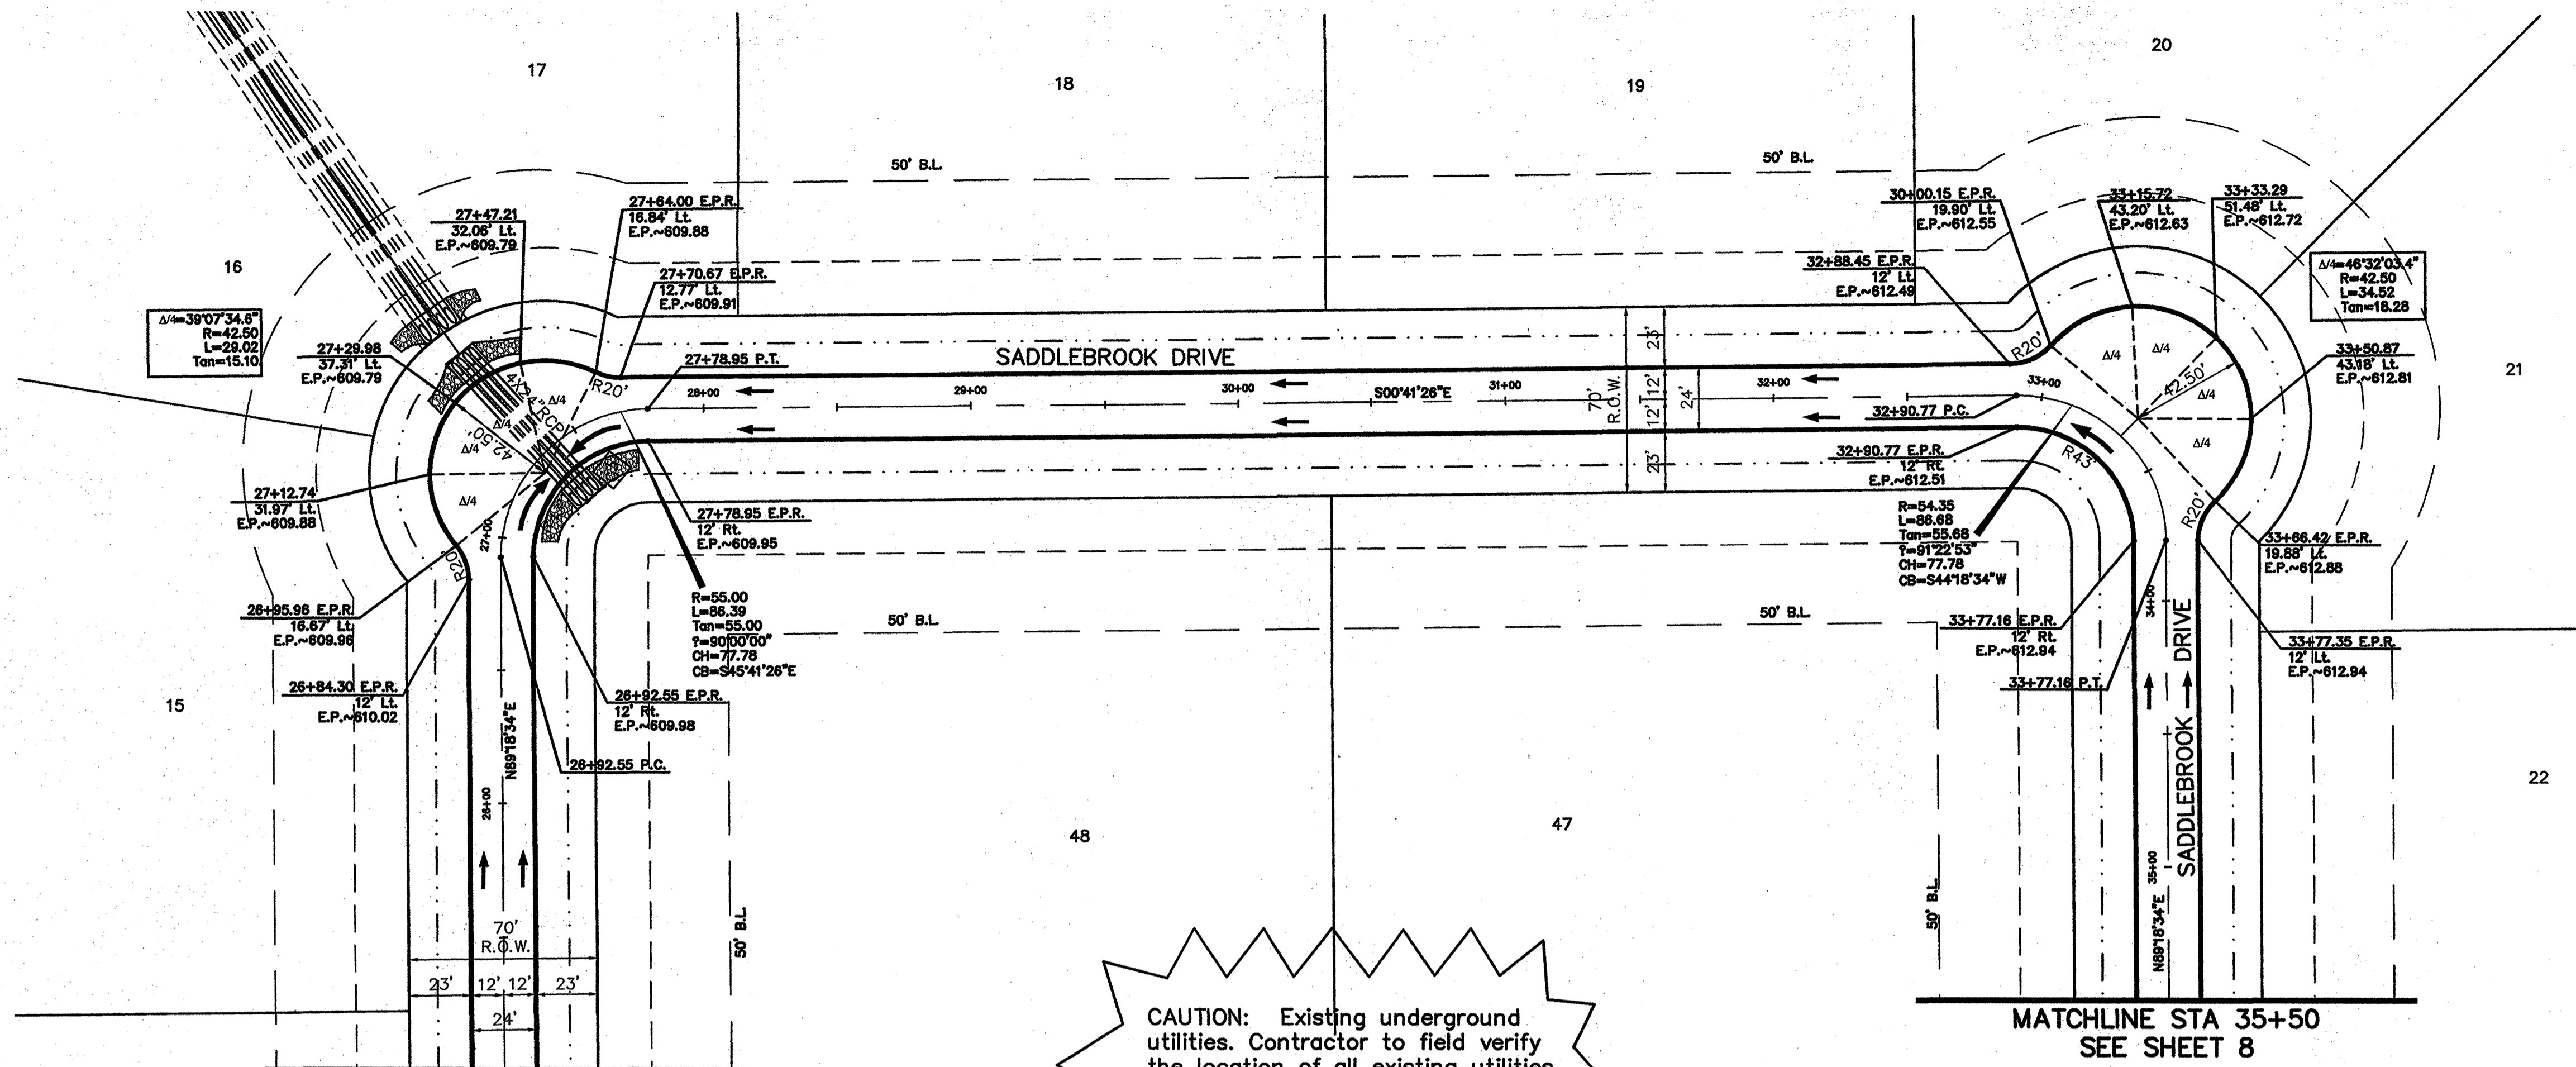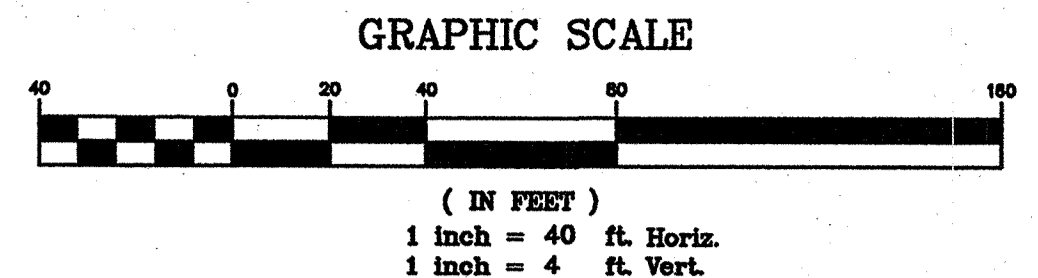

**CAUTION:** Existing underground utilities. Contractor to field verify the location of all existing utilities prior to excavation.

- NTMWD NOTES**
- North Texas Municipal Water District (NTMWD) 42-inch and 20-inch water transmission pipelines are located within the limits of the construction.
  - Operation of heavy earthmoving equipment, compaction equipment or heavy construction equipment, such as concrete trucks, shall be restricted to specific crossing points across NTMWD easements, as approved by the NTMWD. The crossings shall be designated and verified to provide a minimum of five feet of cover.
  - To assure that placing of significant loads over the NTMWD pipeline does not damage the existing pipeline, no materials shall be stockpiled on the NTMWD easement, without authorization from the NTMWD. If the contractor desires to use NTMWD's easement for stockpile of materials, contact NTMWD Engineering at (972) 442-5405 so your plans for use of NTMWD's easement can be reviewed.
  - In areas where the cover between the top of the NTMWD pipeline and the bottom of the sub-grade is three (3) feet or less, it is requested that the sub-grade preparation be deleted and thickened pavement section be used to limit construction activities over the pipeline.
  - Crossing of the NTMWD easement with other utilities, such as TV cable, phone, gas and electric, shall be coordinated with the NTMWD to avoid damage to the NTMWD facilities.
  - Outdoor lighting, landscaping, screening walls or other facilities shall not be installed in NTMWD easements without written approval of the NTMWD.
  - Unless otherwise shown or required a minimum of one-foot clearance shall be provided for all utilities crossing the NTMWD pipelines.
  - The contractor shall contact NTMWD Engineering at (972) 442-5405 at least 48 hours prior to performing any work in the vicinity of the NTMWD facilities.
  - Water and Sewer lines crossing the NTMWD easements shall be installed in compliance with the Rules and Regulations for Public Water Systems, Paragraphs 290.44 (e), Location of Water Lines.
  - Septic systems are not permitted within NTMWD easements.
  - Excavation adjacent to NTMWD pipelines, manholes and other appurtenances to install proposed improvements shall be performed so that the manholes, pipelines or appurtenances are not displaced or damaged. Any damage to the manholes, pipelines or appurtenances shall be repaired to the satisfaction of the NTMWD. Further, any cost for repair of damage to the manholes, pipelines or appurtenances resulting from construction by the developer or contractor will be the responsibility for the developer.

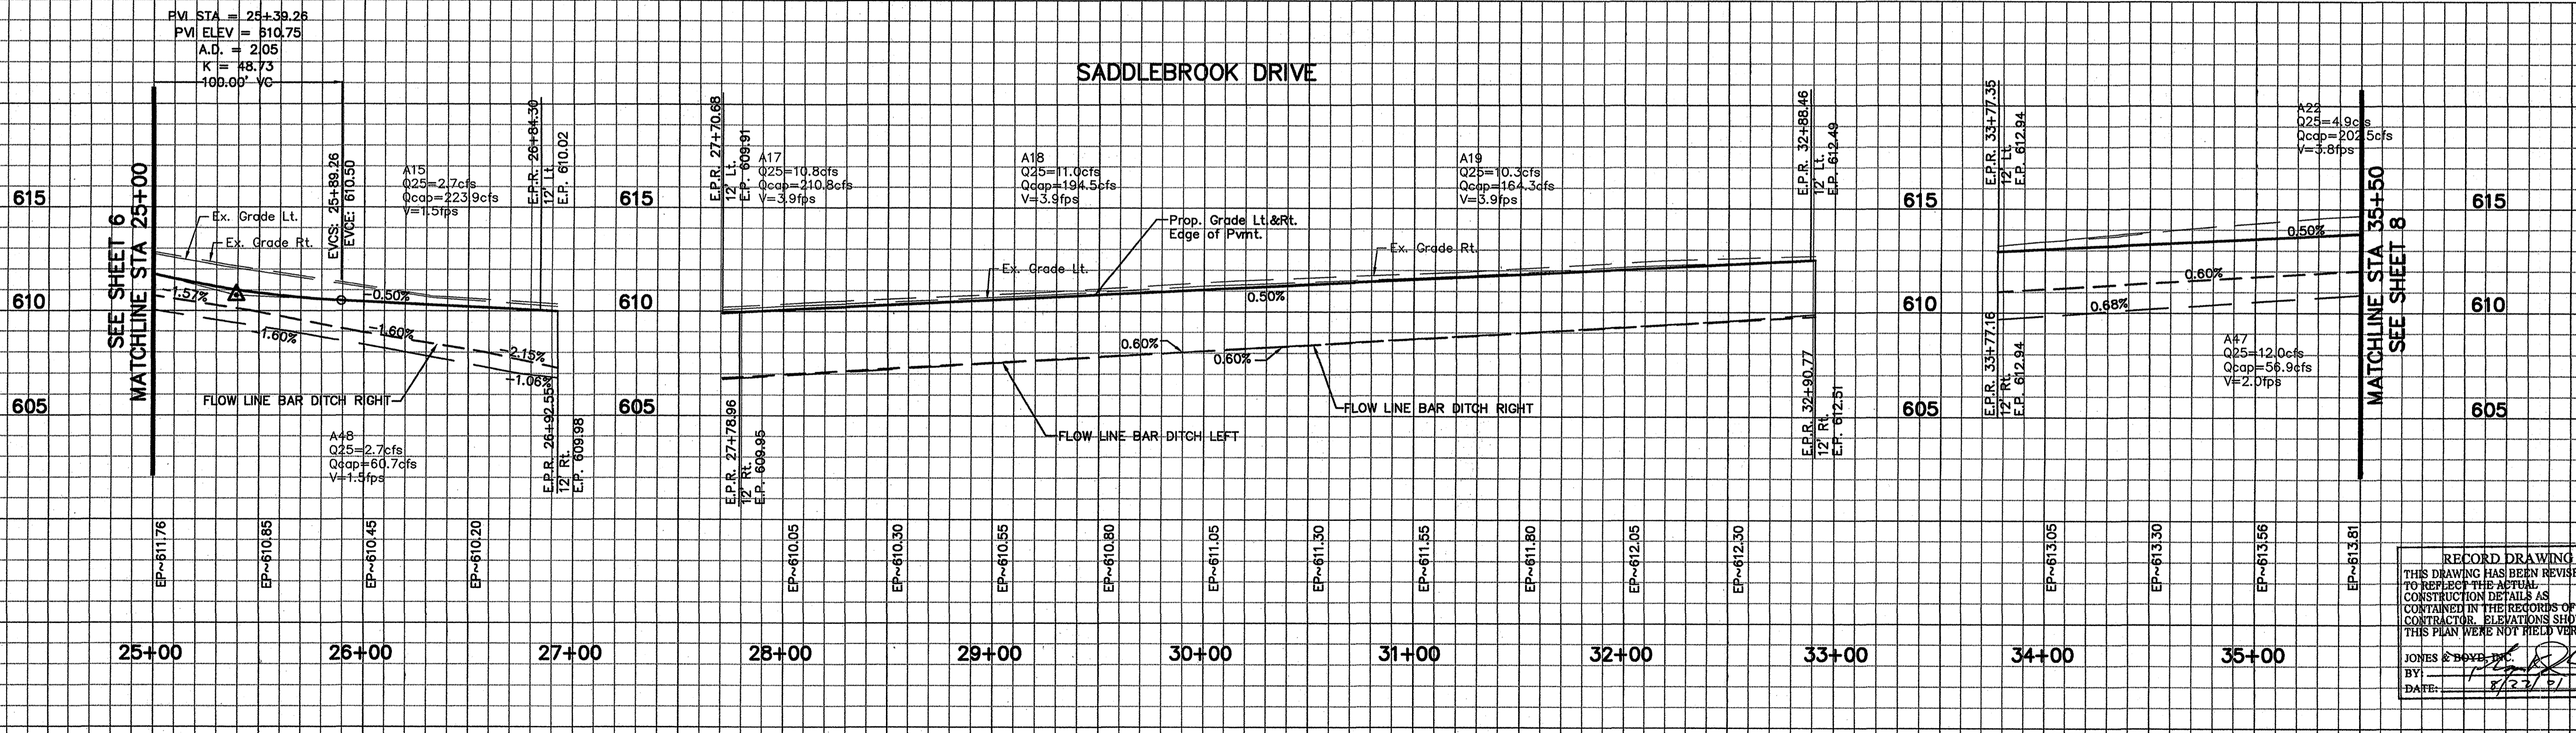


**RECORD DRAWING**  
 THIS DRAWING HAS BEEN REVISED TO REFLECT THE ACTUAL CONSTRUCTION DETAILS AS CONTAINED IN THE RECORDS OF THE CONTRACTOR. ELEVATIONS SHOWN ON THIS PLAN WERE NOT FIELD VERIFIED.  
 BY: JONES & BOYD, INC.  
 DATE: 8/27/01

- BENCHMARKS:**
- 1" 1/2" IR, W of Ingram Rd. +- 1025' N of N edge of Lucas Rd. +- 5' E of fence. Elev. 637.08
  - 1" 1/2" IR, E of Ingram Rd. +- 2850' N of N edge of Lucas Rd. +- 28' E & 37' N of fence corner. Elev. 638.20

NO.	REVISIONS DURING CONSTRUCTION	BY	DATE	NO.	REVISIONS DURING PLAN REVIEW	BY	DATE
2	ADDED NOTES TO NTMWD NOTES	CMG	01/08/01				
1	Cont. Saddlebrook through site. Adjust stationing.	JMW	12/05/00				

The seal appearing on this document was authorized by Thomas K. Juhn, P.E. 81799 on Jan. 08, 2001. Alteration of a sealed document without proper notification to the responsible engineer is an offense under the Texas Engineering Practice Act.

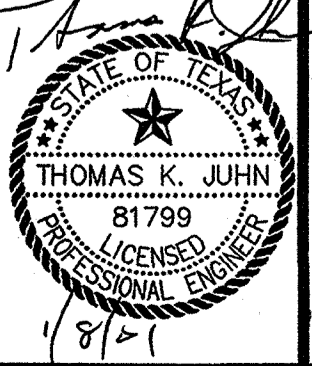

**Jones & Boyd, Inc.**  
 16800 Dallas Parkway, Suite 240  
 Dallas, Texas 75248  
 Tel: 972-248-7676  
 Fax: 972-248-1414

**PAVING PLAN & PROFILE**  
**SADDLEBROOK DRIVE (25+00 to 35+50)**  
**SADDLEBROOK**  
 City of Lucas, Collin County, Texas





PROJECT NO.	SK403
SHEET NO.	7

Plot time: 12:08 pm  
 Plot date: 12/18/00  
 Plotted by: tc  
 Plot info: Drawing: H:\Projects\SK403\dwg\SK403P.dwg  
 Drawing info: H:\Projects\SK403\dwg\SK403P.dwg 12/18/00 1:17 pm



**NTMWD NOTES**

- North Texas Municipal Water District (NTMWD) 42-inch and 20-inch water transmission pipelines are located within the limits of the construction.
- Operation of heavy earthmoving equipment, compaction equipment or heavy construction equipment, such as concrete trucks, shall be restricted to specific crossing points across NTMWD easements, as approved by the NTMWD. The crossings shall be designated and verified to provide a minimum of five feet of cover.
- To assure that placing of significant loads over the NTMWD pipeline does not damage the existing pipeline, no materials shall be stockpiled on the NTMWD easement, without authorization from the NTMWD. If the contractor desires to use NTMWD's easement for stockpile of materials, contact NTMWD Engineering at (972) 442-5405 so your plans for use of NTMWD's easement can be reviewed.
- In areas where the cover between the top of the NTMWD pipeline and the bottom of the sub-grade is three (3) feet or less, it is requested that the sub-grade preparation be deleted and thickened pavement section be used to limit construction activities over the pipeline.
- Crossing of the NTMWD easement with other utilities, such as TV cable, phone, gas and electric, shall be coordinated with the NTMWD to avoid damage to the NTMWD facilities.
- Outdoor lighting, landscaping, screening walls or other facilities shall not be installed in NTMWD easements without written approval of the NTMWD.
- Unless otherwise shown or required a minimum of one-foot clearance shall be provided for all utilities crossing the NTMWD pipelines.
- The contractor shall contact NTMWD Engineering at (972) 442-5405 at least 48 hours prior to performing any work in the vicinity of the NTMWD facilities.
- Water and Sewer lines crossing the NTMWD easements shall be installed in compliance with the Rules and Regulations for Public Water Systems, Paragraphs 290.44 (e), Location of Water Lines.
- Septic systems are not permitted within NTMWD easements.
- Excavation adjacent to NTMWD pipelines, manholes and other appurtenances to install proposed improvements shall be performed so that the manholes, pipelines or appurtenances are not displaced or damaged. Any damage to the manholes, pipelines or appurtenances shall be repaired to the satisfaction of the NTMWD. Further, any cost for repair of damage to the manholes, pipelines or appurtenances resulting from construction by the developer or contractor will be the responsibility for the developer.

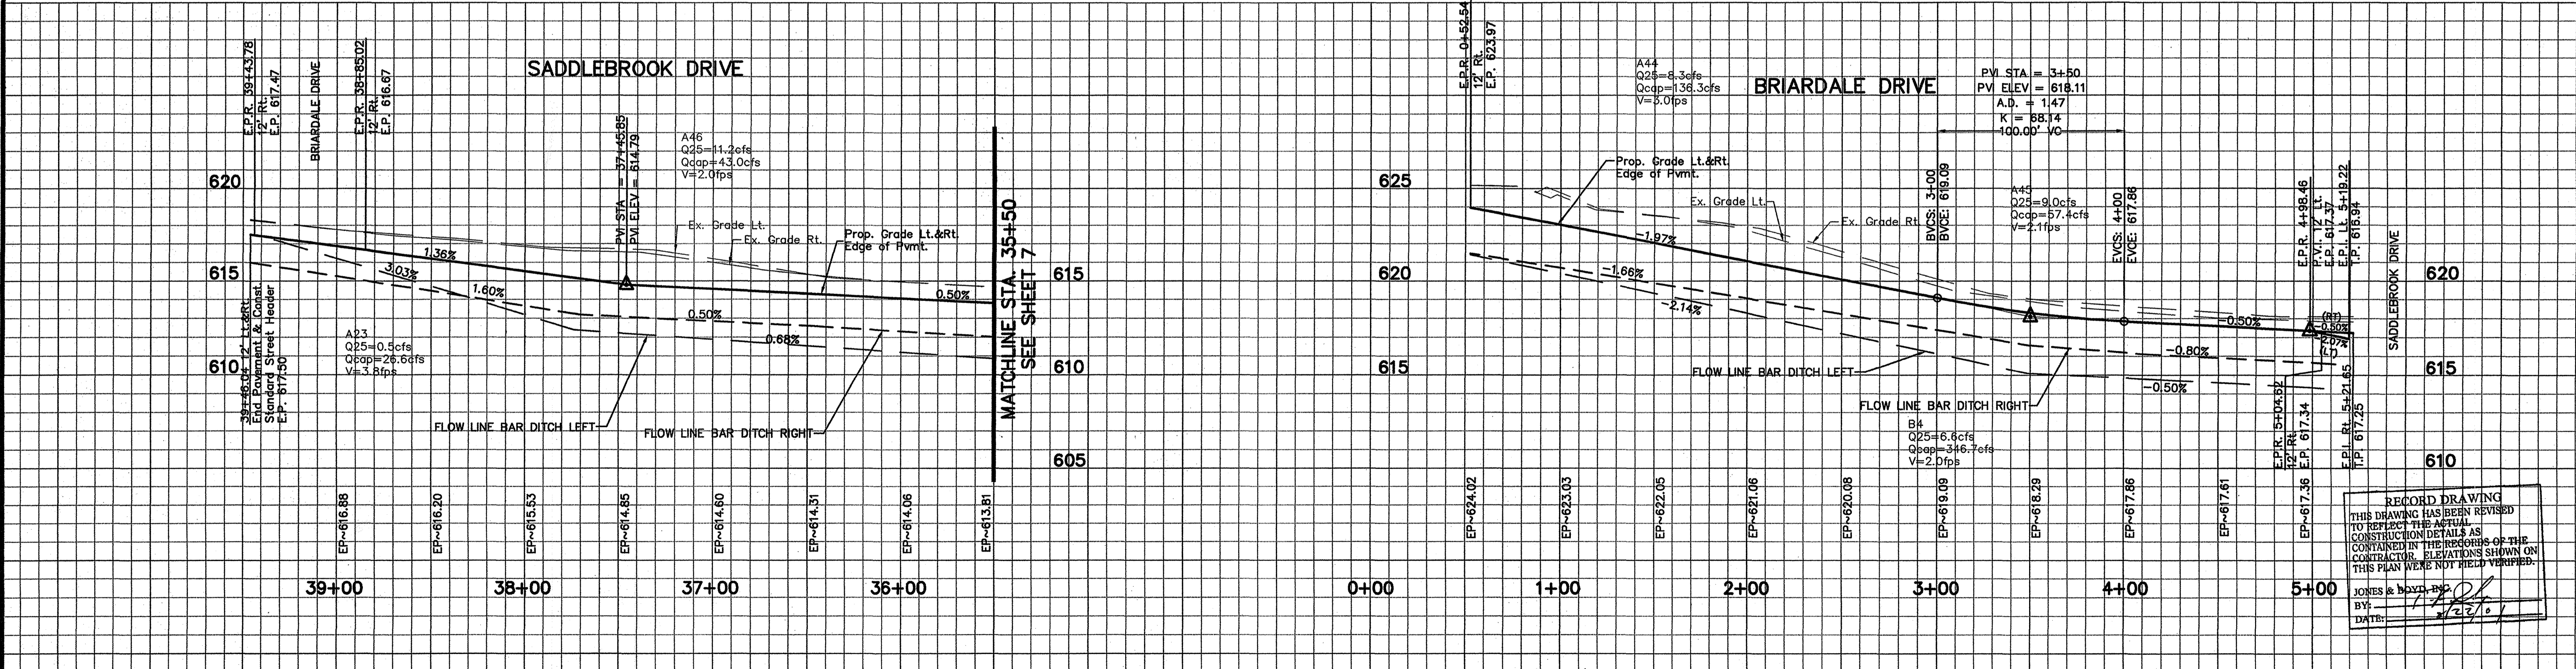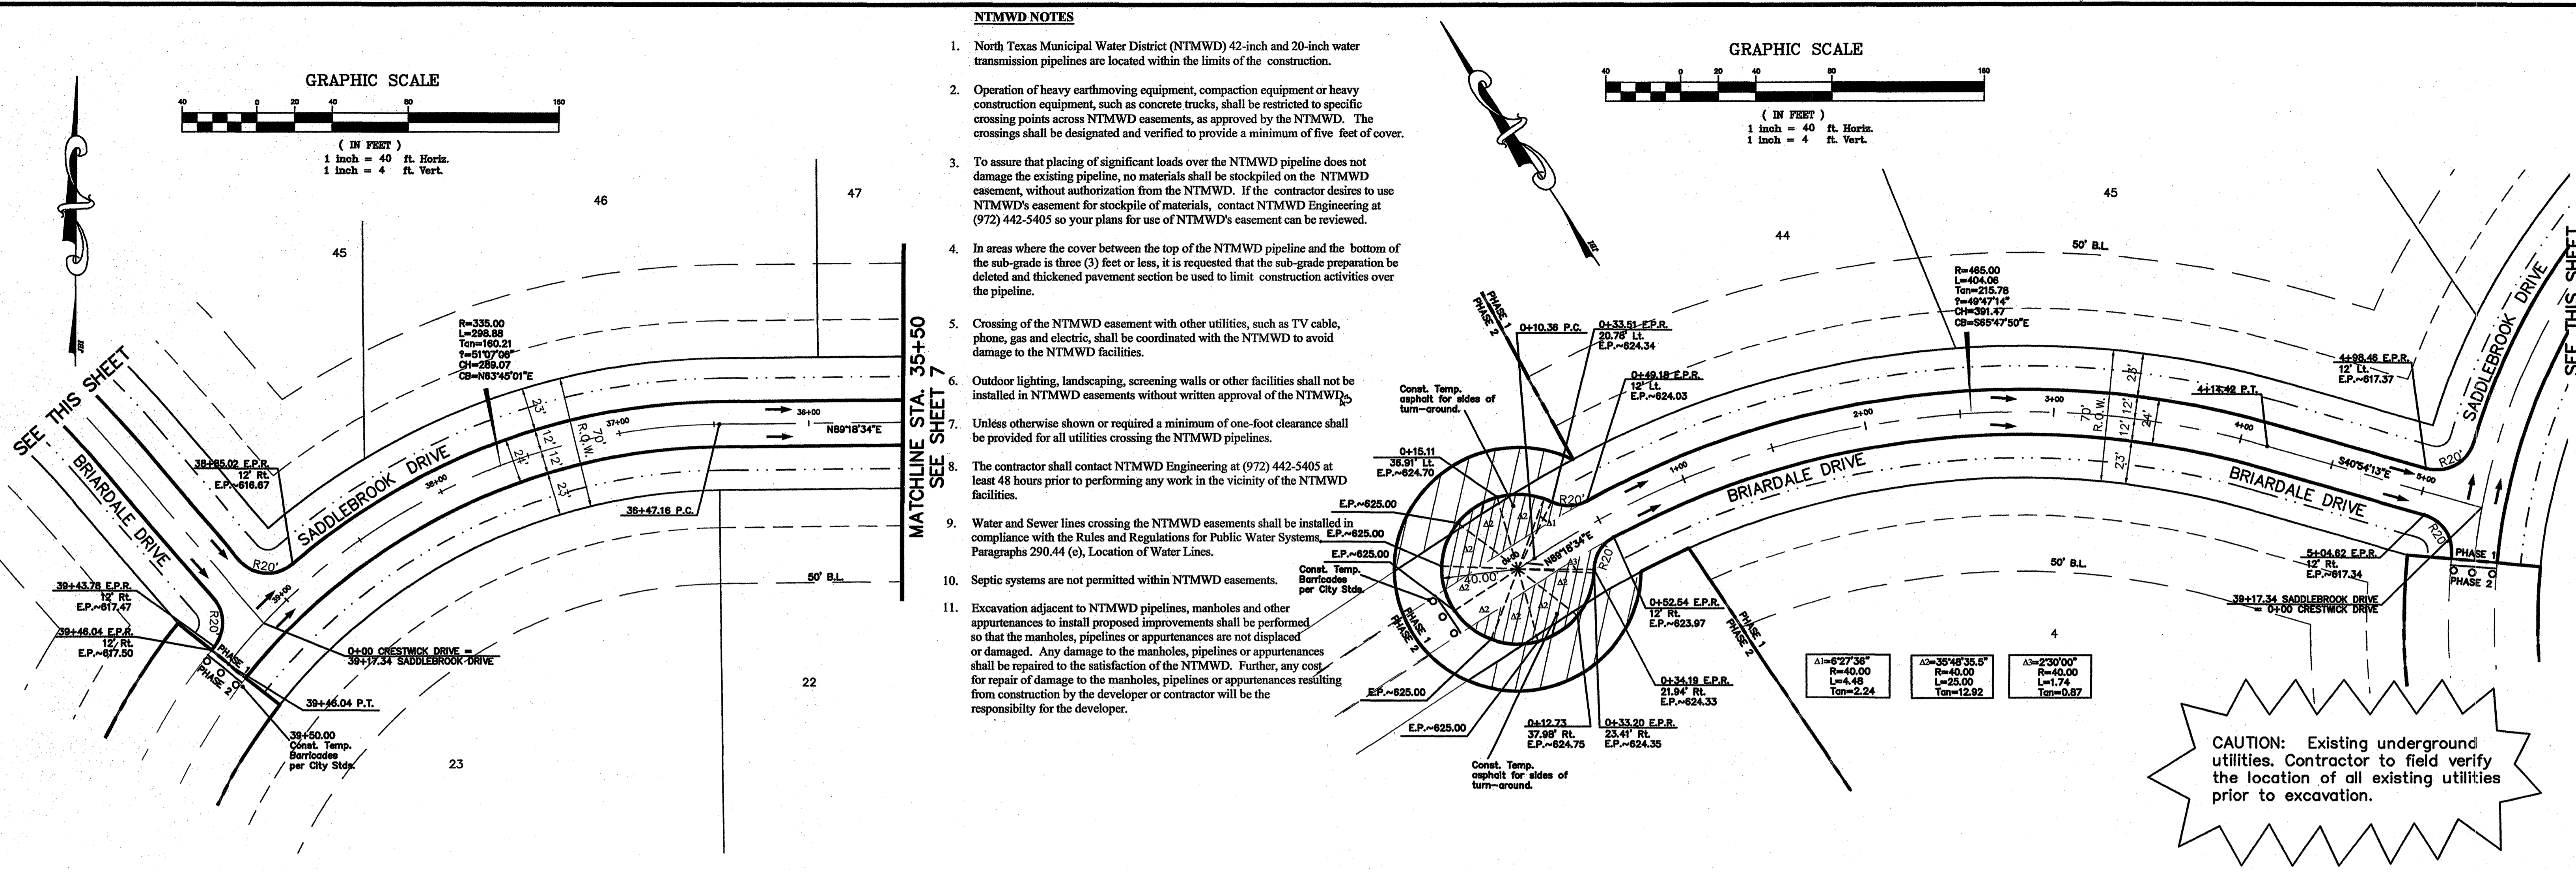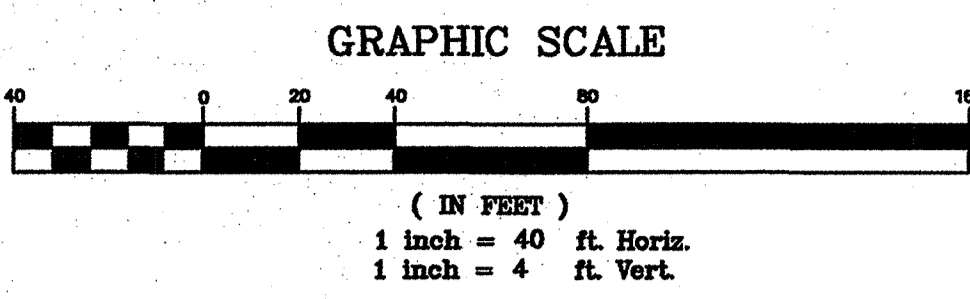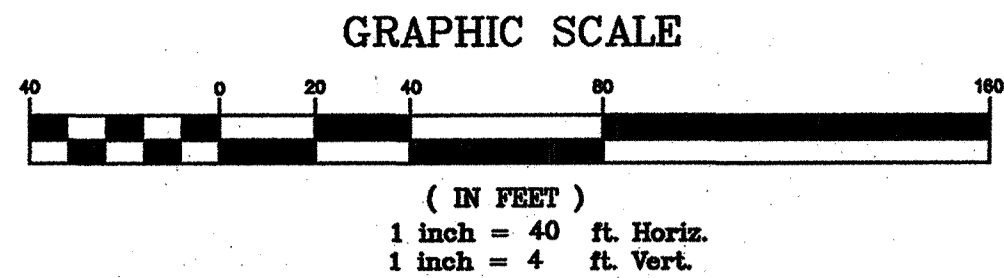

- BENCHMARKS:**
- "T" 1/2" IR, W of Ingram Rd. +- 1025' N of N edge of Lucas Rd. +- 6' E of fence. Elev. 637.08
  - "T" 1/2" IR, E of Ingram Rd. +- 2650' N of N edge of Lucas Rd. +- 28' E & 37' N of fence corner. Elev. 639.20

NO.	REVISIONS DURING CONSTRUCTION	BY	DATE	NO.	REVISIONS DURING PLAN REVIEW	BY	DATE
				2	ADDED NOTES TO NTMWD NOTES	CMG	01/08/01
				1	Cont. Saddlebrook through site. Adjust stationing.	JMW	12/05/00


The seal appearing on this document was authorized by Thomas K. Juhn, P.E. 81799 on Jan. 08, 2001. Alteration of a sealed document without proper notification to the responsible engineer is an offense under the Texas Engineering Practice Act.

**Jones & Boyd, Inc.**  
 16800 Dallas Parkway, Suite 240  
 Dallas, Texas 75248  
 Tel: 972-248-7676  
 Fax: 972-248-1414


**PAVING PLAN & PROFILE**  
**SADDLEBROOK DR.(End) & BRAIRDALE DR.**  
**SADDLEBROOK**  
 City of Lucas, Collin County, Texas

PROJECT NO. SK403  
 SHEET NO. 8

Plot time: 12:08 pm  
 Drawing: H:\Projects\SK403.dwg  
 Plotted by: tc  
 Plot date: 12/18/00  
 Drawing info: H:\Projects\SK403.dwg  
 Plotted by: tc  
 Plot date: 12/18/00  
 1:17 pm

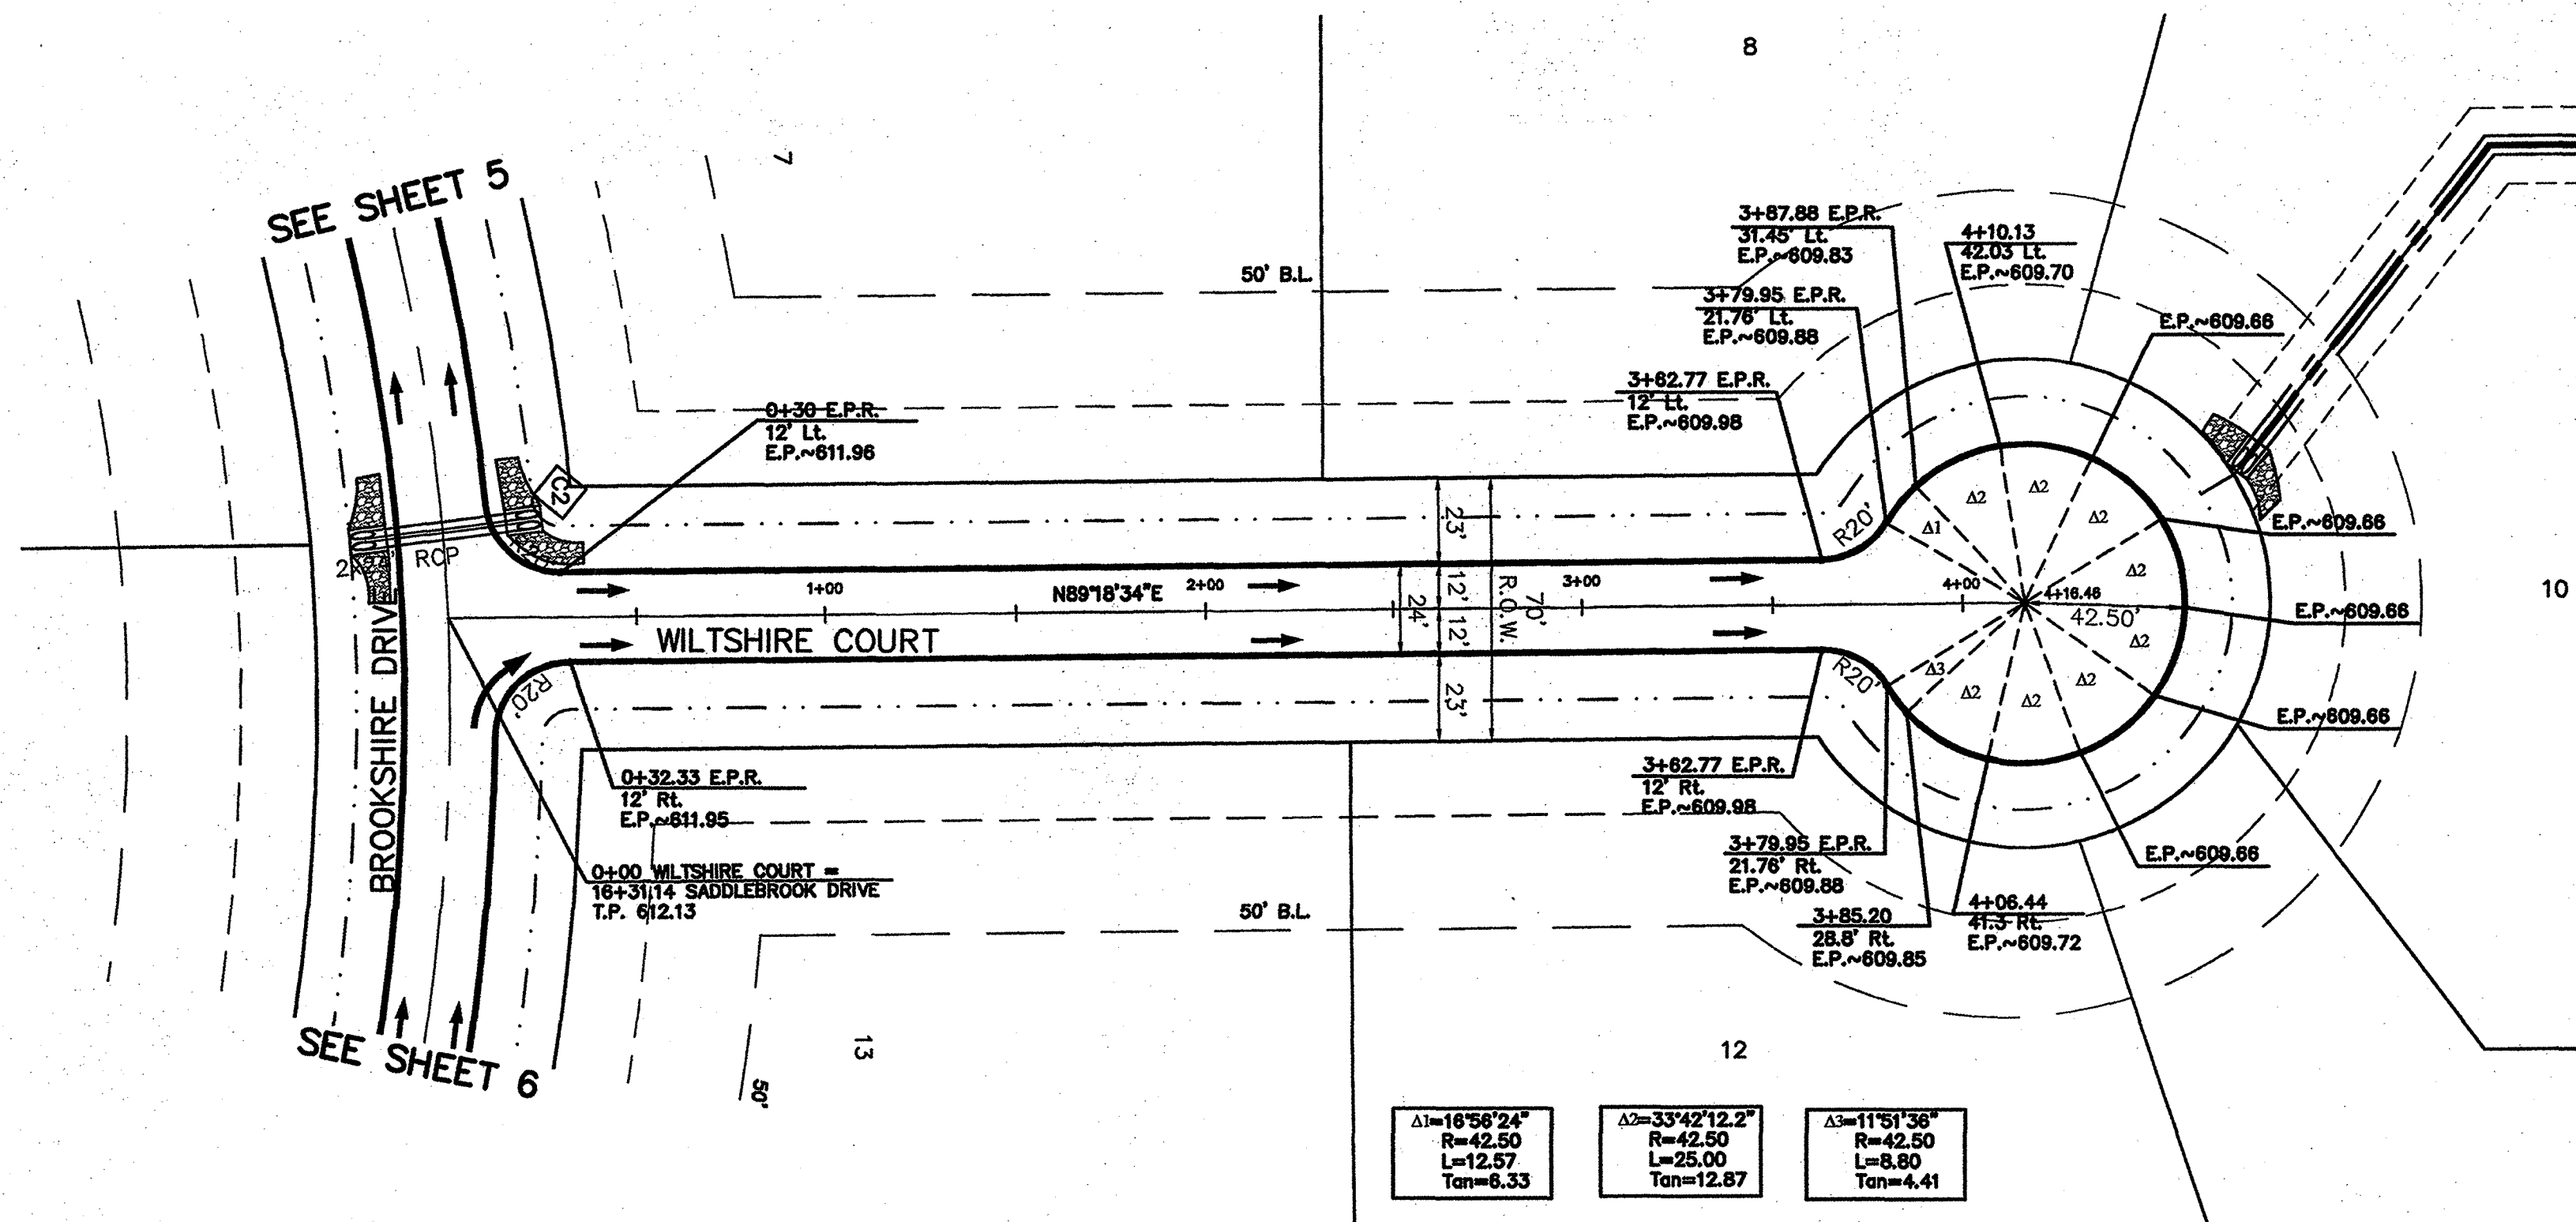


**CAUTION:** Existing underground utilities. Contractor to field verify the location of all existing utilities prior to excavation.

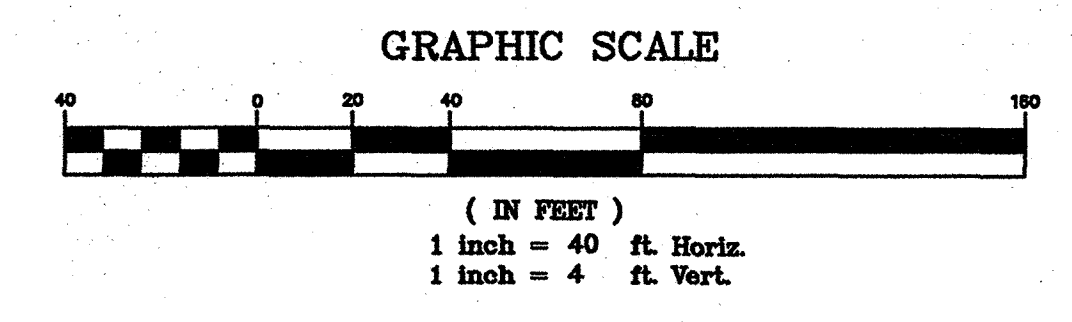

**NTMWD NOTES**

- North Texas Municipal Water District (NTMWD) 42-inch and 20-inch water transmission pipelines are located within the limits of the construction.
- Operation of heavy earthmoving equipment, compaction equipment or heavy construction equipment, such as concrete trucks, shall be restricted to specific crossing points across NTMWD easements, as approved by the NTMWD. The crossings shall be designated and verified to provide a minimum of five feet of cover.
- To assure that placing of significant loads over the NTMWD pipeline does not damage the existing pipeline, no materials shall be stockpiled on the NTMWD easement, without authorization from the NTMWD. If the contractor desires to use NTMWD's easement for stockpile of materials, contact NTMWD Engineering at (972) 442-5405 so your plans for use of NTMWD's easement can be reviewed.
- In areas where the cover between the top of the NTMWD pipeline and the bottom of the sub-grade is three (3) feet or less, it is requested that the sub-grade preparation be deleted and thickened pavement section be used to limit construction activities over the pipeline.
- Crossing of the NTMWD easement with other utilities, such as TV cable, phone, gas and electric, shall be coordinated with the NTMWD to avoid damage to the NTMWD facilities.
- Outdoor lighting, landscaping, screening walls or other facilities shall not be installed in NTMWD easements without written approval of the NTMWD.
- Unless otherwise shown or required a minimum of one-foot clearance shall be provided for all utilities crossing the NTMWD pipelines.
- The contractor shall contact NTMWD Engineering at (972) 442-5405 at least 48 hours prior to performing any work in the vicinity of the NTMWD facilities.  
Water and Sewer lines crossing the NTMWD easements shall be installed in compliance with the Rules and Regulations for Public Water Systems, Paragraphs 290.44 (e), Location of Water Lines.  
Septic systems are not permitted within NTMWD easements.
- Excavation adjacent to NTMWD pipelines, manholes and other appurtenances to install proposed improvements shall be performed so that the manholes, pipelines or appurtenances are not displaced or damaged. Any damage to the manholes, pipelines or appurtenances shall be repaired to the satisfaction of the NTMWD. Further, any cost for repair of damage to the manholes, pipelines or appurtenances resulting from construction by the developer or contractor will be the responsibility for the developer.

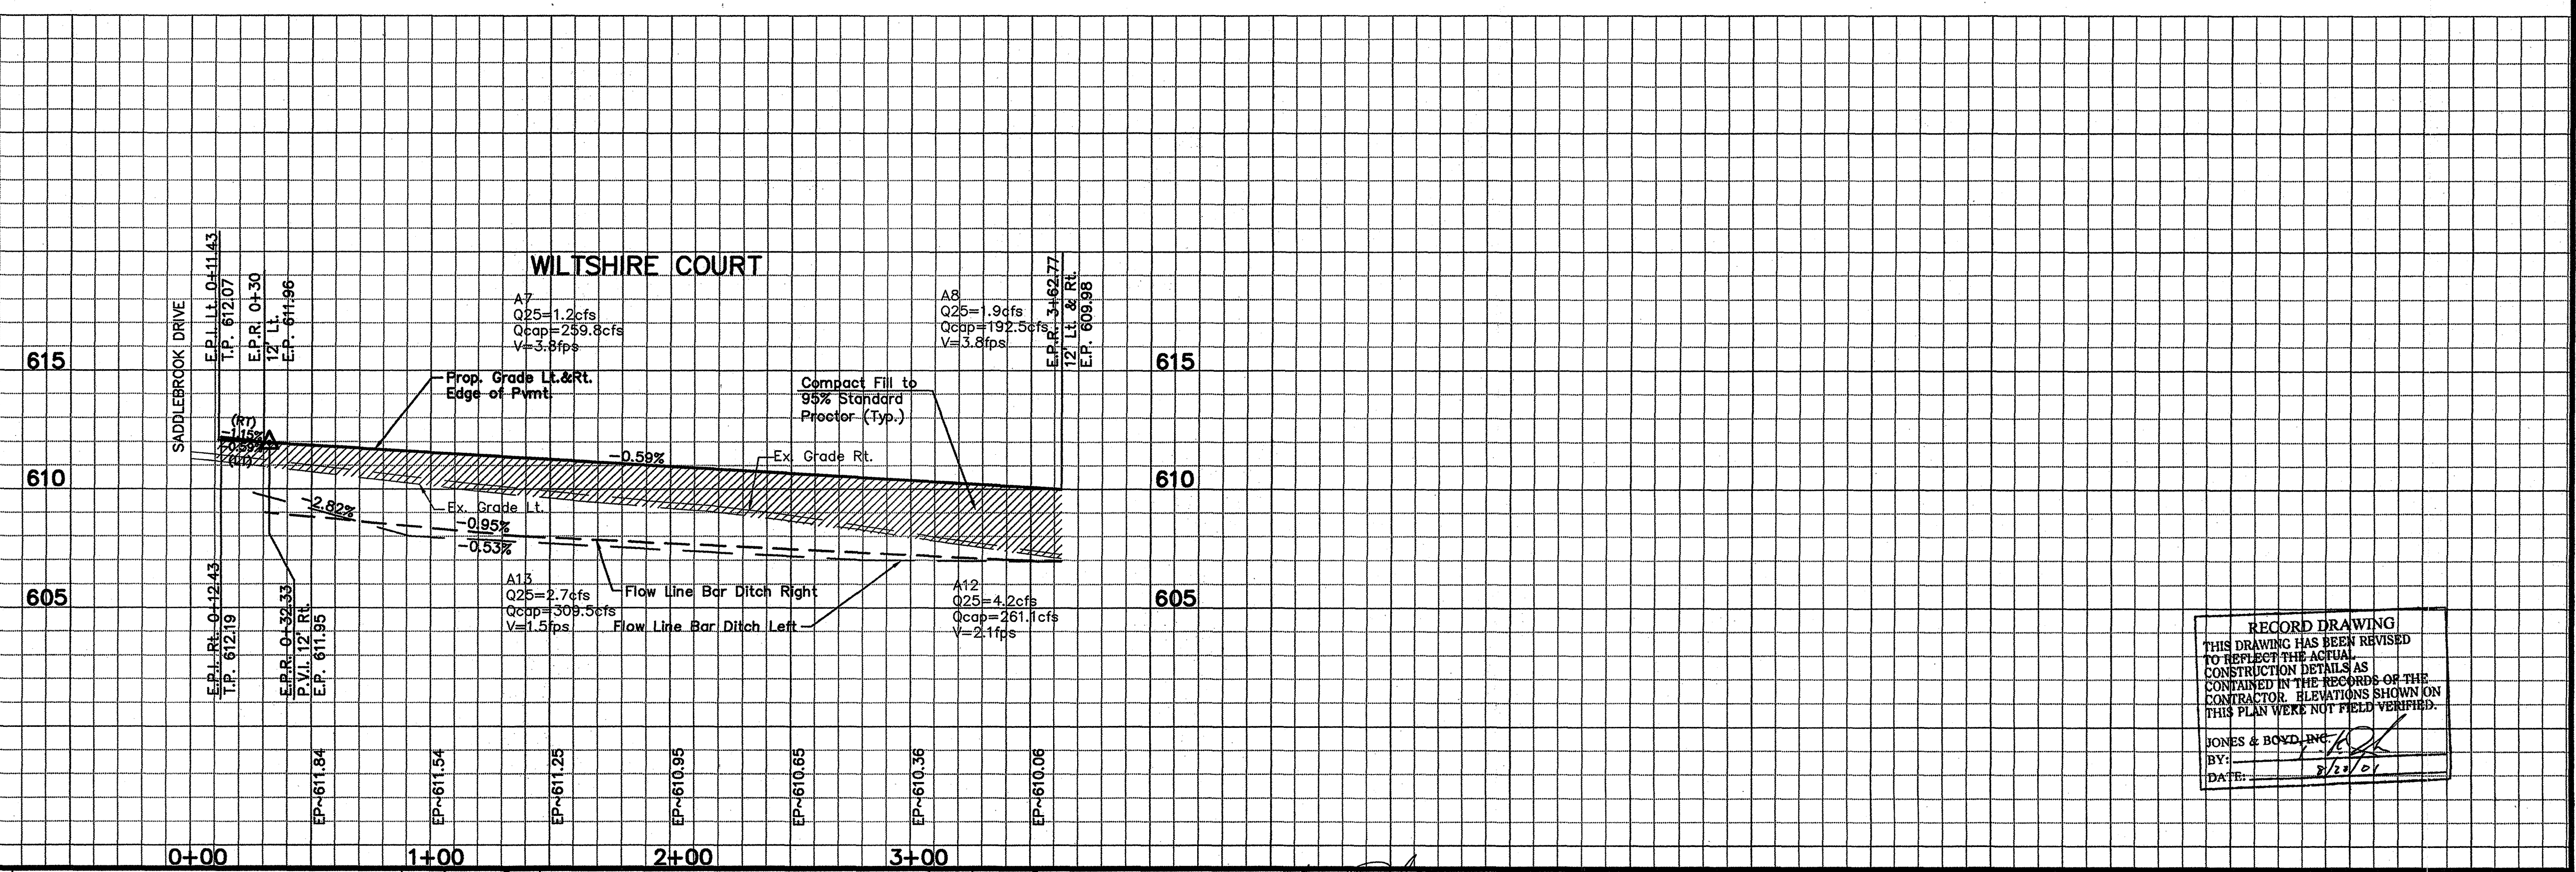

**RECORD DRAWING**  
THIS DRAWING HAS BEEN REVISED TO REFLECT THE ACTUAL CONSTRUCTION DETAILS AS CONTAINED IN THE RECORDS OF THE CONTRACTOR. ELEVATIONS SHOWN ON THIS PLAN WERE NOT FIELD VERIFIED.  
JONES & BOYD, INC.  
BY: [Signature]  
DATE: 2/12/01

- BENCHMARKS:**
- 1" 1/2" IR, W of Ingram Rd. +- 1025' N of N edge of Lucas Rd. +- 6' E of fence. Elev. 637.08
  - 2" 1/2" IR, E of Ingram Rd. +- 2650' N of N edge of Lucas Rd. +- 28' E & 37' N of fence corner. Elev. 639.20

NO.	REVISIONS DURING CONSTRUCTION	BY	DATE	NO.	REVISIONS DURING PLAN REVIEW	BY	DATE
				2	ADDED NOTES TO NTMWD NOTES	CMG	01/08/01
				1	Cont. Saddlebrook through site. Adjust stationing.	JMW	12/05/00

The seal appearing on this document was authorized by Thomas K. Juhn, P.E. 81799 on Jan. 08, 2001. Alteration of a sealed document without proper notification to the responsible engineer is an offense under the Texas Engineering Practice Act.



**Jones & Boyd, Inc.**  
16800 Dallas Parkway, Suite 240  
Dallas, Texas 75248  
Tel: 972-248-7676  
Fax: 972-248-1414

**PAVING PLAN & PROFILE**  
**WILTSHIRE COURT**  
**SADDLEBROOK**  
City of Lucas, Collin County, Texas

PROJECT NO. SK403  
SHEET NO. 9

Plot time: 12:08 pm  
Plotted by: te  
Plot date: 12/18/00  
Drawing: H:\Projects\SK403.dwg  
Project: SK403PV.dwg

**CAUTION:** Existing underground utilities. Contractor to field verify the location of all existing utilities prior to excavation.

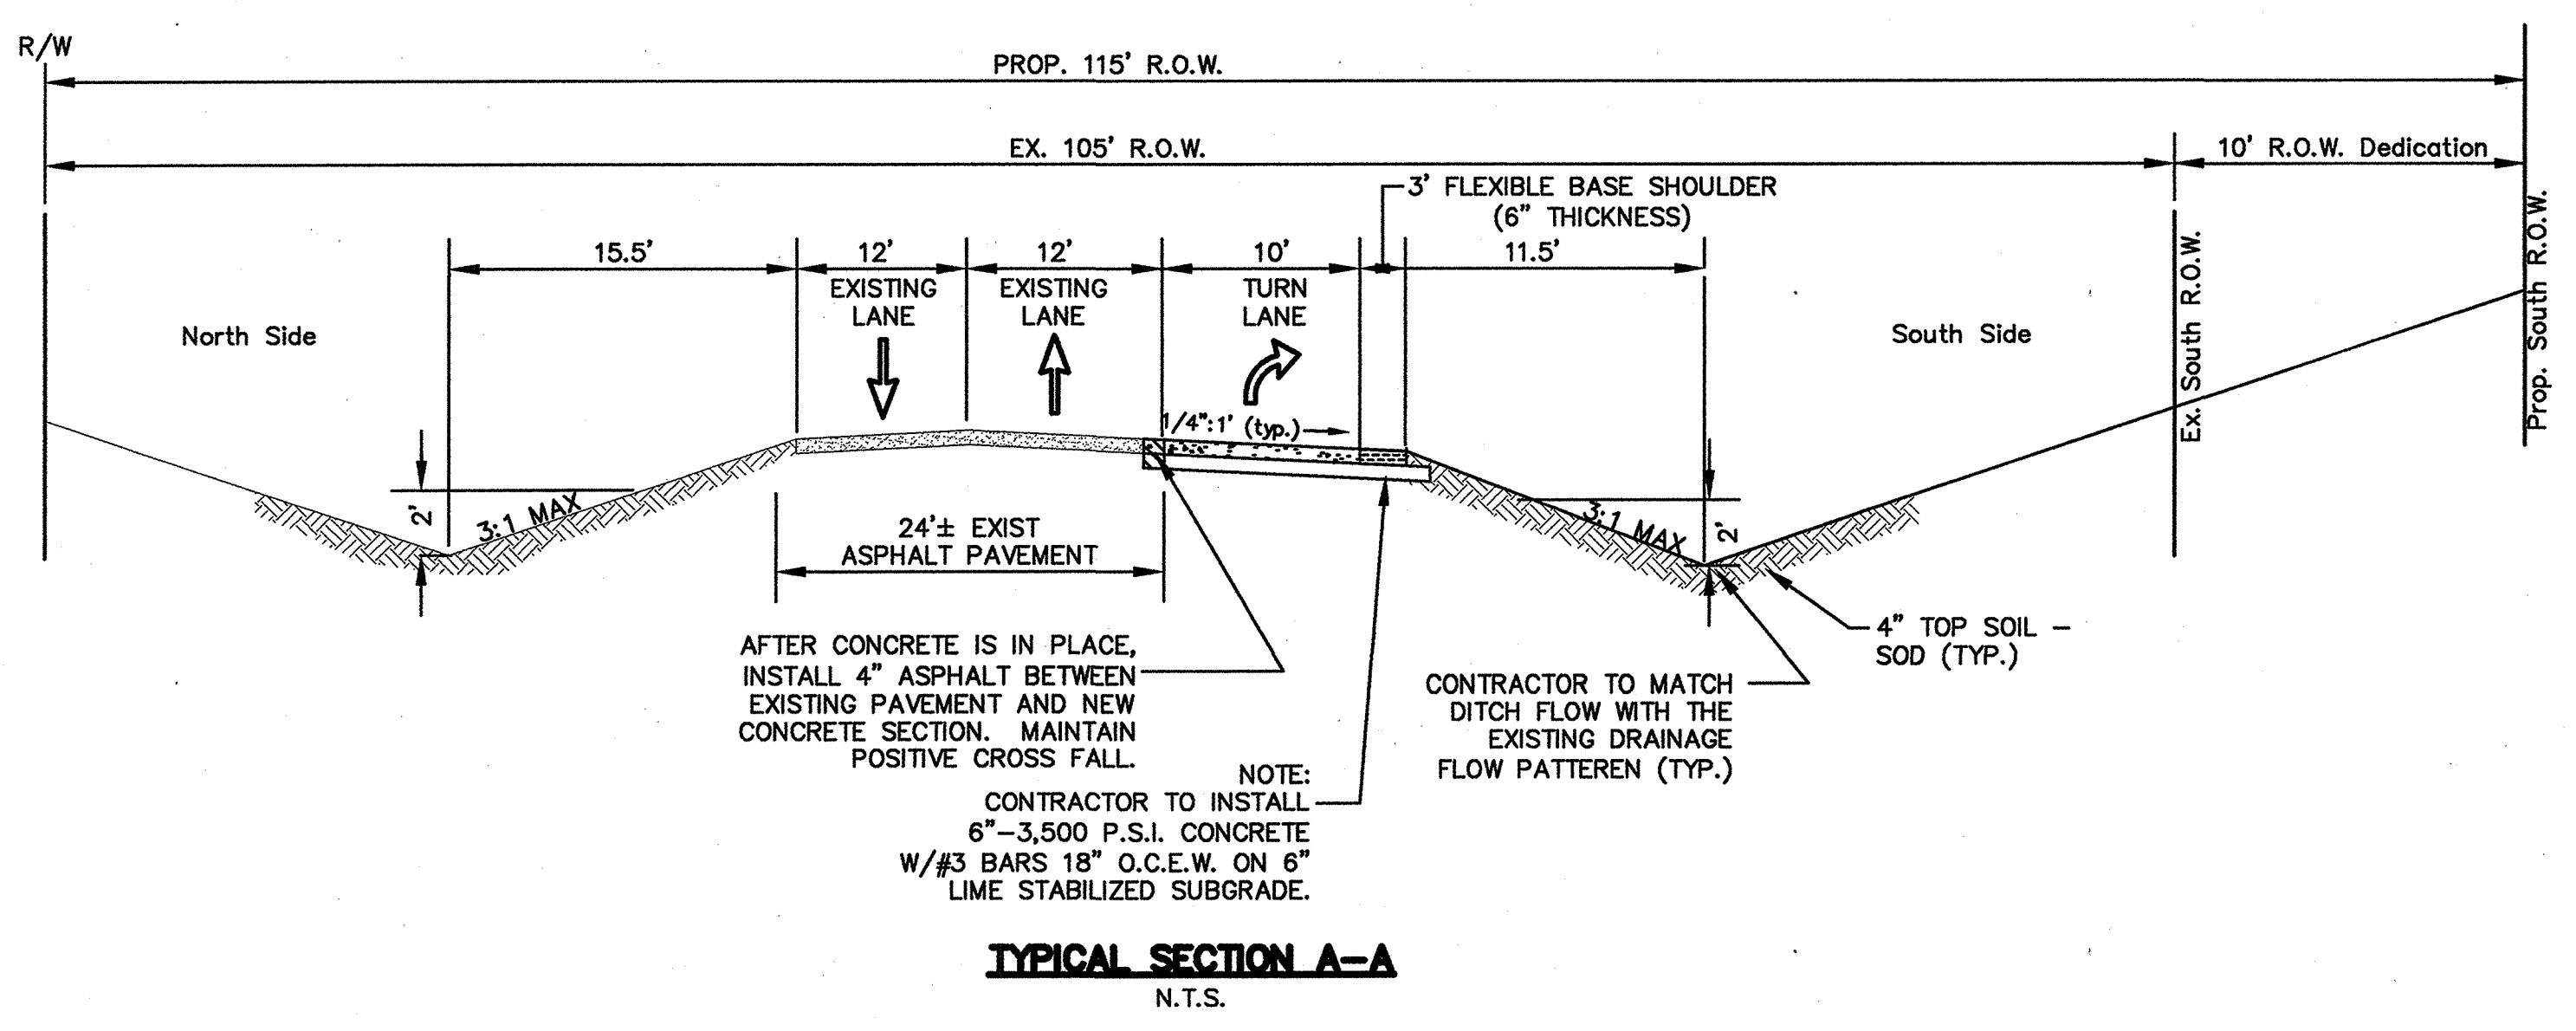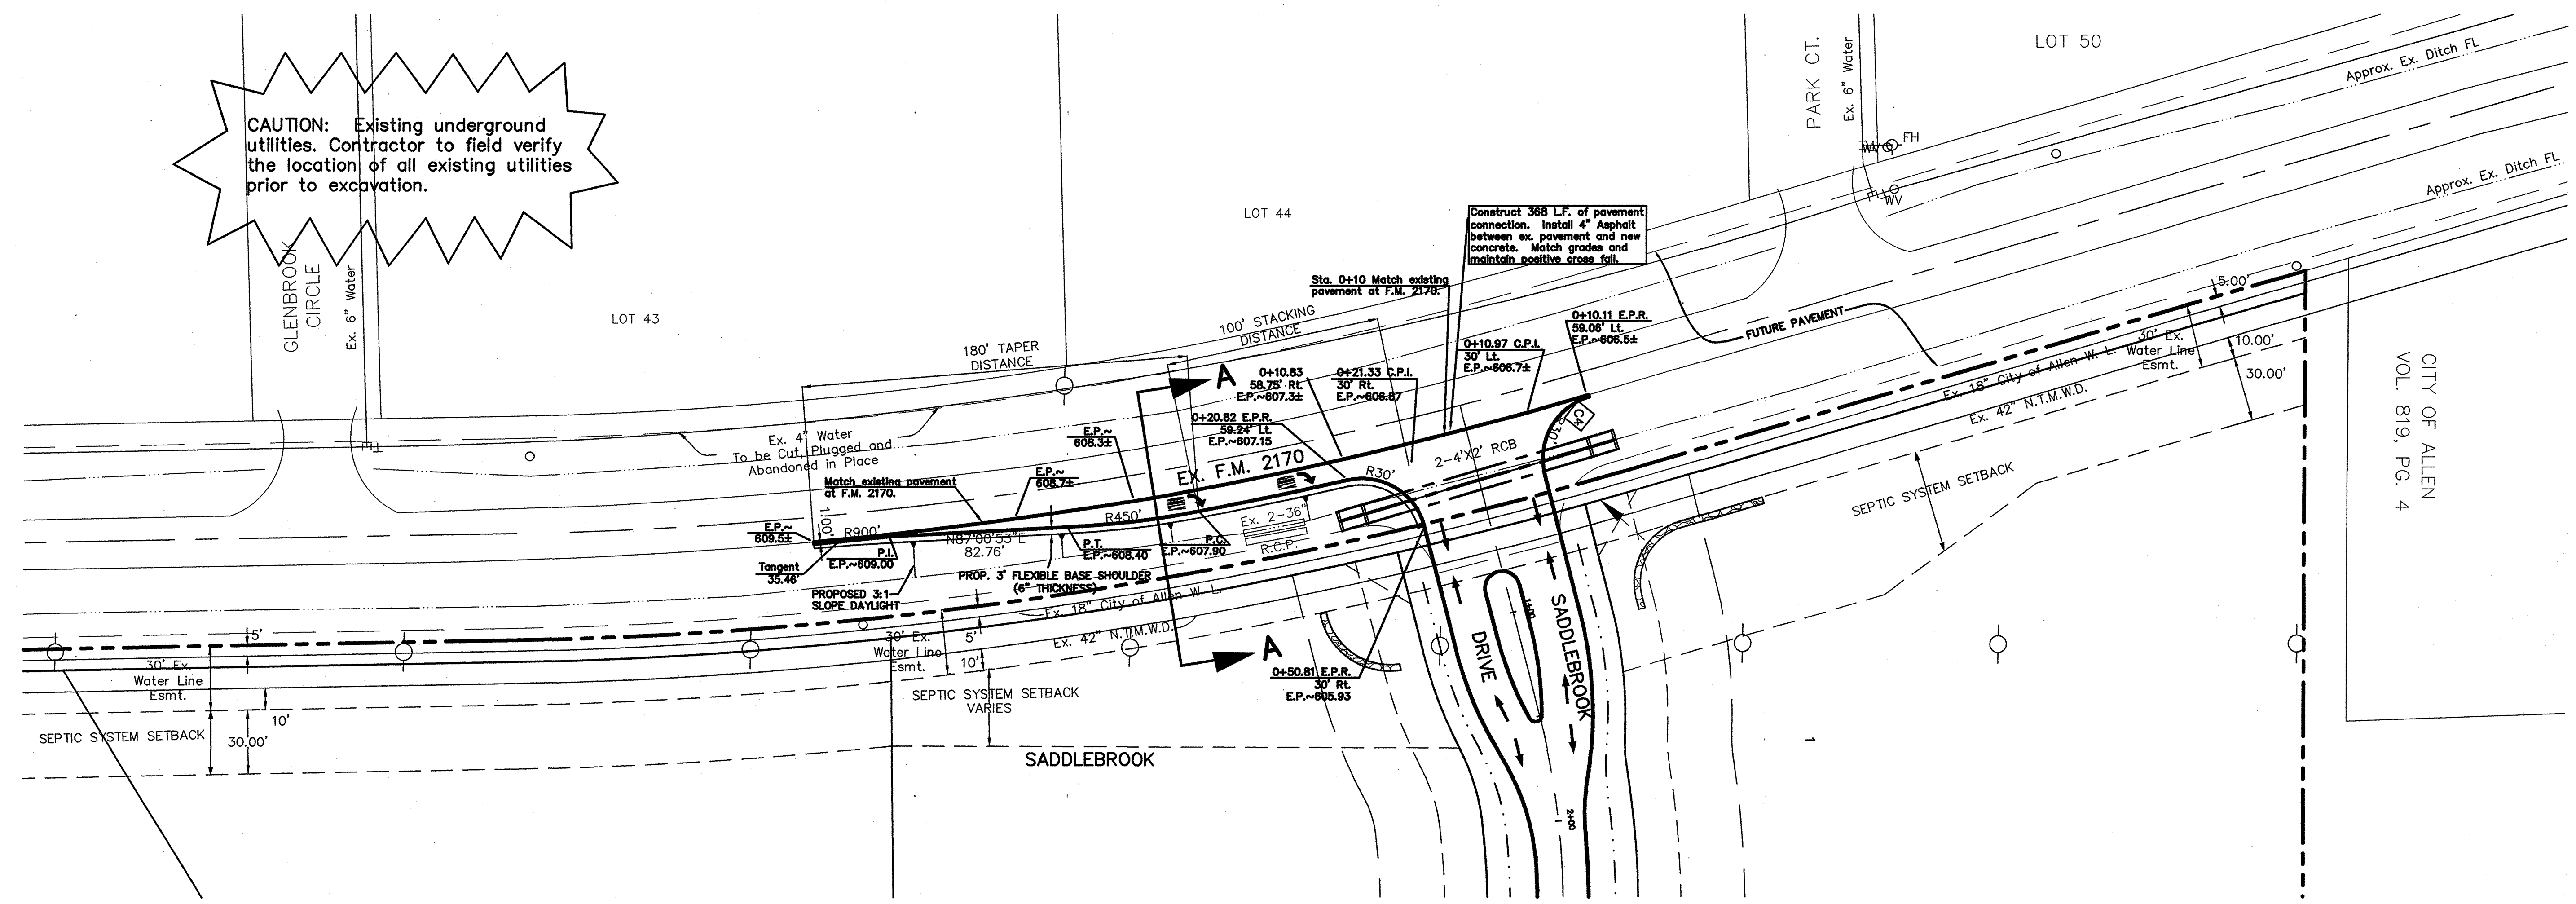


AFTER CONCRETE IS IN PLACE, INSTALL 4" ASPHALT BETWEEN EXISTING PAVEMENT AND NEW CONCRETE SECTION. MAINTAIN POSITIVE CROSS FALL.

NOTE: CONTRACTOR TO INSTALL 6"-3,500 P.S.I. CONCRETE W/#3 BARS 18" O.C.E.W. ON 6" LIME STABILIZED SUBGRADE.

CONTRACTOR TO MATCH DITCH FLOW WITH THE EXISTING DRAINAGE FLOW PATTERN (TYP.)

**TYPICAL SECTION A-A**  
N.T.S.

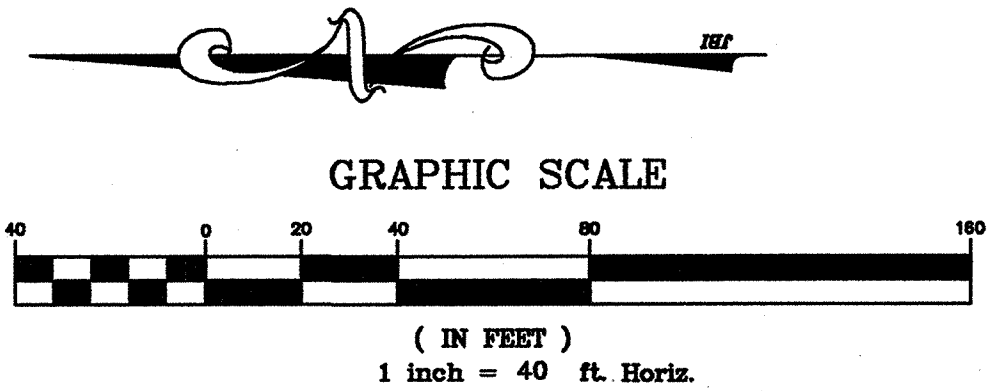

**RECORD DRAWING**  
THIS DRAWING HAS BEEN REVISED TO REFLECT THE ACTUAL CONSTRUCTION DETAILS AS CONTAINED IN THE RECORDS OF THE CONTRACTOR. ELEVATIONS SHOWN ON THIS PLAN WERE NOT FIELD VERIFIED.

BY: *[Signature]*  
DATE: 2/27/01

**NTMWD NOTES**

- North Texas Municipal Water District (NTMWD) 42-inch and 20-inch water transmission pipelines are located within the limits of the construction.
- Operation of heavy earthmoving equipment, compaction equipment or heavy construction equipment, such as concrete trucks, shall be restricted to specific crossing points across NTMWD easements, as approved by the NTMWD. The crossings shall be designated and verified to provide a minimum of five feet of cover.
- To assure that placing of significant loads over the NTMWD pipeline does not damage the existing pipeline, no materials shall be stockpiled on the NTMWD easement, without authorization from the NTMWD. If the contractor desires to use NTMWD's easement for stockpile of materials, contact NTMWD Engineering at (972) 442-5405 so your plans for use of NTMWD's easement can be reviewed.
- In areas where the cover between the top of the NTMWD pipeline and the bottom of the sub-grade is three (3) feet or less, it is requested that the sub-grade preparation be deleted and thickened pavement section be used to limit construction activities over the pipeline.
- Crossing of the NTMWD easement with other utilities, such as TV cable, phone, gas and electric, shall be coordinated with the NTMWD to avoid damage to the NTMWD facilities.
- Outdoor lighting, landscaping, screening walls or other facilities shall not be installed in NTMWD easements without written approval of the NTMWD.
- Unless otherwise shown or required a minimum of one-foot clearance shall be provided for all utilities crossing the NTMWD pipelines.
- The contractor shall contact NTMWD Engineering at (972) 442-5405 at least 48 hours prior to performing any work in the vicinity of the NTMWD facilities.
- Water and Sewer lines crossing the NTMWD easements shall be installed in compliance with the Rules and Regulations for Public Water Systems, Paragraphs 290.44 (e), Location of Water Lines.
- Septic systems are not permitted within NTMWD easements.
- Excavation adjacent to NTMWD pipelines, manholes and other appurtenances to install proposed improvements shall be performed so that the manholes, pipelines or appurtenances are not displaced or damaged. Any damage to the manholes, pipelines or appurtenances shall be repaired to the satisfaction of the NTMWD. Further, any cost for repair of damage to the manholes, pipelines or appurtenances resulting from construction by the developer or contractor will be the responsibility for the developer.

- BENCHMARKS:**
- 1/2" IR, W of Ingram Rd. +- 1025' N of N edge of Lucas Rd. +- 6' E of fence. Elev. 637.08
  - 1/2" IR, E of Ingram Rd. +- 2650' N of N edge of Lucas Rd. +- 28' E & 37' N of fence corner. Elev. 639.20


NO.	REVISIONS DURING CONSTRUCTION	BY	DATE	NO.	REVISIONS DURING PLAN REVIEW	BY	DATE
1	Lengthen right turn lane per TxDOT comments.	JMW	2/14/01	1	Added Turning Lane on Ex. F.M. 2170	TC	12/18/00
2				2	Added Joint Detail & Changed Text	CMG	12/19/00
3				3	Revised F.M. 720 Cross Section	SSC	12/22/00
4				4	ADDED TO NTMWD NOTES & ADDED TEXT TO EASEMENT	CMG	01/08/01

The seal appearing on this document was authorized by Thomas K. Juhn, P.E. 81799 on Feb. 14, 2001. Alteration of a sealed document without proper notification to the responsible engineer is an offense under the Texas Engineering Practice Act.

*[Signature]*  
2/14/01


**Jones & Boyd, Inc.**  
16800 Dallas Parkway, Suite 240  
Dallas, Texas 75248  
Tel: 972-248-7676  
Fax: 972-248-1414

<b>PAVING PLAN</b>		PROJECT NO.
F.M. 2170		SK403
<b>SADDLEBROOK</b>		SHEET NO.
City of Lucas, Collin County, Texas		9A

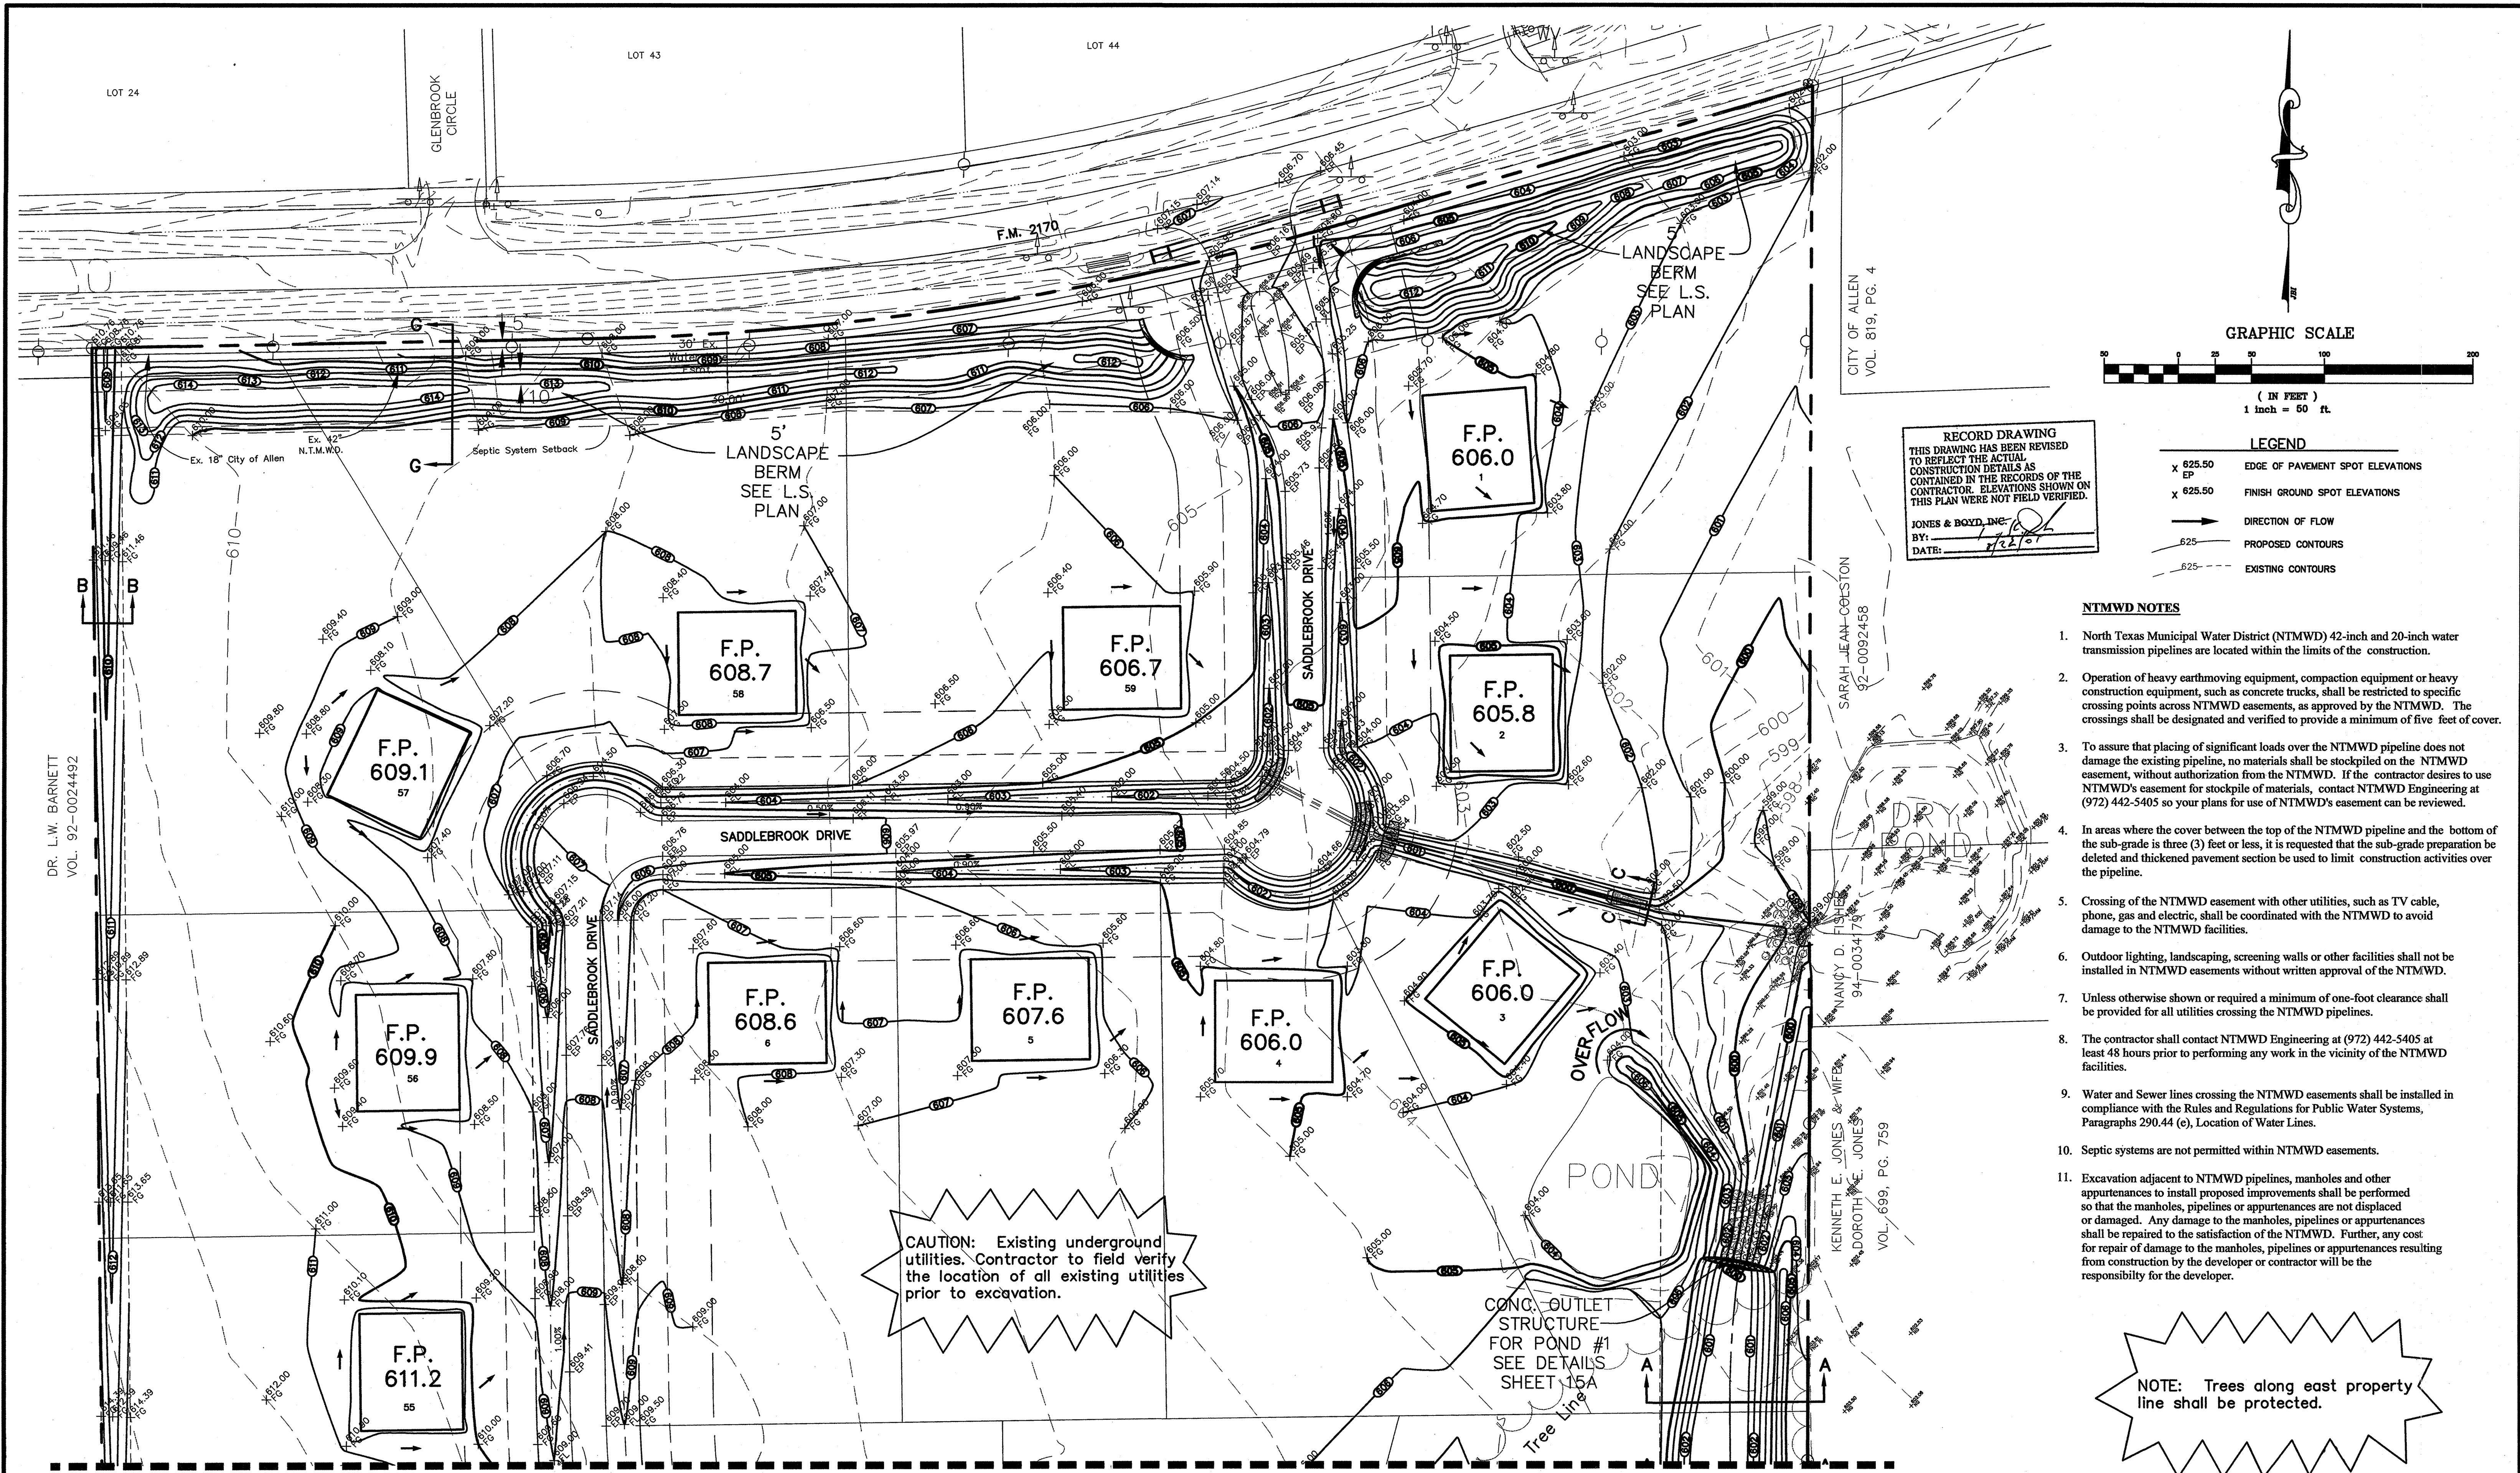

**RECORD DRAWING**  
 THIS DRAWING HAS BEEN REVISED TO REFLECT THE ACTUAL CONSTRUCTION DETAILS AS CONTAINED IN THE RECORDS OF THE CONTRACTOR. ELEVATIONS SHOWN ON THIS PLAN WERE NOT FIELD VERIFIED.

JONES & BOYD, INC.  
 BY: [Signature]  
 DATE: 2/2/01

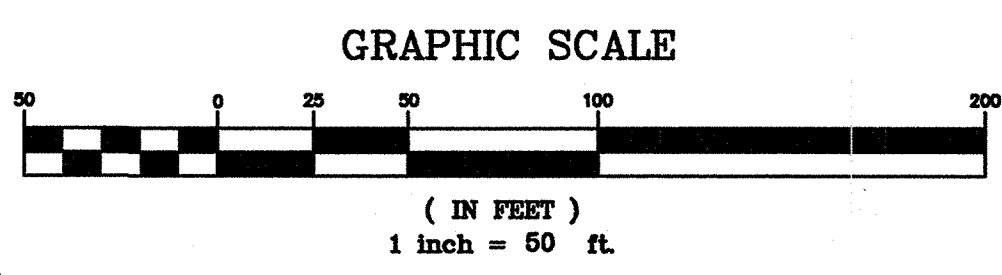

**LEGEND**

x 625.50	EDGE OF PAVEMENT SPOT ELEVATIONS
x 625.50	FINISH GROUND SPOT ELEVATIONS
→	DIRECTION OF FLOW
— 625 —	PROPOSED CONTOURS
- - - 625 - - -	EXISTING CONTOURS

**NTMWD NOTES**

- North Texas Municipal Water District (NTMWD) 42-inch and 20-inch water transmission pipelines are located within the limits of the construction.
- Operation of heavy earthmoving equipment, compaction equipment or heavy construction equipment, such as concrete trucks, shall be restricted to specific crossing points across NTMWD easements, as approved by the NTMWD. The crossings shall be designated and verified to provide a minimum of five feet of cover.
- To assure that placing of significant loads over the NTMWD pipeline does not damage the existing pipeline, no materials shall be stockpiled on the NTMWD easement, without authorization from the NTMWD. If the contractor desires to use NTMWD's easement for stockpile of materials, contact NTMWD Engineering at (972) 442-5405 so your plans for use of NTMWD's easement can be reviewed.
- In areas where the cover between the top of the NTMWD pipeline and the bottom of the sub-grade is three (3) feet or less, it is requested that the sub-grade preparation be deleted and thickened pavement section be used to limit construction activities over the pipeline.
- Crossing of the NTMWD easement with other utilities, such as TV cable, phone, gas and electric, shall be coordinated with the NTMWD to avoid damage to the NTMWD facilities.
- Outdoor lighting, landscaping, screening walls or other facilities shall not be installed in NTMWD easements without written approval of the NTMWD.
- Unless otherwise shown or required a minimum of one-foot clearance shall be provided for all utilities crossing the NTMWD pipelines.
- The contractor shall contact NTMWD Engineering at (972) 442-5405 at least 48 hours prior to performing any work in the vicinity of the NTMWD facilities.
- Water and Sewer lines crossing the NTMWD easements shall be installed in compliance with the Rules and Regulations for Public Water Systems, Paragraphs 290.44 (e), Location of Water Lines.
- Septic systems are not permitted within NTMWD easements.
- Excavation adjacent to NTMWD pipelines, manholes and other appurtenances to install proposed improvements shall be performed so that the manholes, pipelines or appurtenances are not displaced or damaged. Any damage to the manholes, pipelines or appurtenances shall be repaired to the satisfaction of the NTMWD. Further, any cost for repair of damage to the manholes, pipelines or appurtenances resulting from construction by the developer or contractor will be the responsibility for the developer.

**CAUTION:** Existing underground utilities. Contractor to field verify the location of all existing utilities prior to excavation.

**NOTE:** Trees along east property line shall be protected.

(MATCH LINE SEE SHEET 11)

- BENCHMARKS:**
- 1/2" IR, W of Ingram Rd. +- 1025' N of N edge of Lucas Rd. +- 6' E of fence. Elev. 637.08
  - 1/2" IR, E of Ingram Rd. +- 2650' N of N edge of Lucas Rd. +- 28' E & 37' N of fence corner. Elev. 639.20

NO.	REVISIONS DURING CONSTRUCTION	BY	DATE	NO.	REVISIONS DURING PLAN REVIEW	BY	DATE
1	Revise Entrance Paving and Landscape Berms.	JMW	2/13/01	1	Adjust the proposed contours.	JMW	11/30/00
				2	Lower berm, raise pads, create swale along west.	JMW	12/8/00
				3	Create two detention ponds for storage.	JMW	12/18/00
				4	Show existing topo. information at exit point.	JMW	12/19/00
				5	ADDED NOTES TO NTMWD NOTES	CMG	01/05/01

The seal appearing on this document was authorized by Thomas K. Junn, P.E. 81799 on Feb. 13, 2001. Alteration of a sealed document without proper notification to the responsible engineer is an offense under the Texas Engineering Practice Act.

2/13/01

**Jones & Boyd, Inc.**  
 16800 Dallas Parkway, Suite 240  
 Dallas, Texas 75248  
 Tel: 972-248-7676  
 Fax: 972-248-1414

<b>GRADING PLAN</b>		PROJECT NO.
Details		SK403
<b>SADDLEBROOK</b>		SHEET NO.
City of Lucas, Collin County, Texas		10

Plot info: Drawing: H:\Projects\SK403.dwg SK403OR.dwg 2/7/01 Plot date: 2/7/01 Plot time: 3:32 pm

(MATCH LINE SEE SHEET 10)

DR. L.W. BARNETT  
VOL. 92-0024492

ALLEN ISD VOL.  
1454, PG. 527

ALLEN ISD VOL.  
1002, PG. 128

KENNETH E. JONES & WIFE  
DOROTHY E. JONES  
VOL. 699, PG. 759

ROY LEWIS  
JEFFERY  
ANDRESS,  
VOL. 4450,  
PG. 2615

CITY OF LUCAS, VOL.  
2896, PG. 943


DONALD  
LARKIN VOL.  
1160, PG.  
583

BOBBY N. KIRKPATRICK  
94-0063531

VOL. 3961, PG.  
1383 GROUP  
INC. INTERSTATE  
INVESTMENT

83  
TMENT

RECORD DRAWING  
THIS DRAWING HAS BEEN REVISED  
TO REFLECT THE ACTUAL  
CONSTRUCTION DETAILS AS  
CONTAINED IN THE RECORDS OF THE  
CONTRACTOR. ELEVATIONS SHOWN ON  
THIS PLAN WERE NOT FIELD VERIFIED.  
JONES & BOYD, INC.  
BY: [Signature]  
DATE: 8/28/01

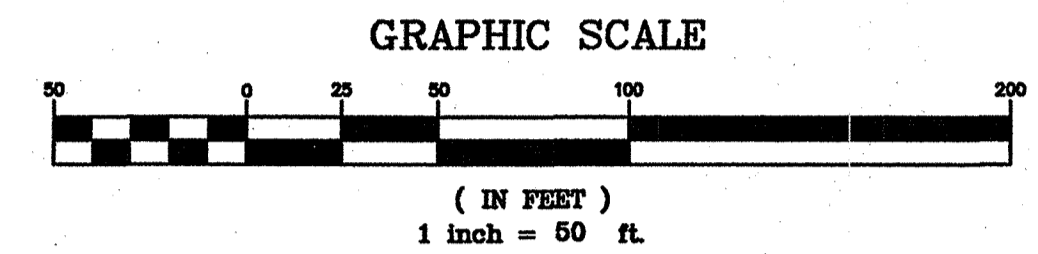

- LEGEND**
- x 625.50 EP EDGE OF PAVEMENT SPOT ELEVATIONS
  - x 625.50 FINISH GROUND SPOT ELEVATIONS
  - DIRECTION OF FLOW
  - - - 625 PROPOSED CONTOURS
  - - - 625 EXISTING CONTOURS

**NTMWD NOTES**

- North Texas Municipal Water District (NTMWD) 42-inch and 20-inch water transmission pipelines are located within the limits of the construction.
- Operation of heavy earthmoving equipment, compaction equipment or heavy construction equipment, such as concrete trucks, shall be restricted to specific crossing points across NTMWD easements, as approved by the NTMWD. The crossings shall be designated and verified to provide a minimum of five feet of cover.
- To assure that placing of significant loads over the NTMWD pipeline does not damage the existing pipeline, no materials shall be stockpiled on the NTMWD easement, without authorization from the NTMWD. If the contractor desires to use NTMWD's easement for stockpile of materials, contact NTMWD Engineering at (972) 442-5405 so your plans for use of NTMWD's easement can be reviewed.
- In areas where the cover between the top of the NTMWD pipeline and the bottom of the sub-grade is three (3) feet or less, it is requested that the sub-grade preparation be deleted and thickened pavement section be used to limit construction activities over the pipeline.
- Crossing of the NTMWD easement with other utilities, such as TV cable, phone, gas and electric, shall be coordinated with the NTMWD to avoid damage to the NTMWD facilities.
- Outdoor lighting, landscaping, screening walls or other facilities shall not be installed in NTMWD easements without written approval of the NTMWD.
- Unless otherwise shown or required a minimum of one-foot clearance shall be provided for all utilities crossing the NTMWD pipelines.
- The contractor shall contact NTMWD Engineering at (972) 442-5405 at least 48 hours prior to performing any work in the vicinity of the NTMWD facilities.
- Water and Sewer lines crossing the NTMWD easements shall be installed in compliance with the Rules and Regulations for Public Water Systems, Paragraphs 290.44 (e), Location of Water Lines.
- Septic systems are not permitted within NTMWD easements.
- Excavation adjacent to NTMWD pipelines, manholes and other appurtenances to install proposed improvements shall be performed so that the manholes, pipelines or appurtenances are not displaced or damaged. Any damage to the manholes, pipelines or appurtenances shall be repaired to the satisfaction of the NTMWD. Further, any cost for repair of damage to the manholes, pipelines or appurtenances resulting from construction by the developer or contractor will be the responsibility for the developer.


NOTE: Trees along east property line shall be protected.

(MATCH LINE SEE SHEET 12)

- BENCHMARKS:**
- 1" 1/2" IR, W of Ingram Rd. +- 1025' N of N edge of Lucas Rd. +- 6' E of fence. Elev. 637.08
  - 2" 1/2" IR, E of Ingram Rd. +- 2850' N of N edge of Lucas Rd. +- 28' E & 37' N of fence corner. Elev. 639.20

NO.	REVISIONS DURING CONSTRUCTION	BY	DATE	NO.	REVISIONS DURING PLAN REVIEW	BY	DATE
4	ADDED NOTES TO NTMWD NOTES	CMG	01/05/01	5			
4	Revise proposed contours along east boundary.	JMW	12/19/00	3	Create two detention ponds for storage.	JMW	12/18/00
3				2	Add tree note, swale along west, street names.	JMW	12/8/00
2				1	Adjust the proposed contours.	JMW	11/30/00


The seal appearing on this document was authorized by Thomas K. Juhn, P.E. 81799 on Jan. 05, 2001. Alteration of a sealed document without proper notification to the responsible engineer is an offense under the Texas Engineering Practice Act.

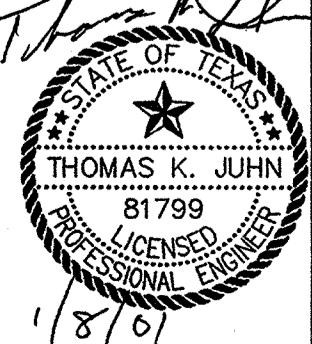

**Jones & Boyd, Inc.**  
16800 Dallas Parkway, Suite 240  
Dallas, Texas 75248  
Tel: 972-248-7676  
Fax: 972-248-1414

<b>GRADING PLAN</b>		PROJECT NO.
Details		SK403
<b>SADDLEBROOK</b>		SHEET NO.
City of Lucas, Collin County, Texas		11

Plot time: 3:54 pm  
Plot date: 1/5/01  
Plotted by: CMG  
Drawing: H:\Projects\SK403\dwg\SK403GR.dwg

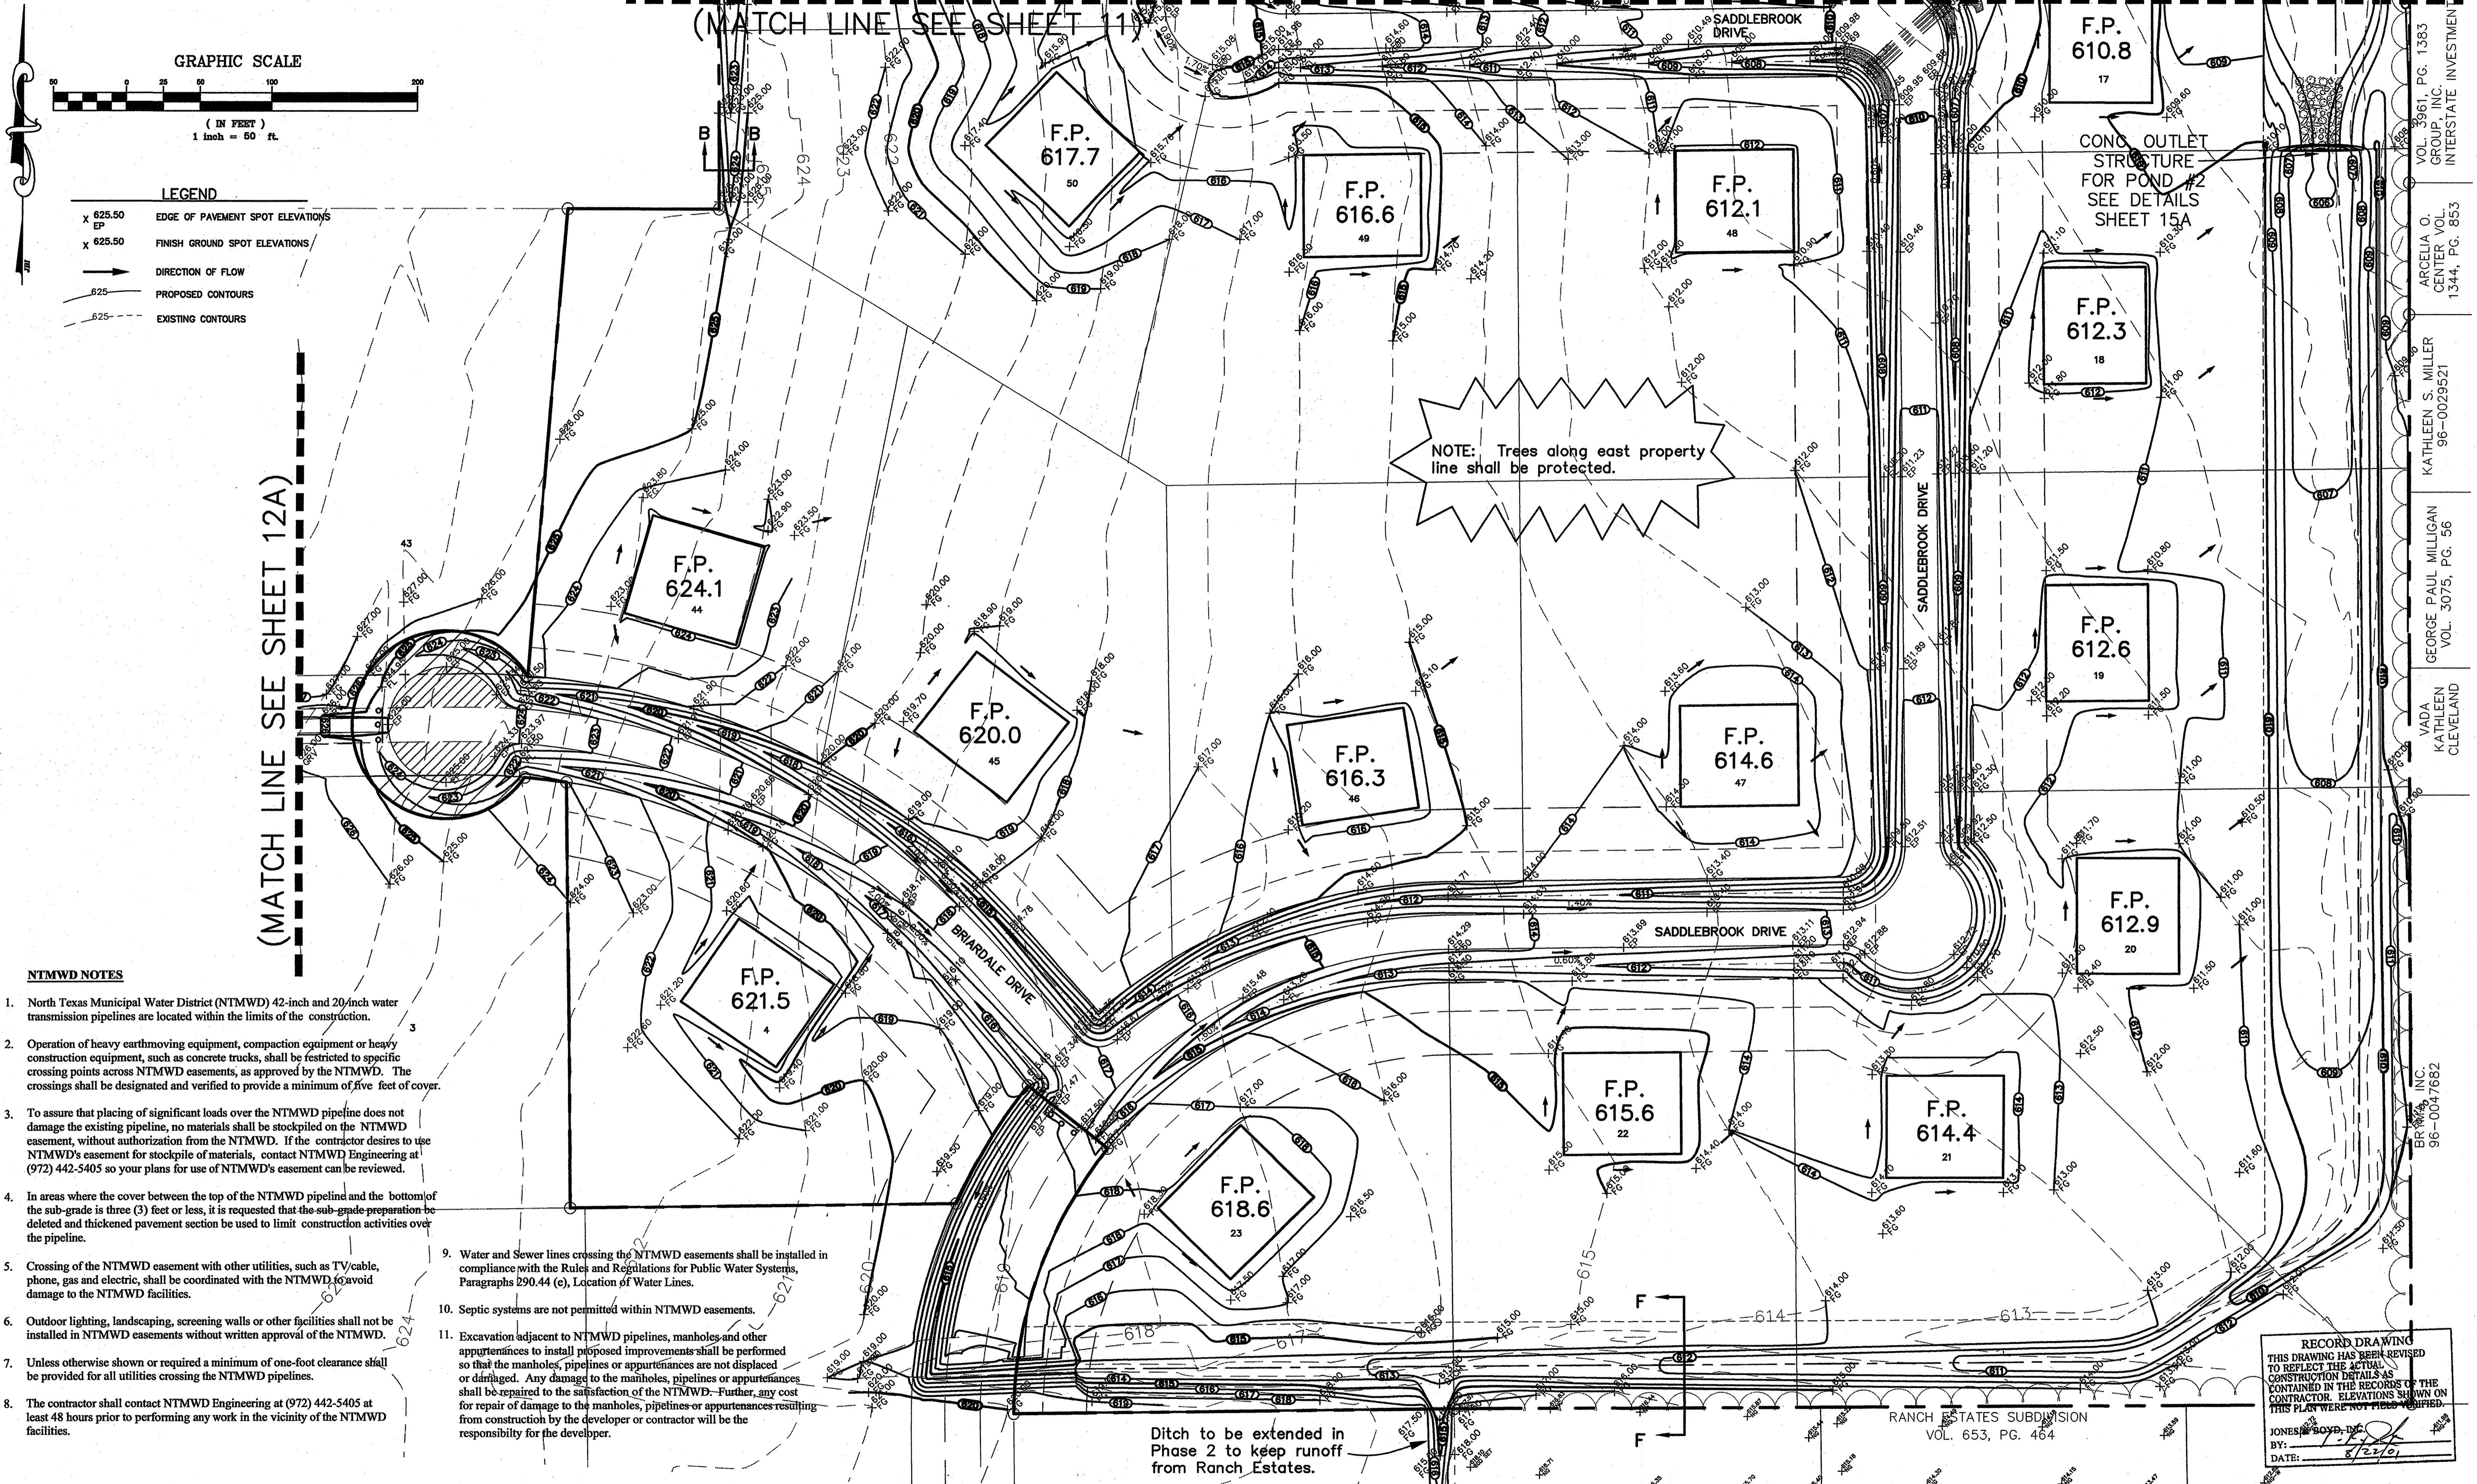

GRAPHIC SCALE

( IN FEET )  
1 inch = 50 ft.

LEGEND

- X 625.50 EDGE OF PAVEMENT SPOT ELEVATIONS
- x 625.50 FINISH GROUND SPOT ELEVATIONS
- DIRECTION OF FLOW
- 625- PROPOSED CONTOURS
- 625- EXISTING CONTOURS

MATCH LINE SEE SHEET 12A

NTMWD NOTES

1. North Texas Municipal Water District (NTMWD) 42-inch and 20-inch water transmission pipelines are located within the limits of the construction.
2. Operation of heavy earthmoving equipment, compaction equipment or heavy construction equipment, such as concrete trucks, shall be restricted to specific crossing points across NTMWD easements, as approved by the NTMWD. The crossings shall be designated and verified to provide a minimum of five feet of cover.
3. To assure that placing of significant loads over the NTMWD pipeline does not damage the existing pipeline, no materials shall be stockpiled on the NTMWD easement, without authorization from the NTMWD. If the contractor desires to use NTMWD's easement for stockpile of materials, contact NTMWD Engineering at (972) 442-5405 so your plans for use of NTMWD's easement can be reviewed.
4. In areas where the cover between the top of the NTMWD pipeline and the bottom of the sub-grade is three (3) feet or less, it is requested that the sub-grade preparation be deleted and thickened pavement section be used to limit construction activities over the pipeline.
5. Crossing of the NTMWD easement with other utilities, such as TV/cable, phone, gas and electric, shall be coordinated with the NTMWD to avoid damage to the NTMWD facilities.
6. Outdoor lighting, landscaping, screening walls or other facilities shall not be installed in NTMWD easements without written approval of the NTMWD.
7. Unless otherwise shown or required a minimum of one-foot clearance shall be provided for all utilities crossing the NTMWD pipelines.
8. The contractor shall contact NTMWD Engineering at (972) 442-5405 at least 48 hours prior to performing any work in the vicinity of the NTMWD facilities.
9. Water and Sewer lines crossing the NTMWD easements shall be installed in compliance with the Rules and Regulations for Public Water Systems, Paragraphs 290.44 (e), Location of Water Lines.
10. Septic systems are not permitted within NTMWD easements.
11. Excavation adjacent to NTMWD pipelines, manholes and other appurtenances to install proposed improvements shall be performed so that the manholes, pipelines or appurtenances are not displaced or damaged. Any damage to the manholes, pipelines or appurtenances shall be repaired to the satisfaction of the NTMWD. Further, any cost for repair of damage to the manholes, pipelines or appurtenances resulting from construction by the developer or contractor will be the responsibility for the developer.

NOTE: Trees along east property line shall be protected.


Ditch to be extended in Phase 2 to keep runoff from Ranch Estates.

RECORD DRAWING  
THIS DRAWING HAS BEEN REVISED TO REFLECT THE ACTUAL CONSTRUCTION DETAILS AS CONTAINED IN THE RECORDS OF THE CONTRACTOR. ELEVATIONS SHOWN ON THIS PLAN WERE NOT FIELD VERIFIED.  
BY: JONES & BOYD, INC.  
DATE: 12/2/01

- BENCHMARKS:
1. "T" 1/2" IR, W of Ingram Rd. +- 1025' N of N edge of Lucas Rd. +- 6' E of fence. Elev. 637.08
  2. "T" 1/2" IR, E of Ingram Rd. +- 2650' N of N edge of Lucas Rd. +- 28' E & 37' N of fence corner. Elev. 639.20

NO.	REVISIONS DURING CONSTRUCTION	BY	DATE	NO.	REVISIONS DURING PLAN REVIEW	BY	DATE
				5	ADDED NOTES TO NTMWD NOTES	CMG	01/05/01
				4	Show drainage swale to the south.	JMW	12/19/00
				3	Create two detention ponds for storage.	JMW	12/18/00
				2	Add tree protection note, update street names.	JMW	12/8/00
				1	Adjust the proposed contours.	JMW	11/30/00

The seal appearing on this document was authorized by Thomas K. Juhn, P.E. 81799 on Jan. 05, 2001. Alteration of a sealed document without proper notification to the responsible engineer is an offense under the Texas Engineering Practice Act.

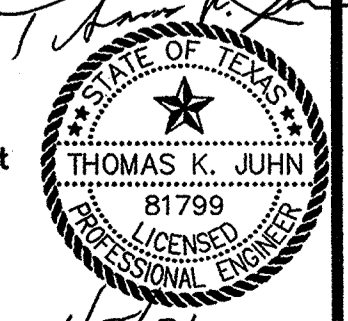


**Jones & Boyd, Inc.**  
16800 Dallas Parkway, Suite 240  
Dallas, Texas 75248  
Tel: 972-248-7676  
Fax: 972-248-1414


<b>GRADING PLAN</b>		PROJECT NO.
Details		SK403
<b>SADDLEBROOK</b>		SHEET NO.
City of Lucas, Collin County, Texas		12

Drawing: H:\Projects\SK403\dwg\SK403GR.dwg Plotted by: CMG Plot date: 1/5/01 Plot time: 3:47 pm  
 BR 1000, INC. 96-0047662  
 VADA KATHLEEN CLEVELAND  
 GEORGE PAUL MILLICAN VOL. 3075, PG. 56  
 KATHLEEN S. MILLER 96-0029521  
 ARGELIA O. CENTER VOL. 1344, PG. 853  
 VOL. 3961, PG. 1383 GROUP, INC. INTERSTATE INVESTMENT

GRAPHIC SCALE

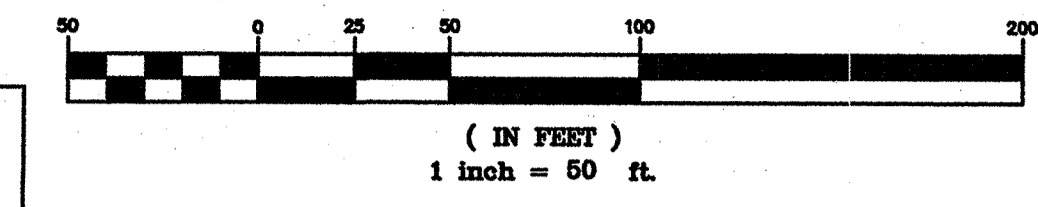


- LEGEND**
- x 625.50 EP EDGE OF PAVEMENT SPOT ELEVATIONS
  - x 625.50 FINISH GROUND SPOT ELEVATIONS
  - DIRECTION OF FLOW
  - 625— PROPOSED CONTOURS
  - - - 625 - - - EXISTING CONTOURS

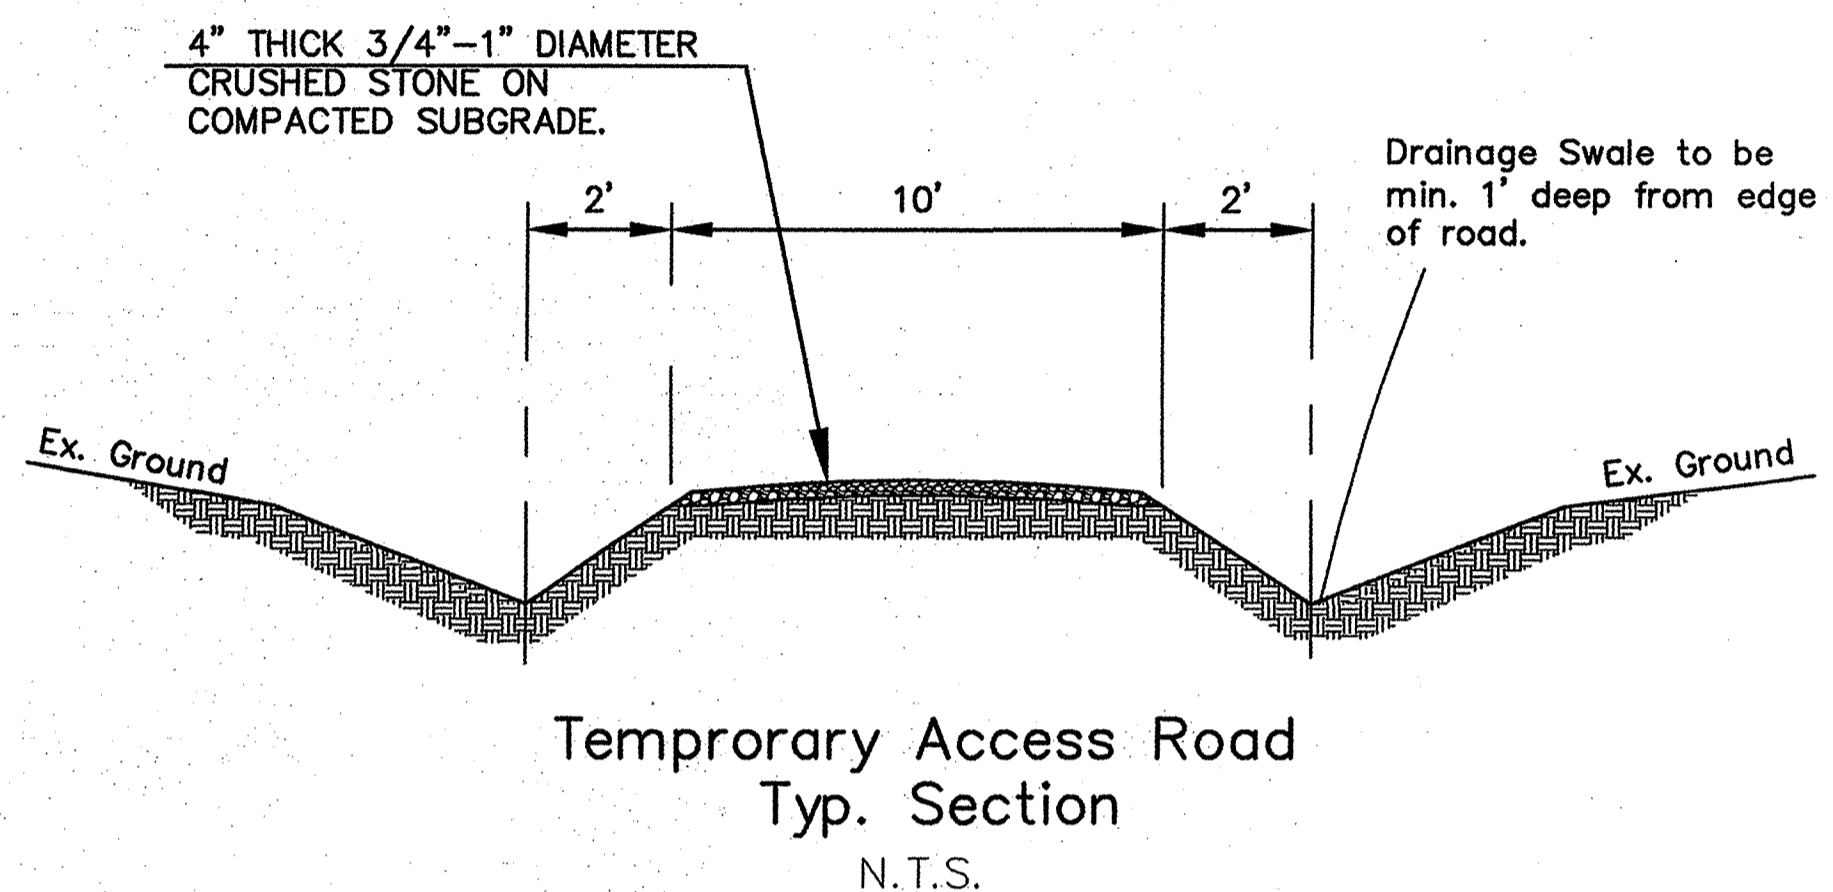

Temporary Access Road  
Typ. Section  
N.T.S.

**NTMWD NOTES**

1. North Texas Municipal Water District (NTMWD) 42-inch and 20-inch water transmission pipelines are located within the limits of the construction.
2. Operation of heavy earthmoving equipment, compaction equipment or heavy construction equipment, such as concrete trucks, shall be restricted to specific crossing points across NTMWD easements, as approved by the NTMWD. The crossings shall be designated and verified to provide a minimum of five feet of cover.
3. To assure that placing of significant loads over the NTMWD pipeline does not damage the existing pipeline, no materials shall be stockpiled on the NTMWD easement, without authorization from the NTMWD. If the contractor desires to use NTMWD's easement for stockpile of materials, contact NTMWD Engineering at (972) 442-5405 so your plans for use of NTMWD's easement can be reviewed.
4. In areas where the cover between the top of the NTMWD pipeline and the bottom of the sub-grade is three (3) feet or less, it is requested that the sub-grade preparation be deleted and thickened pavement section be used to limit construction activities over the pipeline.
5. Crossing of the NTMWD easement with other utilities, such as TV cable, phone, gas and electric, shall be coordinated with the NTMWD to avoid damage to the NTMWD facilities.
6. Outdoor lighting, landscaping, screening walls or other facilities shall not be installed in NTMWD easements without written approval of the NTMWD.
7. Unless otherwise shown or required a minimum of one-foot clearance shall be provided for all utilities crossing the NTMWD pipelines.
8. The contractor shall contact NTMWD Engineering at (972) 442-5405 at least 48 hours prior to performing any work in the vicinity of the NTMWD facilities.
9. Water and Sewer lines crossing the NTMWD easements shall be installed in compliance with the Rules and Regulations for Public Water Systems, Paragraphs 290.44 (e), Location of Water Lines.
10. Septic systems are not permitted within NTMWD easements.
11. Excavation adjacent to NTMWD pipelines, manholes and other appurtenances to install proposed improvements shall be performed so that the manholes, pipelines or appurtenances are not displaced or damaged. Any damage to the manholes, pipelines or appurtenances shall be repaired to the satisfaction of the NTMWD. Further, any cost for repair of damage to the manholes, pipelines or appurtenances resulting from construction by the developer or contractor will be the responsibility for the developer.

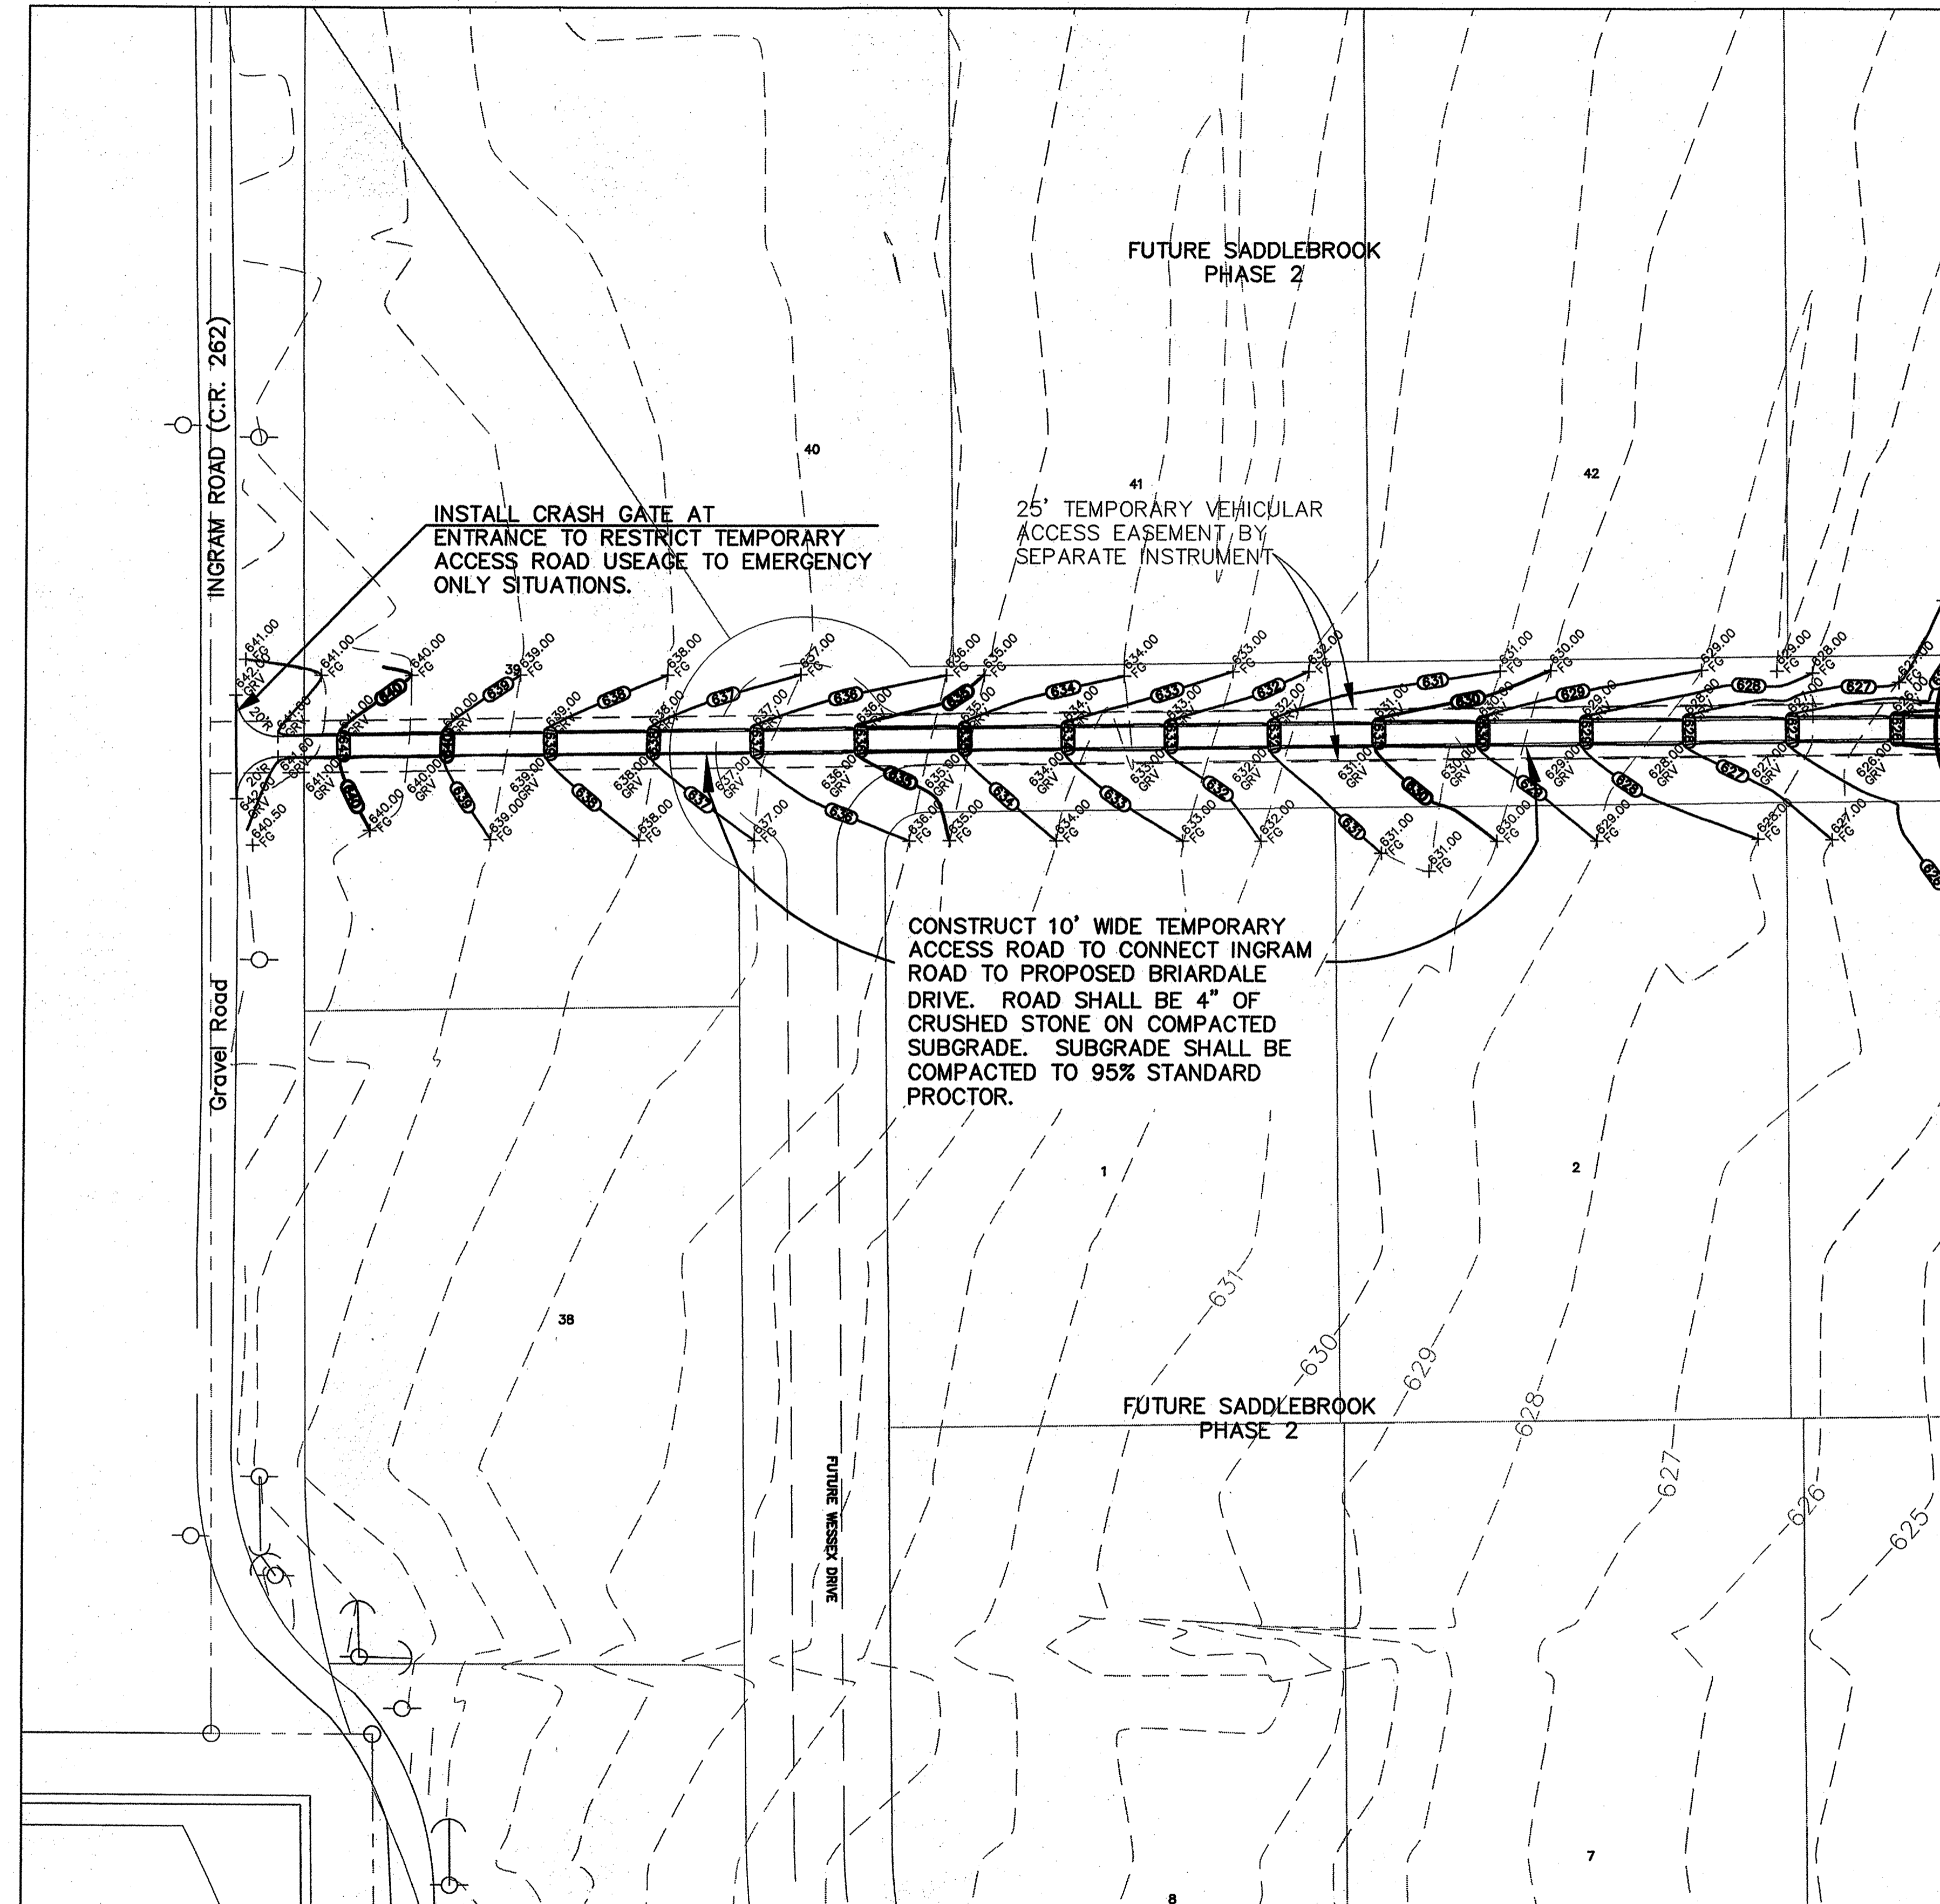

(MATCH LINE SEE SHEET 12A)

**RECORD DRAWING**  
 THIS DRAWING HAS BEEN REVISED TO REFLECT THE ACTUAL CONSTRUCTION DETAILS AS CONTAINED IN THE RECORDS OF THE CONTRACTOR. ELEVATIONS SHOWN ON THIS PLAN WERE NOT FIELD VERIFIED.  
 BY: *[Signature]*  
 DATE: 4/22/01

- BENCHMARKS:**
1. "T" 1/2" IR, W of Ingram Rd. +- 1025' N of N edge of Lucas Rd. +- 6' E of fence. Elev. 637.08
  2. "T" 1/2" IR, E of Ingram Rd. +- 2850' N of N edge of Lucas Rd. +- 28' E & 37' N of fence corner. Elev. 639.20


NO.	REVISIONS DURING CONSTRUCTION	BY	DATE	NO.	REVISIONS DURING PLAN REVIEW	BY	DATE
				3	ADDED NOTES TO NTMWD NOTES	CMG	01/05/01
				2	Add Typ. Section, Gate & Drainage.	CMG	12/19/00
				1	Add Temporary Access Road for Second Entrance.	JMW	12/18/00

The seal appearing on this document was authorized by Thomas K. Juhn, P.E. 81799 on Jan. 05, 2001. Alteration of a sealed document without proper notification to the responsible engineer is an offense under the Texas Engineering Practice Act.


**Jones & Boyd, Inc.**  
 16800 Dallas Parkway, Suite 240  
 Dallas, Texas 75248  
 Tel: 972-248-7676  
 Fax: 972-248-1414

**GRADING PLAN**  
**SADDLEBROOK**  
 City of Lucas, Collin County, Texas

PROJECT NO. SK403  
 SHEET NO. 12A

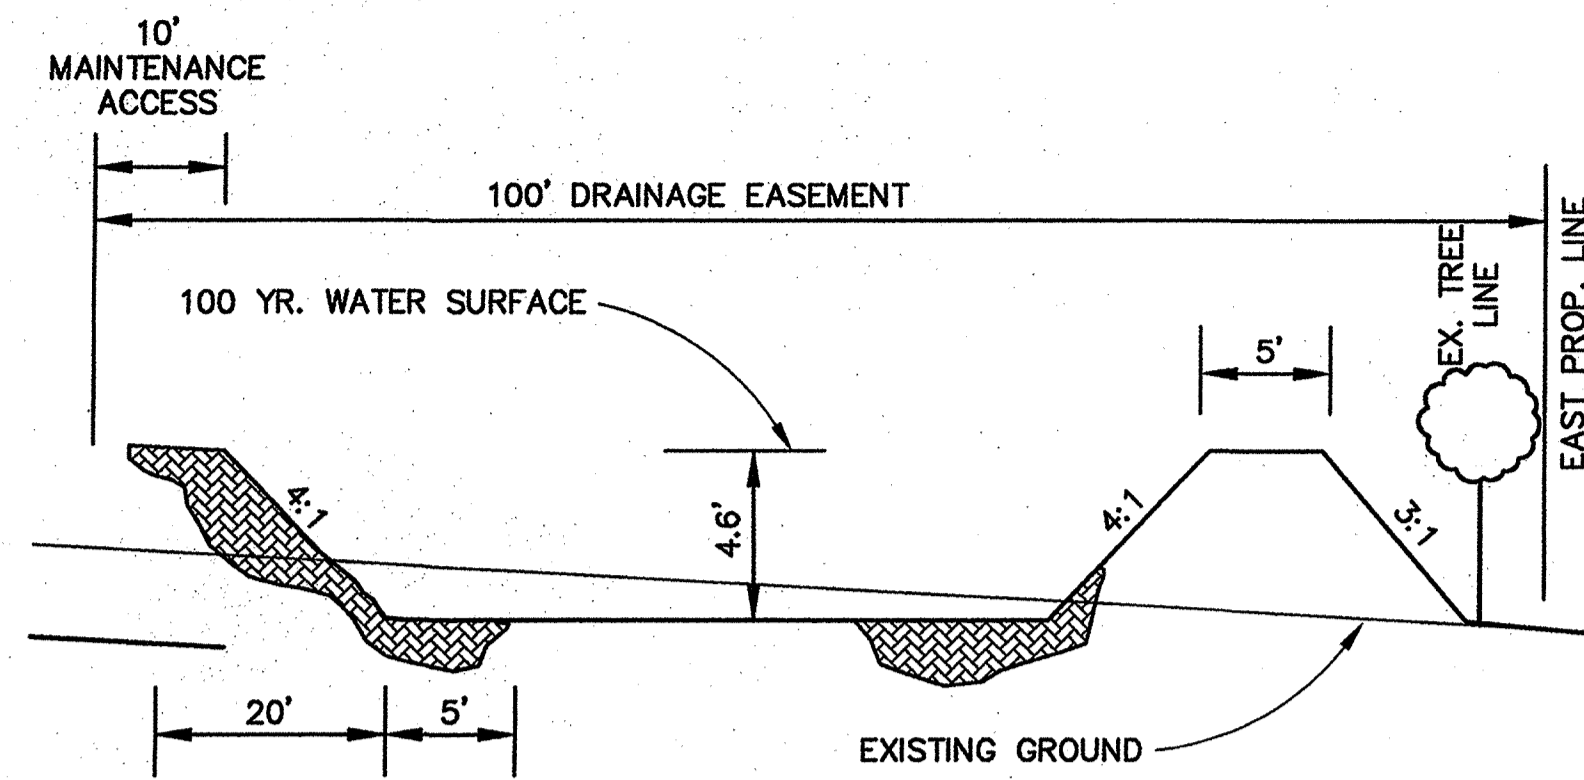


**TYPICAL DRY POND**  
**SECTION A-A**  
N.T.S.

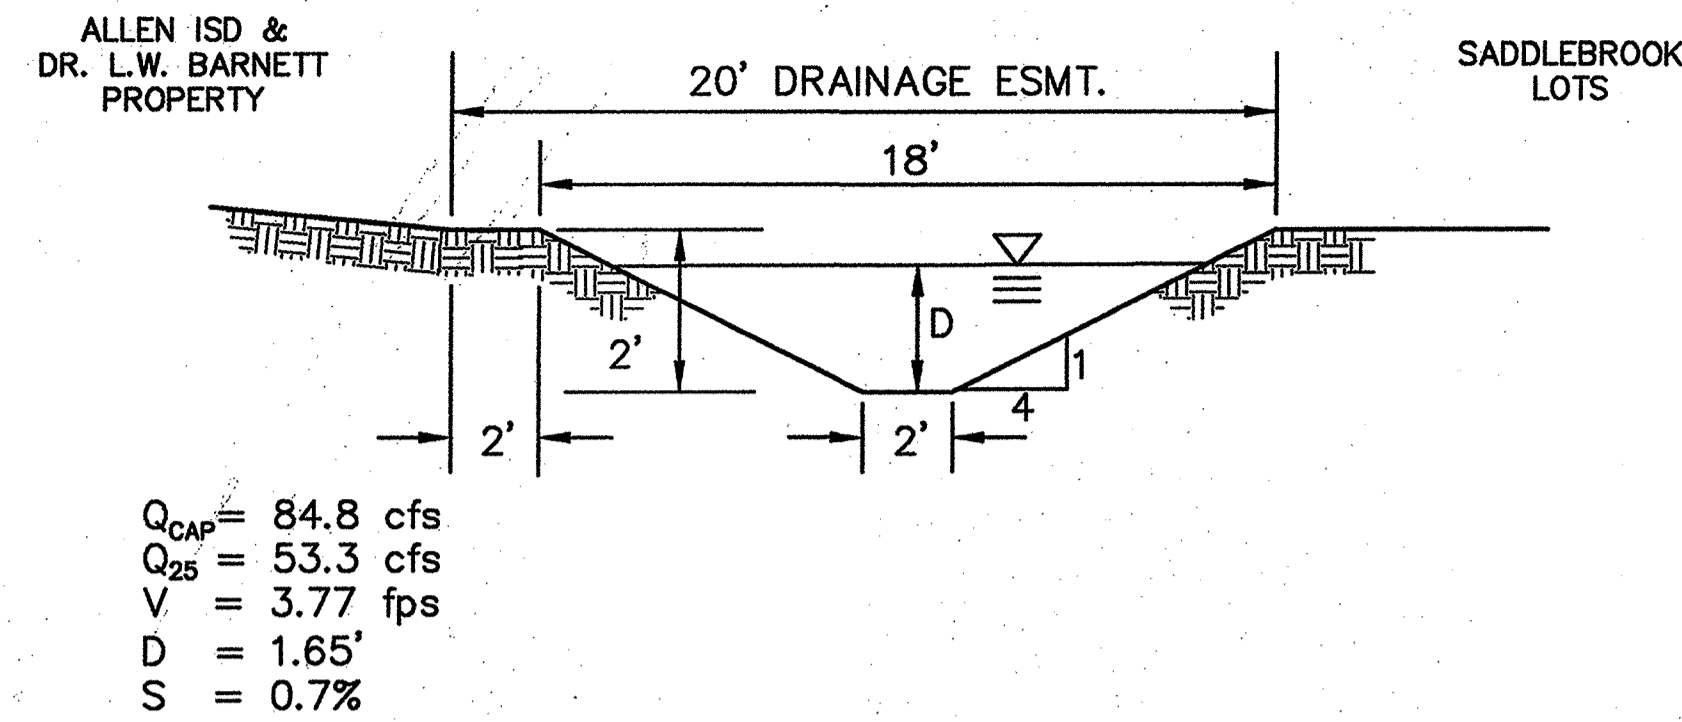


**SWALE ALONG WEST PROPERTY LINE**  
**SECTION B-B**  
N.T.S.

$Q_{CAP} = 84.8$  cfs  
 $Q_{25} = 53.3$  cfs  
 $V = 3.77$  fps  
 $D = 1.65'$   
 $S = 0.7\%$

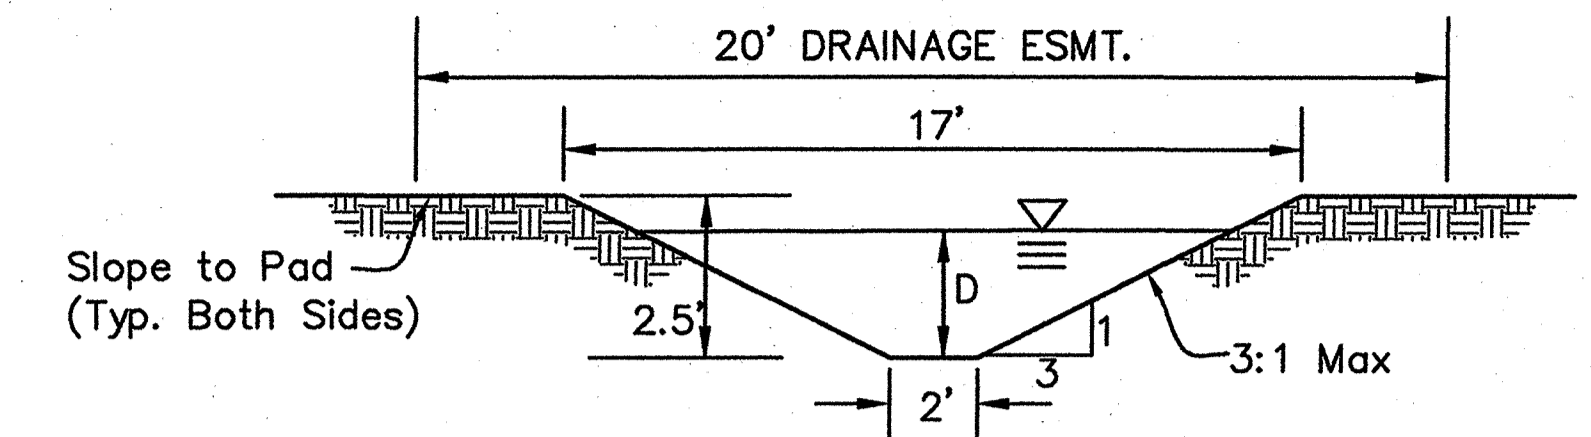


**CHANNEL SECTION C-C**  
N.T.S.

$Q_{CAP} = 100.8$  cfs  
 $Q_{25} = 29.2$  cfs  
 $V = 3.10$  fps  
 $D = 1.47'$   
 $S = 0.5\%$

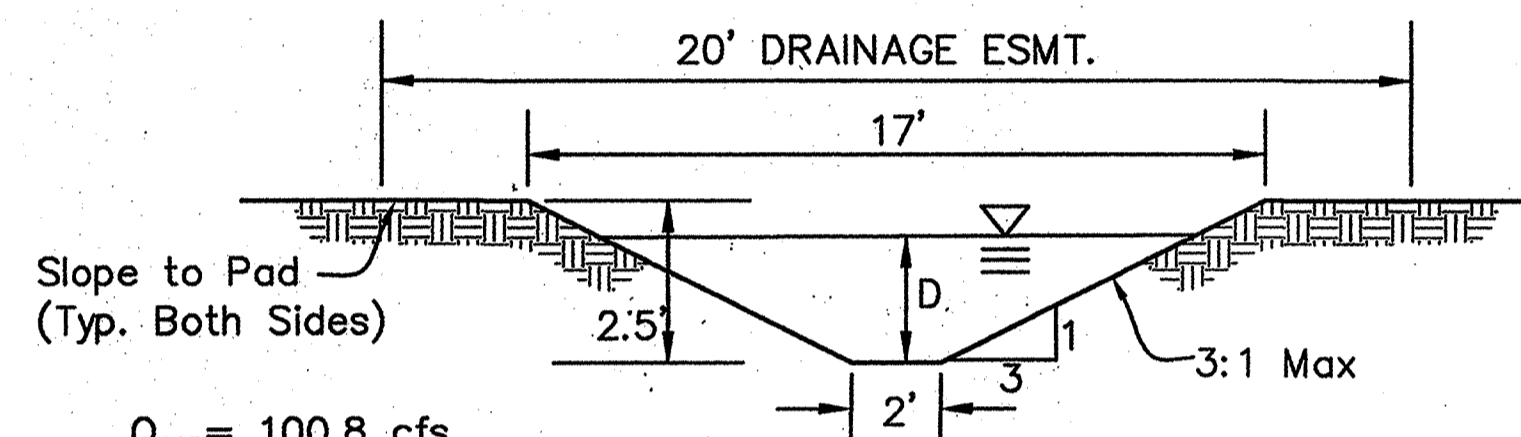


**CHANNEL SECTION D-D**  
N.T.S.

$Q_{CAP} = 100.8$  cfs  
 $Q_{25} = 30.7$  cfs  
 $V = 3.14$  fps  
 $D = 1.50'$   
 $S = 0.5\%$

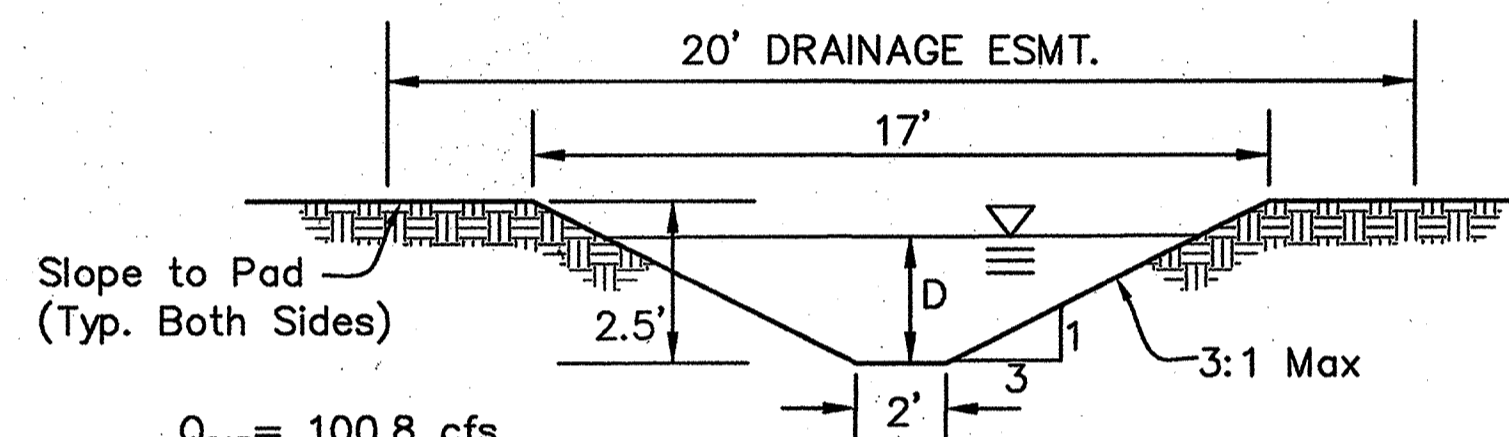


**CHANNEL SECTION E-E**  
N.T.S.

$Q_{CAP} = 100.8$  cfs  
 $Q_{25} = 76.0$  cfs  
 $V = 3.95$  fps  
 $D = 2.22'$   
 $S = 0.5\%$

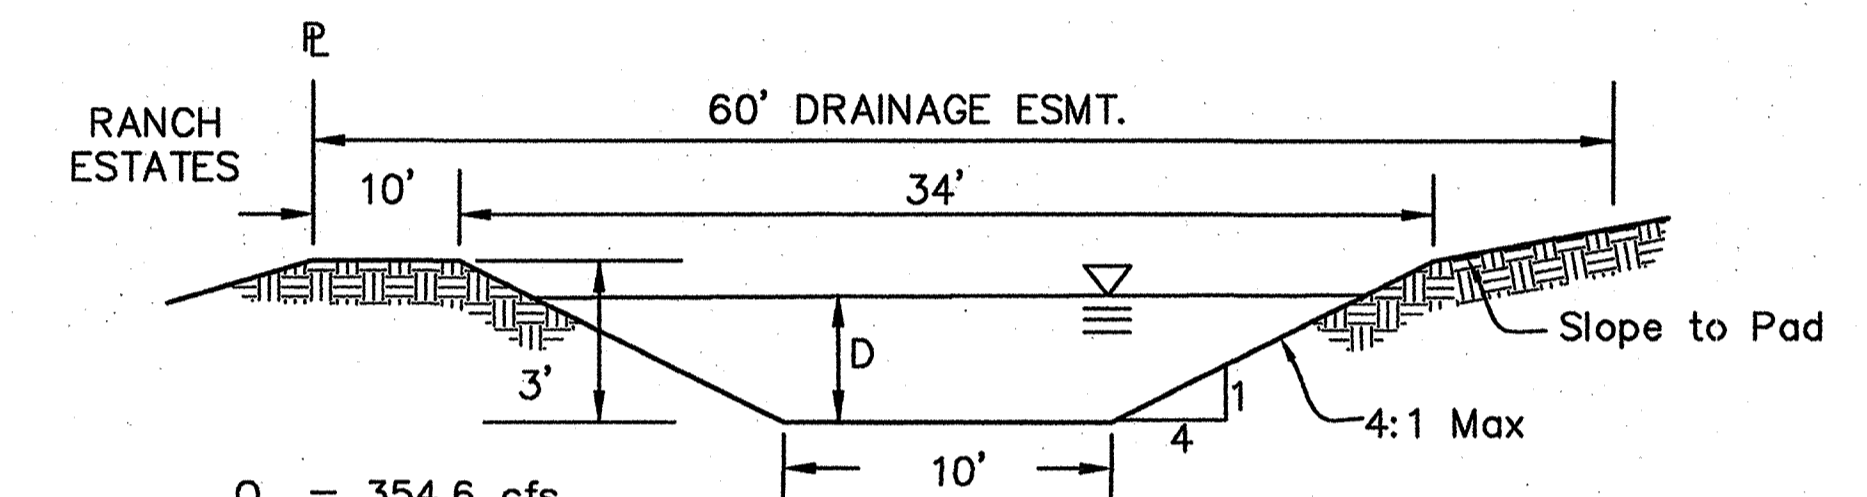

**CHANNEL SECTION F-F**  
N.T.S.

$Q_{CAP} = 354.6$  cfs  
 $Q_{25} = 134$  cfs  
 $V = 4.13$  fps  
 $D = 1.86'$   
 $S = 0.5\%$


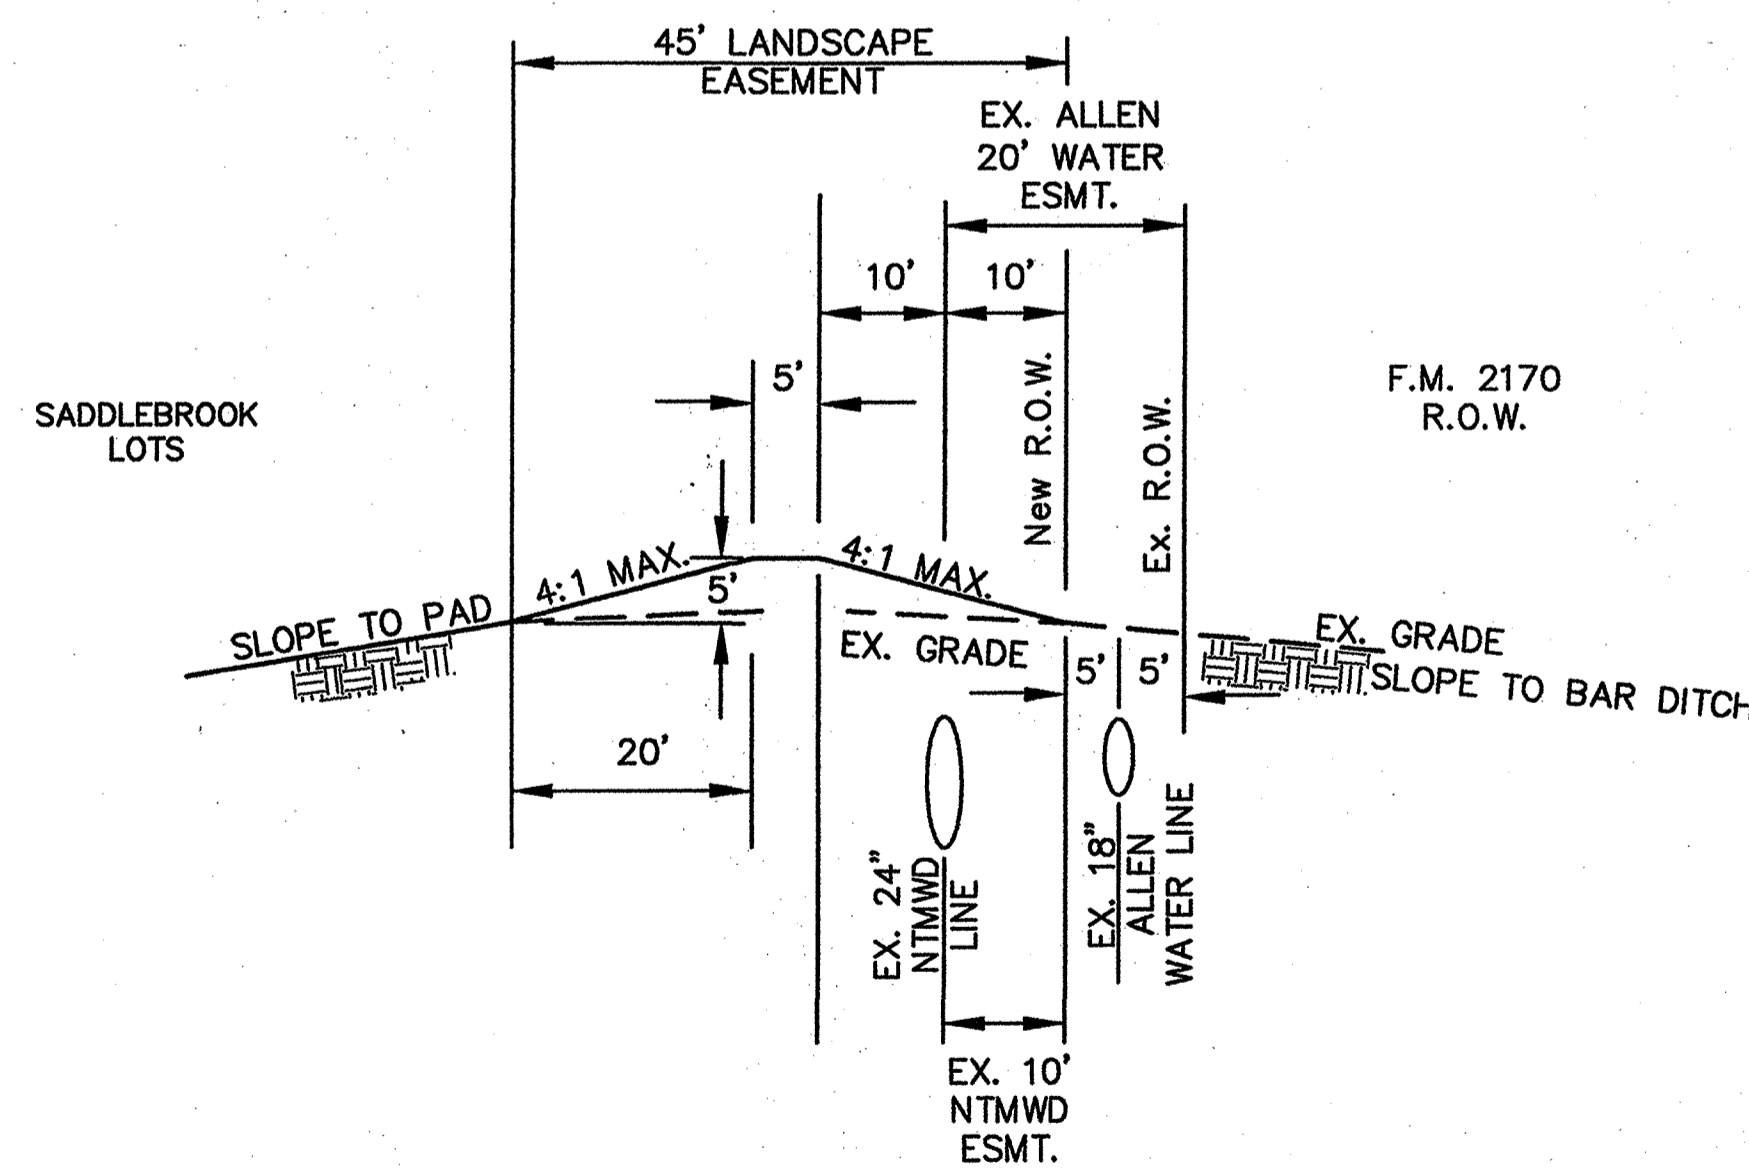


**BERM ALONG NORTH PROPERTY LINE**  
**SECTION G-G**  
N.T.S.

RECORD DRAWING  
THIS DRAWING HAS BEEN REVISED TO REFLECT THE ACTUAL CONSTRUCTION DETAILS AS CONTAINED IN THE RECORDS OF THE CONTRACTOR. ELEVATIONS SHOWN ON THIS PLAN WERE NOT FIELD VERIFIED.  
JONES & BOYD, INC.  
BY: [Signature]  
DATE: 8/23/01

NO.	REVISIONS DURING CONSTRUCTION	BY	DATE	NO.	REVISIONS DURING PLAN REVIEW	BY	DATE
				1	Adjust the proposed contours.	JMW	11/30/00



The seal appearing on this document was authorized by Thomas K. Juhn, P.E. 81799 on Dec. 08, 2000. Alteration of a sealed document without proper notification to the responsible engineer is an offense under the Texas Engineering Practice Act.

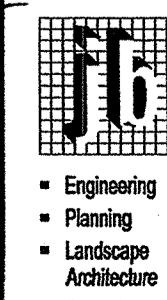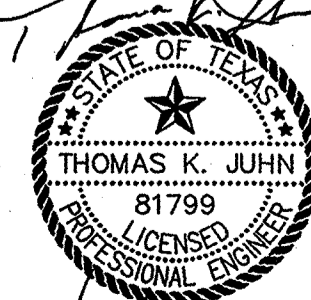


**Jones & Boyd, Inc.**  
16800 Dallas Parkway, Suite 240  
Dallas, Texas 75248  
Tel: 972-248-7676  
Fax: 972-248-1414

<b>TYPICAL SECTIONS</b>		PROJECT NO.
<b>BERMS &amp; SWALES</b>		SK403
<b>SADDLEBROOK</b>		SHEET NO.
City of Lucas, Collin County, Texas		13




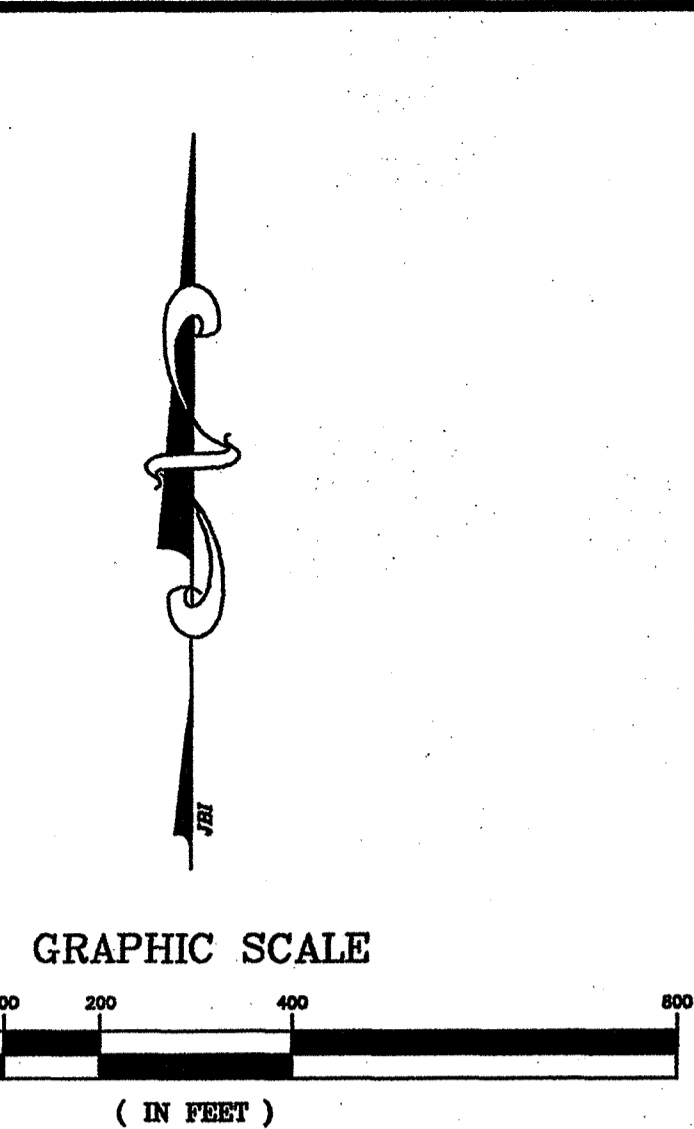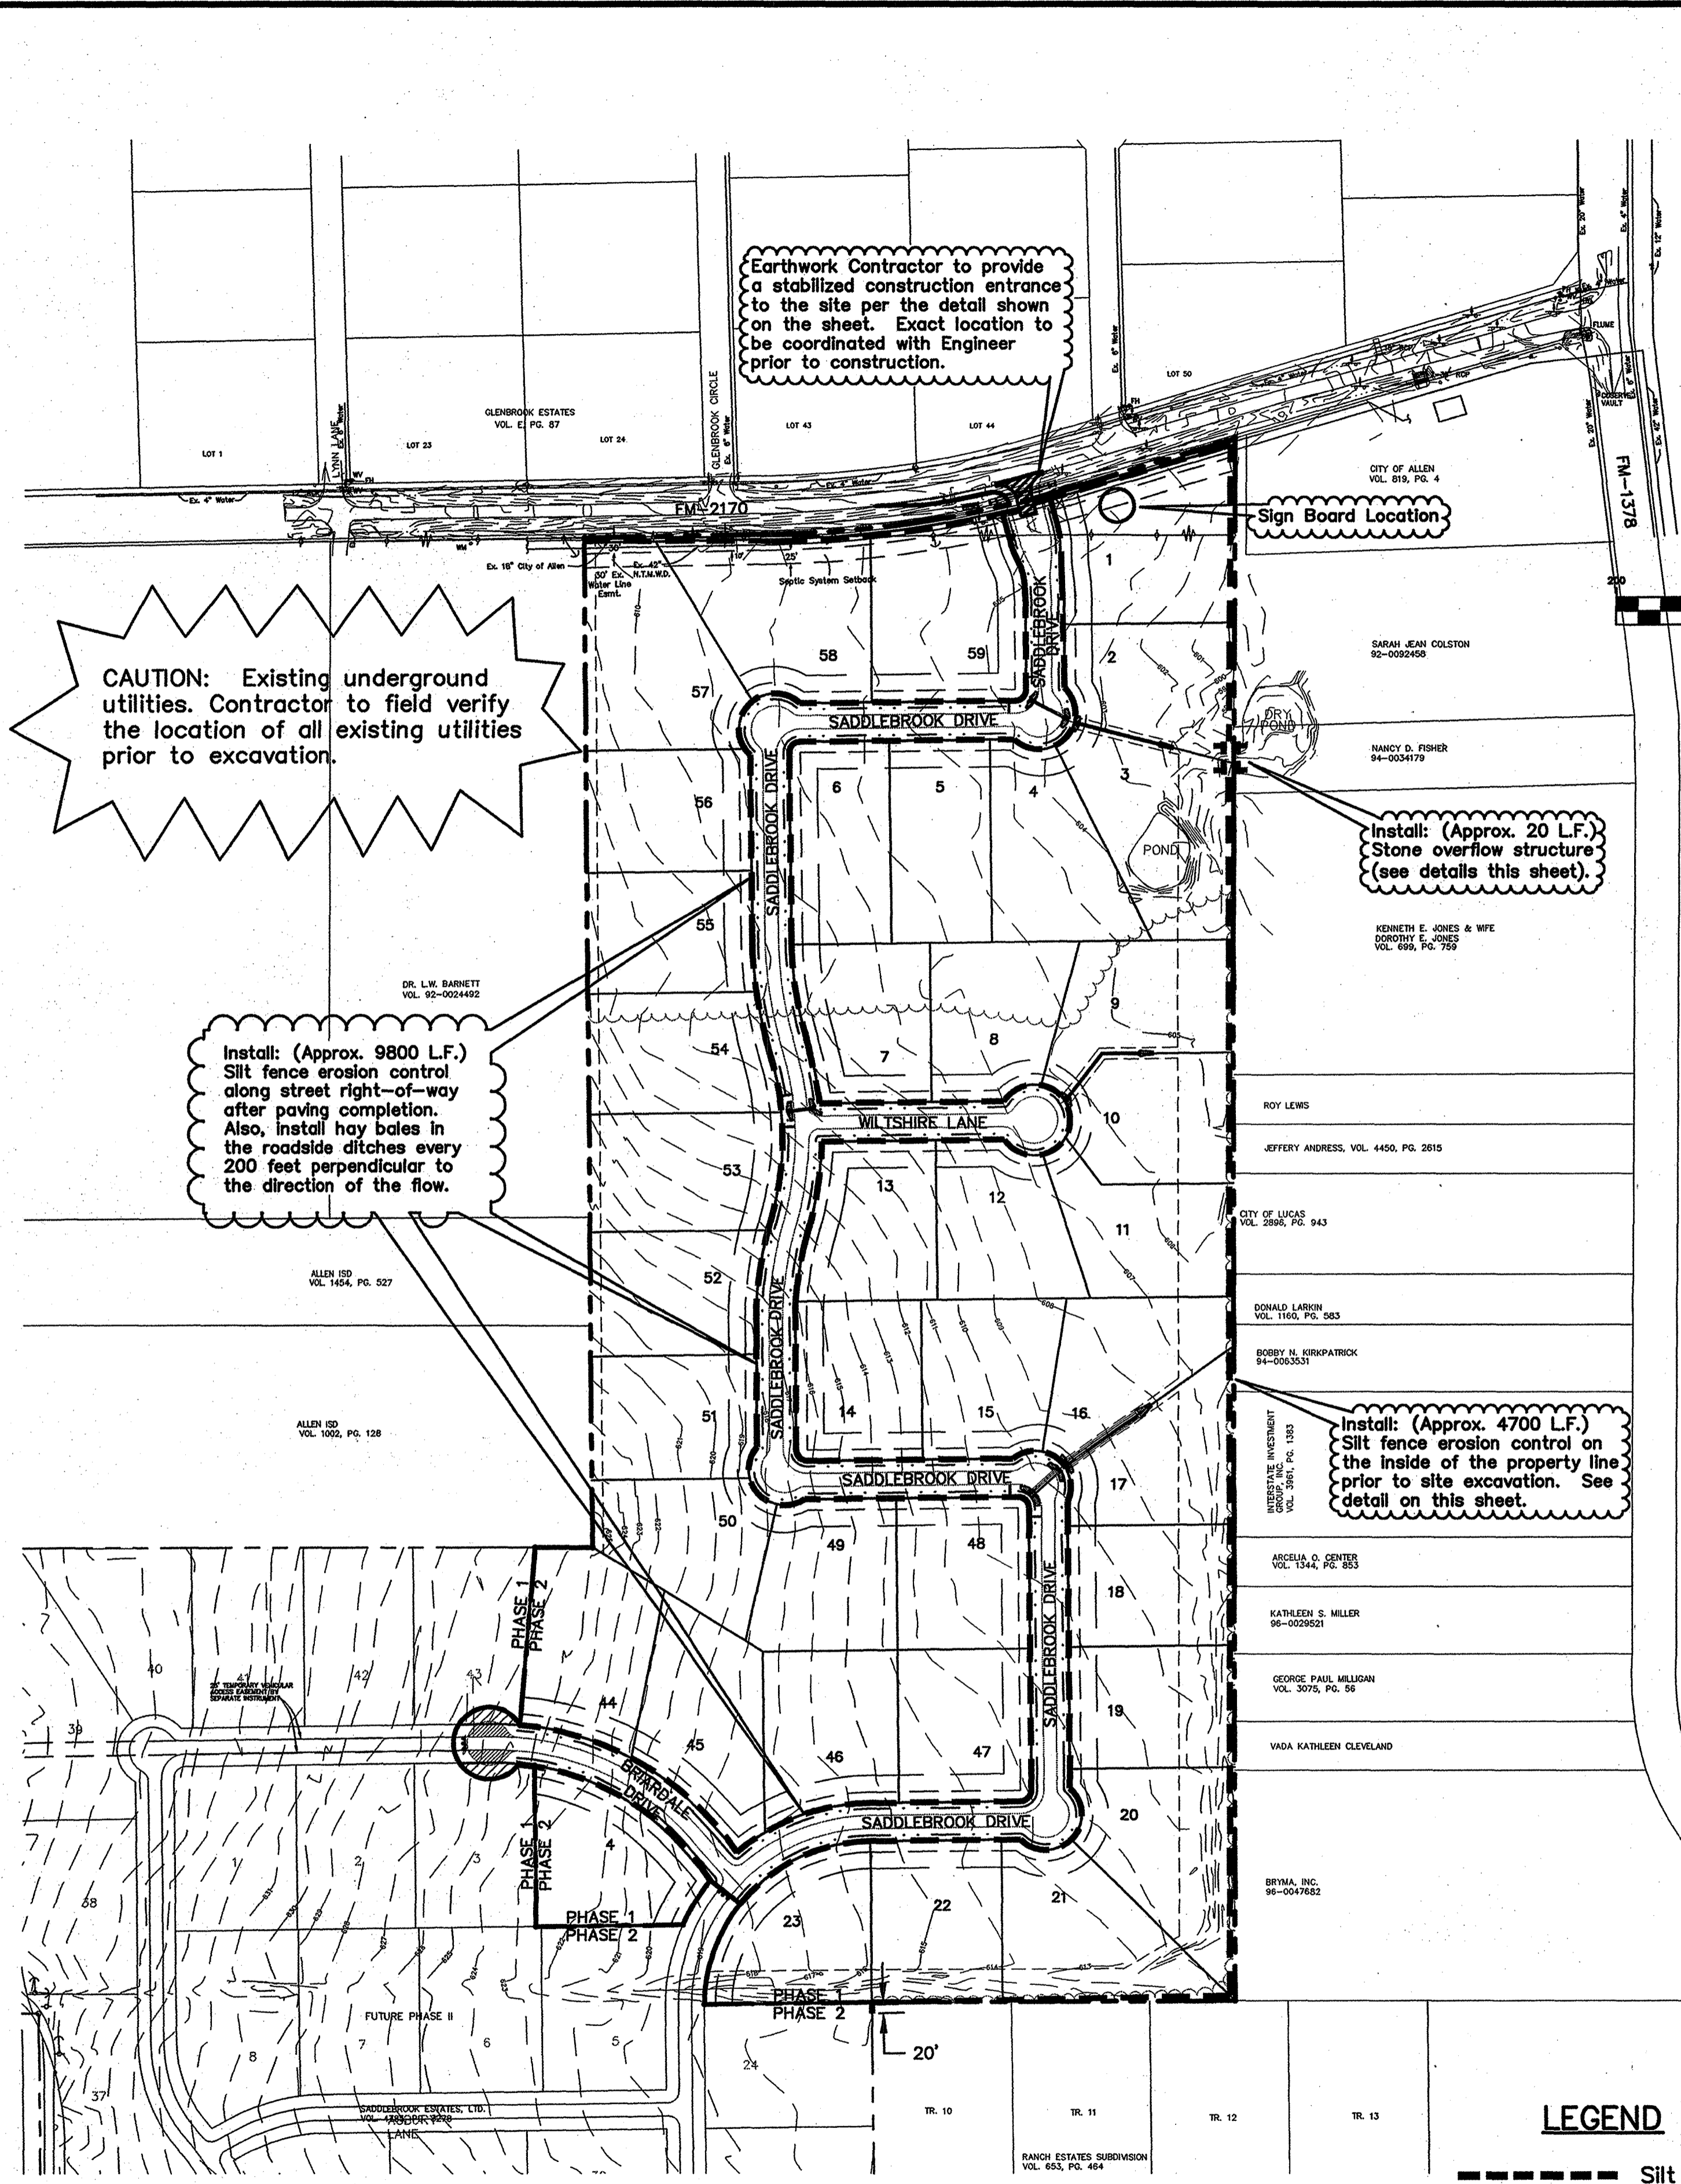

All Erosion Control Shall Be Maintained By Developer Until Ground Cover Is Established. This Includes Grassing of All Roadside Ditches and Drainage Channels.

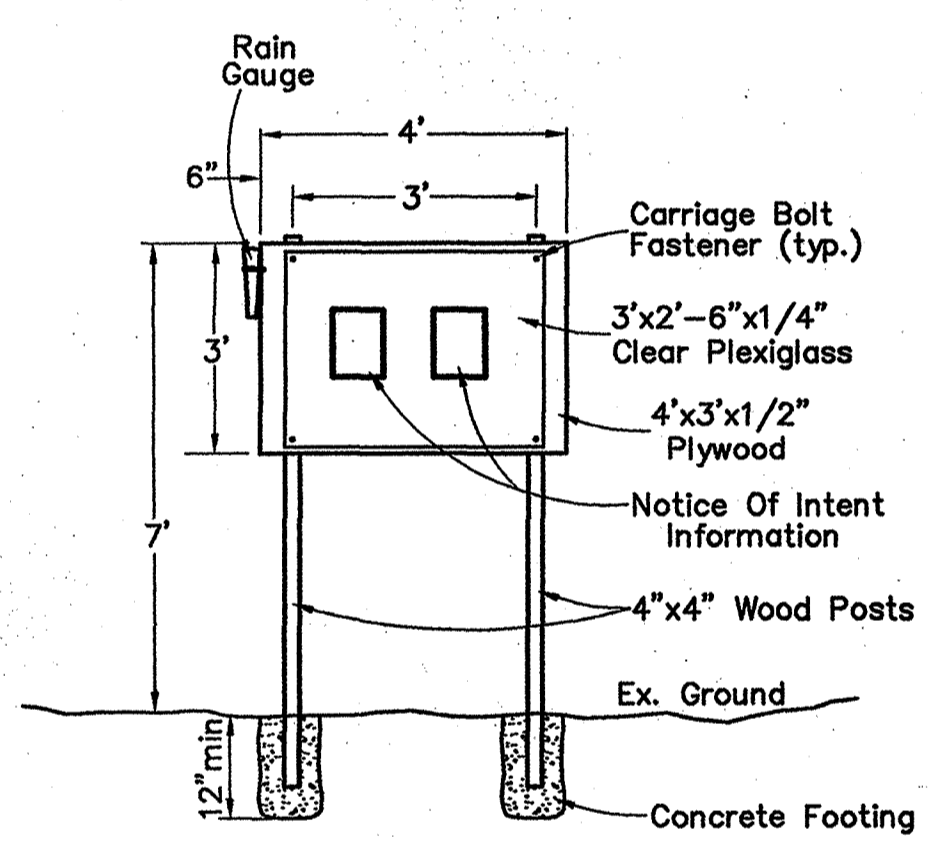

N.O.I. SIGN BOARD N.T.S. Sign location shall be coordinated with Engineer.

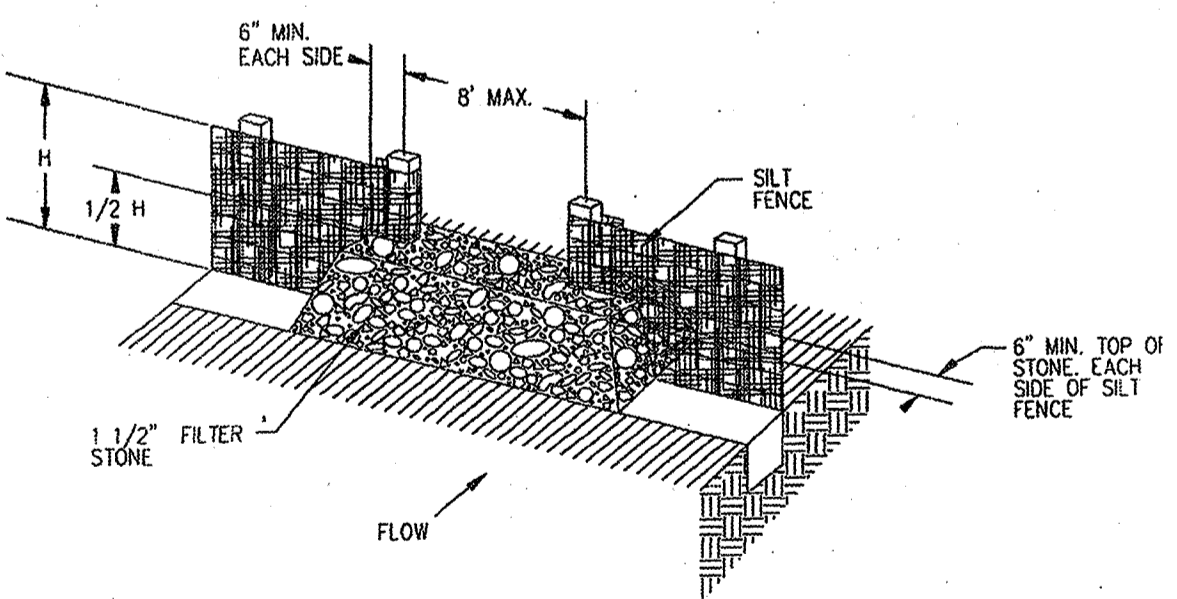

STONE OVERFLOW STRUCTURE N.T.S.

**LEGEND**

- Silt Fence
- Stone Overflow Structure  
Install per details this sheet


**GENERAL NOTES FOR THE EROSION CONTROL PLAN**

1. All operators and/or contractors shall conform to the terms and conditions of the National Pollution Discharge Elimination Systems (NPDES) General Permit as published in the Federal Register, Vol. 63, No. 128, July 6, 1998, by the Environmental Protection Agency (EPA). The Notice of Intent (NOI), as required by the General Permit, must be properly displayed on site at all times by each operator.
2. All releases of reportable quantities of hazardous substances shall be reported immediately to the facility operator and EPA.
3. The Contractor shall inspect the site at least once every fourteen days and within 24 hours of a 1/2-inch or greater rainfall event. The Contractor shall document the results. Copies of the inspection reports shall accompany the Contractor's monthly pay request. The Contractor shall not be paid until said reports are presented to the Owner/Owner's Representative. The Earthwork Contractor shall be responsible for inspection until the Utility Contractor begins his work. The Utility Contractor shall be responsible for inspections until the Paving Contractor begins his work. The Paving Contractor shall be responsible for inspections until the Earthwork Contractor begins lot benching operations. The Earthwork Contractor shall make remaining inspections until project is accepted by the City.
4. Modifications to the Storm Water Pollution Prevention Plan shall be implemented and be in-place within a seven calendar day period. If any contractor sees a violation by an operator or another contractor, he shall notify the operator and contractor in violation, as well as the facility operator.
5. Erosion control shall be installed prior to any grading. Accumulated silt deposits shall be removed from silt fences and hay bale dikes when silt depth reaches six inches. Removal of silt deposits by the contractor shall be incidental to the performance of the contract and a separate bid item shall not be included.
6. The contractor shall add or delete erosion protection at the request and direction of the Operator of the City.
7. After installation of pavement, final lot benching and general cleanup, the grass groundcover shall be established in all street parkways, lots and all other disturbed areas. Materials shall be as specified in Item 2.15 and seeding shall be in accordance with Item 3.10 of the NCTCOG Standard Specifications. Depending upon schedule for house construction, grass establishment may be waived on a single lot basis if house construction begins immediately on that lot. It shall be the contractor's responsibility to control and limit silt and sediment leaving the site. Specifically, the contractor shall protect all public streets, alleys, streams and storm drainage systems from erosion deposits.
8. If any erosion control is removed for construction and/or access purposes, the contractor shall replace it at the end of the work day. It shall be the contractor's responsibility to provide a dumpster (or equal) to collect solid waste materials during construction.


**NTMWD NOTES**

1. North Texas Municipal Water District (NTMWD) 42-inch and 20-inch water transmission pipelines are located within the limits of the construction.
2. Operation of heavy earthmoving equipment, compaction equipment or heavy construction equipment, such as concrete trucks, shall be restricted to specific crossings points across NTMWD easements, as approved by the NTMWD. The crossings shall be designated and verified to provide a minimum of five feet of cover.
3. To assure that placing of significant loads over the NTMWD pipeline does not damage the existing pipeline, no materials shall be stockpiled on the NTMWD easement, without authorization from the NTMWD. If the contractor desires to use NTMWD's easement for stockpile of materials, contact NTMWD Engineering at (972) 442-5405 so your plans for use of NTMWD's easement can be reviewed.
4. In areas where the cover between the top of the NTMWD pipeline and the bottom of the sub-grade is three (3) feet or less, it is requested that the sub-grade preparation be deleted and thickened pavement section be used to limit construction activities over the pipeline.
5. Crossing of the NTMWD easement with other utilities, such as TV cable, phone, gas and electric, shall be coordinated with the NTMWD to avoid damage to the NTMWD facilities.
6. Outdoor lighting, landscaping, screening walls or other facilities shall not be installed in NTMWD easements without written approval of the NTMWD.
7. Unless otherwise shown or required a minimum of one-foot clearance shall be provided for all utilities crossing the NTMWD pipelines.
8. The contractor shall contact NTMWD Engineering at (972) 442-5405 at least 48 hours prior to performing any work in the vicinity of the NTMWD facilities.
9. Water and Sewer lines crossing the NTMWD easements shall be installed in compliance with the Rules and Regulations for Public Water Systems, Paragraphs 290.44 (e), Location of Water Lines.
10. Septic systems are not permitted within NTMWD easements.
11. Excavation adjacent to NTMWD pipelines, manholes and other appurtenances to install proposed improvements shall be performed so that the manholes, pipelines or appurtenances are not displaced or damaged. Any damage to the manholes, pipelines or appurtenances shall be repaired to the satisfaction of the NTMWD. Further, any cost for repair of damage to the manholes, pipelines or appurtenances resulting from construction by the developer or contractor will be the responsibility for the developer.


- SILT FENCE GENERAL NOTES:**
1. Steel posts which support the silt fence shall be installed on a slight angle toward the anticipated runoff source.
  2. The top of the silt fence shall be trenched in with a spade or mechanical trencher, so that the downlope face of the trench is flat and perpendicular to the line of flow.
  3. The trench should be a minimum of six inches deep and four inches wide to allow for the silt fence to be laid in the ground and backfilled.
  4. Silt fence should be securely fastened to each steel support post or to woven wire, which is in turn attached to the steel fence posts.
  5. Inspection shall be frequent and repair or replacement shall be made promptly as needed.
  6. Silt fence shall be removed when it has served its usefulness, so as not to block or impede storm flow or drainage.
  7. Sediment trapped by this practice shall be disposed of in an approved site in a manner that will not contribute to additional siltation.
  8. Accumulated silt shall be removed when it reaches a depth of six inches and disposed of in an approved spoil site or as in No. 7 above.
  9. At point of surface flow concentration reinforce silt fence with wire mesh backing on downstream side of fence.
  10. Filter fabric is to be Marafi 100X or approved equal. (Marafi, Inc.: 800-438-1855)

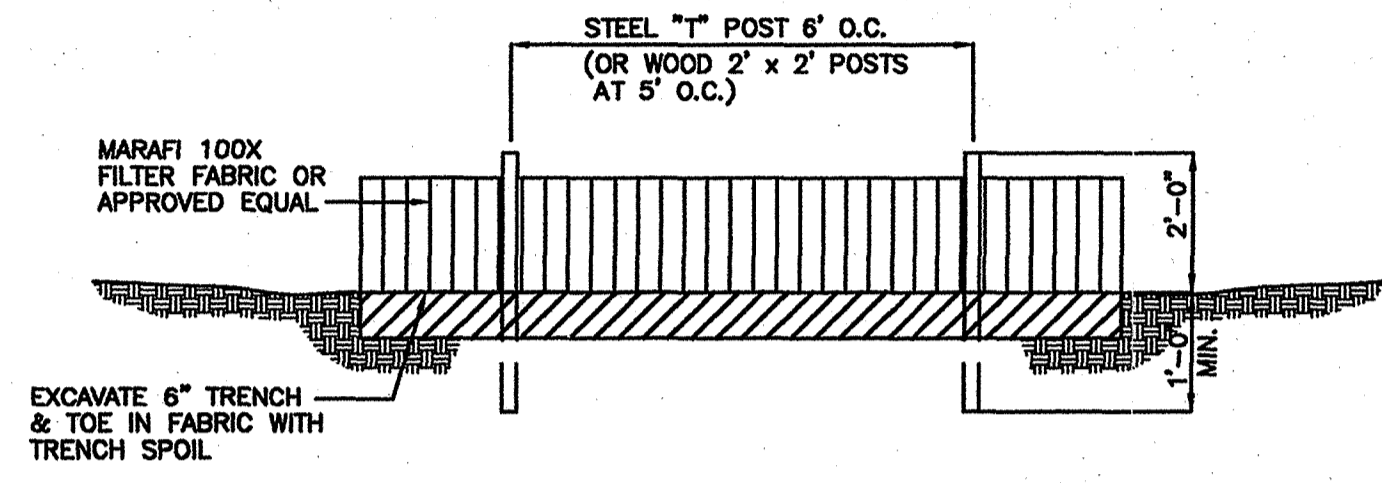


ELEVATION N.T.S.

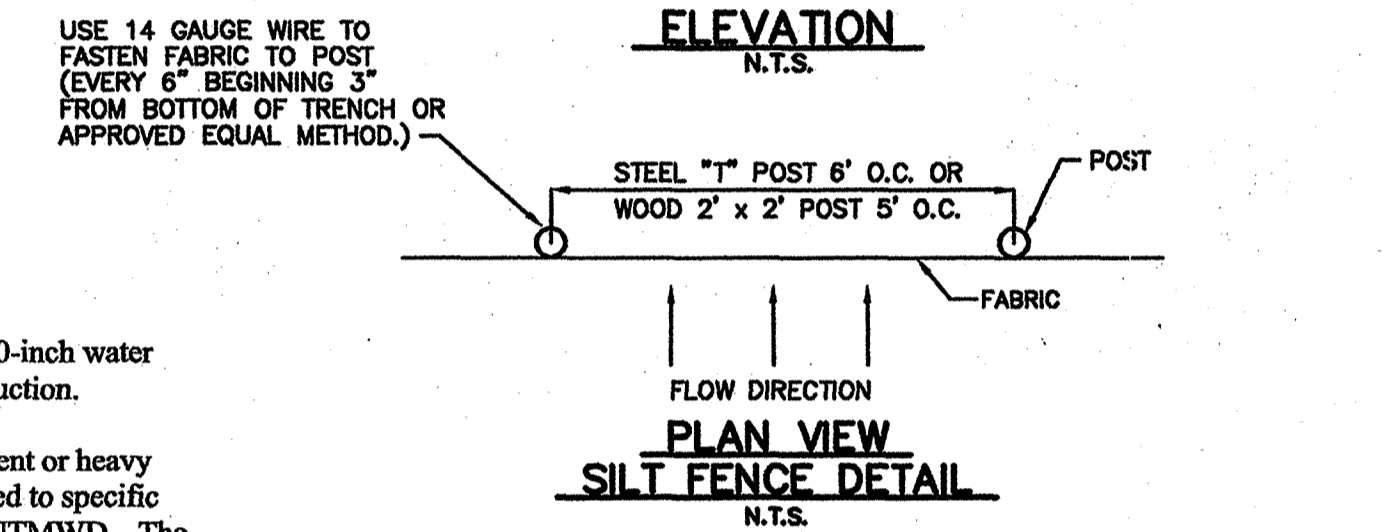

PLAN VIEW SILT FENCE DETAIL N.T.S.

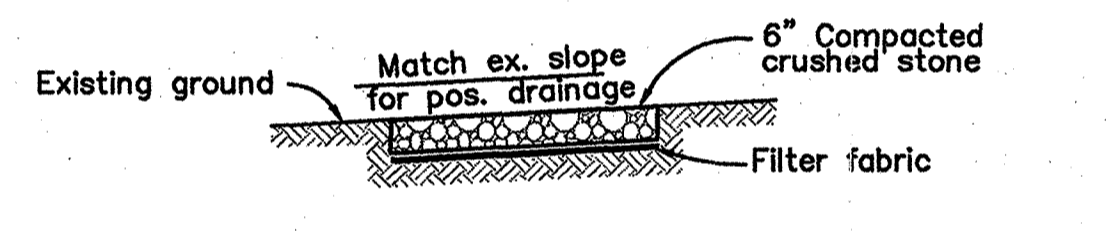

SECTION N.T.S.

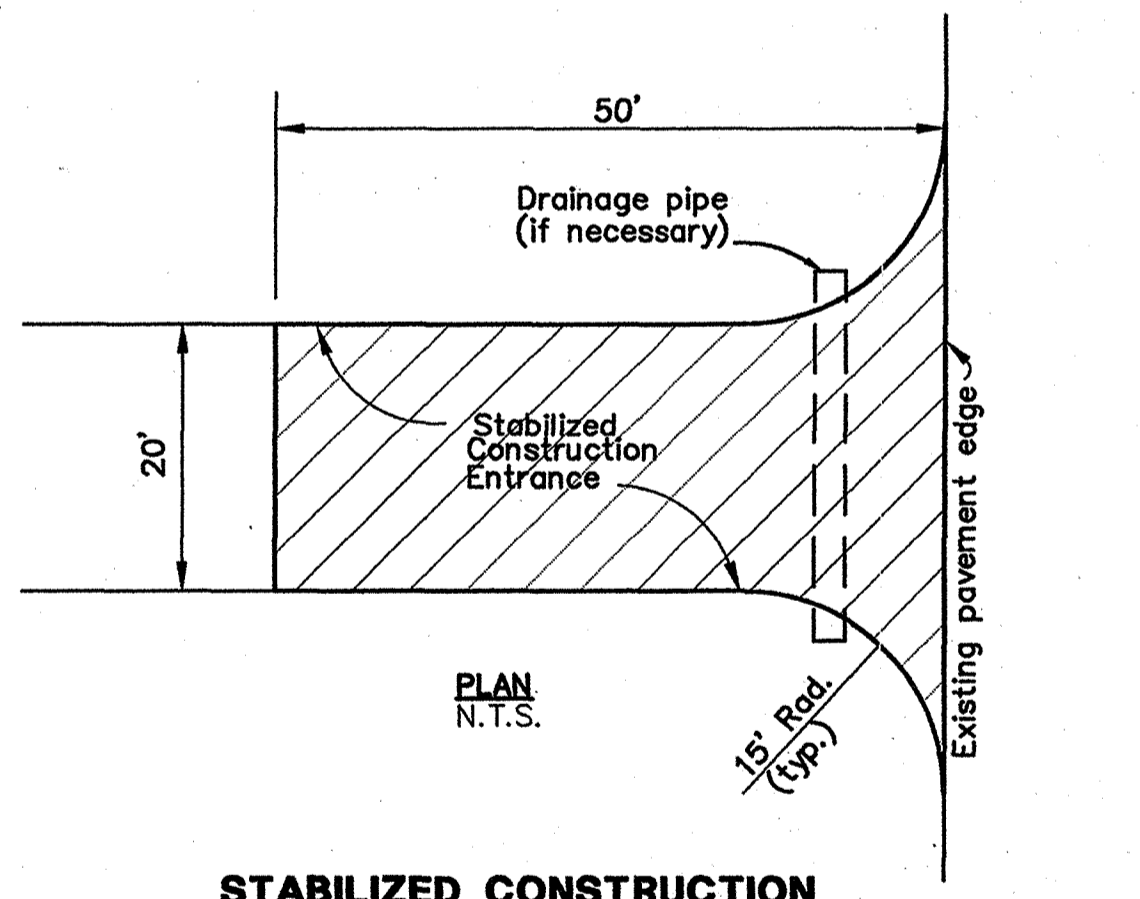

STABILIZED CONSTRUCTION ENTRANCE PLAN N.T.S.

- STABILIZED CONST. ENTRANCE GENERAL NOTES:**
1. Crushed stone for construction entrance shall be 2"-3" at greatest dimension and shall be installed to a compacted depth of six inches.
  2. Filter fabric is to be Marafi 100X or equal. (Marafi, Inc.: 800-438-1855)
  3. If construction entrance crosses a drainage ditch, swale, etc., a drainage pipe shall be installed with min. 12 inches cover of crushed stone.


NOTE: SEE STORM WATER POLLUTION PREVENTION PLAN PREPARED SPECIFICALLY FOR THIS PROJECT FOR ADDITIONAL DETAIL REGARDING EROSION CONTROL & MONITORING.

**RECORD DRAWING**  
THIS DRAWING HAS BEEN REVISED TO REFLECT THE ACTUAL CONSTRUCTION DETAILS AS CONTAINED IN THE RECORDS OF THE CONTRACTOR. ELEVATIONS SHOWN ON THIS PLAN WERE NOT FIELD VERIFIED.  
JONES & BOYD, INC.  
BY: [Signature]  
DATE: 2/2/01

- BENCHMARKS:**
1. "T" 1/2" IR, W of Ingram Rd. +- 1025' N of N edge of Lucas Rd. +- 6' E of fence. Elev. 637.08
  2. "T" 1/2" IR, E of Ingram Rd. +- 2650' N of N edge of Lucas Rd. +- 28' E & 37' N of fence corner. Elev. 639.20

NO.	REVISIONS DURING CONSTRUCTION	BY	DATE	NO.	REVISIONS DURING PLAN REVIEW	BY	DATE
4	ADDED NOTES TO NTMWD NOTES & LOCATED EASEMENT	CMG	01/05/01				
3	REVISED PER CITY COMMENTS	SSC	12/22/00				
2	ADDED SILT FENCE ALONG R.O.W.	CMG	12/19/00				
1	REVISED PER CITY COMMENTS	JMW	12/08/00				

The seal appearing on this document was authorized by Thomas K. Juhn, P.E. 81799 on Jan. 05, 2001. Alteration of a sealed document without proper notification to the responsible engineer is an offense under the Texas Engineering Practice Act.

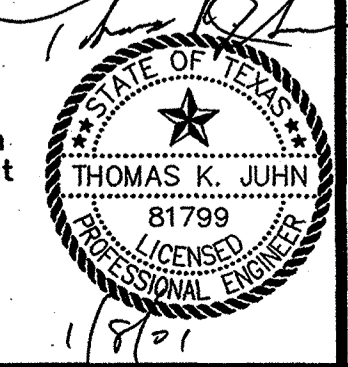


**Jones & Boyd, Inc.**  
16800 Dallas Parkway, Suite 240  
Dallas, Texas 75248  
Tel: 972-248-7676  
Fax: 972-248-1414


<b>EROSION CONTROL PLAN</b>		PROJECT NO.	SK403
<b>SADDLEBROOK</b>		SHEET NO.	14
City of Lucas, Collin County, Texas			

Plot info: Drawing: H:\Projects\SK403.dwg SK403.dwg Plotted by: JMW Plot date: 12/8/00 Plot time: 9:10 am




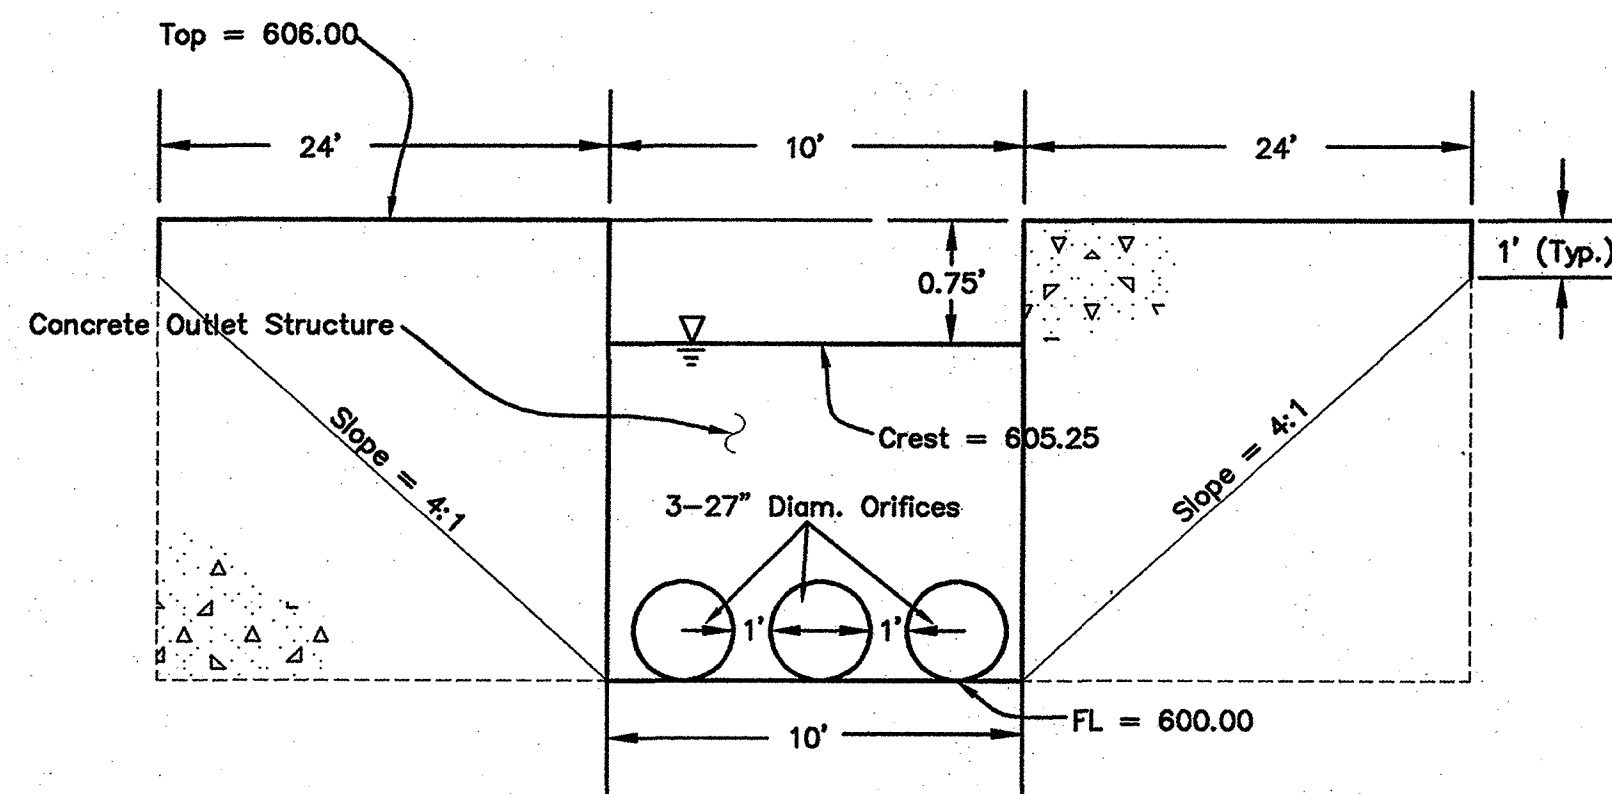

**PROFILE VIEW**  
N.T.S.

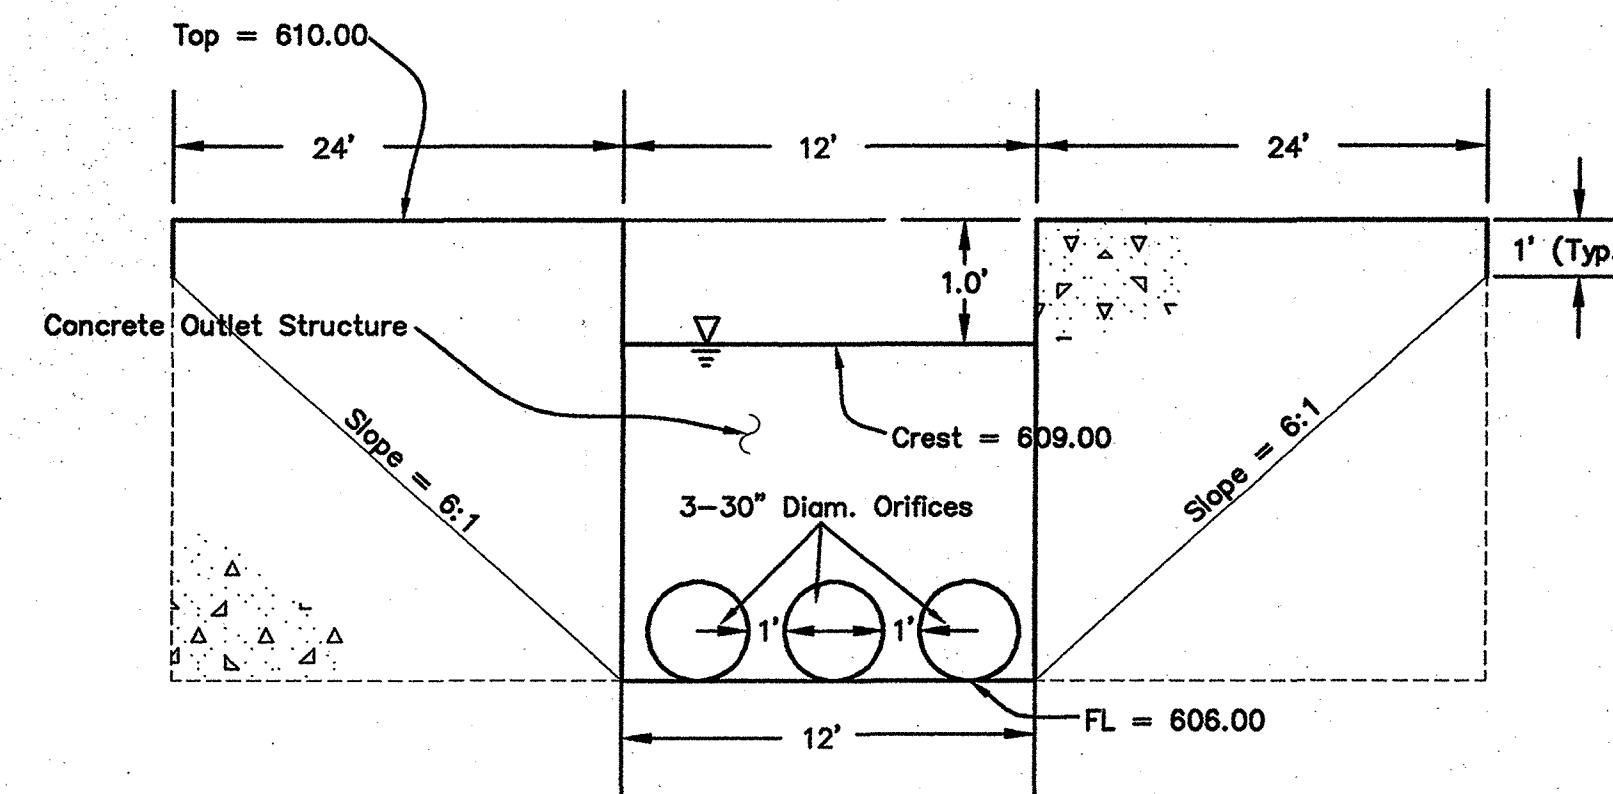


**PROFILE VIEW**  
N.T.S.

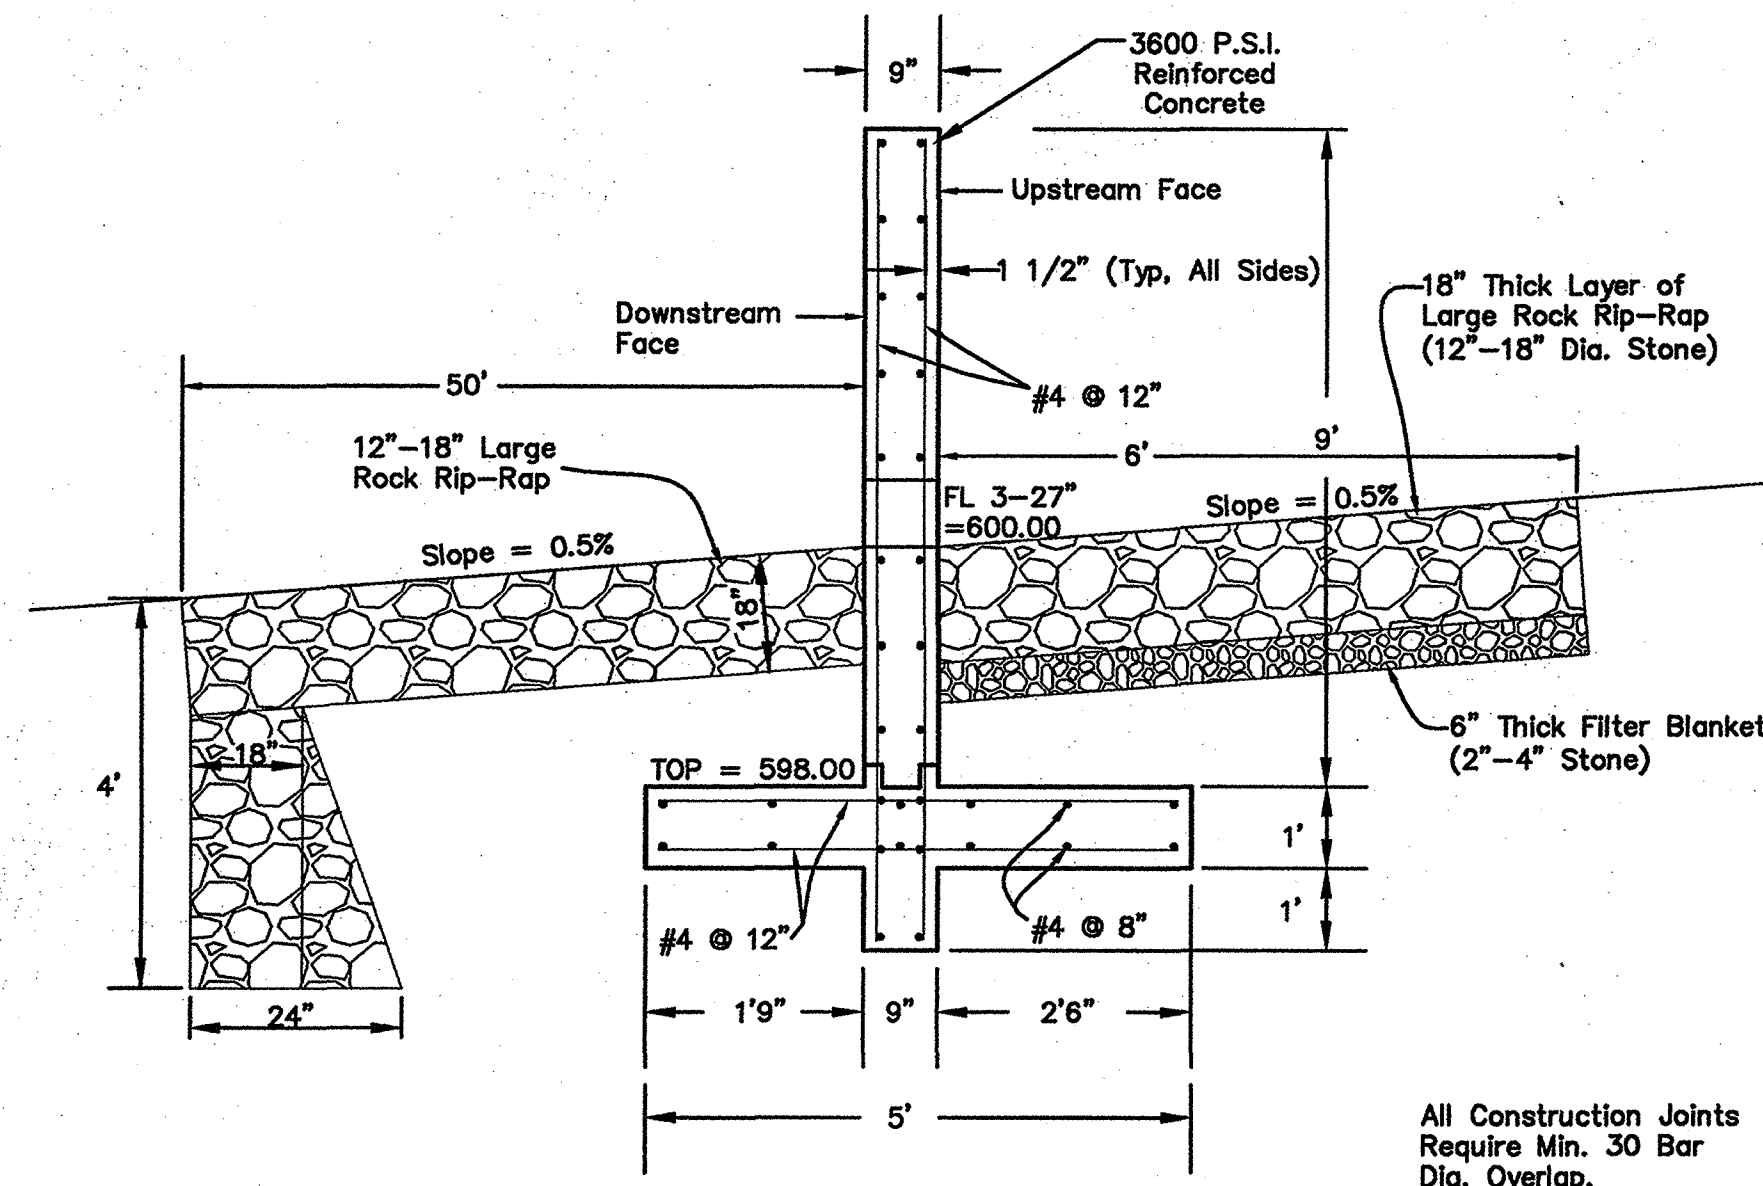

**SIDE VIEW DETAIL**  
N.T.S.

**POND #1 OUTLET STRUCTURE DETAIL**  
(Downstream)

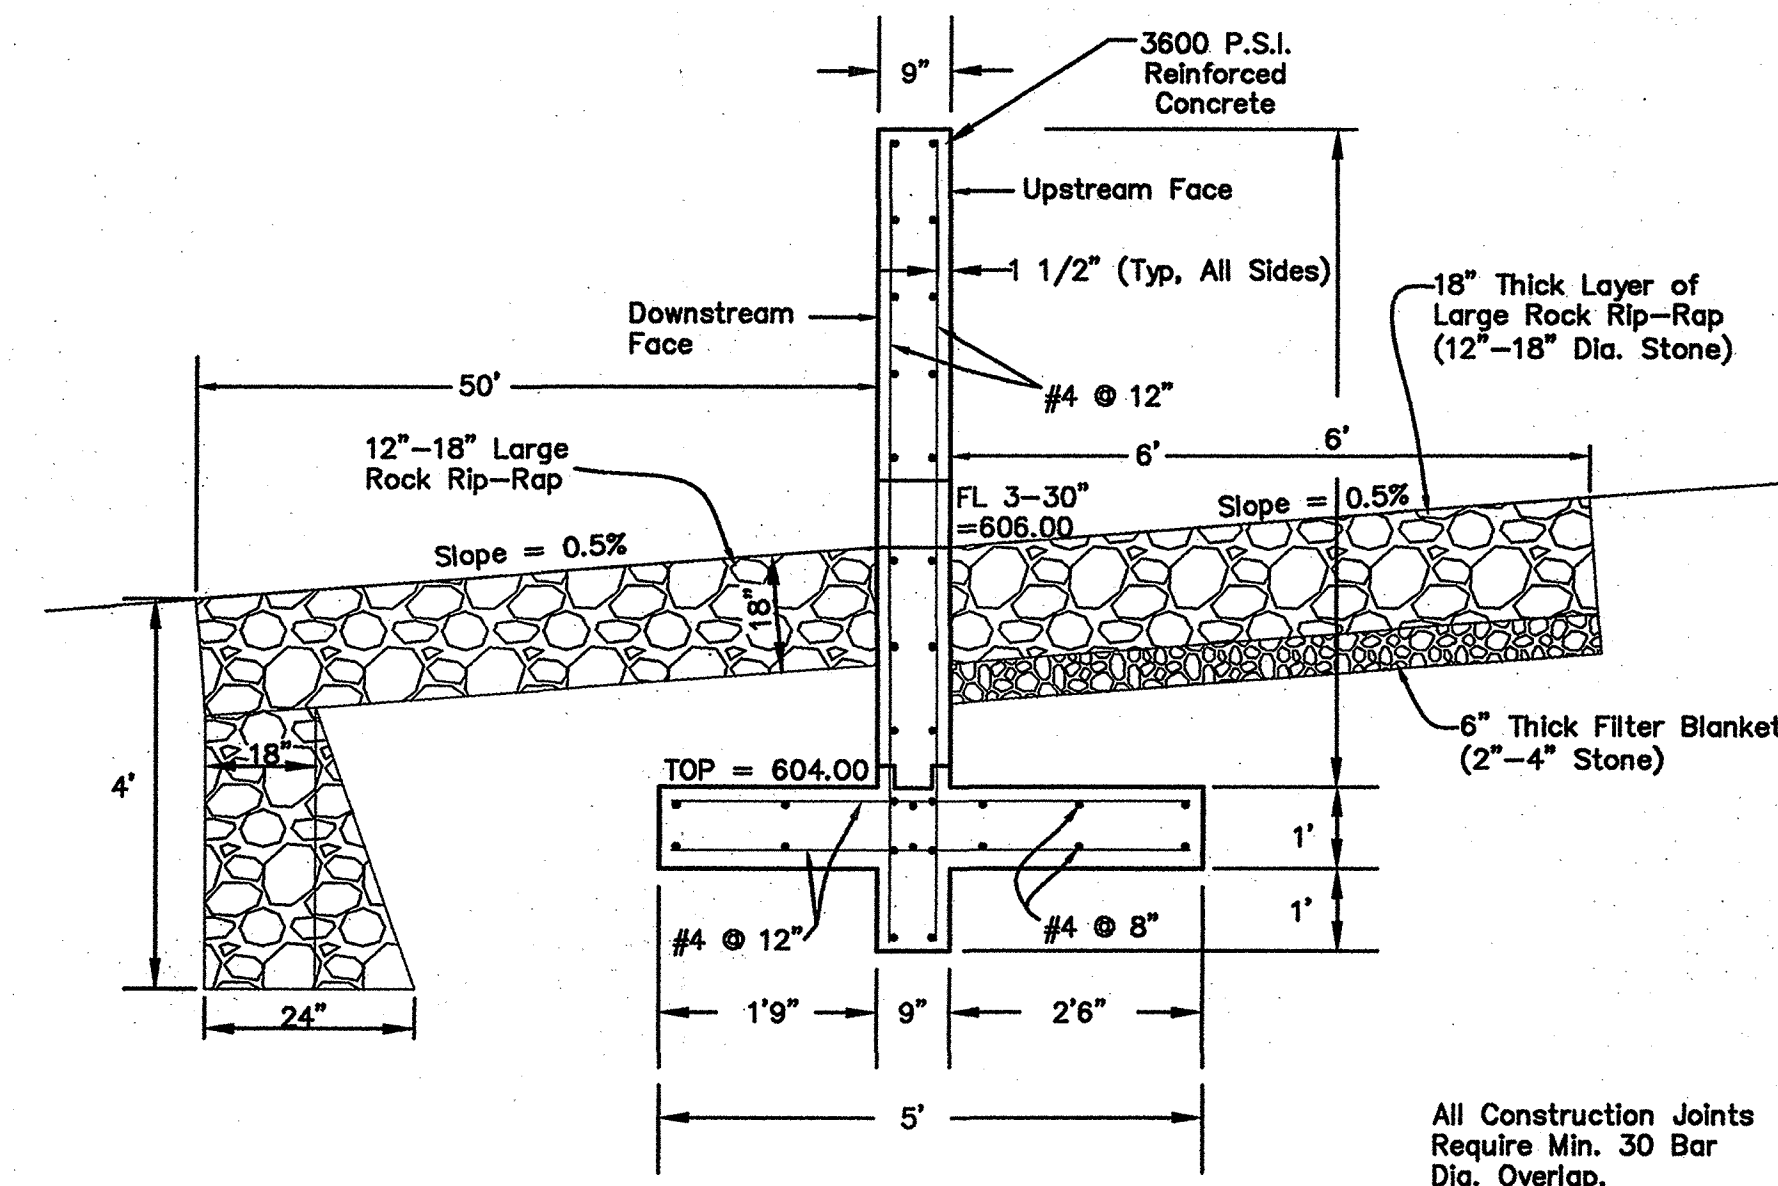

**SIDE VIEW DETAIL**  
N.T.S.

**POND #2 OUTLET STRUCTURE DETAIL**  
(Upstream)

**Pond #1**

**Flow through a Circular Orifice in a Wall.**  $Q = C_c (A_o) (C_v (2 (g) (\Delta H))^{1/2})$

Diameter of the Orifice (in) = 27       $A_o = \text{Area of Orifice (ft}^2) = 3.98$        $g = \text{Gravity (ft}^2/\text{s}^2) = 32.2$   
 Number of Orifices = 3       $C_c = \text{Coeff. of Contraction} = 1.0$   
 $C_v = \text{Coeff. of Velocity} = 0.86$       **Allowable Release Rate = 171.50 cfs**

H1 = Height of water in Pond above Orifice FL. (ft)       $\Delta H = H1 - H2$  (ft)      Q = Flow out of the Pond (cfs)

1.5	0.375	50.41
2.0	0.875	77.01
2.5	1.375	96.53
3.0	1.875	112.72
3.5	2.375	126.87
4.0	2.875	139.58
4.5	3.375	151.24
5.0	3.875	162.05
100 Storm Elevation → 5.25	4.125	167.20
5.5	4.375	172.19
6.0	4.875	181.76

**Pond #2**

**Flow through a Circular Orifice in a Wall.**  $Q = C_c (A_o) (C_v (2 (g) (\Delta H))^{1/2})$

Diameter of the Orifice (in) = 30       $A_o = \text{Area of Orifice (ft}^2) = 4.91$        $g = \text{Gravity (ft}^2/\text{s}^2) = 32.2$   
 Number of Orifices = 3       $C_c = \text{Coeff. of Contraction} = 1.0$   
 $C_v = \text{Coeff. of Velocity} = 0.86$       **Allowable Release Rate = 132.26 cfs**

H1 = Height of water in Pond above Orifice FL. (ft)       $\Delta H = H1 - H2$  (ft)      Q = Flow out of the Pond (cfs)

1.5	0.250	50.82
1.75	0.500	71.86
2.0	0.750	88.02
2.25	1.000	101.63
2.5	1.250	113.63
2.75	1.500	124.47
100 Storm Elevation → 3.0	1.750	134.45
3.25	2.000	143.73
3.5	2.250	152.45
3.75	2.500	160.69
4.0	2.750	168.54

RECORD DRAWING  
 THIS DRAWING HAS BEEN REVISED  
 TO REFLECT THE ACTUAL  
 CONSTRUCTION DETAILS AS  
 CONTAINED IN THE RECORDS OF THE  
 CONTRACTOR. ELEVATIONS SHOWN ON  
 THIS PLAN WERE NOT FIELD VERIFIED.

JONES & BOYD, INC.  
 BY: [Signature]  
 DATE: 1/2/01



NO.	REVISIONS DURING CONSTRUCTION	BY	DATE	NO.	REVISIONS DURING PLAN REVIEW	BY	DATE
				2	Corrected freeboard dimensions.	CMG	12/19/00
				1	Add another outlet structure for 2nd pond.	JMW	12/18/00

The seal appearing on this document was authorized by Thomas K. Juhn, P.E. 81799 on Dec. 19, 2000. Alteration of a sealed document without proper notification to the responsible engineer is an offense under the Texas Engineering Practice Act.


THOMAS K. JUHN  
 81799  
 LICENSED PROFESSIONAL ENGINEER  
 18701

**Jones & Boyd, Inc.**  
 16800 Dallas Parkway, Suite 240  
 Dallas, Texas 75248  
 Tel: 972-248-7676  
 Fax: 972-248-1414

<b>DRAINAGE DESIGN THEORY</b>		PROJECT NO.
		SK403
<b>SADDLEBROOK</b>		SHEET NO.
<b>CITY OF LUCAS, COLLIN COUNTY, TEXAS</b>		15A

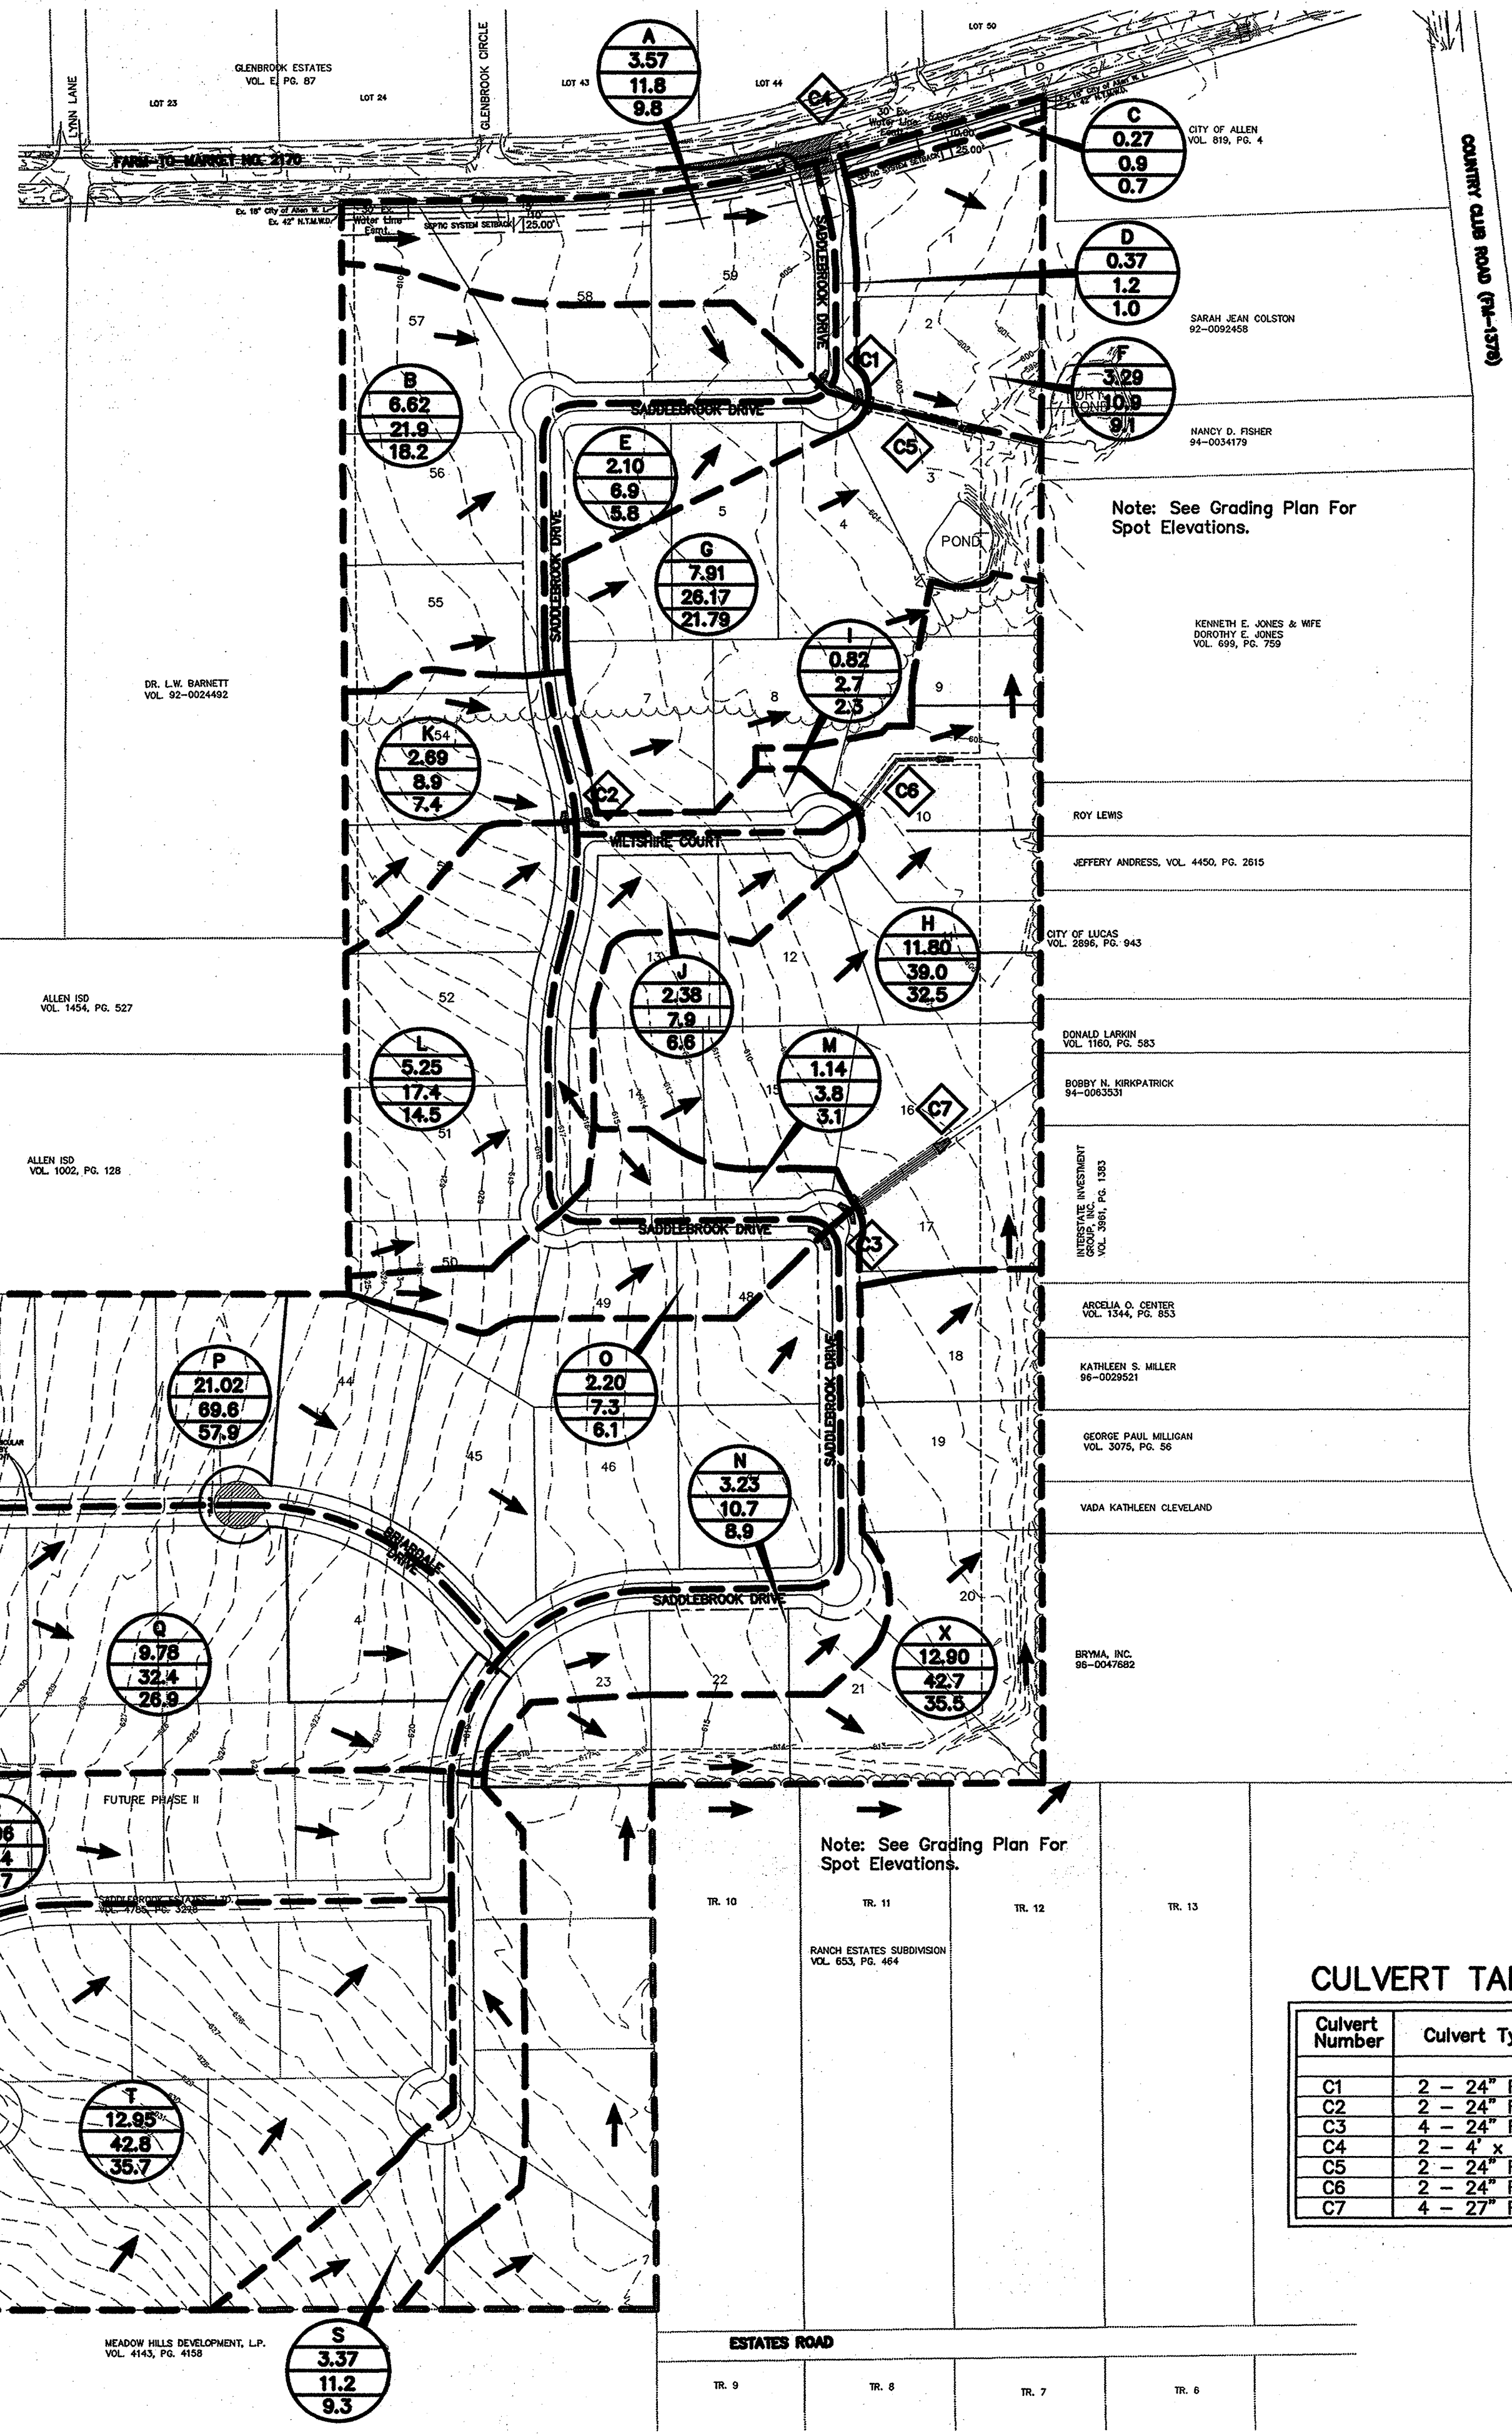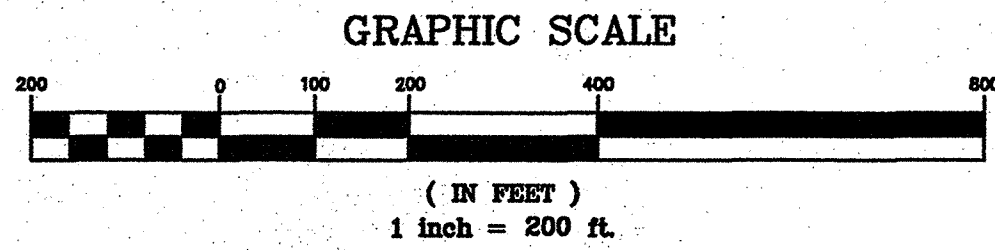

OFF-SITE DRAINAGE AREA MAP (1"=400')

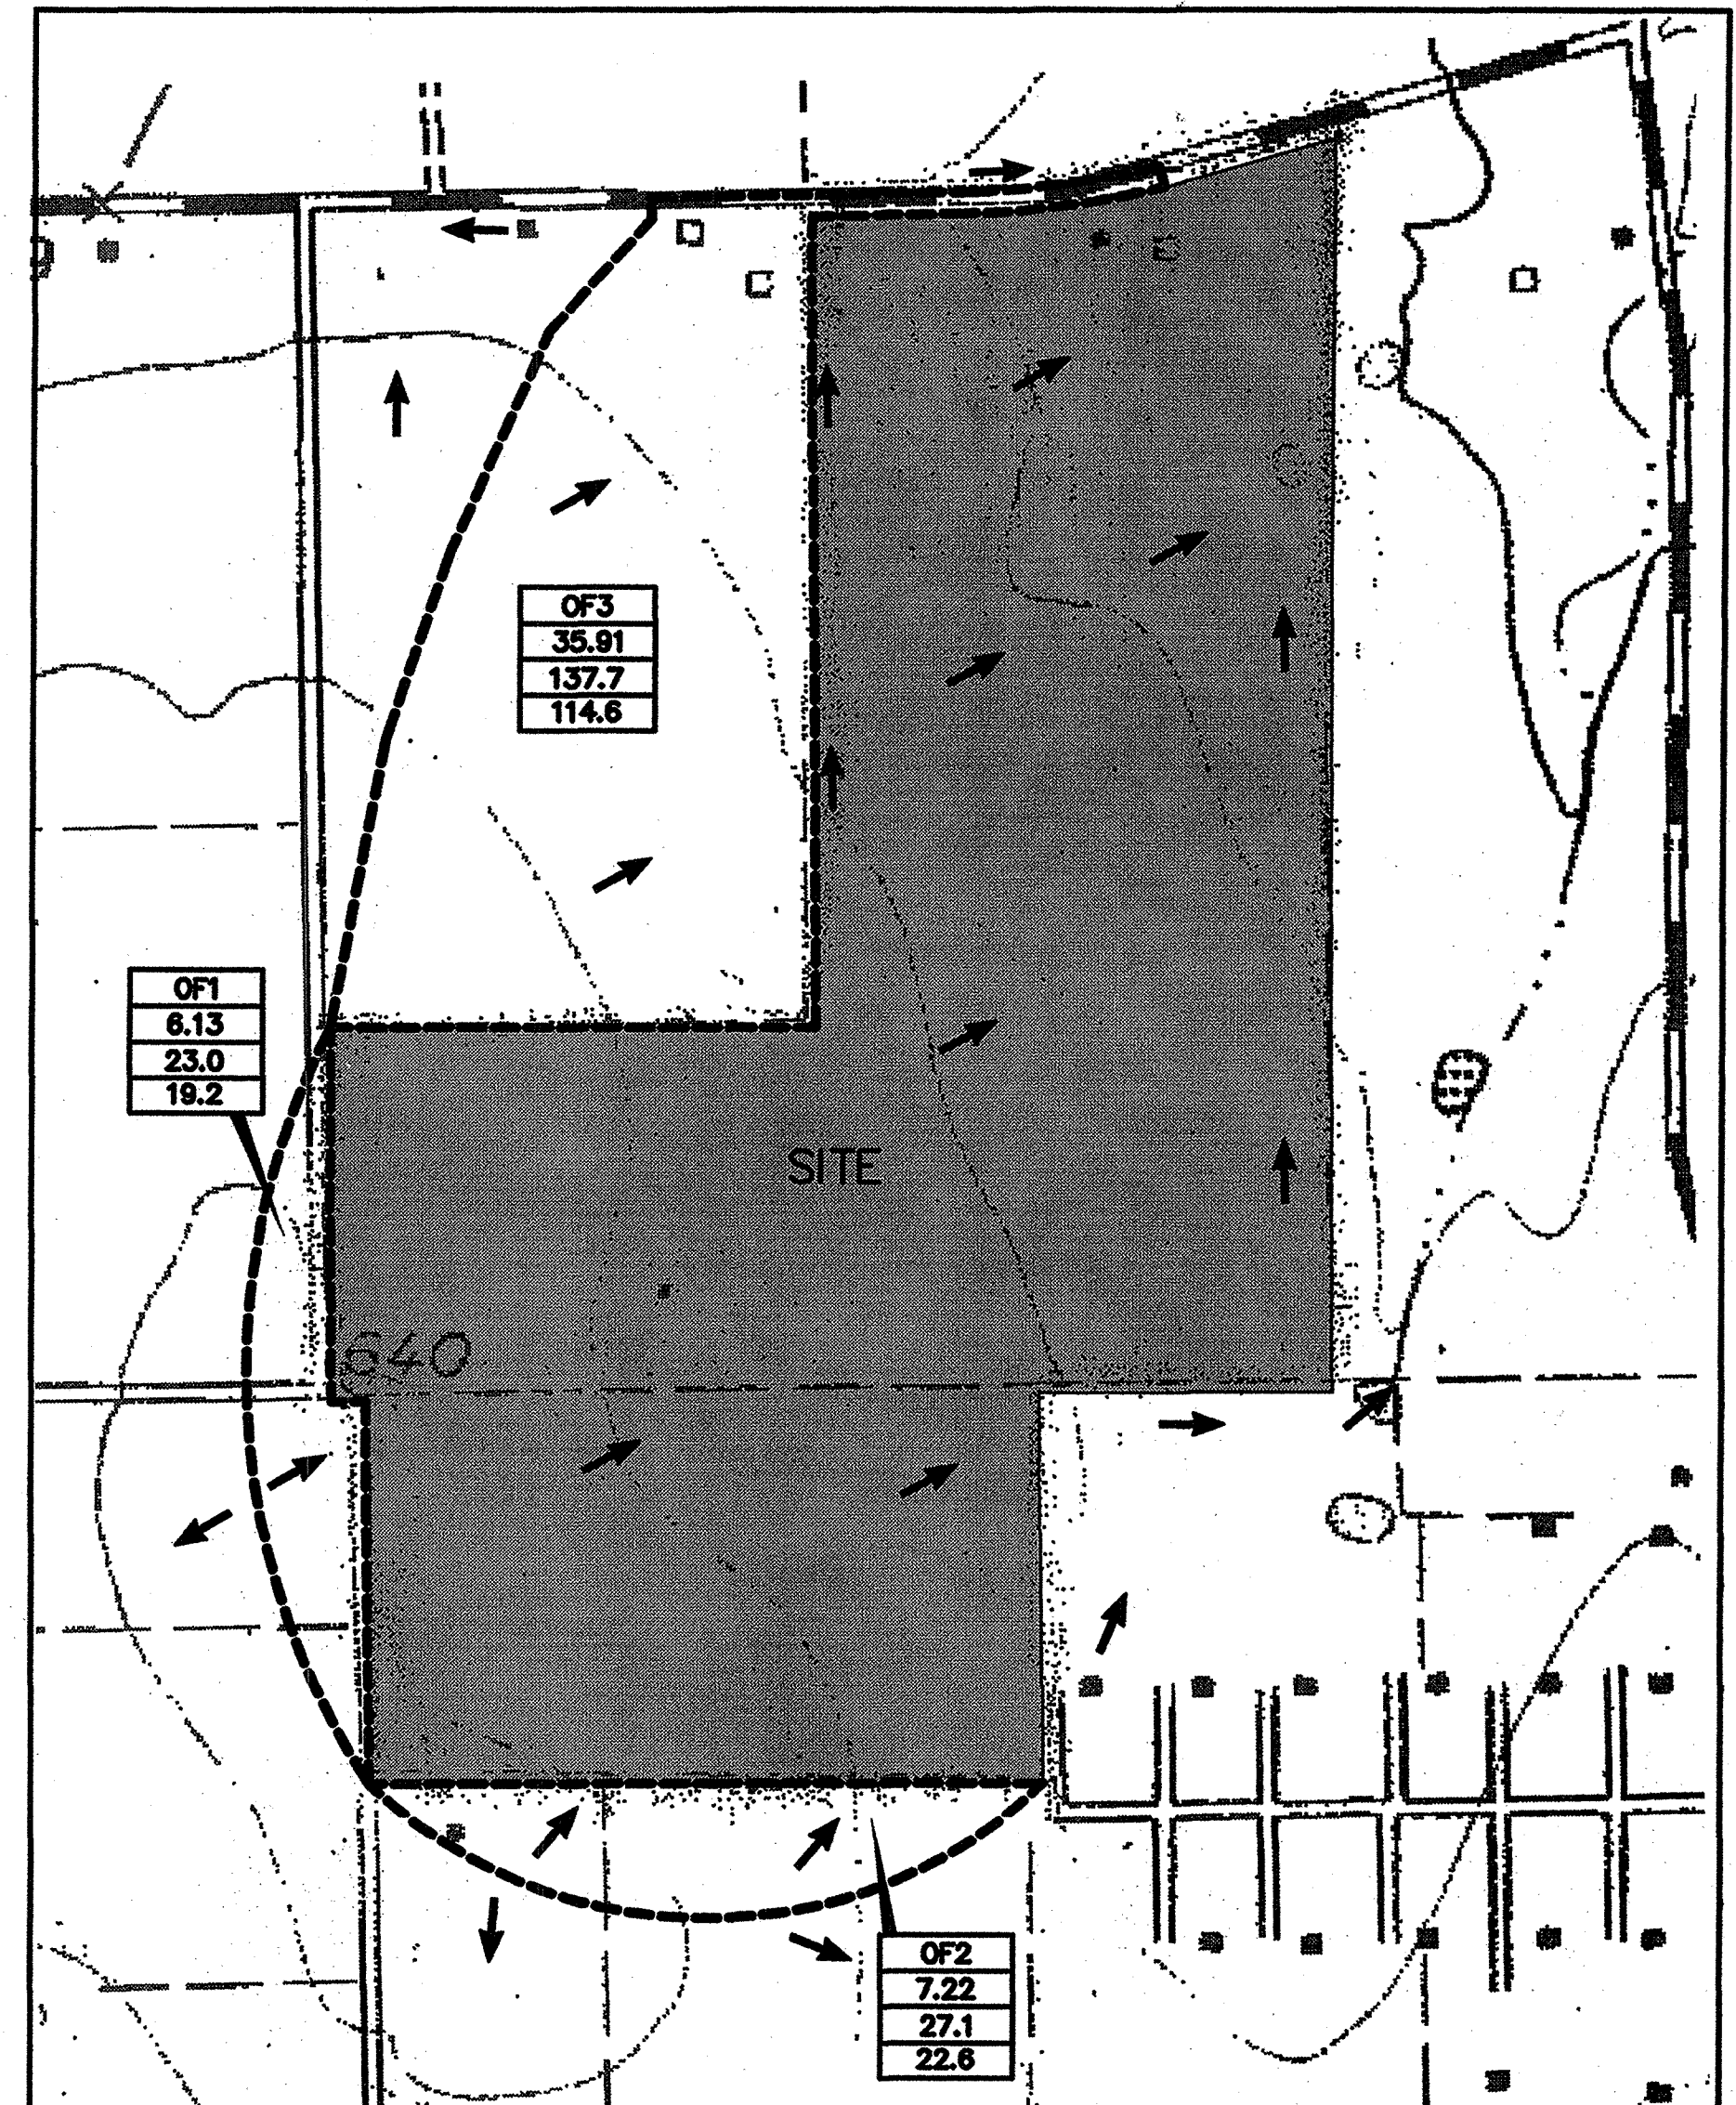

**RECORD DRAWING**  
 THIS DRAWING HAS BEEN REVISED TO REFLECT THE ACTUAL CONSTRUCTION DETAILS AS CONTAINED IN THE RECORDS OF THE CONTRACTOR. ELEVATIONS SHOWN ON THIS PLAN WERE NOT FIELD VERIFIED.  
 BY: JONES & BOYD, INC.  
 DATE: 8/22/03

**DRAINAGE THEORY**  
 Q=CIA (25 yr. storm)  
 Q = Runoff (c.f.s.)  
 C = Runoff Coefficient  
 $C_{(developed)} = 0.35$   
 $C_{(undeveloped)} = 0.44$   
 I = Intensity (in/hr)  
 $I_{25} = 6.26$  (in/hr)  
 A = Area (Acres)

OFF-SITE RUNOFF CALCULATIONS

Drainage Basin	Area (Acres)	Runoff Coeff.	Intensity (in/hr.)	Intensity (in/hr.)	Time (conc.) (minutes)	Discharge (c.f.s.)	Discharge (c.f.s.)	Comment
	"A"	"C"	"I(25)"	"I(100)"	T <sub>c</sub>	"Q(25)"	"Q(100)"	
OF1	6.13	0.5	6.26	7.52	15.0	19.2	23.0	Developed
OF2	7.22	0.5	6.26	7.52	15.0	22.6	27.1	Developed
OF3	35.91	0.51	6.26	7.52	15.0	114.6	137.7	Developed

ON-SITE RUNOFF CALCULATIONS

Drainage Basin	Area (Acres)	Runoff Coeff.	Intensity (in/hr.)	Intensity (in/hr.)	Time (conc.) (minutes)	Discharge (c.f.s.)	Discharge (c.f.s.)	Comment
	"A"	"C"	"I(25)"	"I(100)"	T <sub>c</sub>	"Q(25)"	"Q(100)"	
A	3.57	0.44	6.26	7.52	15.0	9.83	11.8	Developed
B	6.62	0.44	6.26	7.52	15.0	18.23	21.9	Developed
C	0.27	0.44	6.26	7.52	15.0	0.74	0.9	Developed
D	0.37	0.44	6.26	7.52	15.0	1.02	1.2	Developed
E	2.10	0.44	6.26	7.52	15.0	5.78	6.9	Developed
F	3.29	0.44	6.26	7.52	15.0	9.06	10.9	Developed
G	7.91	0.44	6.26	7.52	15.0	21.79	26.17	Developed
H	11.80	0.44	6.26	7.52	15.0	32.50	39.0	Developed
I	0.82	0.44	6.26	7.52	15.0	2.28	2.7	Developed
J	2.38	0.44	6.26	7.52	15.0	6.59	7.9	Developed
K	2.69	0.44	6.26	7.52	15.0	7.41	8.9	Developed
L	5.25	0.44	6.26	7.52	15.0	14.46	17.4	Developed
M	1.14	0.44	6.26	7.52	15.0	3.14	3.8	Developed
N	3.23	0.44	6.26	7.52	15.0	8.90	10.7	Developed
O	2.20	0.44	6.26	7.52	15.0	6.06	7.3	Developed
P	21.02	0.44	6.26	7.52	15.0	57.90	69.6	Developed
Q	9.78	0.44	6.26	7.52	15.0	26.94	32.4	Developed
R	4.96	0.44	6.26	7.52	15.0	13.66	16.4	Developed
S	3.37	0.44	6.26	7.52	15.0	9.28	11.2	Developed
T	12.95	0.44	6.26	7.52	15.0	35.67	42.8	Developed
U	2.27	0.44	6.26	7.52	15.0	6.25	7.5	Developed
V	0.97	0.44	6.26	7.52	15.0	2.67	3.2	Developed
W	1.66	0.44	6.26	7.52	15.0	4.57	5.5	Developed
X	12.90	0.44	6.26	7.52	15.0	35.53	42.7	Developed

CULVERT TABLE

Culvert Number	Culvert Type
C1	2 - 24" RCP
C2	2 - 24" RCP
C3	4 - 24" RCP
C4	2 - 4' x 2' RCB
C5	2 - 24" RCP
C6	2 - 24" RCP
C7	4 - 27" RCP

**LEGEND**

- 501— Existing 1' Interval Contour
- 500— Existing 5' Interval Contour
- Existing Storm Culvert
- Proposed Roadway Culvert and Headwall
- Proposed Drainage Area Divide
- Direction of Flow
- Drainage Structure Label
- Prop. Drainage Area
- Area (acres)
- 100 Yr. Runoff (c.f.s.)
- 25 Yr. Runoff (c.f.s.)
- Offsite Drainage Area
- Area (acres)
- 100 Yr. Runoff (c.f.s.)
- 25 Yr. Runoff (c.f.s.)

- BENCHMARKS:**
- 1" 1/2" IR, W of Ingram Rd. +- 1025' N of N edge of Lucas Rd. +- 6' E of fence. Elev. 637.08
  - 1" 1/2" IR, E of Ingram Rd. +- 2650' N of N edge of Lucas Rd. +- 28' E & 37' N of fence corner. Elev. 639.20

NO.	REVISIONS DURING CONSTRUCTION	BY	DATE	NO.	REVISIONS DURING PLAN REVIEW	BY	DATE
				3	Added City of Allen & NTMWD Easements	CMG	01/08/03
				2	Revised Culvert Along F.M. 2170.	CMG	12/19/02
				1	REVISED PER CITY COMMENTS	SC	12/08/02


The seal appearing on this document was authorized by Thomas K. Juhn, P.E. 81799 on Jan. 08, 2001. Alteration of a sealed document without proper notification to the responsible engineer is an offense under the Texas Engineering Practice Act.

**Jones & Boyd, Inc.**  
 16800 Dallas Parkway, Suite 240  
 Dallas, Texas 75248  
 Tel: 972-248-7676  
 Fax: 972-248-1414

**DRAINAGE AREA MAP**  
**SADDLEBROOK**  
 City of Lucas, Collin County, Texas

PROJECT NO. SK403  
 SHEET NO. 16

Plot time: 8:26 am  
 Drawing: H:\Projects\SK403\dwg\SK403HY.dwg  
 Plotted by: mag  
 Plot date: 12/8/00  
 Plot time: 8:26 am

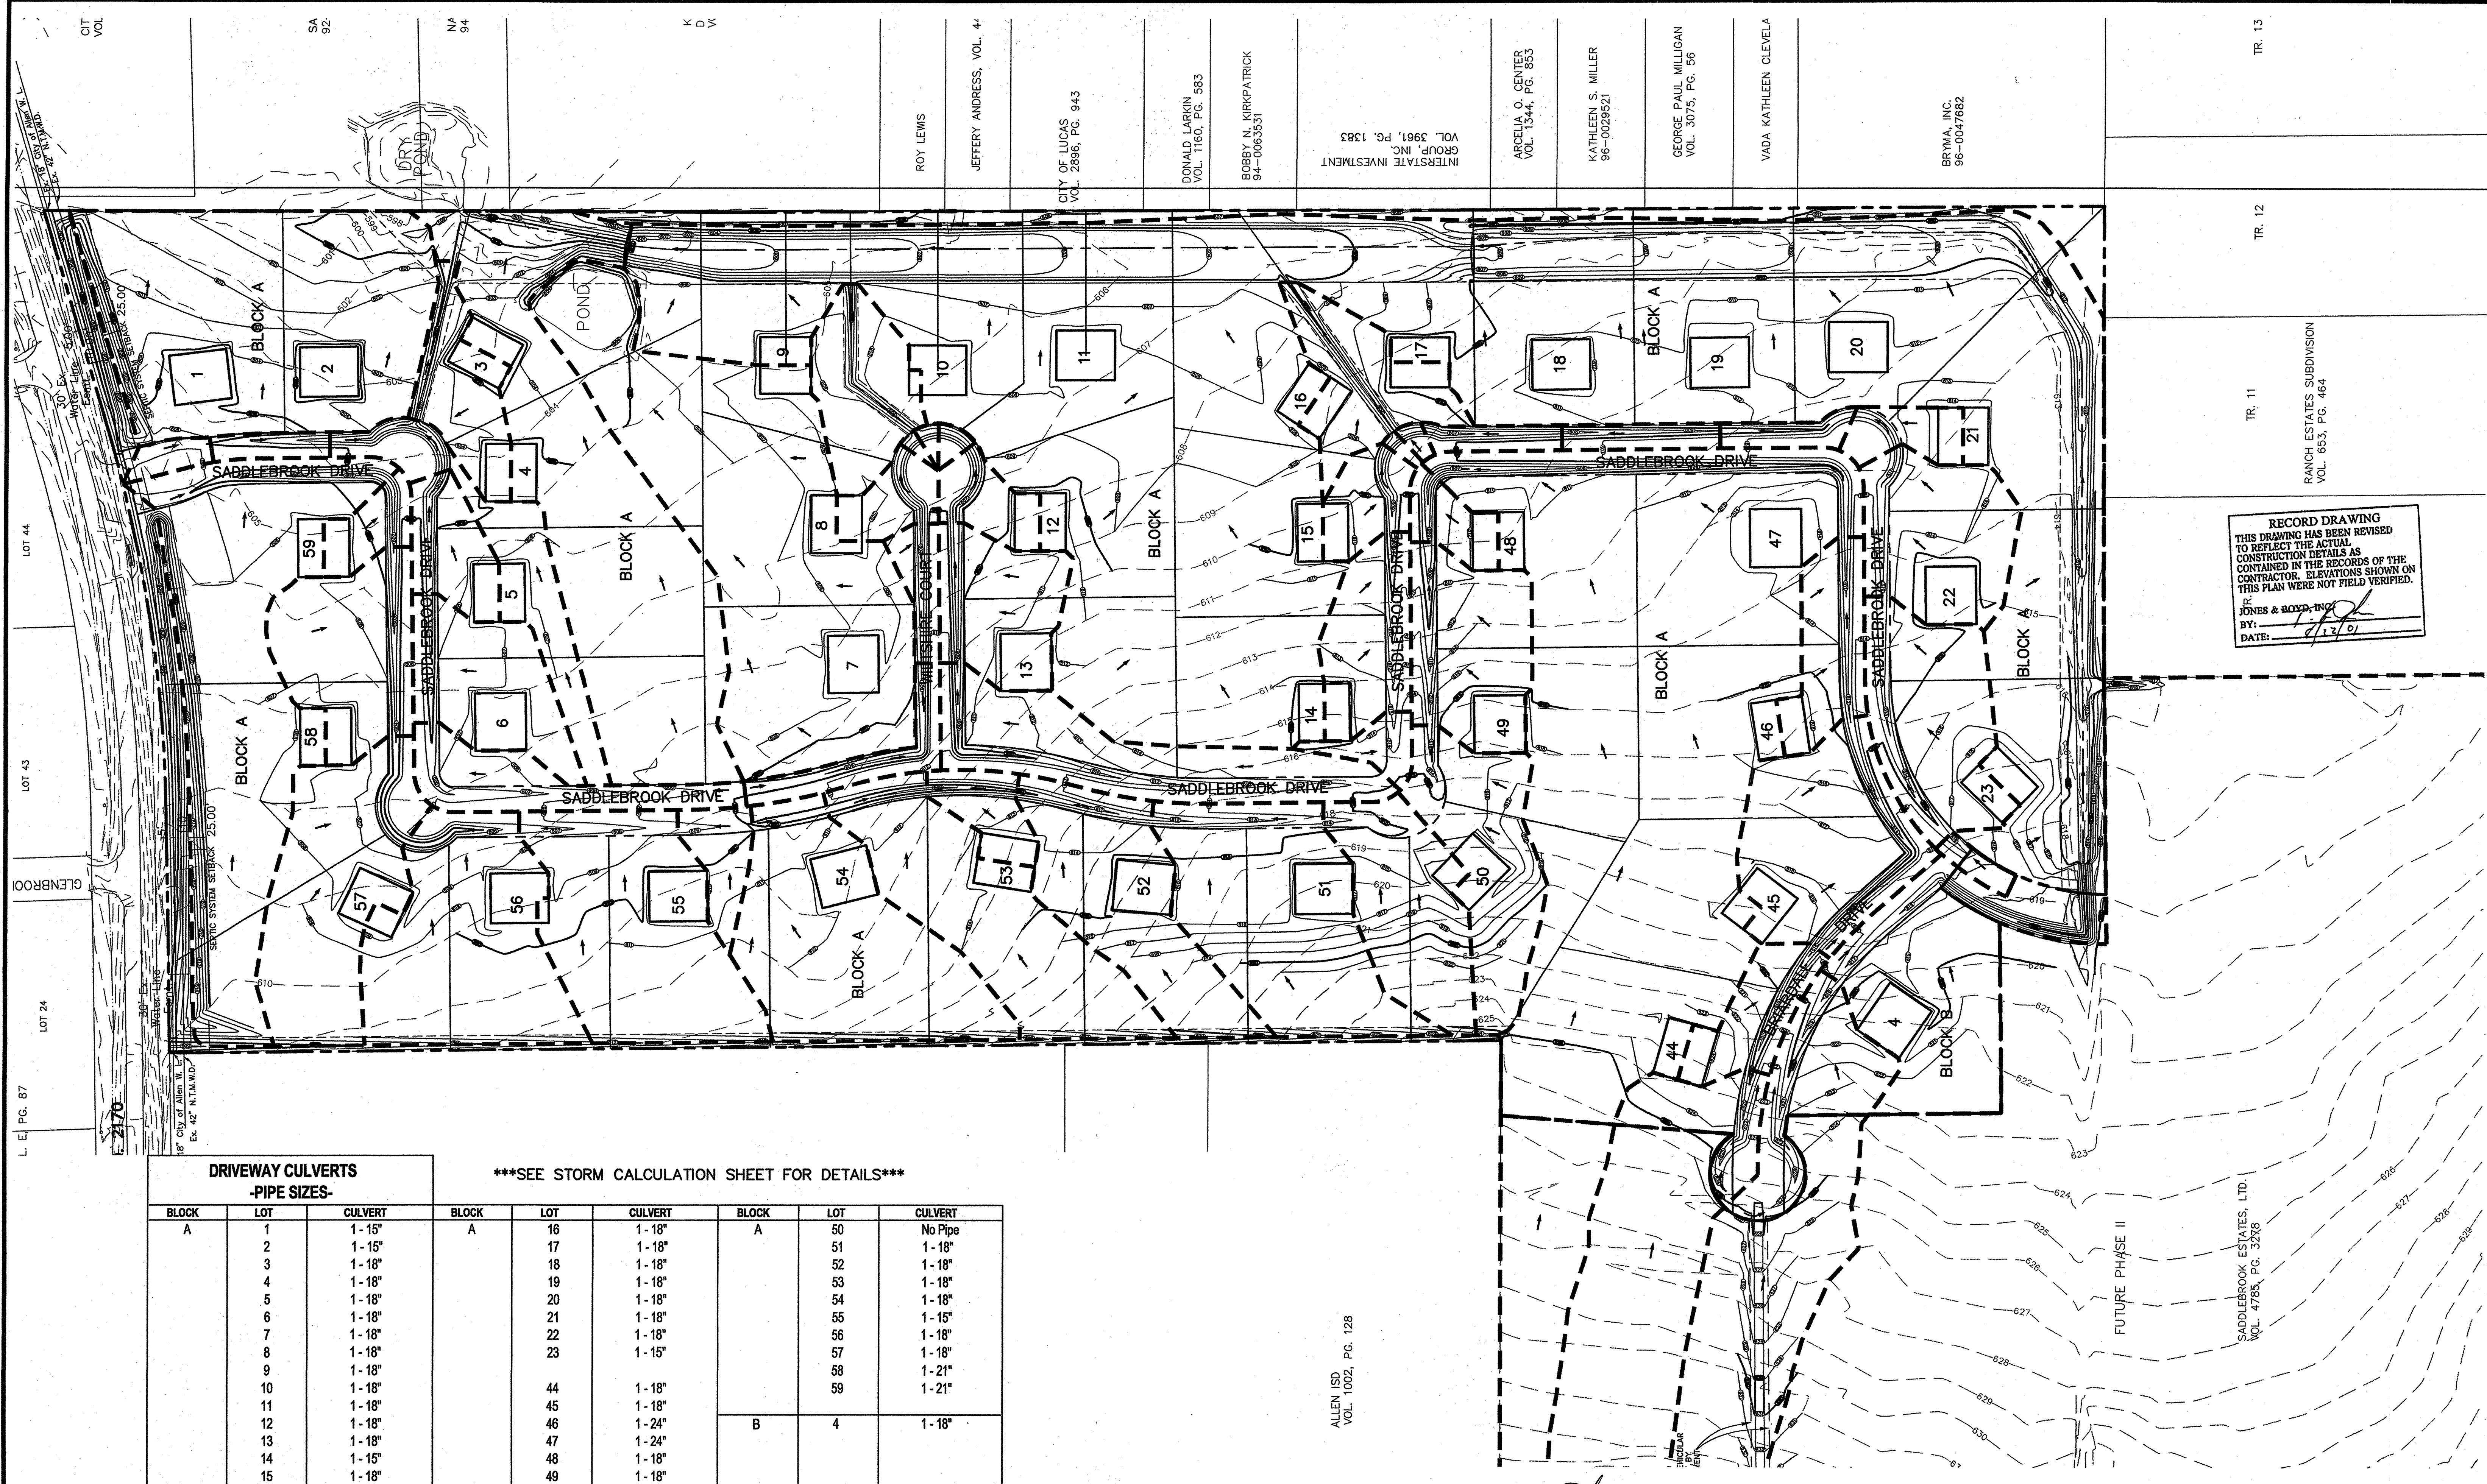

**RECORD DRAWING**  
 THIS DRAWING HAS BEEN REVISED TO REFLECT THE ACTUAL CONSTRUCTION DETAILS AS CONTAINED IN THE RECORDS OF THE CONTRACTOR. ELEVATIONS SHOWN ON THIS PLAN WERE NOT FIELD VERIFIED.  
 BY: JONES & BOYD, INC.  
 DATE: 1/27/01

**DRIVEWAY CULVERTS  
 -PIPE SIZES-**


BLOCK	LOT	CULVERT	BLOCK	LOT	CULVERT	BLOCK	LOT	CULVERT
A	1	1-15"	A	16	1-18"	A	50	No Pipe
	2	1-15"		17	1-18"		51	1-18"
	3	1-18"		18	1-18"		52	1-18"
	4	1-18"		19	1-18"		53	1-18"
	5	1-18"		20	1-18"		54	1-18"
	6	1-18"		21	1-18"		55	1-15"
	7	1-18"		22	1-18"		56	1-18"
	8	1-18"		23	1-15"		57	1-18"
	9	1-18"					58	1-21"
	10	1-18"		44	1-18"		59	1-21"
	11	1-18"		45	1-18"			
	12	1-18"		46	1-24"	B	4	1-18"
	13	1-18"		47	1-24"			
	14	1-15"		48	1-18"			
	15	1-18"		49	1-18"			

\*\*\*SEE STORM CALCULATION SHEET FOR DETAILS\*\*\*

(1) ALL PIPES WITHIN RIGHT-OF-WAY SHALL BE REINFORCED CONCRETE PIPE PER CITY STANDARDS WITH 3:1 SLOPED END SECTIONS

NO.	REVISIONS DURING CONSTRUCTION	BY	DATE	NO.	REVISIONS DURING PLAN REVIEW	BY	DATE
				2	Added City of Allen & NTMWD Easements.	CMG	01/08/01
				1	Update proposed contours.	CMG	12/19/00

The seal appearing on this document was authorized by Thomas K. Juhn, P.E. 81799 on Jan. 08, 2001. Alteration of a sealed document without proper notification to the responsible engineer is an offense under the Texas Engineering Practice Act.

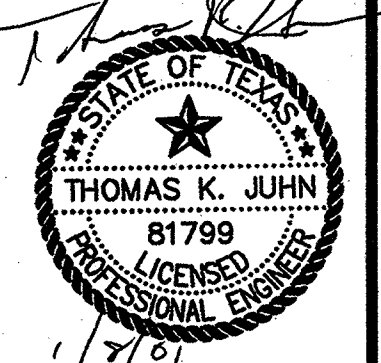

**Jones & Boyd, Inc.**  
 16800 Dallas Parkway, Suite 240  
 Dallas, Texas 75248  
 Tel: 972-248-7676  
 Fax: 972-248-1414

<b>DRAINAGE AREA MAP</b>		PROJECT NO.
Driveway Culverts		SK403
<b>SADDLEBROOK</b>		SHEET NO.
CITY OF LUCAS, COLLIN COUNTY, TEXAS		17

ROADWAY CULVERT CALCULATIONS

Theory: Rational Method

Q = CiA

Tc = Toverland + T slow concentration + T channel + T pond(if applicable)

Tc = {(0.07 (n\*Lof)^.8)/(P^\*.5\*S^\*.4)} + Ls/3600\*Vsc + Lc/3600\*Vc + Lpo/3600\*Vpo

Assume:

P = 4" per City of Dallas

n = 0.06 Mannings Coeff., Overland Flow

C = 0.6 per Table I City of Plano Runoff Coefficient for Single Family / Low Density

S = Weighted Average

Table with columns: Culvert Number, DA, Accum Area, L-overland, L-sc, L-channel, L-pipe, S-overland, S-sc, S-channel, S-pipe, V-sc, V-channel, T-overland, T-sc, T-channel, T-pipe, Tc, Tc, I-25yr, I-100yr, Run-Off, Q-25yr, Q-100yr, Tail Water, Culvert, Head Water, Velocity.

DRIVEWAY CULVERT CALCULATIONS

Theory: Rational Method: Q=CIA

Tc = Toverland + T slow concentration + T channel + T pipe + T pond (if applicable)

Tc = {(0.07 (n\*Lof)^.8)/(P^\*.5\*S^\*.4)} + Lsc/3600\*Vsc + Lc/3600\*Vc + Lpi/3600\*Vpi + Lpo/3600\*Vpo

Assume:

P = 4" per City of Lucas

n = 0.17 Mannings Coeff., Overland Flow

C = 0.44

S = Weighted Average

Large table with columns: Driveway Number, Block & Lot Number, Accum Area, L-overland, L-sh. conc., L-channel, S-overland, S-sc, V-sh. conc., V-channel, T-overland, T-sh. conc., T-channel, Tc, Tc, I-25yr, Run-Off, Q-25yr, Driveway Culvert ("RCP").



RECORD DRAWING
THIS DRAWING HAS BEEN REVISED TO REFLECT THE ACTUAL CONSTRUCTION DETAILS AS CONTAINED IN THE RECORDS OF THE CONTRACTOR. ELEVATIONS SHOWN ON THIS PLAN WERE NOT FIELD VERIFIED.
JONES & BOYD, INC.
BY: [Signature]
DATE: 5/22/01

BENCHMARKS:

- 1. "T" 1/2" IR, W of Ingram Rd. +- 1025' N of N edge of Lucas Rd. +- 6' E of fence.
2. "T" 1/2" IR, E of Ingram Rd. +- 2650' N of N edge of Lucas Rd. +- 26' E & 37' N of fence corner. Elev. 639.20

Table with columns: NO., REVISIONS DURING CONSTRUCTION, BY, DATE, NO., REVISIONS DURING PLAN REVIEW, BY, DATE.

The seal appearing on this document was authorized by Thomas K. Juhn, P.E. 81799 on Dec. 19, 2000. Alteration of a sealed document without proper notification to the responsible engineer is an offense under the Texas Engineering Practice Act.

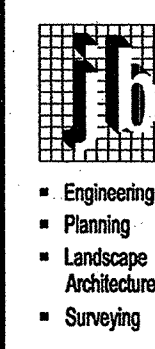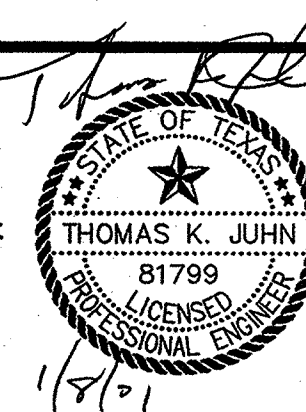

Jones & Boyd, Inc.
16800 Dallas Parkway, Suite 240
Dallas, Texas 75248
Tel: 972-248-7676
Fax: 972-248-1414

DRAINAGE CALCULATIONS


SADDLEBROOK
City of Lucas, Collin County, Texas

PROJECT NO. SK403
SHEET NO. 18

Plot time: 6:26 am
Plot date: 12/8/00
Plotted by: mag
Drawing: H:\Projects\SK403.dwg
Drawing: H:\Projects\SK403.dwg


**CULVERT C1**

CROSSING SADDLEBROOK DR. @ STA. 4+28  
INSTALL: 2-24" CULVERT & HEADWALL (see details)

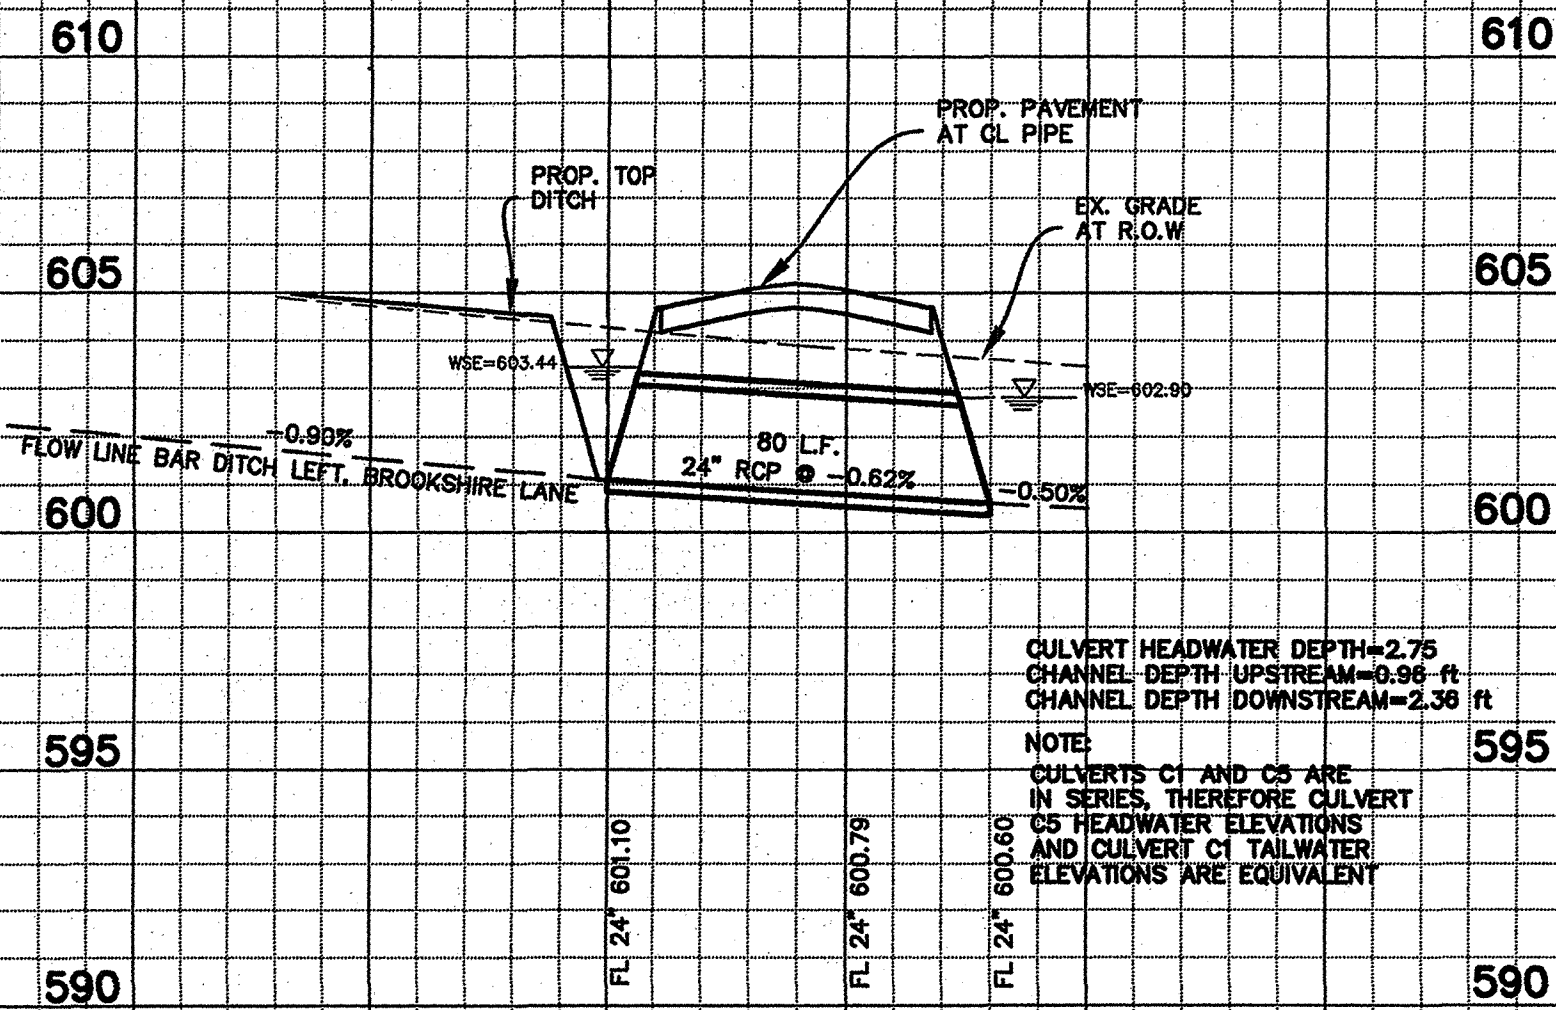


**CULVERT C2**

CROSSING SADDLEBROOK DR. NORTH OF WILTSHIRE CT.  
INSTALL: 2-24" CULVERT & HEADWALL (see details)

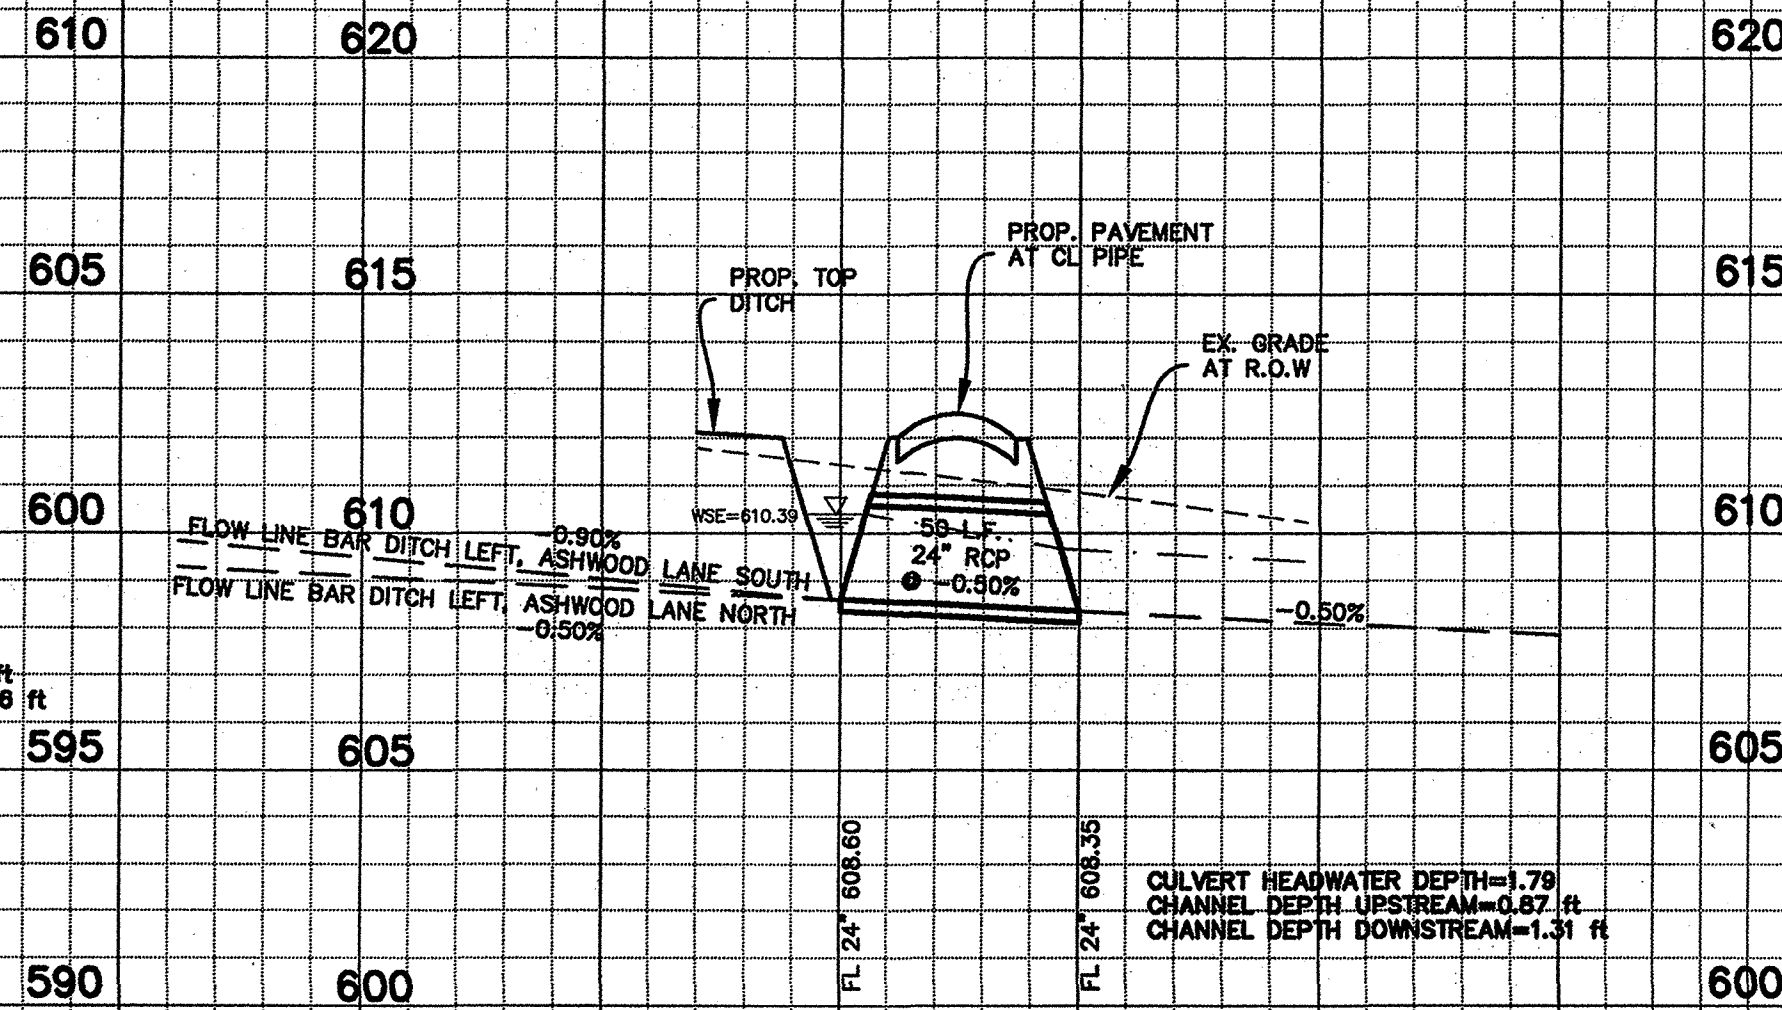


**CULVERT C3**

CROSSING SADDLEBROOK DR. @ STA. 27+37  
INSTALL: 4-24" CULVERT & HEADWALL (see details)

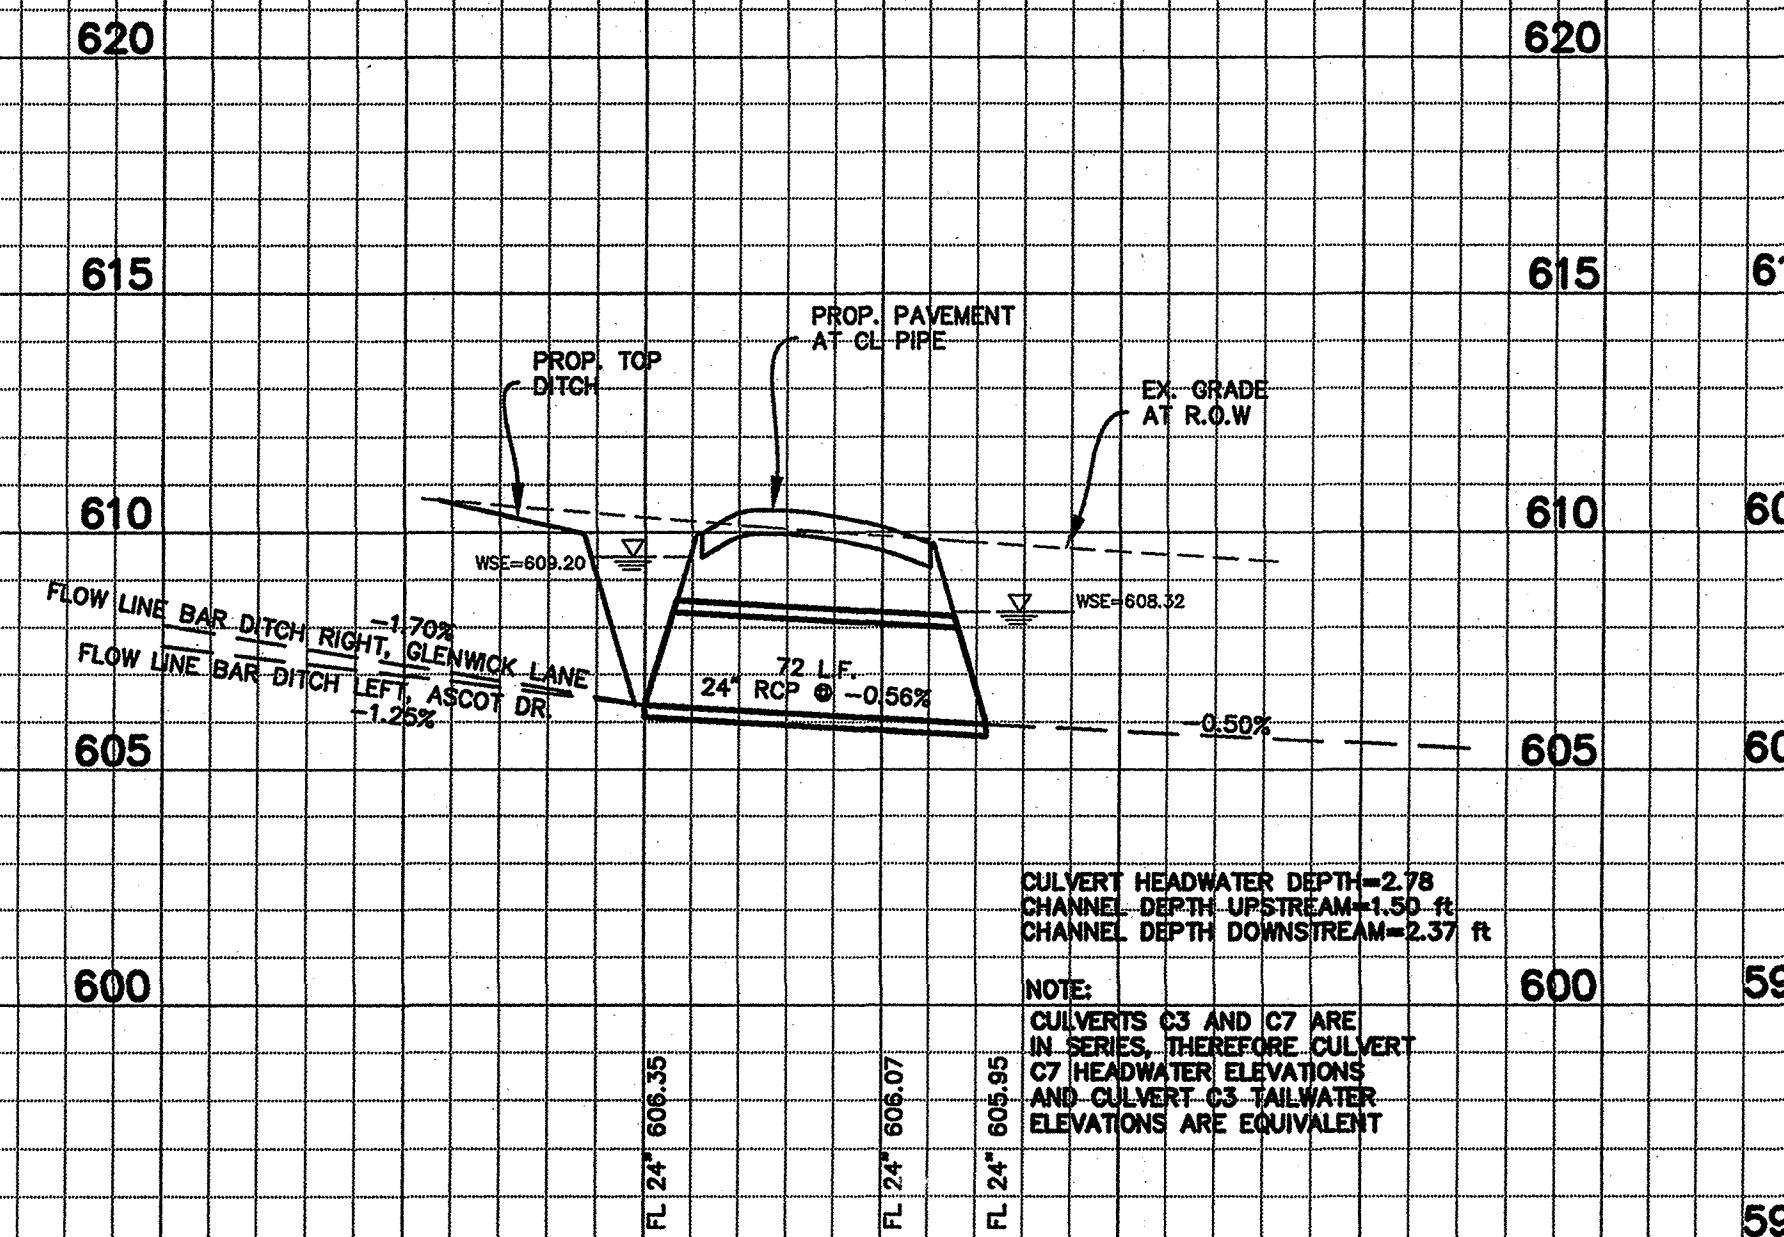


**CULVERT C4**

CROSSING SADDLEBROOK DR. @ F.M. 2170  
INSTALL: 2-4'x2' BOX CULVERT & HEADWALL (see details)

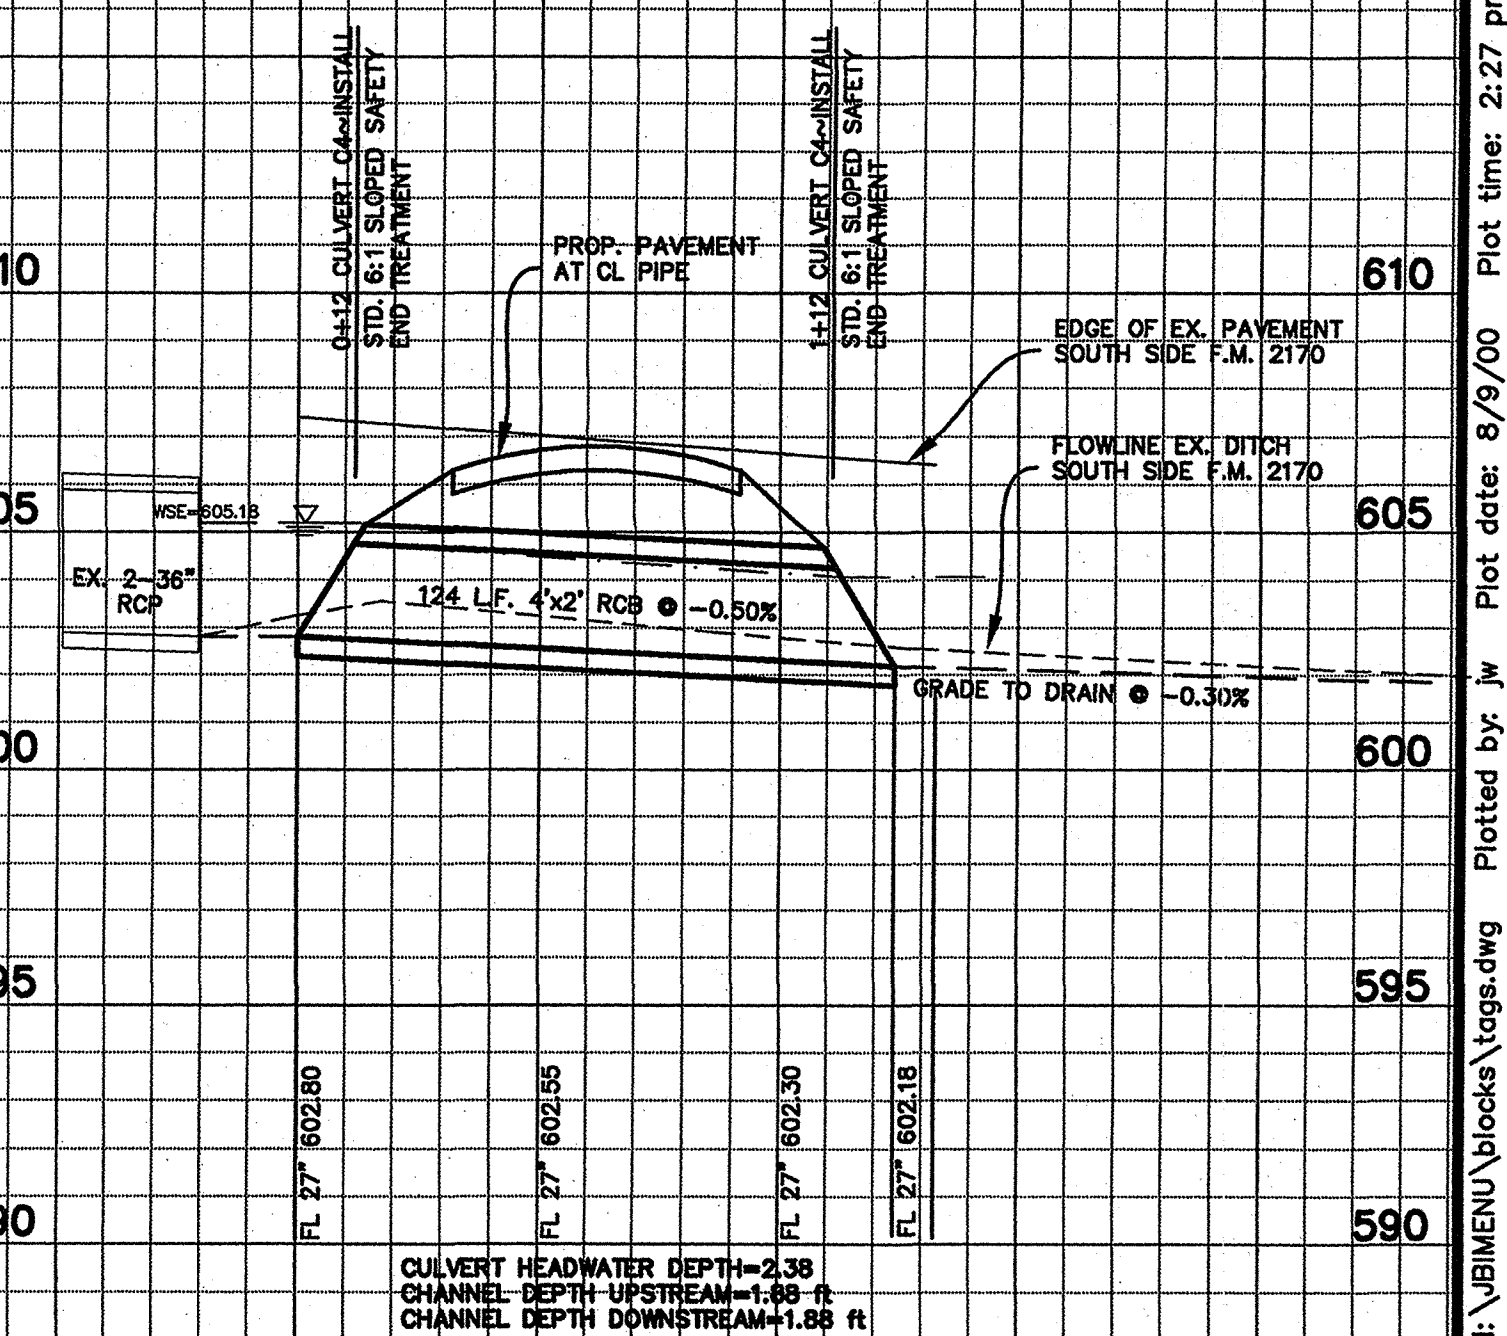


**CULVERT C5**

BETWEEN LOTS 2 & 3, BLOCK A  
INSTALL: 2-24" PVC CULVERT & HEADWALL (see details)

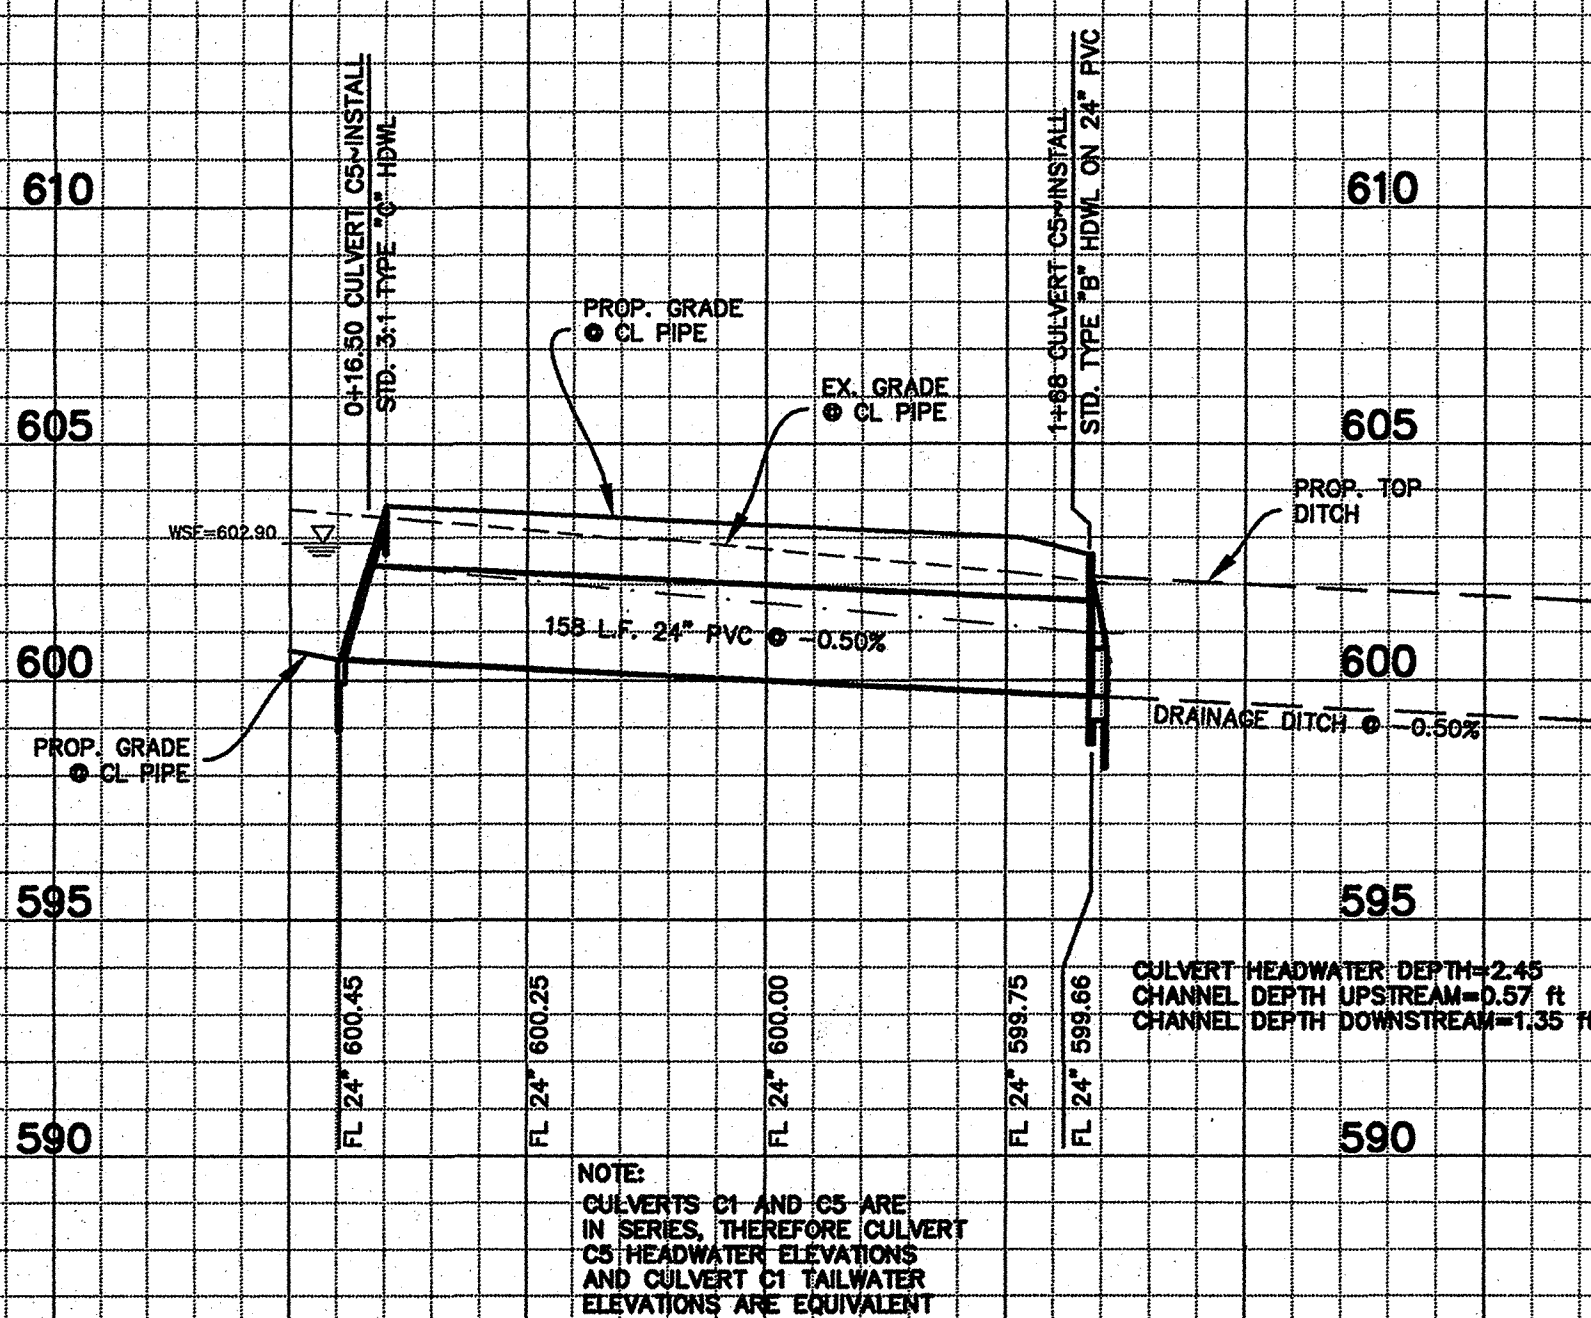


**CULVERT C6**

BETWEEN LOTS 9 & 10, BLOCK A  
INSTALL: 2-24" PVC CULVERT & HEADWALLS (see details)

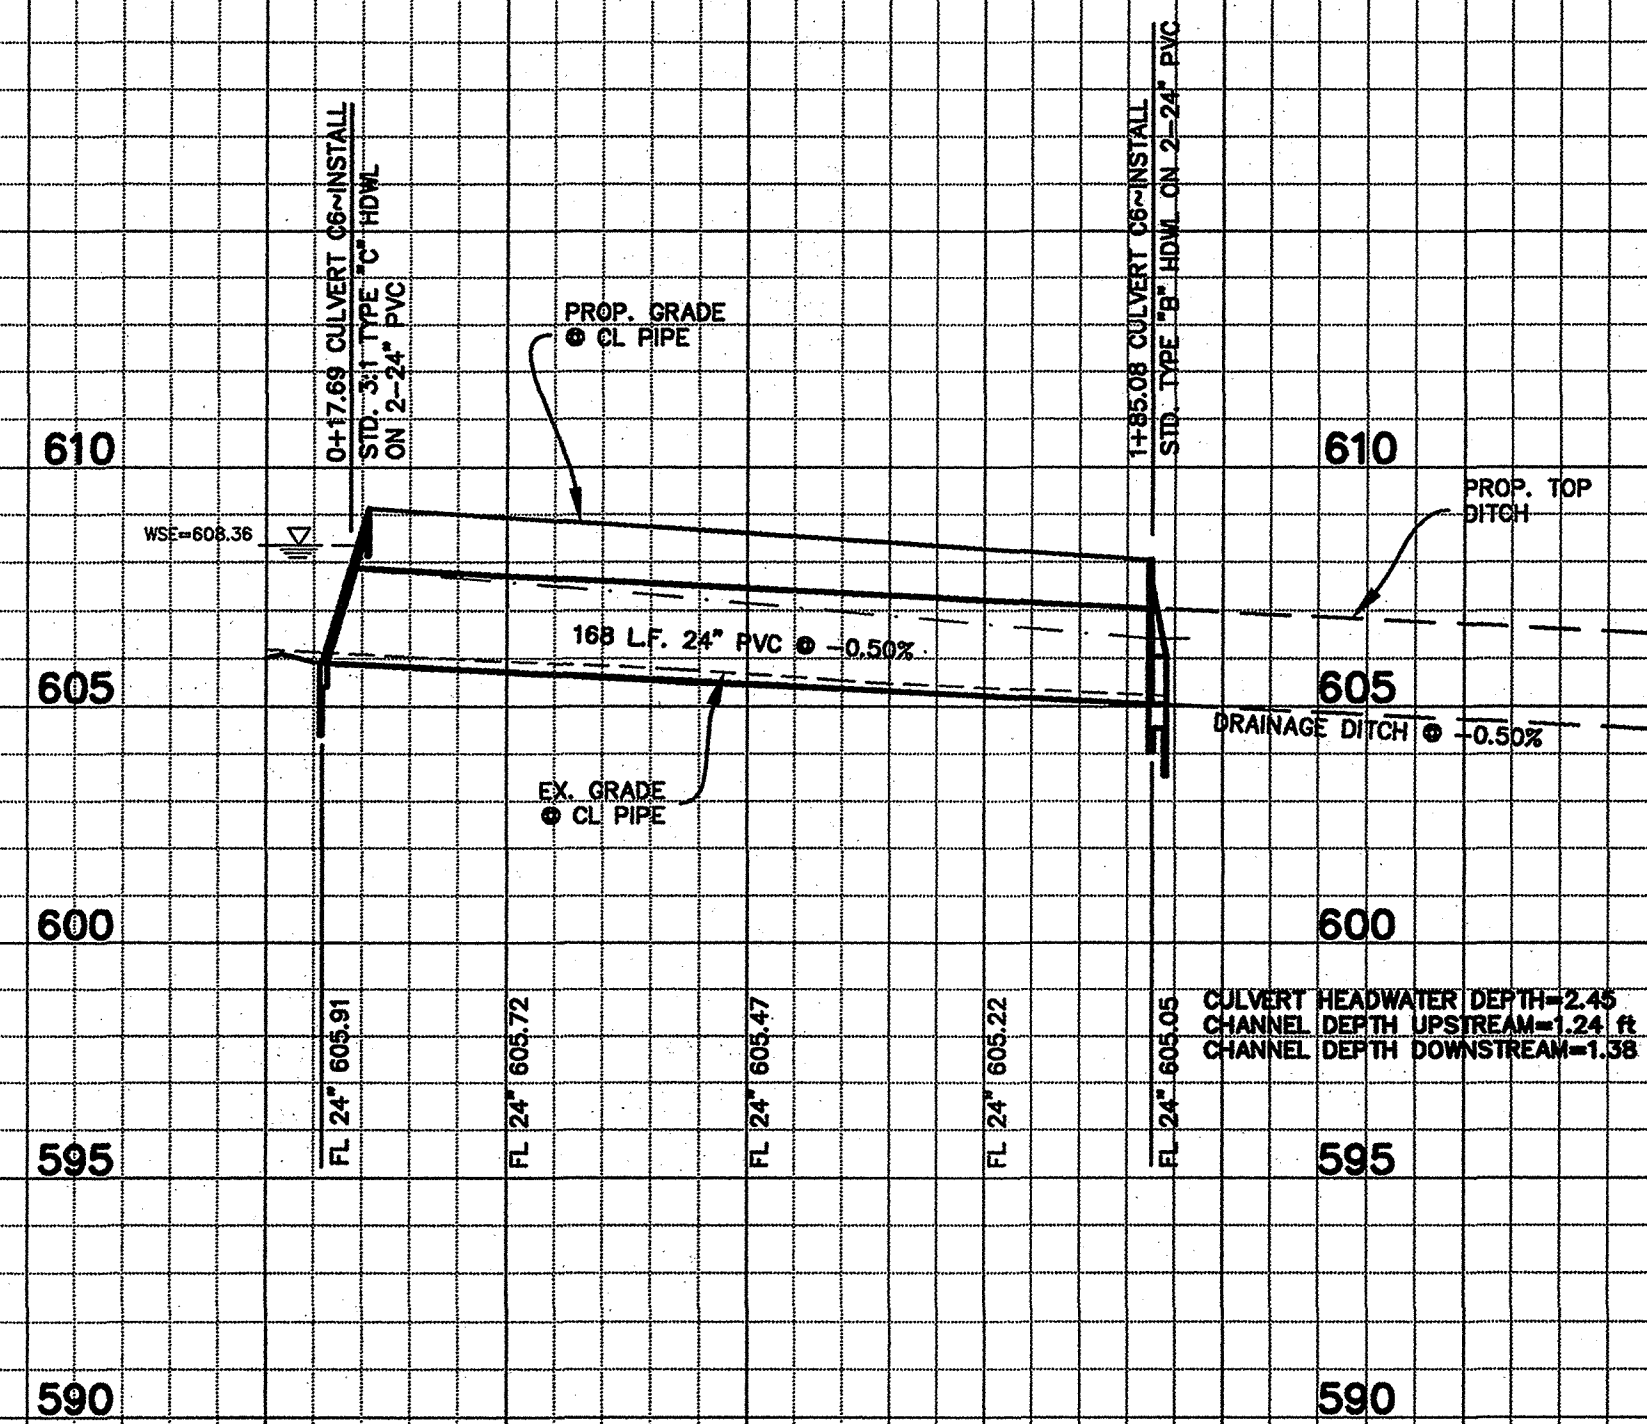

**CULVERT C7**

BETWEEN LOTS 16 & 17, BLOCK A  
INSTALL: 4-27" PVC CULVERT & HEADWALLS (see details)

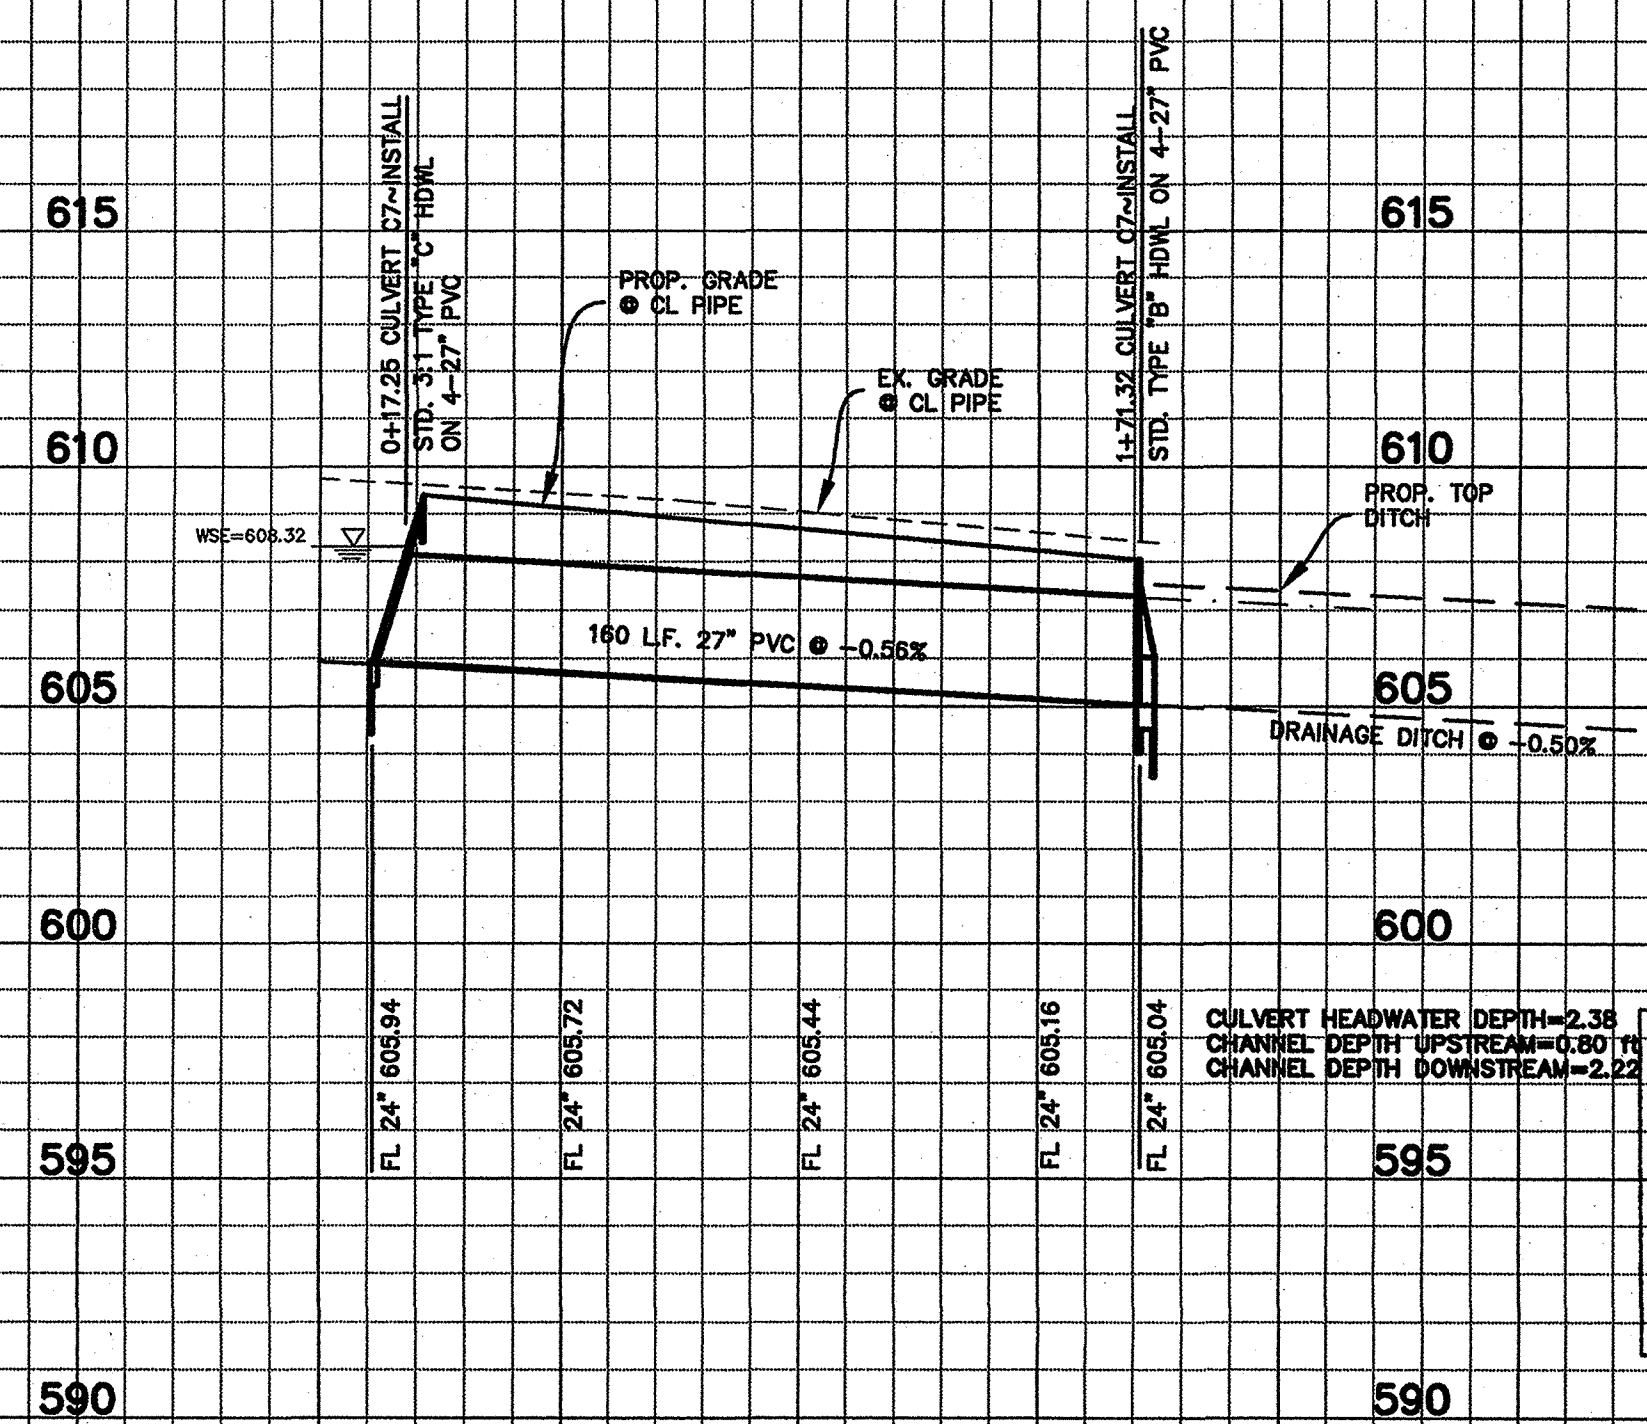


RECORD DRAWING  
THIS DRAWING HAS BEEN REVISED TO REFLECT THE ACTUAL CONSTRUCTION DETAILS AS CONTAINED IN THE RECORDS OF THE CONTRACTOR. ELEVATIONS SHOWN IN THIS PLAN WERE NOT FIELD VERIFIED.

JONES & BOYD, INC.  
BY: [Signature]  
DATE: 8/12/00

- BENCHMARKS:**
- 1/2" IR, W of Ingram Rd. +- 1025' N of N edge of Lucas Rd. +- 6' E of fence. Elev. 637.08
  - 1/2" IR, E of Ingram Rd. +- 2850' N of N edge of Lucas Rd. +- 28' E & 37' N of fence corner. Elev. 639.20

NO.	REVISIONS DURING CONSTRUCTION	BY	DATE	NO.	REVISIONS DURING PLAN REVIEW	BY	DATE
				2	REVISE CULVERTS @ F.M. 2170 & SADDLEBROOK	SC	12/19/00
				1	REVISED PER CITY COMMENTS	SC	12/08/00

The seal appearing on this document was authorized by Thomas K. Juhn, P.E. 81799 on Dec. 19, 2000. Alteration of a sealed document without proper notification to the responsible engineer is an offense under the Texas Engineering Practice Act.

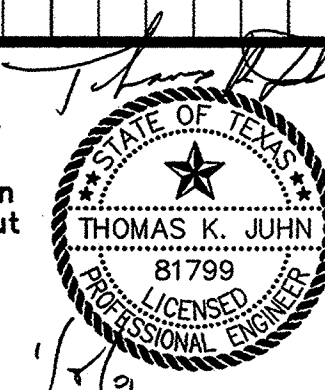

- Engineering
- Planning
- Landscaping
- Architecture
- Surveying

**Jones & Boyd, Inc.**  
16800 Dallas Parkway, Suite 240  
Dallas, Texas 75248  
Tel: 972-248-7676  
Fax: 972-248-1414


**ROADWAY CULVERT PROFILES**  
**SADDLEBROOK**  
City of Lucas, Collin County, Texas

PROJECT NO.  
**SK403**  
SHEET NO.  
**19**

**SECTION A**


**DEVELOPED**  
 $Q_{100}=236.4$  cfs  
 $d=1.40$  ft  
 $S_f=0.0050$  ft/ft  
 $V=2.90$  fps

**UNDEVELOPED**  
 $Q_{100}=240.7$  cfs  
 $d=1.41$  ft  
 $S_f=0.0050$  ft/ft  
 $V=2.91$  fps

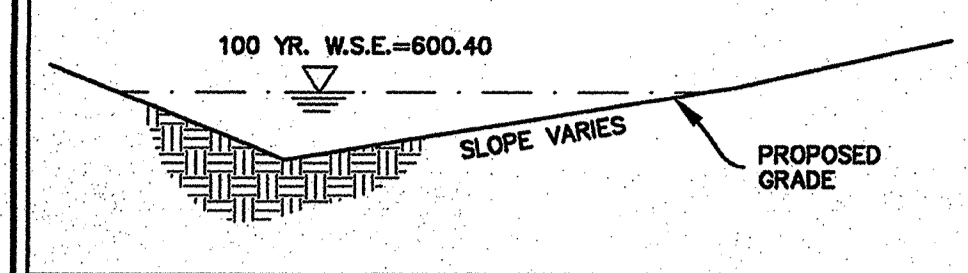



**SECTION B**

**SECTION B**  
 $Q_{100}=167.2$  cfs  
 $d=1.93$  ft  
 $S_f=0.0050$  ft/ft  
 $V=2.72$  fps

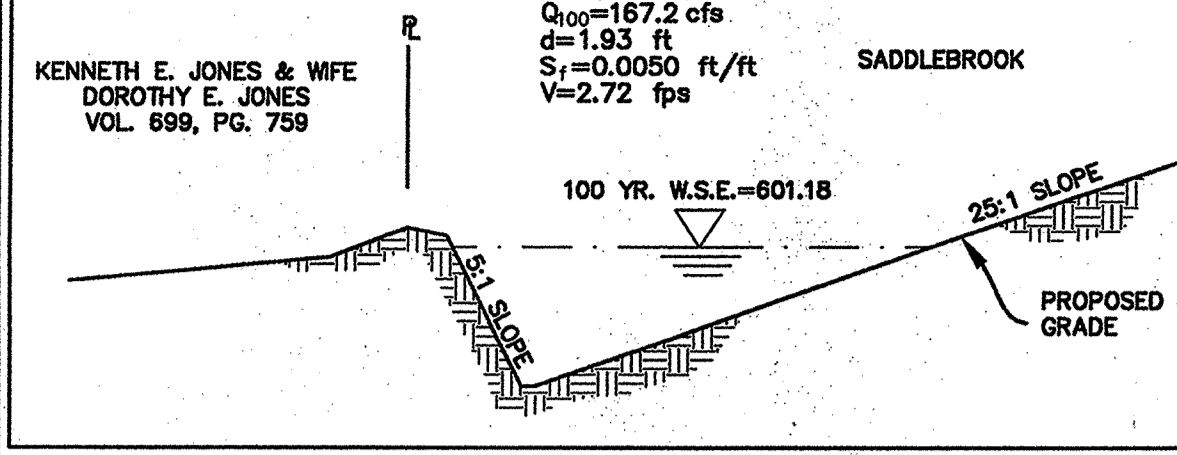

**SECTION C**



**SECTION C**  
 $Q_{100}=167.2$  cfs  
 $d=2.15$  ft  
 $S_f=0.0050$  ft/ft  
 $V=4.42$  fps

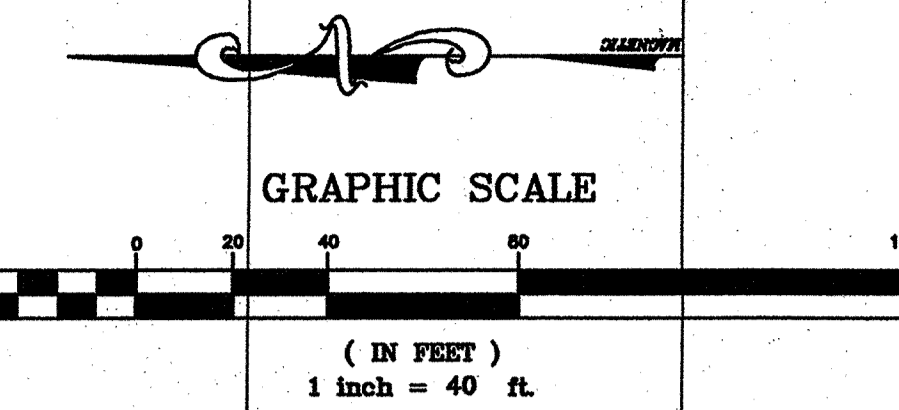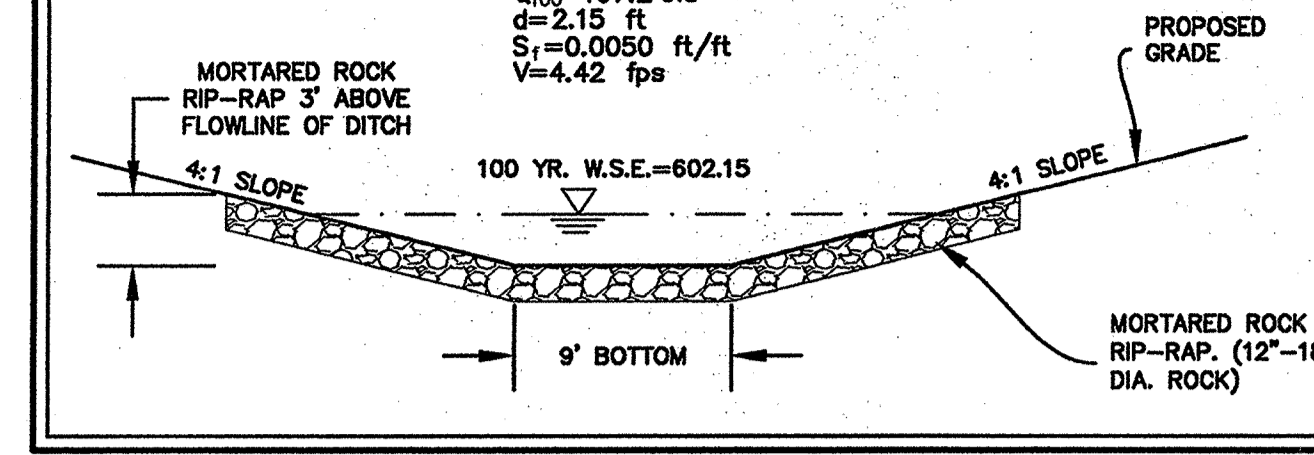

VOL. 961,  
 PG. 1383  
 GROUP, INC.  
 INTERSTATE  
 INVESTMENT

DONALD  
 LARKIN VOL.  
 1160, PG.  
 583

BOBBY N. KIRKPATRICK  
 94-0063531

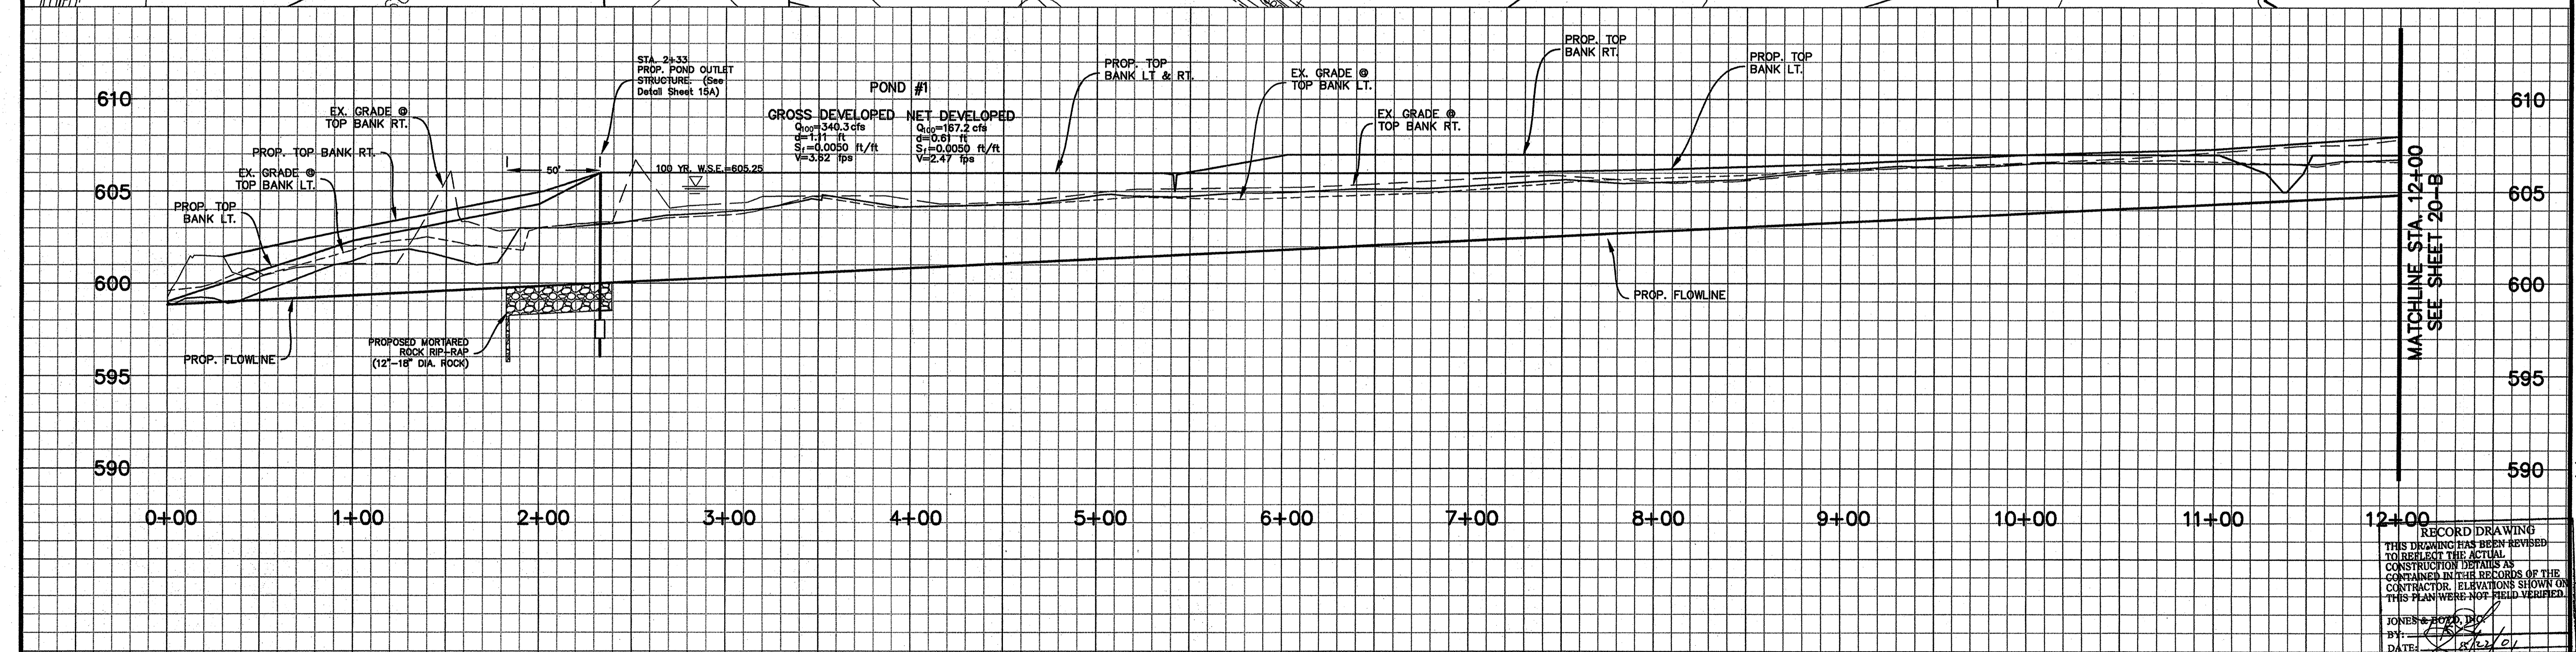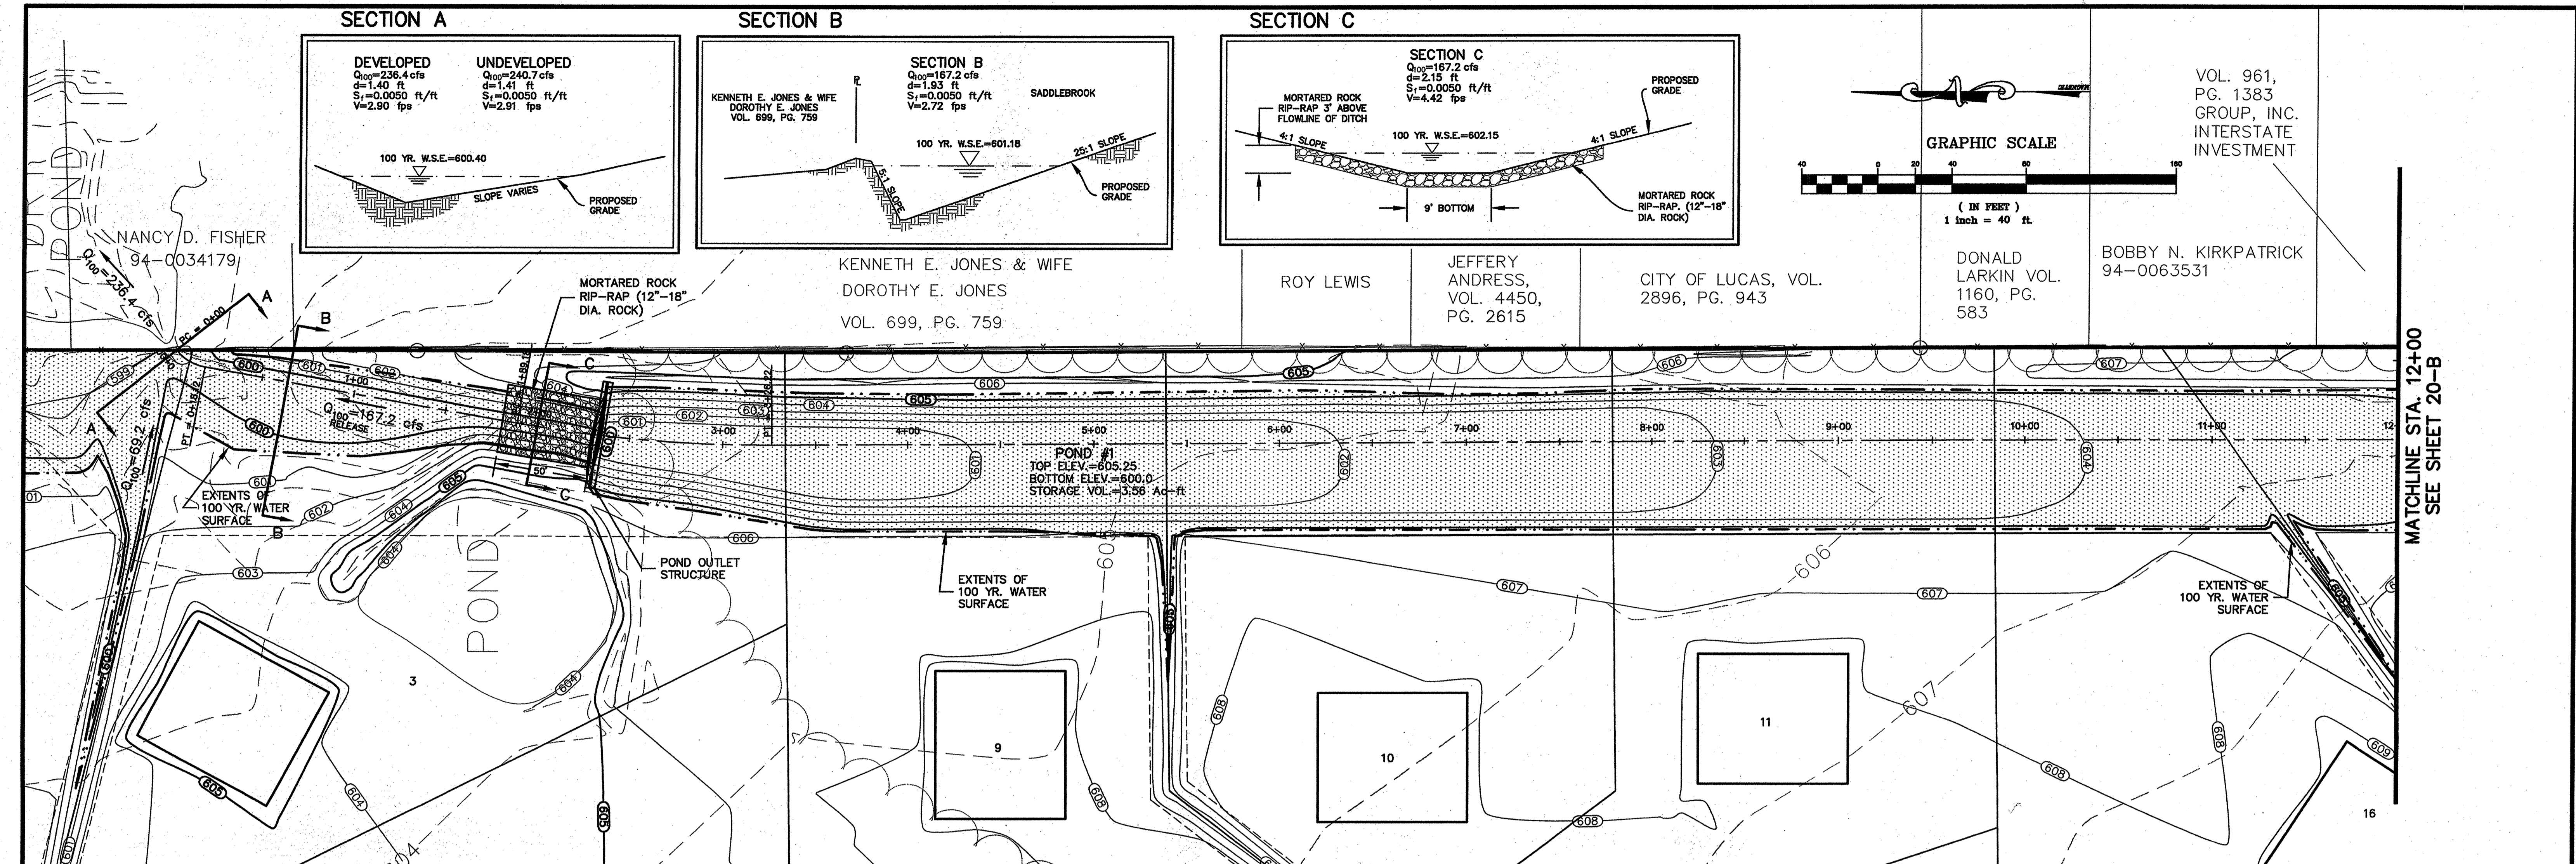

- BENCHMARKS:**
1. "1/2" IR, W of Ingram Rd. +- 1025' N of N edge of Lucas Rd. +- 6' E of fence. Elev. 637.08
  2. "1/2" IR, E of Ingram Rd. +- 2850' N of N edge of Lucas Rd. +- 28' E & 37' N of fence corner. Elev. 639.20

NO.	REVISIONS DURING CONSTRUCTION	BY	DATE	NO.	REVISIONS DURING PLAN REVIEW	BY	DATE
				3	ADDED SECTION B	SC	12/22/01
				2	REVISED PER CITY COMMENTS	SC	12/19/01
				1	REVISED PER CITY COMMENTS	SC	12/08/01

The seal appearing on this document was authorized by Thomas K. Juhn, P.E. 81799 on Dec. 22, 2000. Alteration of a sealed document without proper notification to the responsible engineer is an offense under the Texas Engineering Practice Act.

**Jones & Boyd, Inc.**  
 16800 Dallas Parkway, Suite 240  
 Dallas, Texas 75248  
 Tel: 972-248-7676  
 Fax: 972-248-1414

**POND & DITCH PROFILE**  
 STA. 0+00 to 12+00  
**SADDLEBROOK**  
 City of Lucas, Collin County, Texas





PROJECT NO. SK403  
 SHEET NO. 20A

RECORD DRAWING  
 THIS DRAWING HAS BEEN REVISED TO REFLECT THE ACTUAL CONSTRUCTION DETAILS AS CONTAINED IN THE RECORDS OF THE CONTRACTOR. ELEVATIONS SHOWN ON THIS PLAN WERE NOT FIELD VERIFIED.

JONES & BOYD, INC.  
 BY: [Signature]  
 DATE: 12/22/01



SECTION D

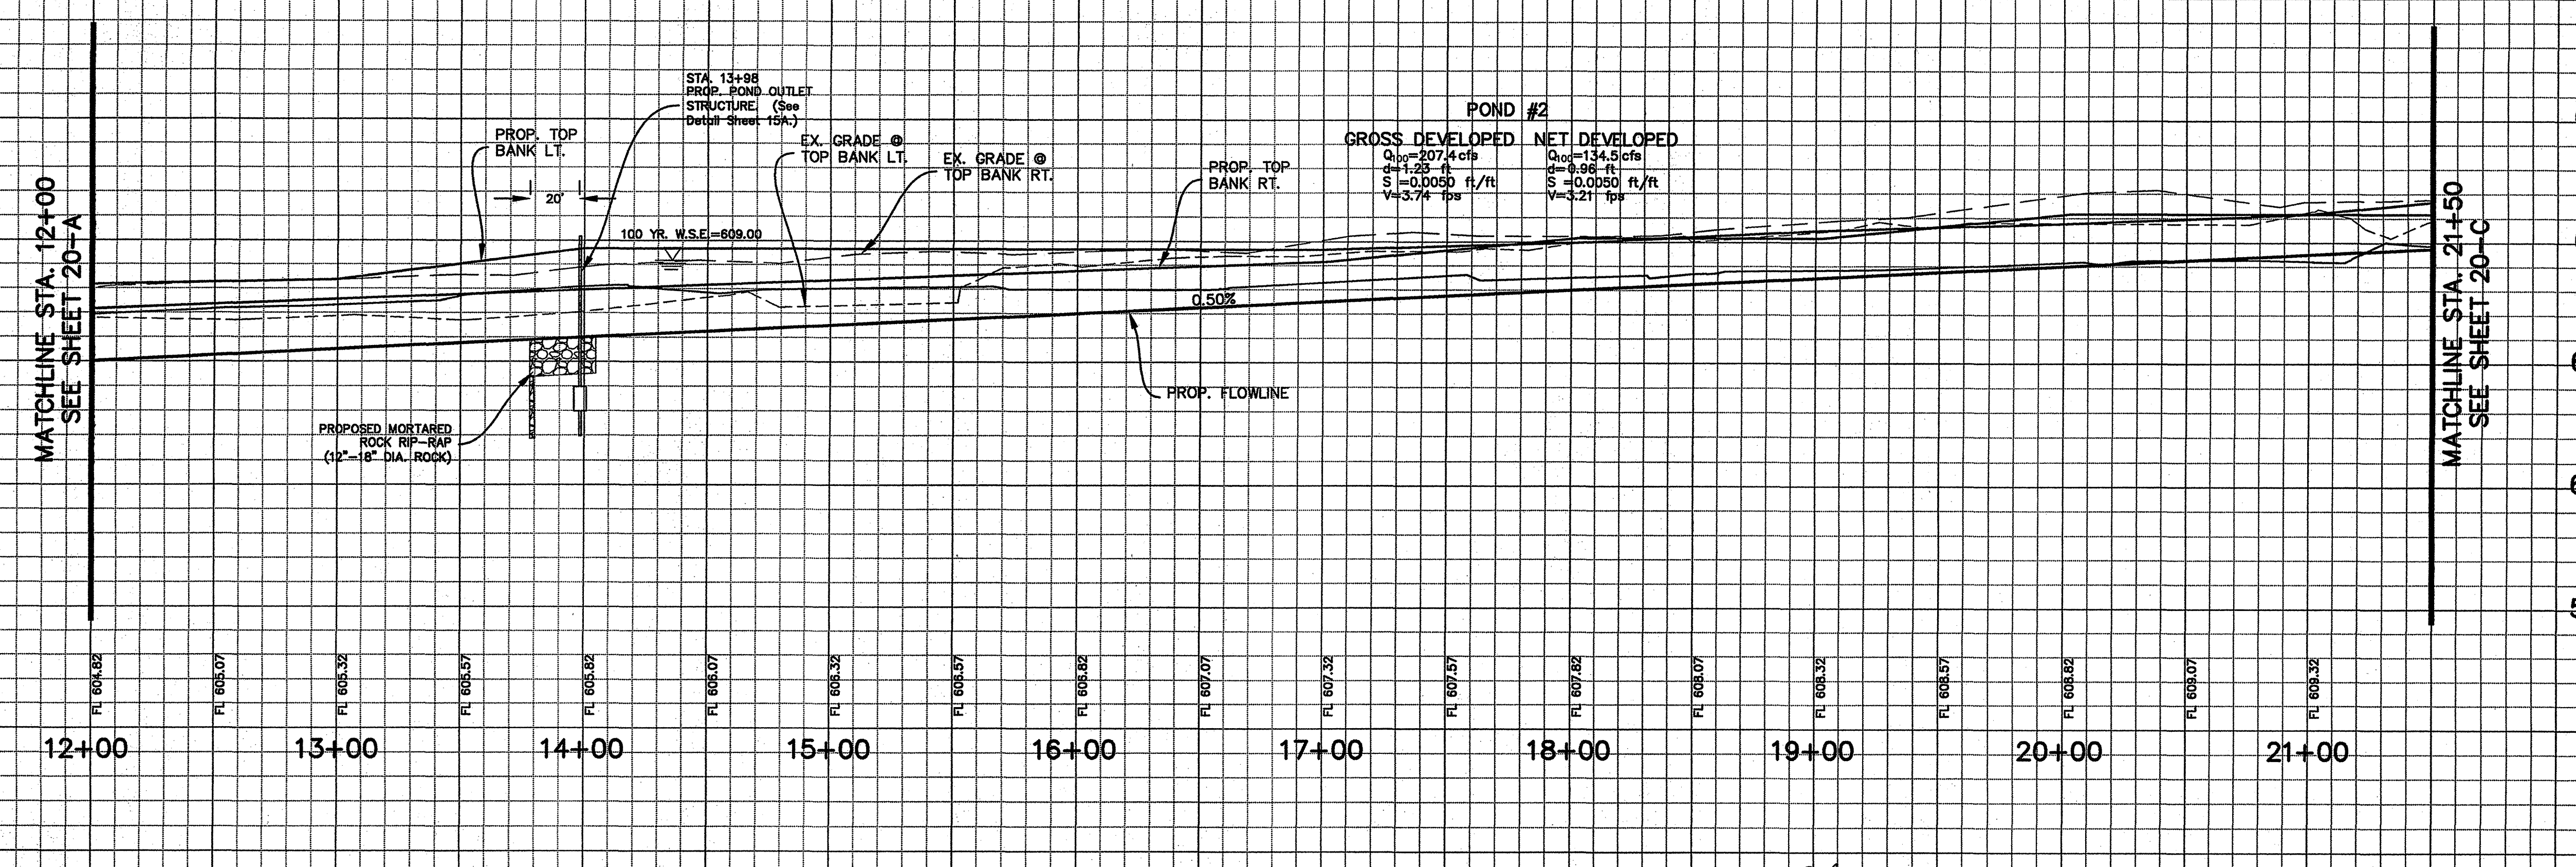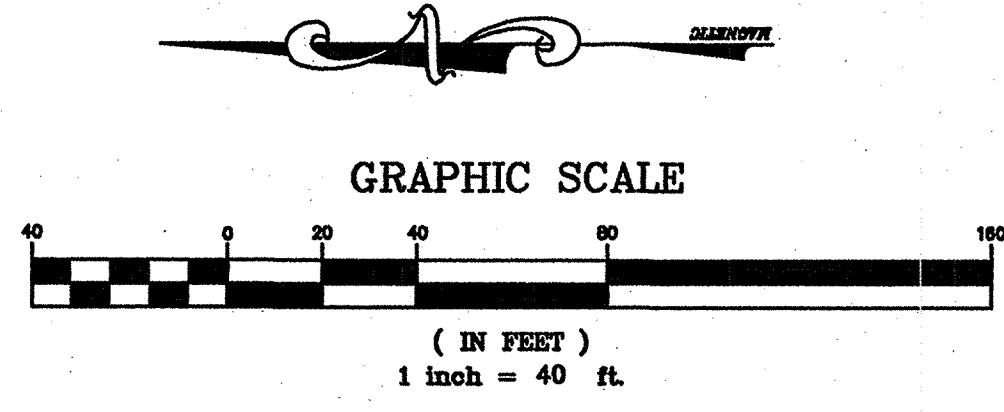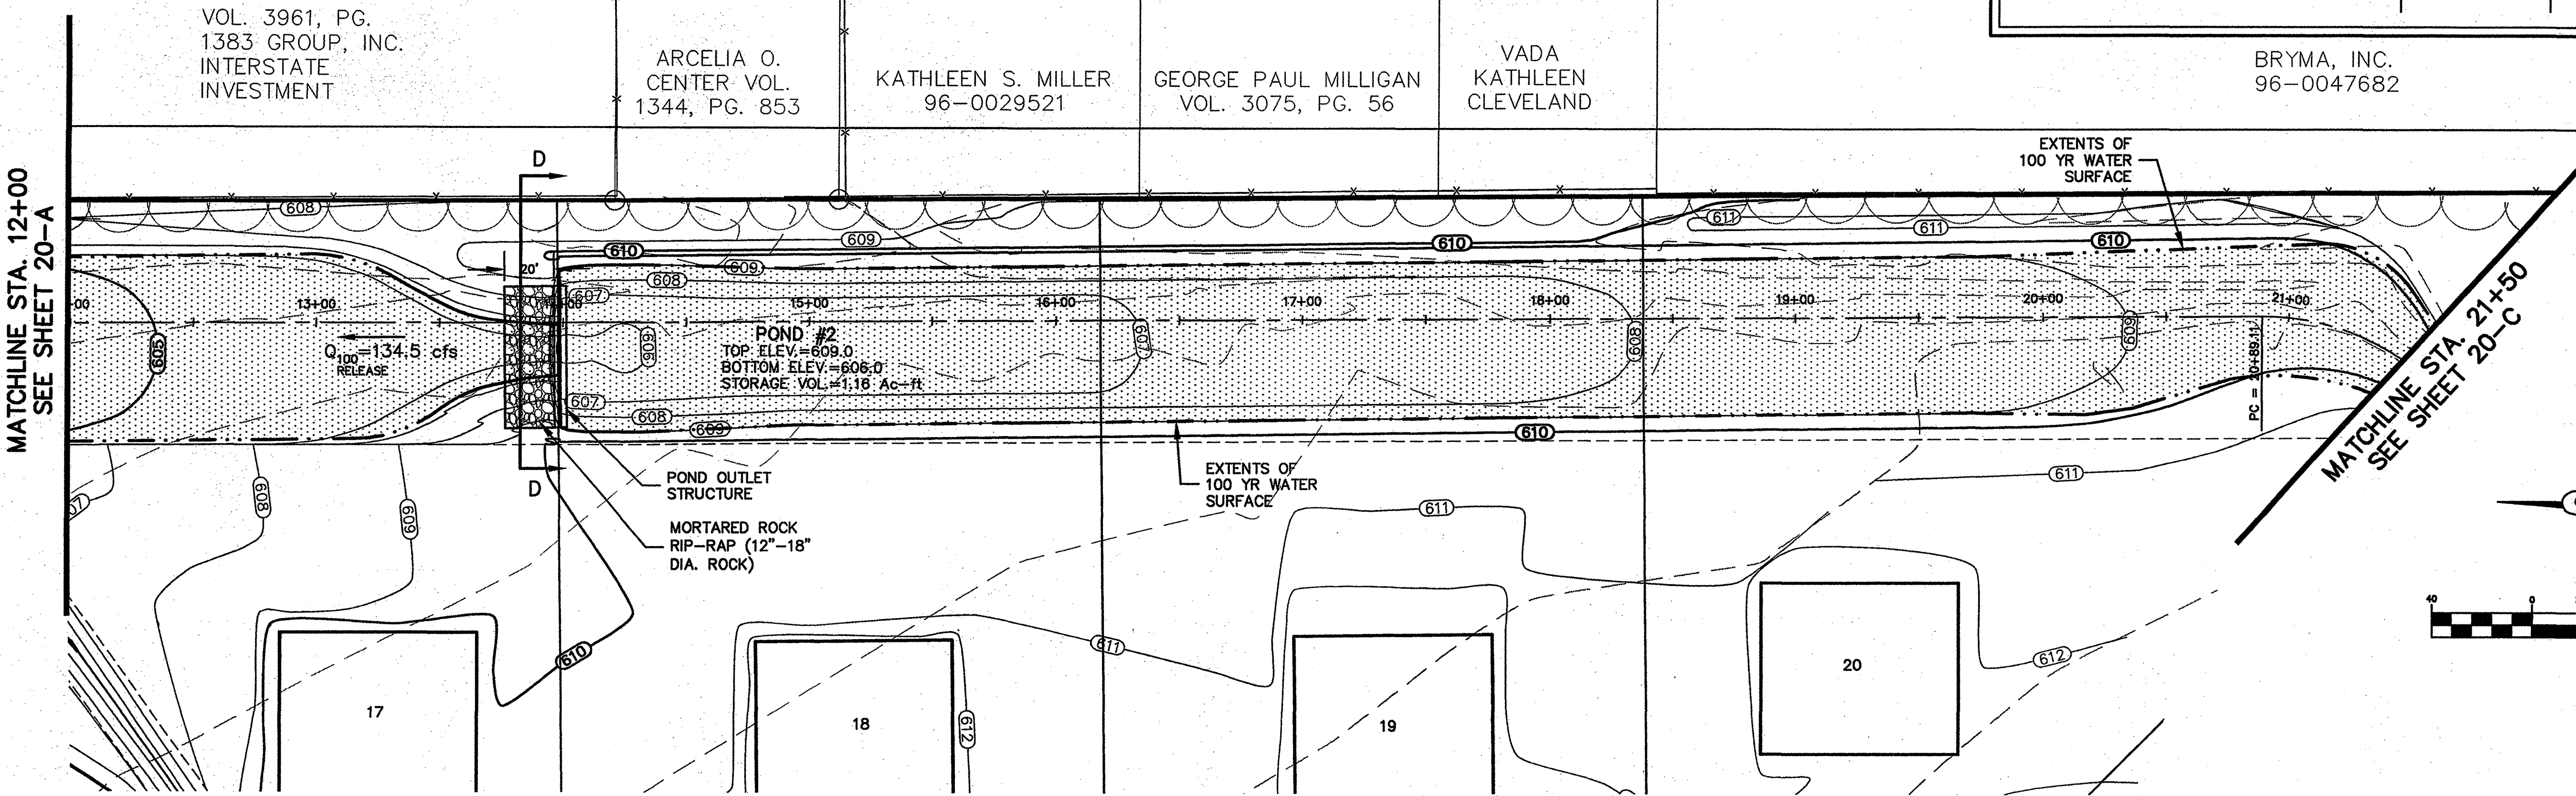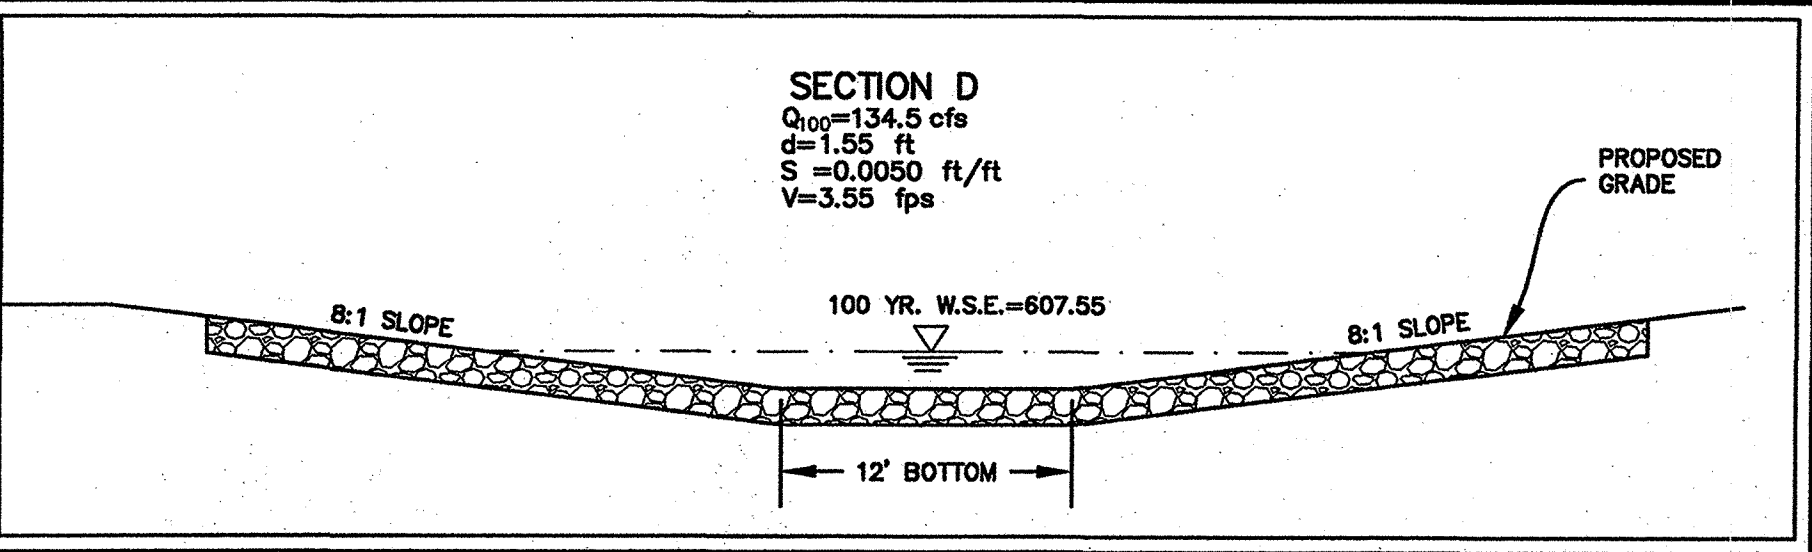


RECORD DRAWING  
 THIS DRAWING HAS BEEN REVISED TO REFLECT THE ACTUAL CONSTRUCTION DETAILS AS CONTAINED IN THE RECORDS OF THE CONTRACTOR. ELEVATIONS SHOWN ON THIS PLAN WERE NOT FIELD VERIFIED.  
 BY: [Signature]  
 DATE: 1/28/14

- BENCHMARKS:
1. " 1/2" IR, W of Ingram Rd. +- 1025' N of N edge of Lucas Rd. +- 6' E of fence. Elev. 637.08
  2. " 1/2" IR, E of Ingram Rd. +- 2650' N of N edge of Lucas Rd. +- 28' E & 37' N of fence corner. Elev. 639.20

NO.	REVISIONS DURING CONSTRUCTION	BY	DATE	NO.	REVISIONS DURING PLAN REVIEW	BY	DATE
				2	REVISED PER CITY COMMENTS	SC	12/19/06
				1	REVISED PER CITY COMMENTS	SC	12/08/06


The seal appearing on this document was authorized by Thomas K. Juhn, P.E. 81799 on Dec. 22, 2000. Alteration of a sealed document without proper notification to the responsible engineer is an offense under the Texas Engineering Practice Act.

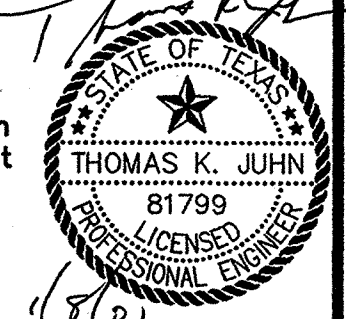


**Jones & Boyd, Inc.**  
 16800 Dallas Parkway, Suite 240  
 Dallas, Texas 75248  
 Tel: 972-248-7676  
 Fax: 972-248-1414

**POND & DITCH PROFILE**  
 STA. 12+00 to 21+50  
**SADDLEBROOK**  
 City of Lucas, Collin County, Texas

PROJECT NO. SK403  
 SHEET NO. 20B

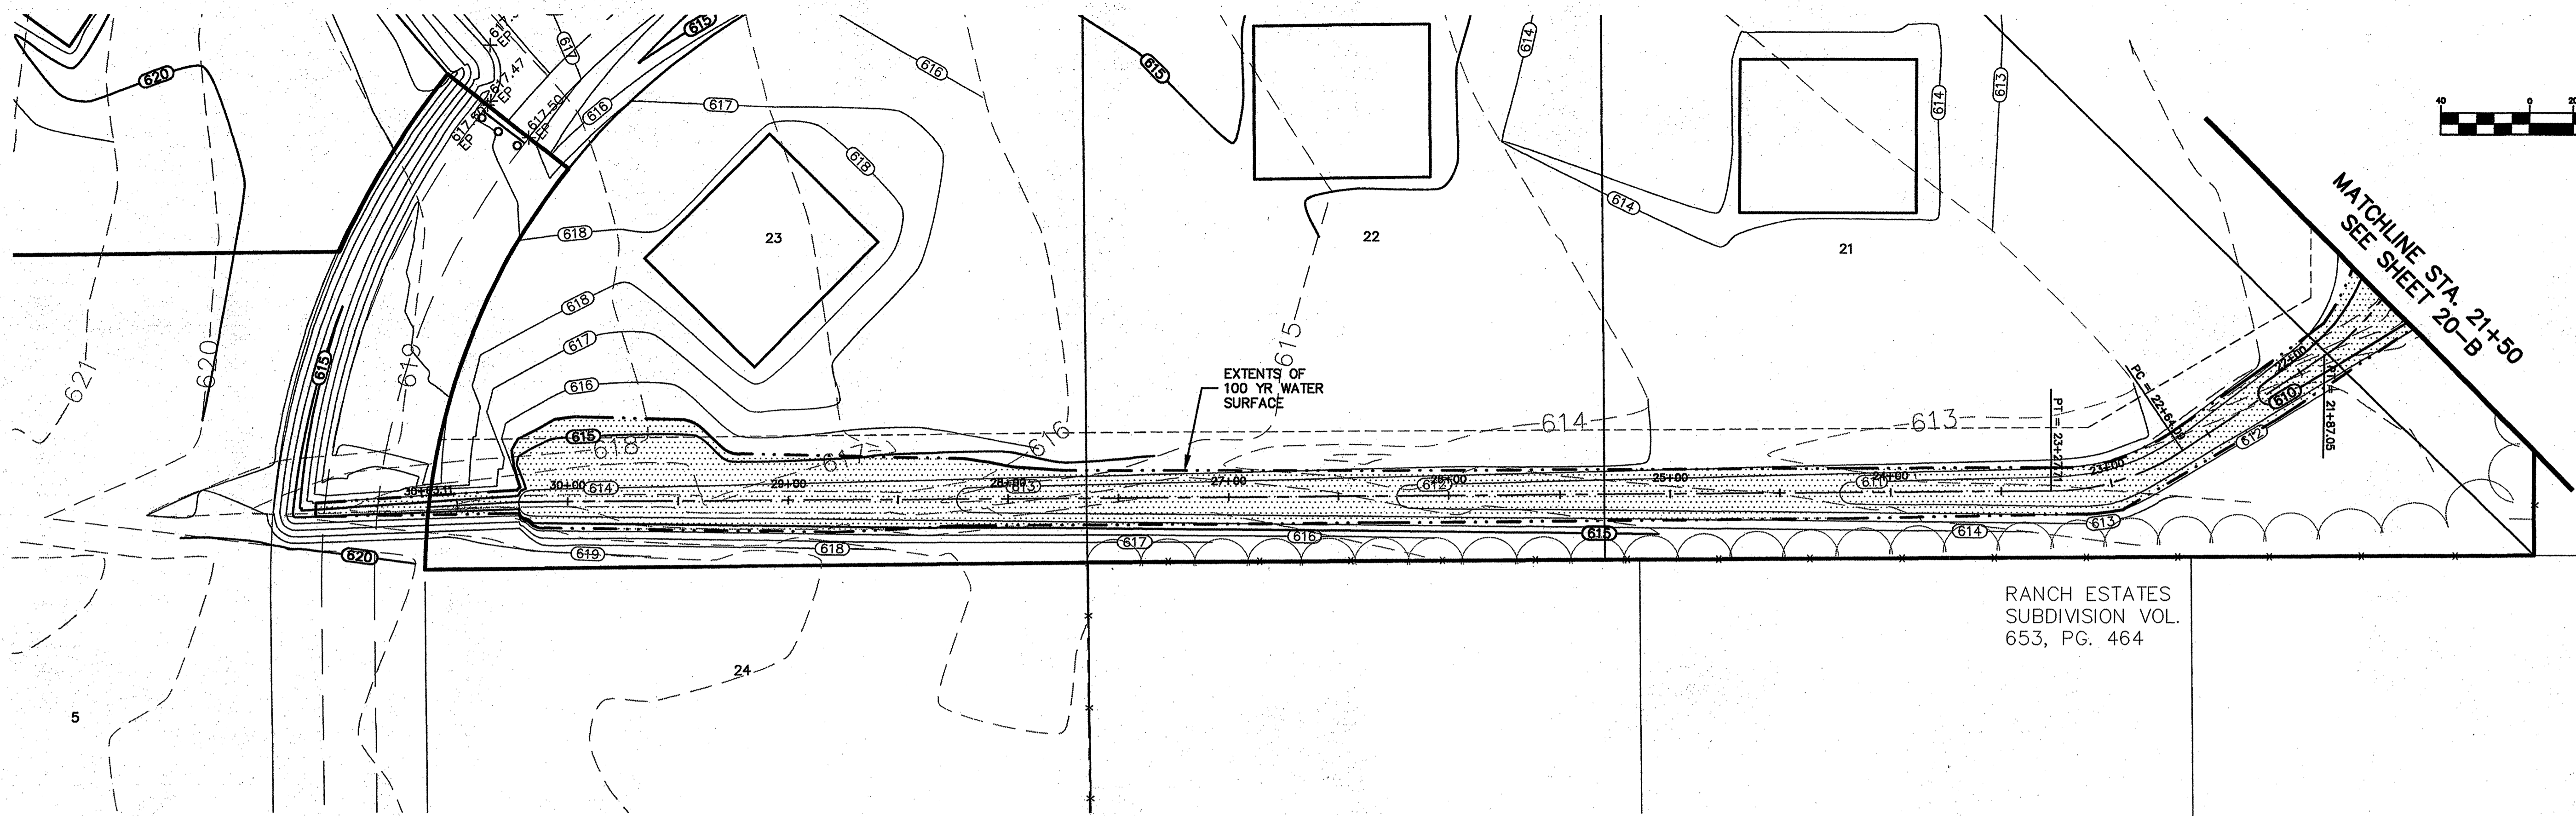

RANCH ESTATES  
SUBDIVISION VOL.  
653, PG. 464

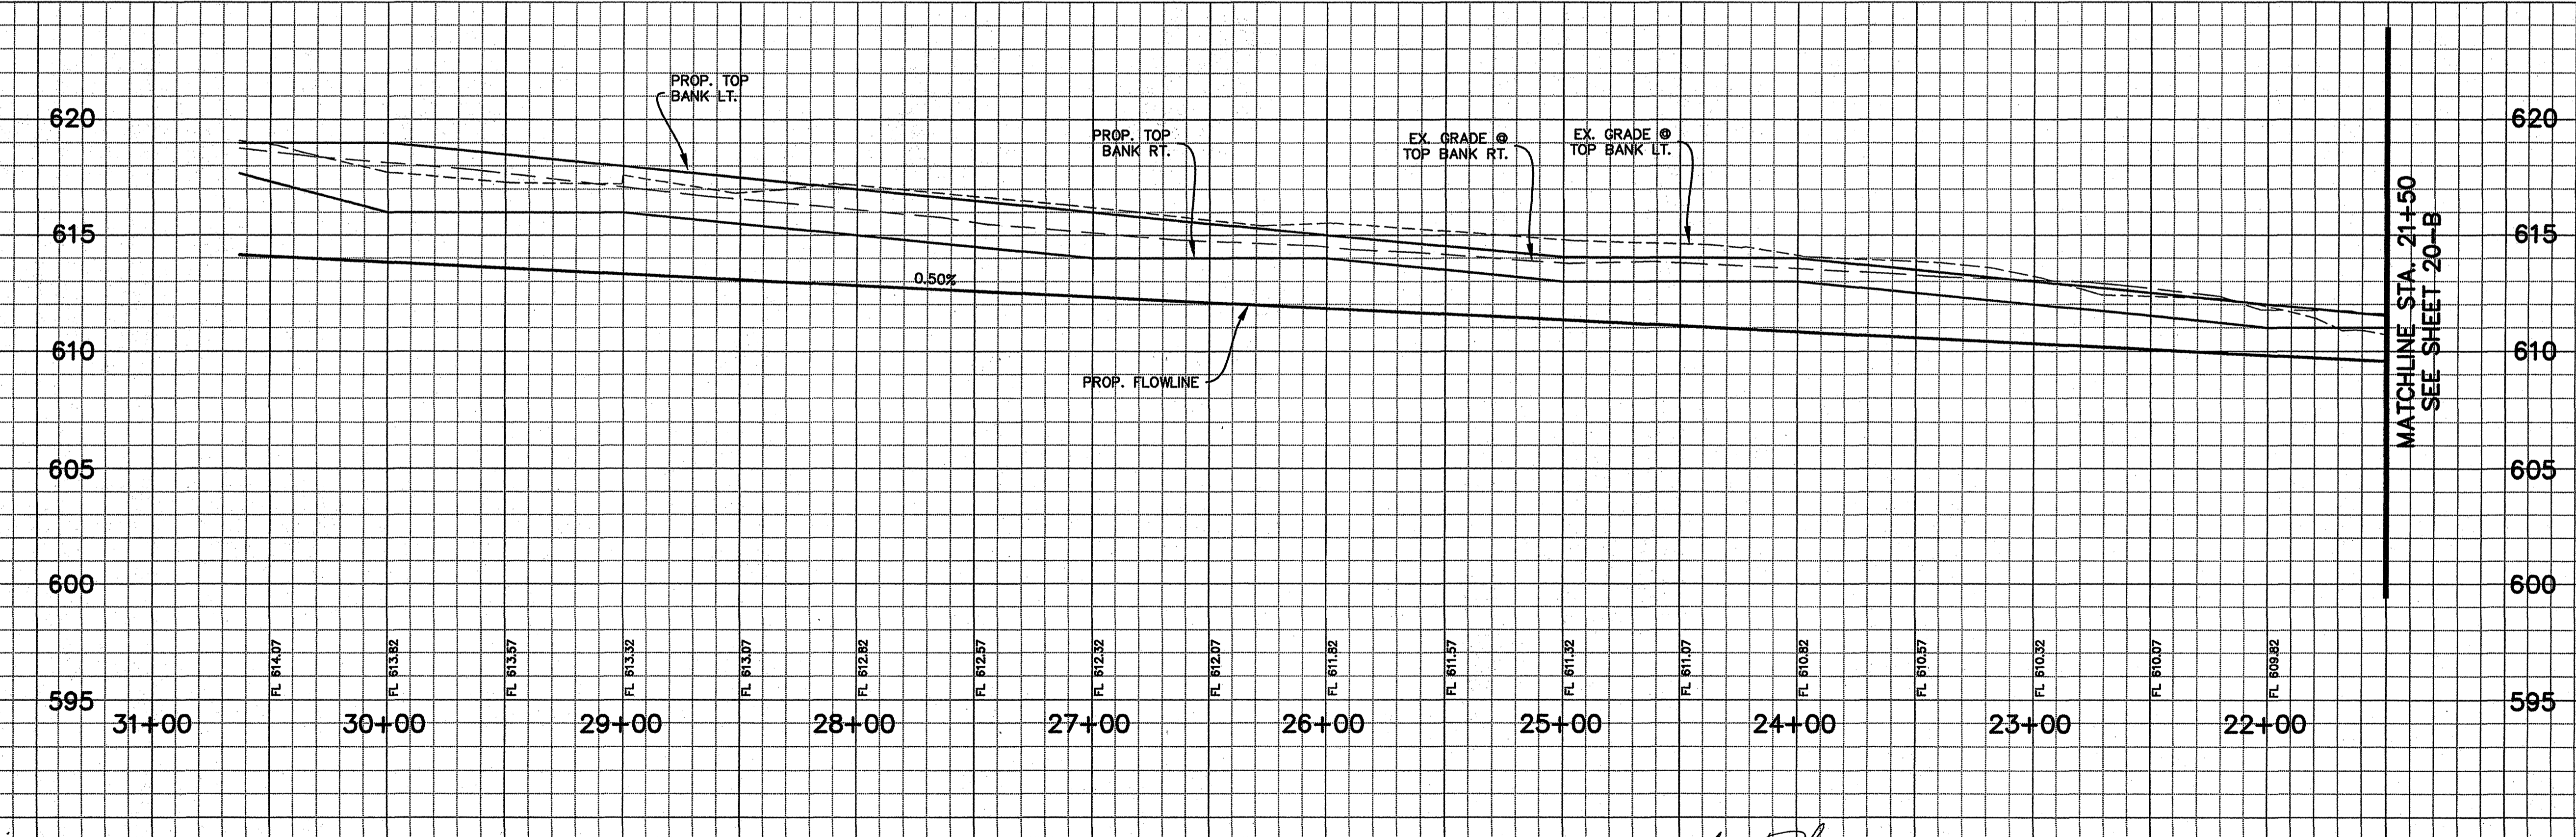


RECORD DRAWING  
THIS DRAWING HAS BEEN REVISED  
TO REFLECT THE ACTUAL  
CONSTRUCTION DETAILS AS  
CONTAINED IN THE RECORDS OF THE  
CONTRACTOR. ELEVATIONS SHOWN ON  
THIS PLAN WERE NOT FIELD VERIFIED.  
BY: [Signature]  
DATE: 1/22/01

- BENCHMARKS:**
1. "T" 1/2" IR, W of Ingram Rd. +- 1025' N of N edge of Lucas Rd. +- 6' E of fence. Elev. 637.08
  2. "T" 1/2" IR, E of Ingram Rd. +- 2650' N of N edge of Lucas Rd. +- 28' E & 37' N of fence corner. Elev. 639.20



NO.	REVISIONS DURING CONSTRUCTION	BY	DATE	NO.	REVISIONS DURING PLAN REVIEW	BY	DATE
				2	REVISED PER CITY COMMENTS	SC	12/19/00
				1	REVISED PER CITY COMMENTS	SC	12/08/00

The seal appearing on this document was authorized by Thomas K. Juhn, P.E. 81799 on Dec. 19, 2000. Alteration of a sealed document without proper notification to the responsible engineer is an offense under the Texas Engineering Practice Act.

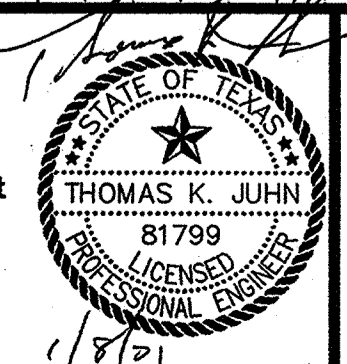

**Jones & Boyd, Inc.**  
16800 Dallas Parkway, Suite 240  
Dallas, Texas 75248  
Tel: 972-248-7676  
Fax: 972-248-1414

<b>POND &amp; DITCH PROFILE</b>		PROJECT NO.
STA. 21+50 to End		SK403
<b>SADDLEBROOK</b>		SHEET NO.
City of Lucas, Collin County, Texas		20C

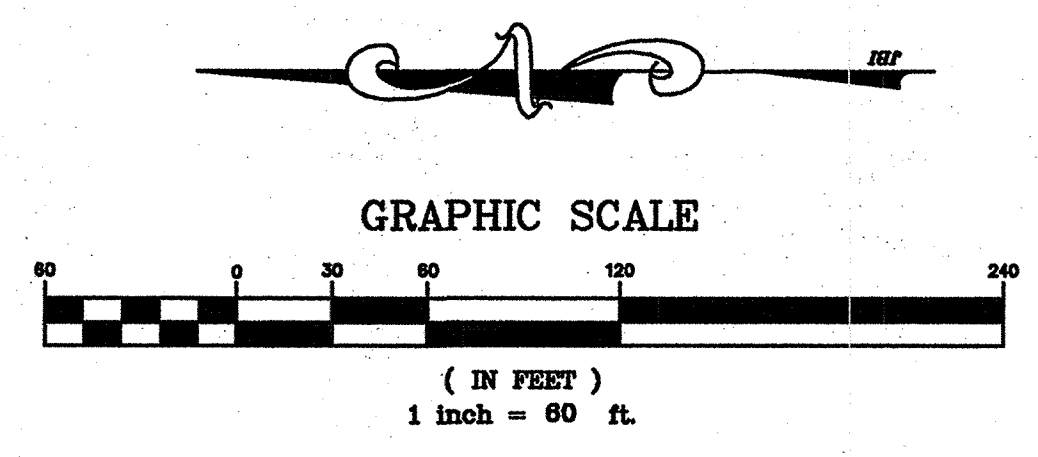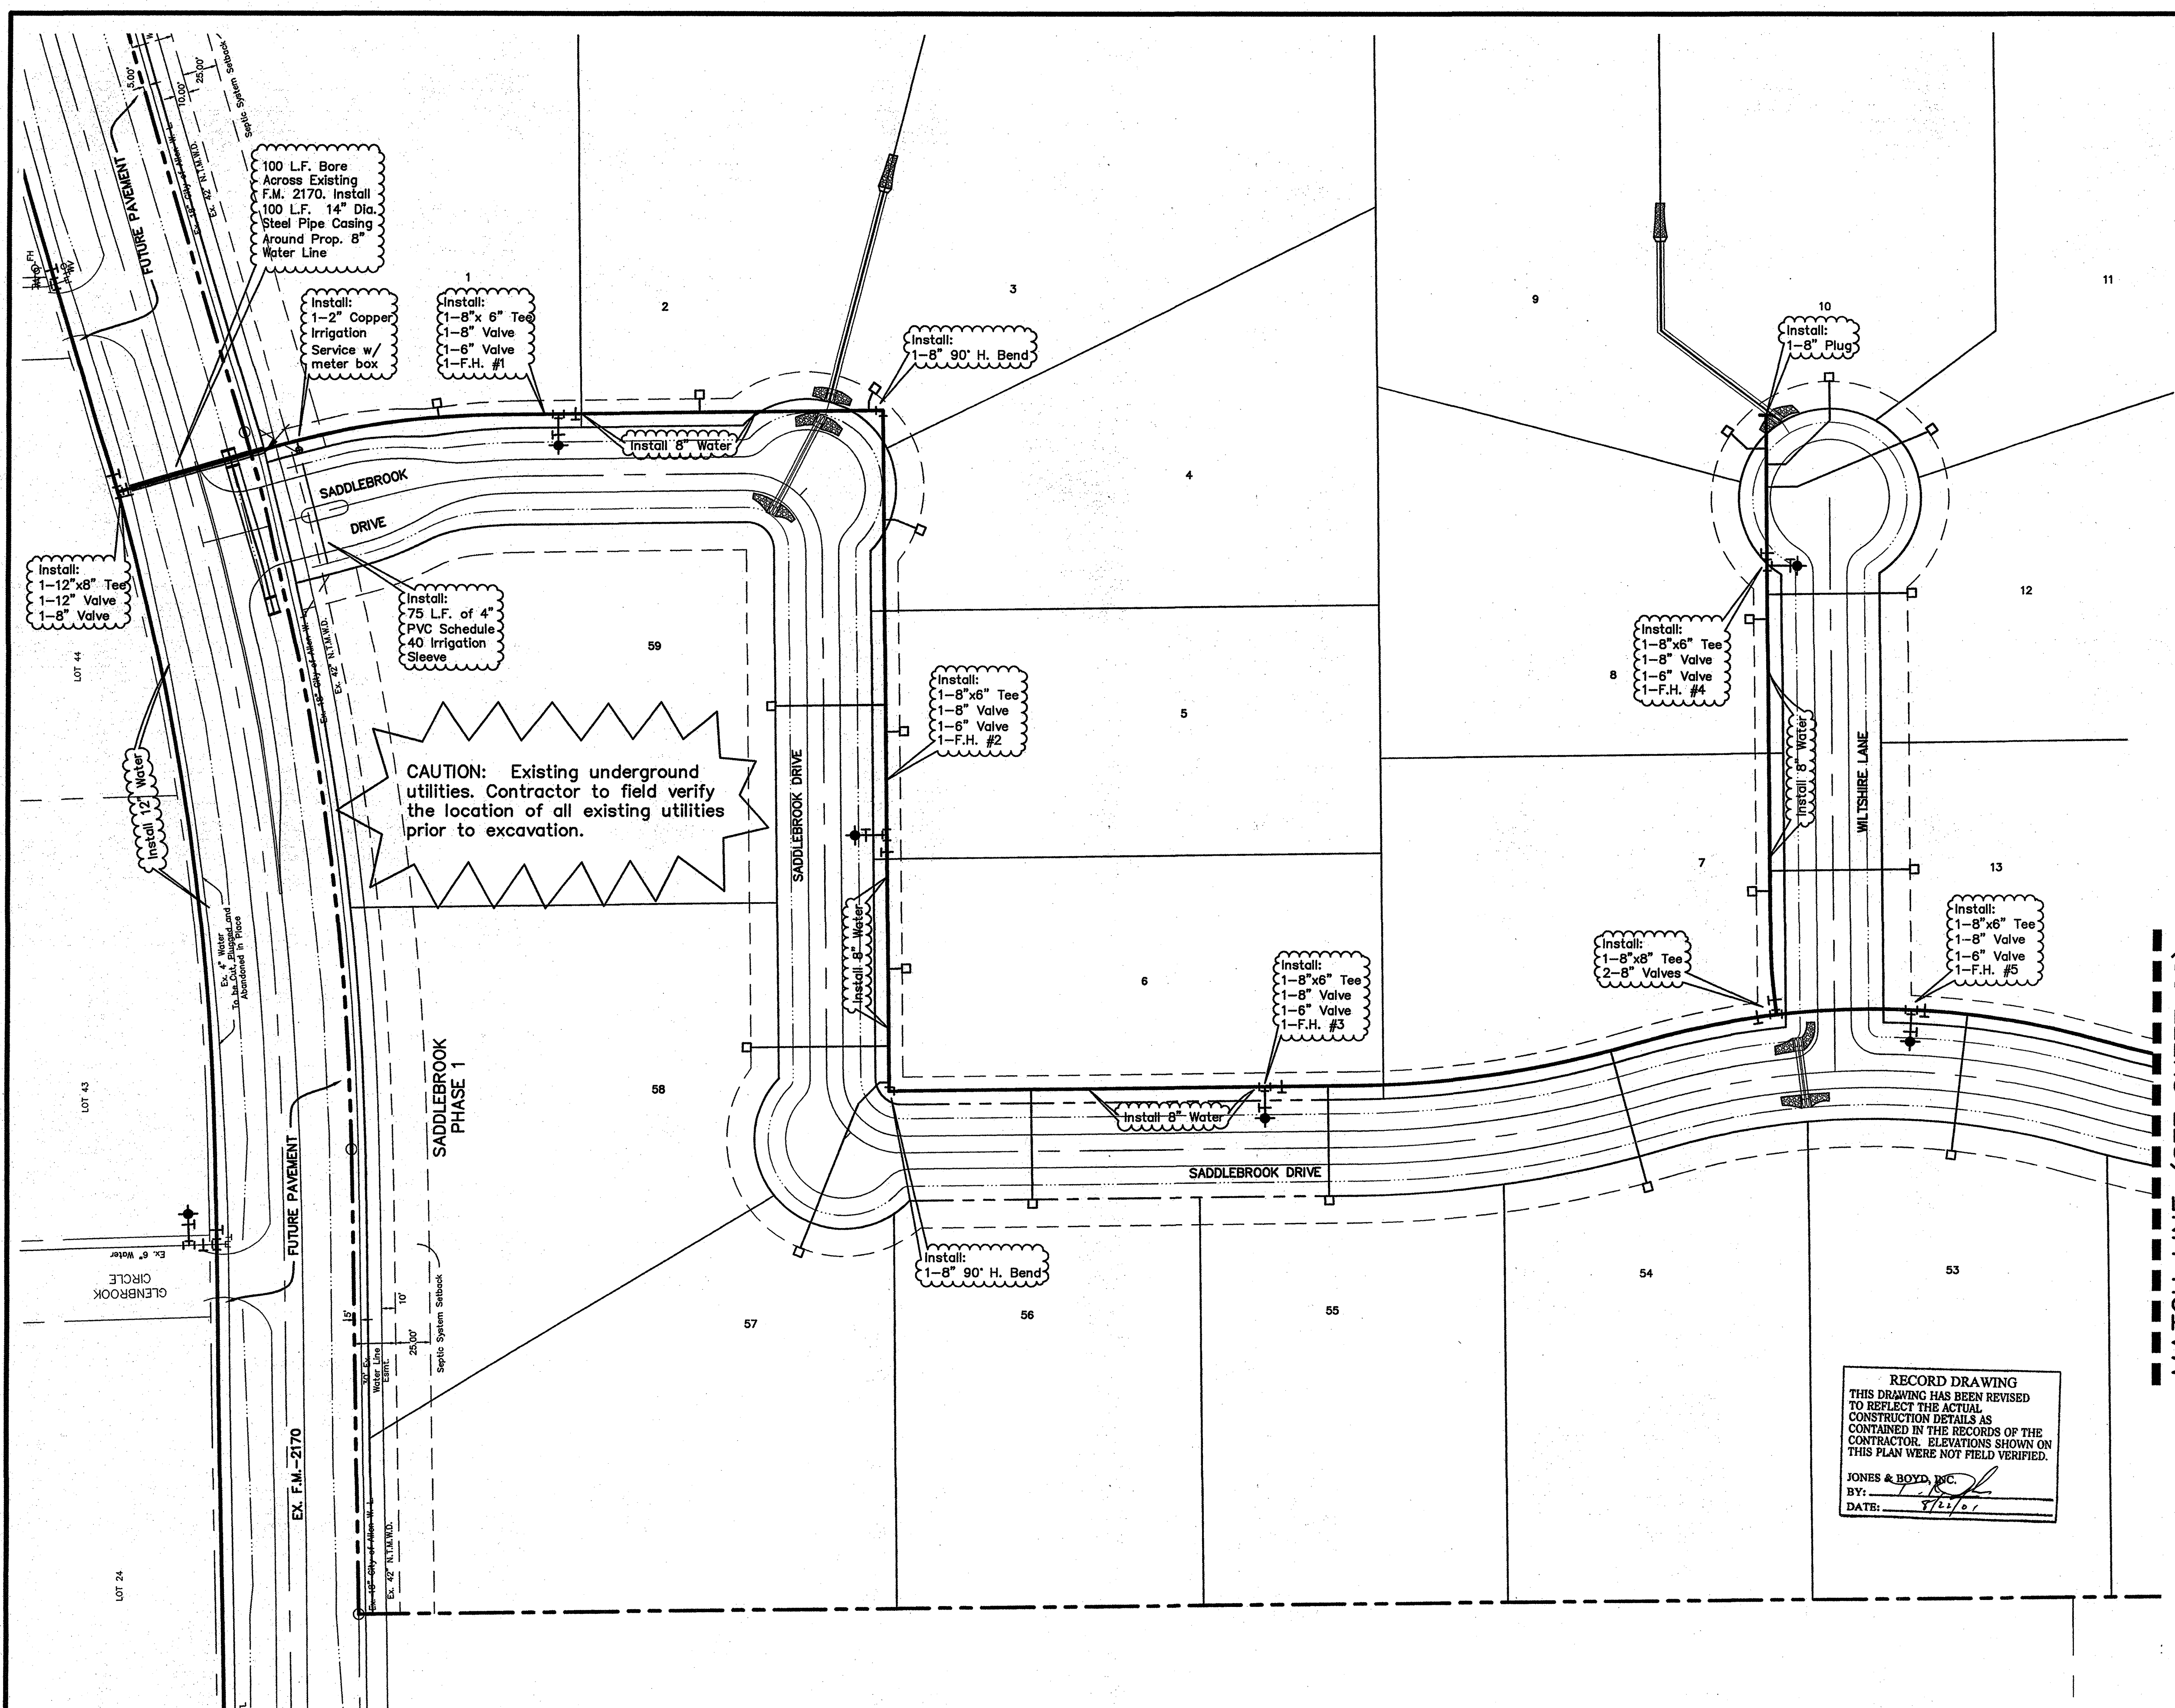


**LEGEND**

- Prop. Water Line and Valve
- Prop. Fire Hydrant
- Prop. Water Service
- Exist. Fire Hydrant
- Exist. Water Line and Valve
- 1" Service & 3/4" Meter

**WATER METER SCHEDULE**

METER NUMBER	WATER SERVICE SIZE	WATER METER SIZE	METER DOM.	METER IRR.
39	2"	2"	X	X

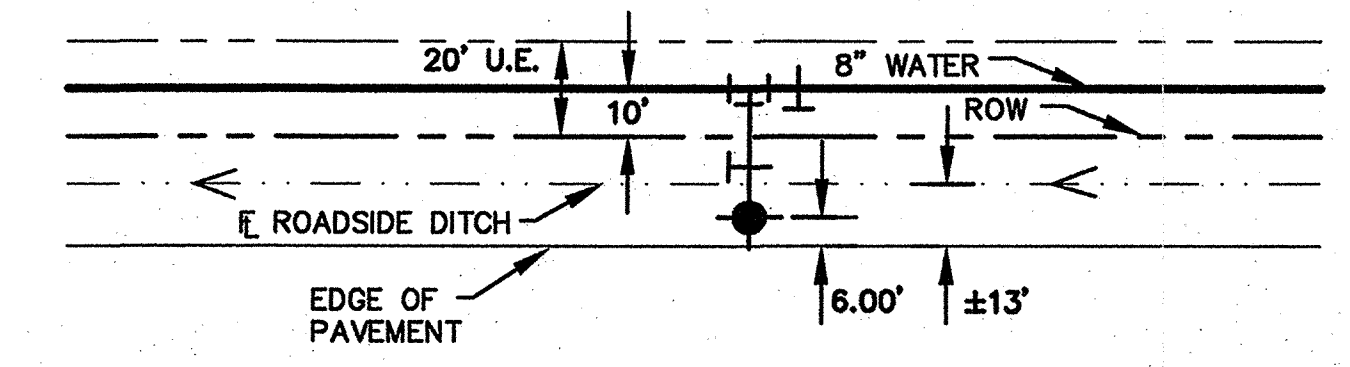

**FIRE HYDRANT LOCATION DETAIL**  
1" = 40'

- NTMWD NOTES**
- North Texas Municipal Water District (NTMWD) 42-inch and 20-inch water transmission pipelines are located within the limits of the construction.
  - Operation of heavy earthmoving equipment, compaction equipment or heavy construction equipment, such as concrete trucks, shall be restricted to specific crossing points across NTMWD easements, as approved by the NTMWD. The crossings shall be designated and verified to provide a minimum of five feet of cover.
  - To assure that placing of significant loads over the NTMWD pipeline does not damage the existing pipeline, no materials shall be stockpiled on the NTMWD easement, without authorization from the NTMWD. If the contractor desires to use NTMWD's easement for stockpile of materials, contact NTMWD Engineering at (972) 442-5405 so your plans for use of NTMWD's easement can be reviewed.
  - In areas where the cover between the top of the NTMWD pipeline and the bottom of the sub-grade is three (3) feet or less, it is requested that the sub-grade preparation be deleted and thickened pavement section be used to limit construction activities over the pipeline.
  - Crossing of the NTMWD easement with other utilities, such as TV cable, phone, gas and electric, shall be coordinated with the NTMWD to avoid damage to the NTMWD facilities.
  - Outdoor lighting, landscaping, screening walls or other facilities shall not be installed in NTMWD easements without written approval of the NTMWD.
  - Unless otherwise shown or required a minimum of one-foot clearance shall be provided for all utilities crossing the NTMWD pipelines.
  - The contractor shall contact NTMWD Engineering at (972) 442-5405 at least 48 hours prior to performing any work in the vicinity of the NTMWD facilities.
  - Water and Sewer lines crossing the NTMWD easements shall be installed in compliance with the Rules and Regulations for Public Water Systems, Paragraphs 290.44 (e), Location of Water Lines.
  - Septic systems are not permitted within NTMWD easements.
  - Excavation adjacent to NTMWD pipelines, manholes and other appurtenances to install proposed improvements shall be performed so that the manholes, pipelines or appurtenances are not displaced or damaged. Any damage to the manholes, pipelines or appurtenances shall be repaired to the satisfaction of the NTMWD. Further, any cost for repair of damage to the manholes, pipelines or appurtenances resulting from construction by the developer or contractor will be the responsibility for the developer.


MATCH LINE (SEE SHEET 22)

**RECORD DRAWING**  
THIS DRAWING HAS BEEN REVISED TO REFLECT THE ACTUAL CONSTRUCTION DETAILS AS CONTAINED IN THE RECORDS OF THE CONTRACTOR. ELEVATIONS SHOWN ON THIS PLAN WERE NOT FIELD VERIFIED.

JONES & BOYD, INC.  
BY: *[Signature]*  
DATE: 7/22/01



NO.	REVISIONS DURING CONSTRUCTION	BY	DATE	NO.	REVISIONS DURING PLAN REVIEW	BY	DATE
3	ADDED NOTES TO NTMWD NOTES	CMG	01/05/01				
2	EXTEND BORE ACROSS R.O.W. PER TxDOT COMMENTS	TC	12/19/00				
1	REVISED PER CITY COMMENTS	TC	12/08/00				

The seal appearing on this document was authorized by Thomas K. Juhn, P.E. 81799 on Jan. 05, 2001. Alteration of a sealed document without proper notification to the responsible engineer is an offense under the Texas Engineering Practice Act.

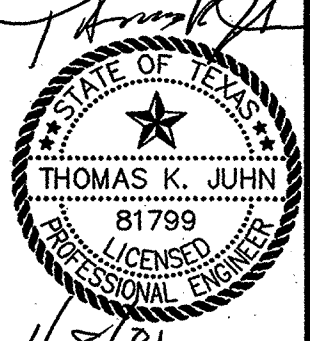

**Jones & Boyd, Inc.**  
16800 Dallas Parkway, Suite 240  
Dallas, Texas 75248  
Tel: 972-248-7676  
Fax: 972-248-1414

<b>WATER PLAN</b>		PROJECT NO.
Details		SK403
<b>SADDLEBROOK</b>		SHEET NO.
City of Lucas, Collin County, Texas		21

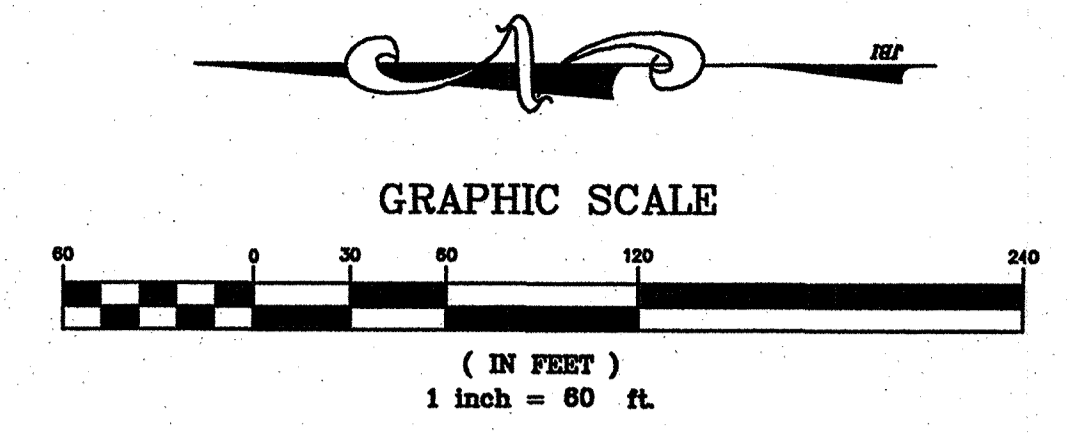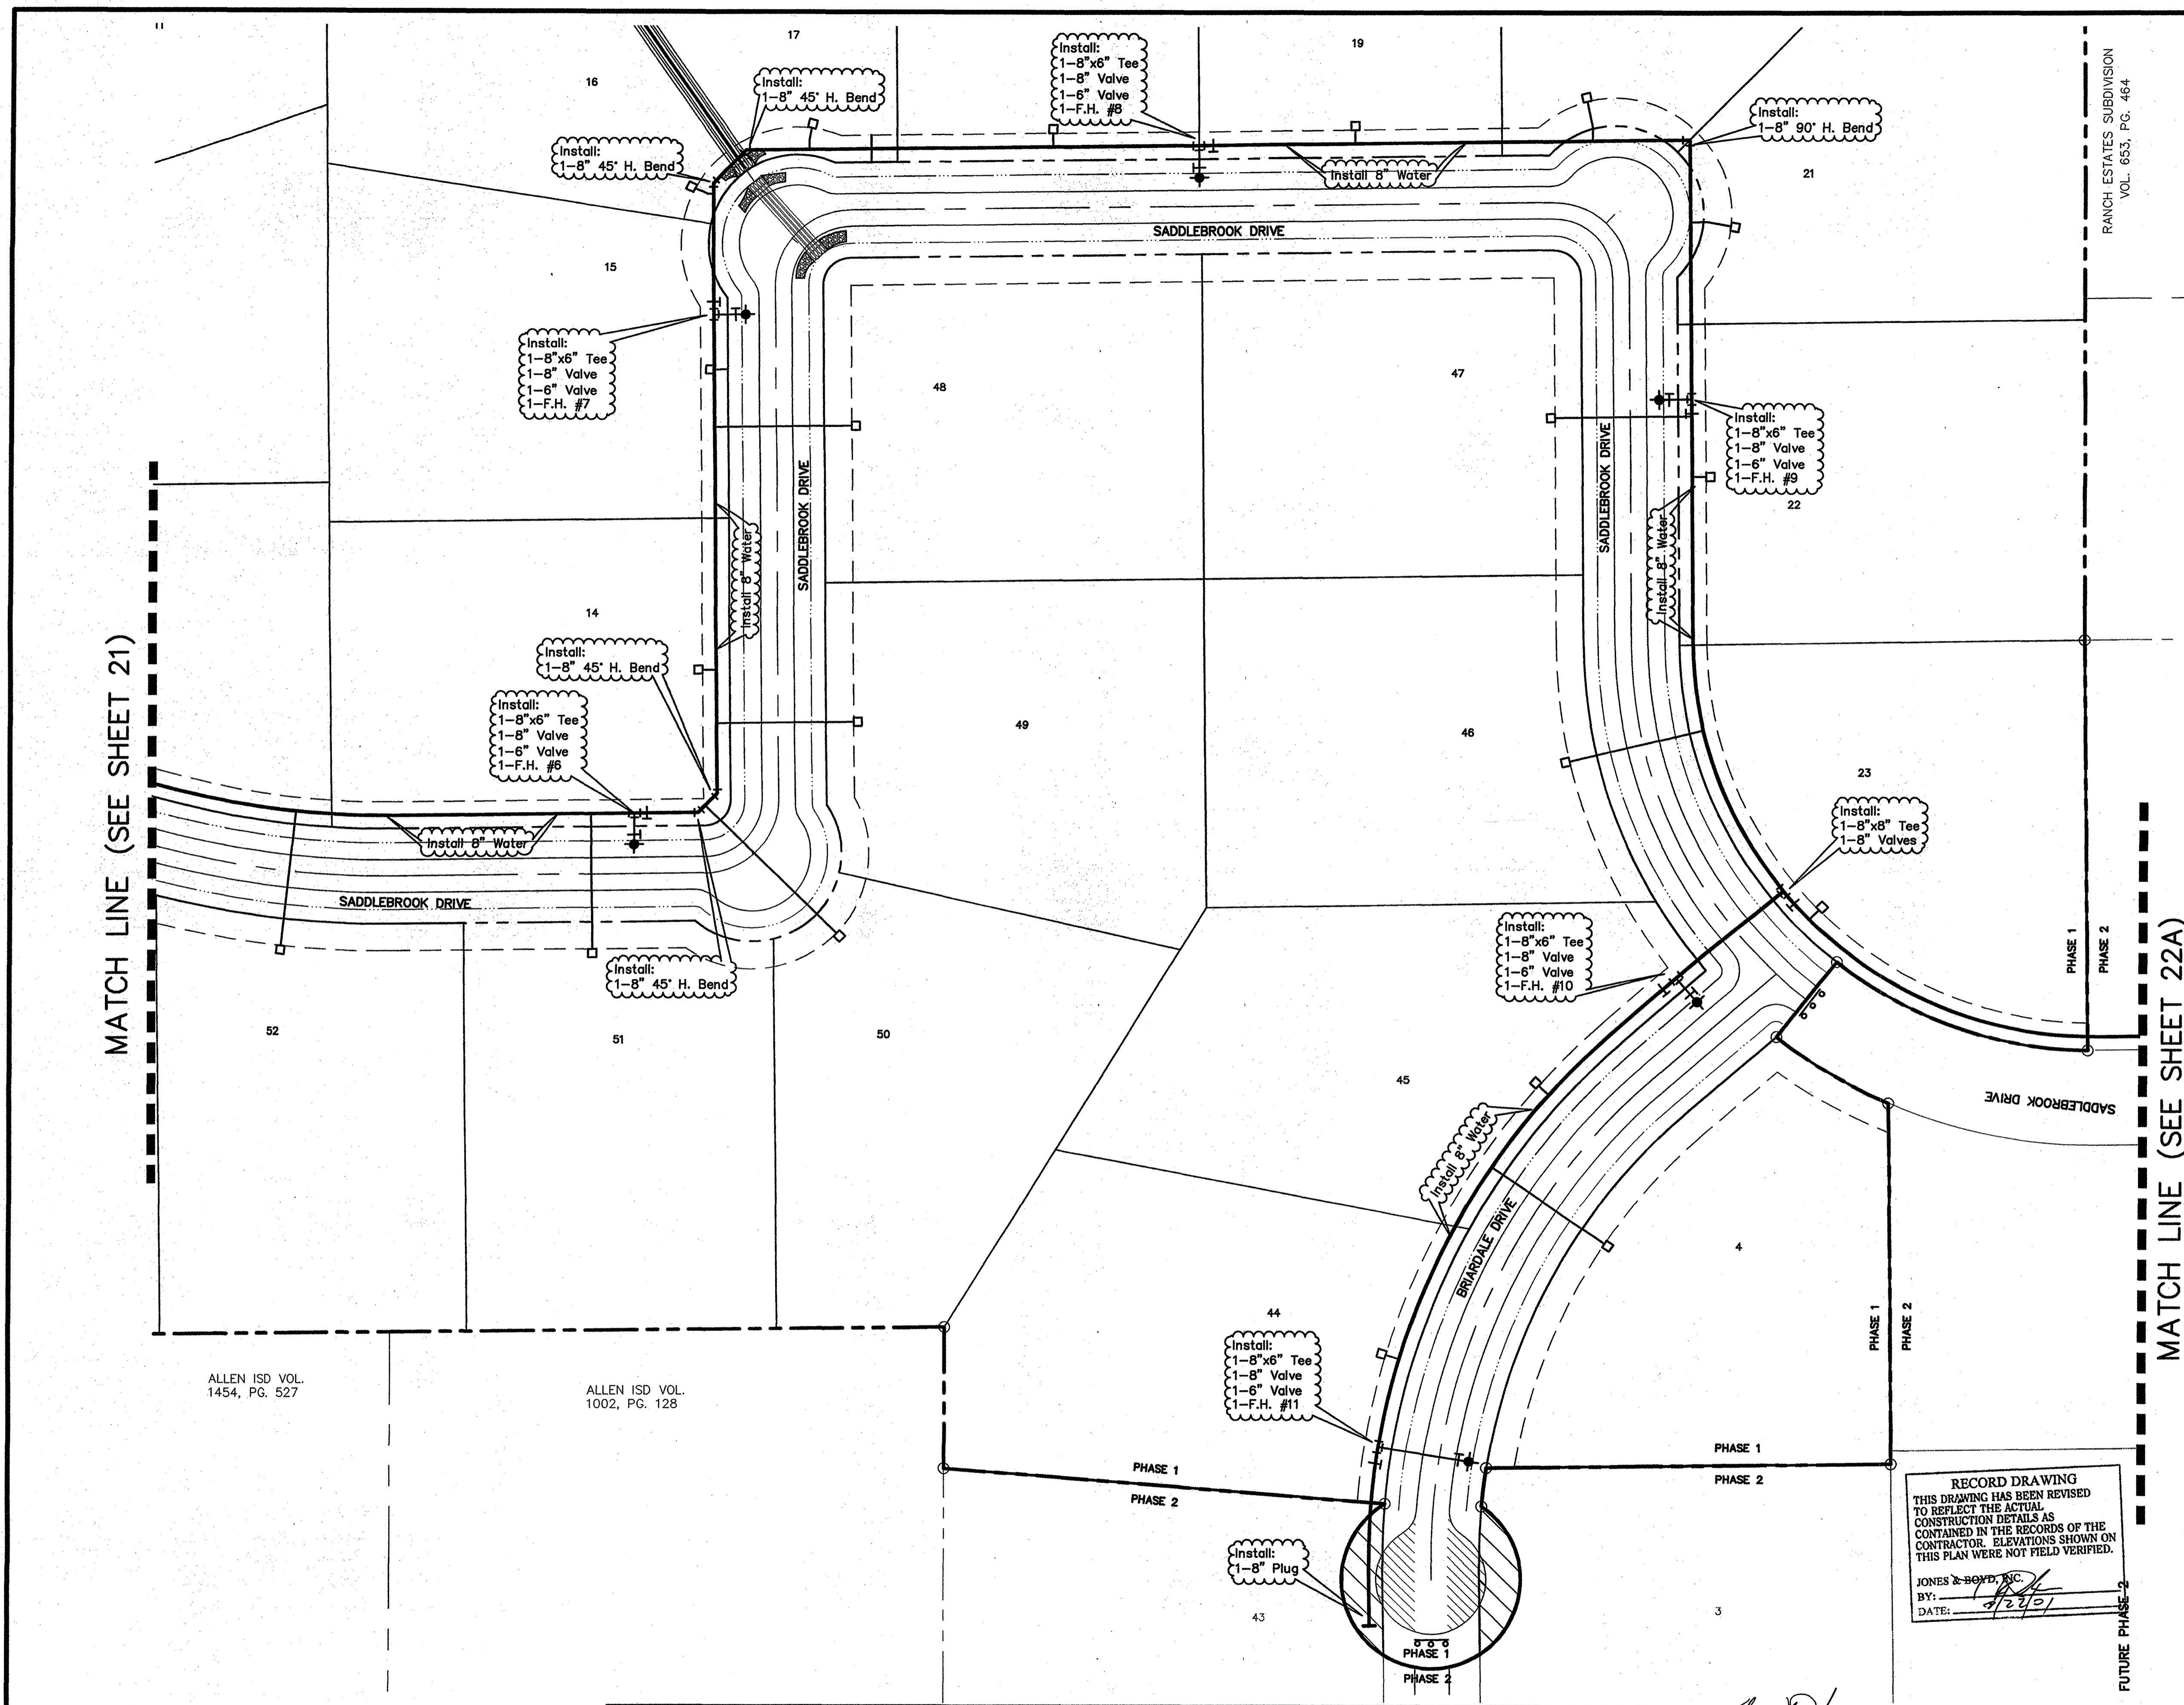


**LEGEND**

- Prop. Water Line and Valve
- Prop. Fire Hydrant
- Prop. Water Service
- Exist. Fire Hydrant
- Exist. Water Line and Valve
- 1" Service & 3/4" Meter

**WATER METER SCHEDULE**

METER ID NUMBER	WATER SERVICE SIZE	WATER METER SIZE	METER	
			DOM.	IRR.
39	1"	3/4"	X	
1	2"	2"		X

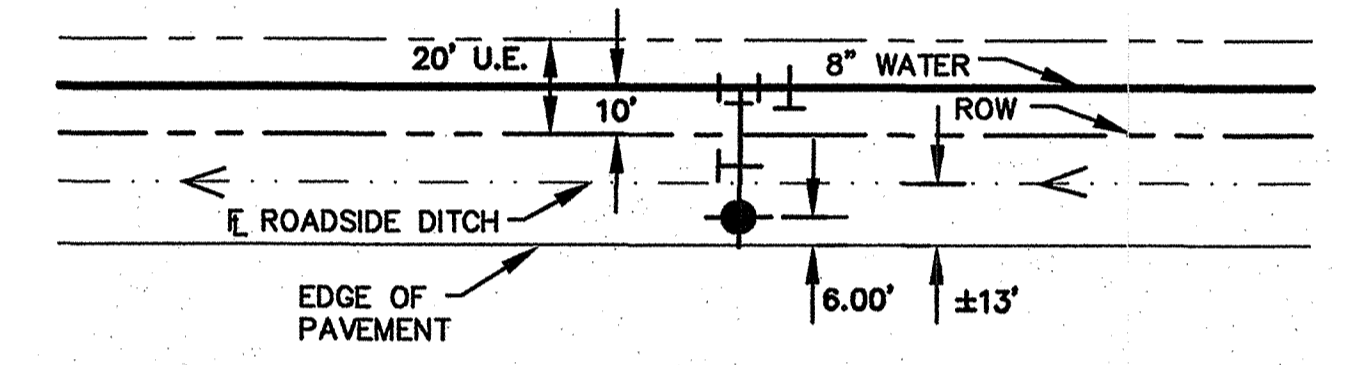

**FIRE HYDRANT LOCATION DETAIL**  
1" = 40'

**NTMWD NOTES**

1. North Texas Municipal Water District (NTMWD) 42-inch and 20-inch water transmission pipelines are located within the limits of the construction.
2. Operation of heavy earthmoving equipment, compaction equipment or heavy construction equipment, such as concrete trucks, shall be restricted to specific crossing points across NTMWD easements, as approved by the NTMWD. The crossings shall be designated and verified to provide a minimum of five feet of cover.
3. To assure that placing of significant loads over the NTMWD pipeline does not damage the existing pipeline, no materials shall be stockpiled on the NTMWD easement, without authorization from the NTMWD. If the contractor desires to use NTMWD's easement for stockpile of materials, contact NTMWD Engineering at (972) 442-5405 so your plans for use of NTMWD's easement can be reviewed.
4. In areas where the cover between the top of the NTMWD pipeline and the bottom of the sub-grade is three (3) feet or less, it is requested that the sub-grade preparation be deleted and thickened pavement section be used to limit construction activities over the pipeline.
5. Crossing of the NTMWD easement with other utilities, such as TV cable, phone, gas and electric, shall be coordinated with the NTMWD to avoid damage to the NTMWD facilities.
6. Outdoor lighting, landscaping, screening walls or other facilities shall not be installed in NTMWD easements without written approval of the NTMWD.
7. Unless otherwise shown or required a minimum of one-foot clearance shall be provided for all utilities crossing the NTMWD pipelines.
8. The contractor shall contact NTMWD Engineering at (972) 442-5405 at least 48 hours prior to performing any work in the vicinity of the NTMWD facilities.
9. Water and Sewer lines crossing the NTMWD easements shall be installed in compliance with the Rules and Regulations for Public Water Systems, Paragraphs 290.44 (c), Location of Water Lines.
10. Septic systems are not permitted within NTMWD easements.
11. Excavation adjacent to NTMWD pipelines, manholes and other appurtenances to install proposed improvements shall be performed so that the manholes, pipelines or appurtenances are not displaced or damaged. Any damage to the manholes, pipelines or appurtenances shall be repaired to the satisfaction of the NTMWD. Further, any cost for repair of damage to the manholes, pipelines or appurtenances resulting from construction by the developer or contractor will be the responsibility for the developer.

**RECORD DRAWING**  
THIS DRAWING HAS BEEN REVISED TO REFLECT THE ACTUAL CONSTRUCTION DETAILS AS CONTAINED IN THE RECORDS OF THE CONTRACTOR. ELEVATIONS SHOWN ON THIS PLAN WERE NOT FIELD VERIFIED.


JONES & BOYD, INC.  
BY: *[Signature]*  
DATE: 8/24/01

ALLEN ISD VOL. 1454, PG. 527  
ALLEN ISD VOL. 1002, PG. 128

- BENCHMARKS:**
1. "I" 1/2" IR, W of Ingram Rd. +- 1025' N of N edge of Lucas Rd. +- 6" E of fence. Elev. 637.08
  2. "I" 1/2" IR, E of Ingram Rd. +- 2650' N of N edge of Lucas Rd. +- 28' E & 37' N of fence corner. Elev. 638.20

NO.	REVISIONS DURING CONSTRUCTION	BY	DATE	NO.	REVISIONS DURING PLAN REVIEW	BY	DATE
				3	ADDED NOTES TO NTMWD NOTES	CMG	01/05/01
				2	EXTEND 8" WATER TO LOOP SYSTEM	TC	12/18/00
				1	REVISED PER CITY COMMENTS	TC	12/08/00



The seal appearing on this document was authorized by Thomas K. Juhn, P.E. 81799 on Jan. 05, 2001. Alteration of a sealed document without proper notification to the responsible engineer is an offense under the Texas Engineering Practice Act.

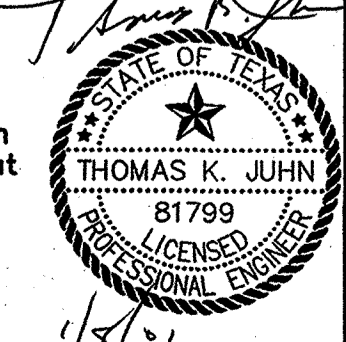



**Jones & Boyd, Inc.**  
16800 Dallas Parkway, Suite 240  
Dallas, Texas 75248  
Tel: 972-248-7676  
Fax: 972-248-1414

<b>WATER PLAN</b>		PROJECT NO.
Details		SK403
<b>SADDLEBROOK</b>		SHEET NO.
City of Lucas, Collin County, Texas		22

Plot time: 4:28 pm  
Plot date: 1/5/01  
Plotted by: CMG  
Drawing: H:\Projects\SK403.dwg  
SK403.dwg  
H:\Projects\SK403.dwg  
SK403.dwg  
1/2/01  
5:36 pm

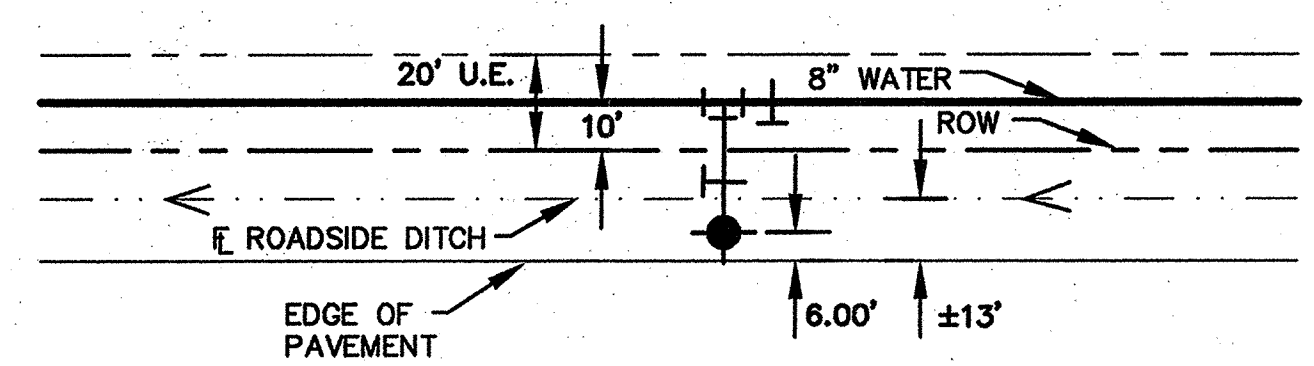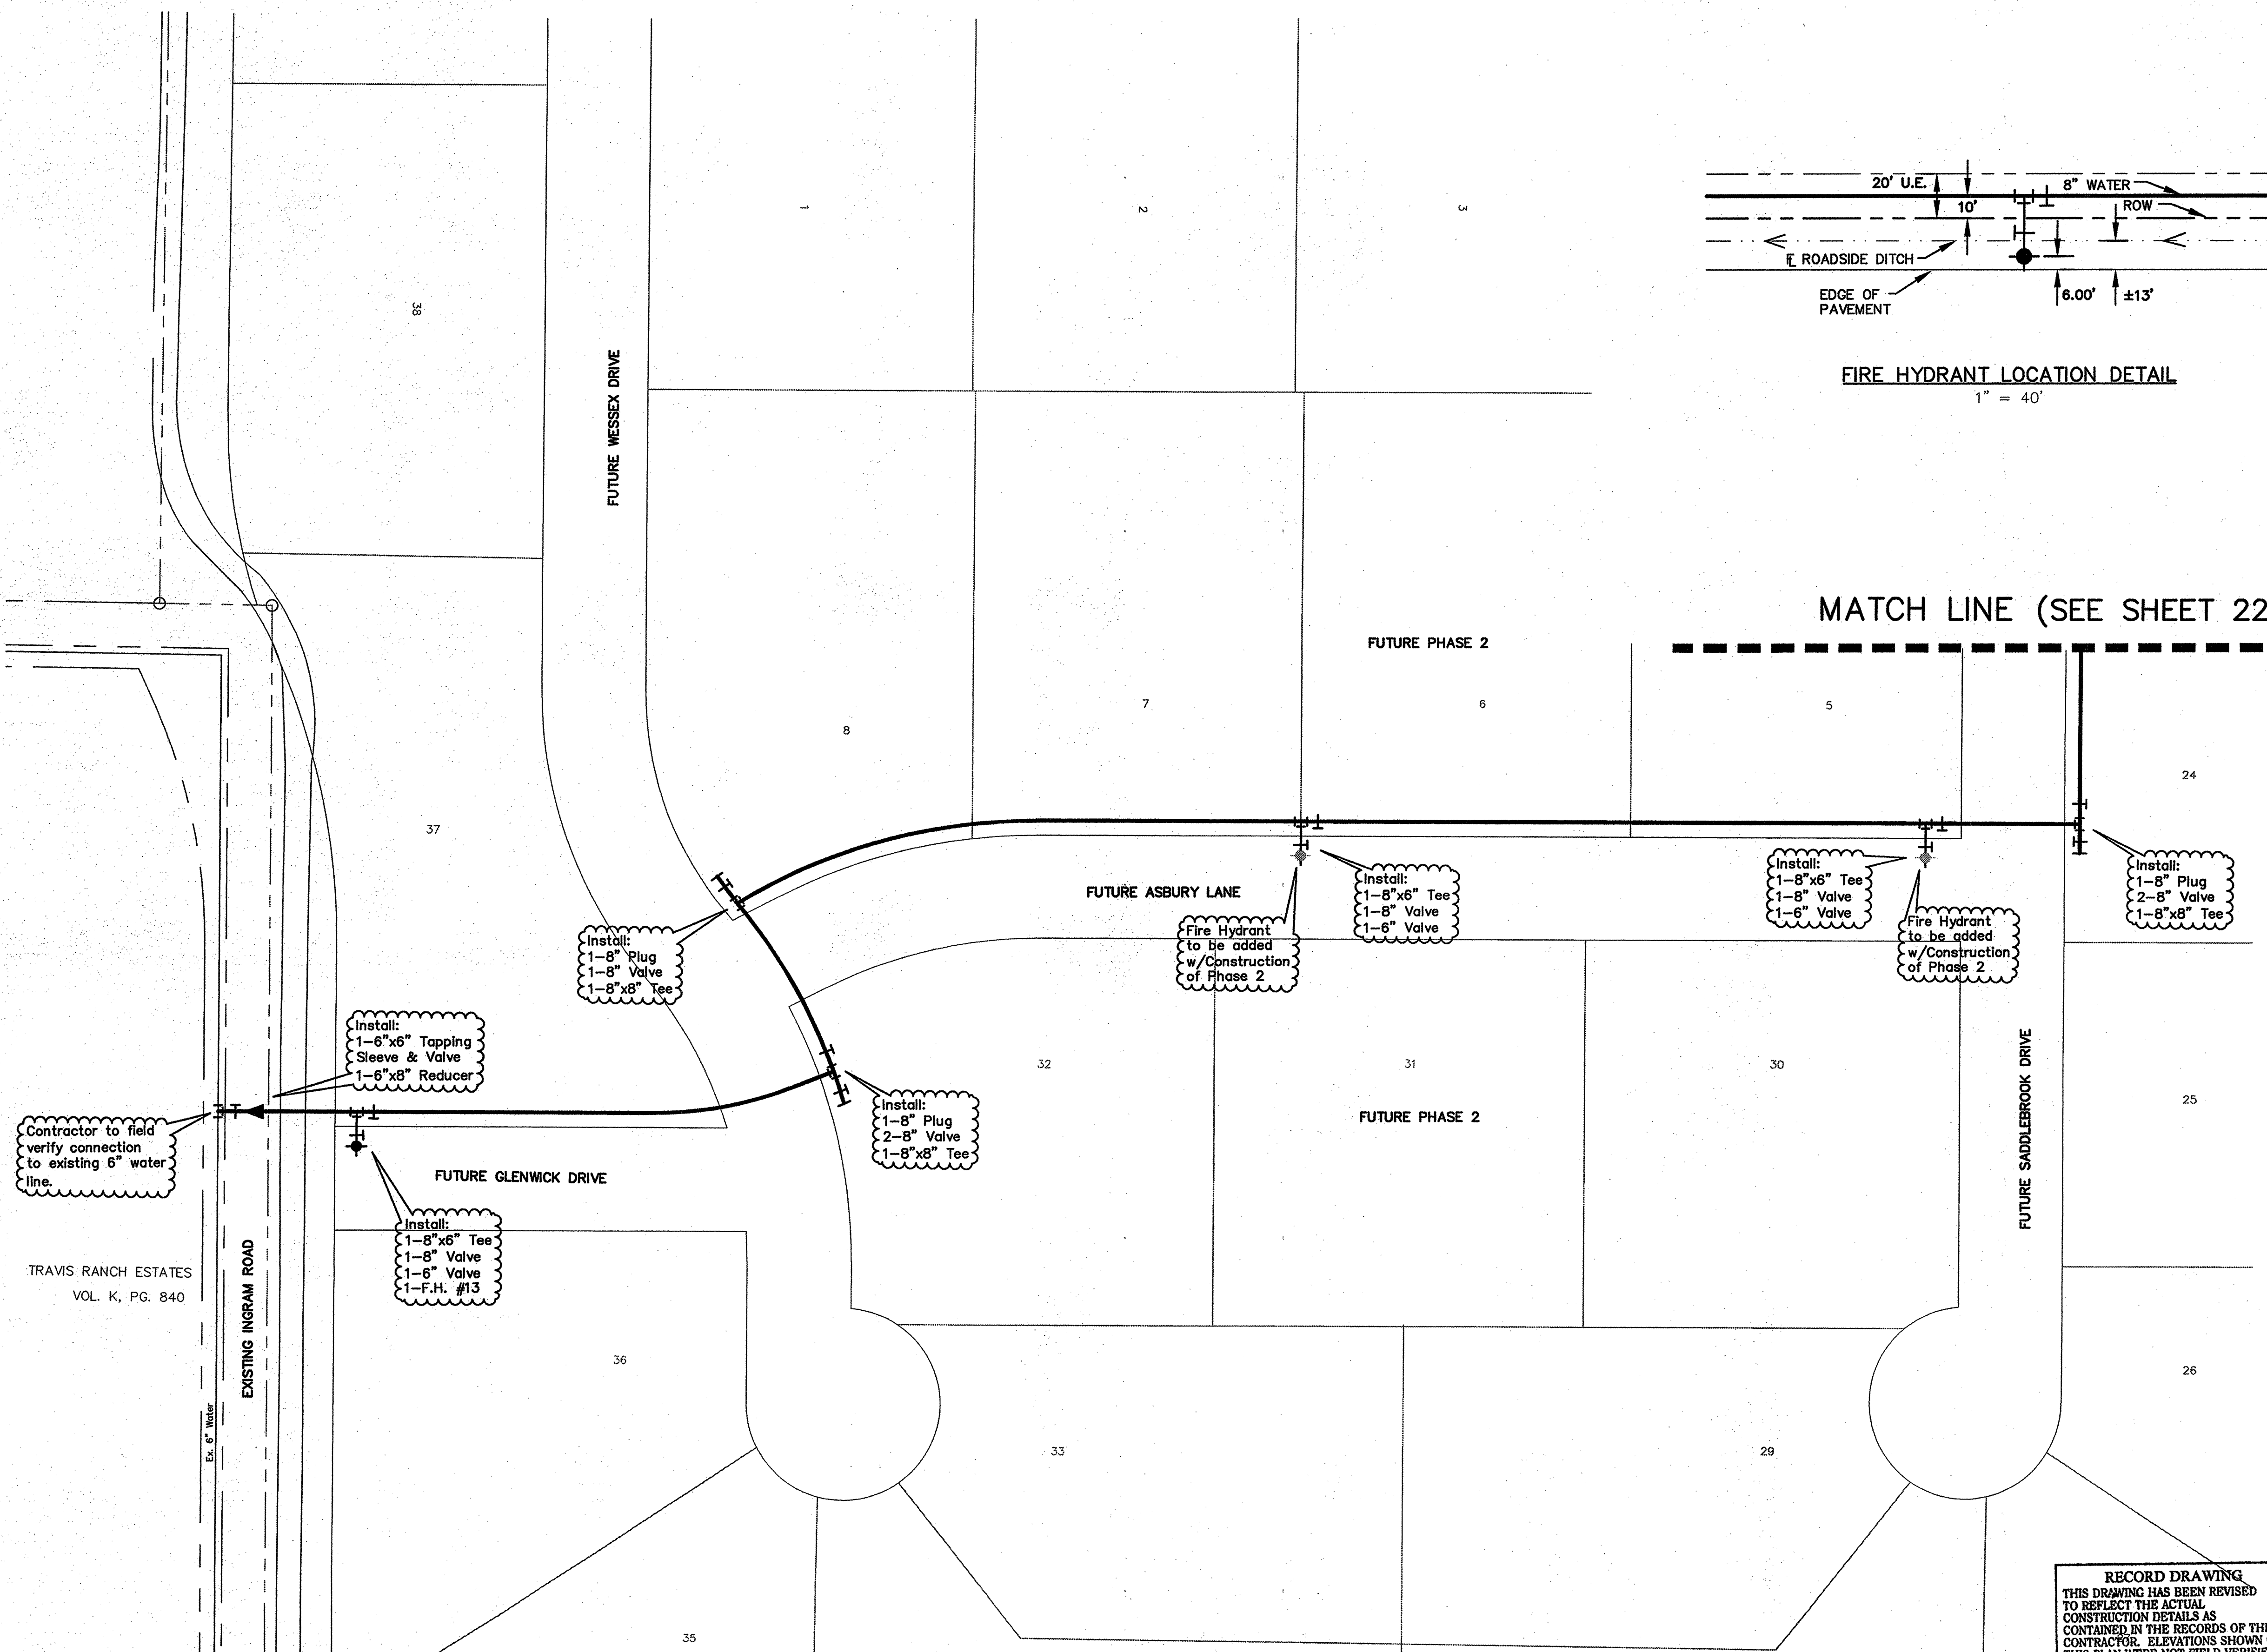

FIRE HYDRANT LOCATION DETAIL  
1" = 40'

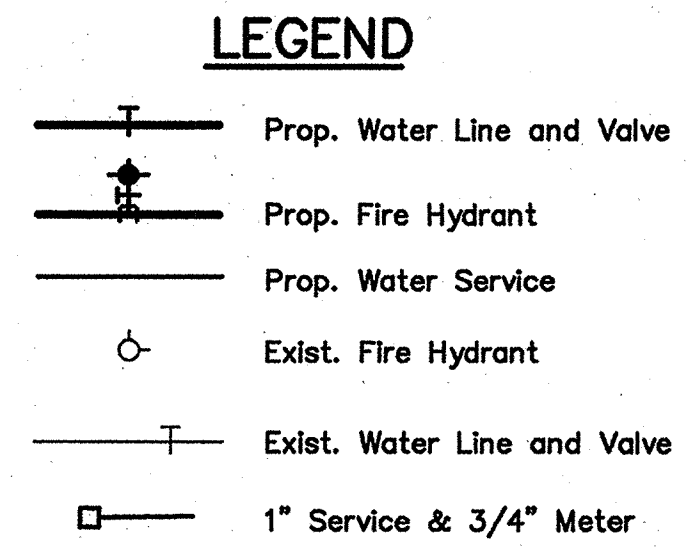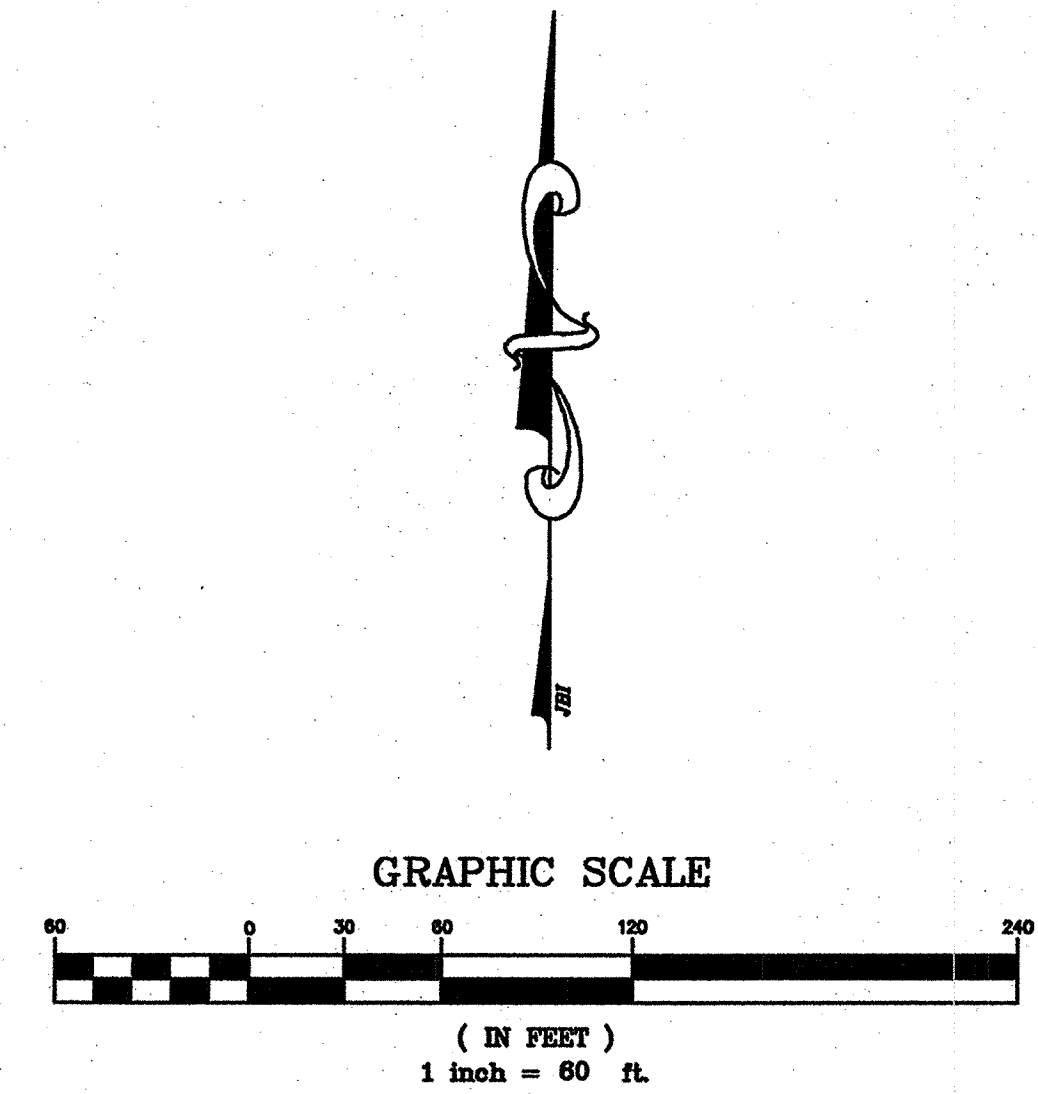

**WATER METER SCHEDULE**

METER ID NUMBER	WATER SERVICE SIZE	WATER METER SIZE	METER	
			DOM.	IRR.
39	1"	3/4"	X	
1	2"	2"		X


- NTMWD NOTES**
- North Texas Municipal Water District (NTMWD) 42-inch and 20-inch water transmission pipelines are located within the limits of the construction.
  - Operation of heavy earthmoving equipment, compaction equipment or heavy construction equipment, such as concrete trucks, shall be restricted to specific crossing points across NTMWD easements, as approved by the NTMWD. The crossings shall be designated and verified to provide a minimum of five feet of cover.
  - To assure that placing of significant loads over the NTMWD pipeline does not damage the existing pipeline, no materials shall be stockpiled on the NTMWD easement, without authorization from the NTMWD. If the contractor desires to use NTMWD's easement for stockpile of materials, contact NTMWD Engineering at (972) 442-5405 so your plans for use of NTMWD's easement can be reviewed.
  - In areas where the cover between the top of the NTMWD pipeline and the bottom of the sub-grade is three (3) feet or less, it is requested that the sub-grade preparation be deleted and thickened pavement section be used to limit construction activities over the pipeline.
  - Crossing of the NTMWD easement with other utilities, such as TV cable, phone, gas and electric, shall be coordinated with the NTMWD to avoid damage to the NTMWD facilities.
  - Outdoor lighting, landscaping, screening walls or other facilities shall not be installed in NTMWD easements without written approval of the NTMWD.
  - Unless otherwise shown or required a minimum of one-foot clearance shall be provided for all utilities crossing the NTMWD pipelines.
  - The contractor shall contact NTMWD Engineering at (972) 442-5405 at least 48 hours prior to performing any work in the vicinity of the NTMWD facilities.
  - Water and Sewer lines crossing the NTMWD easements shall be installed in compliance with the Rules and Regulations for Public Water Systems, Paragraphs 290.44 (e), Location of Water Lines.
  - Septic systems are not permitted within NTMWD easements.
  - Excavation adjacent to NTMWD pipelines, manholes and other appurtenances to install proposed improvements shall be performed so that the manholes, pipelines or appurtenances are not displaced or damaged. Any damage to the manholes, pipelines or appurtenances shall be repaired to the satisfaction of the NTMWD. Further, any cost for repair of damage to the manholes, pipelines or appurtenances resulting from construction by the developer or contractor will be the responsibility for the developer.

**RECORD DRAWING**  
THIS DRAWING HAS BEEN REVISED TO REFLECT THE ACTUAL CONSTRUCTION DETAILS AS CONTAINED IN THE RECORDS OF THE CONTRACTOR. ELEVATIONS SHOWN ON THIS PLAN WERE NOT FIELD VERIFIED.  
JONES & BOYD, INC.  
BY: [Signature]  
DATE: 8/23/01

- BENCHMARKS:**
- 1" 1/2" IR, W of Ingram Rd. +- 1025' N of N edge of Lucas Rd. +- 6' E of fence. Elev. 637.08
  - 1" 1/2" IR, E of Ingram Rd. +- 2650' N of N edge of Lucas Rd. +- 28' E & 37' N of fence corner. Elev. 639.20


NO.	REVISIONS DURING CONSTRUCTION	BY	DATE	NO.	REVISIONS DURING PLAN REVIEW	BY	DATE
				3	ADDED NOTES TO NTMWD NOTES	CMG	01/05/01
				2	ADD F.H. @ INGRAM/SHOW F.H. AS FUTURE	TC	12/18/00
				1	8" WATER LOOP TO INGRAM ROAD	TC	12/18/00

The seal appearing on this document was authorized by Thomas K. Juhn, P.E. 81799 on Jan. 05, 2001. Alteration of a sealed document without proper notification to the responsible engineer is an offense under the Texas Engineering Practice Act.

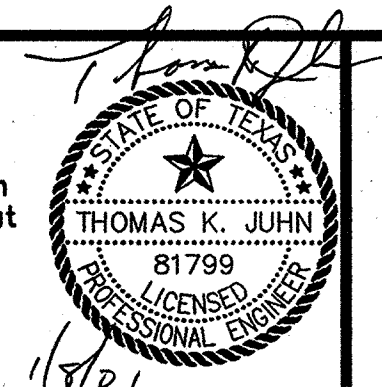

**Jones & Boyd, Inc.**  
16800 Dallas Parkway, Suite 240  
Dallas, Texas 75248  
Tel: 972-248-7676  
Fax: 972-248-1414

<b>WATER PLAN</b>		PROJECT NO.
Details		SK403
<b>SADDLEBROOK</b>		SHEET NO.
City of Lucas, Collin County, Texas		22A

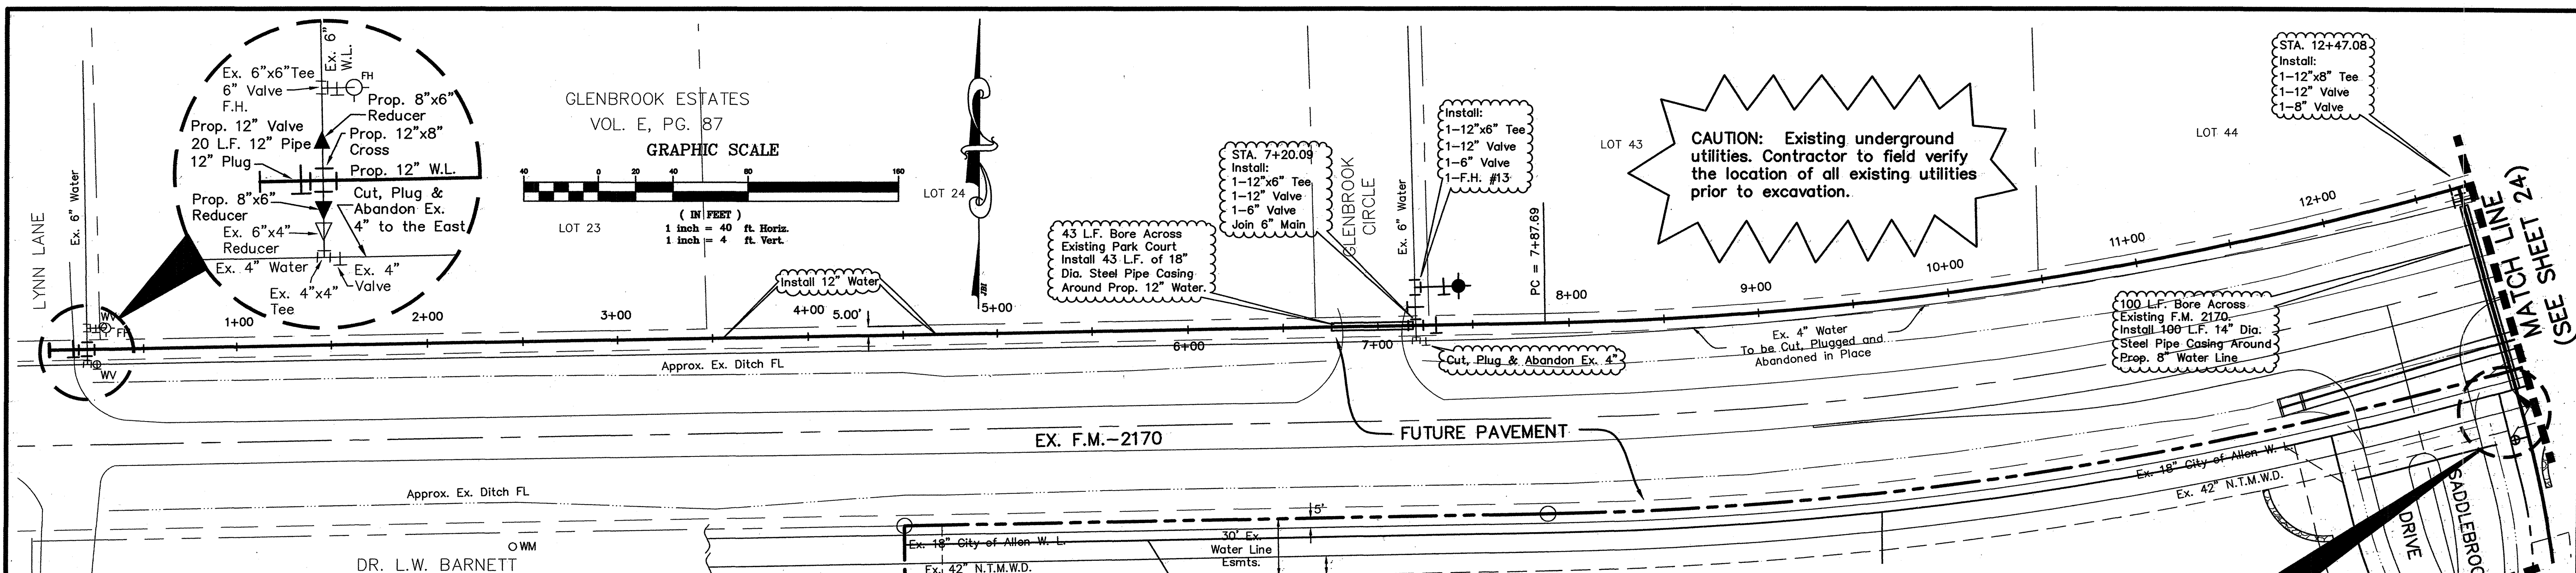


- NTMWD NOTES**
- North Texas Municipal Water District (NTMWD) 42-inch and 20-inch water transmission pipelines are located within the limits of the construction.
  - Operation of heavy earthmoving equipment, compaction equipment or heavy construction equipment, such as concrete trucks, shall be restricted to specific crossing points across NTMWD easements, as approved by the NTMWD. The crossings shall be designated and verified to provide a minimum of five feet of cover.
  - To assure that placing of significant loads over the NTMWD pipeline does not damage the existing pipeline, no materials shall be stockpiled on the NTMWD easement, without authorization from the NTMWD. If the contractor desires to use NTMWD's easement for stockpile of materials, contact NTMWD Engineering at (972) 442-5405 so your plans for use of NTMWD's easement can be reviewed.
  - In areas where the cover between the top of the NTMWD pipeline and the bottom of the sub-grade is three (3) feet or less, it is requested that the sub-grade preparation be deleted and thickened pavement section be used to limit construction activities over the pipeline.

- Crossing of the NTMWD easement with other utilities, such as TV cable, phone, gas and electric, shall be coordinated with the NTMWD to avoid damage to the NTMWD facilities.
- Outdoor lighting, landscaping, screening walls or other facilities shall not be installed in NTMWD easements without written approval of the NTMWD.
- Unless otherwise shown or required a minimum of one-foot clearance shall be provided for all utilities crossing the NTMWD pipelines.
- The contractor shall contact NTMWD Engineering at (972) 442-5405 at least 48 hours prior to performing any work in the vicinity of the NTMWD facilities.
- Water and Sewer lines crossing the NTMWD easements shall be installed in compliance with the Rules and Regulations for Public Water Systems, Paragraphs 290.44 (e), Location of Water Lines.


- Septic systems are not permitted within NTMWD easements.
- Excavation adjacent to NTMWD pipelines, manholes and other appurtenances to install proposed improvements shall be performed so that the manholes, pipelines or appurtenances are not displaced or damaged. Any damage to the manholes, pipelines or appurtenances shall be repaired to the satisfaction of the NTMWD. Further, any cost for repair of damage to the manholes, pipelines or appurtenances resulting from construction by the developer or contractor will be the responsibility for the developer.

**SADDLEBROOK PHASE 1**

NOTE: Contractor shall return the landscape berm on North side of F.M. 2170 to its original condition including any necessary sodding and seeding.

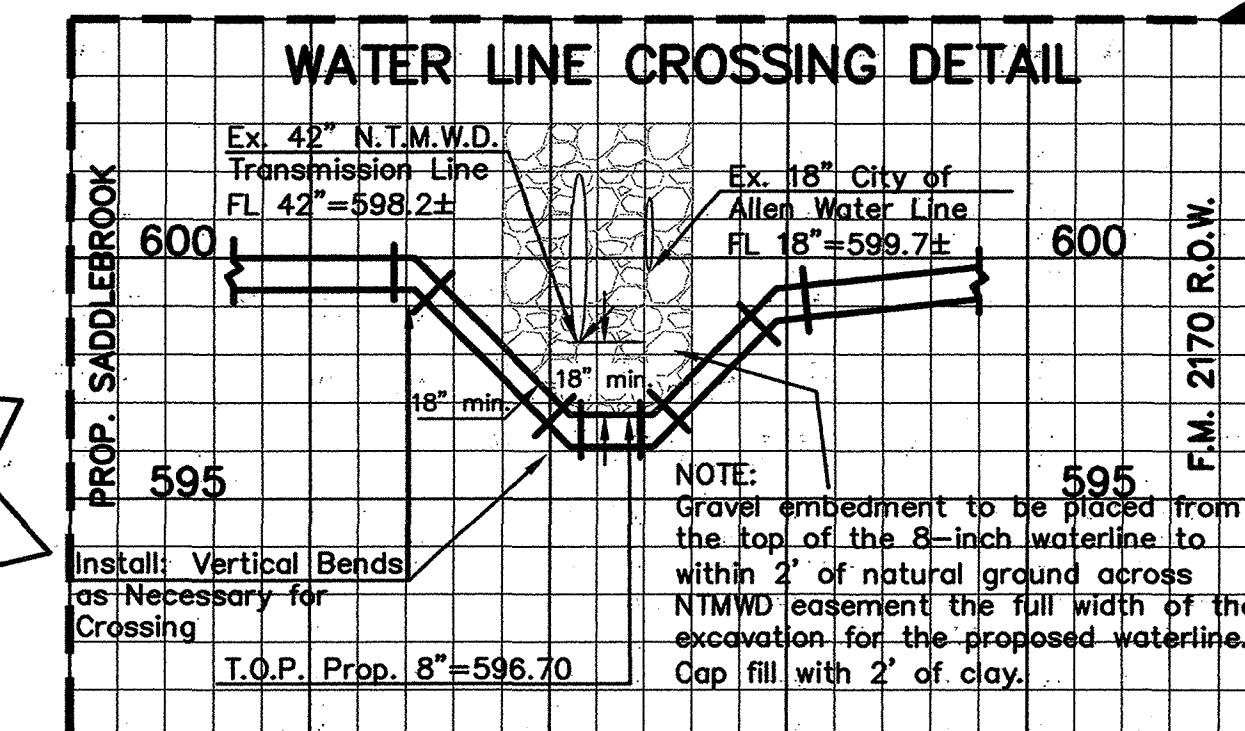

- LEGEND**
- Prop. Water Line and Valve
  - Prop. Fire Hydrant
  - Prop. Water Service
  - Exist. Fire Hydrant
  - Exist. Water Line and Valve

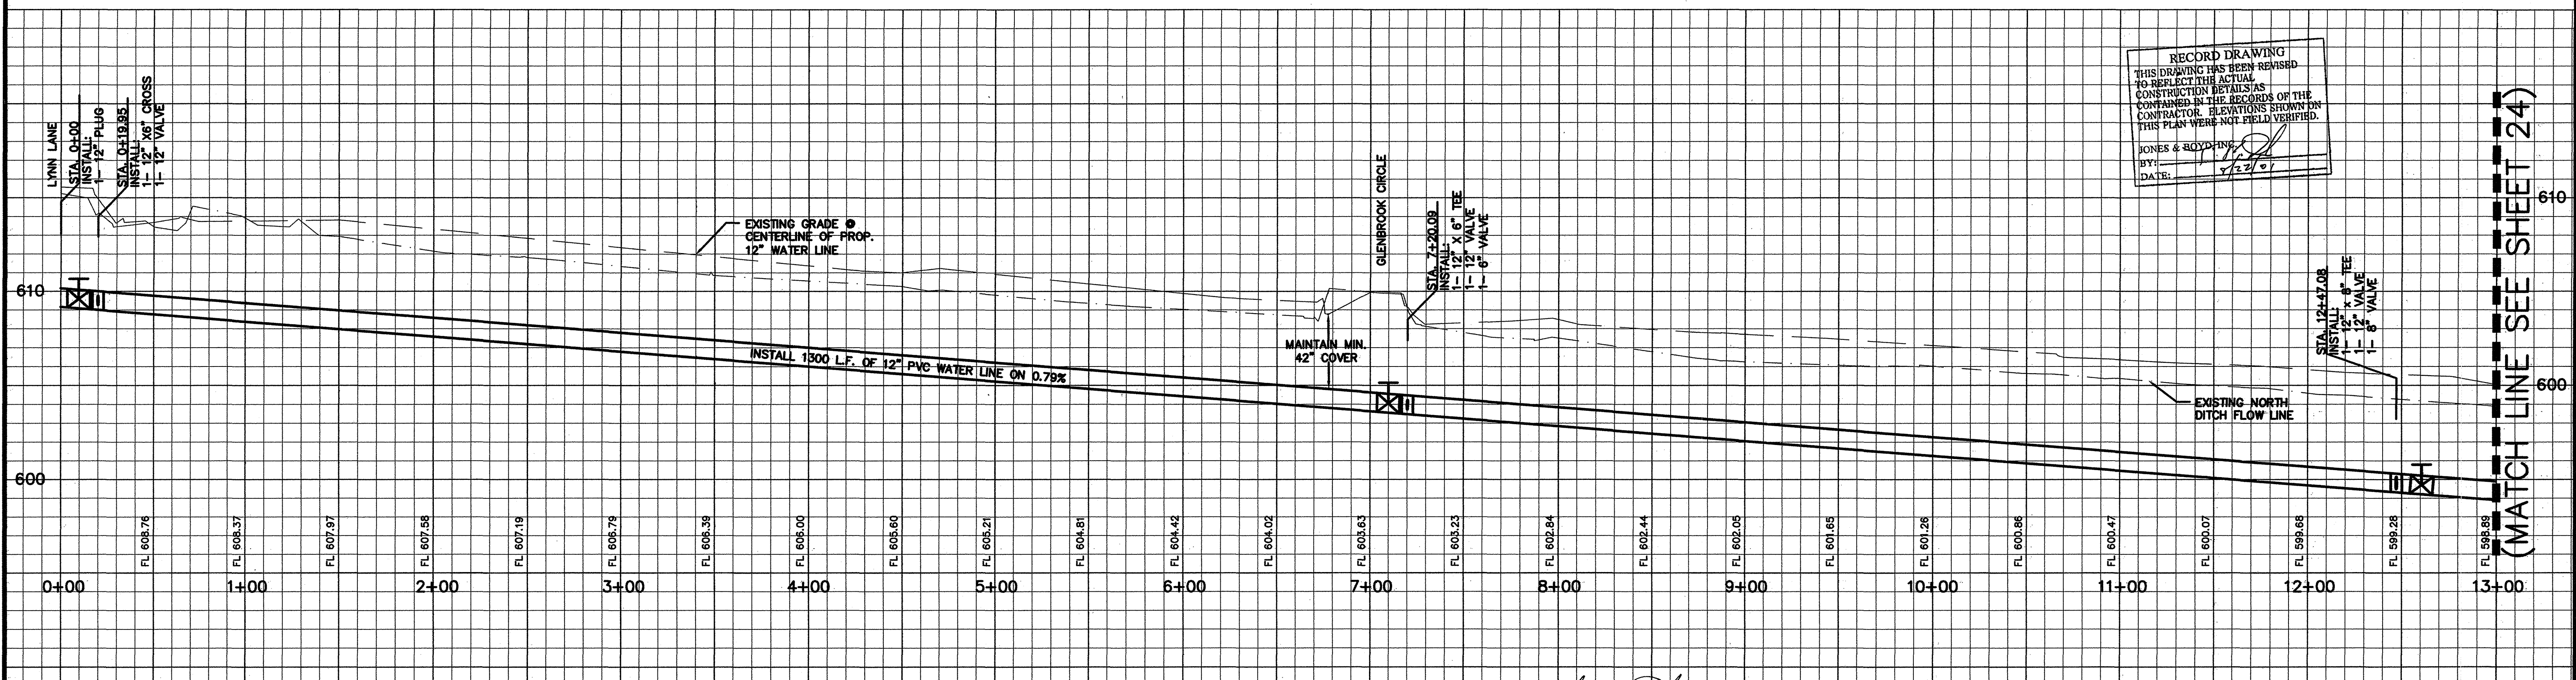

**BENCHMARKS:**

- "T" 1/2" IR, W of Ingram Rd. +- 1025' N of N edge of Lucas Rd. +- 8' E of fence. Elev. 637.08
- "T" 1/2" IR, E of Ingram Rd. +- 2650' N of N edge of Lucas Rd. +- 28' E & 37' N of fence corner. Elev. 639.20

NO.	REVISIONS DURING CONSTRUCTION	BY	DATE	NO.	REVISIONS DURING PLAN REVIEW	BY	DATE
1	ADDED BORE & ENCASE PER TxDOT COMMENTS.	JMW	02/16/01	1	REVISED PER CITY COMMENTS	TC	12/08/00
2	EXTEND BORE ACCROSS R.O.W PER TxDOT COMMENTS	TC	12/19/00	2	EXTEND BORE ACCROSS R.O.W PER TxDOT COMMENTS	TC	12/19/00
3	ADDED NOTE TO DETAIL & SHOWN GRAVEL EMBEDMENT.	CMG	01/05/01	3	ADDED NOTE TO DETAIL & SHOWN GRAVEL EMBEDMENT.	CMG	01/05/01

The seal appearing on this document was authorized by Thomas K. Juhn, P.E. 81799 on Feb. 16, 2001. Alteration of a sealed document without proper notification to the responsible engineer is an offense under the Texas Engineering Practice Act.

THOMAS K. JUHN  
81799  
LICENSED PROFESSIONAL ENGINEER

**Jones & Boyd, Inc.**  
16800 Dallas Parkway, Suite 240  
Dallas, Texas 75248  
Tel: 972-248-7676  
Fax: 972-248-1414



**OFFSITE 12" WATER LINE**  
North Side of F.M. 2170  
**SADDLEBROOK**  
City of Lucas, Collin County, Texas

PROJECT NO. **SK403**  
SHEET NO. **23**

**RECORD DRAWING**  
THIS DRAWING HAS BEEN REISSUED TO REFLECT THE ACTUAL CONSTRUCTION DETAILS AS CONTAINED IN THE RECORDS OF THE CONTRACTOR. ELEVATIONS SHOWN ON THIS PLAN WERE NOT FIELD VERIFIED.

JONES & BOYD, INC.  
BY: [Signature]  
DATE: 7/22/01

Plot Info: Plot date: 1/27/01 Plot time: 5:35:36 am Drawing Info: H:\projects\SK403\view\SK403RWS.dwg Plotted by: JMW

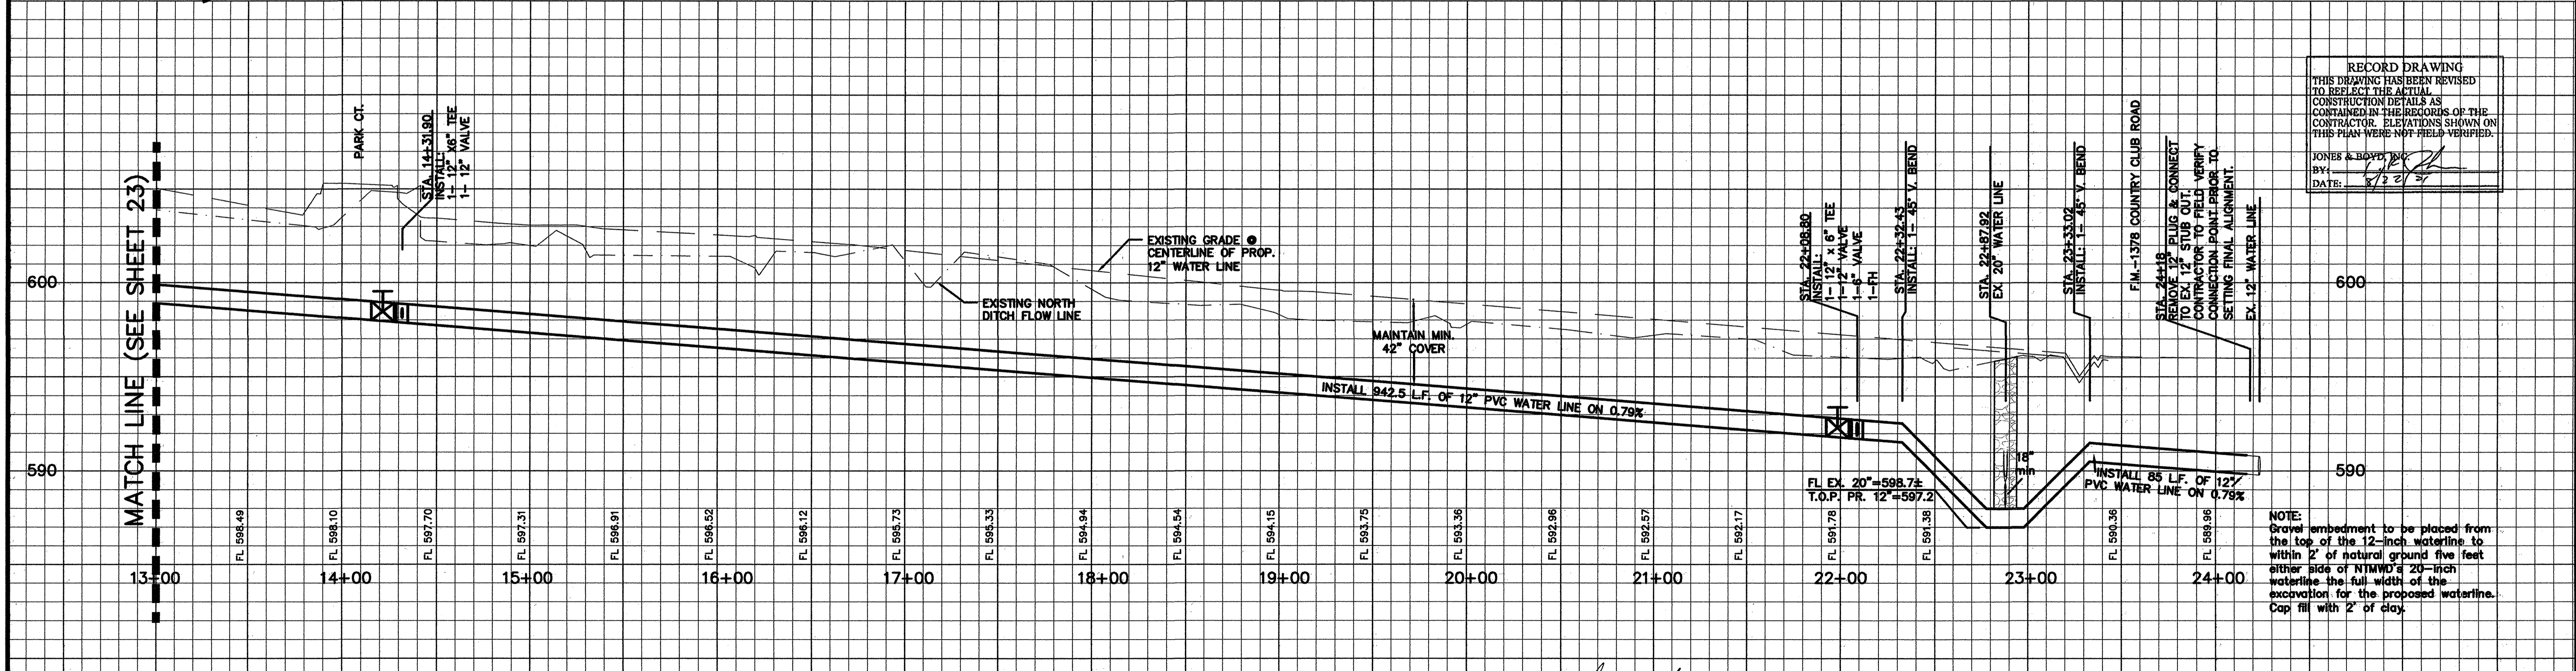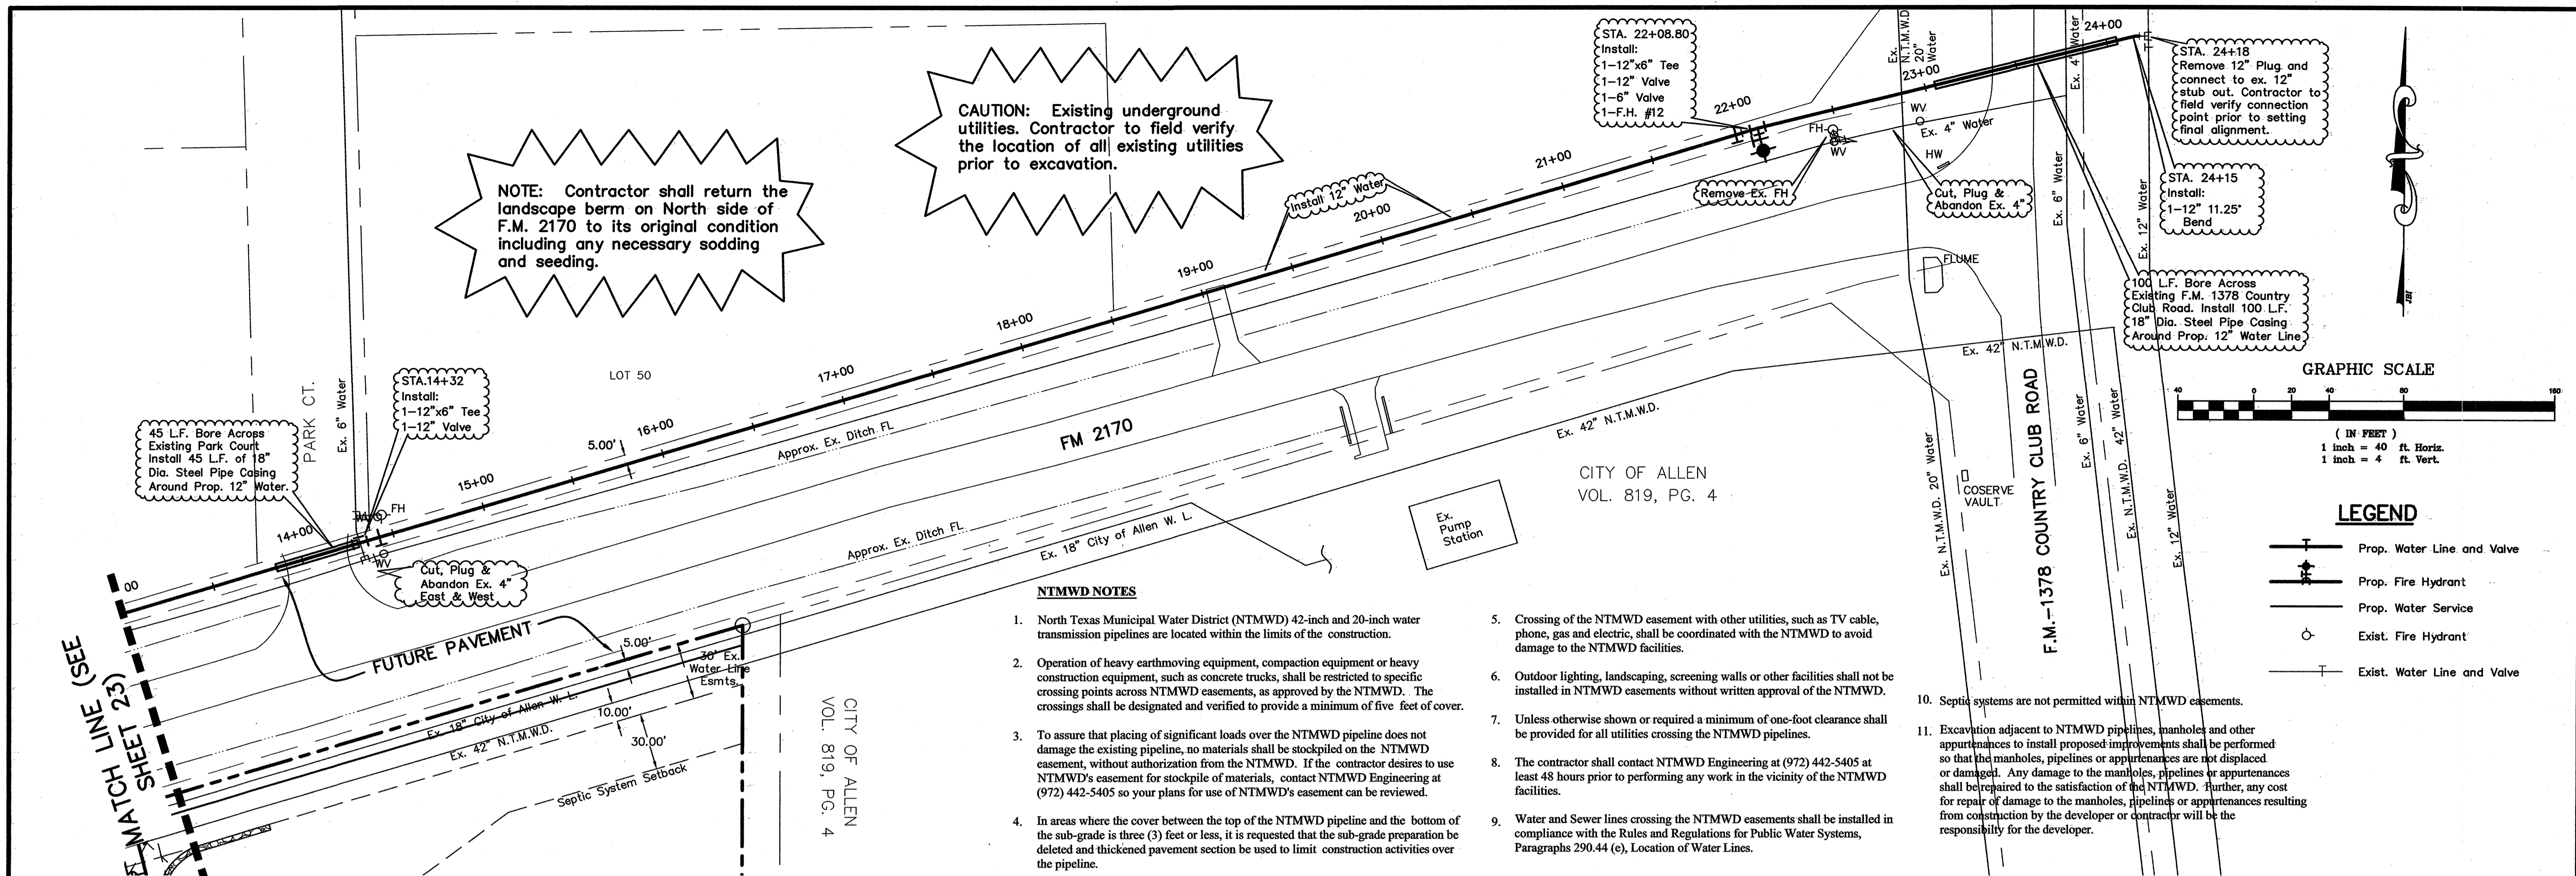

**BENCHMARKS:**

1. "T" 1/2" IR, W of Ingram Rd. +- 1025' N of N edge of Lucas Rd. +- 8' E of fence. Elev. 637.08
2. "U" 1/2" IR, E of Ingram Rd. +- 2650' N of N edge of Lucas Rd. +- 28' E & 37' N of fence corner. Elev. 639.20

NO.	REVISIONS DURING CONSTRUCTION	BY	DATE	NO.	REVISIONS DURING PLAN REVIEW	BY	DATE
1	ADDED BORE & ENCASE per TxDOT COMMENTS.	JMW	02/16/01	1	REVISED PER CITY COMMENTS	TC	12/08/00
2	EXTEND BORE ACROSS R.O.W. PER TxDOT COMMENTS	TC	12/19/00	2	EXTEND BORE ACROSS R.O.W. PER TxDOT COMMENTS	TC	12/19/00
3	ADDED NOTE TO DETAIL & SHOWN GRAVEL EMBEDMENT.	CMG	01/05/01	3	ADDED NOTE TO DETAIL & SHOWN GRAVEL EMBEDMENT.	CMG	01/05/01

The seal appearing on this document was authorized by Thomas K. Juhn, P.E. 81799 on Feb. 16, 2001. Alteration of a sealed document without proper notification to the responsible engineer is an offense under the Texas Engineering Practice Act.



2/16/01

**Jones & Boyd, Inc.**  
 16800 Dallas Parkway, Suite 240  
 Dallas, Texas 75248  
 Tel: 972-248-7676  
 Fax: 972-248-1414

**OFFSITE 12" WATER LINE**  
 North Side of F.M. 2170  
**SADDLEBROOK**  
 City of Lucas, Collin County, Texas

PROJECT NO. SK403  
 SHEET NO. 24

Plot info: Drawing: H:\projects\SK403\dwg\SK403WLS.dwg Plotted by: JMW Plot date: 1/2/01 Plot time: 5:35 pm

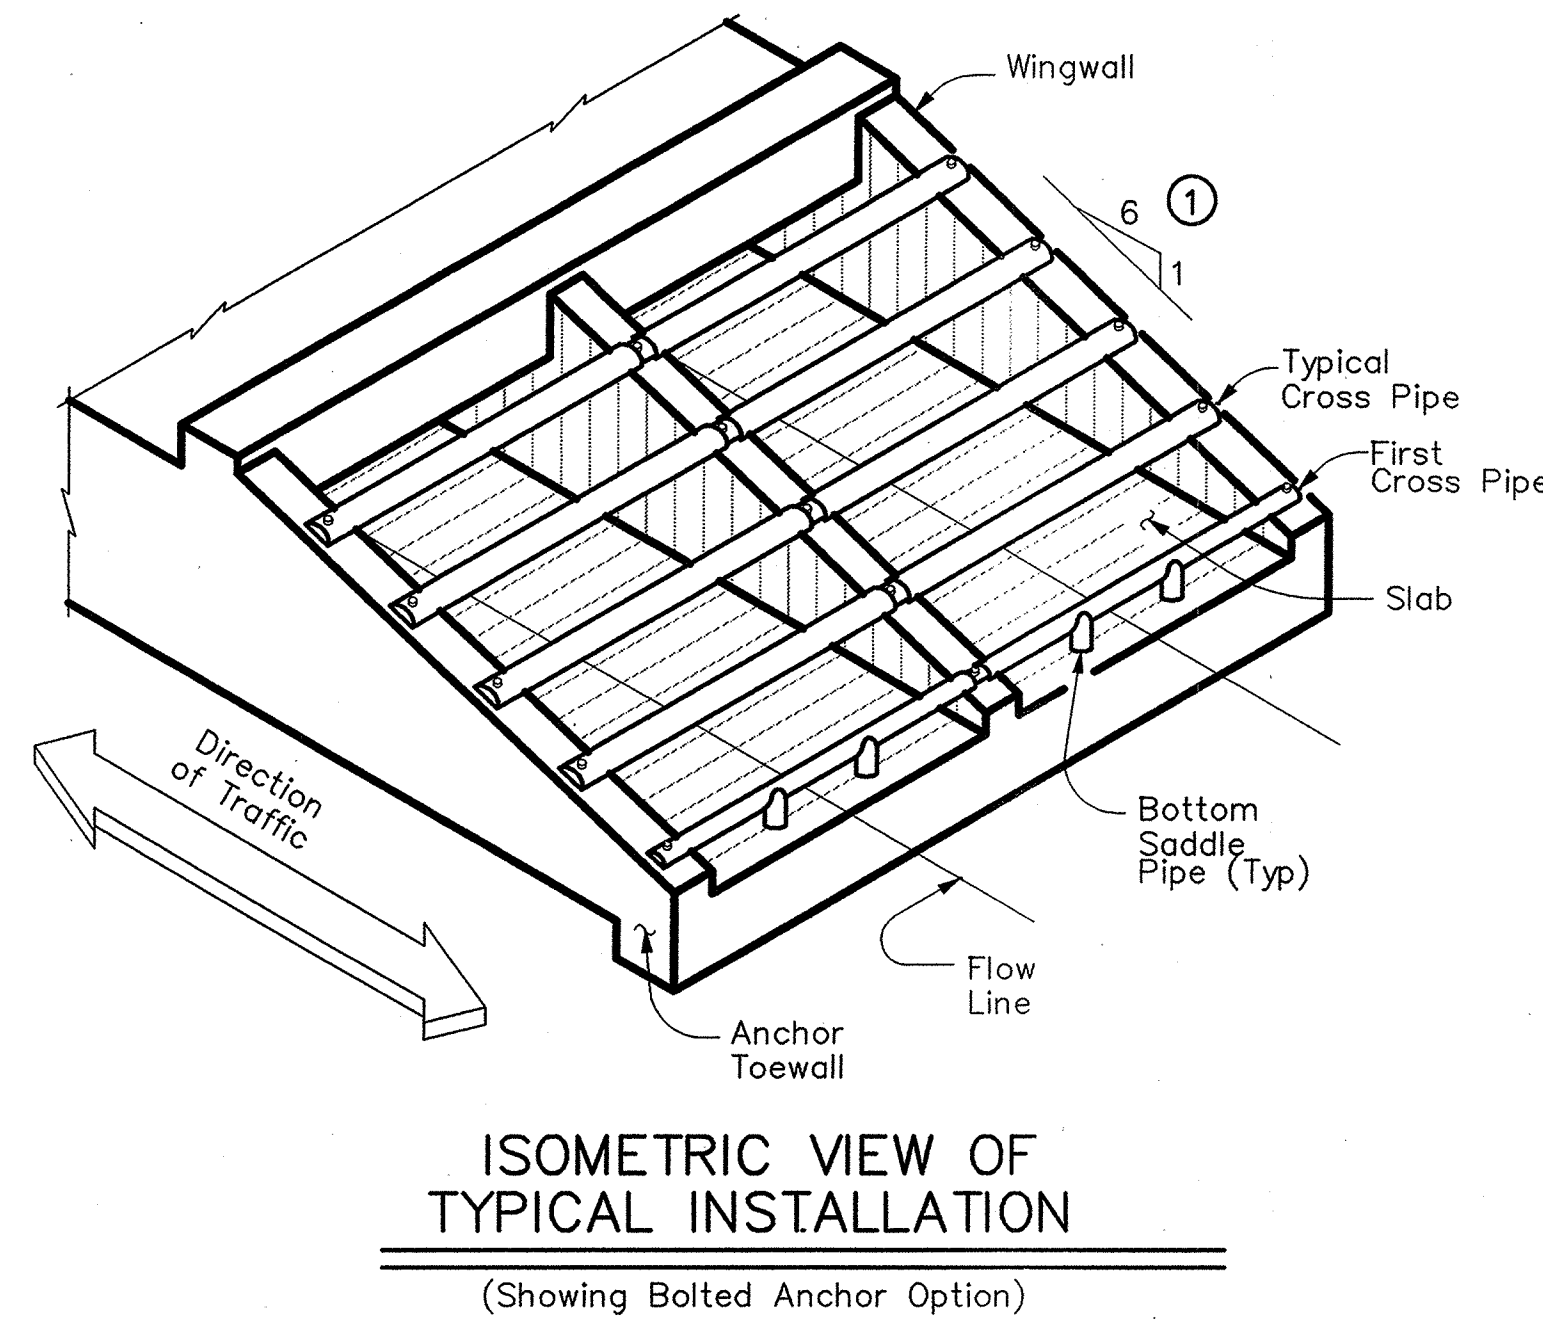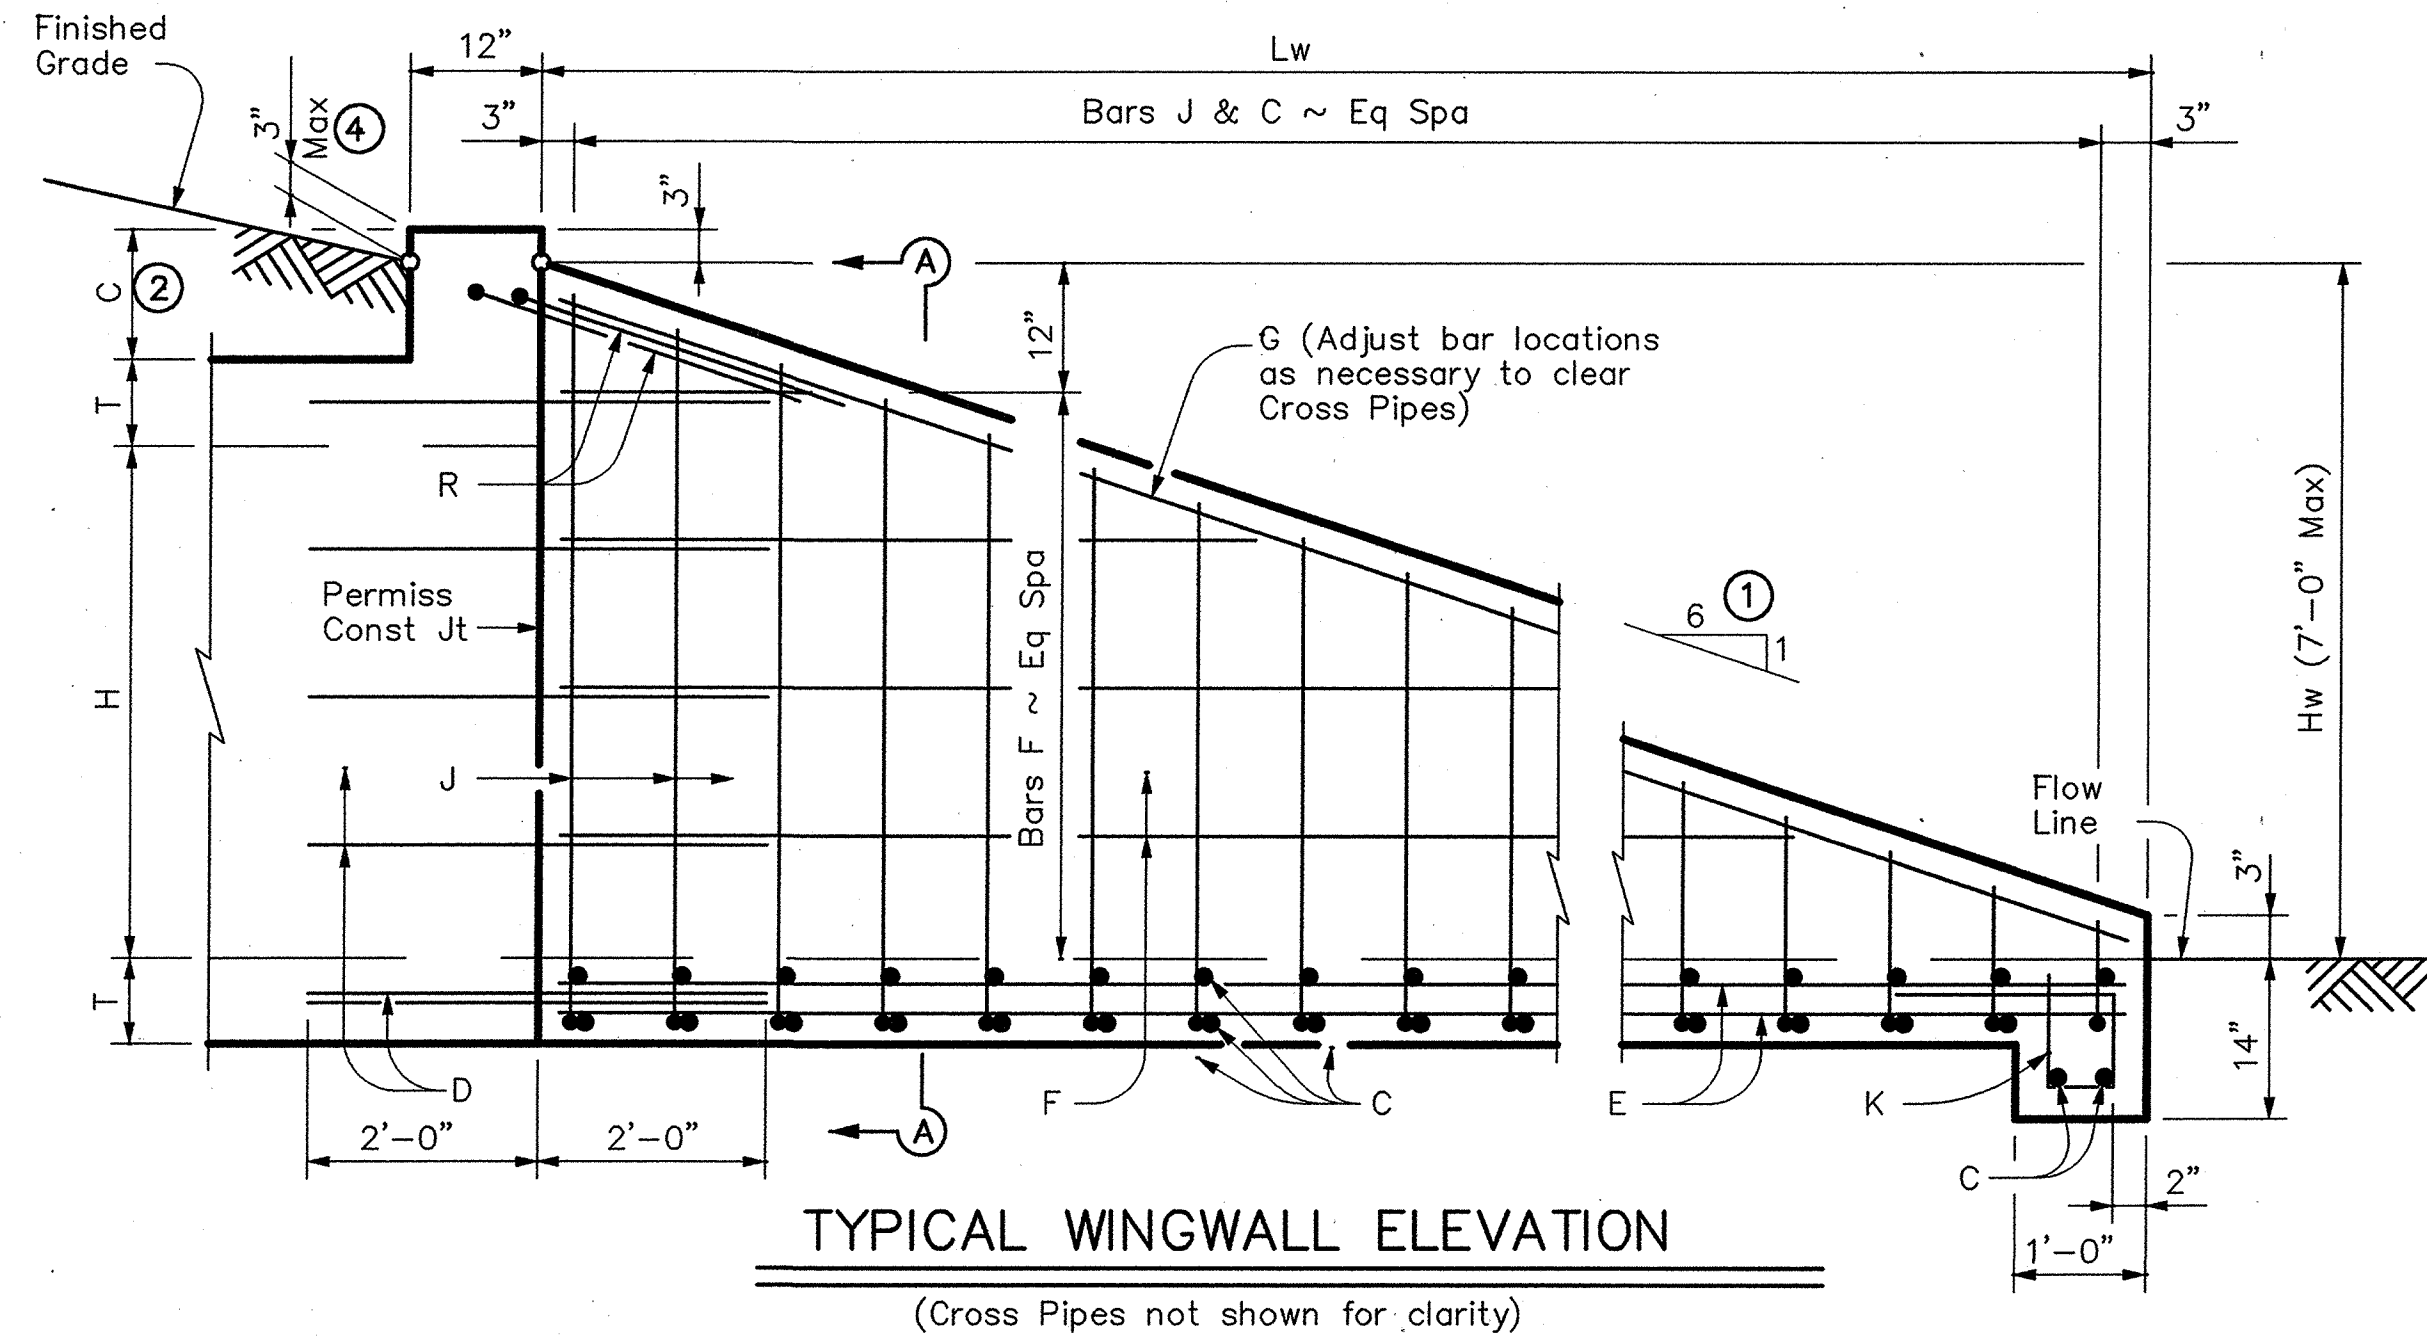

Formulas: (All values are in Feet)  
 $Hw = H + T + C - 0.250'$   
 $Lw = (Hw - 0.250') * (SL)$

For Cast-in-place culverts:  
 $Atw = (N) * (S) + (N+1) * (U)$

For Precast culverts:  
 $Atw = (N) * (2U + S) + (N-1) * (0.500')$

Total Wingwall Area (S.F.)  
 $= (0.5) * (Hw + 0.250') * (Lw) * (N+1)$

Total Concrete Volume (C.Y.)  
 $= [(Wingwall Area) * (U) + (Lw) * (Atw) * (T) + (Atw) * (1.000') * (1.167' - T)] \div (27)$




Total Reinforcing (Lbs)  
 $= (1.55) * (Lw) * (Atw) + (4.43) * (Atw) + (K2) * (Hw) * (N+1) * (\sqrt{Lw})$

C = Height of Curb above top of Top Slab  
Hw = Height of Wingwall  
K = Constant Value for use in formulas  
Slope SL:1 K  
3:1 ~ 7.50  
4:1 ~ 8.61  
6:1 ~ 10.41

Atw = Anchor Toewall Length  
Lw = Length of Wingwall  
N = Number of Culvert Barrels  
S = Clear Span of each Barrel  
SL:1 = Side Slope Ratio (Horizontal : 1 Vertical)

See applicable box culvert standard for H, S, T, and U values.

**GENERAL NOTES:**  
Designed according to current AASHTO Standard and Interim Specifications.  
The Safety End Treatments shown herein are intended for use in those installations where out of control vehicles are likely to traverse the openings approximately perpendicular to the Cross Pipes.  
Cross Pipes are designed for a traversing load of 10,000 pounds at yield as recommended by Research Report 280-2F, "Safety Treatment of Roadside Parallel-Drainage Structures", Texas Transportation Institute, March 1981.  
All concrete, except Riprap, shall be Class "C" and shall have a minimum 28 day compressive strength of 3600 psi.  
All reinforcing steel shall be Grade 60. All reinforcing shall be adjusted as necessary to provide a minimum clear cover of 1.25".  
The quantities for concrete, reinforcing steel, and Cross Pipes resulting from the formulas given herein are for Contractor's information only.  
Cross Pipes, Sleeve Pipes, and Saddle Pipes shall conform to the requirements of ASTM A53 (Type E or S, Grade B), ASTM A500 (Grade B), or API 5LX52.  
Bolts and nuts shall conform to ASTM A307. All steel components, except the concrete reinforcing, shall be galvanized after fabrication. Galvanizing damaged during transport or construction shall be repaired in accordance with the specifications.

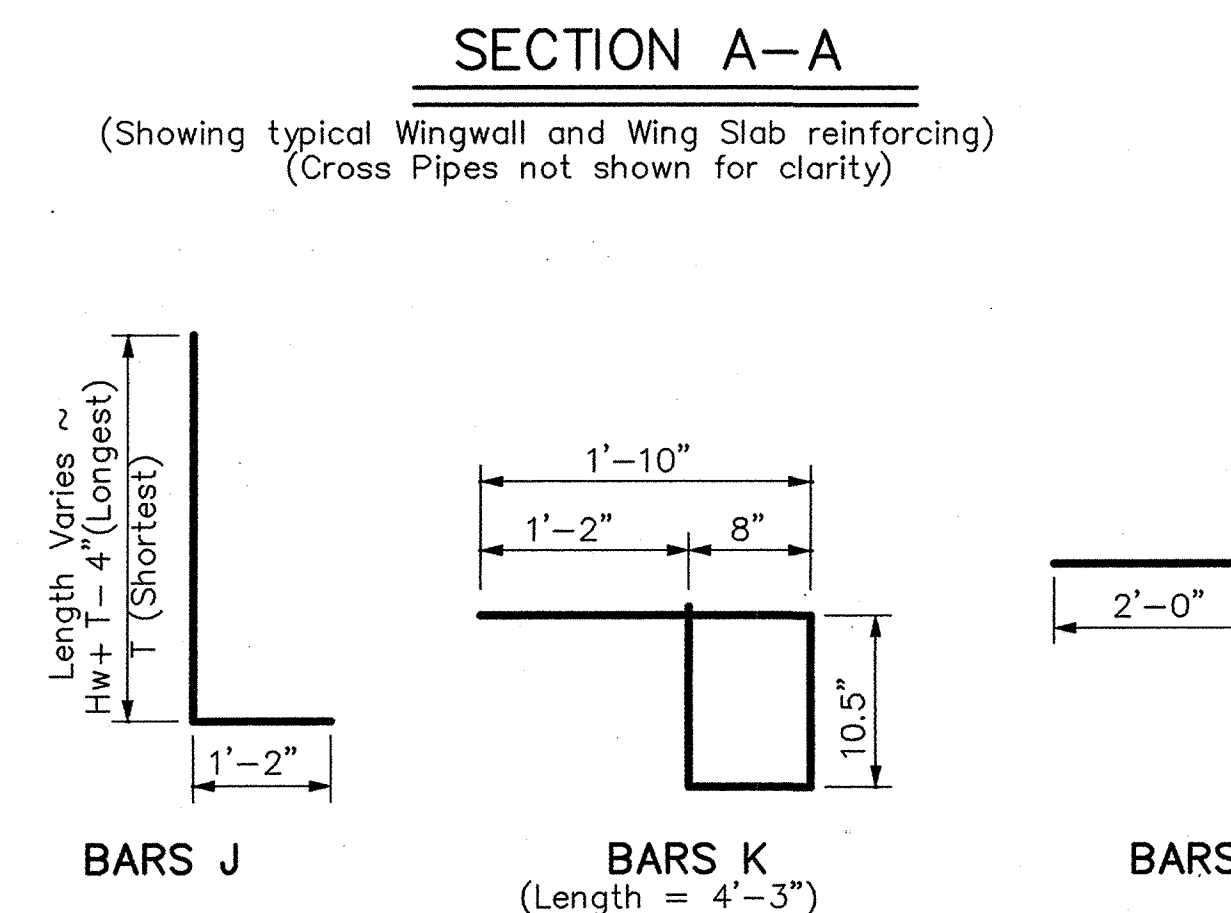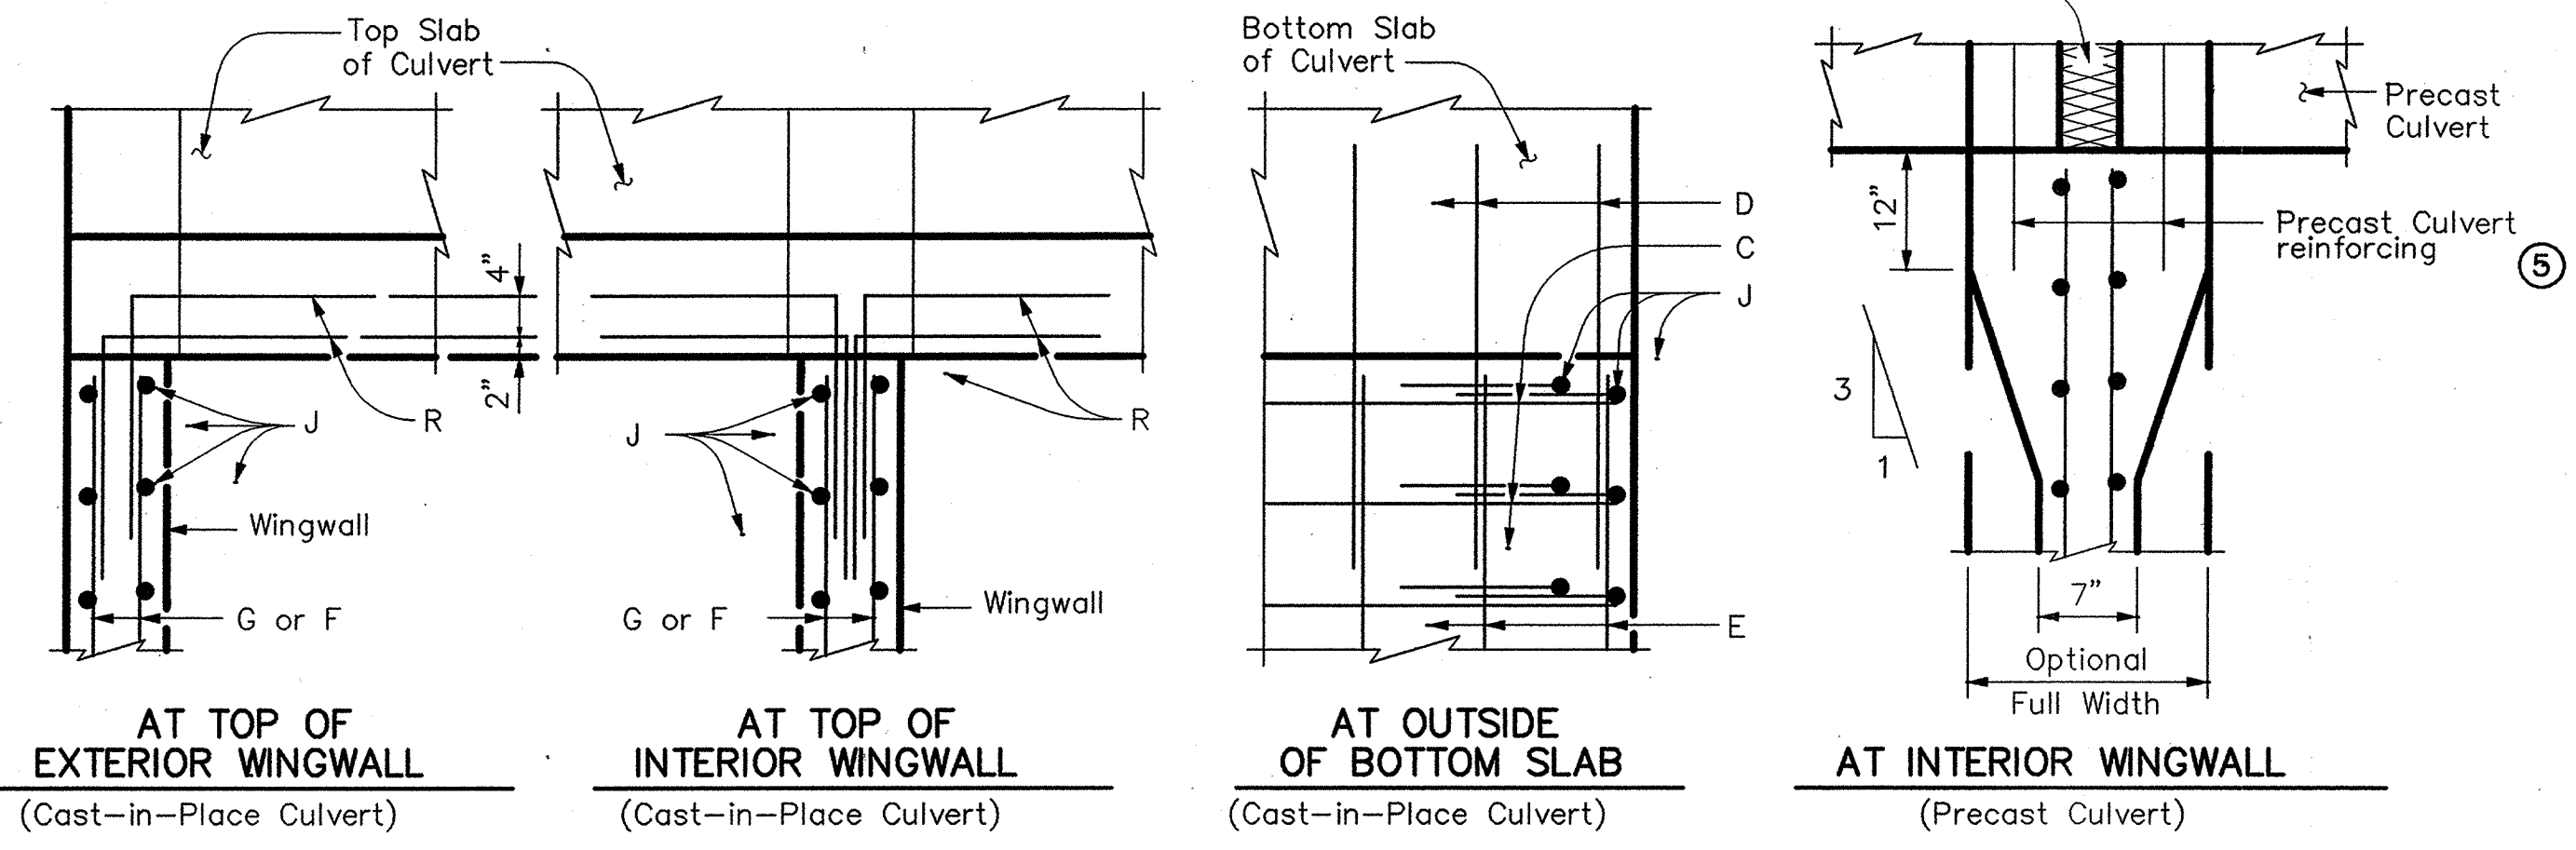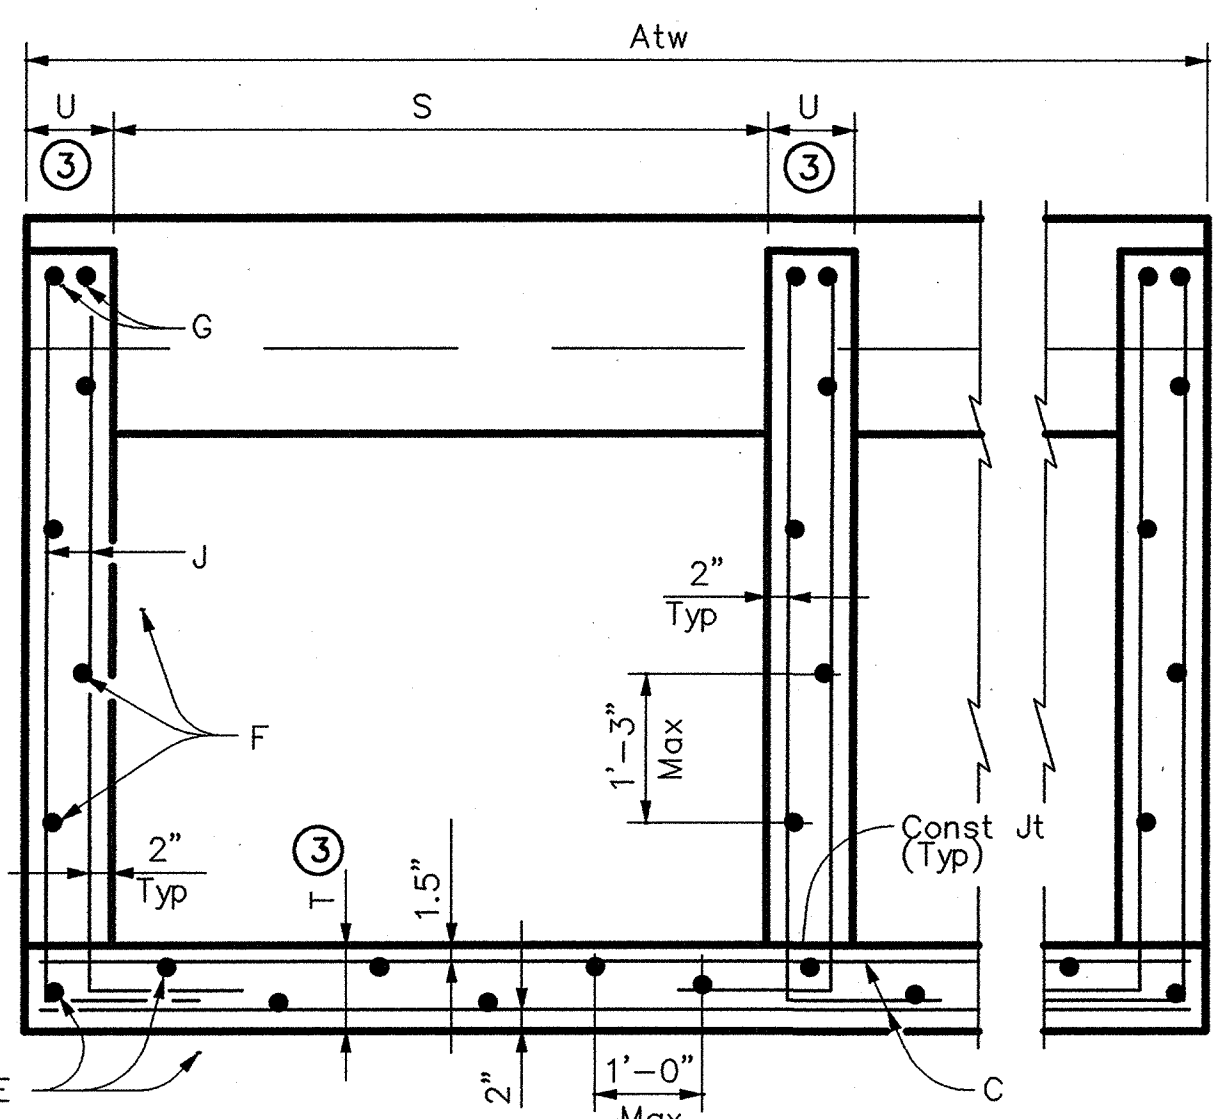

**TABLE OF REINFORCING BAR SIZES & SPACING**

Bar	Size	Spacing
C	#4	10" Max
D	#4	match F & E
E	#4	1'-0" Max
F	#4	1'-3" Max
G	#4	Shown
J	#4	10" Max
K	#4	1'-0" Max
R	#4	Shown

- Match Cross Slope as shown elsewhere in the plans. Cross Slope of 6:1 or flatter is required for vehicle safety.
- 0" min to 5'-0" max. For curbs greater than 1'-0" high, see ECD standard for additional details. Estimated curb heights are shown elsewhere in the plans.
- Wingwall and slab thicknesses may be the same as the adjacent culvert wall and slab thicknesses (7" Minimum)
- For vehicle safety, curb heights and wall heights shall be reduced, if necessary, to provide a maximum 3" projection above Finished Grade. No changes will be made in the quantities and no additional compensation will be allowed for this work.
- For Culverts with C = 0", the precast culvert reinforcing may extend 1'-0" minimum into Wingwall. Wingwall Bars D and R may be omitted. Otherwise, refer to the "Wingwall Connection Detail" on the SCP-MD standard.

**RECORD DRAWING**  
THIS DRAWING HAS BEEN REVISED TO REFLECT THE ACTUAL CONSTRUCTION DETAILS AS CONTAINED IN THE RECORDS OF THE CONTRACTOR. ELEVATIONS SHOWN ON THIS PLAN WERE NOT FIELD VERIFIED.

JONES & BOYD, INC.  
BY: [Signature]  
DATE: 2/22/01

LEVELS DISPLAYED  
COMMENTS:  
1 12 13 14 15 16 17 18 19 20 21 22 23 24 25 26 27 28 29 30 31 32  
33 34 35 36 37 38 39 40 41 42 43 44 45 46 47 48  
49 50 51 52 53 54 55 56 57 58 59 60 61 62 63

SHEET 1 OF 2

Texas Department of Transportation  
Bridge Division  
**SAFETY END TREATMENT**  
FOR BOX CULVERTS  
(MAXIMUM Hw = 7'-0")  
TYPE I ~ PARALLEL DRAINAGE

SETB-PD

FILE: setbpdse.dgn	DN: GAF	CK: CAT	DW: JRP	OK: GAF
© TxDOT September 2000	DISTRICT	FEDERAL AID PROJECT	SHEET	
REVISIONS		COUNTY	CONTROL	SECT
			JOB	HIGHWAY

NO.	REVISIONS DURING CONSTRUCTION	BY	DATE	NO.	REVISIONS DURING PLAN REVIEW	BY	DATE
				1	Add details to plan set per TxDOT comment.	JMW	2/14/01

The seal appearing on this document was authorized by Thomas K. Juhn, P.E. 81799 on Feb. 14, 2001. Alteration of a sealed document without proper notification to the responsible engineer is an offense under the Texas Engineering Practice Act.

THOMAS K. JUHN  
81799  
LICENSED PROFESSIONAL ENGINEER

Jones & Boyd, Inc.  
16800 Dallas Parkway, Suite 240  
Dallas, Texas 75248  
Tel: 972-248-7676  
Fax: 972-248-1414

**TxDOT STANDARD DETAILS**

**SADDLEBROOK**

City of Lucas, Collin County, Texas

PROJECT NO. SK403  
SHEET NO. 25

Drawing Info: TC H:\Projects\SK403\DWG\SK403TX-DOTDET.dwg Plotted by: TC Plot date: 12/8/00 Plot time: 8:48 am  
Drawing Info: H:\Projects\SK403\DWG\SK403TX-DOTDET.dwg Plotted by: TC Plot date: 12/8/00 Plot time: 8:48 am



