

JB09955  
1/29/2019  
10:34:58 AM  
X:\18-112 Stinson Road\18112 Stinson Plan Set\roadway\GNWTRD01.DGN  
PLOTTED BY:  
PLOT DATE:  
LAST SAVED:  
LOCATION:

- ALL CONSTRUCTION AND MATERIALS SHALL BE IN ACCORDANCE WITH THE TEXAS DEPARTMENT OF TRANSPORTATION (TXDOT) STANDARD SPECIFICATIONS FOR CONSTRUCTION AND MAINTENANCE OF HIGHWAYS, STREETS, AND BRIDGES, NOVEMBER 2014 EDITION, REFERRED TO AS "THE STANDARD SPECIFICATIONS".
- IN THE EVENT AN ITEM IS NOT COVERED WITHIN THESE PLANS AND SPECIFICATIONS, THE TXDOT STANDARD SPECIFICATIONS SHALL APPLY.
- THE CONTRACTOR SHALL SECURE ALL NECESSARY PERMITS BEFORE ANY WORK MAY BEGIN. ALL PERMIT FEES SHALL BE CONSIDERED INCIDENTAL TO PAY ITEMS PROVIDED.
- THE CONTRACTOR SHALL PROVIDE A CONSTRUCTION SCHEDULE UPDATE TO THE ENGINEER AND THE CONSTRUCTION INSPECTOR WITH THE MONTHLY PAY ESTIMATE.
- THE CONTRACTOR WILL BE PAID ONLY FOR THE WORK WHICH IS COMPLETED IN STRICT CONFORMANCE TO THE PLANS AND CONSTRUCTION DETAILS.
- FINAL PAYMENT TO CONTRACTOR SHALL BE RELEASED AFTER THE ACCEPTANCE OF THE FINAL INSPECTION BY AUTHORIZED PERSONNEL OF THE PUBLIC WORKS DEPARTMENT.
- THE CONTRACTOR SHALL CONTACT THE ENGINEER SHOULD ANY DISCREPANCIES BE FOUND IN THE CONSTRUCTION PLANS AND/OR THE SPECIAL PROVISIONS PRIOR TO CONSTRUCTION. THE CONTRACTOR WILL NOT BE COMPENSATED FOR ANY WORK NOT AUTHORIZED BY THE ENGINEER.
- THE CONTRACTOR SHALL PROVIDE ALL NECESSARY CONSTRUCTION STAKING BY A TEXAS REGISTERED PROFESSIONAL LAND SURVEYOR. WORK IS NOT PERMITTED OUTSIDE OF THE RIGHT OF WAY OR EASEMENTS WITHOUT PRIOR PERMISSION AND COORDINATION WITH THE CITY.
- CONSTRUCTION OBSERVATION AND ADDITIONAL MATERIALS TESTING WILL BE PERFORMED BY REPRESENTATIVES OF THE OWNER, ENGINEER AND REVIEW AUTHORITIES AND AGENCIES. UNRESTRICTED ACCESS SHALL BE PROVIDED TO THESE REPRESENTATIVES AT ALL TIMES. THE CONTRACTOR IS RESPONSIBLE FOR UNDERSTANDING THE REQUIRED INSPECTIONS AND ALLOWING FOR THEM IN HIS SCHEDULE OF OPERATIONS. CONTRACTOR WILL NOT BE ALLOWED ANY ADDITIONAL CONTRACT DAYS OR COMPENSATION AS A RESULT OF HIS FAILURE TO ADEQUATELY PROVIDE FOR AUTHORIZED INSPECTIONS.
- THE CONTRACTOR SHALL NOTIFY THE PUBLIC WORKS DEPARTMENT AND THE ENGINEER TWO WORKING DAYS BEFORE STARTING WORK.
- THE CONTRACTOR SHALL NOTIFY THE PUBLIC WORKS DEPARTMENT AND THE ENGINEER TWO WORKING DAYS IN ADVANCE OF ANY CONCRETE PLACING OR ASPHALT LAYING OPERATION.
- THE CONTRACTOR MUST FURNISH AT LEAST TWO PHONE NUMBERS WHERE RESPONSIBLE PERSONNEL CAN BE REACHED IN CASE OF EMERGENCY DURING WORKING AND NONWORKING HOURS. IF THERE ARE ANY CHANGES, THE INFORMATION MUST BE UPDATED IMMEDIATELY FOR THE DURATION OF THE PROJECT.
- IF CULTURAL RESOURCES (ARCHAEOLOGICAL FINDINGS UNEARTHED) ARE LOCATED DURING CONSTRUCTION, WORK SHALL STOP IMMEDIATELY IN THAT AREA. IMMEDIATELY NOTIFY THE ENGINEER.
- THE ENGINEER/INSPECTOR WILL NOT SUPERVISE, DIRECT OR HAVE CONTROL OVER THE CONTRACTOR'S WORK; NOR WILL THE ENGINEER/INSPECTOR HAVE AUTHORITY OVER OR BE RESPONSIBLE FOR THE MEANS, METHODS, TECHNIQUES, SEQUENCES OR PROCEDURES OF CONSTRUCTION; FOR THE SAFETY PRECAUTIONS AND PROGRAMS INCIDENT TO THE WORK OF CONTRACTOR; OR FOR ANY FAILURE OF CONTRACTOR TO COMPLY WITH LAWS, RULES, REGULATIONS, ORDINANCES, CODES OR ORDERS APPLICABLE TO CONTRACTOR FURNISHING AND PERFORMING THE WORK.
- THE CONTRACTOR SHALL PROTECT AND BE RESPONSIBLE FOR RESETTING OR ESTABLISHING NEW BENCHMARKS AFFECTED BY THE CONSTRUCTION (NO SEPARATE PAY ITEM).
- ALL CONCRETE SHALL BE IN COMPLIANCE WITH THE SPECIFIED CLASSES OF CONCRETE PER TXDOT SPECIFICATIONS.
- CONTRACTOR SHALL ADHERE TO ALL REQUIREMENTS OF TXDOT ITEM 360, CONCRETE PAVEMENT.
- THE CONTRACTOR SHALL SUBMIT TO THE ENGINEER THE COMPLETE CONCRETE MIX (BATCH) DESIGN AT THE PRE- CONSTRUCTION CONFERENCE AND/OR AT LEAST TEN WORKING DAYS PRIOR TO THE START OF ANY CONCRETE PLACING OPERATIONS. VOLUMETRIC CONCRETE IS NOT APPROVED FOR THIS PROJECT.
- CONTRACTOR SHALL SUBMIT PAVING CONSTRUCTION PLAN AS DESCRIBED IN TXDOT ITEM 360, CONCRETE PAVEMENT.
- CONTRACTOR SHALL EMPLOY A CERTIFIED TESTING LABORATORY TO PERFORM DENSITY TESTING IN ACCORDANCE WITH TXDOT PROCEDURE TEX-115-E.
- CONTRACTOR SHALL EMPLOY A CERTIFIED TESTING LABORATORY FOR CONCRETE SAMPLING AND TESTING IN ACCORDANCE WITH ASTM C31-18P AND ASTM C39-18 AND TEMPERATURE. ONE SET OF FIVE (6IN X 12IN) CONCRETE CYLINDERS (TEST 1@3, 1@7, 2@28 DAYS) FOR EACH DAY'S PRODUCTION. IF THE TWO 28 DAYS TEST FAIL TO MEET REQUIRED STRENGTH, TEST THE 5TH CYLINDER AT 48 DAYS. COST OF CONCRETE TESTING SHALL BE INCLUDED IN CONCRETE POUR OPERATIONS AT NO ADDITIONAL COST. ALL TEST RESULTS SHALL BE SUBMITTED TO THE ENGINEER. TEST LOCATIONS SHALL BE MARKED IN THE PLANS AND SUBMITTED WITH THE RESULTS. CONCRETE SHALL BE SAMPLED AT POINT OF DISCHARGE AND INDICATED AS SUCH ON REPORT. ~~CONCRETE SHALL HAVE AIR ENTRAINMENT OF 3-6%.~~
- CONTRACTOR SHALL EMPLOY A CERTIFIED TESTING SUBCONSULTANT TO PERFORM PRESSURE TESTING REQUIRED ON ALL WATERWORKS.
- ALL INSPECTION AND TESTING LABORATORIES MUST BE APPROVED BY THE CITY PRIOR TO PERFORMING ANY WORK. SUBMIT INSPECTION AND TESTING CERTIFICATIONS A MINIMUM OF TWO WEEKS PRIOR TO BEGINNING RELATED WORK.
- WHEN AIR TEMPERATURE IS BETWEEN 85 DEG. F (30 DEG. C) AND 90 DEG F (32 DEG. C), REDUCE MIXING AND DELIVERY TIME FROM 1 1/2 HOURS TO 75 MINUTES, AND WHEN AIR TEMPERATURE IS ABOVE 90 DEG. F (32 DEG. C), REDUCE MIXING AND DELIVERY TIME TO 60 MINUTES. NO ADMIXTURE SHALL BE PERMITTED IN THE CONCRETE MIX WITHOUT WRITTEN APPROVAL BY THE ARCHITECT/ENGINEER. NO WATER SHALL BE ADDED TO THE CONCRETE MIX AT THE JOB SITE.
- CONCRETE WASHOUT WILL NOT BE PERMITTED ON SITE AND MUST BE CONDUCTED AT A FACILITY DESIGNATED FOR SUCH PURPOSES.
- ALL REINFORCING STEEL AND DOWEL BARS IN PAVEMENT SHALL BE SUPPORTED AND MAINTAINED AT THE CORRECT CLEARANCES BY THE USE OF BAR CHAIRS OR OTHER APPROVED SUPPORT.

- THE USE OF WOOD FORMS FOR PAVEMENT CONSTRUCTION WILL BE PERMITTED ONLY FOR LEAVE-OUTS, ALLEYS, SIDEWALKS, DRIVEWAYS, BARRIER FREE RAMPS AND INTERSECTIONS. WOOD FORMS MAY BE PERMITTED FOR OTHER USES, BUT ONLY ON A CASE-BY-CASE BASIS, AND MUST BE EXPLICITLY AUTHORIZED BY THE ENGINEER.
- DRIVEWAY APPROACHES DAMAGED BY THE CONTRACTOR SHALL BE REMOVED AND REPLACED TO MATCH THE EXISTING CONDITIONS, AT THE CONTRACTOR'S EXPENSE AND TO THE SATISFACTION OF THE CITY OF LUCAS. DRAINAGE PIPE UNDER DRIVEWAY APPROACHES DAMAGED BY THE CONTRACTOR SHALL BE REPLACED OR REPAIRED TO EQUAL OR BETTER THAN EXISTING CONDITION, AT THE CONTRACTOR'S EXPENSE.
- THE CONTRACTOR SHALL PROTECT ALL EXISTING FENCES (TO REMAIN). ANY DAMAGES DUE TO CONTRACTOR'S ACTION SHALL BE REPAIRED AT NO ADDITIONAL COST TO THE CITY.
- THE CONTRACTOR SHALL RESTORE ALL AREAS DISTURBED BY THE CONSTRUCTION TO THE ORIGINAL CONDITION OR BETTER. RESTORED AREAS INCLUDE BUT NOT LIMITED TO TRENCH BACKFILL, SIDE SLOPES, FENCES, IRRIGATION SYSTEMS, DRIVEWAYS, PRIVATE YARDS, SIGNS AND ROADWAYS.
- DISTURBED AREAS SHALL BE HYDRO MULCHED, WATERED & ESTABLISHED. DISTURBED CHANNEL SIDE SLOPES SHALL BE RESTORED WITH SOLID BLOCK SOD, WATERED, FERTILIZED & ESTABLISHED. THE ESTABLISHMENT OF GRASS IN DISTURBED AREAS SHALL BE DETERMINED BY THE CITY.
- THE CONTRACTOR SHALL NOT PLACE FILL OR WASTE MATERIAL ON ANY PRIVATE PROPERTY WITHOUT A WRITTEN AGREEMENT WITH THE PROPERTY OWNER AND APPROVAL BY CITY. A COPY OF THIS AGREEMENT SHALL BE PROVIDED TO THE CITY. LETTERS OF FINAL APPROVAL AND RELEASE FROM THE AFFECTED PROPERTY OWNER(S) MUST BE SUBMITTED TO THE CITY BEFORE FINAL PAYMENT WILL BE AUTHORIZED ON THIS PROJECT.
- NO EXCESS EXCAVATED MATERIAL SHALL BE DEPOSITED IN LOW AREAS OR ALONG ANY NATURAL DRAINAGE WAY, WITHOUT WRITTEN PERMISSION FROM THE ENGINEER. IF THE CONTRACTOR PLACES EXCESS MATERIAL IN AREAS WITHOUT WRITTEN PERMISSION, HE WILL BE RESPONSIBLE FOR ALL DAMAGE RESULTING FROM SUCH FILL AND HE SHALL REMOVE THE MATERIAL AT HIS OWN COST IF THE CITY SO DIRECTS.
- THE CONTRACTOR SHALL PROTECT THE EXISTING TREES, BUSHES, LANDSCAPING PLANTS, SPRINKLERS, AND LAWNS UNLESS SHOWN OTHERWISE ON THE CONSTRUCTION DRAWINGS. ANY DAMAGE TO THE EXISTING TREES, BUSHES, LANDSCAPING PLANTS, SPRINKLERS, AND LAWNS CAUSED BY THE CONSTRUCTION SHALL BE REPLACED TO THE SATISFACTION OF THE PROPERTY OWNER AND THE CITY AT THE CONTRACTOR'S SOLE EXPENSE.
- THE CONTRACTOR SHALL PROTECT ALL UNDERGROUND IRRIGATION SYSTEMS. ADJUSTMENT OR RELOCATION OF IRRIGATION SYSTEM SHALL BE INSTALLED BY AN IRRIGATOR LICENSED IN THE STATE OF TEXAS AND, IF REQUIRED, SHALL BE INCIDENTAL TO RIGHT OF WAY PREPARATION.
- NO TREES SHALL BE CUT EXCEPT ON SPECIFIC AUTHORITY OF THE ENGINEER. TREES 6-INCH OR LESS IN DIAMETER ARE SUBSIDIARY TO PROJECT (NO SEPARATE PAY ITEM).
- SHOULD ANY TREE ROOTS BE FOUND IN CONFLICT WITH PROPOSED CONSTRUCTION, THE CONTRACTOR SHALL HAVE A PROFESSIONAL ARBORIST PRUNE THE ROOTS TO PREVENT DAMAGE TO THE TREE. CONTRACTOR SHALL NOTIFY ENGINEER A LEAST 2 DAYS PRIOR TO ANY ROOT PRUNING ACTIVITIES.
- THE CONTRACTOR IS RESPONSIBLE FOR KEEPING STREETS, DRIVEWAYS AND SIDEWALKS ADJACENT TO THE PROJECT FREE OF MUD AND DEBRIS FROM THE CONSTRUCTION AT ALL TIMES.
- MAIL BOXES WILL BE RESET AS DIRECTED IN THE PLANS OR BY THE ENGINEER. ALL MAIL BOXES TO BE REMOVED SHALL BE TEMPORARILY LOCATED AS TO NOT INTERRUPT MAIL SERVICE AND RESET AS SOON AS ALLOWED BY CONSTRUCTION ACTIVITIES. ALL MAIL BOXES DAMAGED BY CONSTRUCTION ACTIVITIES SHALL BE REPLACED WITH MAILBOXES OF EQUAL OR BETTER QUALITY, AND OF A IDENTICAL STYLE TO THOSE BEING REPLACED.
- ADJUSTMENT OF UNPAVED DRIVEWAYS BEHIND PROPERTY LINE AND RESTORATION OF THE SURFACE TO EQUAL OR BETTER THAN THE ORIGINAL IS INCIDENTAL WORK ON THIS PROJECT. CONTRACTOR MUST COORDINATE WITH THE ENGINEER AND PROPERTY OWNER PRIOR TO ACCESSING OR WORKING ON PRIVATE PROPERTY. HARMONIZATION IS INCIDENTAL TO THE RELATED WORK. NO ADDITIONAL PAYMENT WILL BE MADE.
- EXISTING UTILITIES ARE SHOWN AT APPROXIMATE LOCATIONS AND DEPTHS BASED ON BEST AVAILABLE RECORDS AND LIMITED FIELD DATA. NOT ALL UTILITIES MAY BE SHOWN. THE CONTRACTOR SHALL VERIFY EXACT LOCATIONS AND DEPTHS OF ALL UTILITIES PRIOR TO BEGINNING CONSTRUCTION. ANY DAMAGES TO UTILITIES SHALL BE REPAIRED AT CONTRACTOR'S EXPENSE.
- CALL 1-800-DIG-TESS (1-800-344-8377) AT LEAST TWO WORKING DAYS PRIOR TO BEGINNING CONSTRUCTION, SO THAT THE LOCATION OF UTILITIES CAN BE MARKED. IF NECESSARY, TEST DITCHES SHALL BE DUG TO VERIFY/DETERMINE ACTUAL FIELD LOCATIONS AND CONDITIONS. ~~LOCATION OF CITY UTILITIES TO BE PROVIDED BY THE CITY OF LUCAS.~~
- THE CONTRACTOR SHALL PROVIDE A TRENCH SAFETY PLAN. THIS DOCUMENT SHALL BE SUBMITTED TO THE CITY OF LUCAS AT THE PRE CONSTRUCTION CONFERENCE OR PRIOR TO THE START OF CONSTRUCTION.
- ALL PAVEMENT MARKINGS, SIGN MATERIALS AND CONSTRUCTION SHALL CONFORM TO THE LATEST ADDITIONS OF THE STANDARD HIGHWAY DEPARTMENT SIGN DESIGN FOR TEXAS, THE TEXAS MANUAL OF UNIFORM TRAFFIC CONTROL DEVICES (TMUTCD) UNLESS NOTED OTHERWISE.
- SIGN LOCATIONS SHOWN ON THE PLANS ARE DIAGRAMMATIC. SIGNS SHALL BE PLACED IN CONFORMANCE WITH THE LATEST EDITION OF TMUTCD.
- PAYMENT FOR EACH SIGN SHALL INCLUDE ALL MOUNTING HARDWARE, THE SIGN POLE AND WEDGE BASE SYSTEM. (TXDOT SMD (TWT)-08).
- REFLECTORIZED PAVEMENT MARKINGS SHALL BE THERMOPLASTIC, PER TXDOT STANDARD SPECIFICATIONS, ITEM 666. PAVEMENT MARKERS SHALL COMPLY WITH TXDOT STANDARD SPECIFICATIONS, ITEM 672.
- ALL EXISTING SIGNS TEMPORARILY REMOVED BY THE CONTRACTOR SHALL BE PROTECTED FOR REINSTALLATION BY THE CONTRACTOR. ALL EXISTING SIGNS PERMANENTLY REMOVED SHALL BE SALVAGED.
- A MINIMUM OF 6% HYDRATED LIME BY DRY SOIL WEIGHT TO THE SPECIFIED DEPTH.

| REVISIONS |                       |
|-----------|-----------------------|
| DATE      | DESCRIPTION           |
| 01/29/19  | 2 UPDATED/ADDED NOTES |


**LAKES**  
**ENGINEERING, INC.**

CHRISTOPHER P. MESZLER, P.E.  
LIC. No. 112052  
1903 CENTRAL DRIVE, SUITE #405  
BEDFORD, TX 76021  
PHONE: 817.618.3640  
TBPE REG. F-15243



STINSON ROAD IMPROVEMENTS  
CITY OF LUCAS  
PUBLIC WORKS DEPARTMENT  
665 COUNTRY CLUB ROAD  
LUCAS, TX. 75002

GENERAL NOTES

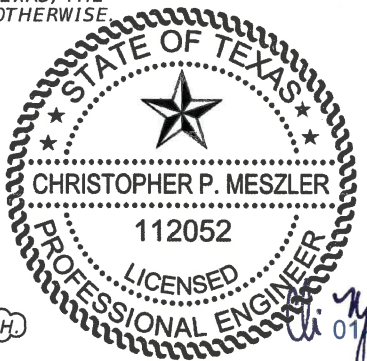

|           |
|-----------|
| SHEET NO. |
| 10        |

CALL BEFORE YOU DIG  
TEXAS ONE CALL SYSTEM REQUEST  
48 HOURS OR BLAST - STOP CALL  
TEXAS ONE CALL SYSTEM  
1-800-DIG-TESS



PLOTTED BY: JBoggess  
PLOT DATE: 1/31/2019  
LAST SAVED: 10:22:08 AM  
LOCATION: X:\18-112 Stinson Road\18112 Stinson Plan Set\roadway\SUMORD01 (REV 2).DGN

| ITEM-CODE |            |       | DESCRIPTION                                   | UNIT | TOTAL |       |
|-----------|------------|-------|-----------------------------------------------|------|-------|-------|
| ITEM NO.  | DESC. CODE | SP NO |                                               |      | EST.  | FINAL |
| 100       | 6001       |       | PREPARING ROW                                 | AC   | 7     |       |
| 105       | 6011       |       | REMOVING STAB BASE AND ASPH PAV (2"-6")       | SY   | 12634 |       |
| 110       | 6001       |       | EXCAVATION (ROADWAY)                          | CY   | 5472  |       |
| 132       | 6001       |       | EMBANKMENT (FINAL)(ORDINARY COMPACTION)(TY A) | CY   | 2196  |       |
| 134       | 6003       |       | BACKFILLING (TYPE C)                          | STA  | 89    |       |
| 160       | 6003       |       | FURNISHING AND PLACING TOPSOIL (4")           | SY   | 21893 |       |
| 162       | 6002       |       | BLOCK SODDING                                 | SY   | 4333  |       |
| 162       | 6004       |       | MULCH SODDING                                 | SY   | 15891 |       |
| 166       | 6001       |       | FERTILIZER                                    | AC   | 4.523 |       |
| 247       | 6449       |       | FL BS (CIP)(TY D GR-1-2,3 OR 5)(FNL POS)      | CY   | 30    |       |
| 260       | 6079       |       | LIME TREATED (SUBGRADE)(6")                   | SY   | 16763 |       |
| 340       | 6011       |       | D-GR HMA(SQ) TY-B PG64-22                     | TN   | 23    |       |
| 344       | 6066       |       | SUPERPAVE MIXTURES SP-C PG76-22 (OVERBUILD)   | TN   | 45    |       |
| 344       | 6138       |       | SUPERPAVE MIXTURES SP-D PG76-22               | TN   | 78    |       |
| 354       | 6189       |       | PLANE ASHP CONC PAV (1.25")                   | SY   | 1361  |       |
| 360       | 6000       |       | CONC PVT (CONT REINF - CRCP) (6")             | SY   | 14550 |       |
| 431       | 6001       |       | PNEUMATICALLY PLACED CONCRETE                 | CF   | 3813  |       |
| 432       | 6058       |       | BEDDING MATERIAL (VARIABLE)                   | CY   | 86    |       |
| 462       | 6003       |       | CONC BOX CULVERT (4X2)                        | LF   | 237   |       |
| 462       | 6007       |       | CONC BOX CULVERT (5X3)                        | LF   | 142   |       |
| 462       | 6010       |       | CONC BOX CULVERT (6X3)                        | LF   | 60    |       |
| 464       | 6003       |       | RC PIPE (CL III)(18 IN)                       | LF   | 214   |       |
| 464       | 6005       |       | RC PIPE (CL III)(24 IN)                       | LF   | 161   |       |
| 464       | 6032       |       | RC PIPE (ARCH)(CLASS III)(DES 3)              | LF   | 34    |       |
| 464       | 6033       |       | RC PIPE (ARCH)(CLASS III)(DES 4)              | LF   | 381   |       |
| 466       | 6063       |       | HEADWALL (CH-FW-A-0)(DES=4)                   | EA   | 2     |       |
| 467       | 6159       |       | SET (TY I) (S=4FT)(HW=7FT)(6: 1)(P)           | EA   | 2     |       |
| 467       | 6192       |       | SET (TY I) (S=5FT)(HW=7FT)(6: 1)(P)           | EA   | 2     |       |
| 467       | 6229       |       | SET (TY I) (S=6FT)(HW=7FT)(6: 1)(P)           | EA   | 2     |       |
| 467       | 6363       |       | SET (TY II) (18 IN) (RCP) (6: 1) (P)          | EA   | 14    |       |
| 467       | 6395       |       | SET (TY II) (24 IN) (RCP) (6: 1) (P)          | EA   | 4     |       |
| 467       | 6545       |       | SET (TY II) (DES 3) (RCP) (6: 1) (P)          | EA   | 2     |       |
| 467       | 6555       |       | SET (TY II) (DES 4) (RCP) (6: 1) (P)          | EA   | 6     |       |
| 506       | 6001       |       | ROCK FILTER DAMS (INSTALL) (TY I)             | LF   | 273   |       |
| 506       | 6011       |       | ROCK FILTER DAMS (REMOVE)                     | LF   | 273   |       |
| 506       | 6022       |       | CONSTRUCTION EXITS (INSTALL) (TY 3)           | SY   | 356   |       |
| 506       | 6024       |       | CONSTRUCTION EXITS (REMOVE)                   | SY   | 356   |       |
| 506       | 6038       |       | TEMP SEDMT CONT FENCE (INSTALL)               | LF   | 9508  |       |
| 506       | 6039       |       | TEMP SEDMT CONT FENCE (REMOVE)                | LF   | 9508  |       |
| 529       | 6004       |       | CONC CURB (MONO) (TY I)                       | LF   | 317   |       |
| 529       | 6005       |       | CONC CURB (MONO) (TY II)                      | LF   | 56    |       |
| 530       | 6004       |       | DRIVEWAYS (CONC)                              | SY   | 873   |       |
| 530       | 6017       |       | DRIVEWAYS (CONC)(HES)(6")(4000 PSI)           | CY   | 100   |       |
| 536       | 6004       |       | CONCRETE DIRECTIONAL ISLAND                   | SY   | 200   |       |
| 550       | 6001       |       | CHAIN LINK FENCE (INSTALL) (6')               | LF   | 93    |       |
| 550       | 6003       |       | CHAIN LINK FENCE (REMOVE)                     | LF   | 71    |       |
| 550       | 6006       |       | GATE REMOVE                                   | EA   | 1     |       |
| 552       | 6005       |       | GATE (TYPE I)                                 | EA   | 1     |       |
| 560       | 6011       |       | MAILBOX INSTALL-S (TWW-POST) TY 4             | EA   | 3     |       |
| 1001      | 6006       |       | LANDSCAPING ARCHITECTURAL FEATURES            |      |       |       |
|           |            |       | RELOCATION/REPLACEMENT                        | LS   | 1     |       |
| 1004      | 6001       |       | TREE PROTECTION                               | LS   | 1     |       |

| ITEM-CODE       |            |       | DESCRIPTION                            | UNIT | TOTAL |       |
|-----------------|------------|-------|----------------------------------------|------|-------|-------|
| ITEM NO.        | DESC. CODE | SP NO |                                        |      | EST.  | FINAL |
| TRAFFIC CONTROL |            |       |                                        |      |       |       |
| 500             | 6001       |       | MOBILIZATION                           | LS   | 1     |       |
| 502             | 6001       |       | BARRICADES, SIGNS AND TRAFFIC HANDLING | LS   | 1     |       |
| 510             | 6001       |       | ONE-WAY TRAF CONT (FLAGGER CONT)       | LS   | 1     |       |
| 512             | 6001       |       | PORT CTB (FUR & INST)(SGL SLOPE)(TY 1) | LS   | 1     |       |
| 512             | 6025       |       | PORT CTB (MOVE)(SGL SLP)(TY 1)         | LS   | 1     |       |
| 512             | 6049       |       | PORT CTB (REMOVE)(SGL SLP)(TY 1)       | LS   | 1     |       |
| 560             | 6011       |       | MAILBOX INSTALL-S (TWW-POST) TY 4      | LS   | 1     |       |
| 662             | 6063       |       | WK ZN PAV MRK REMOV (W)4"(SLD)         | LS   | 1     |       |
| 662             | 6095       |       | WK ZN PAV MRK REMOV (Y)4"(SLD)         | LS   | 1     |       |
| 6001            | 6001       |       | PORTABLE CHANGEABLE MESSAGE SIGN       | LS   | 1     |       |

| ITEM-CODE                   |            |       | DESCRIPTION                                  | UNIT | TOTAL |       |
|-----------------------------|------------|-------|----------------------------------------------|------|-------|-------|
| ITEM NO.                    | DESC. CODE | SP NO |                                              |      | EST.  | FINAL |
| SIGNING & PAVEMENT MARKINGS |            |       |                                              |      |       |       |
| 644                         | 6060       |       | IN SM RD SN SUP & AM TY TWT(1)WS(P)          | EA   | 28    |       |
| 644                         | 6076       |       | REMOVE SM RD SN SUP & AM                     | EA   | 10    |       |
| 666                         | 6002       |       | REFL PAV MRK TY I (W) 4" (BRK)(090 MIL)      | LF   | 74    |       |
| 666                         | 6011       |       | REFL PAV MRK TY I (W) 4" (SLD)(090 MIL)      | LF   | 9429  |       |
| 666                         | 6020       |       | REFL PAV MRK TY I (W) 6" (SLD)(090 MIL)      | LF   | 147   |       |
| 666                         | 6053       |       | REFL PAV MRK TY I (W) (ARROW)(090 MIL)       | EA   | 3     |       |
| 666                         | 6101       |       | REFL PAV MRK TY I (W) 36" (YLD TRI)(090 MIL) | EA   | 12    |       |
| 666                         | 6119       |       | REFL PAV MRK TY I (Y) 4" (BRK)(090 MIL)      | LF   | 2333  |       |
| 666                         | 6125       |       | REFL PAV MRK TY I (Y) 4" (SLD)(090 MIL)      | LF   | 4260  |       |
| 666                         | 6224       |       | PAVEMENT SEALER 4"                           | LF   | 16096 |       |
| 666                         | 6225       |       | PAVEMENT SEALER 6"                           | LF   | 147   |       |
| 666                         | 6231       |       | PAVEMENT SEALER (ARROW)                      | EA   | 3     |       |
| 666                         | 6243       |       | PAVEMENT SEALER (YLD TRI)                    | EA   | 12    |       |
| 672                         | 6009       |       | REFL PAV MRKR TY II-A-A                      | EA   | 3570  |       |
| 672                         | 6010       |       | REFL PAV MRKR TY II-C-R                      | EA   | 7     |       |
| 678                         | 6001       |       | PAV SURF PREP FOR MRK (4")                   | LF   | 16096 |       |
| 678                         | 6002       |       | PAV SURF PREP FOR MRK (6")                   | LF   | 147   |       |
| 678                         | 6009       |       | PAV SURF PREP FOR MRK (ARROW)                | EA   | 3     |       |
| 678                         | 6023       |       | PAV SURF PREP FOR MRK (36") (YLD TRI)        | EA   | 12    |       |
| 678                         | 6033       |       | PAV SURF PREP FOR MRK (RPM)                  | EA   | 3574  |       |

| ITEM-CODE |            |       | DESCRIPTION                            | UNIT | TOTAL |       |
|-----------|------------|-------|----------------------------------------|------|-------|-------|
| ITEM NO.  | DESC. CODE | SP NO |                                        |      | EST.  | FINAL |
| UTILITIES |            |       |                                        |      |       |       |
| 6000      | 6153       |       | REPLACE ACCESS HOLE COVER              | EA   | 1     |       |
| 6295      | 6001       |       | DECORATIVE LIGHTING ASSEMBLY           | EA   | 1     |       |
| 7049      | 6004       |       | WATER MAIN PIPE (PVC) (6IN)            | LF   | 45    |       |
| 7049      | 6087       |       | TAPPING SLEEVE AND VALVE (12IN X 6IN)  | EA   | 2     |       |
| 7049      | 6122       |       | ADJUSTING METER BOX                    | EA   | 3     |       |
| 7049      | 6161       |       | REMOVE AND RELOCATE FIRE HYDRANT       | EA   | 2     |       |
| 7126      | 6007       |       | ADJUST AND/OR RELOCATE WATER METER BOX | EA   | 1     |       |
| 7128      | 6005       |       | MULTI 3" CONDUITS AND CONDUCTORS (BORE | LF   | 48    |       |
| 7152      | 6021       |       | CONNECT TO EXISITNG WATER LINE         | EA   | 2     |       |
| 7155      | 6051       |       | ADJ EXST SAN SWR MNHL FNL GRADE        | EA   | 1     |       |
| 7156      | 6006       |       | ADJUST EXISTING FIRE HYDANT            | EA   | 3     |       |
| 7164      | 6013       |       | WTR GATE VALVE (6")                    | EA   | 2     |       |
| 7164      | 6019       |       | ADJ EXT WTR VALVE BOX                  | EA   | 2     |       |
| 7167      | 6009       |       | CUT AND PLUG EXIST WATER LINE (2"-12") | EA   | 2     |       |
| 7169      | 6006       |       | 6" GATE VALVE AND BOX                  | EA   | 3     |       |
| 7173      | 6022       |       | ADJUST VALVE BOX TO GRADE              | EA   | 14    |       |
| 7177      | 6003       |       | RELOC EXIST METER & METER BOX          | EA   | 2     |       |
| 7180      | 6010       |       | CAP PIPE (6IN)                         | EA   | 2     |       |
| 7181      | 6024       |       | RELOCATE FIRE HYDRANT                  | EA   | 2     |       |

PAY ITEM NOTES:

- COST FOR ALL TESTING AND SAMPLING REQUIRED PER THE STANDARD SPECIFICATION AND GENERAL NOTES IS TO BE INCLUDED IN THE RELATED PAY ITEMS.
- 431 6001 INCLUDES ALL MATERIAL AND LABOR REQUIRED FOR CONSTRUCTION OF ISOLATION JOINT CONNECTIONS BETWEEN CONCRETE DITCH LINING AND CONCRETE HEADWALLS.
- 506 6022 QUANTITY IS NOT A PLAN QUANTITY AND MAY BE INCREASED OR DECREASED BASED ON CONTRACTOR'S PHASING AND WORK ZONE. NO ADDITIONAL PAYMENT PROVIDED.
- 506 6024 INCLUDES REQUIRED INSPECTIONS WEEKLY AND AFTER RAIN EVENTS. NO EXTRA PAYMENT FOR REPAIRS TO EXISTING INSTALLATIONS.
- 506 6038
- 550 6008 CONTRACTOR SHALL MATCH EXISTING FENCE TYPE, MATERIAL, CONSTRUCTION, AND HEIGHT WHERE REPLACING FENCING. NO ADDITIONAL PAYMENT FOR VARYING FENCE TYPES.
- 560 6011 EXISTING MAILBOXES TO BE RELOCATED SHALL BE PRESERVED AND INSTALLED OR REPLACED IN EQUAL OR BETTER CONDITION MATCHING MATERIAL TYPE, SIZE, AND COLOR. NO ADDITIONAL PAYMENT PROVIDED FOR VARYING MAILBOX TYPES.
- 672 6009 INCLUDES BLUE RPM'S AS SHOWN IN PLANS.
- 1004 6001 PROVIDE TREE PROTECTION ON ALL TREES TO REMAIN WITHIN 5 FT OF PROPOSED WORK OR WORK ZONE. LUMP SUM ITEM INCLUDES ALL TREES AS DESCRIBED AND DIRECTED BY THE ENGINEER.


2 6001 6001 INCLUDES ALL PCMS FOR THE DURATION OF THE PROJECT

| REVISIONS                           |                            | DATE | DESCRIPTION | LAKES ENGINEERING, INC. | CHRISTOPHER P. MESZLER, P.E.<br>LIC. No. 112052<br>1903 CENTRAL DRIVE, SUITE #405<br>BEDFORD, TX 76021<br>PHONE: 817.618.3640<br>TBPE REG. F-15243 | SHEET NO. |
|-------------------------------------|----------------------------|------|-------------|-------------------------|----------------------------------------------------------------------------------------------------------------------------------------------------|-----------|
| DATE                                | DESCRIPTION                |      |             |                         |                                                                                                                                                    |           |
| 01/18/19                            | 1 BID ITEMS UPDATED        |      |             |                         |                                                                                                                                                    |           |
| 01/29/19                            | 2 ADDED PAY ITEMS AND NOTE |      |             |                         |                                                                                                                                                    |           |
| ESTIMATES AND SUMMARY OF QUANTITIES |                            |      |             |                         |                                                                                                                                                    | 11        |


CALL BEFORE YOU DIG  
TEXAS ONE CALL SYSTEM  
REQUEST  
48 HOURS OR BLAST - STOP CALL  
1-800-DIG-TESS



ibogress  
6/20/2019  
9:39:35 AM  
LAST SAVED:  
LOCATION:  
T:\18-112 Stinson Road\Plan Set\roadway\PLANRD01.DGN

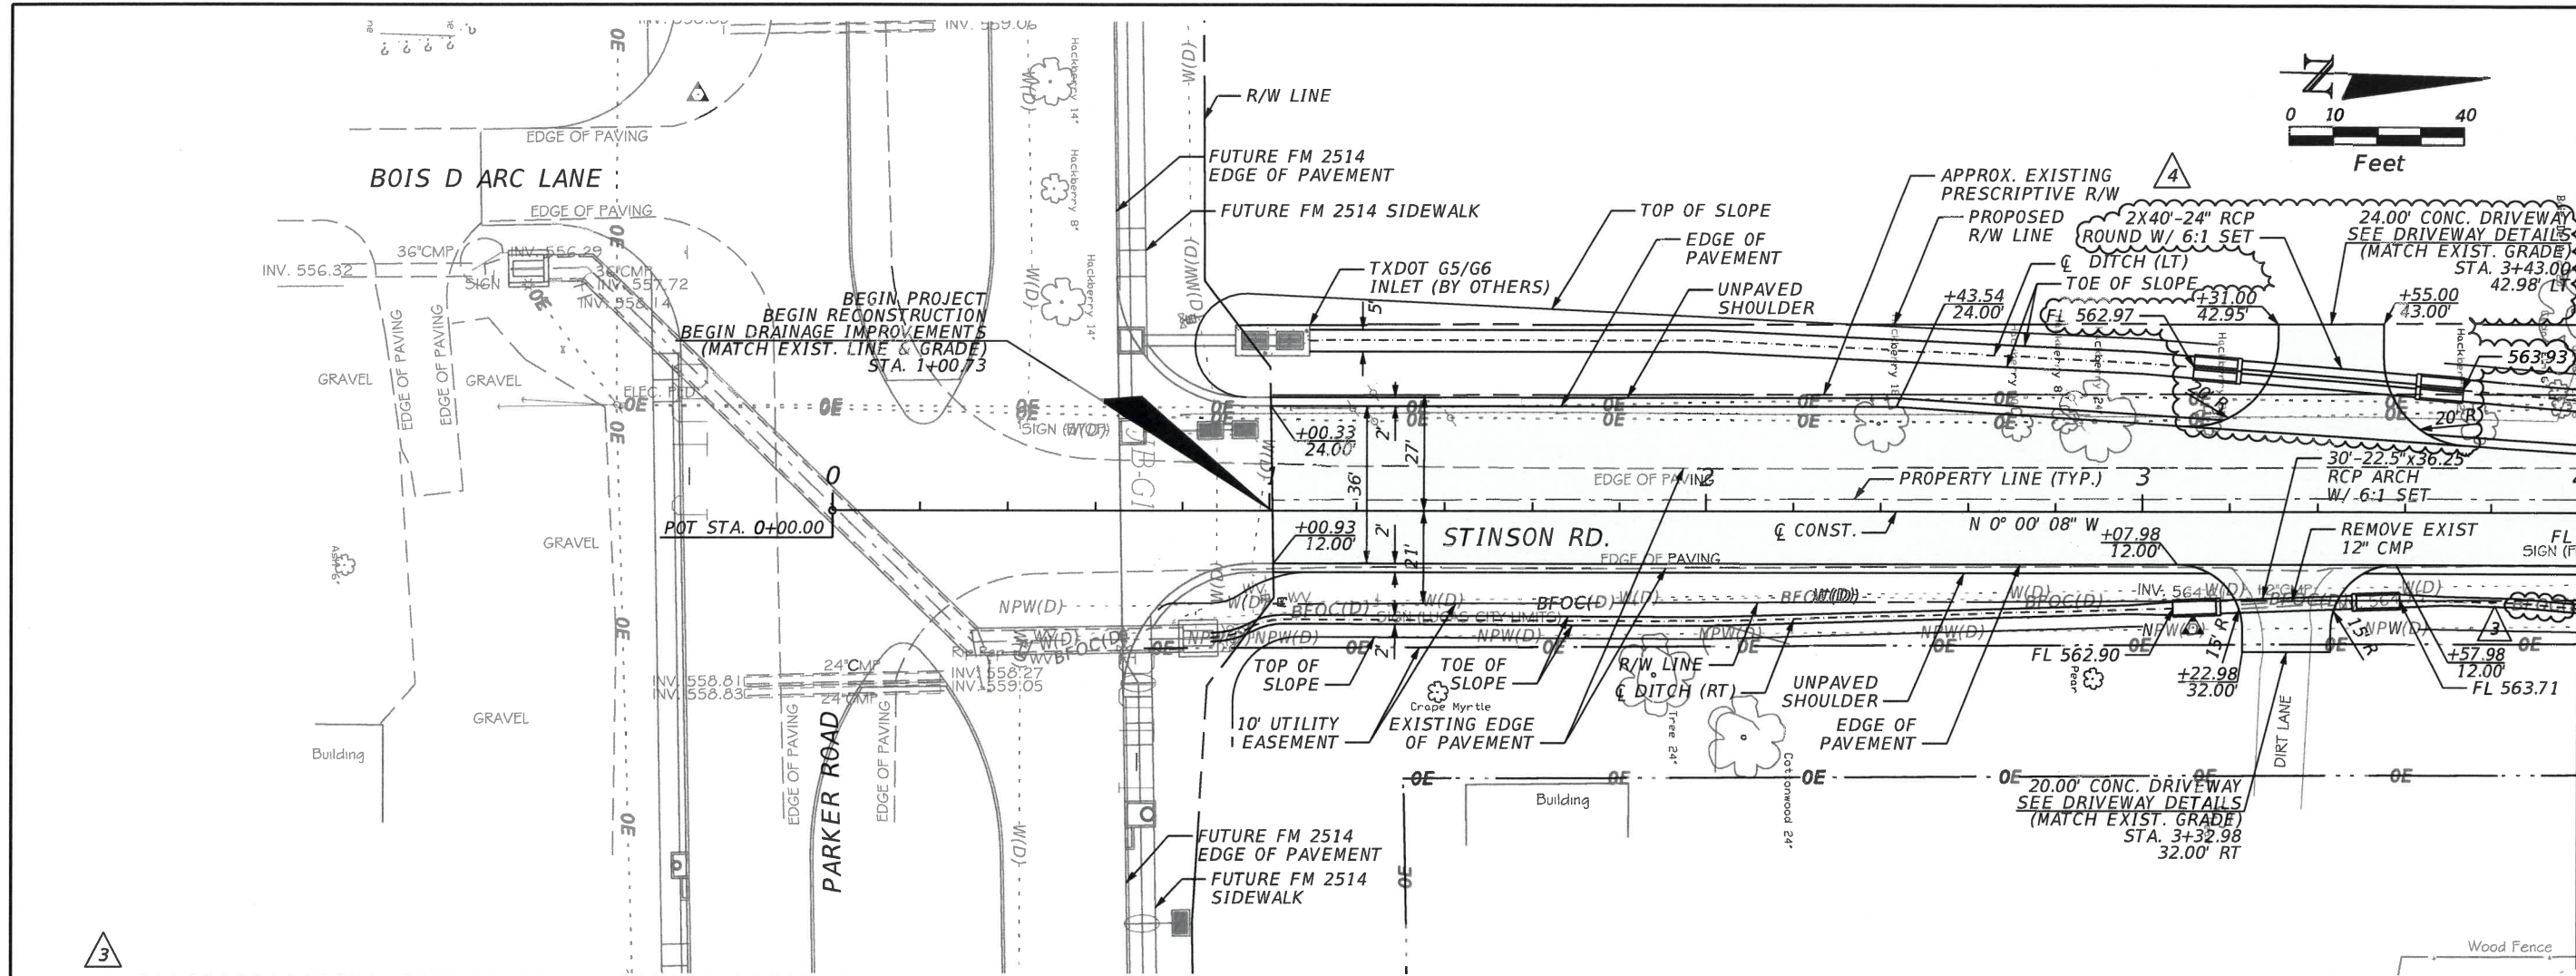

06-20-2019

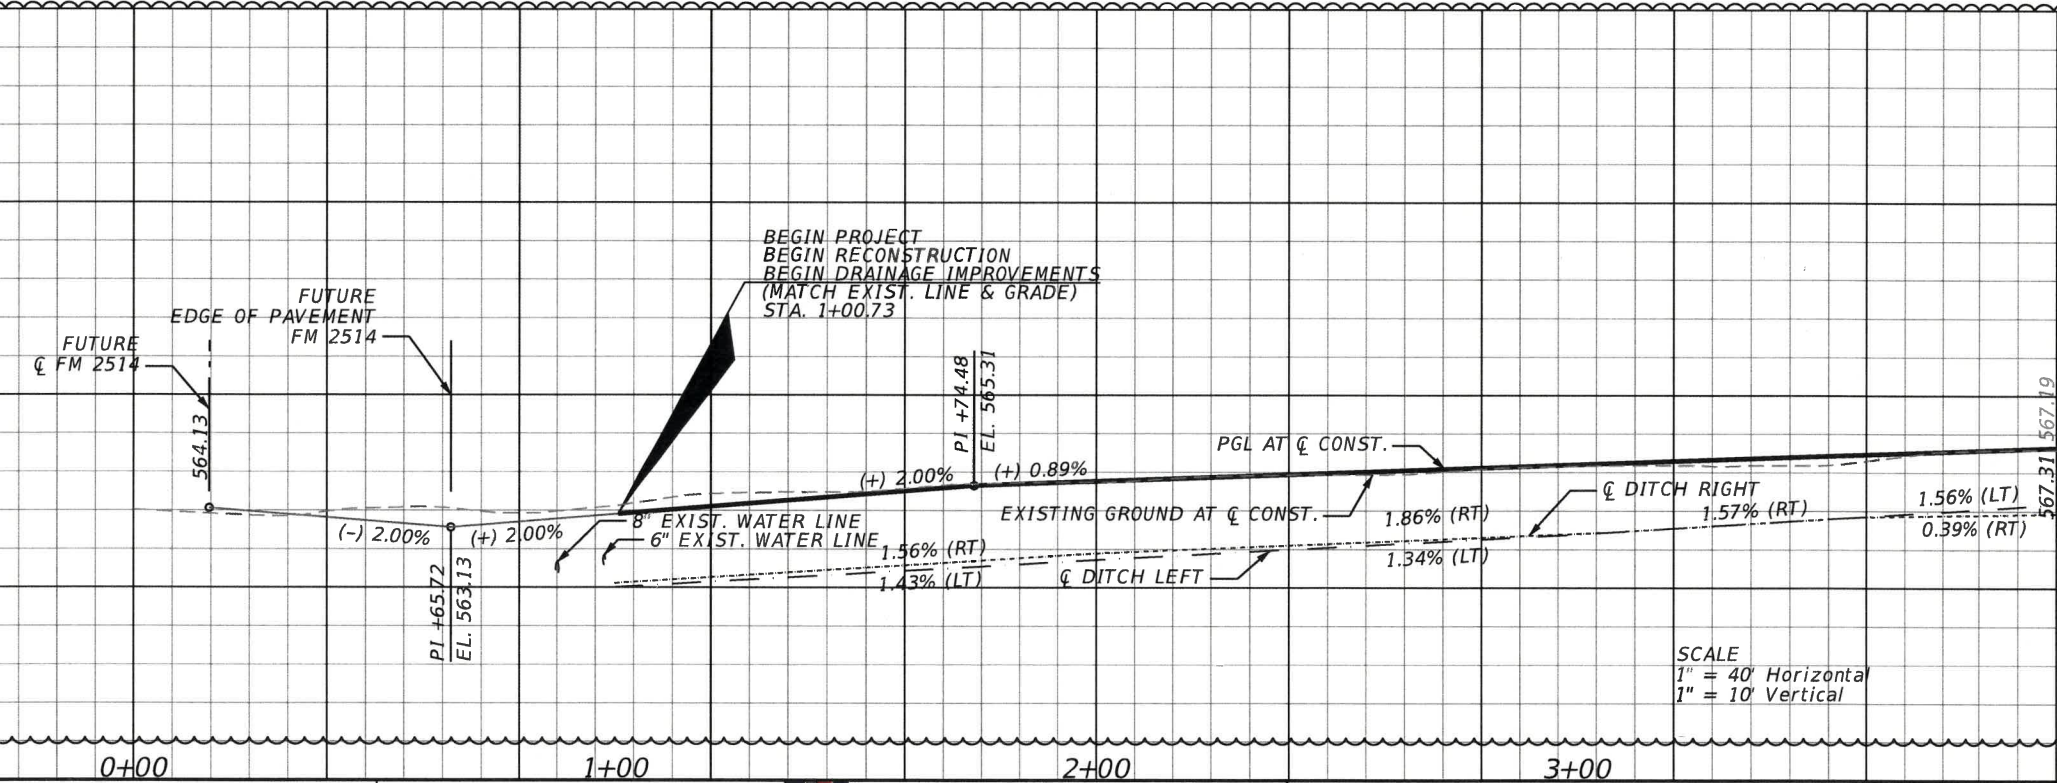

| REVISIONS |                              |
|-----------|------------------------------|
| DATE      | DESCRIPTION                  |
| 5/17/2019 | 3 REVISED DITCH LIMITS       |
| 6/04/2019 | 4 ADDED DRIVEWAY & RCP W/SET |

**LAKES**  
ENGINEERING, INC.

CHRISTOPHER P. MESZLER, P.E.  
LIC. No. 112052  
1903 CENTRAL DRIVE, SUITE #405  
BEDFORD, TX 76021  
PHONE: 817.618.3640  
TBPE REG. F-15243



STINSON ROAD IMPROVEMENTS  
CITY OF LUCAS  
PUBLIC WORKS DEPARTMENT  
665 COUNTRY CLUB ROAD  
LUCAS, TX. 75002


PLAN & PROFILE

SHEET  
NO.  
12

CALL BEFORE YOU DIG  
TEXAS ONE CALL SYSTEM  
1-800-DIG-1-ESS  
OR BLAST - STOP CALL



plotted by: jhoggess  
plot date: 6/20/2019  
last saved: 9:39:36 AM  
location: T:\18-112 Stinson Road\18112 Stinson Plan Set\roadway\PLANRD02.DGN

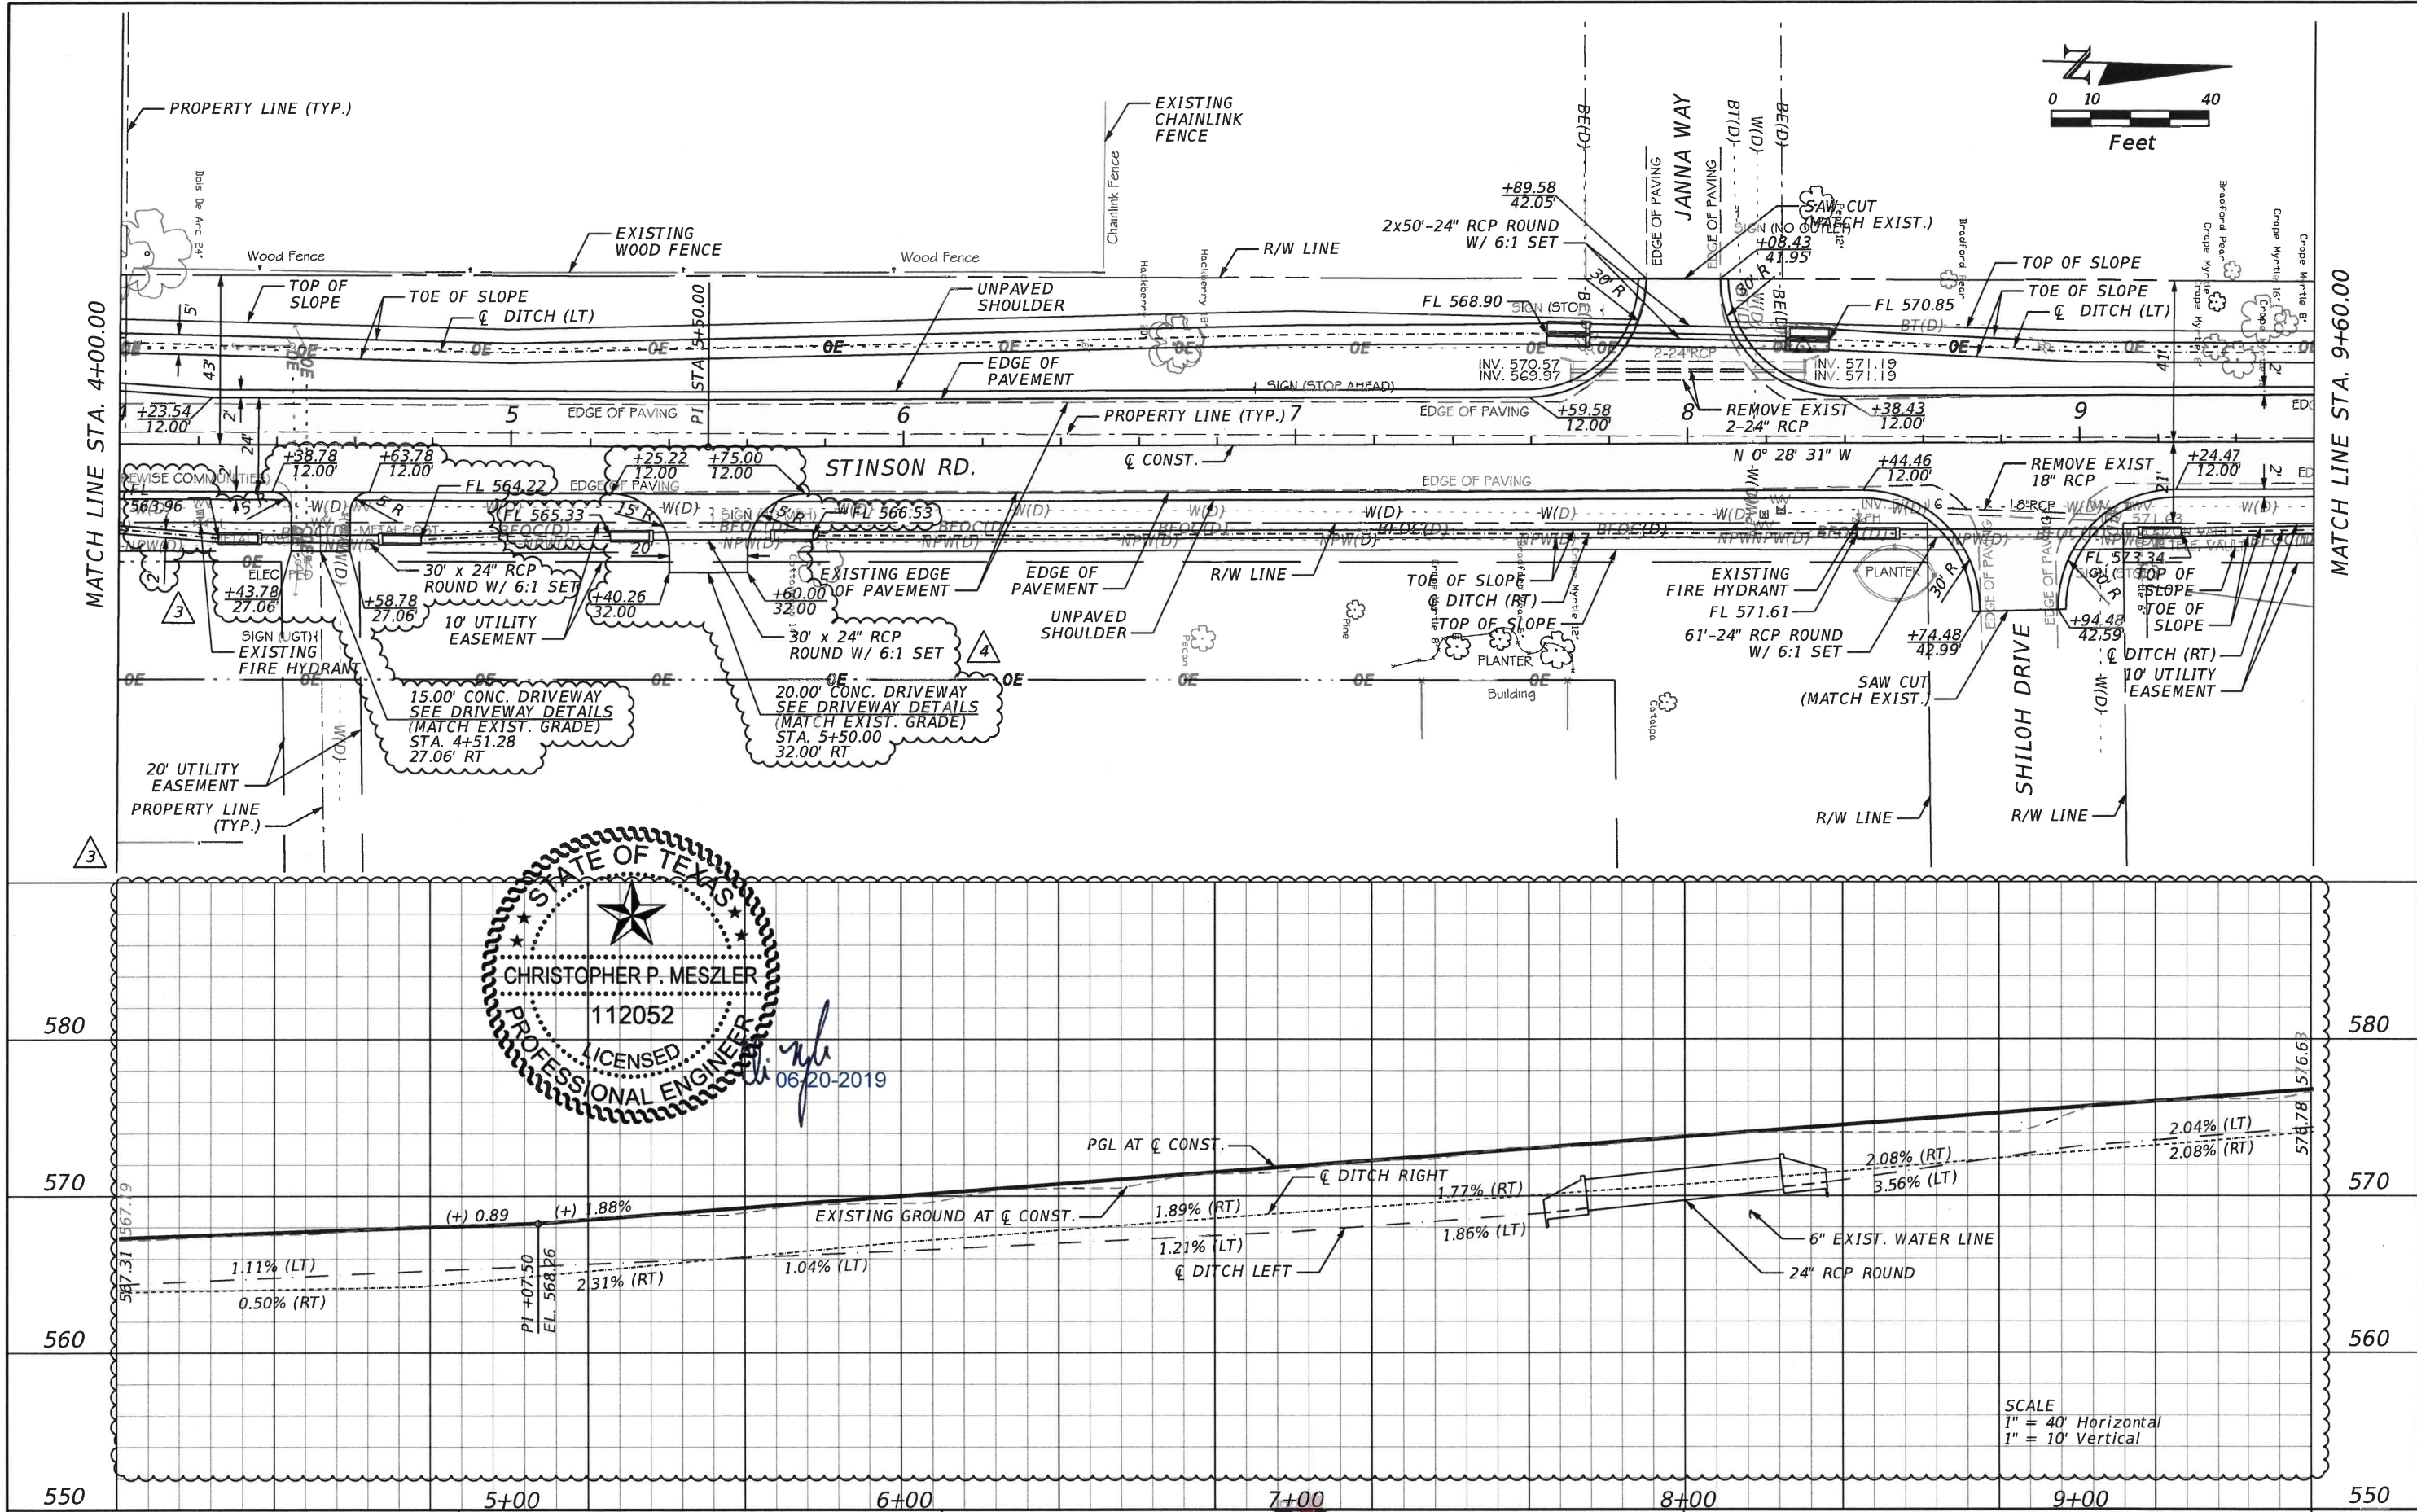

| REVISIONS |                                                             |
|-----------|-------------------------------------------------------------|
| DATE      | DESCRIPTION                                                 |
| 5/17/2019 | 3 DRIVEWAY ADDED, REVISED DITCH LIMITS & RCP W/ SET'S ADDED |
| 6/04/2019 | 4 ADDED DRIVEWAY & RCP W/SET                                |

**LAKES**  
ENGINEERING, INC.

CHRISTOPHER P. MESZLER, P.E.  
LIC. No. 112052  
1903 CENTRAL DRIVE, SUITE #405  
BEDFORD, TX 76021  
PHONE: 817.618.3640  
TBPE REG. F-15243



STINSON ROAD IMPROVEMENTS  
CITY OF LUCAS  
PUBLIC WORKS DEPARTMENT  
665 COUNTRY CLUB ROAD  
LUCAS, TX. 75002




PLAN & PROFILE

SHEET  
NO.  
13

CALL BEFORE YOU DIG  
TEXAS ONE CALL SYSTEM  
1-800-DIG-1-ESS  
OR BLAST - STOP CALL



ibogness  
5/31/2019  
2:42:32 PM  
T:\18-112 Stinson Road\18112 Stinson Plan Set\roadway\PLANRD03 (Rev 3).DGN

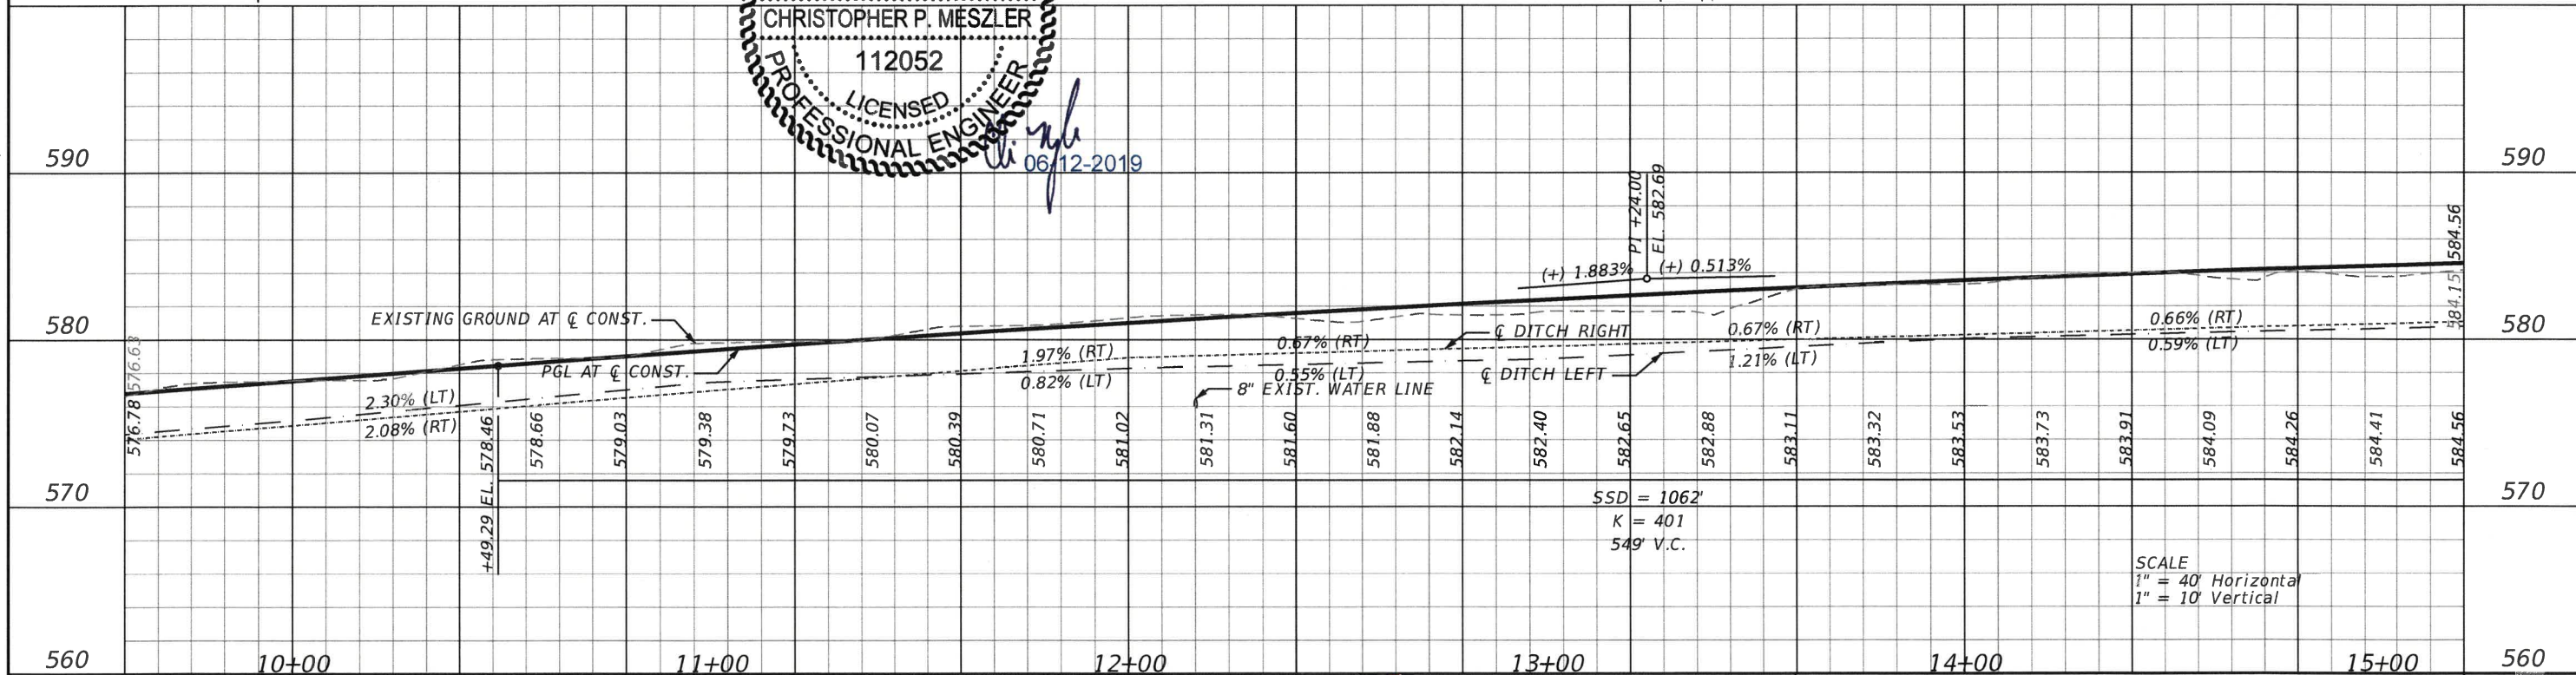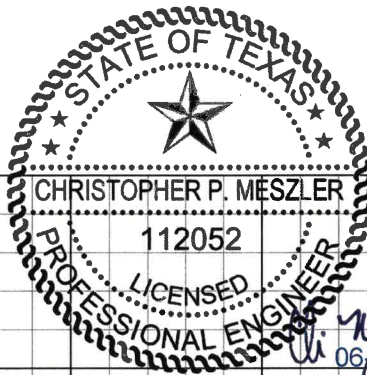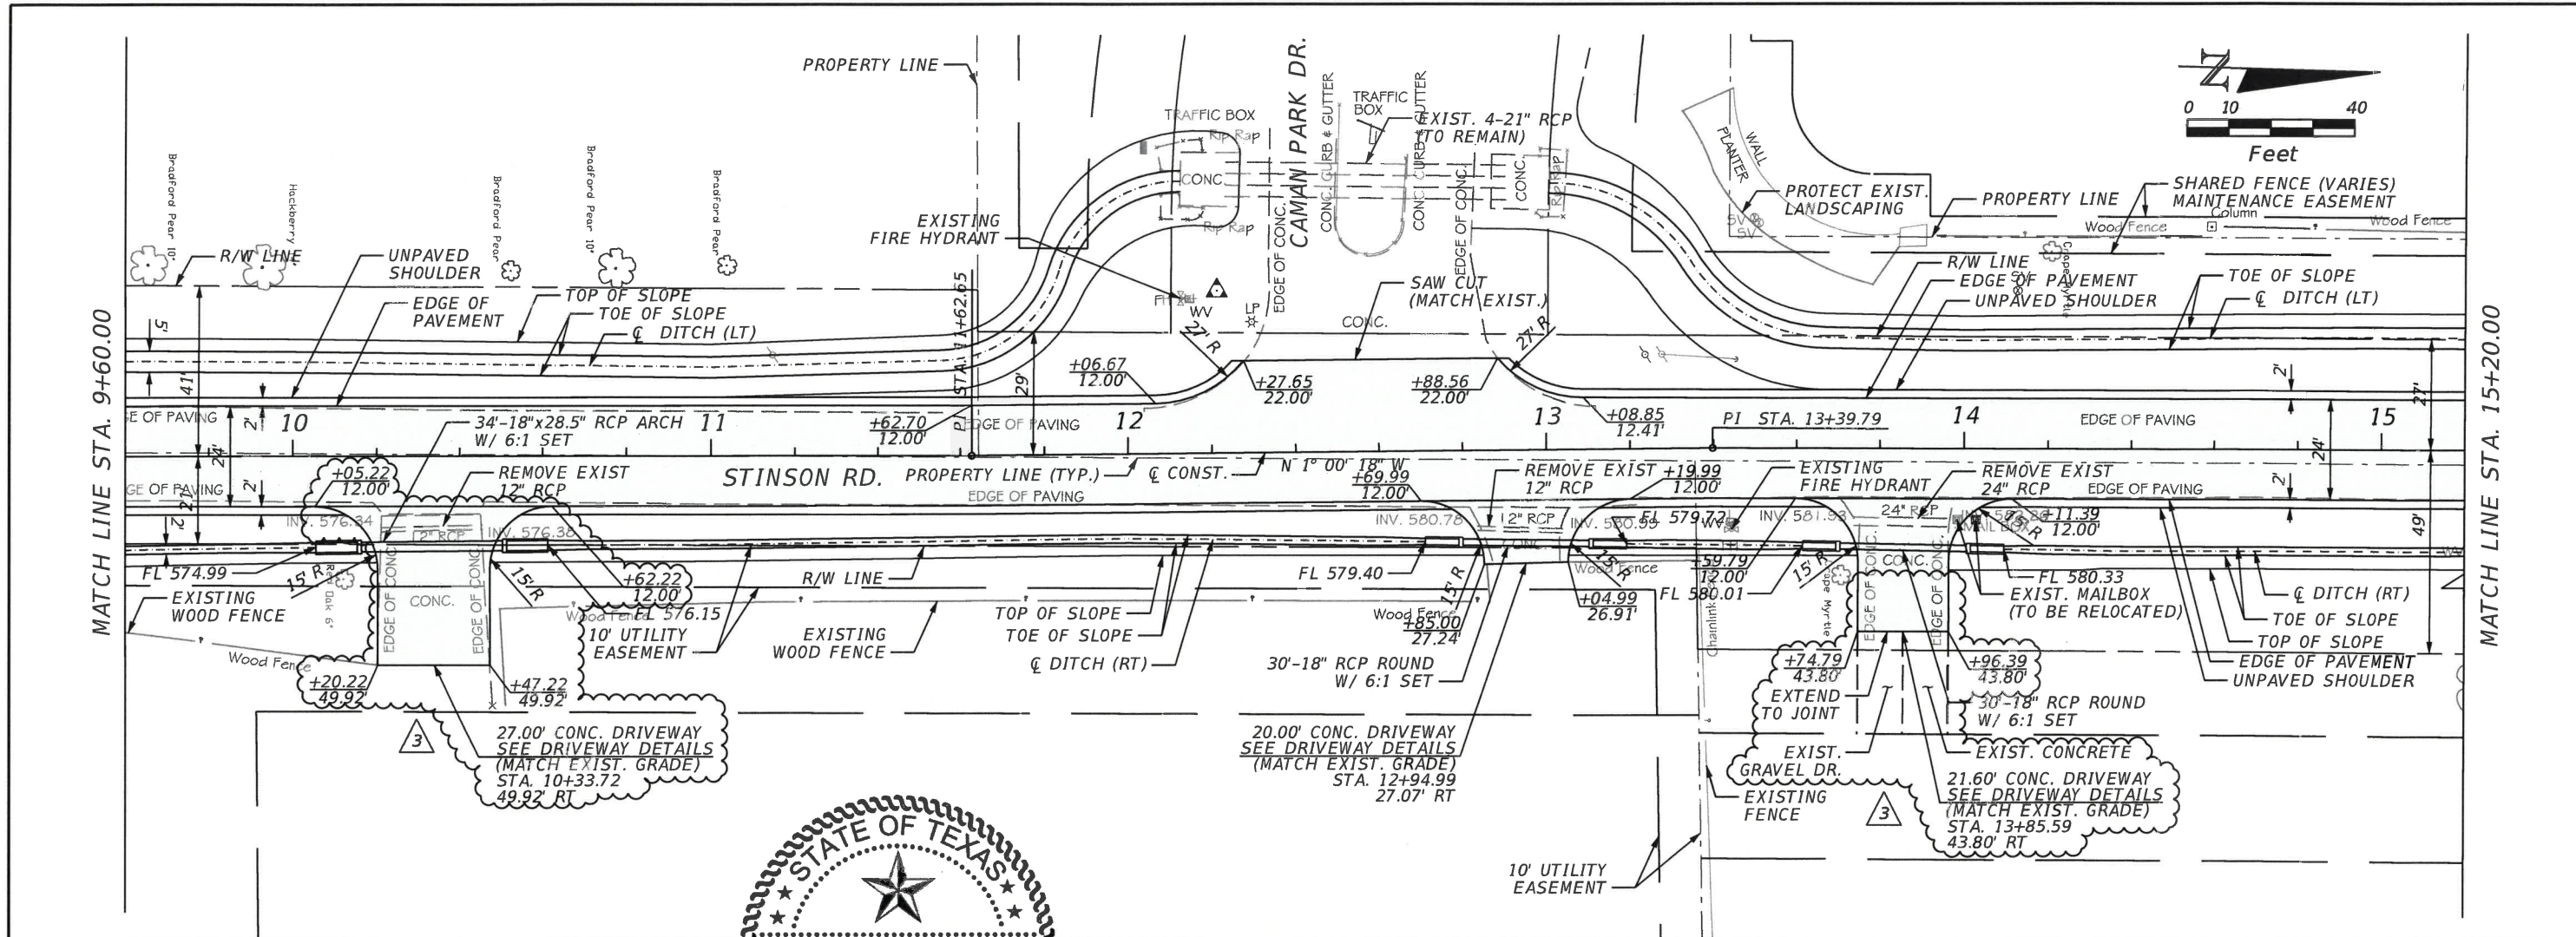

| REVISIONS |                            |
|-----------|----------------------------|
| DATE      | DESCRIPTION                |
| 5/17/2019 | 3 EXTEND DRIVEWAY TO JOINT |

**LAKES**  
ENGINEERING, INC.

CHRISTOPHER P. MESZLER, P.E.  
LIC. No. 112052  
1903 CENTRAL DRIVE, SUITE #405  
BEDFORD, TX 76021  
PHONE: 817.618.3640  
TBPE REG. F-15243



STINSON ROAD IMPROVEMENTS  
CITY OF LUCAS  
PUBLIC WORKS DEPARTMENT  
665 COUNTRY CLUB ROAD  
LUCAS, TX. 75002

PLAN & PROFILE

SHEET  
NO.  
14



CALL BEFORE YOU DIG  
TEXAS ONE CALL SYSTEM  
1-800-DIG-1-ESS  
OR BLAST - STOP CALL







ibogess  
5/31/2019  
2:42:35 PM  
T:\18-112 Stinson Road\18112 Stinson Plan Set\roadway\PLANRD06 (Rev 3).DGN

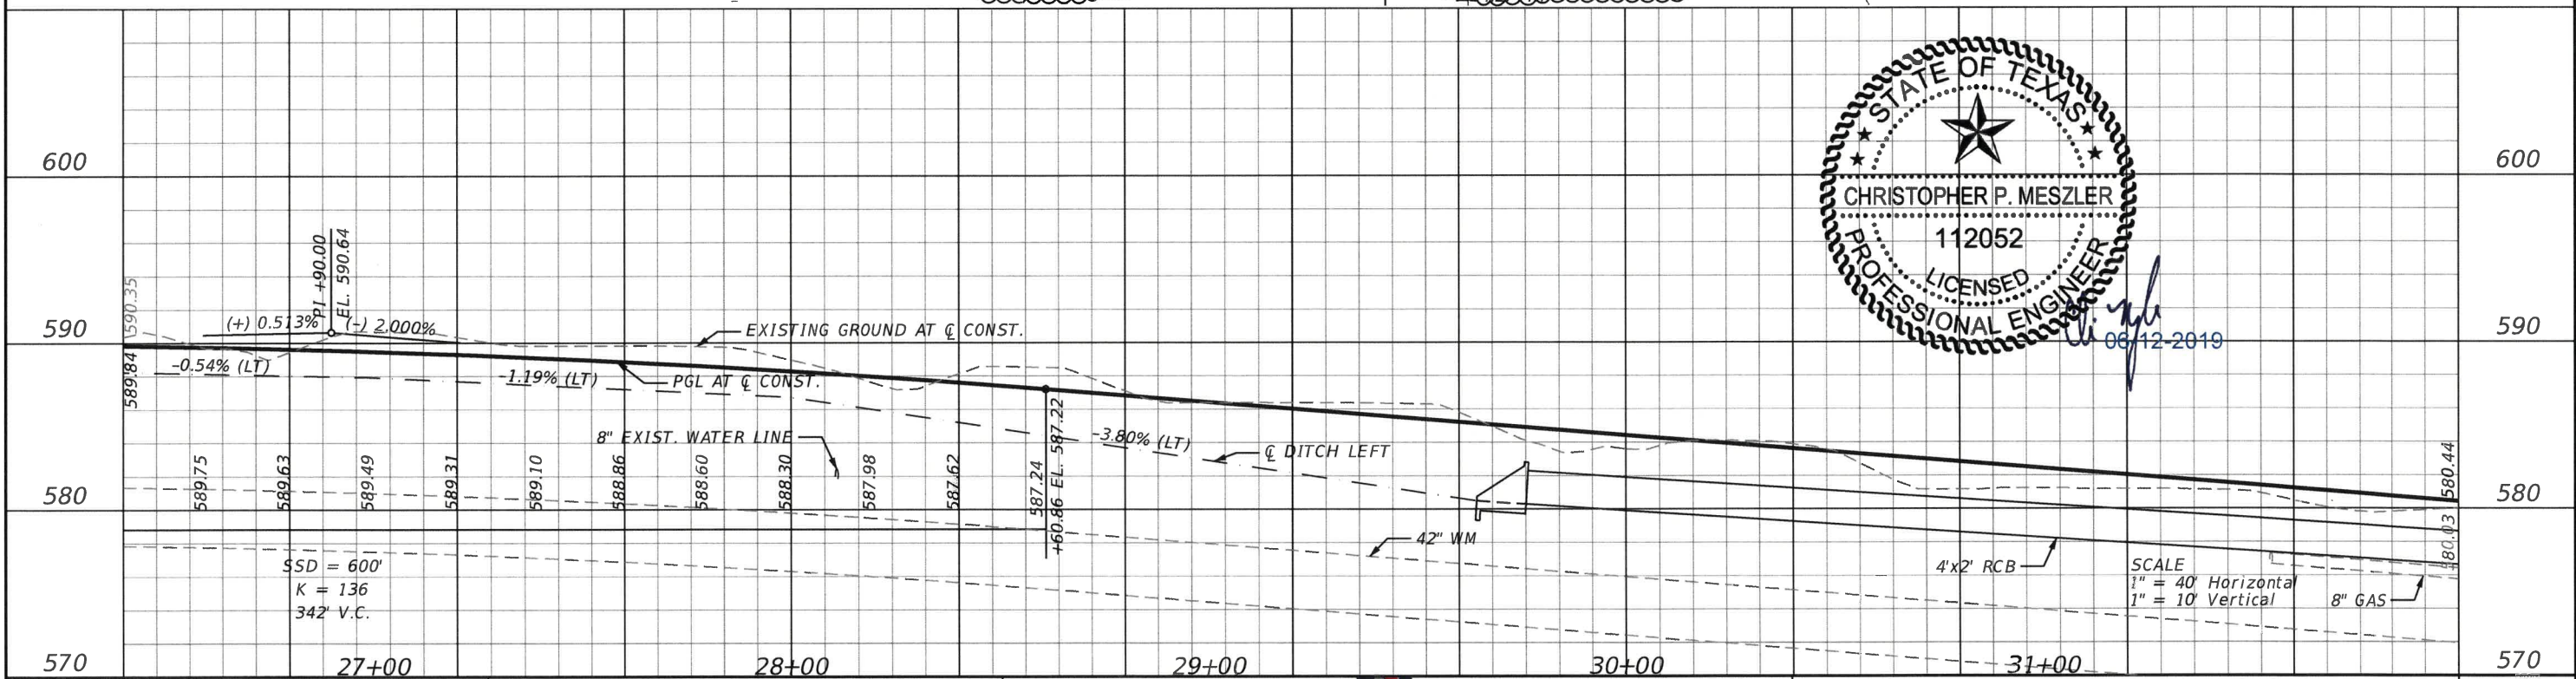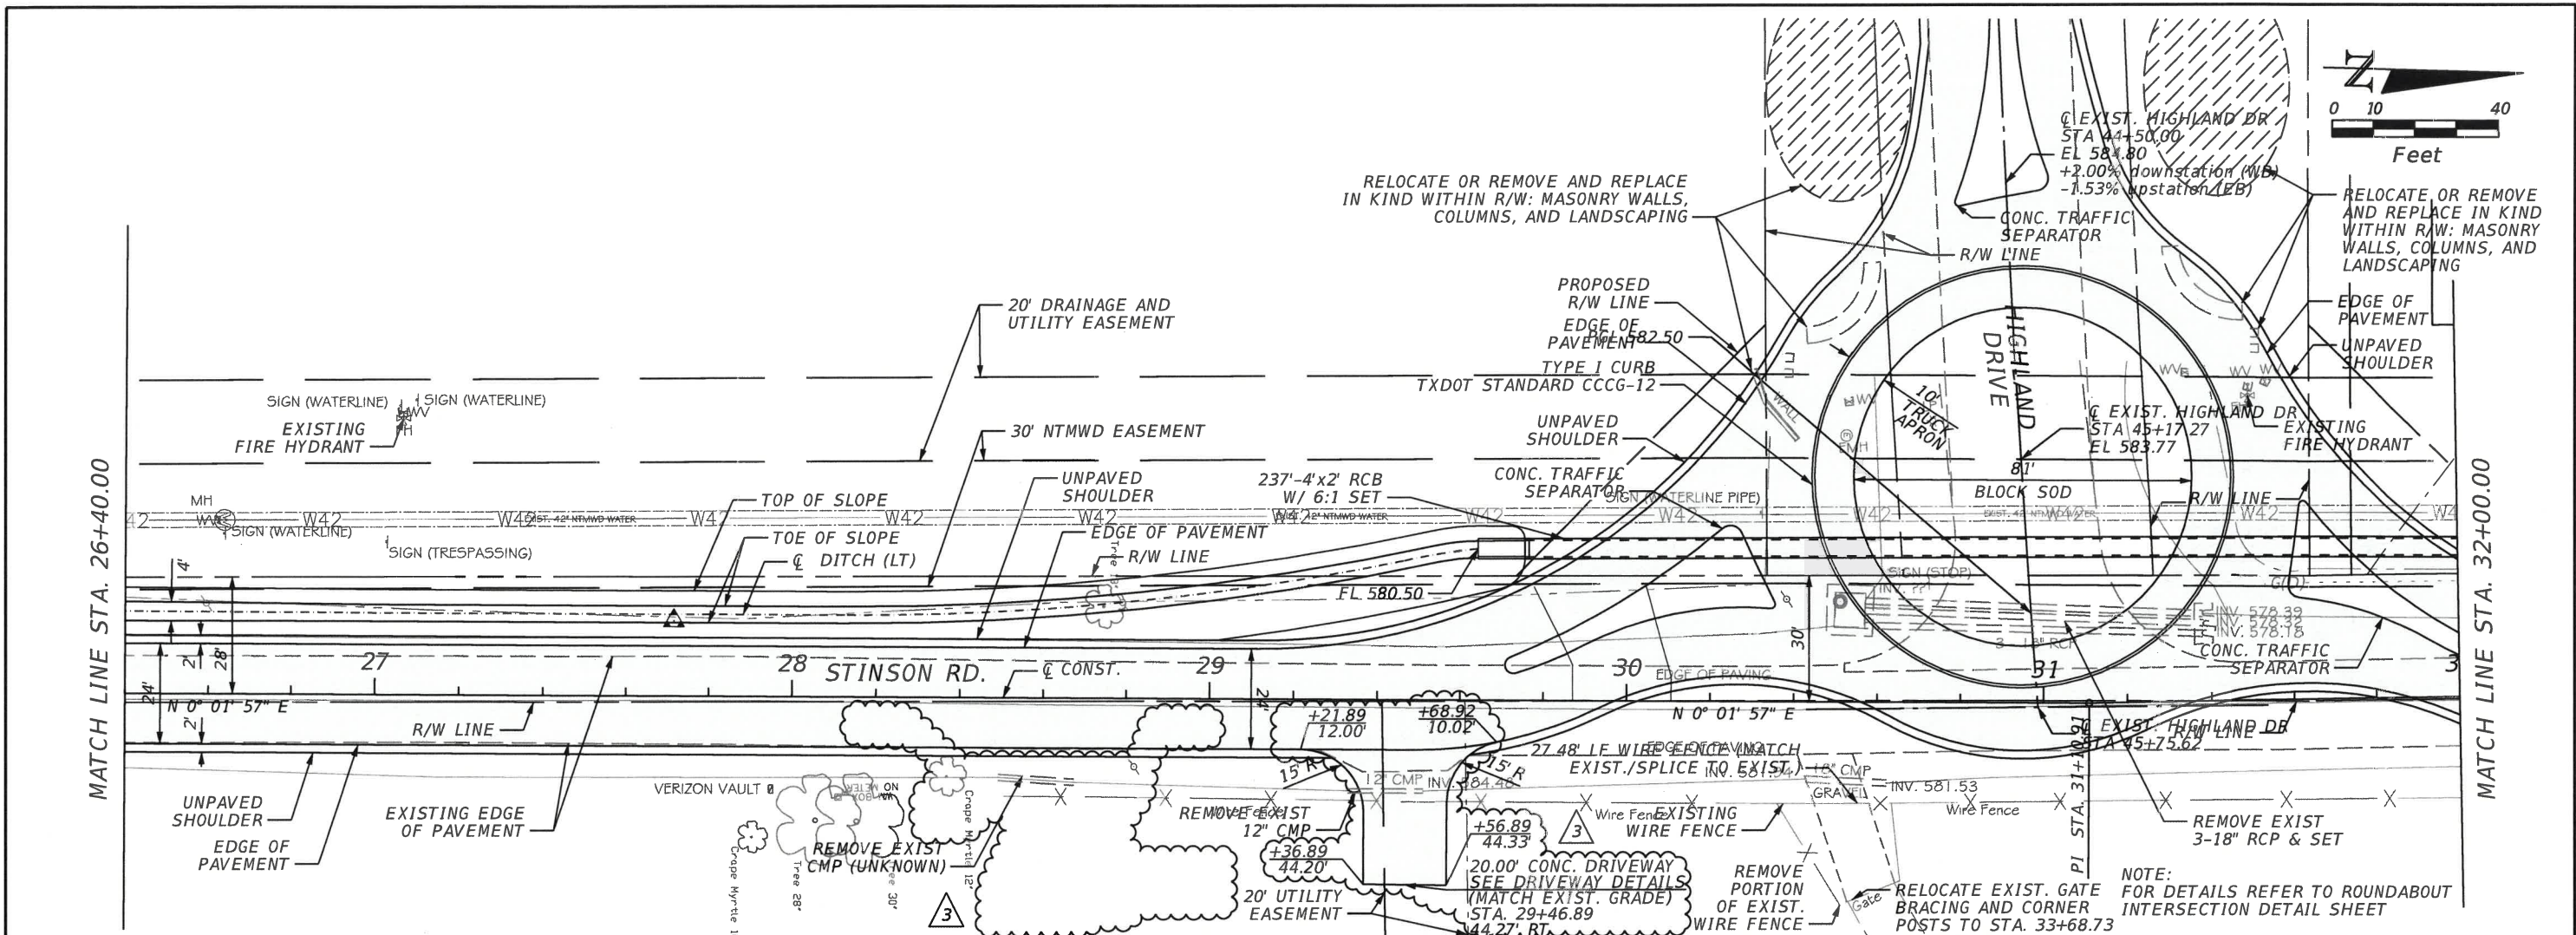

| REVISIONS |                                        |
|-----------|----------------------------------------|
| DATE      | DESCRIPTION                            |
| 5/17/2019 | 3 EXTENDED DRIVEWAY & REMOVED DRIVEWAY |

**LAKES**  
ENGINEERING, INC.

CHRISTOPHER P. MESZLER, P.E.  
LIC. No. 112052  
1903 CENTRAL DRIVE, SUITE #405  
BEDFORD, TX 76021  
PHONE: 817.618.3640  
TBPE REG. F-15243

STINSON ROAD IMPROVEMENTS  
CITY OF LUCAS  
PUBLIC WORKS DEPARTMENT  
665 COUNTRY CLUB ROAD  
LUCAS, TX. 75002

PLAN & PROFILE



| SHEET NO. |
|-----------|
| 17        |




CALL BEFORE YOU DIG  
TEXAS ONE CALL SYSTEM  
1-800-DIG-TESS  
OR BLAST - STOP CALL



ibogness  
5/31/2019  
2:42:37 PM  
T:\18-112 Stinson Road\18112 Stinson Road Plan Set\roadway\PLANRD10\_REV\_3.DGN

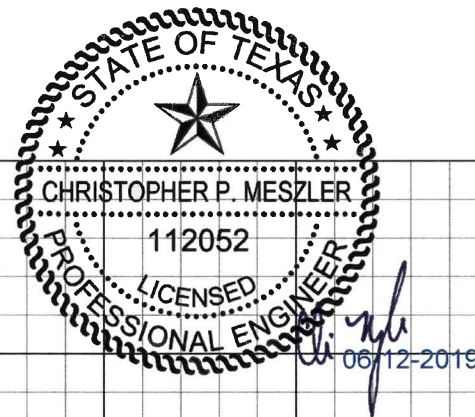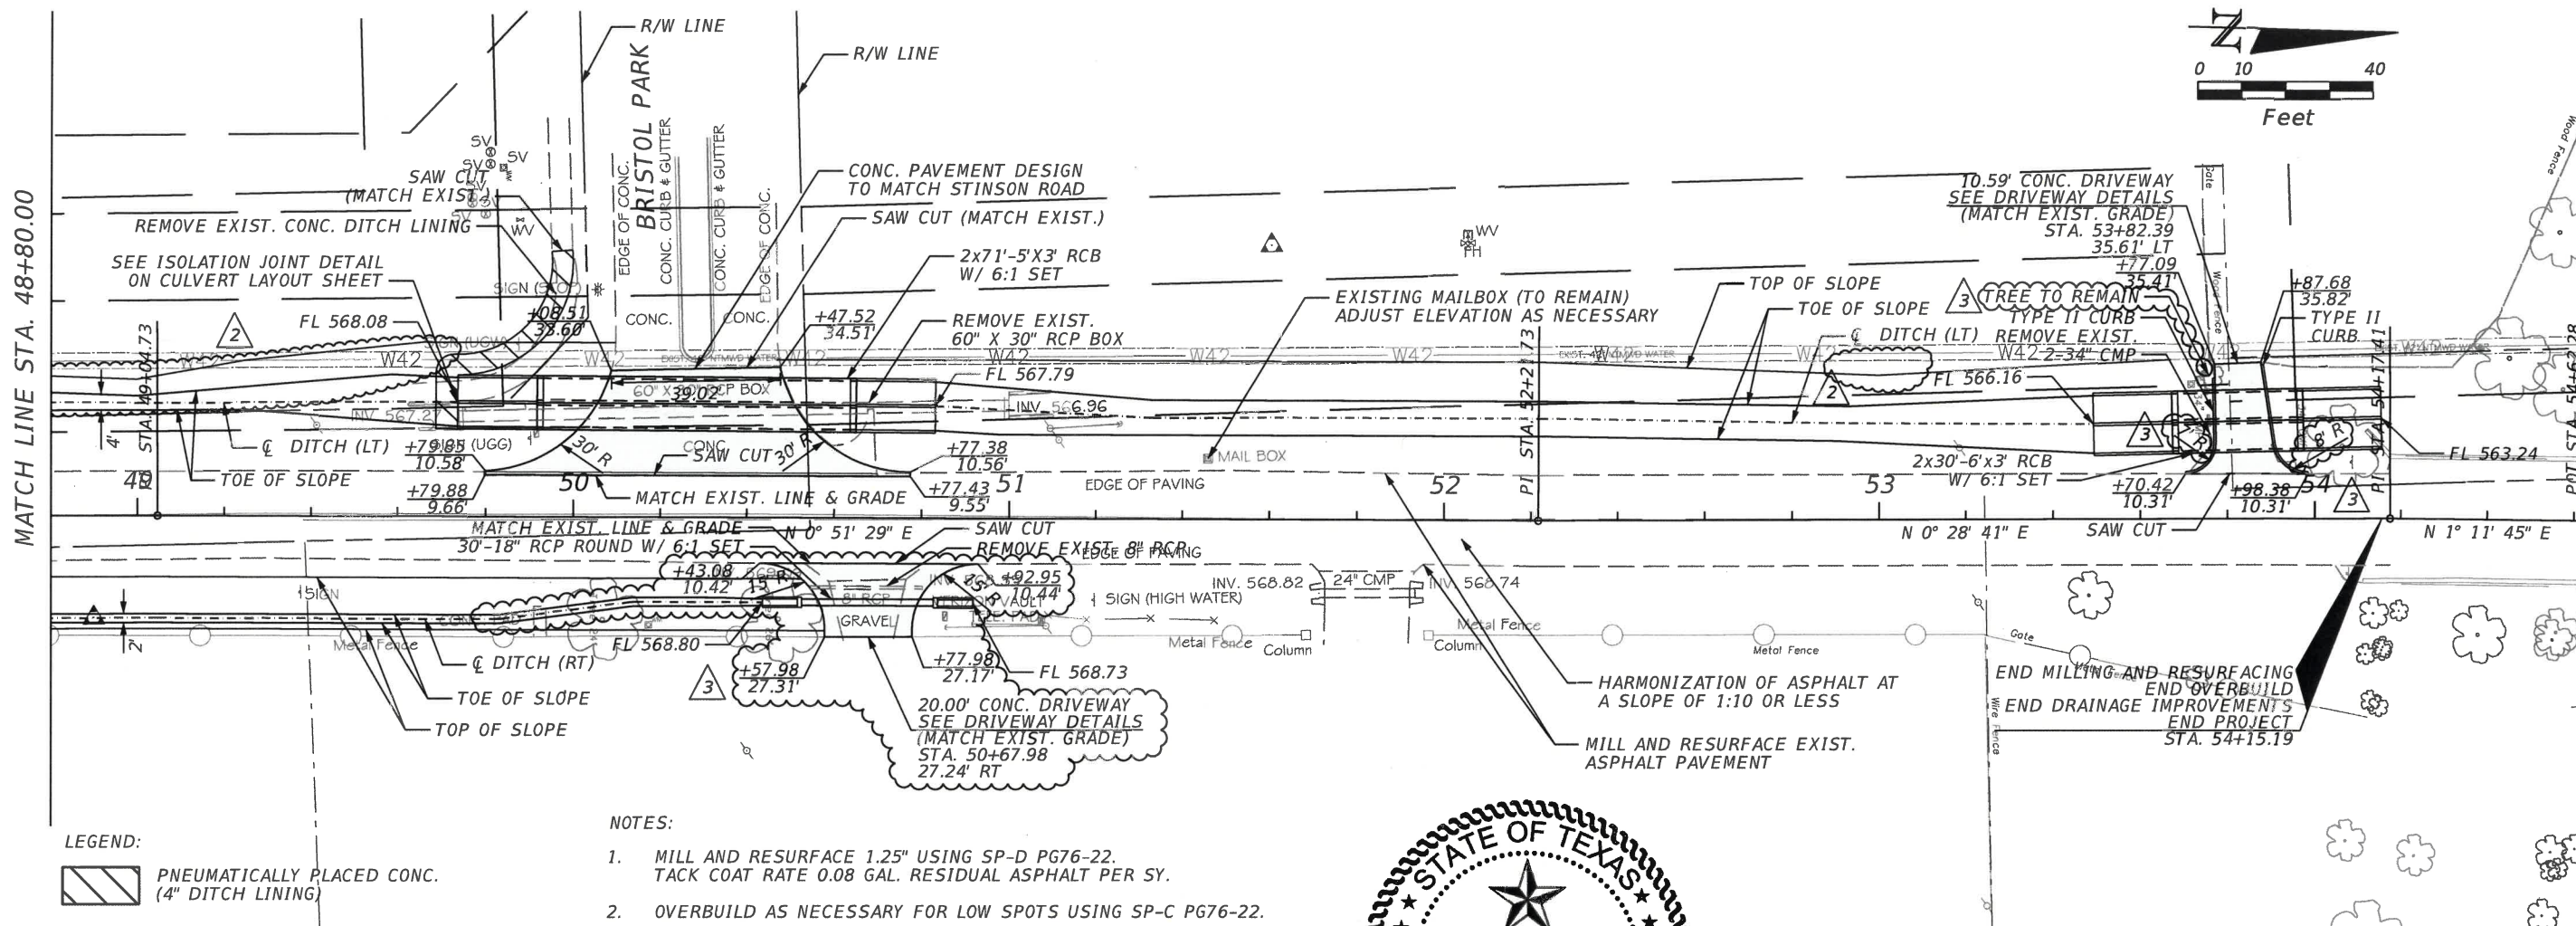

END MILLING AND RESURFACING  
END OVERBUILD  
END DRAINAGE IMPROVEMENTS  
END PROJECT  
STA. 54+15.19

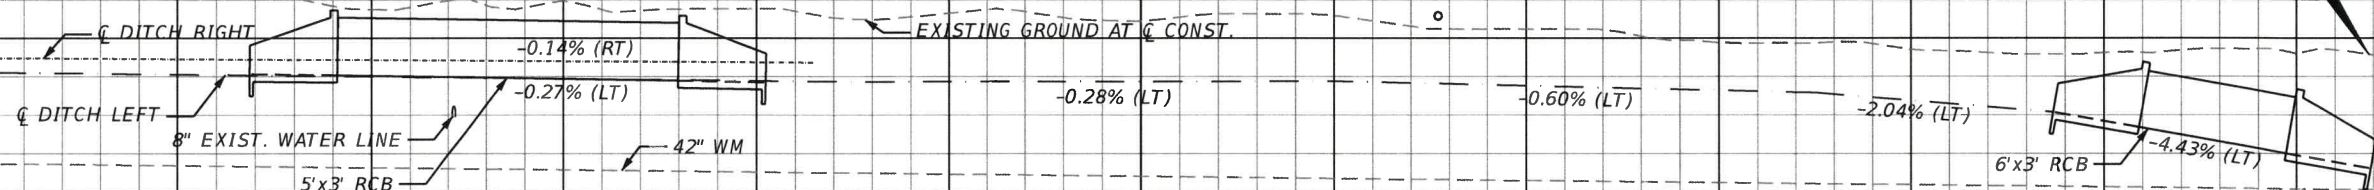

| REVISIONS |                                                                           |
|-----------|---------------------------------------------------------------------------|
| DATE      | DESCRIPTION                                                               |
| 01/29/19  | 2 REVISED DITCH LIMITS                                                    |
| 5/17/19   | 3 CONC. DRIVEWAY WIDENED<br>RCP MOVED WEST<br>WALNUT TREE TO BE PROTECTED |

**LAKES**  
ENGINEERING, INC.

CHRISTOPHER P. MESZLER, P.E.  
LIC. No. 112052  
1903 CENTRAL DRIVE, SUITE #405  
BEDFORD, TX 76021  
PHONE: 817.618.3640  
TBPE REG. F-15243



STINSON ROAD IMPROVEMENTS  
CITY OF LUCAS  
PUBLIC WORKS DEPARTMENT  
665 COUNTRY CLUB ROAD  
LUCAS, TX. 75002

PLAN & PROFILE


SHEET  
NO.  
21

CALL BEFORE YOU DIG  
TEXAS ONE CALL SYSTEM  
1-800-DIG-1155  
OR BLAST - STOP CALL









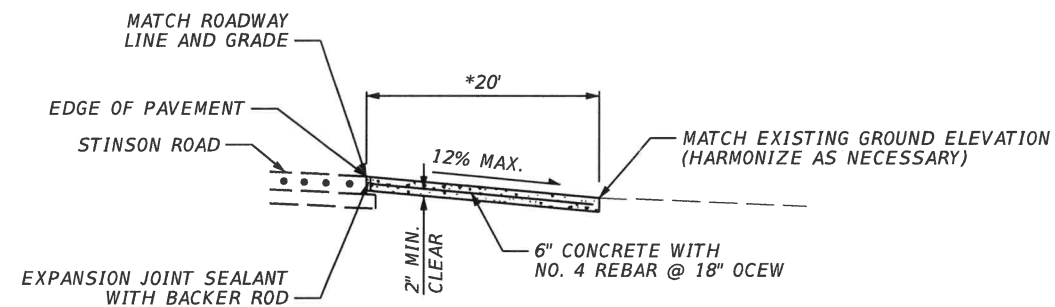


\* DIMENSION MAY VARY AS SHOWN IN PLANS  
**DRIVEWAY TYPICAL PROFILE**  
 (WITHOUT SIDEDRAIN)

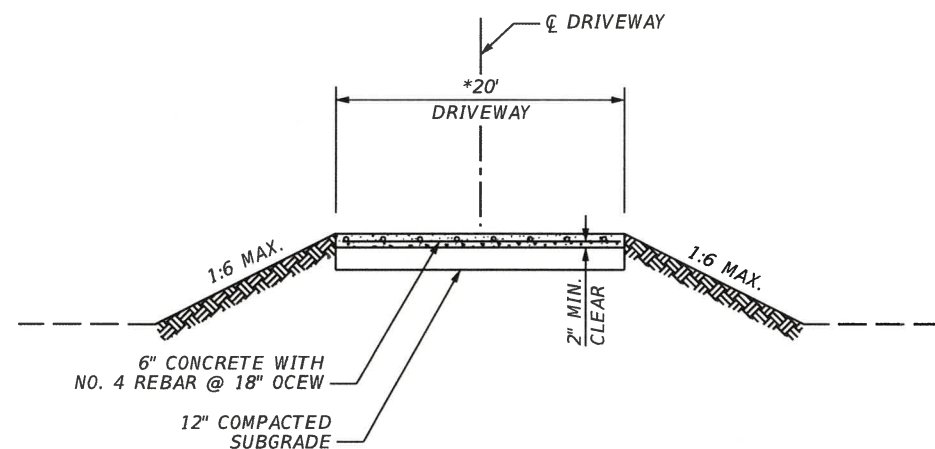


\* DIMENSION MAY VARY AS SHOWN IN PLANS  
**DRIVEWAY TYPICAL SECTION**  
 (WITHOUT SIDEDRAIN)

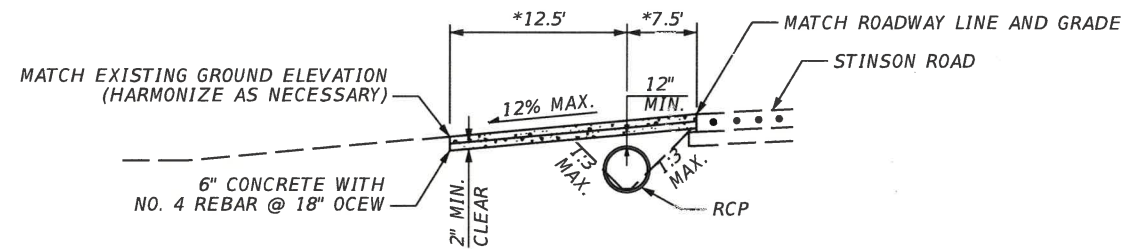

\* DIMENSION MAY VARY AS SHOWN IN PLANS  
**DRIVEWAY TYPICAL PROFILE**  
 (WITH SIDEDRAIN)

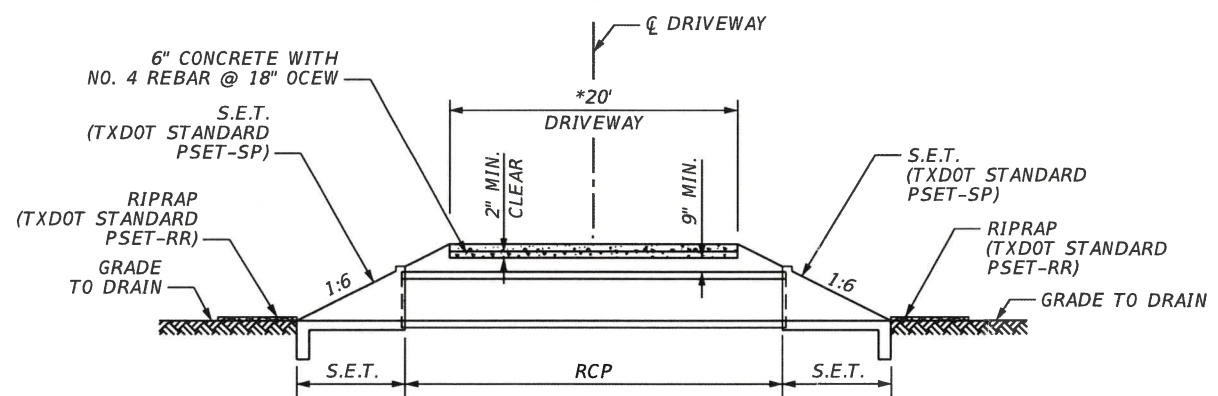

\* DIMENSION MAY VARY AS SHOWN IN PLANS  
**DRIVEWAY TYPICAL SECTION**  
 (WITH SIDEDRAIN)

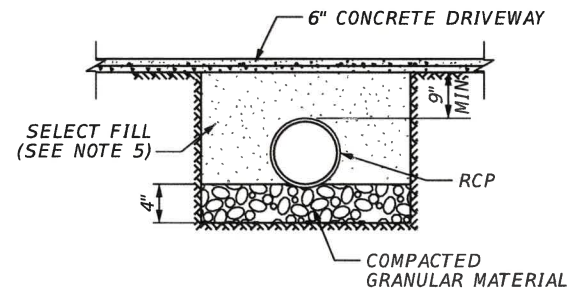


**BACKFILL AND BEDDING DETAIL**

**NOTES:**

1. DRIVEWAY MAY BE EXTENDED BEYOND RIGHT OF WAY LINE AS REQUIRED TO MEET EXISTING GRADE. COORDINATE WITH PROPERTY OWNER AND CITY.
2. EXACT LOCATIONS, DIMENSIONS, AND TYPE MAY BE FIELD MODIFIED WITH PRIOR APPROVAL FROM THE CITY.
3. SIDE DRAINS TO BE INSTALLED WHERE ROADSIDE DITCH DRAINAGE IS PRESENT, AS INDICATED ON PLANS AND/OR AS DIRECTED BY THE ENGINEER.
4. SIDE DRAINS TO BE INSTALLED WITH A MINIMUM OF 9" COVER, NOT INCLUDING CONCRETE DRIVEWAY THICKNESS.
5. PLACE BACKFILL EQUALLY ALONG BOTH SIDES OF THE PIPE IN UNIFORM LIFTS (8 IN. MAX.). COMPACT EACH LIFT MECHANICALLY. THOROUGHLY COMPACT MATERIALS PLACED UNDER THE HAUNCHES OF THE PIPE TO PREVENT DAMAGE OR DISPLACEMENT OF THE PIPE. CONTINUE TO PLACE BACKFILL IN THIS MANNER TO THE TOP-OF-PIPE ELEVATION. PLACE AND COMPACT BACKFILL ABOVE THE TOP OF THE PIPE IN UNIFORM LIFTS (8 IN. MAX.).
6. ALL SUBGRADE COMPACTION UNDER PAVEMENT SHALL BE 98% STANDARD PROCTOR DENSITY AT +2% OF OPTIMUM MOISTURE.
7. FLOWABLE FILL SHALL BE PROVIDED IN LOCATIONS WHERE COMPACTION CANNOT BE ACHIEVED, SUCH AS BETWEEN HAUNCHES OF ADJACENT PIPES.

2. USE HIGH-EARLY STRENGTH 4,000 PSI CONCRETE AS DIRECTED BY THE ENGINEER.

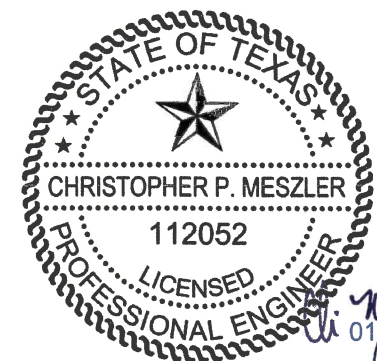

01/31-2019

PLOTTED BY: JBoggess  
 PLOT DATE: 1/29/2019  
 LAST SAVED: 12:47:24 PM  
 LOCATION: X:\18-112 Stinson Road\18112 Stinson Plan Set\roadway\SPDTRD01.DGN

| DATE     | REVISIONS DESCRIPTION |
|----------|-----------------------|
| 01/29/19 | 2 DRIVEWAY NOTE ADDED |

**LAKES**  
**ENGINEERING, INC.**

CHRISTOPHER P. MESZLER, P.E.  
 LIC. No. 112052  
 1903 CENTRAL DRIVE, SUITE #405  
 BEDFORD, TX 76021  
 PHONE: 817.618.3640  
 TBPE REG. F-15243



**STINSON ROAD IMPROVEMENTS**  
 CITY OF LUCAS  
 PUBLIC WORKS DEPARTMENT  
 665 COUNTRY CLUB ROAD  
 LUCAS, TX. 75002

**DRIVEWAY DETAILS**

SHEET  
 NO.  
 23

CALL BEFORE YOU DIG  
 TEXAS ONE CALL SYSTEM  
 1-800-DIG-TESS  
 48 HOURS OR BLAST STOP CALL















PLOTTED BY:  
PLOT DATE:  
LAST SAVED:  
LOCATION:

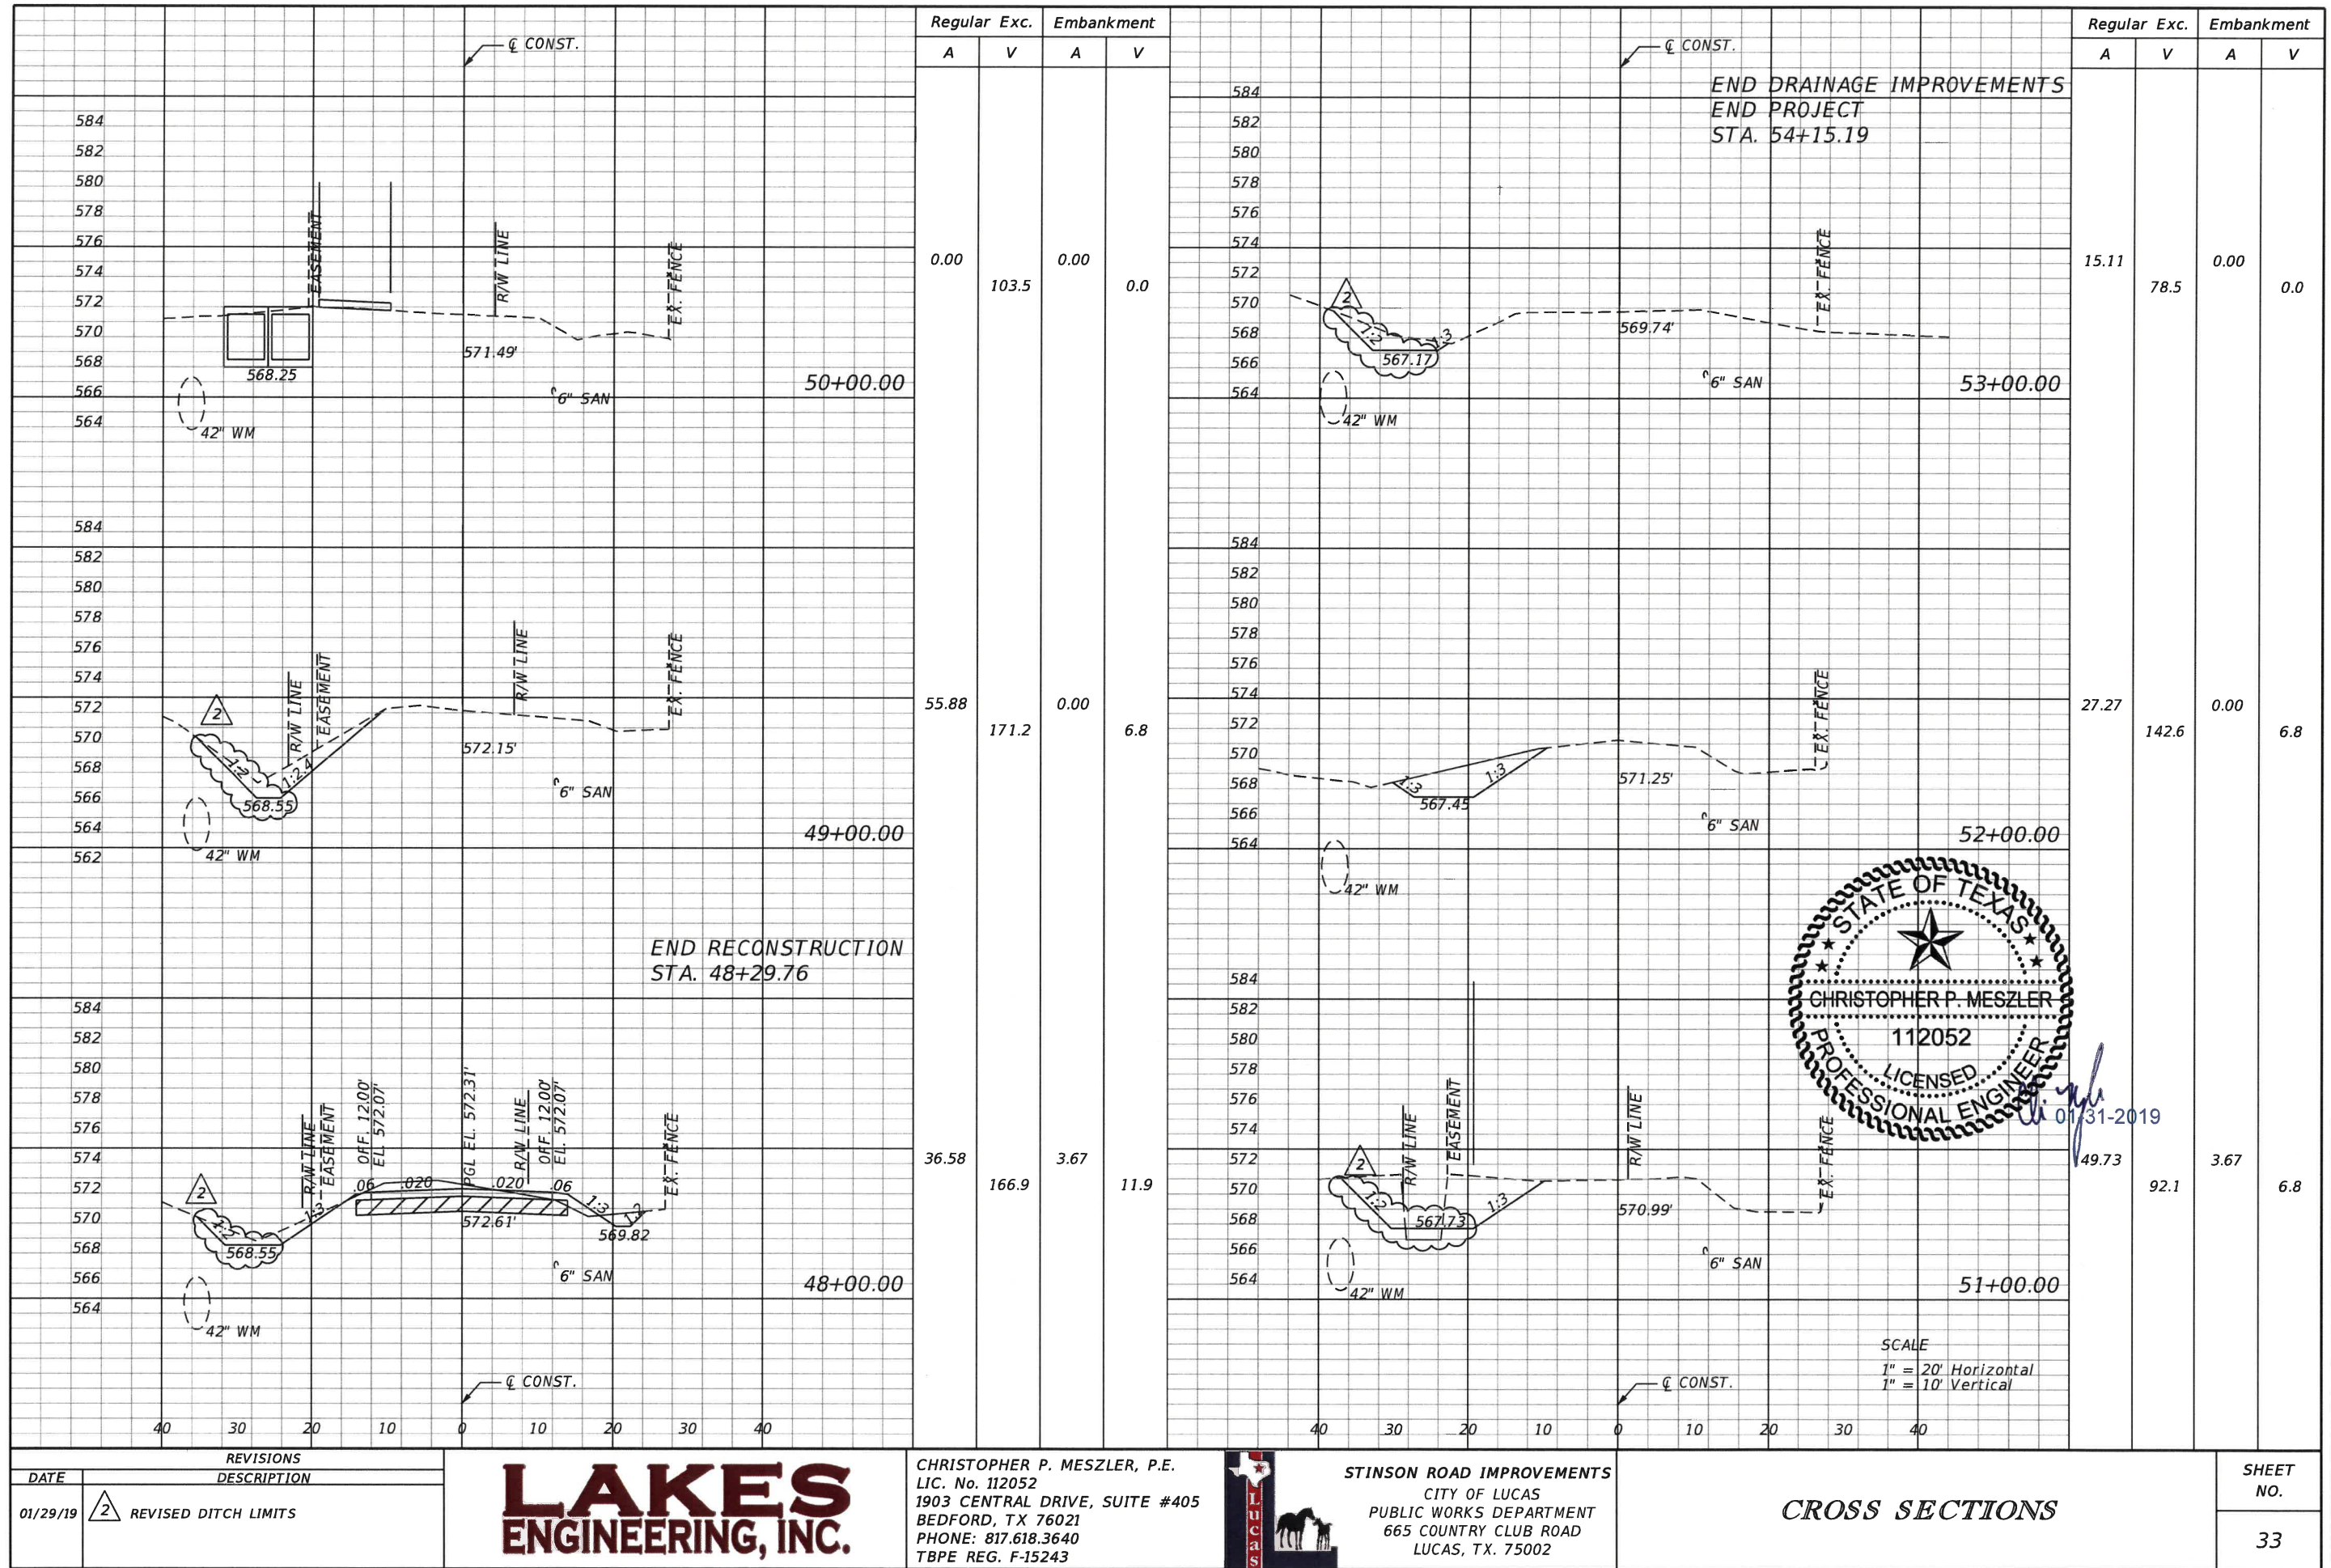

CALL BEFORE YOU DIG  
48 HOURS NOTICE  
OR BLAST - STOP CALL



ibogness  
6/13/2019  
2:23:22 PM  
LAST SAVED:  
LOCATION:  
7:\18-112 Stinson Road\18112 Stinson Road Set\roadway\UTADRD02.DGN

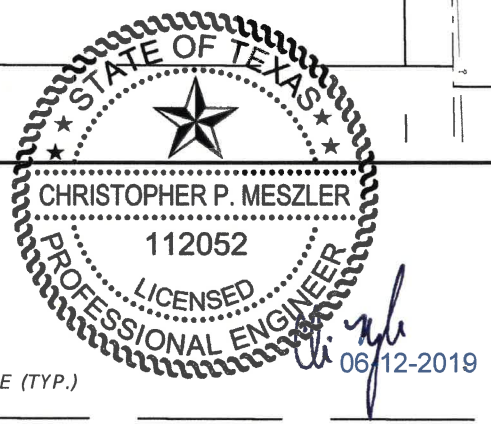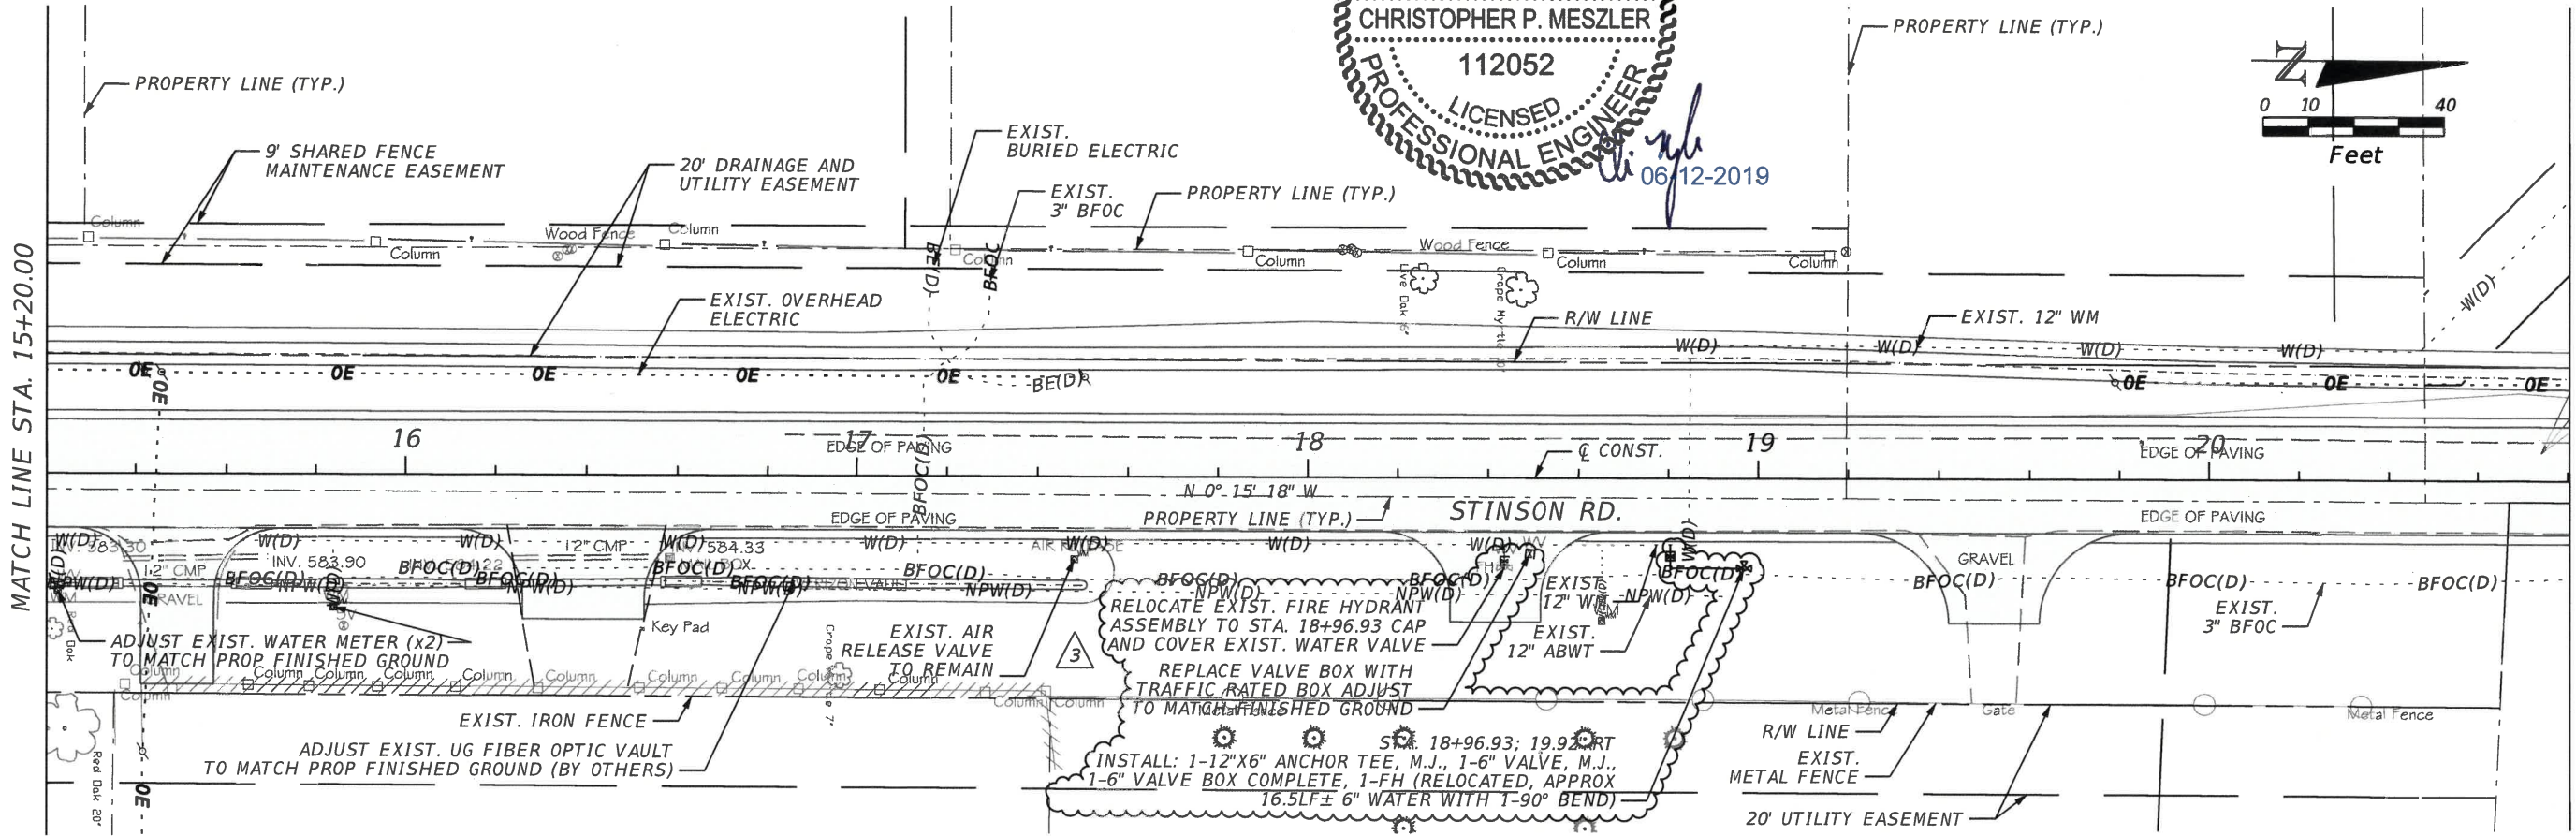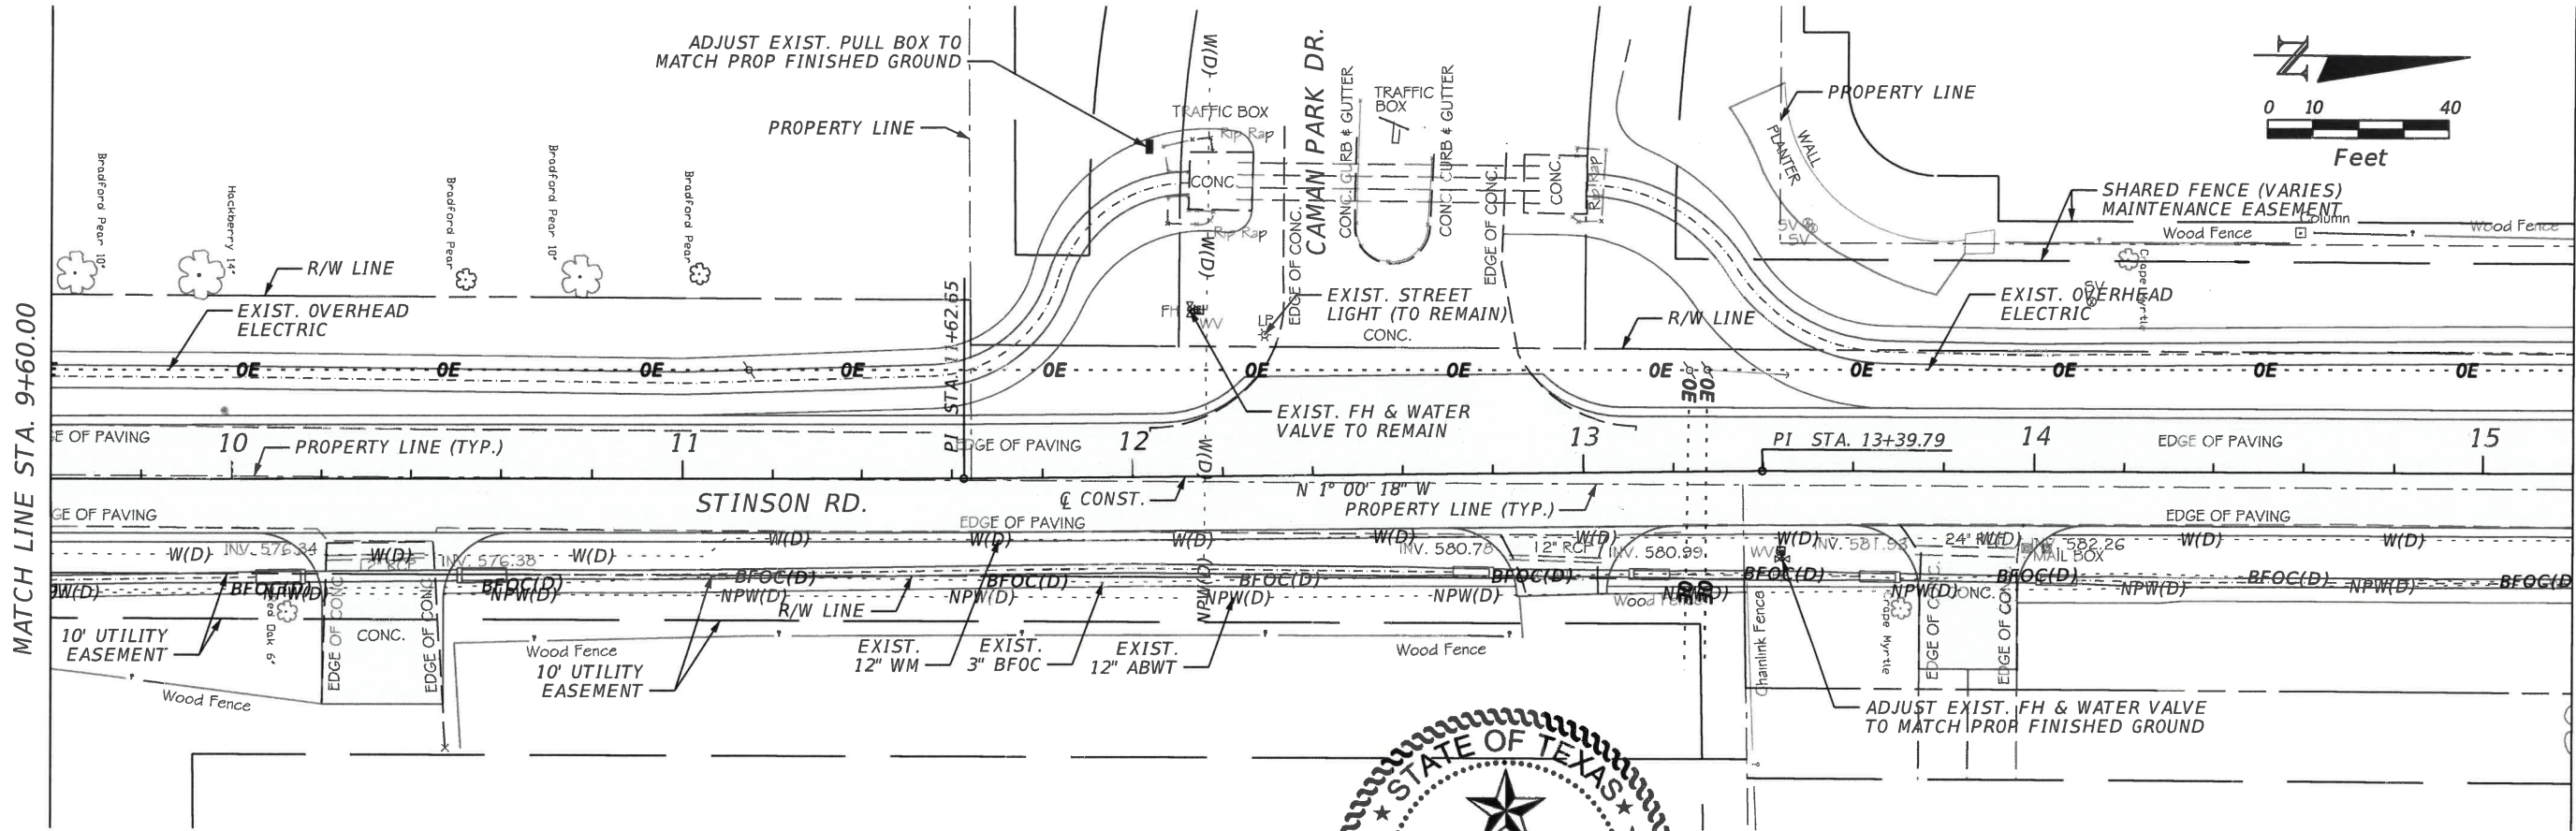

| REVISIONS |                                                      |
|-----------|------------------------------------------------------|
| DATE      | DESCRIPTION                                          |
| 05/17/19  | 3 ADDED DRIVEWAY AND RELOCATED FIRE HYDRANT ASSEMBLY |



CHRISTOPHER P. MESZLER, P.E.  
LIC. No. 112052  
1903 CENTRAL DRIVE, SUITE #405  
BEDFORD, TX 76021  
PHONE: 817.618.3640  
TBPE REG. F-15243



STINSON ROAD IMPROVEMENTS  
CITY OF LUCAS  
PUBLIC WORKS DEPARTMENT  
665 COUNTRY CLUB ROAD  
LUCAS, TX. 75002

UTILITY ADJUSTMENTS

|           |
|-----------|
| SHEET NO. |
| 50        |

CALL BEFORE YOU DIG  
TEXAS ONE CALL SYSTEM  
1-800-485-1111  
OR BLAST - STOP CALL