

in the
JAMES ANDERSON SURVEY, ABSTRACT NO. 17
CITY OF LUCAS
COLLIN COUNTY, TEXAS
NOVEMBER, 2014



SITE PLANNING CIVIL ENGINEERING PLATTING
CONSULTANTS, LLC
 LAND SURVEYING LANDSCAPE ARCHITECTURE

Contact: R. Von Beougher, P.E.

C

COVER SHEET

LEWIS PARK ESTATES

CONSTRUCTION PLANS

File: Z:\2014\14026\Drawings\FP & Coast Plans\SHEET SET\14026 COV
 Plotted: 11/20/2015 3:53 PM, by Josh Burton; Saved: 11/20/2015 3:50 PM, by josh

1. THE TERM "CITY OF LUCAS" REFERS TO THE CITY OF LUCAS.
2. ALL WORK SHALL CONFORM TO THE REQUIREMENTS OF THE MUNICIPALITY AND SHALL BE IN ACCORDANCE WITH THE MUNICIPAL STANDARD DETAILS AND SPECIFICATIONS FOR CONSTRUCTION. ALL WORK NOT COVERED IN THE CONTRACT DOCUMENTS AND MUNICIPAL STANDARD DETAILS AND SPECIFICATIONS FOR CONSTRUCTION SHALL BE GOVERNED BY THE NORTH CENTRAL TEXAS COUNCIL OF GOVERNMENT STANDARD SPECIFICATIONS FOR PUBLIC WORKS CONSTRUCTION.
3. EXISTING UTILITY LOCATIONS SHOWN ARE GENERALLY SCHEMATIC IN NATURE AND MAY NOT ACCURATELY REFLECT THE SIZE AND LOCATION OF EACH PARTICULAR UTILITY. EXISTING UTILITIES SHOWN HAVE BEEN BASED ON AVAILABLE RECORD DRAWINGS AND SURFACE APPURTENANCE FIELD TIES ONLY. SOME UTILITY LINES AND SURFACE LOCATIONS MAY NOT BE SHOWN. THE CONTRACTOR SHALL ASSUME RESPONSIBILITY FOR ACTUAL FIELD LOCATIONS AND PROTECTION OF EXISTING UTILITIES WHETHER SHOWN OR NOT. THE CONTRACTOR SHALL ALSO ASSUME RESPONSIBILITY FOR REPAIRS TO EXISTING UTILITIES WHETHER SHOWN OR NOT, DAMAGED BY THE CONTRACTOR'S ACTIVITIES. DIFFERENCES IN HORIZONTAL OR VERTICAL LOCATIONS OF EXISTING UTILITIES SHALL NOT BE BASIS FOR ADDITIONAL COMPENSATIONS TO THE CONTRACTOR.
4. THE CONTRACTOR SHALL PROTECT EXISTING PROPERTY MONUMENTATION AND PRIMARY CONTROL. ANY SUCH POINTS WHICH THE CONTRACTOR BELIEVES WILL BE DESTROYED SHALL HAVE OFFSET POINTS ESTABLISHED BY THE CONTRACTOR PRIOR TO CONSTRUCTION. ANY MONUMENTATION DESTROYED BY THE CONTRACTOR SHALL BE REESTABLISHED AT CONTRACTORS EXPENSE BY A REGISTERED PROFESSIONAL LAND SURVEYOR.
5. IT SHALL BE THE RESPONSIBILITY OF THE CONTRACTOR TO: A.) PREVENT ANY DAMAGES TO PRIVATE PROPERTY AND PROPERTY OWNER'S POLES, FENCES, SHRUBS, ETC. B.) PROTECT ALL UNDERGROUND UTILITIES. C.) NOTIFY ALL UTILITY COMPANIES AT LEAST 48 HOURS PRIOR TO EXCAVATION IN ACCORDANCE WITH TEXAS LAW. D.) FIELD VERIFY HORIZONTAL AND VERTICAL LOCATION OF ALL UTILITIES IN THE VICINITY OF CONSTRUCTION ACTIVITIES PRIOR TO START OF CONSTRUCTION. THE CONTRACTOR SHALL NOTIFY ENGINEER OF ANY UNIDENTIFIED POTENTIAL CONFLICTS THAT MAY EXIST BETWEEN THE EXISTING UTILITIES AND CONSTRUCTION PLANS.
6. ANY DAMAGES THAT MAY OCCUR TO REAL PROPERTY OR EXISTING IMPROVEMENTS, INCLUDING EXISTING PRIVATE AND PUBLIC LANDSCAPE IRRIGATION SYSTEMS, SHALL BE RESTORED BY THE CONTRACTOR TO AT LEAST THE SAME CONDITION THAT THE REAL PROPERTY OR EXISTING IMPROVEMENT WERE IN PRIOR TO THE DAMAGES. THE CONTRACTOR WILL ALSO BE RESPONSIBLE FOR THE ADJUSTMENT OF SPRINKLER HEADS TO FINAL GRADE AND RELOCATION IF NECESSARY.
7. THE CONTRACTOR SHALL MAINTAIN DRAINAGE AT ALL TIMES DURING CONSTRUCTION. THE PONDING OF WATER IN STREETS, DRIVES, TRENCHES, ETC, WILL NOT BE ALLOWED. THE CONTRACTOR SHALL MAINTAIN EXISTING DRIVEWAYS ACCESS AT ALL TIME.
8. THE CONTRACTOR SHALL MAINTAIN EXISTING WATER SERVICES AT ALL TIMES DURING CONSTRUCTION.
9. AREAS OF THE SITE THAT WILL UNDERLIE FILL SHALL BE SCARIFIED TO A DEPTH OF 8 INCHES, FILL SHALL BE PLACED IN LOOSE LIFTS NOT EXCEEDING 8 INCHES IN UNCOMPACTED THICKNESS. ALL FILL MATERIAL SHALL BE COMPACTED TO 95% STANDARD PROCTOR DENSITY WITH A MOISTURE CONTENT FROM -3% TO +1% OF OPTIMUM OR PER GEOTECH RECOMMENDATION. FIELD DENSITY TESTS PER MUNICIPAL REQUIREMENTS.
10. THE CONTRACTOR SHALL ABIDE BY ALL APPLICABLE FEDERAL, STATE, AND LOCAL LAWS GOVERNING EXCAVATION. THE CONTRACTOR SHALL PROVIDE DETAILED PLANS AND SPECIFICATION FOR TRENCH SAFETY SYSTEMS THAT COMPLY WITH APPLICABLE LAWS GOVERNING EXCAVATION. THESE PLANS SHALL BE SEALED BY AN ENGINEER EXPERIENCED IN THE DESIGN OF TRENCH SAFETY SYSTEM, REGISTERED IN THE STATE OF TEXAS. THE CONTRACTOR SHALL SUBMIT COMPLETED TRENCH SAFETY PLANS TO THE MUNICIPALITY PRIOR TO COMMENCING WORK. THE CONTRACTOR SHALL BE SOLELY RESPONSIBLE FOR ALL ASPECTS OF WORK RELATED TO EXCAVATION. ALL EXCAVATIONS, TRENCHING AND SHORING OPERATIONS SHALL COMPLY WITH THE REQUIREMENTS OF THE U.S. DEPARTMENT OF LABOR, OSHA, "CONSTRUCTION SAFETY AND HEALTH REGULATIONS".
11. WORK MAY NOT BE BACKFILLED OR COVERED UNTIL IT HAS BEEN INSPECTED BY THE MUNICIPALITY.
12. ALL EXCAVATION ON THE PROJECT IS UNCLASSIFIED.
13. CONTRACTOR SHALL COORDINATE THE PROTECTION OF EXISTING FRANCHISE UTILITIES AND APPURTENANCES INCLUDING EXISTING UTILITY POLES IN THE VICINITY OF CONSTRUCTION OPERATIONS WHETHER UTILITIES ARE SHOWN ON PLANS OR NOT. ANY DAMAGE INCURRED TO EXISTING FRANCHISE UTILITIES, APPURTENANCES, UTILITY POLES, LIGHT STANDARDS, ETC., BY CONSTRUCTION RELATED ACTIVITIES SHALL BE THE SOLE RESPONSIBILITY OF THE CONTRACTOR.
14. THE CONTRACTOR SHALL LOCATE AND RECORD EXISTING IRRIGATION SYSTEMS PRIOR TO CONSTRUCTION. CONTRACTOR SHALL TEMPORARILY REMOVE AND CAP IRRIGATION SYSTEM AS NECESSARY FOR CONSTRUCTION AND SHALL REPLACE THE PORTION REMOVED WITH EQUIVALENT SYSTEMS. CONTRACTOR SHALL COORDINATE ANY IRRIGATION WORK WITH THE MUNICIPALITY AND PROPERTY OWNER'S REPRESENTATIVES.
15. THE CONTRACTOR MUST CEASE ALL CONSTRUCTION OPERATIONS IMMEDIATELY IF A SUSPECTED ARCHEOLOGICAL OBJECT/ARTIFACT IS UNCOVERED DURING CONSTRUCTION. THE CONTRACTOR MUST IMMEDIATELY CONTACT THE TEXAS HISTORICAL COMMISSION AND THE MUNICIPALITY. PROJECT WORK WILL NOT COMMENCE UNTIL PROPER PERMITS ARE IN PLACE AND PROVIDED TO THE MUNICIPALITY.
16. ALL PAVING DIMENSIONS ARE TO EDGE OF PAVEMENT UNLESS OTHERWISE NOTED.
17. IT IS THE CONTRACTOR'S RESPONSIBILITY TO ENSURE COMPLIANCE WITH ALL HANDICAPPED ACCESSIBILITY REQUIREMENTS INCLUDING SIGNAGE, TEXTURES, COLORING, MARKINGS, AND SLOPES OF ADA/TAS 2012 ACCESSIBLE ROUTES & RAMPS, AND PARKING SPACES.
18. ALL PIPE LENGTHS MEASURED FROM STATION TO STATION BASED ON THE CENTER OF STRUCTURE UNLESS OTHERWISE NOTED.
19. CONTRACTOR SHALL NOTIFY ENGINEER IF ANY DISCREPANCIES ARISE.

1. ALL WATER LINES SHALL BE PVC PIPE CONFORMING TO A.W.W.A. STANDARD C-900 SDR-18 MINIMUM, WITH NSF SEAL, PRESSURE TESTED AND DISINFECTED IN ACCORDANCE WITH MUNICIPAL AND/OR NCTCOG STD. SPECS., UNLESS OTHERWISE NOTED WITHIN THE CONSTRUCTION PLANS.
2. CONTRACTOR SHALL NOT DIG WITHIN 20 FEET OF ANY WATERLINES ON FRIDAY, SATURDAY OR SUNDAY WITHOUT WRITTEN PERMISSION OF THE CITY ENGINEER.

1. THE SUB GRADE SHALL BE PROOF ROLLED AND OBSERVED BY THE CONSTRUCTION INSPECTOR PRIOR TO AND AFTER SUB-GRADE STABILIZATION.
2. INDIVIDUAL WATER AND SEWER SERVICES AND WATER VALVES SHALL BE MARKED IN ACCORDANCE WITH MUNICIPAL REQUIREMENTS.
3. THE CONTRACTOR SHALL PROCEED WITH PAVING NO MORE THAN SEVENTY-TWO (72) HOURS AFTER DENSITY/MOISTURE TESTS HAVE BEEN TAKEN AND PASSED BY A REGISTERED TESTING FIRM. COPIES OF THE TEST RESULTS SHALL BE FURNISHED TO THE MUNICIPALITY. IN THE EVENT PAVING OPERATIONS HAVE NOT COMMENCED WITHIN THE SEVENTY-TWO (72) HOUR LIMIT, A RETEST SHALL BE REQUIRED AT THE CONTRACTOR'S EXPENSE.
4. MANHOLE RIM ELEVATIONS, CLEAN-OUTS, VALVE BOXES, FIRE HYDRANTS, ETC. SHALL BE ADJUSTED TO FINISHED GRADE BY THE PAVING CONTRACTOR AT THE TIME OF PAVING.
5. THE PAVING CONTRACTOR SHALL INSTALL A BLUE REFLECTOR IN THE STREET OR FIRE LANE CENTERLINE AT THE LOCATION OF EACH FIRE HYDRANT.
6. THE CONTRACTOR SHALL PREPARE ALL TRAFFIC CONTROL PLANS AND SUBMIT TO THE MUNICIPALITY PRIOR TO THE ISSUANCE OF ANY CONSTRUCTION PERMITS FOR WORK WITHIN THE MUNICIPALITY. THE PLAN SHALL BE PREPARED IN ACCORDANCE WITH THE CURRENT EDITION OF THE M.U.T.C.D. AND AS MODIFIED BY THE TxDOT SUPPLEMENT TO THE M.U.T.C.D. THE PLAN SHALL ADDRESS THE REQUIREMENTS FOR ALL SIGNS, BARRICADES, FLAGMEN, LIGHTS, HOURS OF CONSTRUCTION, AND OTHER DEVICES AS NECESSARY FOR SAFE TRAFFIC CONTROL.

1. THE TEXAS DEPARTMENT OF TRANSPORTATION (TXDOT) MUST APPROVE ANY WORK TO BE DONE IN THE STATE HIGHWAY RIGHT-OF-WAY. AN APPLICATION AND APPROPRIATE PLANS MUST BE SUBMITTED TO THE CITY OF LUCAS FOR REVIEW AND APPROVED BY THE MUNICIPALITY WHERE THE WORK WILL BE PERFORMED.
2. THE LOCATION OF UNDERGROUND FACILITIES INDICATED ON THE PLANS IS TAKEN FROM PUBLIC RECORDS. IT IS THE CONTRACTOR'S SOLE RESPONSIBILITY TO MAKE ARRANGEMENTS WITH THE OWNERS OF SUCH UNDERGROUND FACILITIES PRIOR TO WORKING IN THE AREA TO CONFIRM THEIR EXACT LOCATION AND TO DETERMINE WHETHER ANY ADDITIONAL FACILITIES OTHER THAN THOSE SHOWN ON THE PLANS MAY BE PRESENT. THE CONTRACTOR SHALL PRESERVE AND PROTECT ALL UNDERGROUND FACILITIES. IF THE EXISTING UNDERGROUND UTILITIES ARE DAMAGED, THE CONTRACTOR WILL BE RESPONSIBLE FOR THE COST OF REPAIRING THE UTILITY.
3. WHERE EXISTING UTILITIES, SERVICE LINES OR IRRIGATION LINES ARE CUT, BROKEN OR DAMAGED, THE CONTRACTOR SHALL REPLACE OR REPAIR THE UTILITIES, SERVICE LINES OR IRRIGATION LINES WITH THE SAME TYPE OF ORIGINAL MATERIAL AND CONSTRUCTION, OR BETTER, UNLESS OTHERWISE SHOWN OR NOTED ON THE PLANS, AT HIS OWN COST AND EXPENSE. THE CONTRACTOR SHALL IMMEDIATELY NOTIFY THE ENGINEER AT ONCE OF ANY CONFLICTS IN GRADES AND ALIGNMENTS.
4. CONTRACTOR SHALL NOT DIG WITHIN 20 FEET OF ANY WATERLINES ON FRIDAY, SATURDAY OR SUNDAY WITHOUT WRITTEN PERMISSION OF THE CITY ENGINEER.
5. ALL EXCAVATIONS, TRENCHING AND SHORING OPERATIONS SHALL COMPLY WITH THE REQUIREMENTS OF THE U.S. DEPARTMENT OF LABOR, OSHA, "CONST. SAFETY AND HEALTH REGULATIONS." VOL. 29, SUBPART P. PG. 128-137, AND ANY AMENDMENTS THERETO. THE CONTRACTOR SHALL PREPARE AND IMPLEMENT A TRENCH SAFETY PLAN FOR THIS PROJECT.
6. THE CONTRACTOR SHALL RESTORE ALL AREAS, ONSITE AND OFFSITE, DISTURBED BY CONSTRUCTION TO ORIGINAL CONDITION OR BETTER. RESTORED AREAS INCLUDE, BUT ARE NOT LIMITED TO: TRENCH BACKFILL, SIDE SLOPES, FENCES, CULVERT PIPES, DRAINAGE SWALES, STAGING AREAS, DRIVEWAYS, PRIVATE YARDS AND ROADWAYS. UNLESS OTHERWISE DIRECTED BY THE LANDSCAPE DRAWINGS, RESTORATION SHALL INCLUDE SODDING ALL DISTURBED AREAS. ESTABLISHMENT OF GRASS THROUGH PROPER WATERING IS LEFT UP TO THE CONTRACT'S MEANS AND METHODS, UNLESS OTHERWISE DIRECTED BY THE LANDSCAPE/IRRIGATION DRAWINGS.
7. THE CONTRACTOR SHALL KEEP RECORDS FOR AS-BUILTS DRAWINGS AND SHALL SUBMIT MARK-UPS TO THE MUNICIPALITY INSPECTOR PRIOR TO SCHEDULING A FINAL WALK THROUGH INSPECTION.
8. PRIOR TO CONSTRUCTION, A PRE-CONSTRUCTION MEETING SHALL BE HELD WITH REPRESENTATIVES FROM ALL CONTRACTORS, THE ENGINEER, AND THE MUNICIPALITY.
9. ALL CONSTRUCTION MUST ADHERE TO THE TREE PRESERVATION REQUIREMENTS OF THE MUNICIPALITY.

1. ALL STORM SEWER AND CULVERT PIPE AND FITTINGS SHALL BE ASTM C76, CLASS III REINFORCED CONCRETE PIPE (RCP), INSTALLED WITH COMPRESSIVE TYPE JOINTS UNLESS NOTED OTHERWISE.
2. AFTER COMPLETION OF ALL STORM SEWER INSTALLATION, THE CONTRACTOR SHALL ENSURE THAT ALL DEBRIS AND SILTATION HAS BEEN REMOVED.

1. ALL EXISTING MAILBOXES IN CONFLICT WITH THE PROPOSED IMPROVEMENTS SHALL BE RELOCATED AND REPLACED WITH AN EQUIVALENT MAILBOX AT NO COST UNLESS SPECIFIED AS A BID ITEM.

**AS-BUILT
RECORD DRAWING**

Douglas W. Weaver
G & A Consultants, LLC.
Date: 11/23/2015

LEWIS PARK ESTATES
 Lot 1-16, 1-20, Block A, B
LEWIS PARK ESTATES
 60.858 Acres
 in the
JAMES ANDERSON SURVEY, ABSTRACT NO. 17
CITY OF LUCAS
COLLIN COUNTY, TEXAS

G&A CONSULTANTS, LLC.
TBPE F-1798

Drawn By: TJF
Date: 11/07/2014
Scale: N/A
Revisions:

C1




BENCHMARKS:
BM#1 - RM133 - 590.08'
Square cut on east headwall of west of bridge at White Rock Creek (East) and FM 1378. Map# 48085C04556, Dated January 19th, 1996.
TBM#2 - Square Cut - 568.45'
~981' Southwest from the Northwest corner of subject property on south edge of Brookhaven Dr.
N=7,079,521.1' E=2,557,109.8'
TBM#3 - "X" - 579.96'
~760' Northeast from the Northwest corner of subject property near the intersection of Conner Ln. & Chapel Ct.
N=7,080,175.7' E=2,558,146.1'
TBM#4 - PK Nail - 554.84'
~900' Northeast from the Northeast corner of subject property on a headwall on the north side of the intersection of FM 1378 & Seis Lagos Trail.
N=7,079,803.4' E=2,559,558.0'
TBM#5 - "X" - 584.19'
~1040' Southeast from the southeast corner of subject property on a headwall on the north side of the intersection of FM 1378 & Seis Lagos Trail.
N=7,076,568.5' E=2,559,653.8'



DENSITY TABLE

	Acres	Density
Gross Land Area	60.858	0.58 du/ac
Net Land Area		
ROW Internal	5.913	
Total Net Acres	54.945	0.60 du/ac

- LEGEND**
- P.O.B. = POINT OF BEGINNING
 - RF = REBAR FOUND
 - CRS = CAPPED REBAR SET
 - BL = BUILDING LINE
 - CRF = CAPPED REBAR FOUND
 - G&A = G&A CONSULTANTS, LLC
 - PRCCT = PLAT RECORDS, COLLIN COUNTY, TEXAS
 - RPRCCT = REAL PROPERTY RECORDS COLLIN COUNTY, TEXAS
 - SSE = SANITARY SEWER EASEMENT
 - WLE = WATER LINE EASEMENT
 - PAE = PEDESTRIAN ACCESS EASEMENT
 - UE = UTILITY EASEMENT
 - DE = DRAINAGE EASEMENT
 - DUE = DRAINAGE & UTILITY EASEMENT
 - NTMWD = NORTH TEXAS MUNICIPAL WATER DISTRICT
 - OVERHEAD POWER
 - DENOTES STREET NAME CHANGE

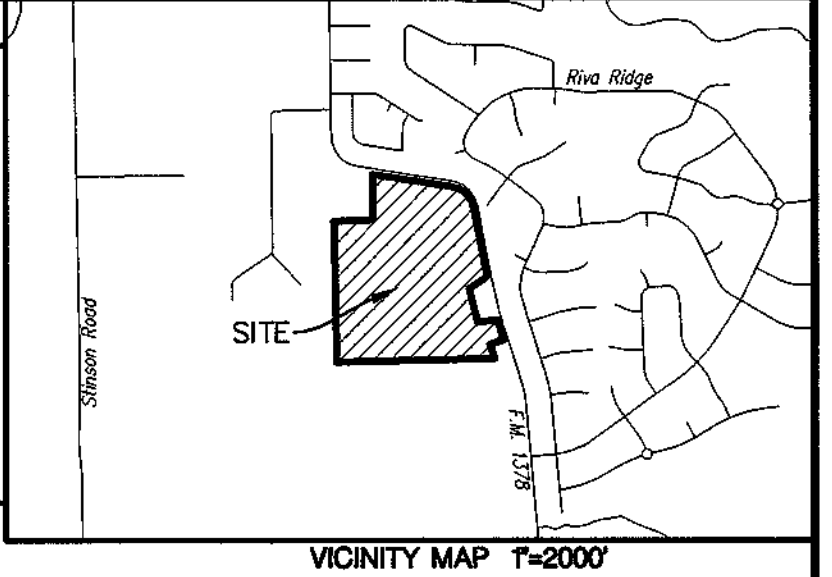

- NOTES:**
- Bearings based on the Texas Coordinate System, North Central Zone (4202), NAD '83.
 - Surveyor has made no investigation or independent search for easement of record, encumbrances, restrictive covenants, ownership title evidence, or any other facts that an accurate abstract of title may disclose.
 - No flood zone area analysis has been performed on the subject property by G&A Consultants.
 - According to Community/Panel No. 48085C0405J, effective May 6, 2009, of the FLOOD INSURANCE RATE MAP for Collin County, Texas & Incorporated Areas, by graphic plotting only, a portion of this property appears to be within Flood Zone "AE" (area within the 1% annual chance flood plain, with base flood elevations established). This flood statement does not imply that the property and/or the structures thereon will be free from flooding or flood damage. On rare occasions, greater floods can and will occur and flood heights may be increased by man-made or natural causes.
 - This flood statement shall not create liability on the part of the surveyor.
 - Lots or portions of lots within the floodplain or areas of special flood hazard require a development permit prior to issuance of a building permit or commencement of construction including site grading, on all or part of those lots.
 - No access to F.M. 1378 from any part of a lot shall be allowed.
 - Easement in favor of North Texas Municipal Water District, recorded in Volume 508, Page 126 is not for public use.
 - Drainage easements shall be maintained by the HOA

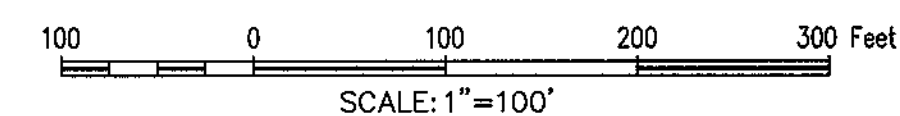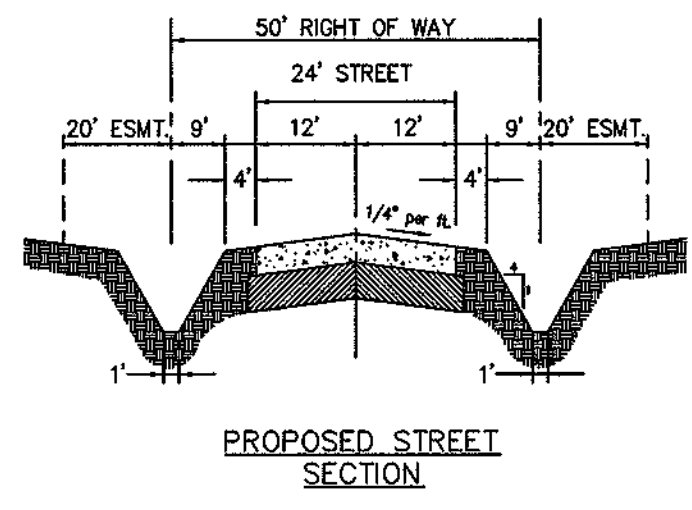

"PRELIMINARY PLAT- For Inspection Purposes Only"
LEWIS PARK ESTATES
PRELIMINARY PLAT
Lots 1-26, Block A
Lots 1-20, Block B
60.858 Acres
Zone R-H15
In the
JAMES ANDERSON SURVEY, ABSTRACT NO. 17
CITY OF LUCAS
COLLIN COUNTY, TEXAS

G&A CONSULTANTS, LLC
SITE PLANNING CIVIL ENGINEERING PLATTING
LAND SURVEYING LANDSCAPE ARCHITECTURE
111 Hillside Drive • Lewisville, TX 75057 • P: 972.436.9712 • F: 972.436.9715
610 Byron Nelson Blvd. Ste 114 • Roanoke, TX 76262 • P: 832.831.9712 • F: 817.890.4043
No. 10047700

1/2

TBPE Firm
No. 1798
TBPLS Firm
No. 10047700

DRAWN BY: DATE: 09/03/14 SCALE: 1"=100' JOB. No. **14026**

OWNER
CADD Lewis Park LLC
c/o Lenart Development Company, LLC
520 Central Parkway E.
Suite 104
Plano, TX 75074
Contact: Steve Lenart
(972) 422-8880

OWNER'S CERTIFICATE AND DEDICATION

STATE OF TEXAS :
COUNTY OF COLLIN : WHEREAS WE, CADG LEWIS PARK LLC, are the owners of property situated in the City of Lucas described as follows:
BEING all that certain lot, tract or parcel of land situated in the J. Anderson Survey, Abstract Number 17, in the City of Lucas, Collin County, Texas and part of those certain tracts of land described as Tracts I and II, in deed to Guardian Mortgage Company, Inc., as recorded in Document Number 20140131000092420 of the Deed Records of Collin County, Texas, and being all of that certain called 24.45 acre tract of land described in deed to Lewis-McWhirter, Ltd, recorded in Document Number 2005-160899 of the Deed Records of Collin County, Texas, and being more particularly described as follows:
BEGINNING at a 5/8" capped rebar found (Kimley Horn and Associates) at the southwest corner of said Tract I, and being an inner elle corner of that certain called 232.162 acre tract of land described in deed to CTMGT Lucas 238, LLC, recorded in Document Number 20130904001244240 of the Deed Records of Collin County, Texas;
THENCE N 00°32'10" W, 351.96 feet with the west line of said Tract I, and the east line of said 232.162 acre tract, to a 5/8" rebar found at the northeast corner thereof, and being the southeast corner of Brookhaven Ranch Estates, an addition to the City of Lucas, according to the plat thereof, recorded in Volume 26, Page 71 of the Plat Records of Collin County, Texas;
THENCE N 01°00'30" W, 478.04 feet with the west line of said Tract 1, and the east line of said Brookhaven Ranch Estates to a 3/8" rebar found at the northwest corner of said Tract 1, and being the southwest corner of said Tract 2;
THENCE N 01°15'55" W, 241.35 feet with the west line of said Tract 2, and the east line of said Brookhaven Ranch Estates, to a 1/2" rebar found;
THENCE N 01°25'45" W, 387.03 feet with the west line of said Tract 2, and the east line of said Brookhaven Ranch Estates, to a 1/2" rebar found at the westerly northwest corner of said Tract 2, and being the southwest corner of that certain called 3.00 acre tract of land described in deed to the City of Lucas, recorded in Volume 2170, Page 202 of the Deed Records of Collin County, Texas;
THENCE N 8°74'45" E, 407.01 feet, with the north line of said Tract 2, and the south line of said 3.00 acre tract, to the southeast corner thereof;
THENCE N 00°09'20" W, 470.74 feet, with the north line of said Tract 2, and the east line of said 3.00 acre tract, to a 1/2" rebar found at the most northerly northwest corner of said Tract 2, the northeast corner of said 3.00 acre tract, and being on the south line of F.M. Highway 1378;
THENCE S 81°10'35" E, with the north line of said Tract 2, and the south line of said F.M. Highway 1378, passing at 581.11 feet a 1/2" rebar found at the northeast corner of said Tract 2, and being the northwest corner of said 24.45 acre tract, continuing with the north line thereof, 836.31 feet to a 1/2" rebar found;
THENCE Southeasterly with east line of said 24.45 acre tract, and the west line of said F.M. Highway 1378, with the arc of a curve to the right, having a radius of 273.31 feet, a central angle of 89°53'35", an arc length of 333.40 feet, and whose chord bears S 46°13'48" E, 313.11 feet;
THENCE S 11°17'10" E, 722.68 feet, with the east line of said 24.45 acre tract, and the west line of F.M. Highway 1378, to the northeast corner of that certain tract of land described in deed to Roger L. Davis, recorded in Document Number 22070308000318040 of the Deed Records of Collin County, Texas;
THENCE S 56°27'50" W, 223.97 feet with the east line of said 24.45 acre tract, and the north line of said Davis tract, to the northwest corner thereof;
THENCE S 13°18'10" E, 363.98 feet with the east line of said 24.45 acre tract, and the west line of said Davis tract, to the southwest corner thereof;
THENCE N 82°23'15" E, 209.39 feet with the east line of said 24.45 acre tract, and the south line of said Davis tract, to the southeast corner thereof, being on the west line of F.M. Highway 1378;
THENCE Southeasterly with the east line of said 24.45 acre tract, and the west line of said F.M. Highway 1378, with the arc of a non-tangent curve to the left, having a radius of 2909.79 feet, a central angle of 00°38'41", an arc length of 32.74 feet, and whose chord bears S 17°17'56" E, 32.74 feet;
THENCE S 17°36'00" E, 190.00 feet with the east line of said 24.45 acre tract, and the west line of said F.M. Highway 1378, to the northeast corner of that certain tract of land described in deed to North Texas Municipal Water District, recorded in Volume 848, Page 774 of the Deed Records of Collin County, Texas;
THENCE S 72°41'30" W, 149.75 feet with the east line of said 24.45 acre tract, and the north line of said North Texas Municipal Water District tract, to the northwest corner thereof;
THENCE S 17°36'50" E, 156.53 feet with the east line of said 24.45 acre tract, and the west line of said North Texas Municipal Water District tract, to a 5/8" capped rebar found (Sparr Surveys) at the southwest corner thereof, and being the southeast corner of said 24.45 acre tract, and being on the north line of that certain called 60.000 acre tract of land described in deed to Wylie Independent School District, recorded in Document Number 20090625000794570 of the Deed Records of Collin County, Texas;
THENCE S 88°47'00" W, 726.31 feet with the south line of said 24.45 acre tract, and the north line of said 60.000 acre tract, to a 1/2" rebar found at the southwest corner of said 24.45 acre tract, and being the southeast corner of said Tract I;
THENCE S 88°48'10" W, 649.63 feet, with the south line of said Tract I, and the north line of said 60.00 acre tract, to a 5/8" capped rebar found (Kimley Horn and Associates) at the northwest corner thereof, and being the easterly northeast corner of said 232.162 acre tract;
THENCE S 88°49'35" W, 273.28 feet with the south line of said Tract I, and a north line of said 232.162 acre tract, to the POINT OF BEGINNING and containing approximately 60.858 acres of land.

NOW, THEREFORE, KNOW ALL MEN BY THESE PRESENTS: THAT WE, CADG LEWIS PARK LLC, acting herein by and through its duly authorized representatives, do hereby adopt this preliminary plat designating the hereinabove described tract as LEWIS PARK ESTATES, an addition to the City of Lucas, Collin County, Texas, and do hereby dedicate to the public use forever the streets, alleys, and right-of-ways as shown thereon, and do hereby reserve the easement strips shown on this plat for the mutual use and accommodation of garbage collection agencies and all public utilities desiring to use or using same. Any public utility shall have the right to remove and keep removed all or part of any buildings, fences, trees, shrubs, or other improvements or growths that in any way endanger or interfere with the construction, maintenance or efficiency of its respective systems on any of these easement strips, and any public utility shall at all times have the right of ingress and egress to and from and upon the said easement strips for the purpose of constructing, reconstructing, inspecting, patrolling, without the necessity at any time of procuring the permission of anyone. Additionally, we, CADG LEWIS PARK LLC, are the sole owners of the dedicated property and that no other's interest are attached to this property unless otherwise indicated on the required Mortgage Holder Certification that is included on this plat. This plat approved subject to all platting ordinances, rules, regulations, and resolution of the City of Lucas, Texas.

WITNESS MY HAND this _____ day of _____, 2014.

Authorized Representative
CADG LEWIS PARK LLC

STATE OF TEXAS :
COUNTY OF _____ : BEFORE ME, THE UNDERSIGNED AUTHORITY, personally appeared _____, known to me to be the person whose name is subscribed to the foregoing instrument and acknowledged that he executed the same for the purpose and consideration therein expressed and in the capacity therein stated.

GIVEN UNDER MY HAND AND SEAL OF OFFICE this _____ day of _____, 2012.

Notary Public State of Texas

My commission expires the _____ day of _____, _____.

MORTGAGE HOLDER CERTIFICATION

THAT I, _____, hold a mortgage or represent holders of a mortgage on the described property herein, do hereby consent to the submission and filing of this plat designating the hereinabove described property as LEWIS PARK ESTATES, an addition to the City of Lucas, Texas, do hereby dedicate to the public use forever the streets, alleys, and right-of-ways as shown thereon, and do hereby reserve the easement strips shown on this plat for the mutual use and accommodation of garbage collection agencies and all public utilities desiring to use or using same. Any public utility shall have the right to remove and keep removed all or part of any buildings, fences, trees, shrubs, or other improvements or growths that in any way endanger or interfere with the construction, maintenance or efficiency of its respective systems on any of these easement strips, and any public utility shall at all times have the right of ingress and egress to and from and upon the said easement strips for the purpose of constructing, reconstructing, inspecting, patrolling, without the necessity at any time of procuring the permission of anyone. This plat approved subject to all platting ordinances, rules, regulations, and resolution of the City of Lucas, Texas.

WITNESS OUR HAND this _____ day of _____, 2014.

Authorized Representative

Title

CITY APPROVAL CERTIFICATE

This plat is hereby approved by the Planning and Zoning Commission of the City of Lucas, Texas

Chairman, Planning and Zoning Commission Date _____

ATTEST:

Signature _____ Date _____

Name & Title

The Director of Public Works of the City of Lucas, Texas hereby certifies that to the best of his/her knowledge or belief, this subdivision plat conforms to all requirements of the Code of Ordinances and with engineering construction standards and processes adopted by the City of Lucas, Texas as to which his/her approval is required.

Director of Public Works Date _____

The Director of Planning and Community Development of the City of Lucas, Texas hereby certifies that to the best of his/her knowledge or belief, this subdivision plat conforms to all requirements of the Code of Ordinances, or as may have been amended or modifies, as allowed, by the Planning and Zoning Commission as to which his/her approval is required.

Director of Planning and Community Development Date _____

LEGEND

P.O.B. = POINT OF BEGINNING
RF = REBAR FOUND
CRS = CAPPED REBAR SET
BL = BUILDING LINE
CRF = CAPPED REBAR FOUND
G&A = G&A CONSULTANTS, LLC.
PRCCT = PLAT RECORDS, COLLIN COUNTY, TEXAS
RPRCCT = REAL PROPERTY RECORDS COLLIN COUNTY, TEXAS
SSE = SANITARY SEWER EASEMENT
WLE = WATER LINE EASEMENT
PAE = PEDESTRIAN EASEMENT
UE = UTILITY EASEMENT
DE = DRAINAGE EASEMENT
DUE = DRAINAGE & UTILITY EASEMENT
NTMWD = NORTH TEXAS MUNICIPAL WATER DISTRICT
= OVERHEAD POWER
= DENOTES STREET NAME CHANGE

VICINITY MAP T-20007

LOT / BLOCK ANALYSIS

LOT	BLOCK	SQUARE FEET	ACRES
1	BLOCK A	70,904	1.628
2	BLOCK A	65,368	1.501
3	BLOCK A	65,696	1.508
4	BLOCK A	65,396	1.501
5	BLOCK A	65,378	1.501
6	BLOCK A	65,657	1.507
7	BLOCK A	76,836	1.764
8	BLOCK A	65,369	1.501
9	BLOCK A	65,341	1.500
10	BLOCK A	65,472	1.503
11	BLOCK A	65,341	1.500
12	BLOCK A	65,403	1.501
13	BLOCK A	65,340	1.500
14	BLOCK A	66,088	1.517
15	BLOCK A	66,313	1.522
16	BLOCK A	69,837	1.603

LOT / BLOCK ANALYSIS

LOT	BLOCK	SQUARE FEET	ACRES
1	BLOCK B	65,353	1.500
2	BLOCK B	65,590	1.506
3	BLOCK B	77,367	1.776
4	BLOCK B	66,119	1.518
5	BLOCK B	65,513	1.504
6	BLOCK B	65,599	1.506
7	BLOCK B	65,682	1.508
8	BLOCK B	74,340	1.707
9	BLOCK B	70,567	1.620
10	BLOCK B	65,340	1.500
11	BLOCK B	65,340	1.500
12	BLOCK B	65,983	1.515
13	BLOCK B	65,162	1.519
14	BLOCK B	65,377	1.501
15	BLOCK B	65,356	1.500
16	BLOCK B	65,366	1.501
17	BLOCK B	65,361	1.500
18	BLOCK B	65,344	1.500
19	BLOCK B	65,389	1.501
20	BLOCK B	70,448	1.617

CURVE TABLE

CURVE	RADIUS	DELTA ANGLE	ARC LENGTH	LONG CHORD
C1	300.00'	18°57'16"	99.24'	S 88°06'22" E, 98.79'
C2	300.00'	112°2'16"	59.54'	N 84°18'52" W, 59.44'

LINE TABLE

LINE	BEARING	DISTANCE
L1	N 45°00'00" W	21.21'
L2	S 45°00'00" E	21.21'
L3	N 45°00'00" E	21.21'
L4	N 00°00'00" E	19.69'
L5	N 88°37'30" W	5.81'
L6	N 01°22'30" E	58.34'
L16	N 46°14'55" E	35.73'
L17	N 18°03'20" E	23.69'
L18	N 15°05'30" W	20.92'
L19	N 30°12'35" W	27.28'
L20	N 11°31'30" W	103.64'

SURVEYOR'S STATEMENT

I, Mark Paine, a Registered Professional Surveyor in the State of Texas, have prepared this plat of the above property from an actual survey of the ground and buildings, etc., and certify that survey made by me or under my supervision.

STATE OF TEXAS :
COUNTY OF DENTON : BEFORE ME, THE UNDERSIGNED AUTHORITY, personally appeared Mark Paine, known to me to be the person whose name is subscribed to the foregoing instrument and acknowledged that he executed the same for the purpose and consideration therein expressed and in the capacity therein stated.

GIVEN UNDER MY HAND AND SEAL OF OFFICE this _____ day of _____, 2014.

Notary Public
State of Texas

My commission expires the _____ day of _____, _____.

"PRELIMINARY PLAT- For Inspection Purposes Only"

LEWIS PARK ESTATES

PRELIMINARY PLAT

Lots 1-16, Block A

Lots 1-20, Block B

60.858 Acres

Zoned R15

in the
JAMES ANDERSON SURVEY, ABSTRACT NO. 17
CITY OF LUCAS
COLLIN COUNTY, TEXAS





SITE PLANNING CIVIL ENGINEERING PLATTING
CONSULTANTS, LLC
LAND SURVEYING LANDSCAPE ARCHITECTURE

111 Hillside Drive • Lewisville, TX 75057 • P: 972.436.9712 • F: 972.436.9715
610 Byron Nelson Blvd, Ste 114 • Roanoke, TX 76262 • P: 662.831.9712 • F: 817.890.4043 No. 10047700

2/2

DRAWN BY: DATE: 8/16/14 SCALE: 1"=100' JOB. No. **14026**

OWNER
CADG Lewis Park LLC
c/o Lenart Development Company, LLC
520 Central Parkway E.
Suite 104
Plano, TX 75074
Contact: Steve Lenart
(972) 422-8880

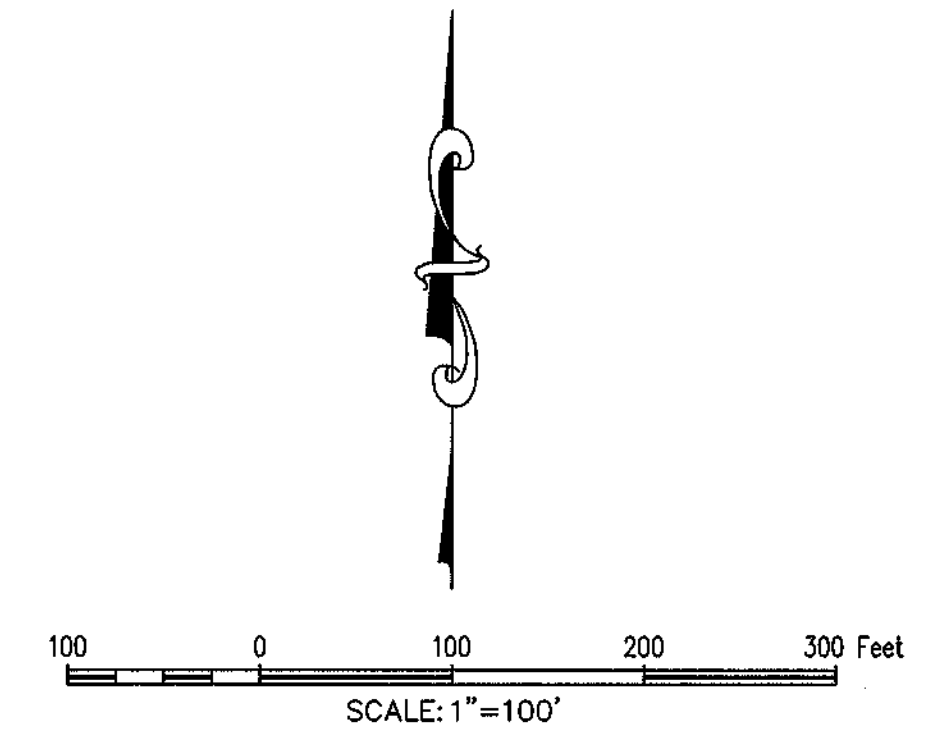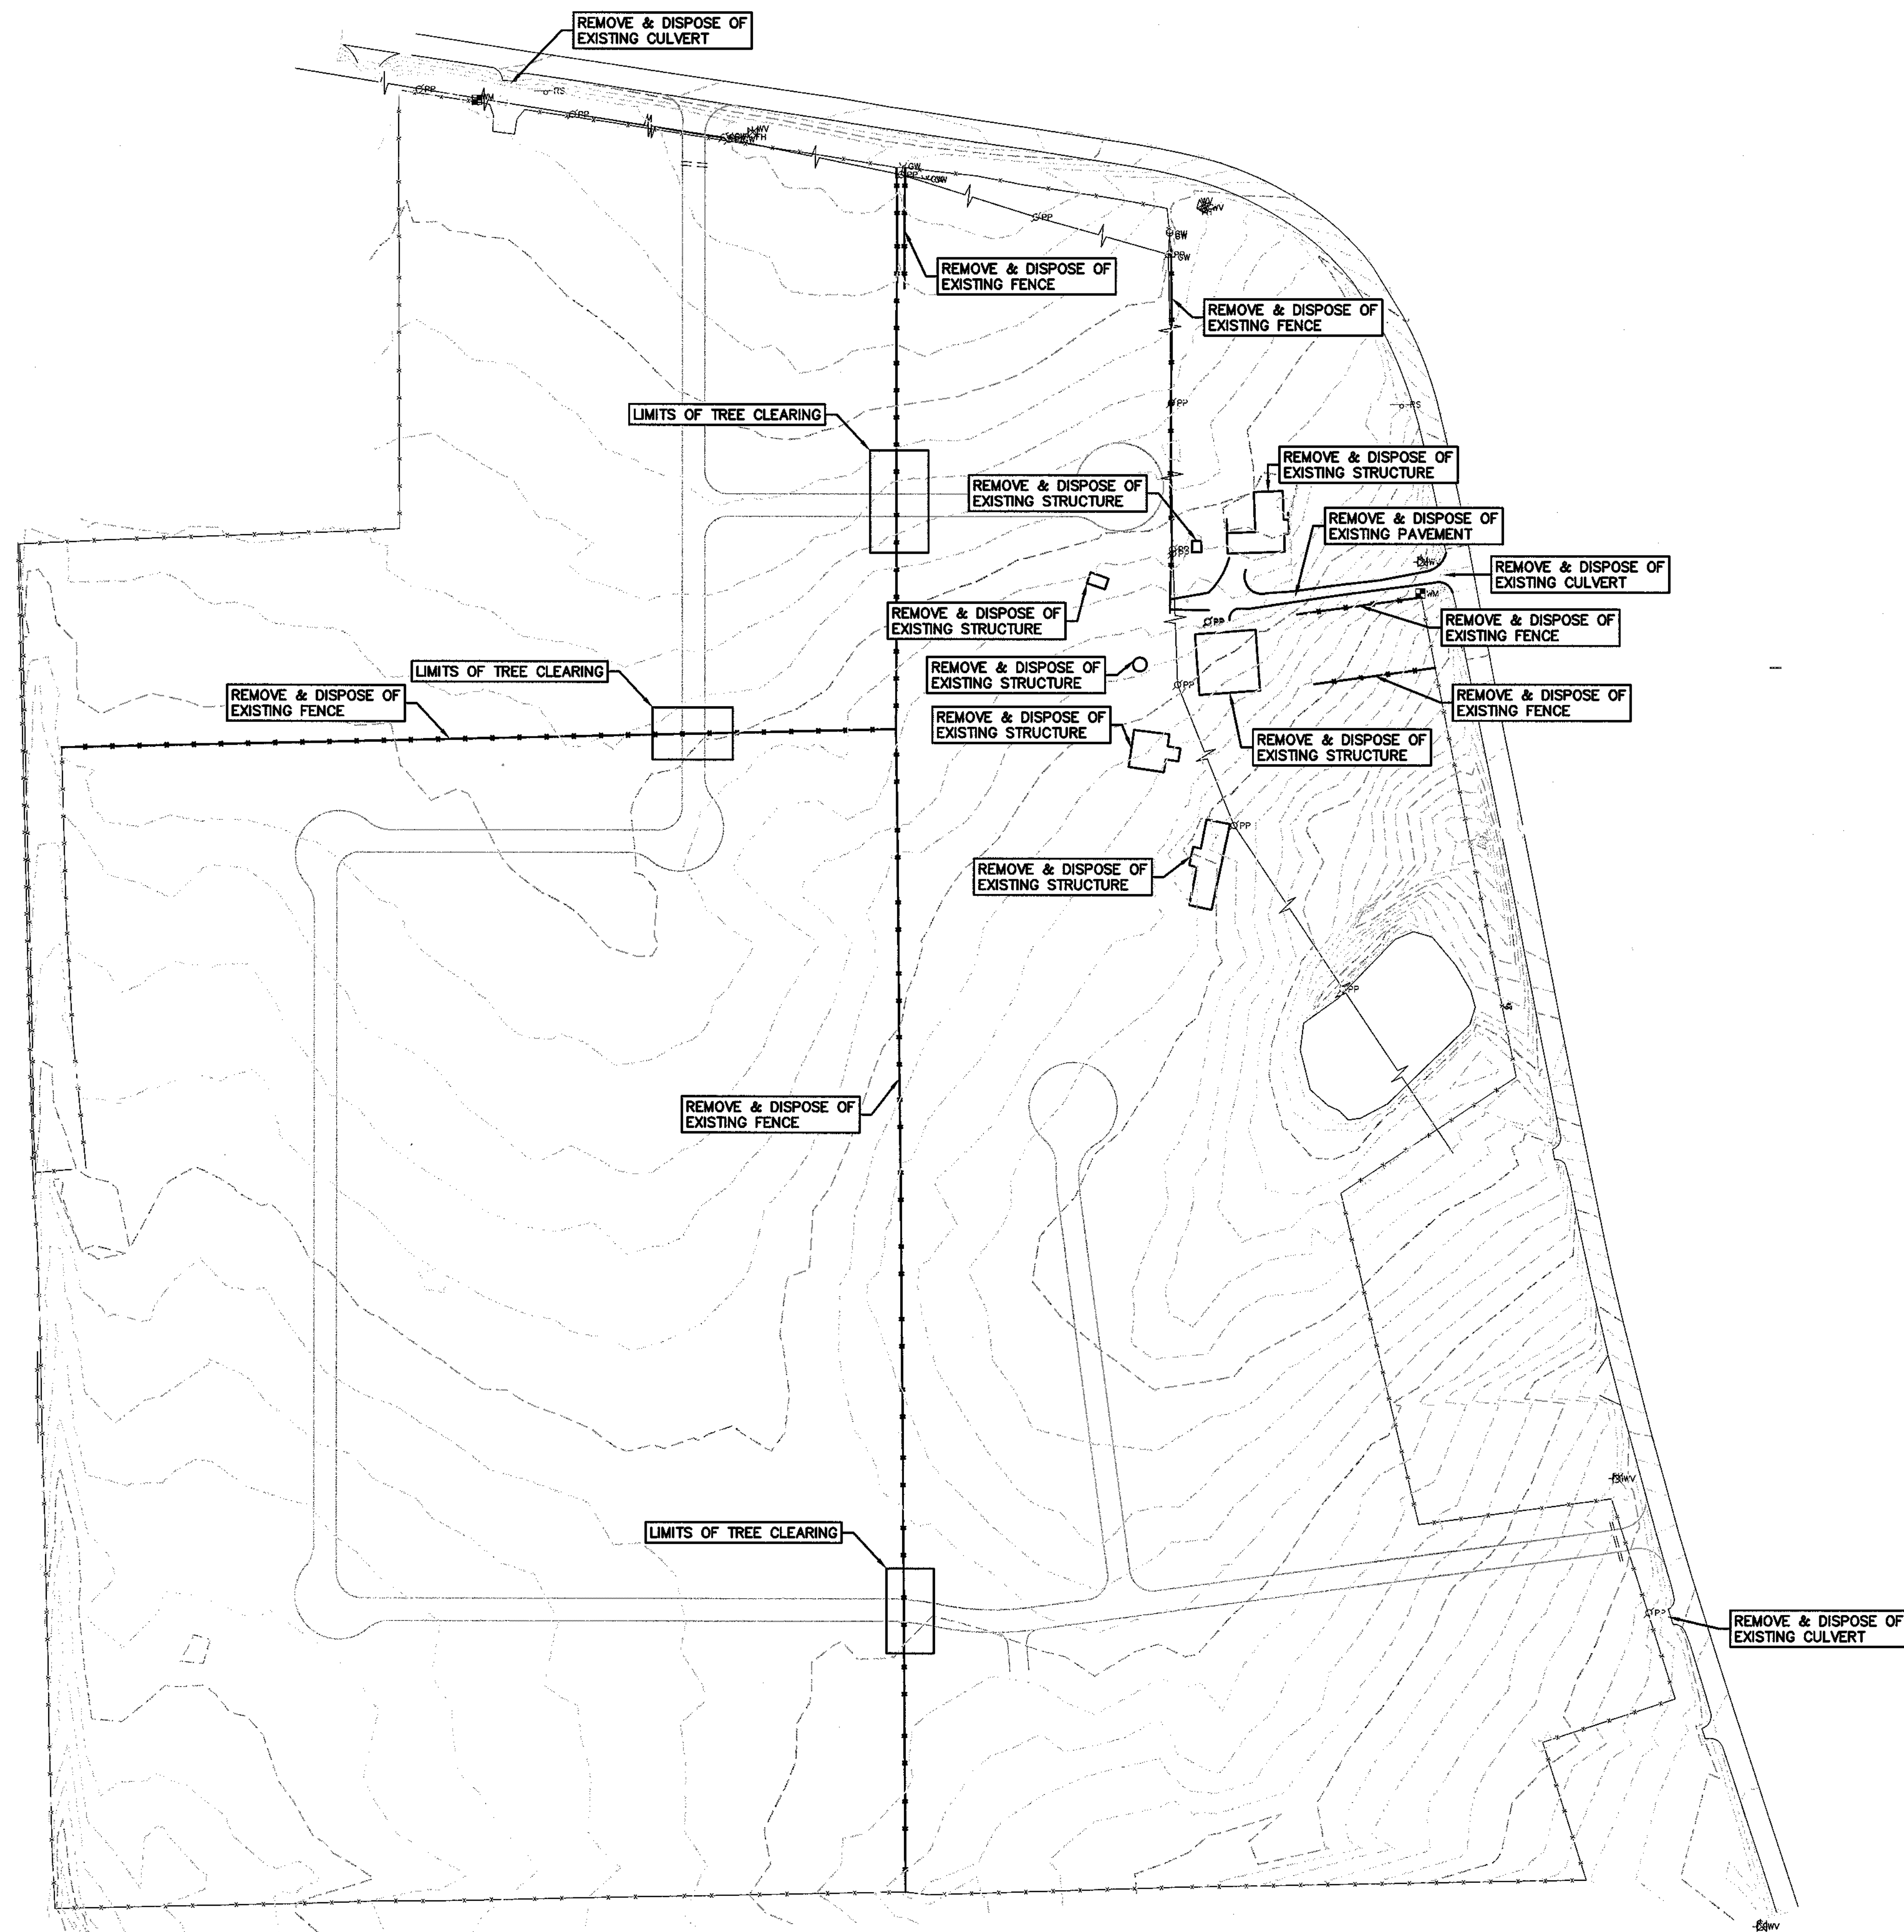

BENCHMARKS:

BM#1 ~ RM133 ~ 590.08'
Square cut on east headwall of west of bridge at White Rock Creek (East) and FM 1378. Map# 40805C04550, Dated January 19th, 1996.

TBM#2 ~ Square Cut ~ 569.45'
~981' Southwest from the Northwest corner of subject property on south edge of Brookhaven Dr.
N=7,079,521.1' E=2,557,109.8

TBM#3 ~ "X" ~ 579.96'
~760' Northeast from the Northwest corner of subject property near the Intersection of Conner Ln. & Chapel Ct.
N=7,080,175.7' E=2,556,146.1

TBM#4 ~ PK Nail ~ 554.84'
~900' Northeast from the Northeast corner of subject property at the south edge of a cul-de-sac on Alameda Cir.
N=7,079,803.4' E=2,559,558.0

TBM#5 ~ "X" ~ 584.19'
~1040' Southeast from the southeast corner of subject property on headwall on north side of the intersection of FM 1378 & Seis Lagos Trail.
N=7,076,565.3' E=2,559,653.8'

LEGEND

C.R.F.	Capped Rebar Found		Overhead Power Lines
C.R.S.	Capped Rebar Set		Down Guy Wire
C.M.	Control Monument		Existing Contours
Mon.	Monument		Proposed Contours
BM	Benchmark		Concrete Pavement
FH	Fire Hydrant		Asphalt Pavement
WM	Water Meter		Wood Fence
WV	Water Valve		Chain Link Fence
W/L	Water Line		Wire Fence
ICV	Irrigation Control Valve		Masonry Wall
SSMH	Sanitary Sewer Manhole		Existing Tree
CO	Sanitary Sewer Cleanout		(FL) Flowline
UP	Utility Pole		Centerline of Creek, Swale, or Waterway
LP	Light Pole		Creek, Swale, or Waterway Embankment
TC	Top of Curb		
TP	Top of Pavement		
TW	Top of Wall		
FG	Finished Grade		
U.E.	Utility Easement		
D.E.	Drainage Easement		
B.L.	Building Line		
R.O.W.	Right-of-Way		
D.R.	Deed Records		
P.R.	Plat Records		

GENERAL NOTES

1. THE CITY OF LUCAS CONSTRUCTION STANDARDS APPLY WHETHER INDICATED ON THESE PLANS OR NOT.

**AS-BUILT
RECORD DRAWING**

THE INFORMATION ON THESE PLANS HAS BEEN REVISED TO REFLECT CHANGES TO PUBLIC IMPROVEMENTS MADE DURING CONSTRUCTION PROVIDED TO ENGINEER BY THE CONTRACTOR. UNLESS OTHERWISE NOTED, THE CONSTRUCTION OF THE IMPROVEMENTS IS IN GENERAL CONFORMANCE WITH THE SPECIFICATIONS BASED UPON INFORMATION PROVIDED BY THE CONTRACTOR. THE RESPONSIBILITY FOR ACCURACY AND COMPLETENESS OF THE INFORMATION IS TO THE CONTRACTOR.

Douglas W. Weaver
G & A Consultants, LLC.

Date: 11/23/2015

Date: 11/23/2015

OWNER/DEVELOPER
CADG LEWIS PARK LLC
C/O LENART DEVELOPMENT COMPANY,
LLC
520 CENTRAL PARKWAY E SUITE 104
PLANO, TX 75074
Ph. (972) 422-9880
Contact: Steve Lenart

G&A

STEPHEN CIVIL ENGINEERING PLATTING
CONSULTANTS, LLC
LAND SURVEYING LANDSCAPE ARCHITECTURE

111 Hildes Drive • Lewisville, TX 75057 • P: 972.438.9712 • F: 972.438.9715
810 Byron Nelson Blvd. Ste 1114 • Houston, TX 76622 • P: 862.231.9712 • F: 817.860.4043
TBPUS Firm No. 10047700
TBPUS Firm No. 1788

LEWIS PARK ESTATES
Lot 1-16, 1-20, Block A, B
LEWIS PARK ESTATES
60.858 Acres
in the
JAMES ANDERSON SURVEY, ABSTRACT N
CITY OF LUCAS
COLLIN COUNTY, TEXAS

DEMOLITION PLAN



STATE OF TEXAS
DOUGLAS W. WEAVER
117386
LICENSED PROFESSIONAL ENGINEER

G&A CONSULTANTS, LLC.
TBPE F-1798

Drawn By: TJF
Date: 11/07/2014
Scale: 1" = 100'
Revisions:

4026


4)

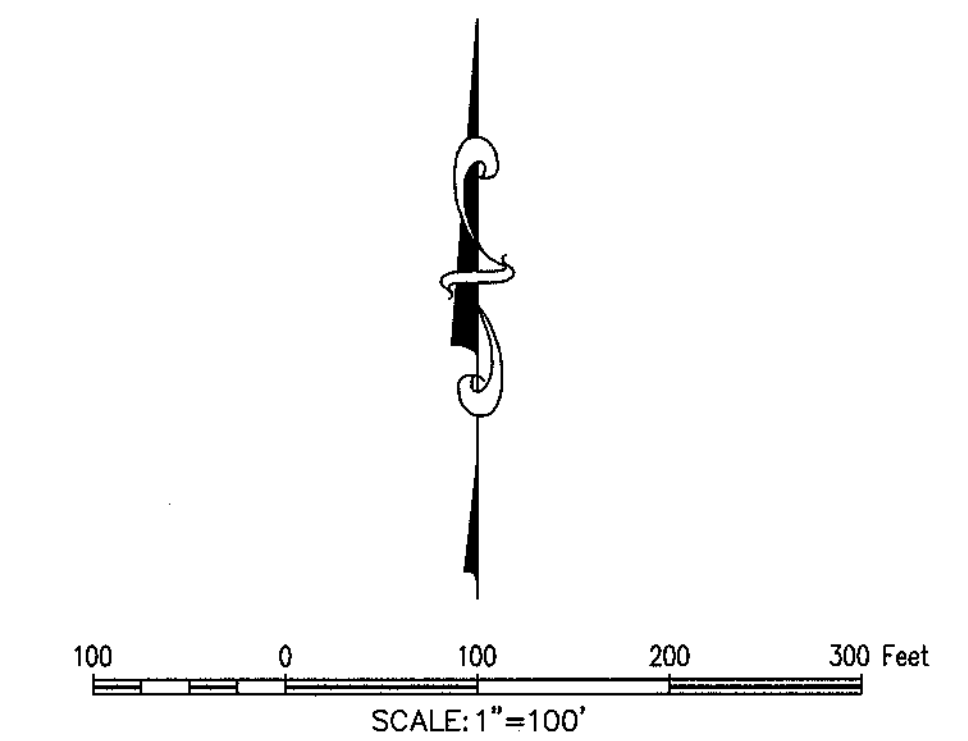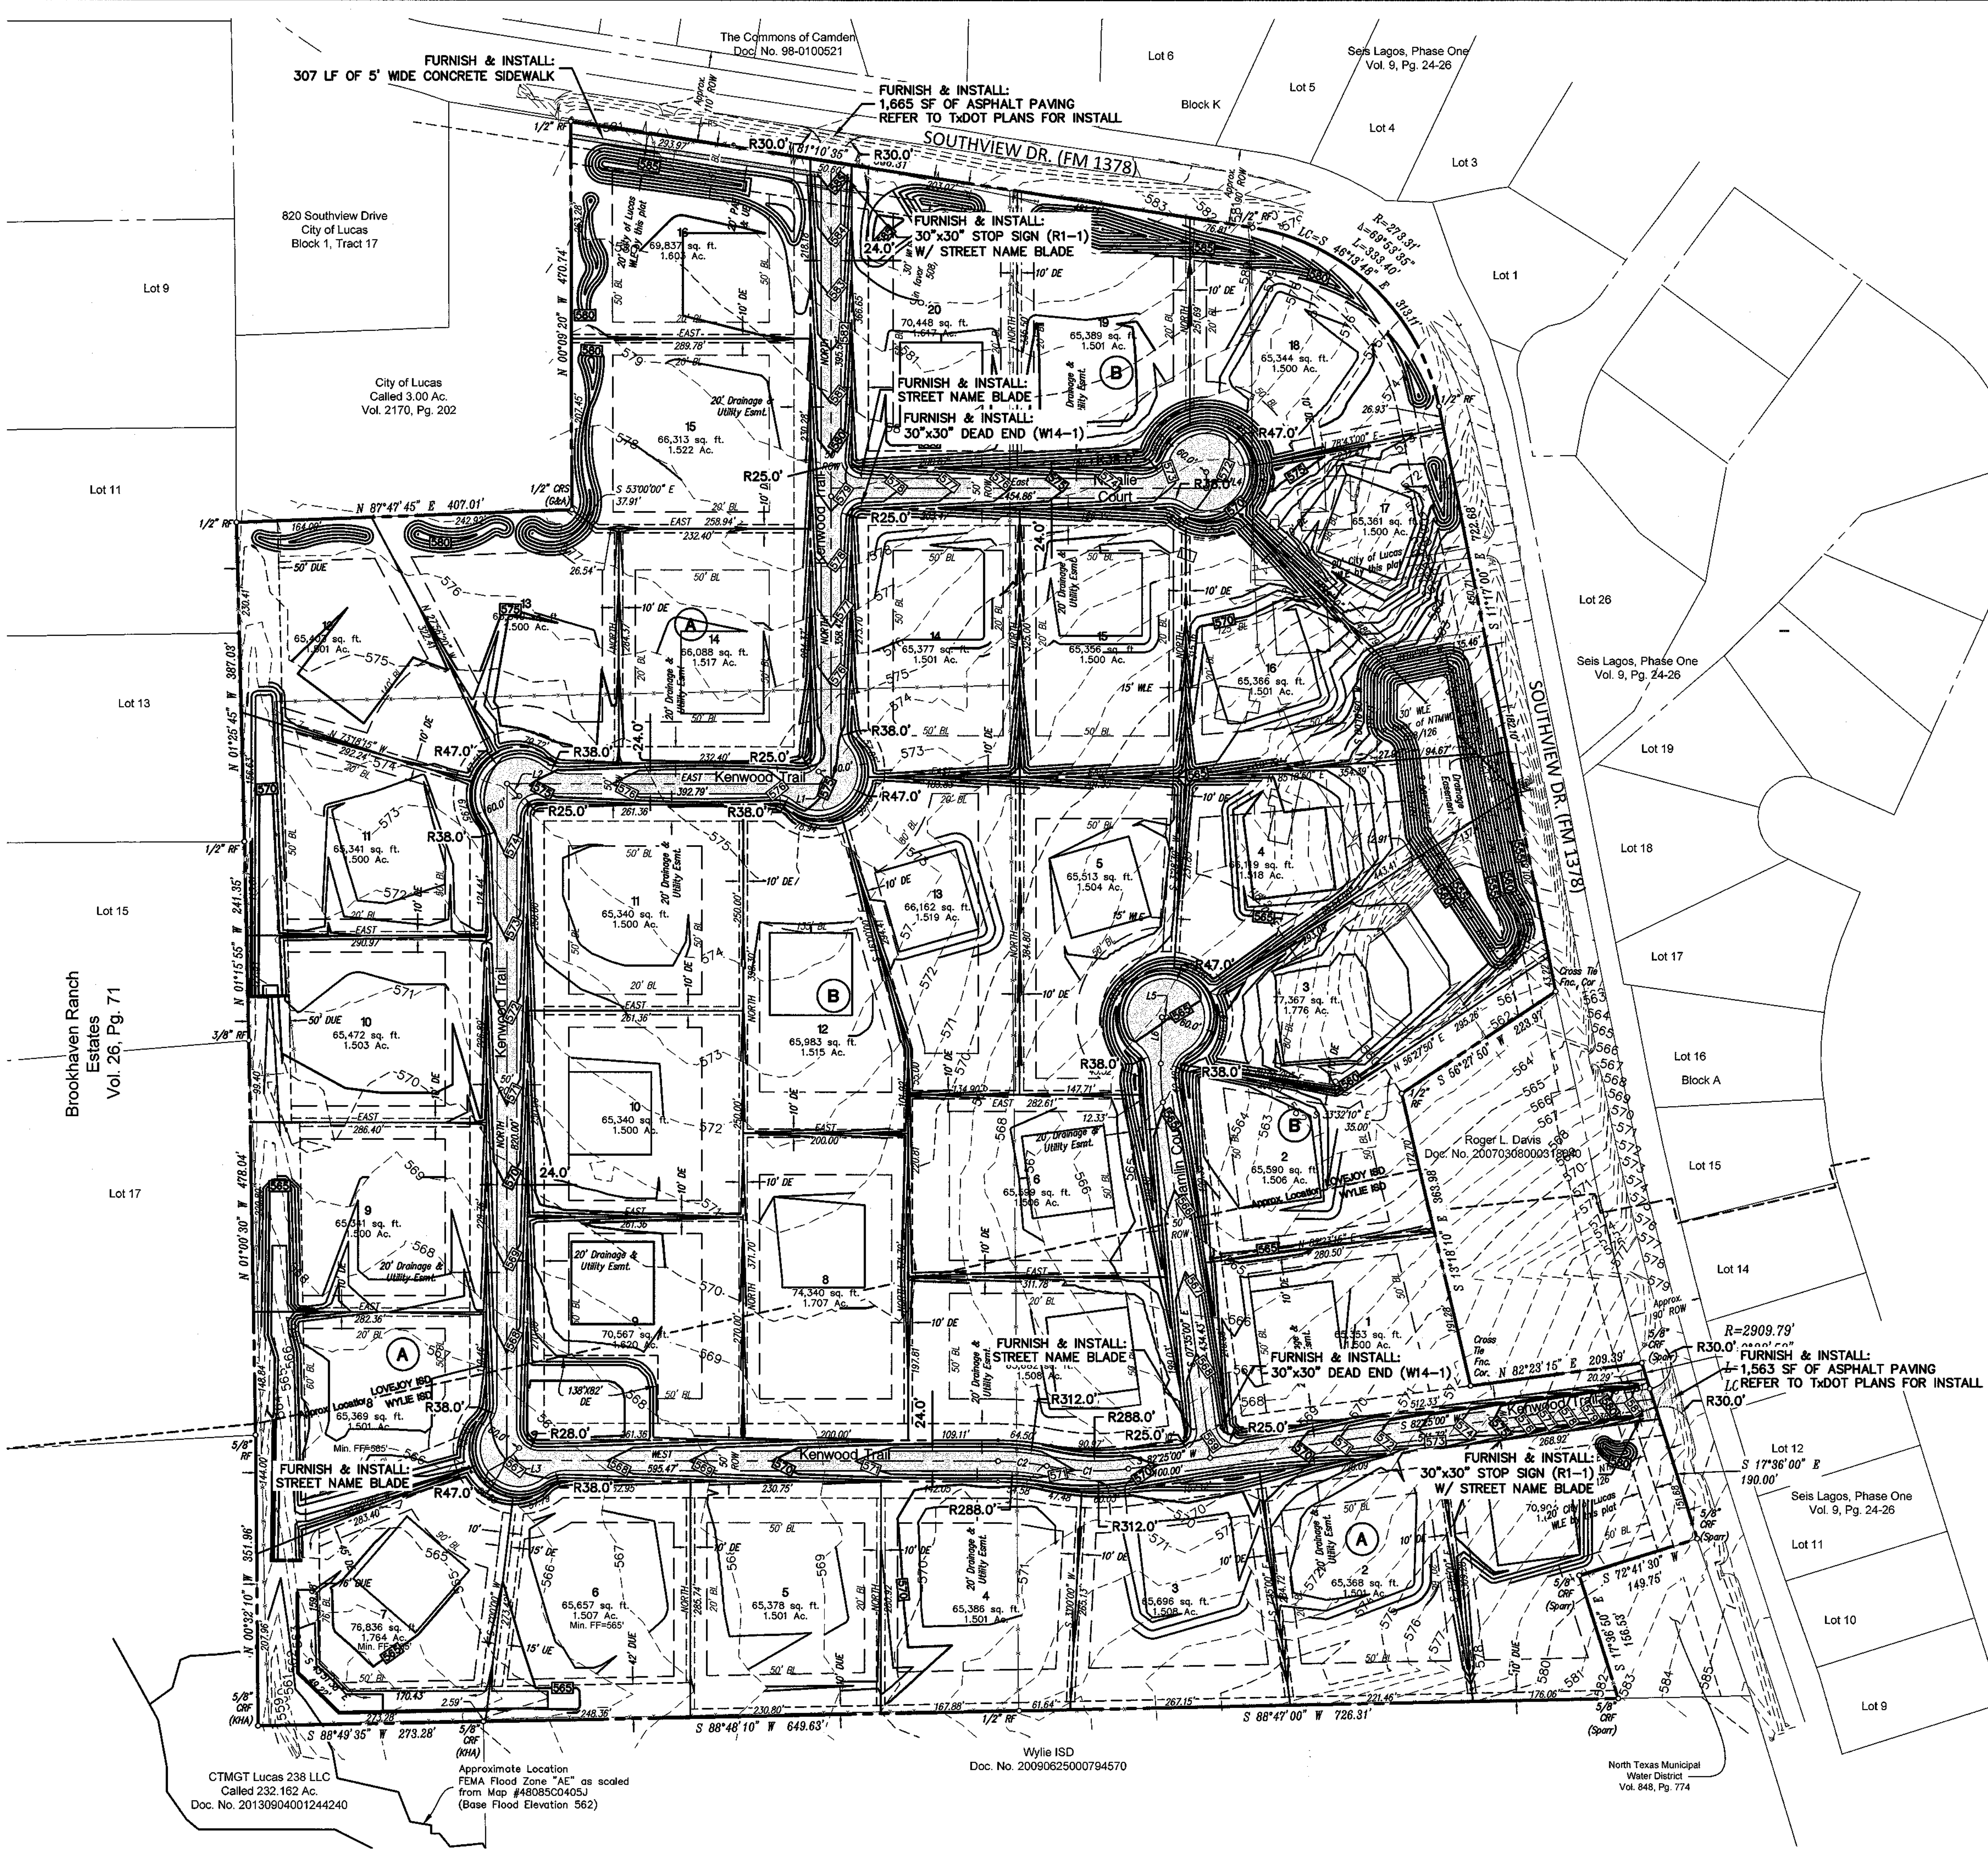

- BENCHMARKS:**
- BM#1 - RM133 - 590.08'
Square cut on east headwall of west of bridge at White Rock Creek (East) and FM 1378. Map# 48085C0455G, Dated January 19th, 1996.
 - TBM#2 - Square Cut - 569.45'
~981' Southwest from the Northwest corner of subject property on south edge of Brookhaven Dr.
N=7,079,521.1' E=2,557,109.8'
 - TBM#3 - "X" - 579.96'
~760' Northeast from the Northwest corner of subject property near the intersection of Corner Ln. & Chapel Ct.
N=7,080,175.7' E=2,558,146.1'
 - TBM#4 - PK Nail - 554.84'
~900' Northeast from the Northeast corner of subject property at the south edge of a cul-de-sac on Alameda Cir.
N=7,079,803.4' E=2,559,558.0'
 - TBM#5 - "X" - 584.19'
~1040' Southeast from the southeast corner of subject property on a headwall on the north side of the intersection of FM 1378 & Seis Lagos Trail.
N=7,076,568.5' E=2,559,653.8'

- GENERAL NOTES:**
- THE CITY OF LUCAS CONSTRUCTION STANDARDS APPLY WHETHER INDICATED ON THESE PLANS OR NOT.
 - ALL SIGNAGE WITHIN TXDOT ROW SHALL MEET TXDOT STANDARDS.

- PAVING SPECIFICATIONS:**
- CONCRETE ROAD:**
6" 3,600 PSI CONC. PAVEMENT W/ #3 BARS
@ 18" O.C.E.W. ON 6" STABILIZED SUBGRADE OR APPROVED EQUAL
 - ASPHALT PAVEMENT AREA:**
REFER TO TXDOT PLANS.

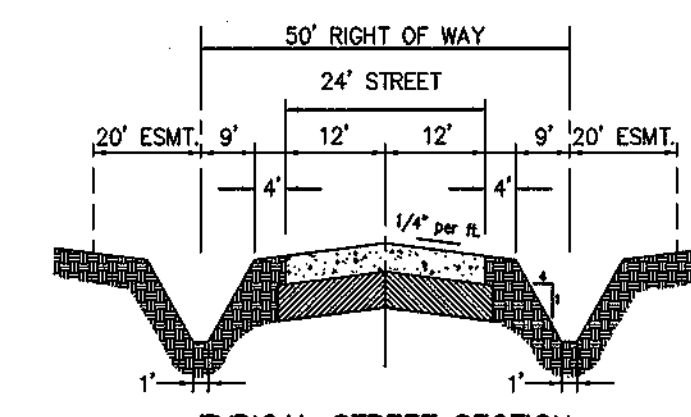

**AS-BUILT
RECORD DRAWING**

THE INFORMATION ON THESE PLANS HAS BEEN REVISED TO REFLECT CHANGES TO PUBLIC IMPROVEMENTS MADE DURING CONSTRUCTION PROVIDED TO ENGINEER BY THE CONTRACTOR. UNLESS OTHERWISE NOTED, THE CONSTRUCTION OF THE PUBLIC IMPROVEMENTS IS IN GENERAL CONFORMANCE WITH THE BASED UPON INFORMATION PROVIDED BY THE CONTRACTOR, AND THE RESPONSIBILITY FOR ACCURACY AND COMPLETENESS BELONGS TO THE CONTRACTOR.

Douglas W. Weaver
G & A Consultants, LLC.
Date: 11/23/2015

CONSULTANTS, LLC
SITE PLANNING CIVIL ENGINEERING PLATTING
LAND SURVEYING LANDSCAPE ARCHITECTURE

117 Hildale Drive • Lewisville, TX 76047 • P: 972.438.9712 • F: 972.438.9715
610 Byron Nelson Blvd. Ste 14 • Ft. Worth, TX 76104 • P: 817.880.4443
TBPES Firm No. 1798

LEWIS PARK ESTATES
Lot 1-16, 1-20, Block A & B
LEWIS PARK ESTATES
60.858 Acres
in the
JAMES ANDERSON SURVEY, ABSTRACT NO. 17
CITY OF LUCAS
COLLIN COUNTY, TEXAS

**PAVING, LIGHTING &
SIGNAGE PLAN**


G&A CONSULTANTS, LLC
TBPES F-1798

Drawn By: JTB
Date: 11/07/2014
Scale: 1" = 100'
Revisions:

14026


C5

OWNER/DEVELOPER
CADG LEWIS PARK LLC
C/O LENART DEVELOPMENT COMPANY, LLC
520 CENTRAL PARKWAY E. SUITE 104
PLANO, TX 75074
Ph: (972) 422-9880
Contact: Steve Lenart

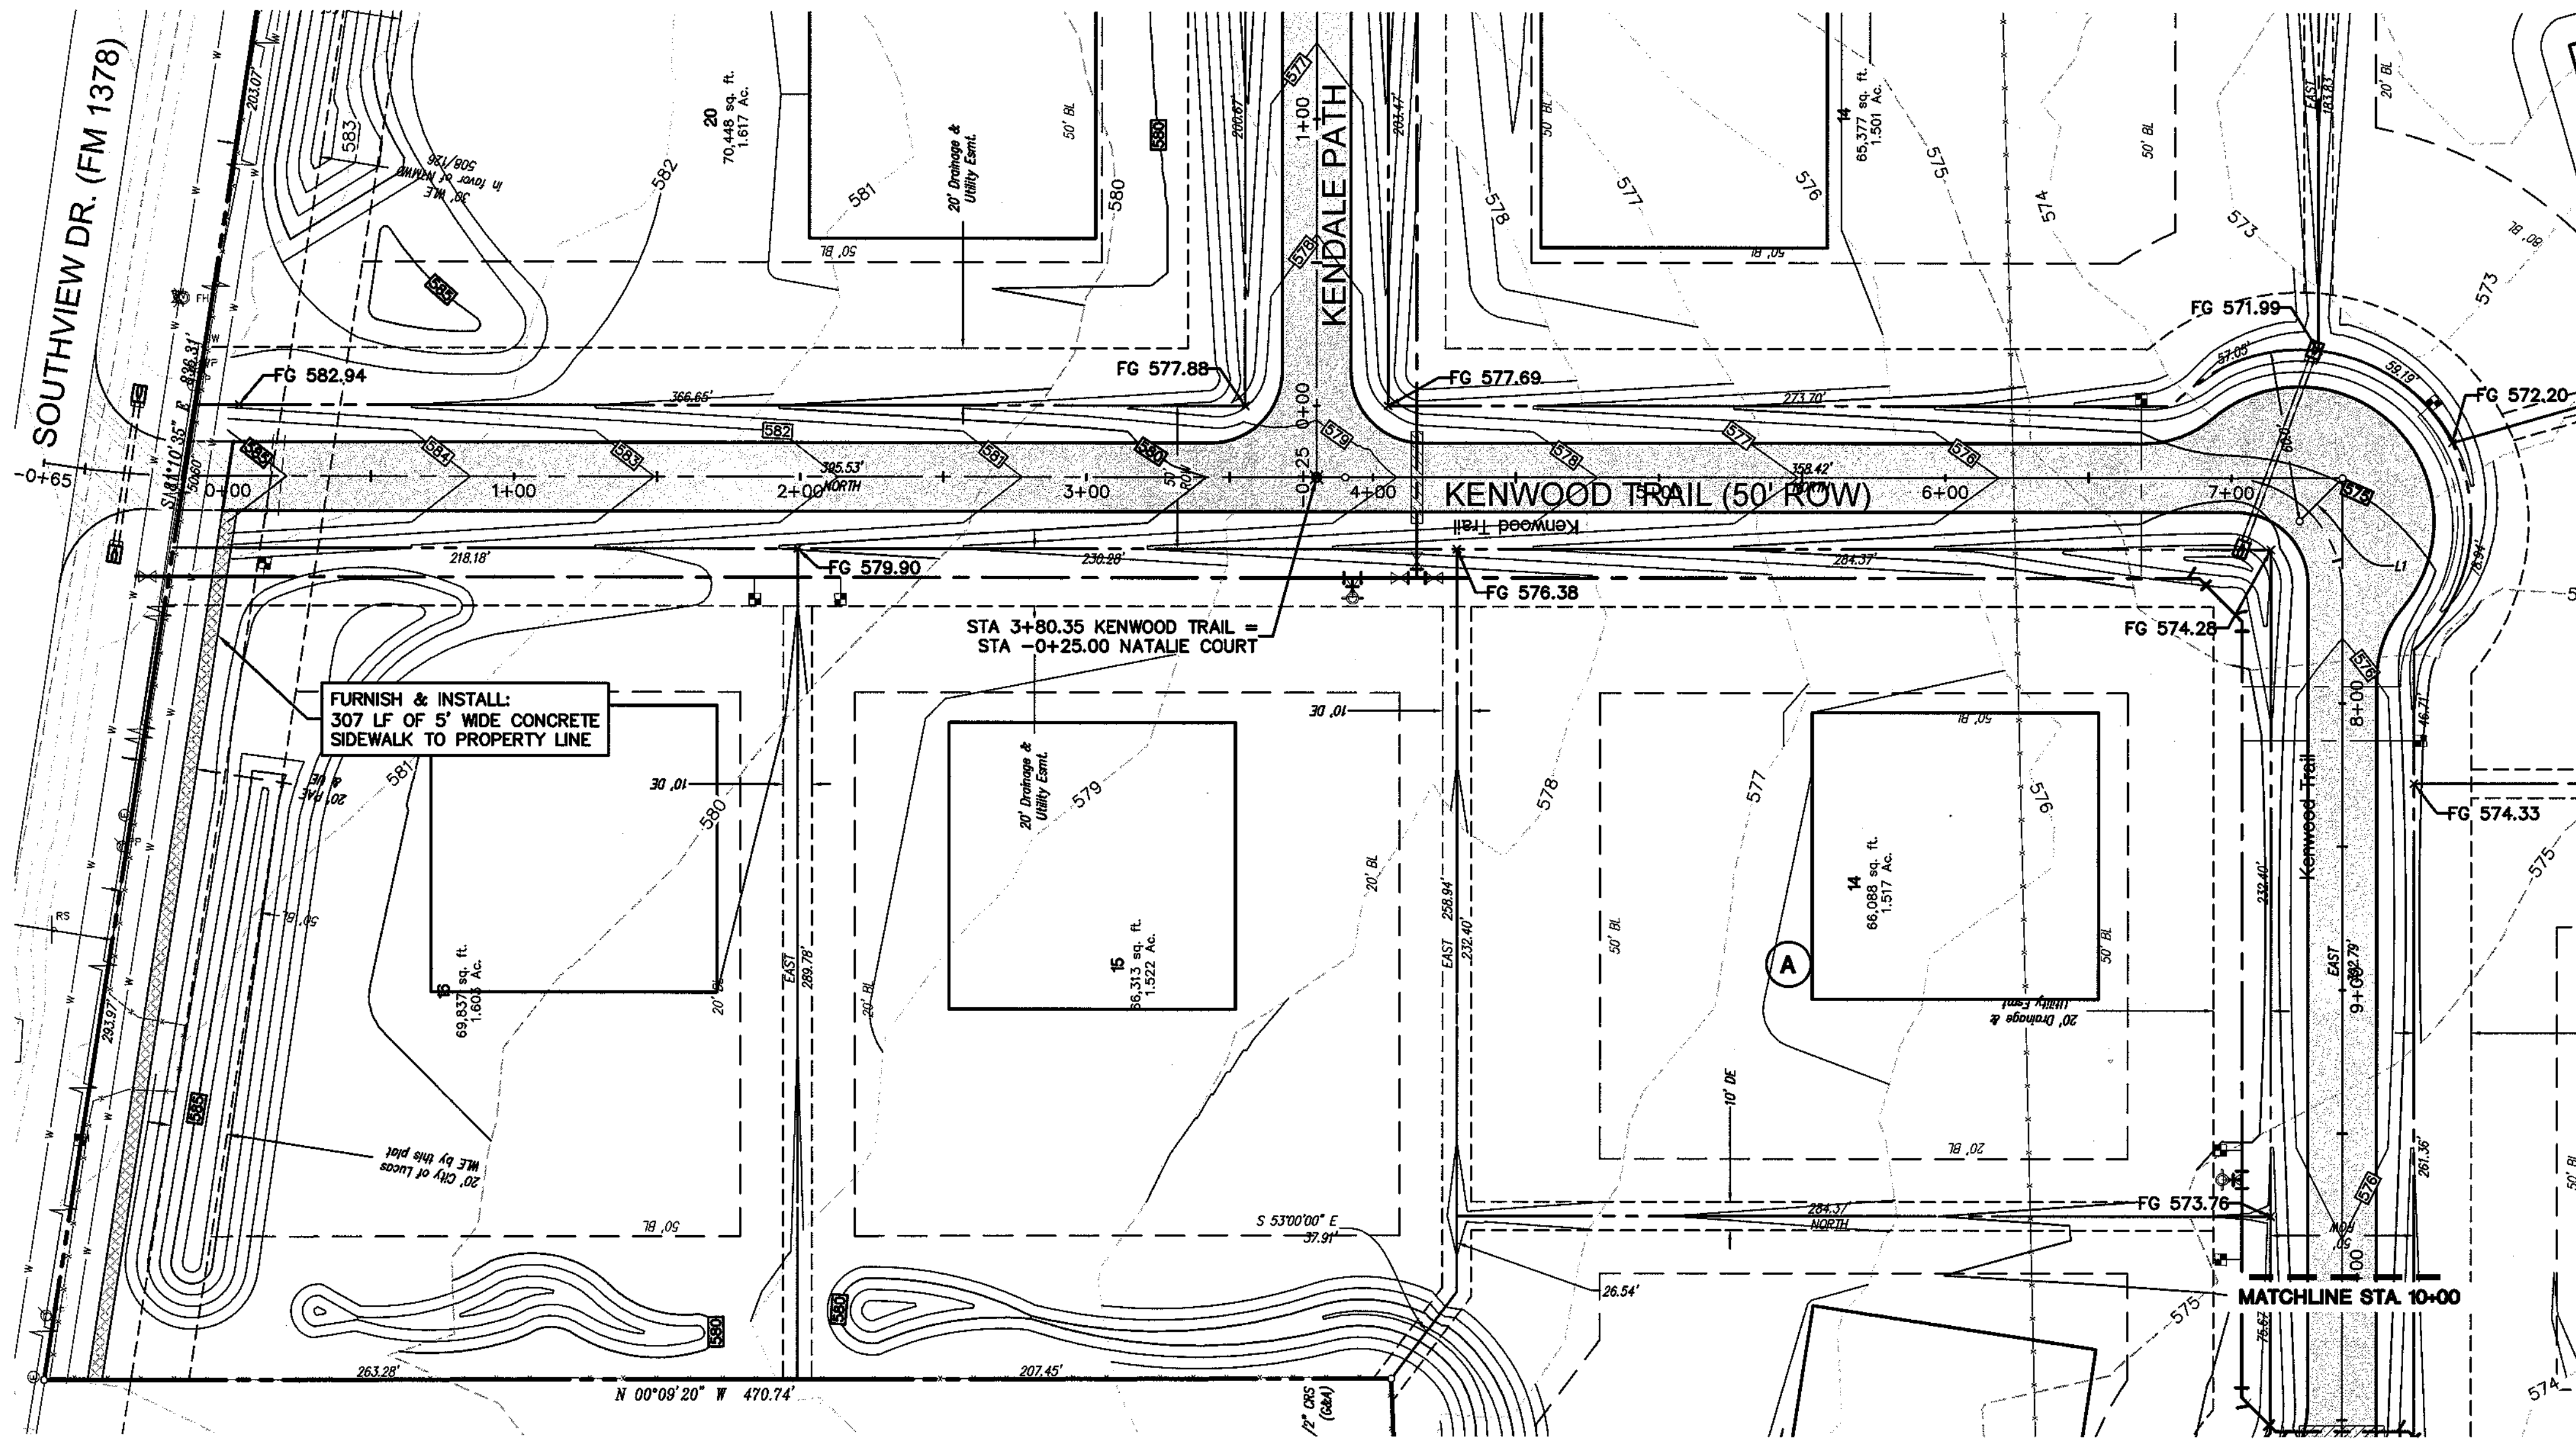

GENERAL NOTES

- THE CITY OF LUCAS CONSTRUCTION STANDARDS APPLY WHETHER INDICATED ON THESE PLANS OR NOT.

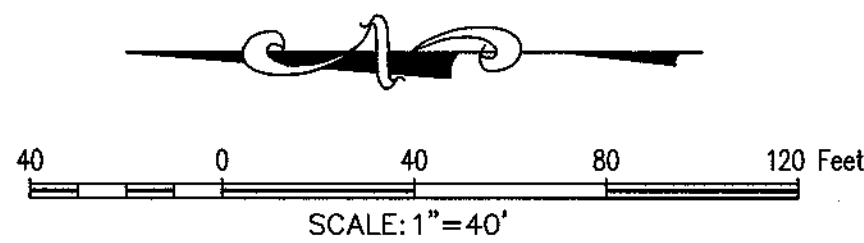

BENCHMARKS:

- BM#1 - RM133 - 590.08'
Square cut on east headwall of west of bridge at White Rock Creek (East) and FM 1378. Map# 4808500455G, Dated January 19th, 1996.
- BM#2 - Square Cut - 569.45'
~981' Southwest from the Northwest corner of subject property on south edge of Brookhaven Dr.
N=7,079,521.1' E=2,557,109.8'
- BM#3 - "X" - 579.96'
~760' Northeast from the Northwest corner of subject property near the intersection of Conner Ln. & Chapel Ct.
N=7,080,175.7' E=2,558,146.1'
- BM#4 - PK Nail - 554.84'
~900' Northeast from the Northeast corner of subject property at the south edge of a cul-de-sac on Alameda Cir.
N=7,079,803.4' E=2,559,558.0'
- BM#5 - "X" - 584.19'
~1040' Southeast from the southeast corner of subject property on a headwall on the north side of the intersection of FM 1378 & Sals Lagoon Trail.
N=7,076,568.5' E=2,559,653.8'

LEGEND


C.R.F.	Capped Rebar Found	—	Overhead Power Lines
C.R.S.	Capped Rebar Set	—	Down Guy Wire
C.M.	Control Monument	—	Existing Contours
Mon.	Monument	—	Proposed Contours
BM	Benchmark	—	Concrete Pavement
FH	Fire Hydrant	—	Asphalt Pavement
WM	Water Meter	—	Wood Fence
WV	Water Valve	—	Chain Link Fence
W/L	Water Line	—	Wire Fence
CV	Irrigation Control Valve	—	Masonry Wall
SSMH	Sanitary Sewer Manhole	—	Existing Tree
CO	Sanitary Sewer Cleanout	—	(FL) Flowline
UP	Utility Pole	—	Centerline of Creek, Swale, or Waterway
LP	Light Pole	—	Creek, Swale, or Waterway Embankment
TC	Top of Curb	—	
TP	Top of Pavement	—	
TW	Top of Wall	—	
FG	Finished Grade	—	
U.E.	Utility Easement	—	
D.E.	Drainage Easement	—	
B.L.	Building Line	—	
R.O.W.	Right-of-Way	—	
D.R.	Deed Records	—	
P.R.	Plat Records	—	

AS-BUILT RECORD DRAWING

THE INFORMATION ON THESE PLANS HAS BEEN REVISED TO REFLECT CHANGES TO PUBLIC IMPROVEMENTS MADE DURING CONSTRUCTION PROVIDED TO ENGINEER BY THE CONTRACTOR. UNLESS OTHERWISE NOTED, THE CONSTRUCTION OF THE PUBLIC IMPROVEMENTS IS IN GENERAL CONFORMANCE WITH THESE PLANS BASED UPON INFORMATION PROVIDED BY THE CONTRACTOR, AND THE RESPONSIBILITY FOR ACCURACY AND COMPLETENESS BELONGS TO THE CONTRACTOR.

Douglas W. Weaver
G & A Consultants, LLC.


Date: 11/23/2015

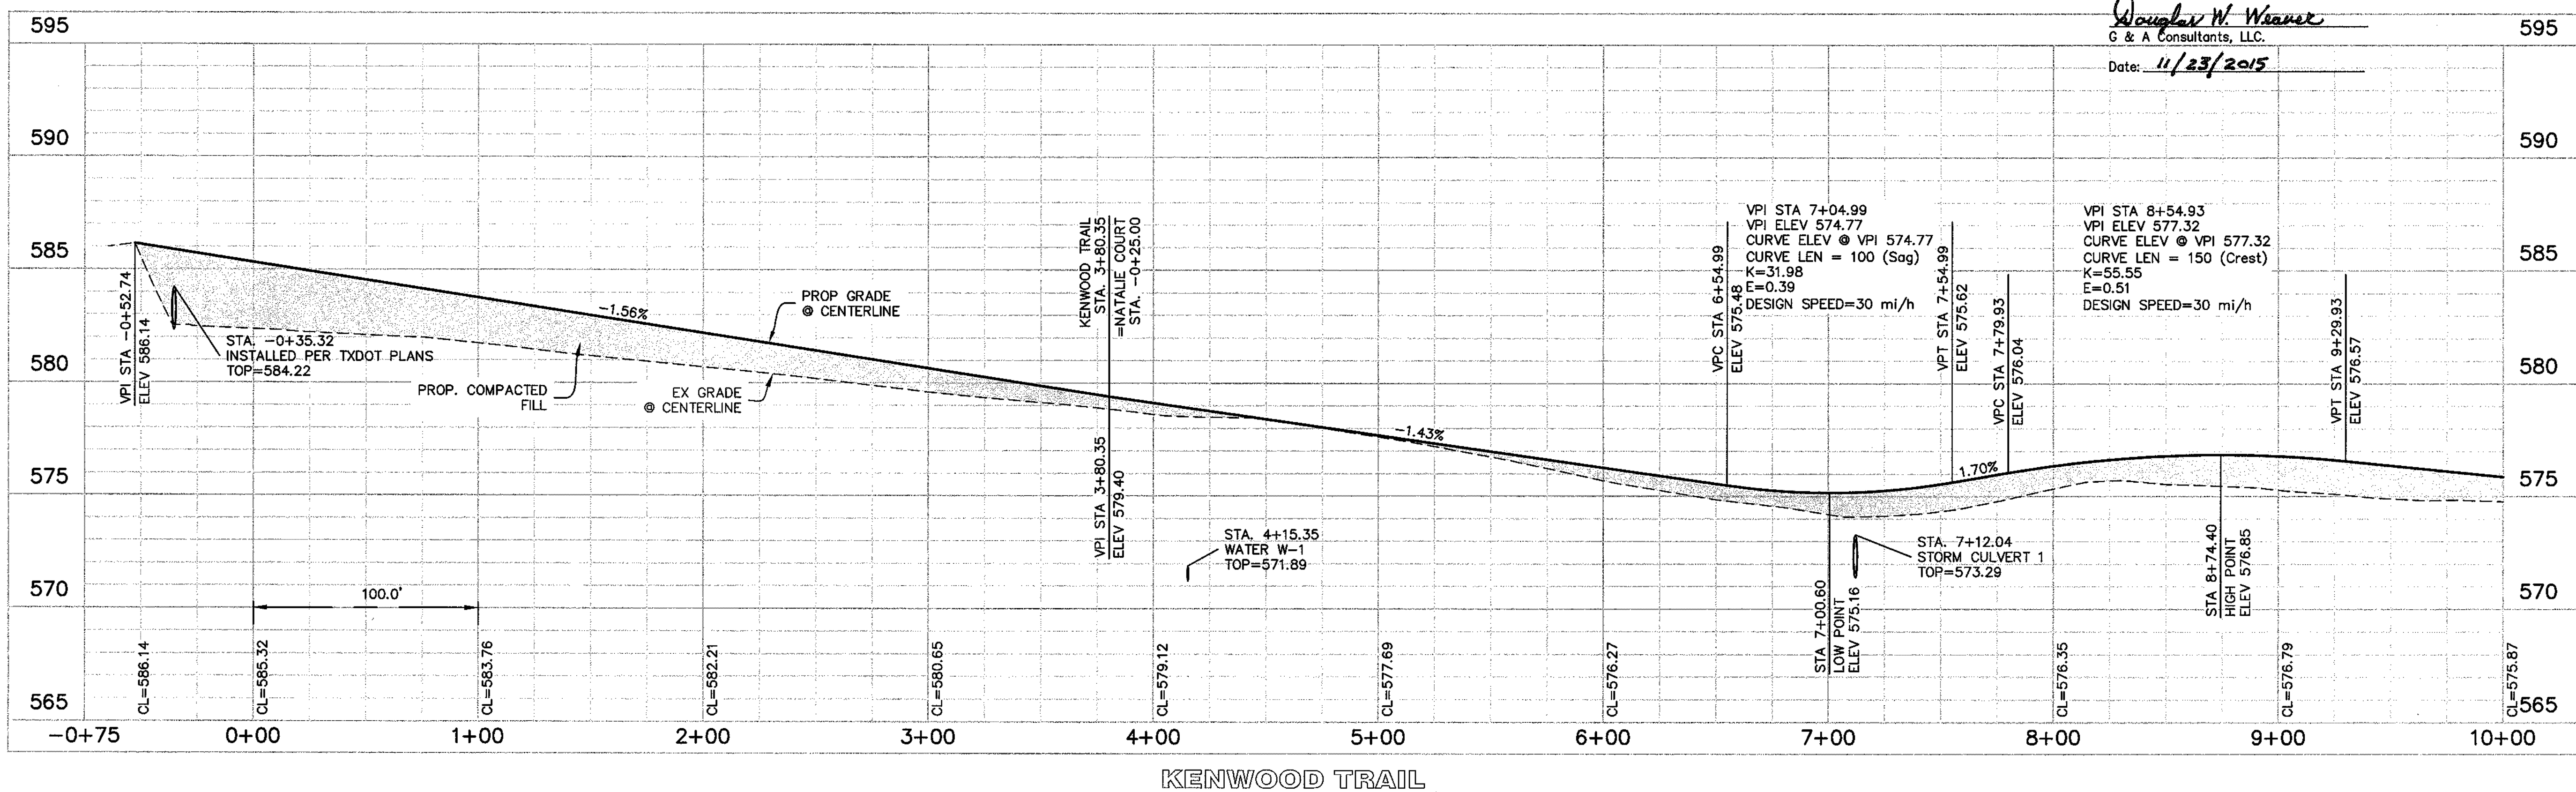

LEWIS PARK ESTATES

Lot 1-16 1-20, Block A, B
LEWIS PARK ESTATES
60.858 Acres
in the
CITY OF LUCAS
COLLIN COUNTY, TEXAS

KENWOOD TRAIL PLAN & PROFILE STA 0+00 TO STA 10+00

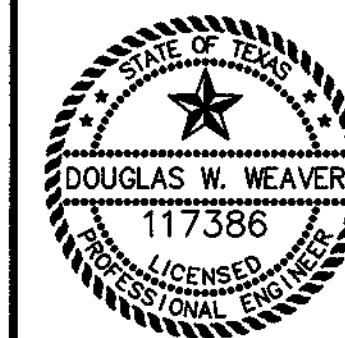

G&A CONSULTANTS, LLC.
TBPE F-1798



Drawn By: T.J.F.
Date: 11/07/2014
Scale: H 1"=40'; V 1"=4'

Revisions:

14026

C6

OWNER/DEVELOPER
CADG LEWIS PARK LLC
C/O LENART DEVELOPMENT COMPANY, LLC
520 CENTRAL PARKWAY E. SUITE 104
PLANO, TX 75074
Ph. (972) 422-9880
Contact: Steve Lenart

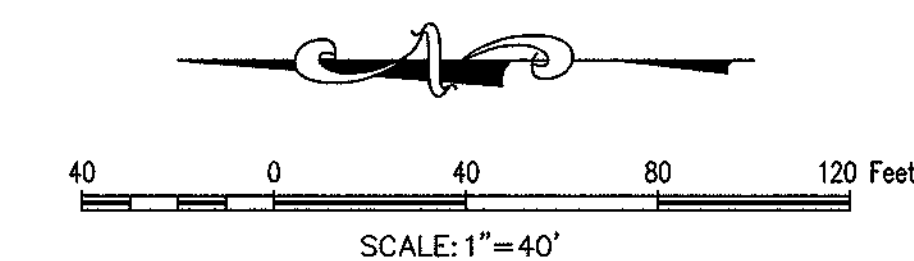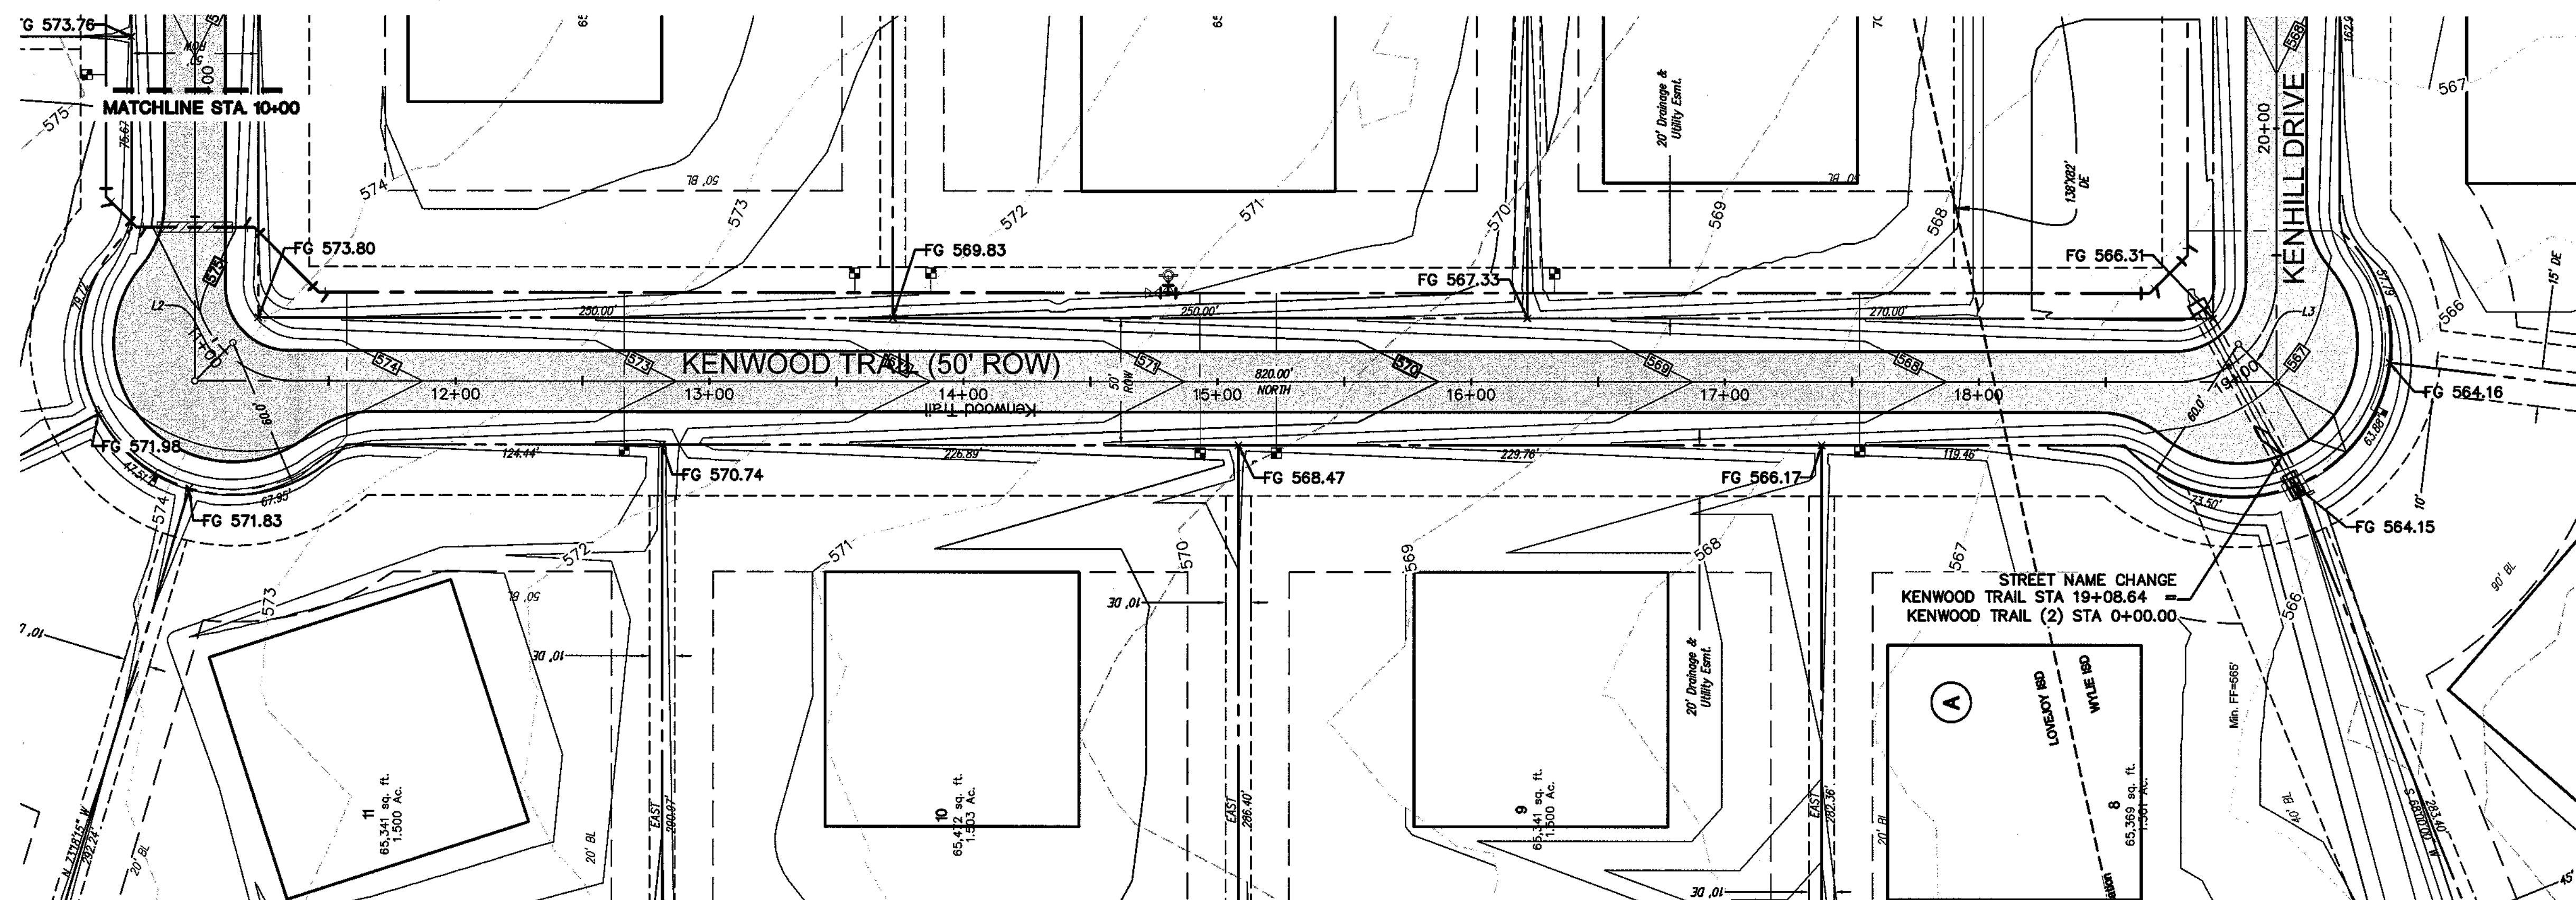

REMARKS:

BM#1 ~ RM133 ~ 590.08'
Square cut on the headwall of west of bridge at White Rock Creek (East) and FM 1378. Map# 48085C04556, Dated January 19th, 1996.

BTM#2 ~ Square Cut ~ 569.45'
~981' Southwest from the Northwest corner of subject property on south edge of Brookhaven Dr.
N=7,079,521.1' E=2,557,109.8'

BTM#3 ~ "X" ~ 579.96'
~760' Northeast from the Northwest corner of subject property near the intersection of Corner Ln. & Chapel Ct.
N=7,080,175.7' E=2,558,146.1'


BTM#4 ~ PK Nail ~ 554.84'
~900' Northeast from the Northeast corner of subject property at the south edge of a cul-de-sac on Alameda Cir.
N=7,079,803.4' E=2,559,558.0'

BTM#5 ~ "X" ~ 584.19'
~1040' Southeast from the southeast corner of subject property on a headwall on the north side of the intersection of FM 1378 & Seale Lanes Trail.
N=7,076,559.3' E=2,559,653.8'

LEGEND			
C.R.F.	Capped Rebar Found		Overhead Power Lines
C.R.S.	Capped Rebar Set		Down Guy Wire
C.M.	Control Monument		Existing Contours
Mon.	Monument		Proposed Contours
BM	Benchmark		Concrete Pavement
FH	Fire Hydrant		Asphalt Pavement
WM	Water Meter		Wood Fence
WV	Water Valve		Chain Link Fence
W/L	Water Line		Wire Fence
—	Irrigation Control Valve		Masonry Wall
SSMH	Sanitary Sewer Manhole		Existing Tree
CO	Sanitary Sewer Cleanout		(FL) Flowline
UP	Utility Pole		Centerline of Creek, Swale, or Waterway
LP	Light Pole		Creek, Swale, or Waterway Embankment
TC	Top of Curb		
TP	Top of Pavement		
TW	Top of Wall		
FG	Finished Grade		
U.E.	Utility Easement		
D.E.	Drainage Easement		
B.L.	Building Line		
R.O.W.	Right-of-Way		
D.R.	Deed Records		
P.R.	Plat Records		

GENERAL NOTES

1. THE CITY OF LUCAS CONSTRUCTION STANDARDS APPLY WHETHER INDICATED ON THESE PLANS OR NOT.

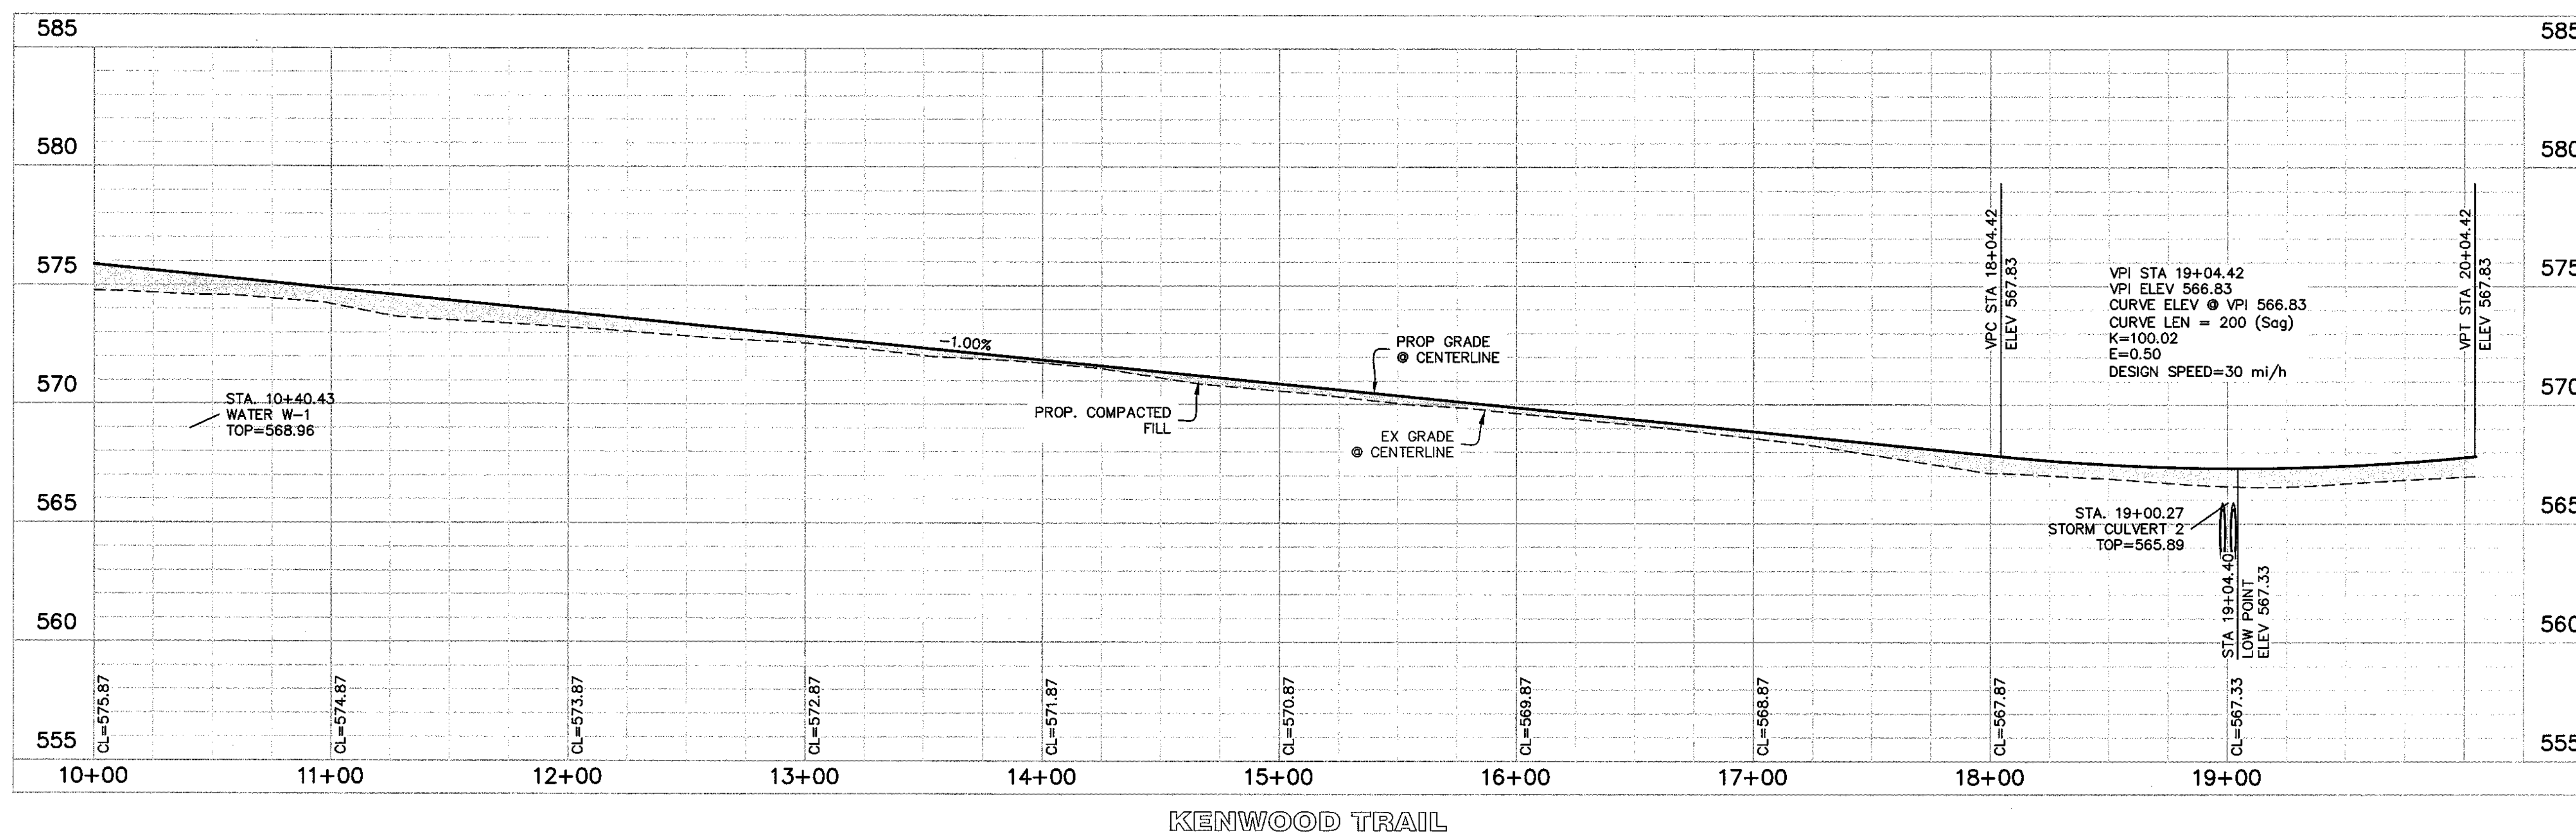

**AS-BUILT
RECORD DRAWING**

THE INFORMATION ON THESE PLANS HAS BEEN REVIEWED TO REFLECT CHANGES TO PUBLIC IMPROVEMENTS MADE DURING CONSTRUCTION PROVIDED TO ENGINEERS BY THE CONTRACTOR. UNLESS OTHERWISE NOTED, THE INFORMATION ON THESE PLANS IMPROVEMENTS IS GENERAL CONFORMANCE WITH THE ACTS BASED UPON INFORMATION PROVIDED BY THE CONTRACTOR AND THE RESPONSIBILITY FOR ACCURACY AND COMPLETENESS BELONGS TO THE CONTRACTOR.

Douglas W. Weaver
G & A Consultants, LLC.

Date: 11/23/2015

G&A CONSULTANTS, LLC.
TBPE F-1798


Drawn By: TJF
Date: 11/07/2014
Scale: H 1"=40'; V 1"=4'
Revisions:

14026

C7

OWNER/DEVELOPER
CADG LEWIS PARK LLC
C/O LENART DEVELOPMENT COMPANY,
LLC
520 CENTRAL PARKWAY E. SUITE 104
PLANO, TX 75074
Ph. (972) 422-9880
Contact: Steve Lenart

File: Z:\2014\140206\Drawings\FP & Const Plans\SHEET SET\140206 STREET PP
 Printed: 11/20/2015 3:56 PM by Josh Barton: Saved: 11/19/2015 3:34 PM by scottw

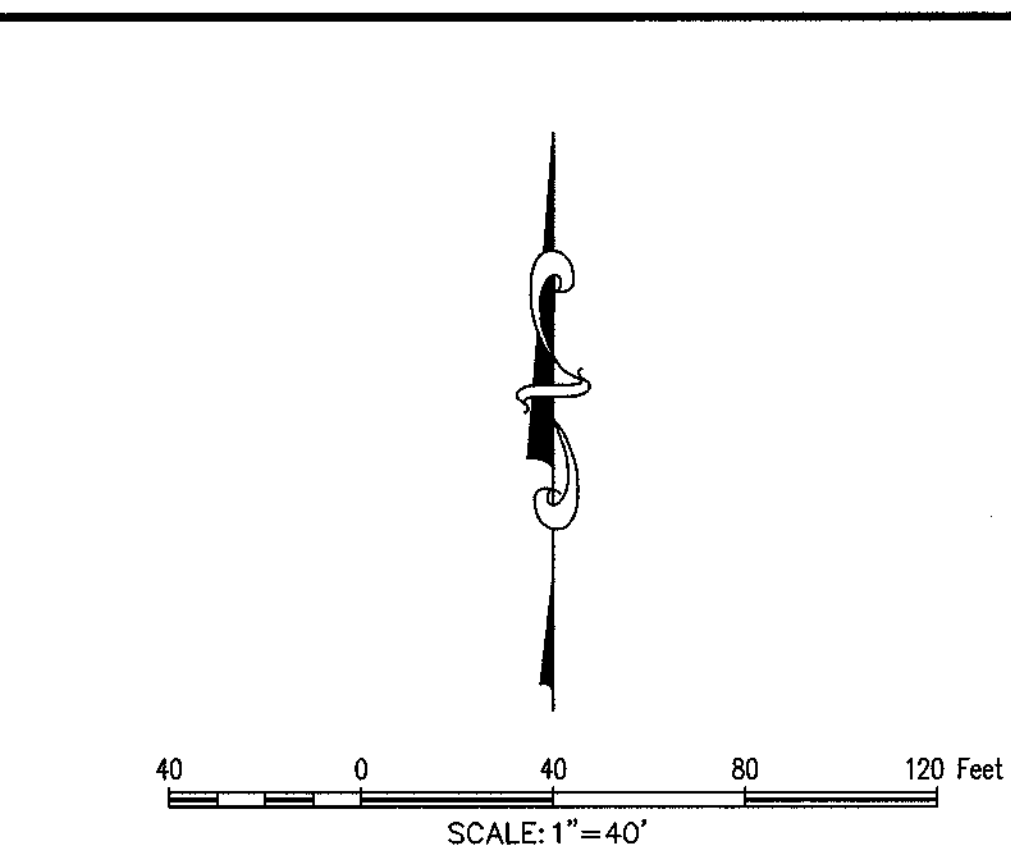

BM#1 - RM133 - 590.08'
Square cut on east headwall of west of bridge at White Rock Creek (East) and FM 1378. Map# 480B5C0455G, Dated January 1978, 1996.

TBM#2 - Square Cut - 569.45'
~981' Southwest from the Northwest corner of subject property on south edge of Brookhaven Dr.
N=7,079,521.1' E=2,557,109.8'

TBM#3 - "X" - 579.95'
~760' Northeast from the Northwest corner of subject property near the intersection of Conner Ln. & Chapel Ct.
N=7,080,175.7' E=2,558,146.1'

TBM#4 - PK Nail - 554.84'
~900' Northeast from the Northeast corner of subject property at the south edge of a cul-de-sac on Alameda Cir.
N=7,079,803.4' E=2,559,558.0'


TBM#5 - "X" - 584.19'
~1040' Southeast from the southeast corner of subject property on a headwall on the north side of the intersection of FM 1378 & Seis Lagos Trail
N=7,076,566.5' E=2,559,653.8'

LEGEND			
C.R.F.	Capped Rebar Found		Overhead Power Lines
C.R.S.	Capped Rebar Set		Down Guy Wire
C.M.	Control Monument		Existing Contours
Mon.	Monument		Proposed Contours
BM	Benchmark		Concrete Pavement
FM	Fire Hydrant		Asphalt Pavement
WM	Water Meter		Wood Fence
WV	Water Valve		Chain Link Fence
W/L	Water Line		Wire Fence
ICV	Ingraving Control Valve		Masonry Wall
SSMH	Sanitary Sewer Manhole		Existing Tree
CO	Sanitary Sewer Cleanout		(FL) Flowline
UP	Utility Pole		Centerline of Creek, Swale, or Waterway
LP	Light Pole		Creek, Swale, or Waterway Embankment
TC	Top of Curb		
TP	Top of Pavement		
TW	Top of Wall		
FG	Finished Grade		
U.E.	Utility Easement		
D.E.	Drainage Easement		
B.L.	Building Line		
R.O.W.	Right-of-Way		
D.R.	Deed Records		
P.R.	Plat Records		

1. THE CITY OF LUCAS CONSTRUCTION STANDARDS
APPLY WHETHER INDICATED ON THESE PLANS OR
NOT

THE INFORMATION ON THESE PLANS HAS BEEN REVISED TO REFLECT CHANGES TO PUBLIC IMPROVEMENTS MADE DURING CONSTRUCTION PROVIDED TO ENGINEER BY THE CONTRACTOR. UNLESS OTHERWISE NOTED, THE LOCATION OF PUBLIC IMPROVEMENTS IS IN GENERAL CONFORMANCE WITH THESE PLANS BASED UPON INFORMATION PROVIDED BY THE CONTRACTOR, AND THE RESPONSIBILITY FOR ACCURACY AND COMPLETENESS BELONGS TO THE CONTRACTOR.

Rouglas W. Weaver
G & A Consultants, LLC.
Date: 11/23/2015

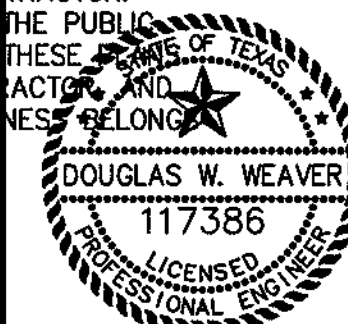

G&A CONSULTANTS, LLC.
TBPE F-1798

Drawn By: TJF
Date: 11/07/2014
Scale: H 1"=40'; V 1"=4'
Revisions:




14026

C8

OWNER/DEVELOPER
CADG LEWIS PARK LLC
C/O LENART DEVELOPMENT COMPANY
LLC
520 CENTRAL PARKWAY E. SUITE 104
PLANO, TX 75074
Ph. (972) 422-9880
Contact: Steve Lenart

File: Z:\2014\14026\Drawings\TP & Coast Plans\SHEET SET\14026 KENHILL.PP
 Printed: 11/20/2015 3:57 PM, by Josh Barton; Saved: 11/20/2015 3:54 PM, by josh

Fig. 2: 10/14/2015 11:00 AM User: JTF & Civil Plans/AS-BUILT STV/002 KENWOOD TRAIL
Printed: 11/23/2015 3:27 PM by John Barton. Source: 11/23/2015 3:24 PM by jpb

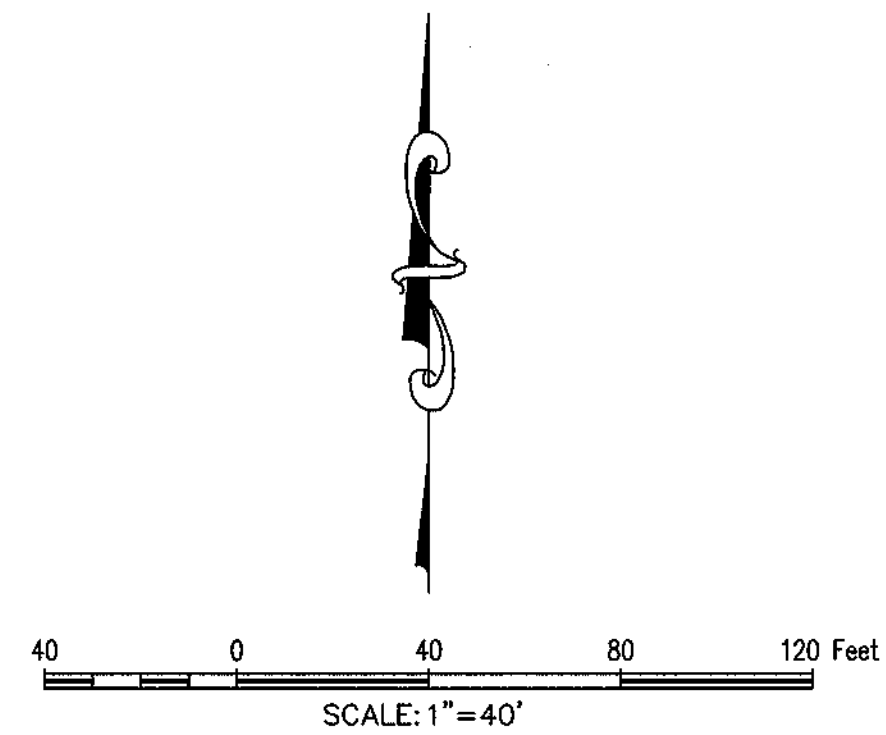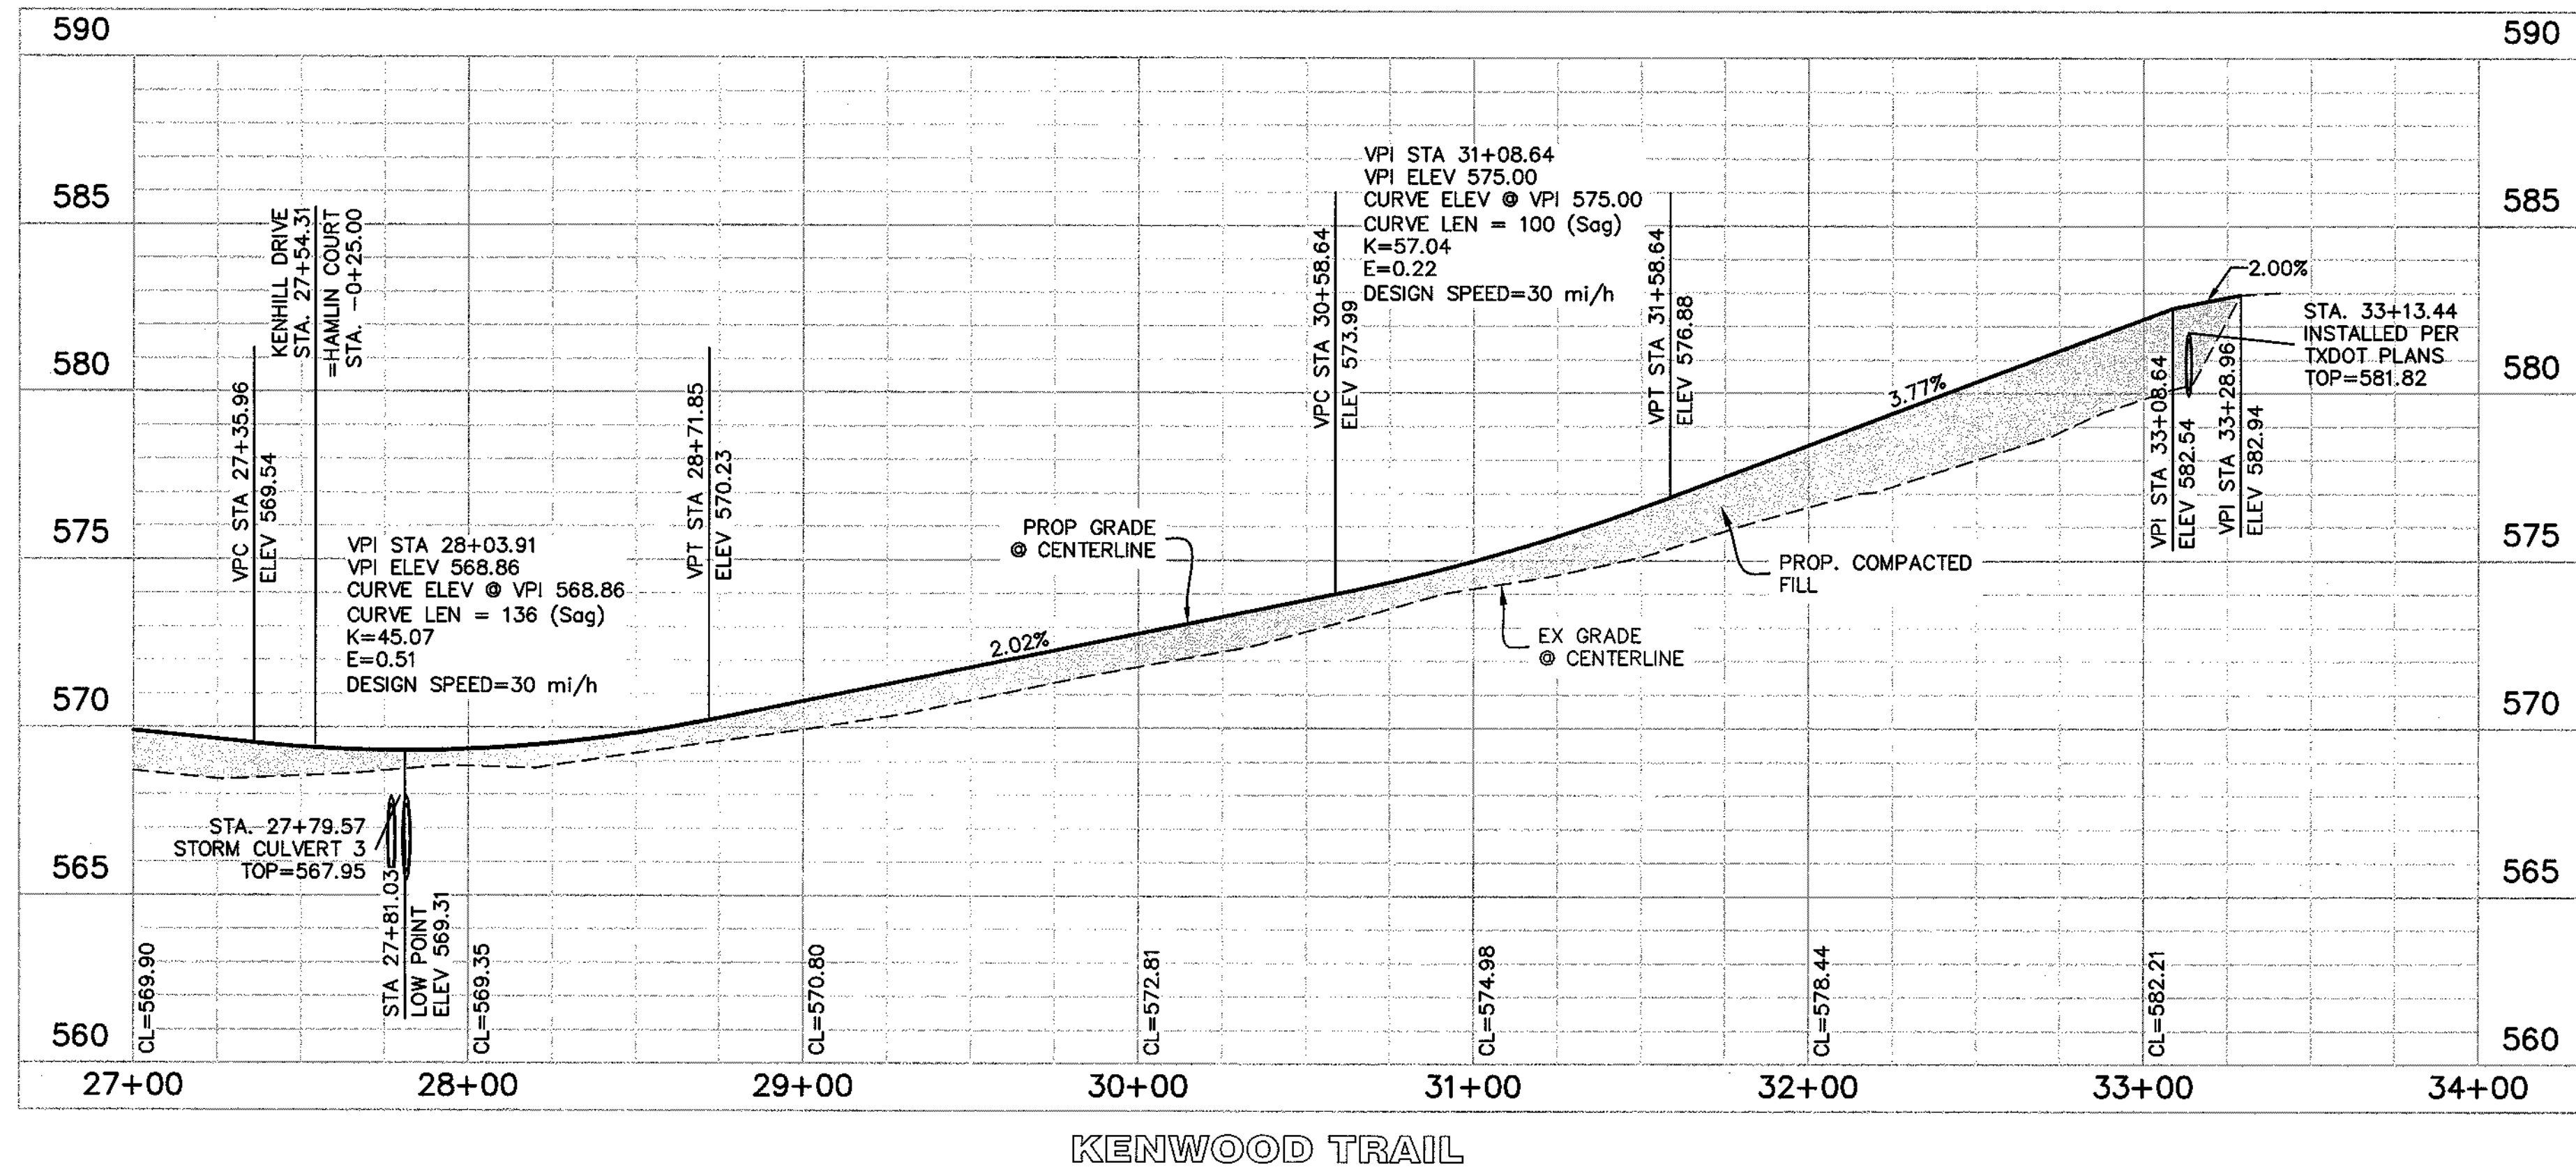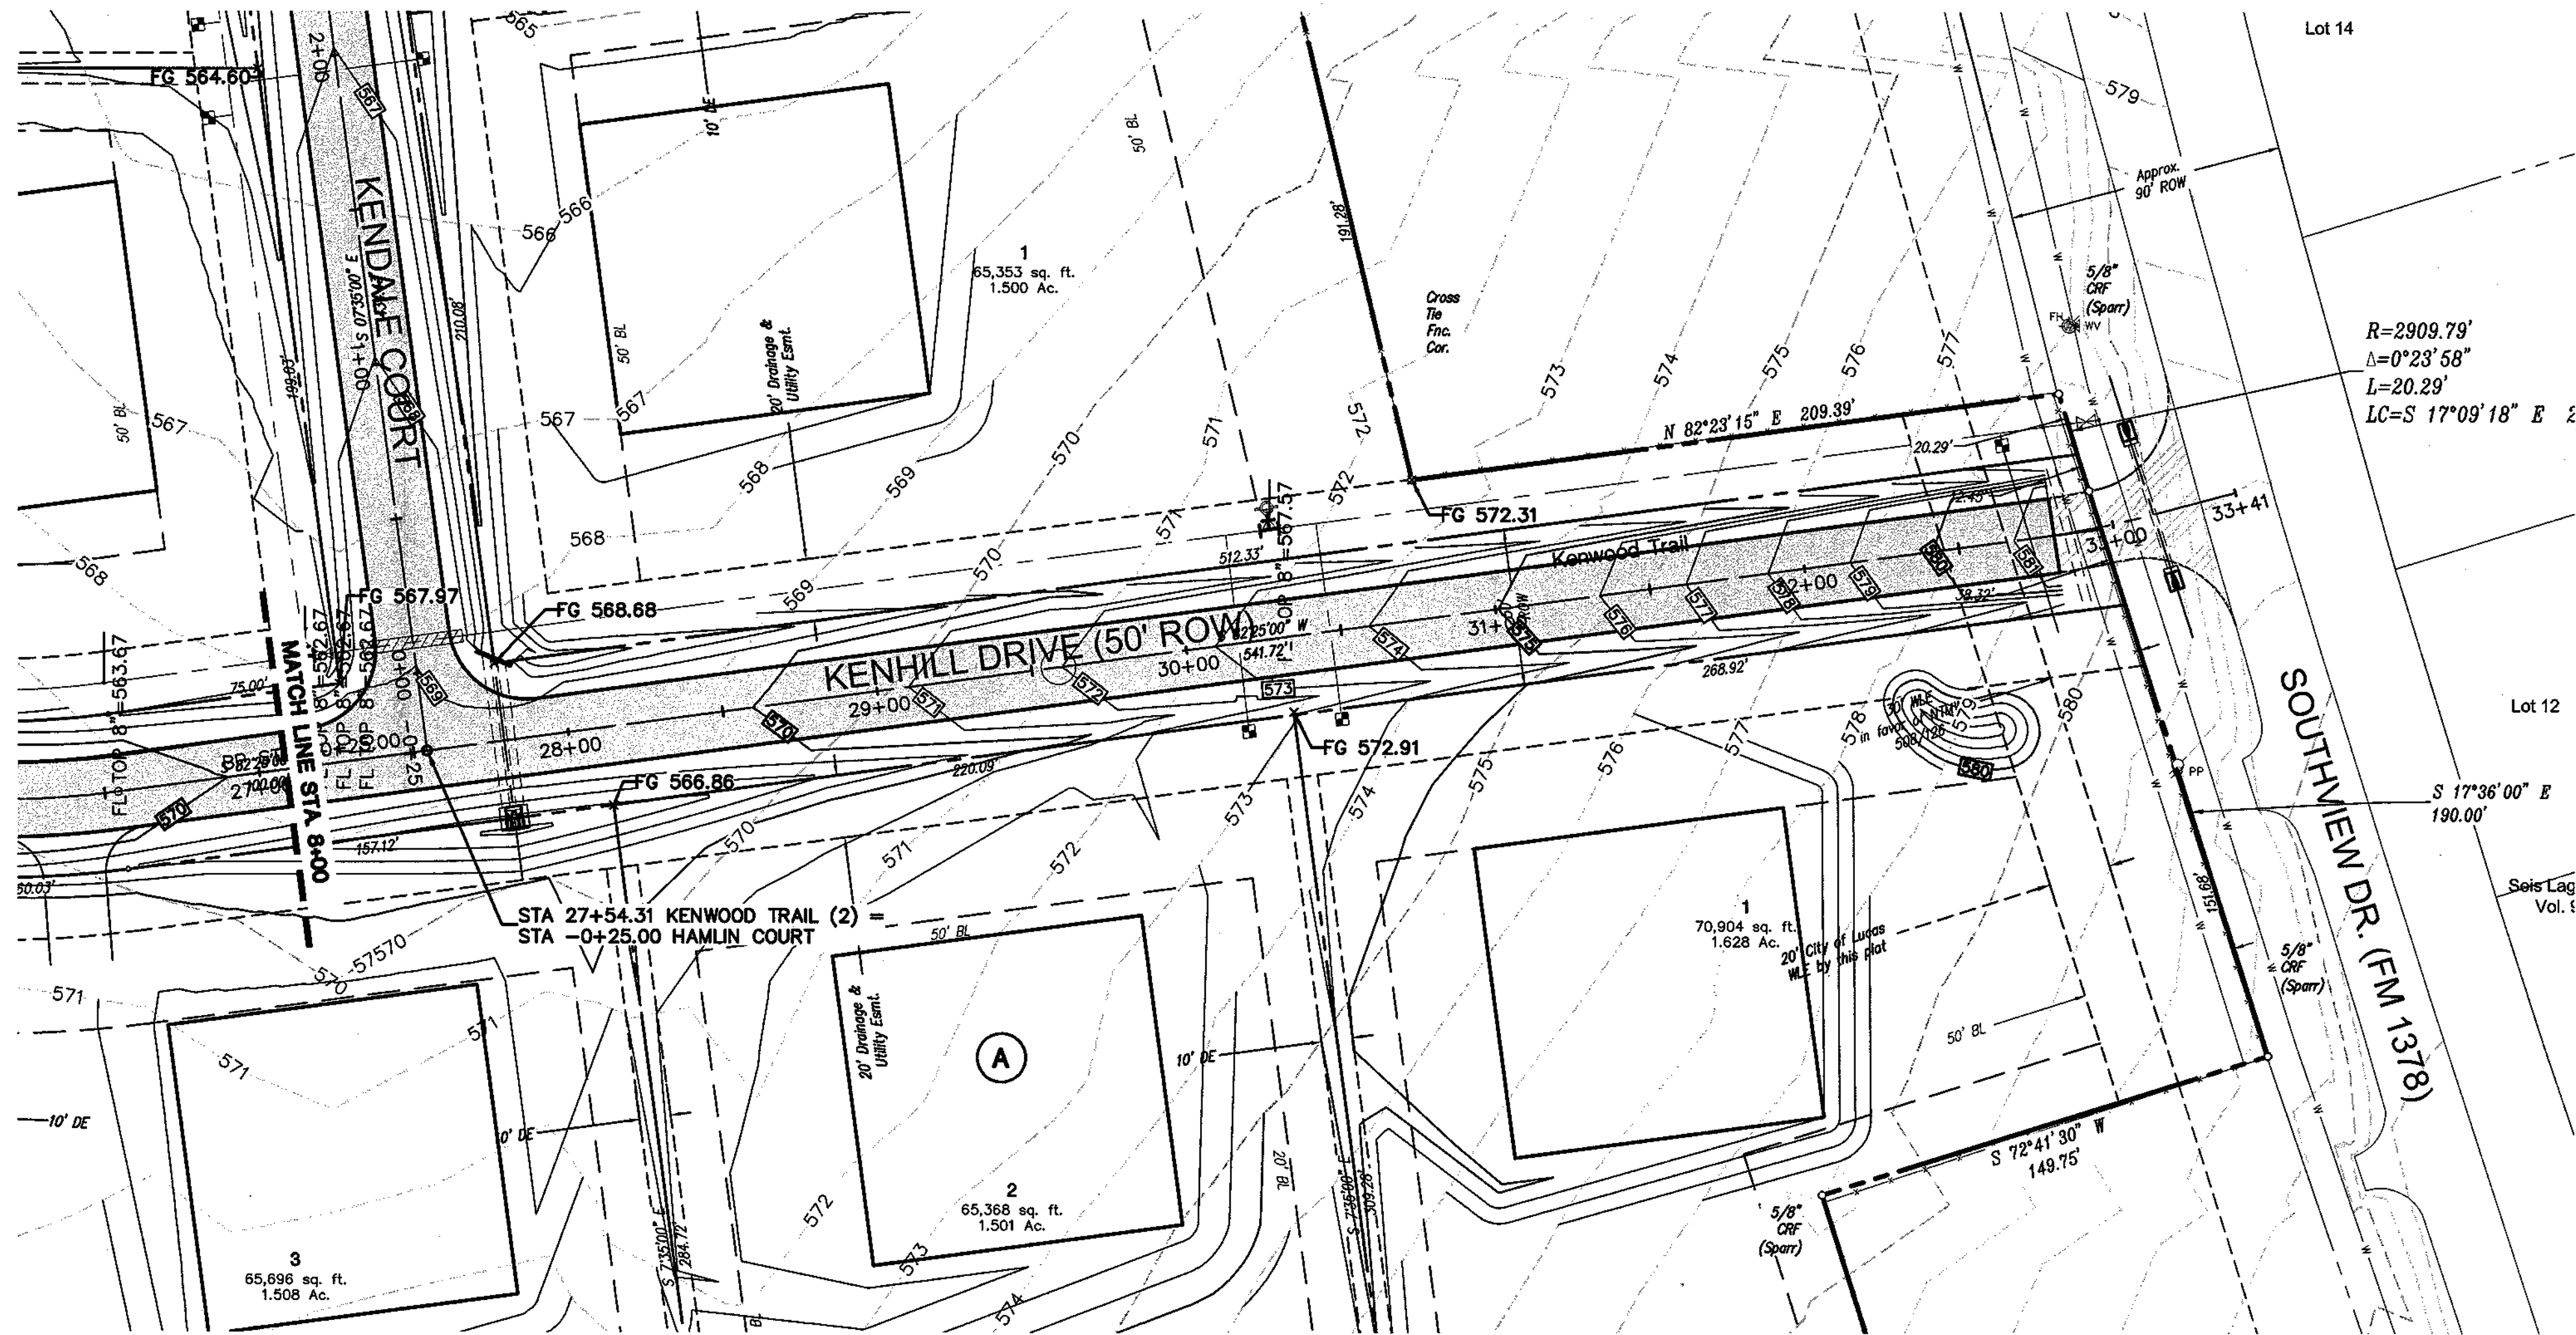

BENCHMARKS:
BM#1 - RM133 - 590.08'
Square cut on east headwall of west of bridge at White Rock Creek (East) and FM 1378. Map# 48085C0455G, Dated January 19th, 1998.
BM#2 - Square Cut - 569.45'
~981' Southwest from the Northwest corner of subject property on south edge of Brookhaven Dr.
N=7,079,521.1' E=2,557,109.8'
BM#3 - "X" - 579.96'
~760' Northeast from the Northwest corner of subject property near the intersection of Conner Ln. & Chapel Ct.
N=7,080,175.7' E=2,558,146.1'
BM#4 - PK Nail - 554.84'
~900' Northeast from the Northeast corner of subject property at the south edge of a cul-de-sac on Alameda Cir.
N=7,079,803.4' E=2,559,558.0'
BM#5 - "X" - 584.19'
~1040' Southeast from the southeast corner of subject property on a headwall on the north side of the intersection of FM 1378 & Sels Lags Trail.
N=7,076,568.5' E=2,559,653.8'

LEGEND		
C.R.F.	Capped Rebar Found	Overhead Power Lines
C.R.S.	Capped Rebar Set	Down Guy Wire
C.M.	Control Monument	443- Existing Contours
Mon.	Monument	445- Proposed Contours
BM	Benchmark	Concrete Pavement
FH	Fire Hydrant	Asphalt Pavement
WM	Water Meter	Wood Fence
WV	Water Valve	Chain Link Fence
W/L	Water Line	Wire Fence
ICV	Irrigation Control Valve	Masonry Wall
SSMH	Sanitary Sewer Manhole	Existing Tree
CO	Sanitary Sewer Cleanout	(FL) Flowline
UP	Utility Pole	Centerline of Creek, Swale, or Waterway
LP	Light Pole	Creek, Swale, or Waterway Embankment
TC	Top of Curb	
TP	Top of Pavement	
TW	Top of Wall	
FG	Finished Grade	
U.E.	Utility Easement	
D.E.	Drainage Easement	
B.L.	Building Line	
R.O.W.	Right-of-Way	
D.R.	Deed Records	
P.R.	Plat Records	

GENERAL NOTES
1. THE CITY OF LUCAS CONSTRUCTION STANDARDS APPLY WHETHER INDICATED ON THESE PLANS OR NOT.

AS-BUILT RECORD DRAWING


THE INFORMATION ON THESE PLANS HAS BEEN REVISED TO REFLECT CHANGES TO PUBLIC IMPROVEMENTS MADE DURING CONSTRUCTION PROVIDED TO ENGINEER BY THE CONTRACTOR. UNLESS OTHERWISE NOTED, THE CONSTRUCTION OF THE PUBLIC IMPROVEMENTS IS IN GENERAL CONFORMANCE WITH THESE PLANS. THE RESPONSIBILITY FOR ACCURACY AND COMPLETENESS BELONGS TO THE CONTRACTOR.

Douglas W. Weaver
G & A Consultants, LLC.
Date: 11/23/2015

G&A CONSULTANTS, LLC
SITE PLANNING CIVIL ENGINEERING PLATTING
LAND SURVEYING LANDSCAPE ARCHITECTURE
111 Filippa Drive - Lewisville, TX 76047 - P: 972.498.9712 - F: 972.498.9715
611 Dallas Drive, Suite 114 - Fort Worth, TX 76103-9712 - F: 817.890.4043
TBPE Firm No. 1798

LEWIS PARK ESTATES
Lot 1-16, 1-20, Block A, B
LEWIS PARK ESTATES
60,858 Acres
in the
JAMES ANDERSON SURVEY, ABSTRACT NO. 17
CITY OF LUCAS
COLLIN COUNTY, TEXAS

KENWOOD TRAIL PLAN & PROFILE STA 27+00 TO STA 34+00

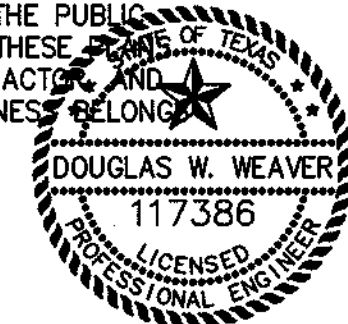



G&A CONSULTANTS, LLC.
TBPE F-1798

Drawn By: JTF
Date: 11/07/2014
Scale: H 1"=40'; V 1"=4'
Revisions:
06/25/15

14026

C9

OWNER/DEVELOPER:
CADG LEWIS PARK LLC
C/O LENART DEVELOPMENT COMPANY, LLC
520 CENTRAL PARKWAY E SUITE 104
PLANO, TX 75074
Ph: (972) 422-9880
Contact: Steve Lenart

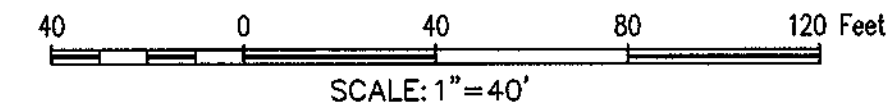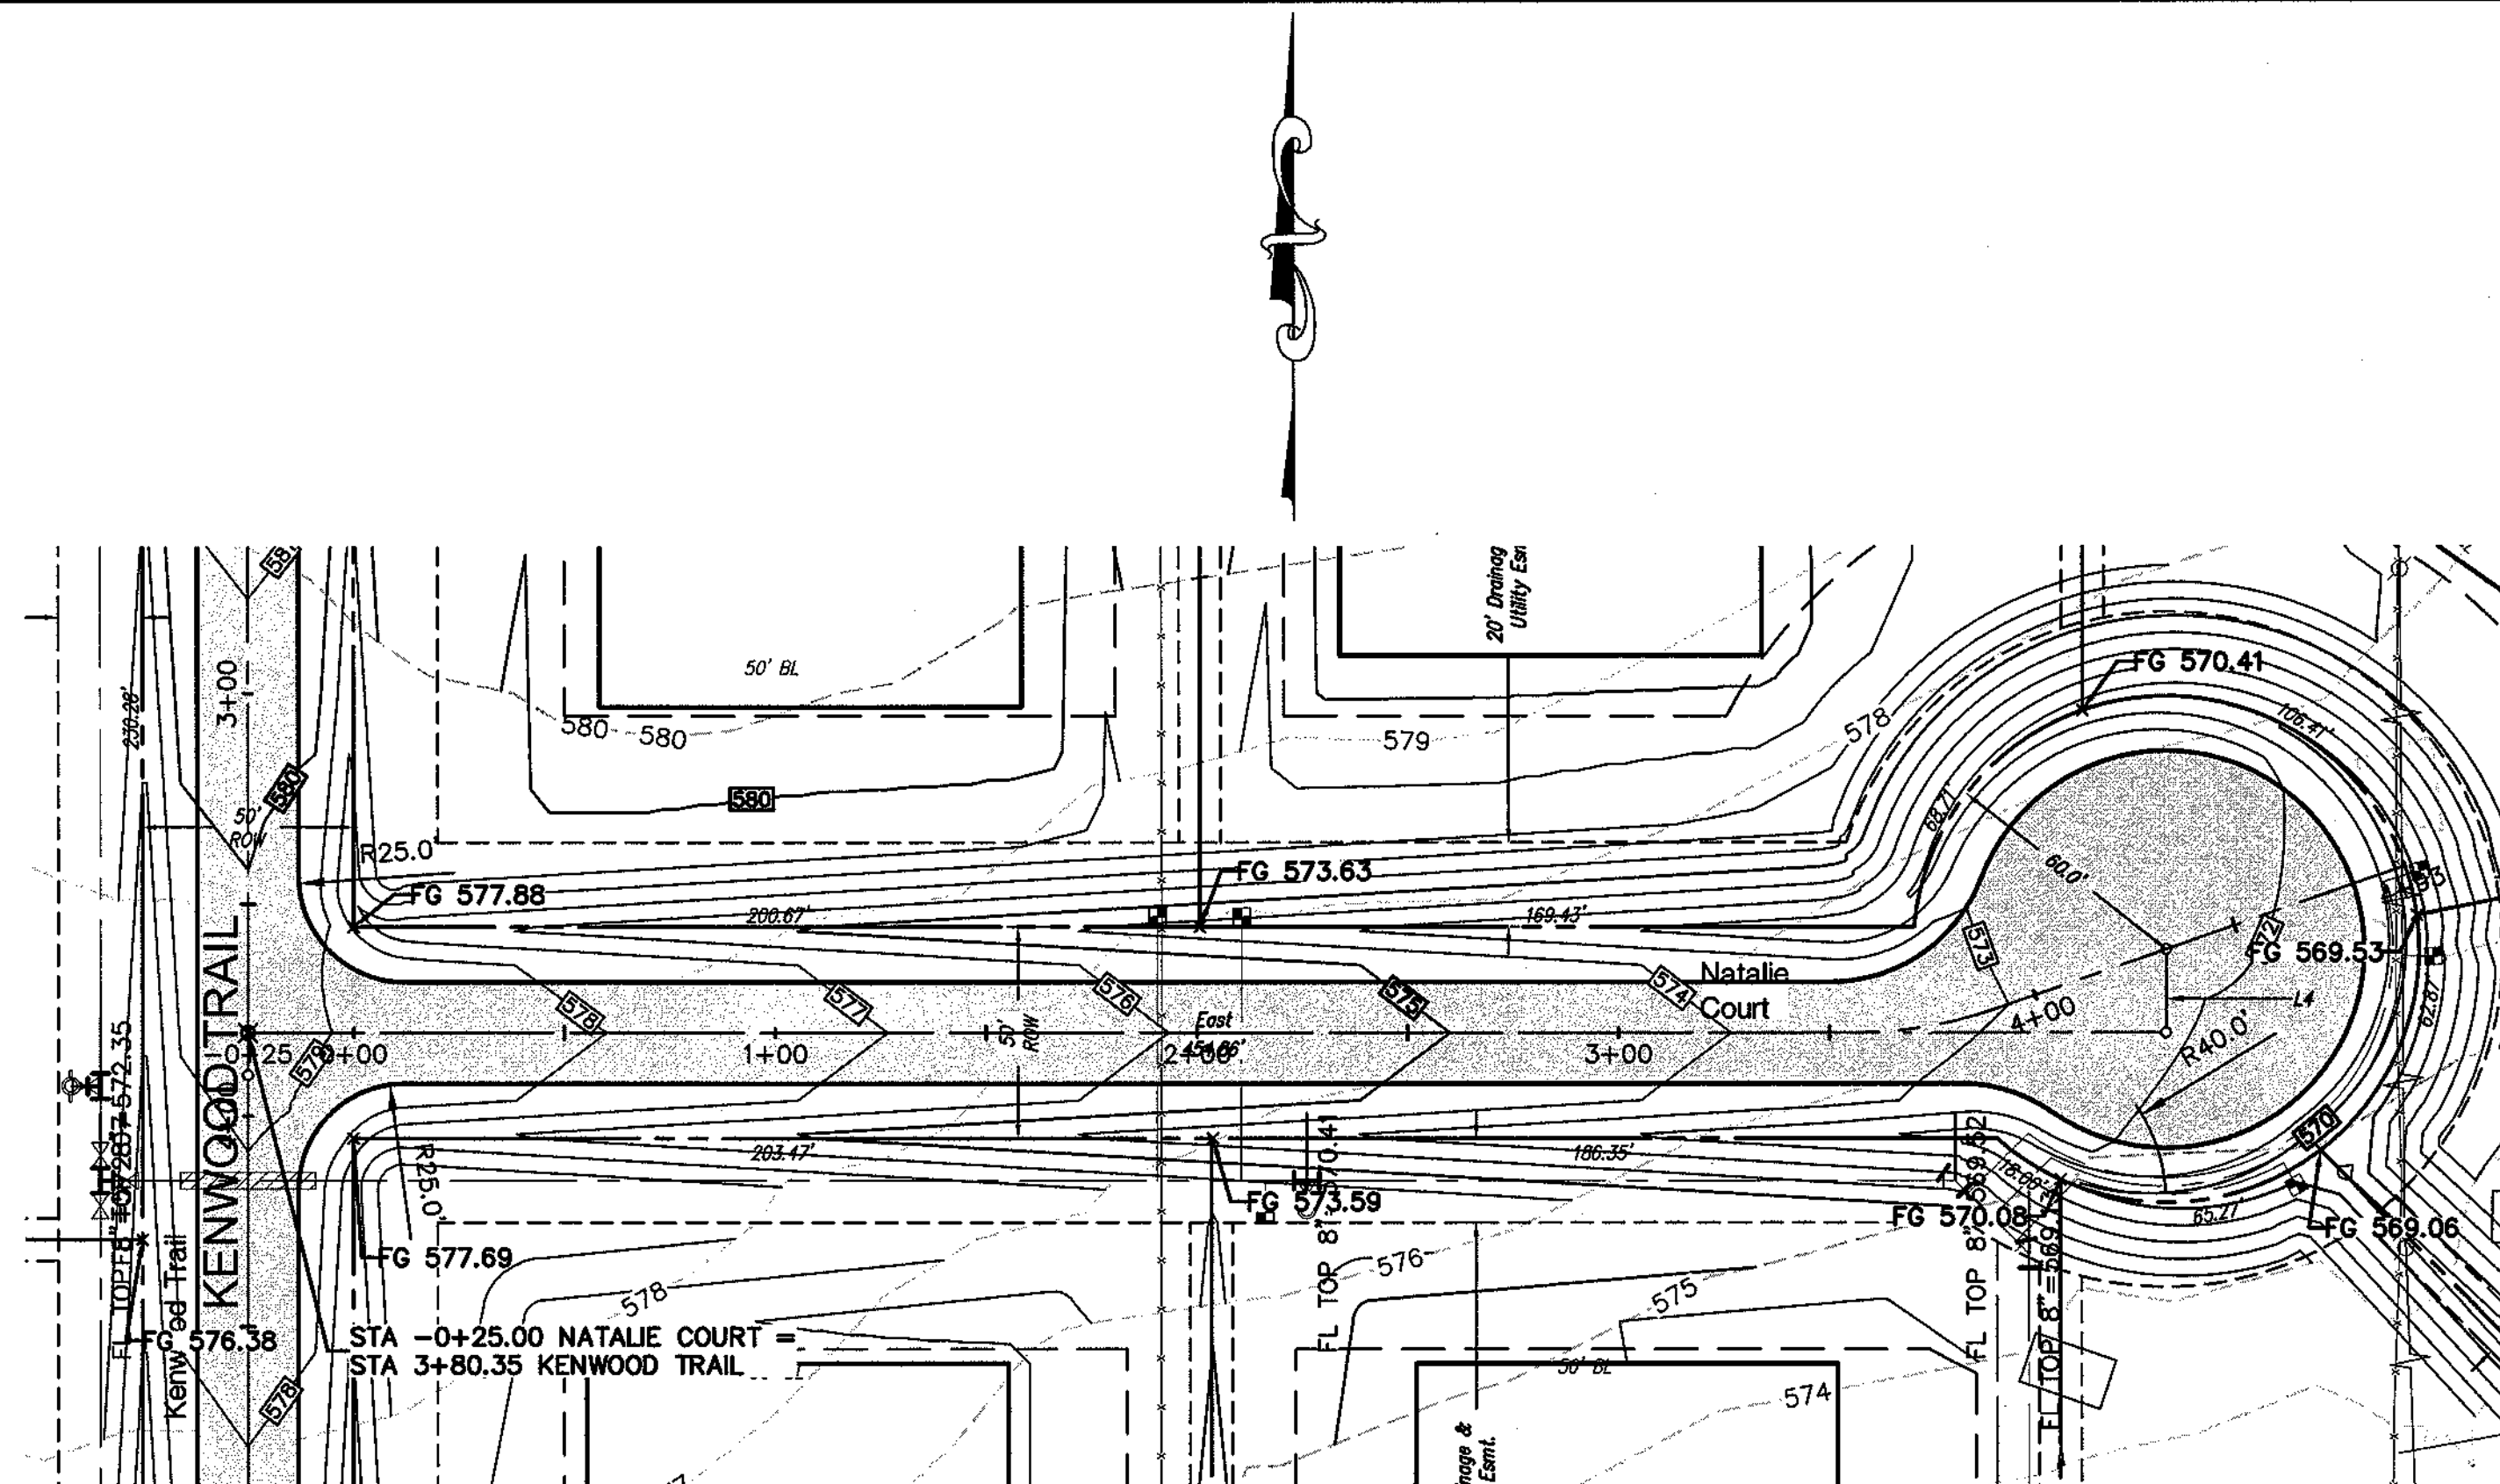

BENCHMARKS:

- BM#1 - RM133 - 590.08'
Square cut on east headwall of west of bridge at White Rock Creek (East) and FM 1378. Map# 48085C0455G, Dated January 19th, 1998.
- TBM#2 - Square Cut - 569.45'
~981' Southwest from the Northwest corner of subject property on south edge of Brookhaven Dr.
N=7,079,521.1' E=2,557,109.8'
- TBM#3 - "X" - 579.96'
~760' Northeast from the Northwest corner of subject property near the intersection of Conner Ln. & Chapel Ct.
N=7,080,175.7' E=2,558,146.1'
- TBM#4 - PK Nail - 554.84'
~900' Northeast from the Northeast corner of subject property at the south edge of a cul-de-sac on Alameda Cir.
N=7,079,803.4' E=2,559,558.0'
- TBM#5 - "X" - 584.19'
~1040' Southeast from the southeast corner of subject property on a headwall on the north side of the intersection of FM 1378 & Sals Lages Trail.
N=7,076,568.5' E=2,559,653.8'

LEGEND

C.R.F.	Capped Rebar Found	Overhead Power Lines
C.R.S.	Capped Rebar Set	Down Guy Wire
C.M.	Control Monument	Existing Contours
Mon.	Monument	Proposed Contours
BM	Benchmark	Concrete Pavement
FH	Fire Hydrant	Asphalt Pavement
WM	Water Meter	Wood Fence
WV	Water Valve	Chain Link Fence
W/L	Water Line	Wire Fence
ICV	Irrigation Control Valve	Masonry Wall
SSMH	Sanitary Sewer Manhole	Existing Tree
CO	Sanitary Sewer Cleanout	(FL) Flowline
UP	Utility Pole	Centerline of Creek, Swale, or Waterway
LP	Light Pole	Creek, Swale, or Waterway Embankment
TC	Top of Curb	
TP	Top of Pavement	
TW	Top of Wall	
FG	Finished Grade	
U.E.	Utility Easement	
D.E.	Drainage Easement	
B.L.	Building Line	
R.O.W.	Right-of-Way	
D.R.	Deed Records	
P.R.	Plat Records	

GENERAL NOTES


1. THE CITY OF LUCAS CONSTRUCTION STANDARDS APPLY WHETHER INDICATED ON THESE PLANS OR NOT.




AS-BUILT RECORD DRAWING

THE INFORMATION ON THESE PLANS HAS BEEN REVISED TO REFLECT CHANGES TO PUBLIC IMPROVEMENTS MADE DURING CONSTRUCTION PROVIDED TO ENGINEER BY THE CONTRACTOR. UNLESS OTHERWISE NOTED, THE CONSTRUCTION OF THE PUBLIC IMPROVEMENTS IS IN GENERAL CONFORMANCE WITH THESE PLANS. BASED UPON INFORMATION PROVIDED BY THE CONTRACTOR, AND THE RESPONSIBILITY FOR ACCURACY AND COMPLETION OF THESE PLANS BELONGS TO THE CONTRACTOR.

Douglas W. Weaver
G & A Consultants, LLC.

Date: 11/23/2015

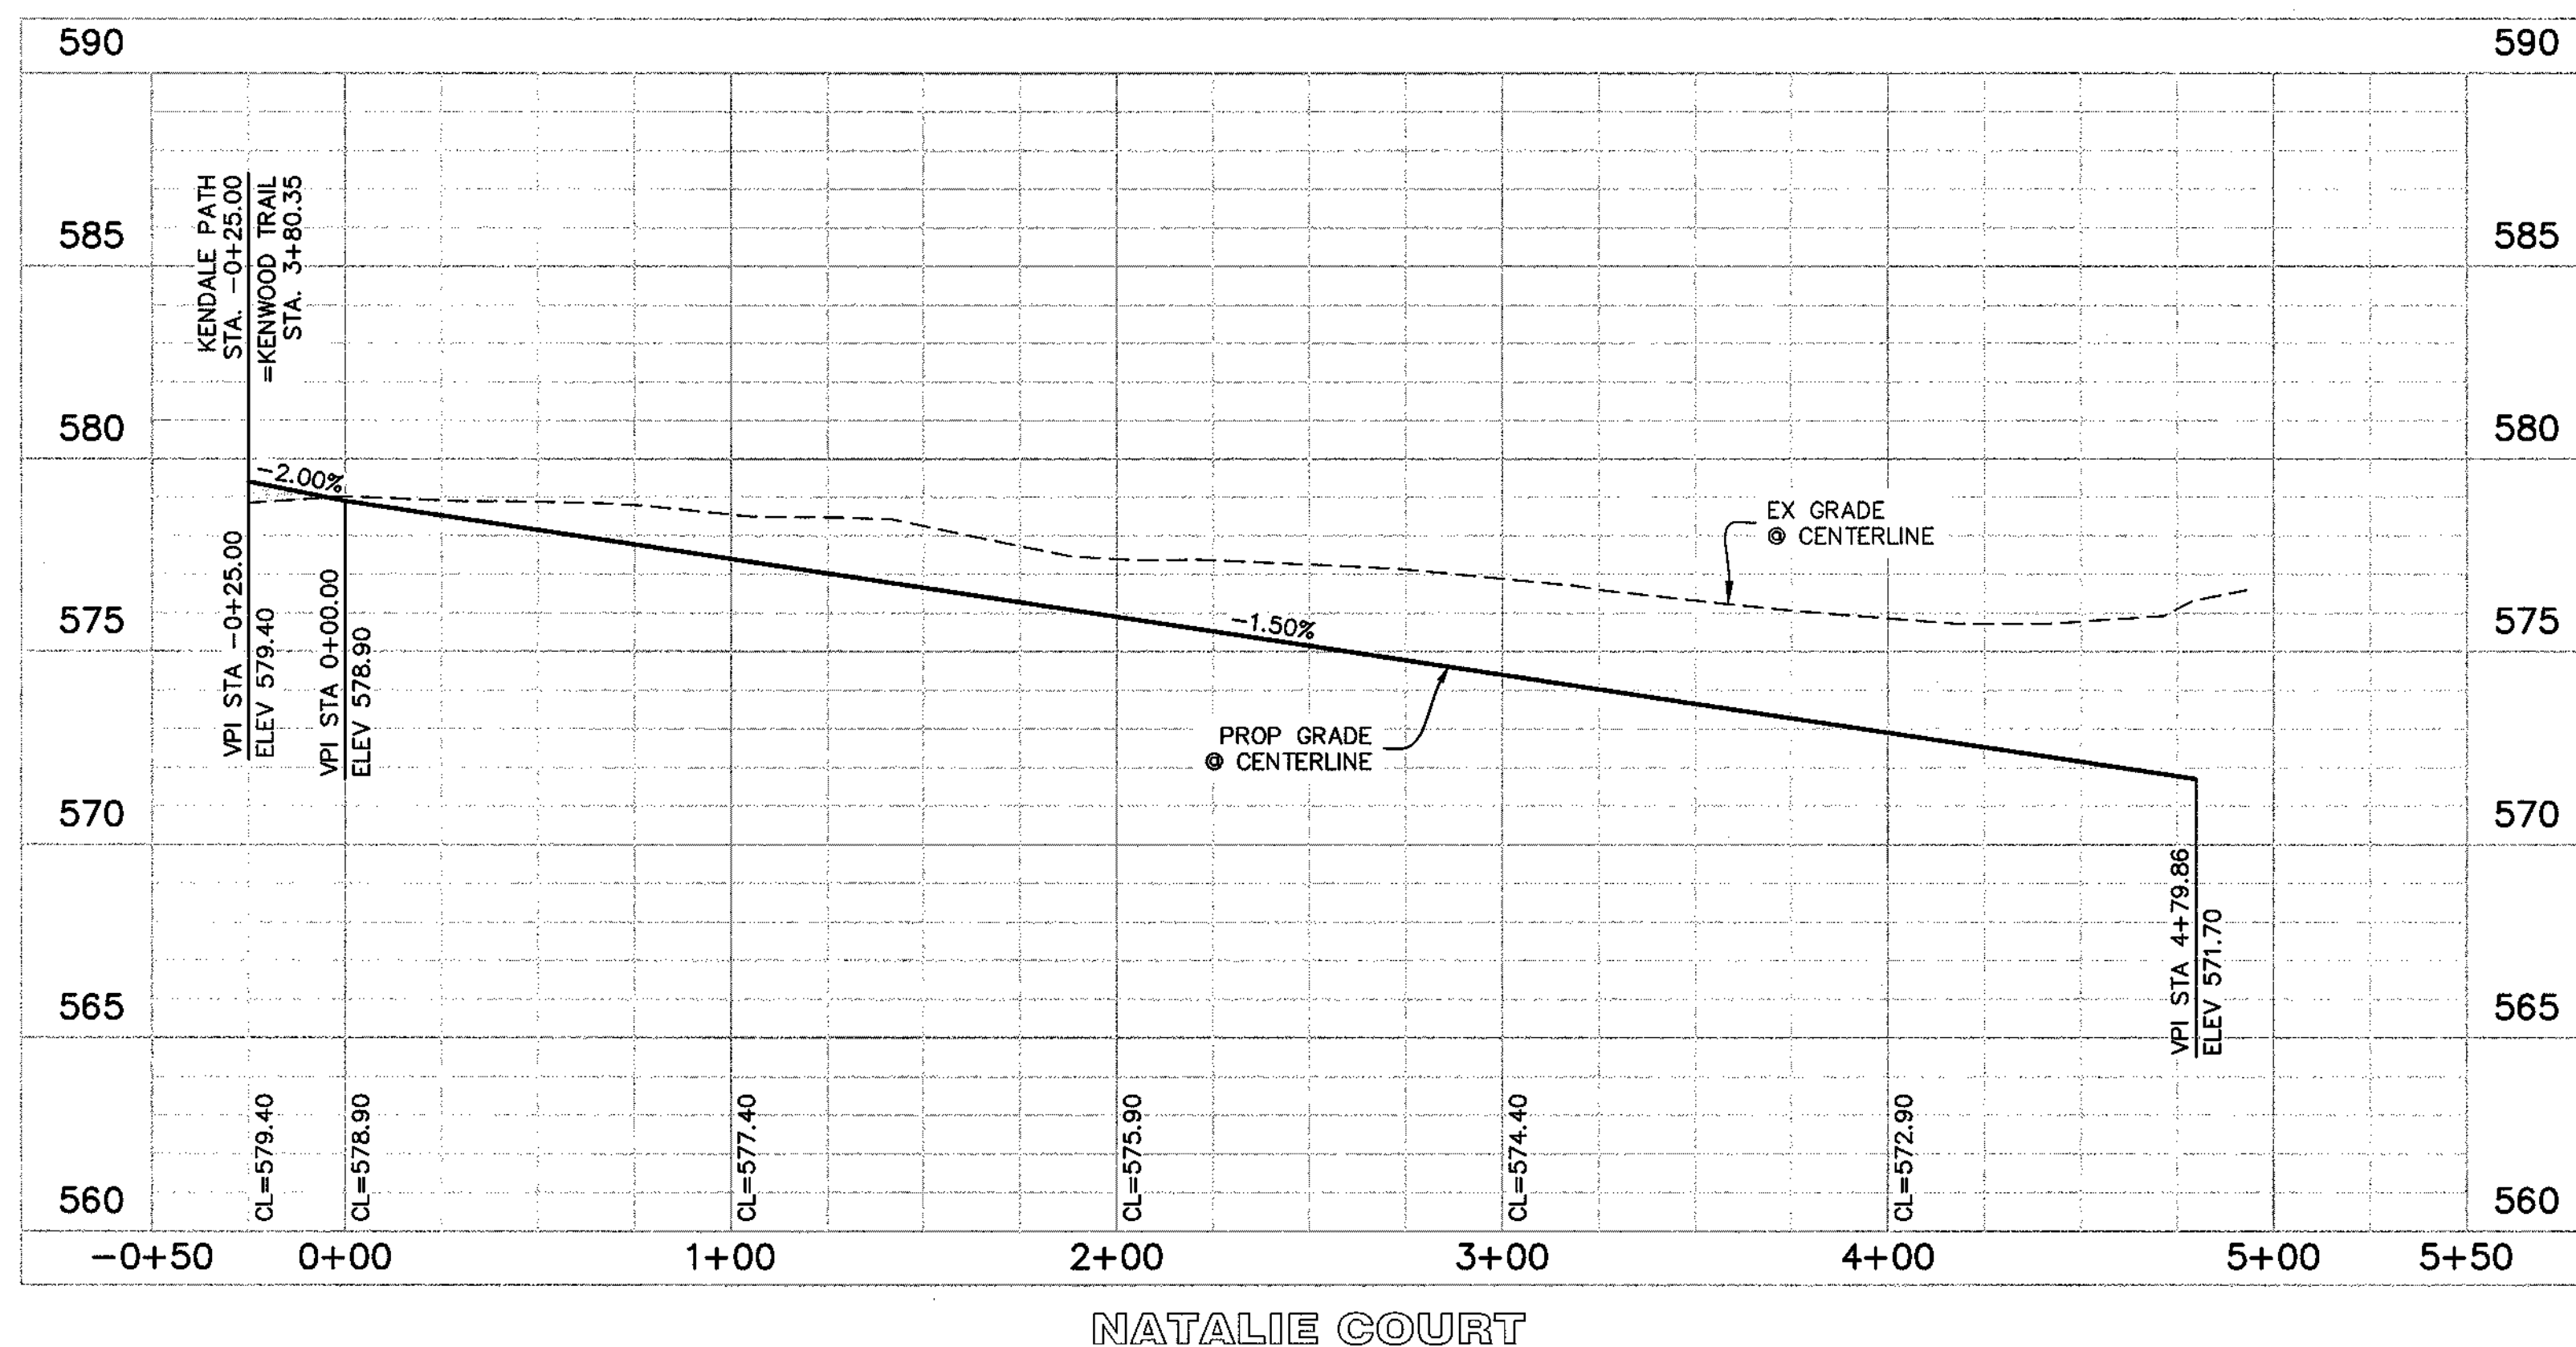

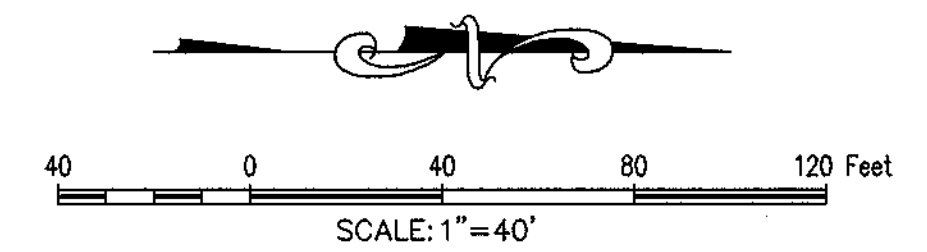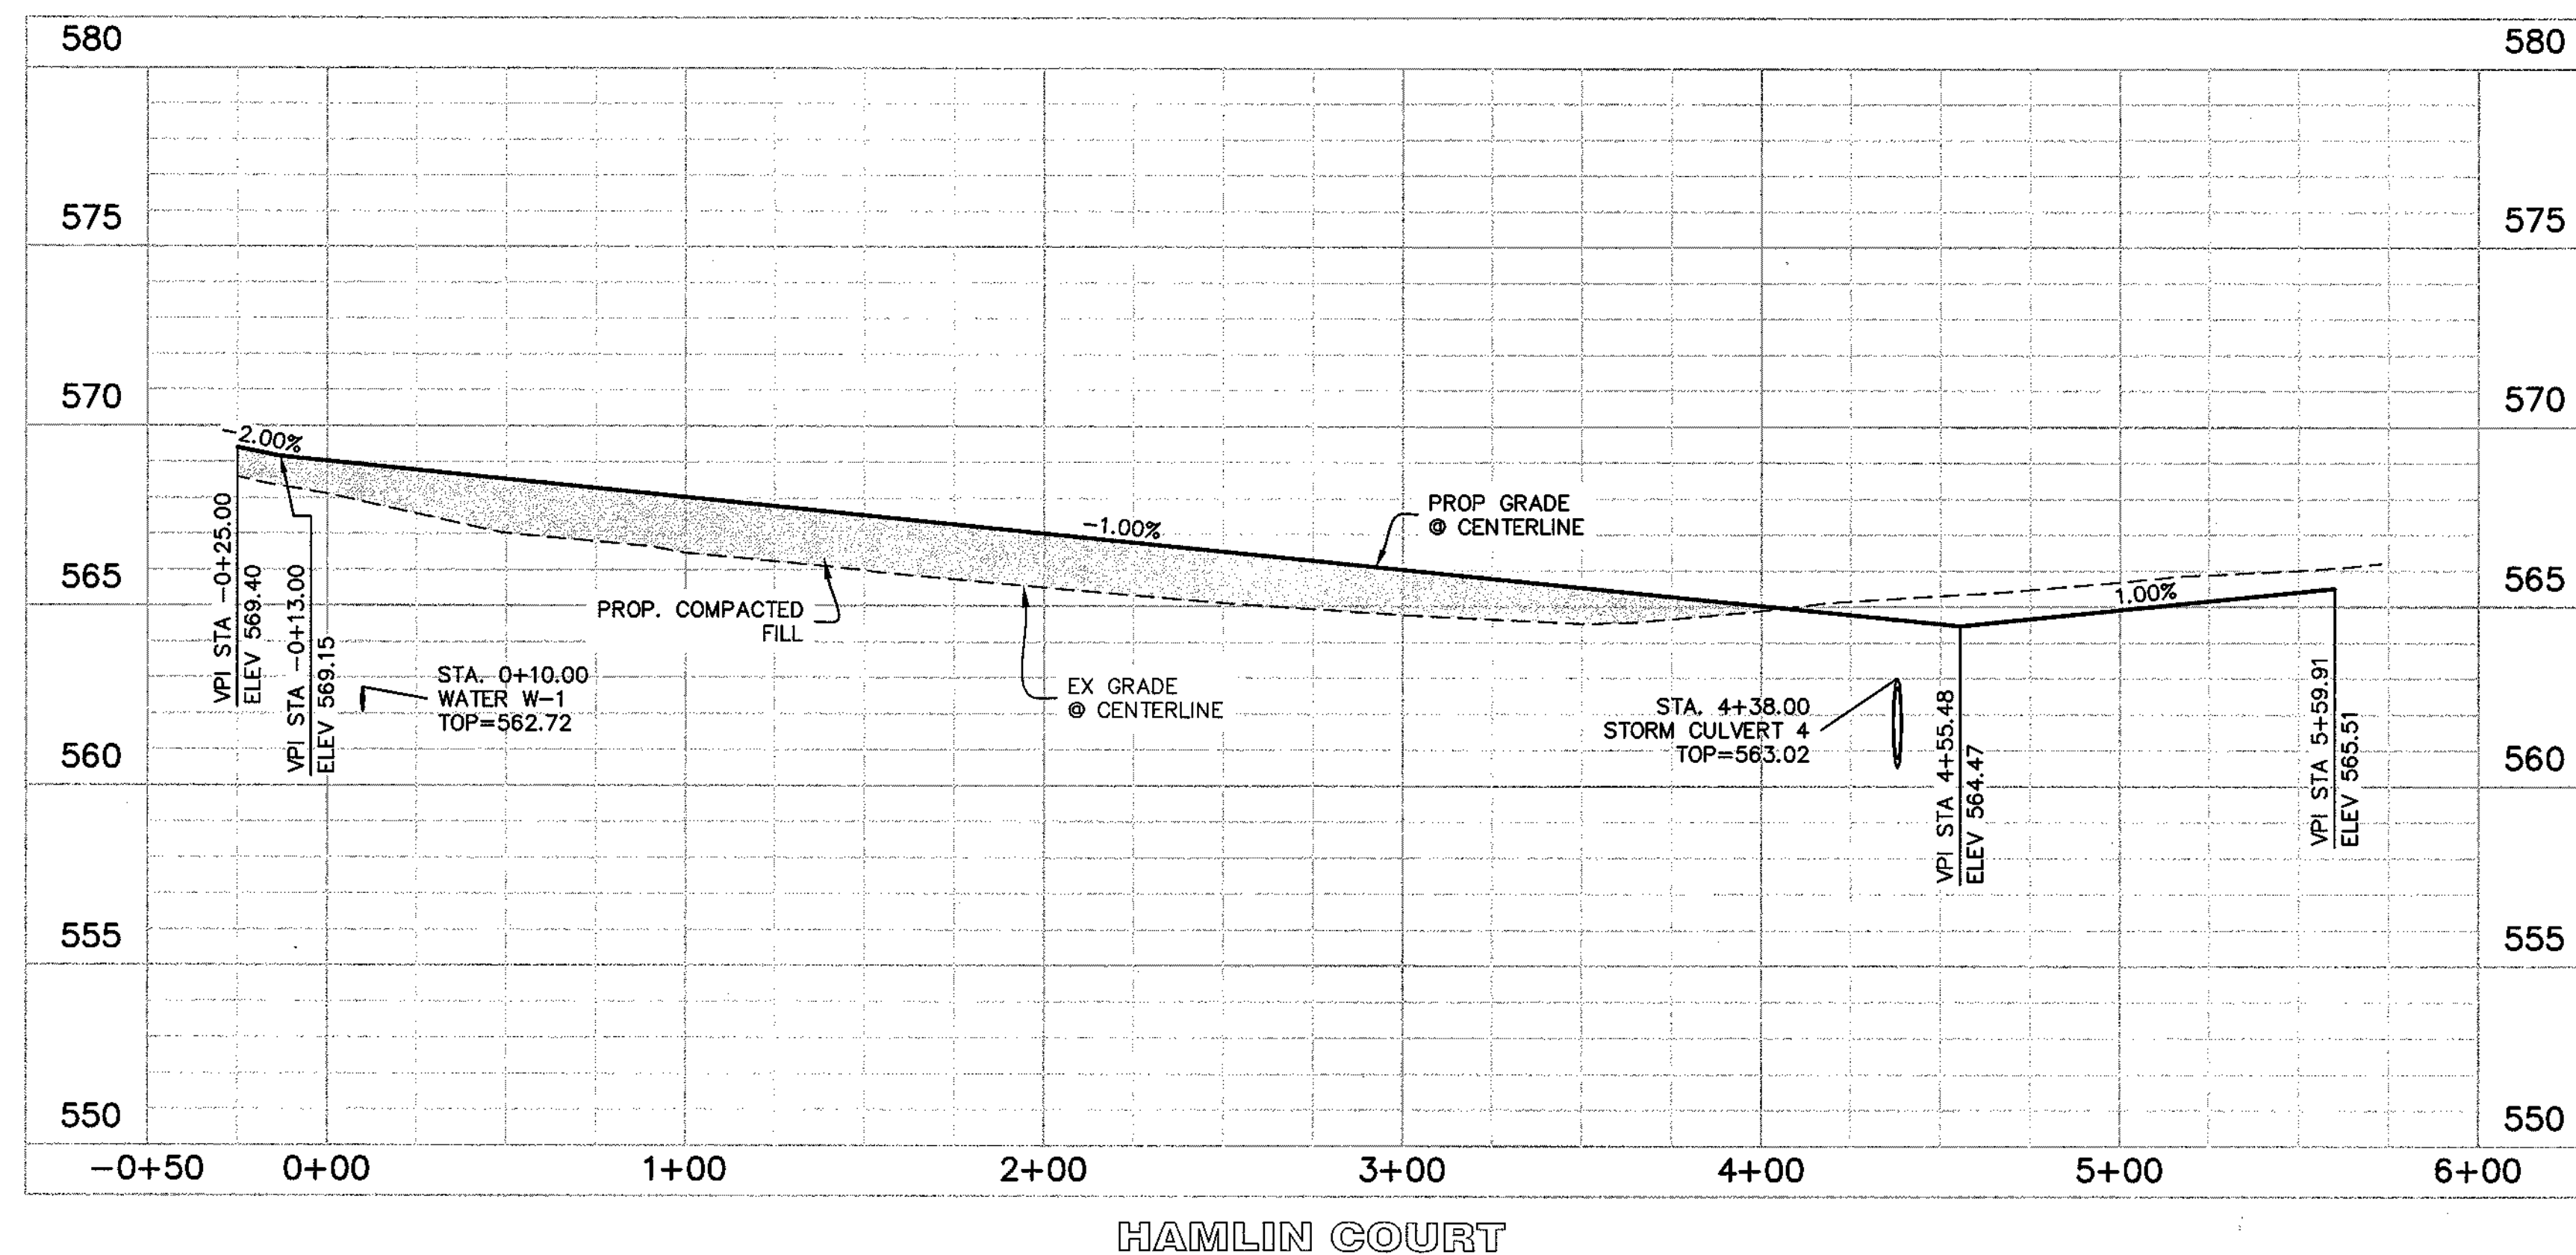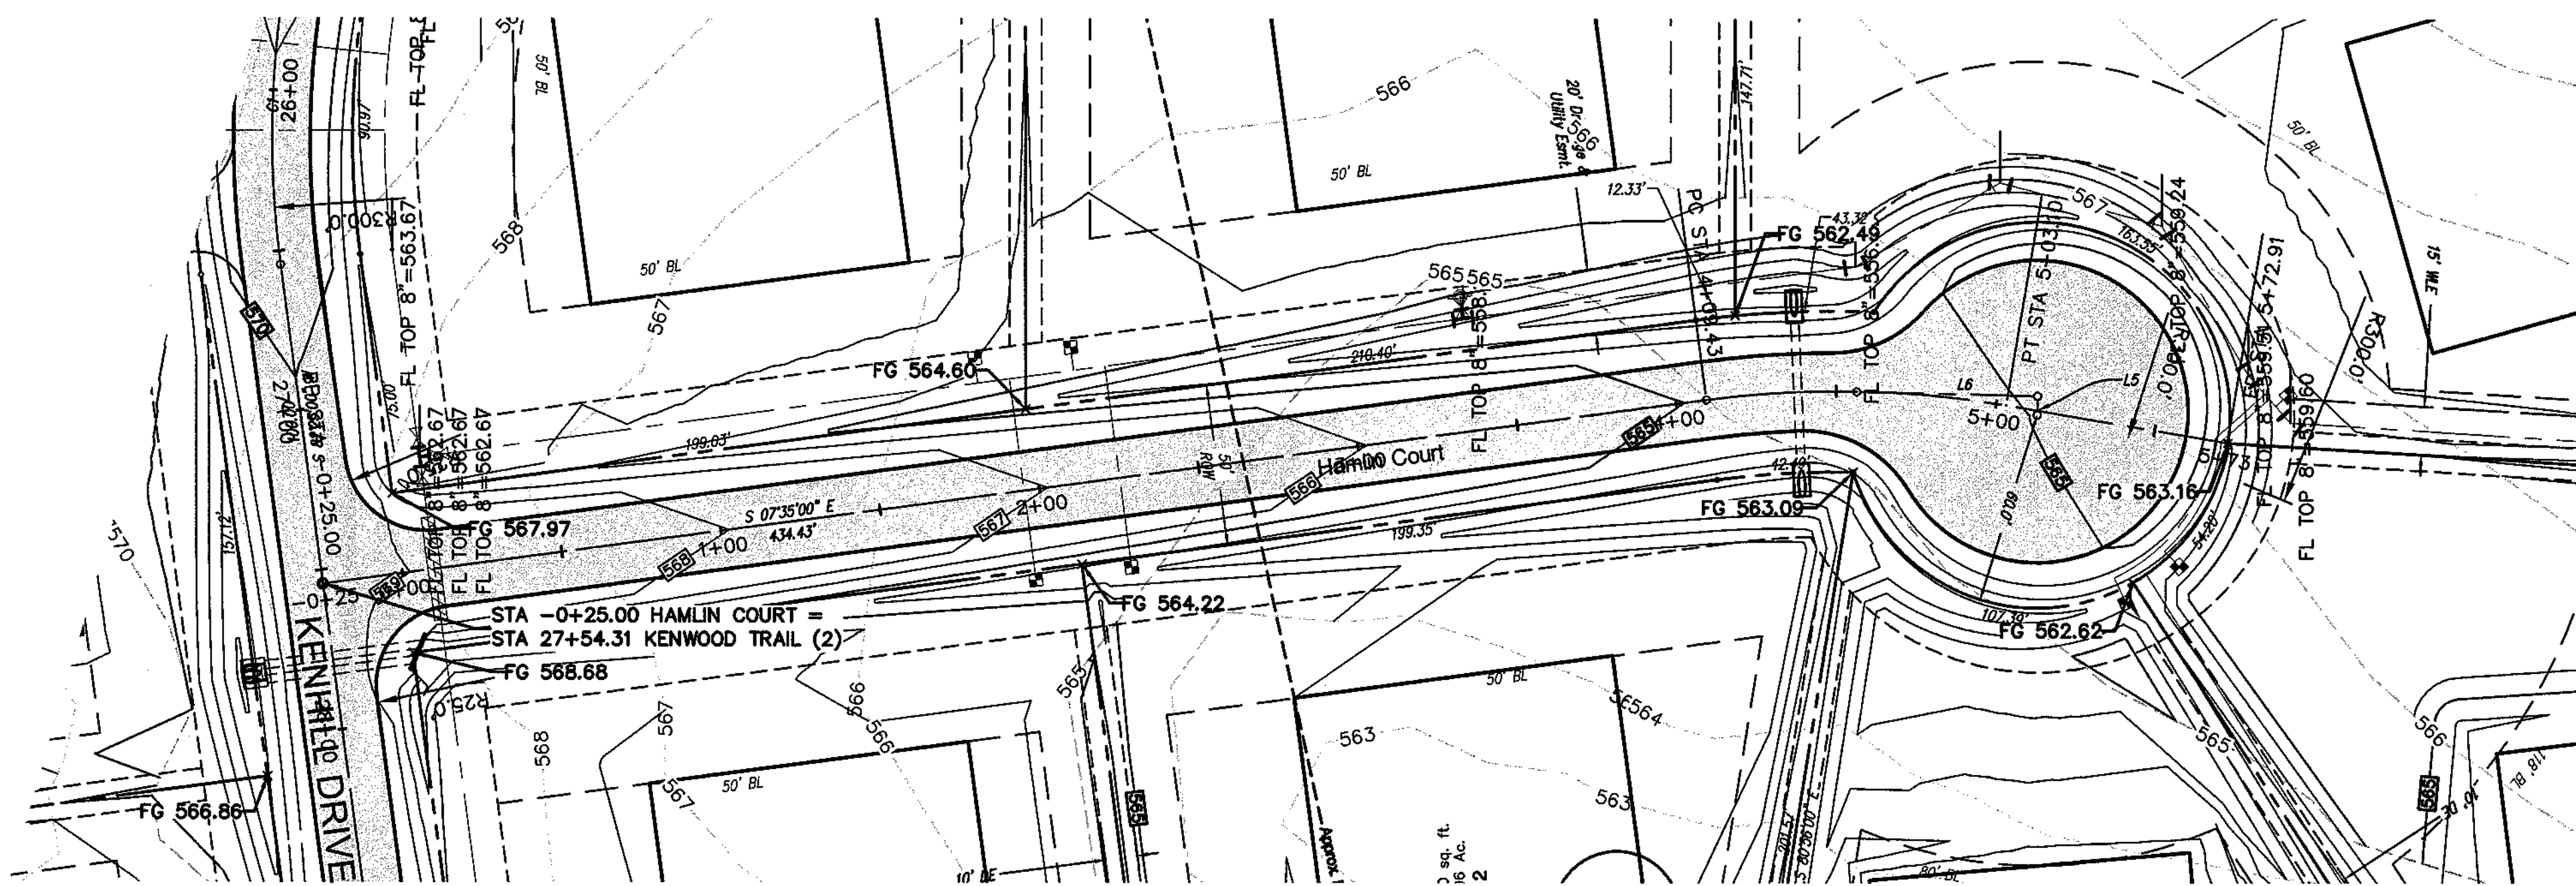

BENCHMARKS:

BM#1 - RM133 - 590.08'

Square cut on east headwall of west of bridge at White Rock
Creek (East) and FM 1378. Map# 48085C0455G, Dated January
19th, 1996.

TBM#2 - Square Cut - 569.45'

N=7,079,521.1' E=2,557,109.8'

TBM#3 - "X" - 579.96'

N=7,080,175.7' E=2,558,146.1

TBM#4 - PK Nail - 554.84'

N=7,079,803.4' E=2,559,558.0'

TBM#5 - "X" - 584.19'

~1040' Southeast from the southeast corner of subject property on a headwall on the north side of the intersection of FM 1378 & Seis Lagos Trail.

LEGEND

C.R.F.	Capped Rebar Found		Overhead Power Lines
C.R.S.	Capped Rebar Set		Down Guy Wire
C.M.	Control Monument		Existing Contours
Mon.	Monument		Proposed Contours
BM	Benchmark		Concrete Pavement
FM	Fire Hydrant		Asphalt Pavement
WM	Water Meter		Wood Fence
WV	Water Valve		Chain Link Fence
W/L	Water Line		Wire Fence
ICV	Irrigation Control Valve		Masonry Wall
SSMH	Sanitary Sewer Manhole		Existing Tree
CO	Sanitary Sewer Cleanout		(FL) Flowline
UP	Utility Pole		Centerline of Creek, Swale, or Waterway
LP	Light Pole		Creek, Swale, or Waterway Embankment
TC	Top of Curb		
TP	Top of Pavement		
TW	Top of Wall		
FG	Finished Grade		
UE	Utility Easement		
D.E.	Drainage Easement		
B.L.	Building Line		
R.O.W.	Right-of-Way		
D.R.	Deed Records		
P.R.	Plot Records		

GENERAL NOTES


1. THE CITY OF LUCAS CONSTRUCTION STANDARDS APPLY WHETHER INDICATED ON THESE PLANS OR NOT.

**AS-BUILT
RECORD DRAWING**

THE INFORMATION ON THESE PLANS HAS BEEN REVISED TO REFLECT CHANGES TO PUBLIC IMPROVEMENTS MADE DURING CONSTRUCTION PROVIDED TO ENGINEER BY THE CONTRACTOR. UNLESS OTHERWISE NOTED, THE CONSTRUCTION OF THE PUBLIC IMPROVEMENTS IS IN GENERAL CONFORMANCE WITH THESE PLANS BASED UPON INFORMATION PROVIDED BY THE CONTRACTOR, AND THE RESPONSIBILITY FOR ACCURACY AND COMPLETENESS BELONGS TO THE CONTRACTOR.

Douglas W. Weaver
G & A Consultants, LLC.

Date: 11/23/2015

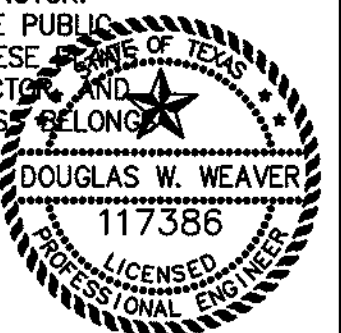

G&A CONSULTANTS, LLC.
TBPE F-1798

Drawn By: TJF

ate: 11/07/2014

Revisions:

1998, 1999, 2000, 2679, 26

14026



14020

© 2006 The Authors

(C11)

(c)

11

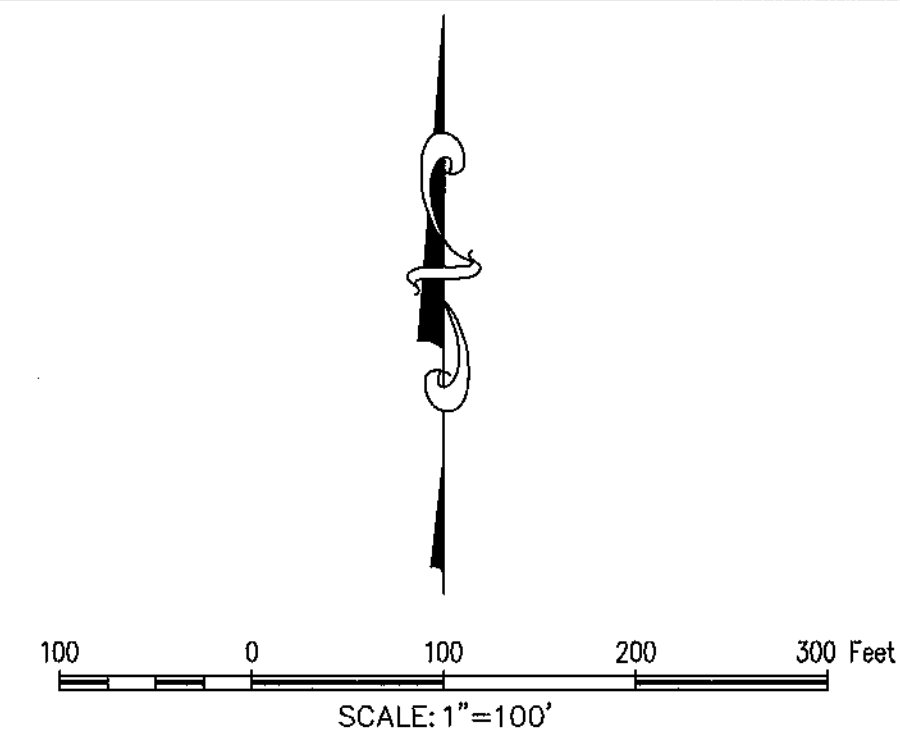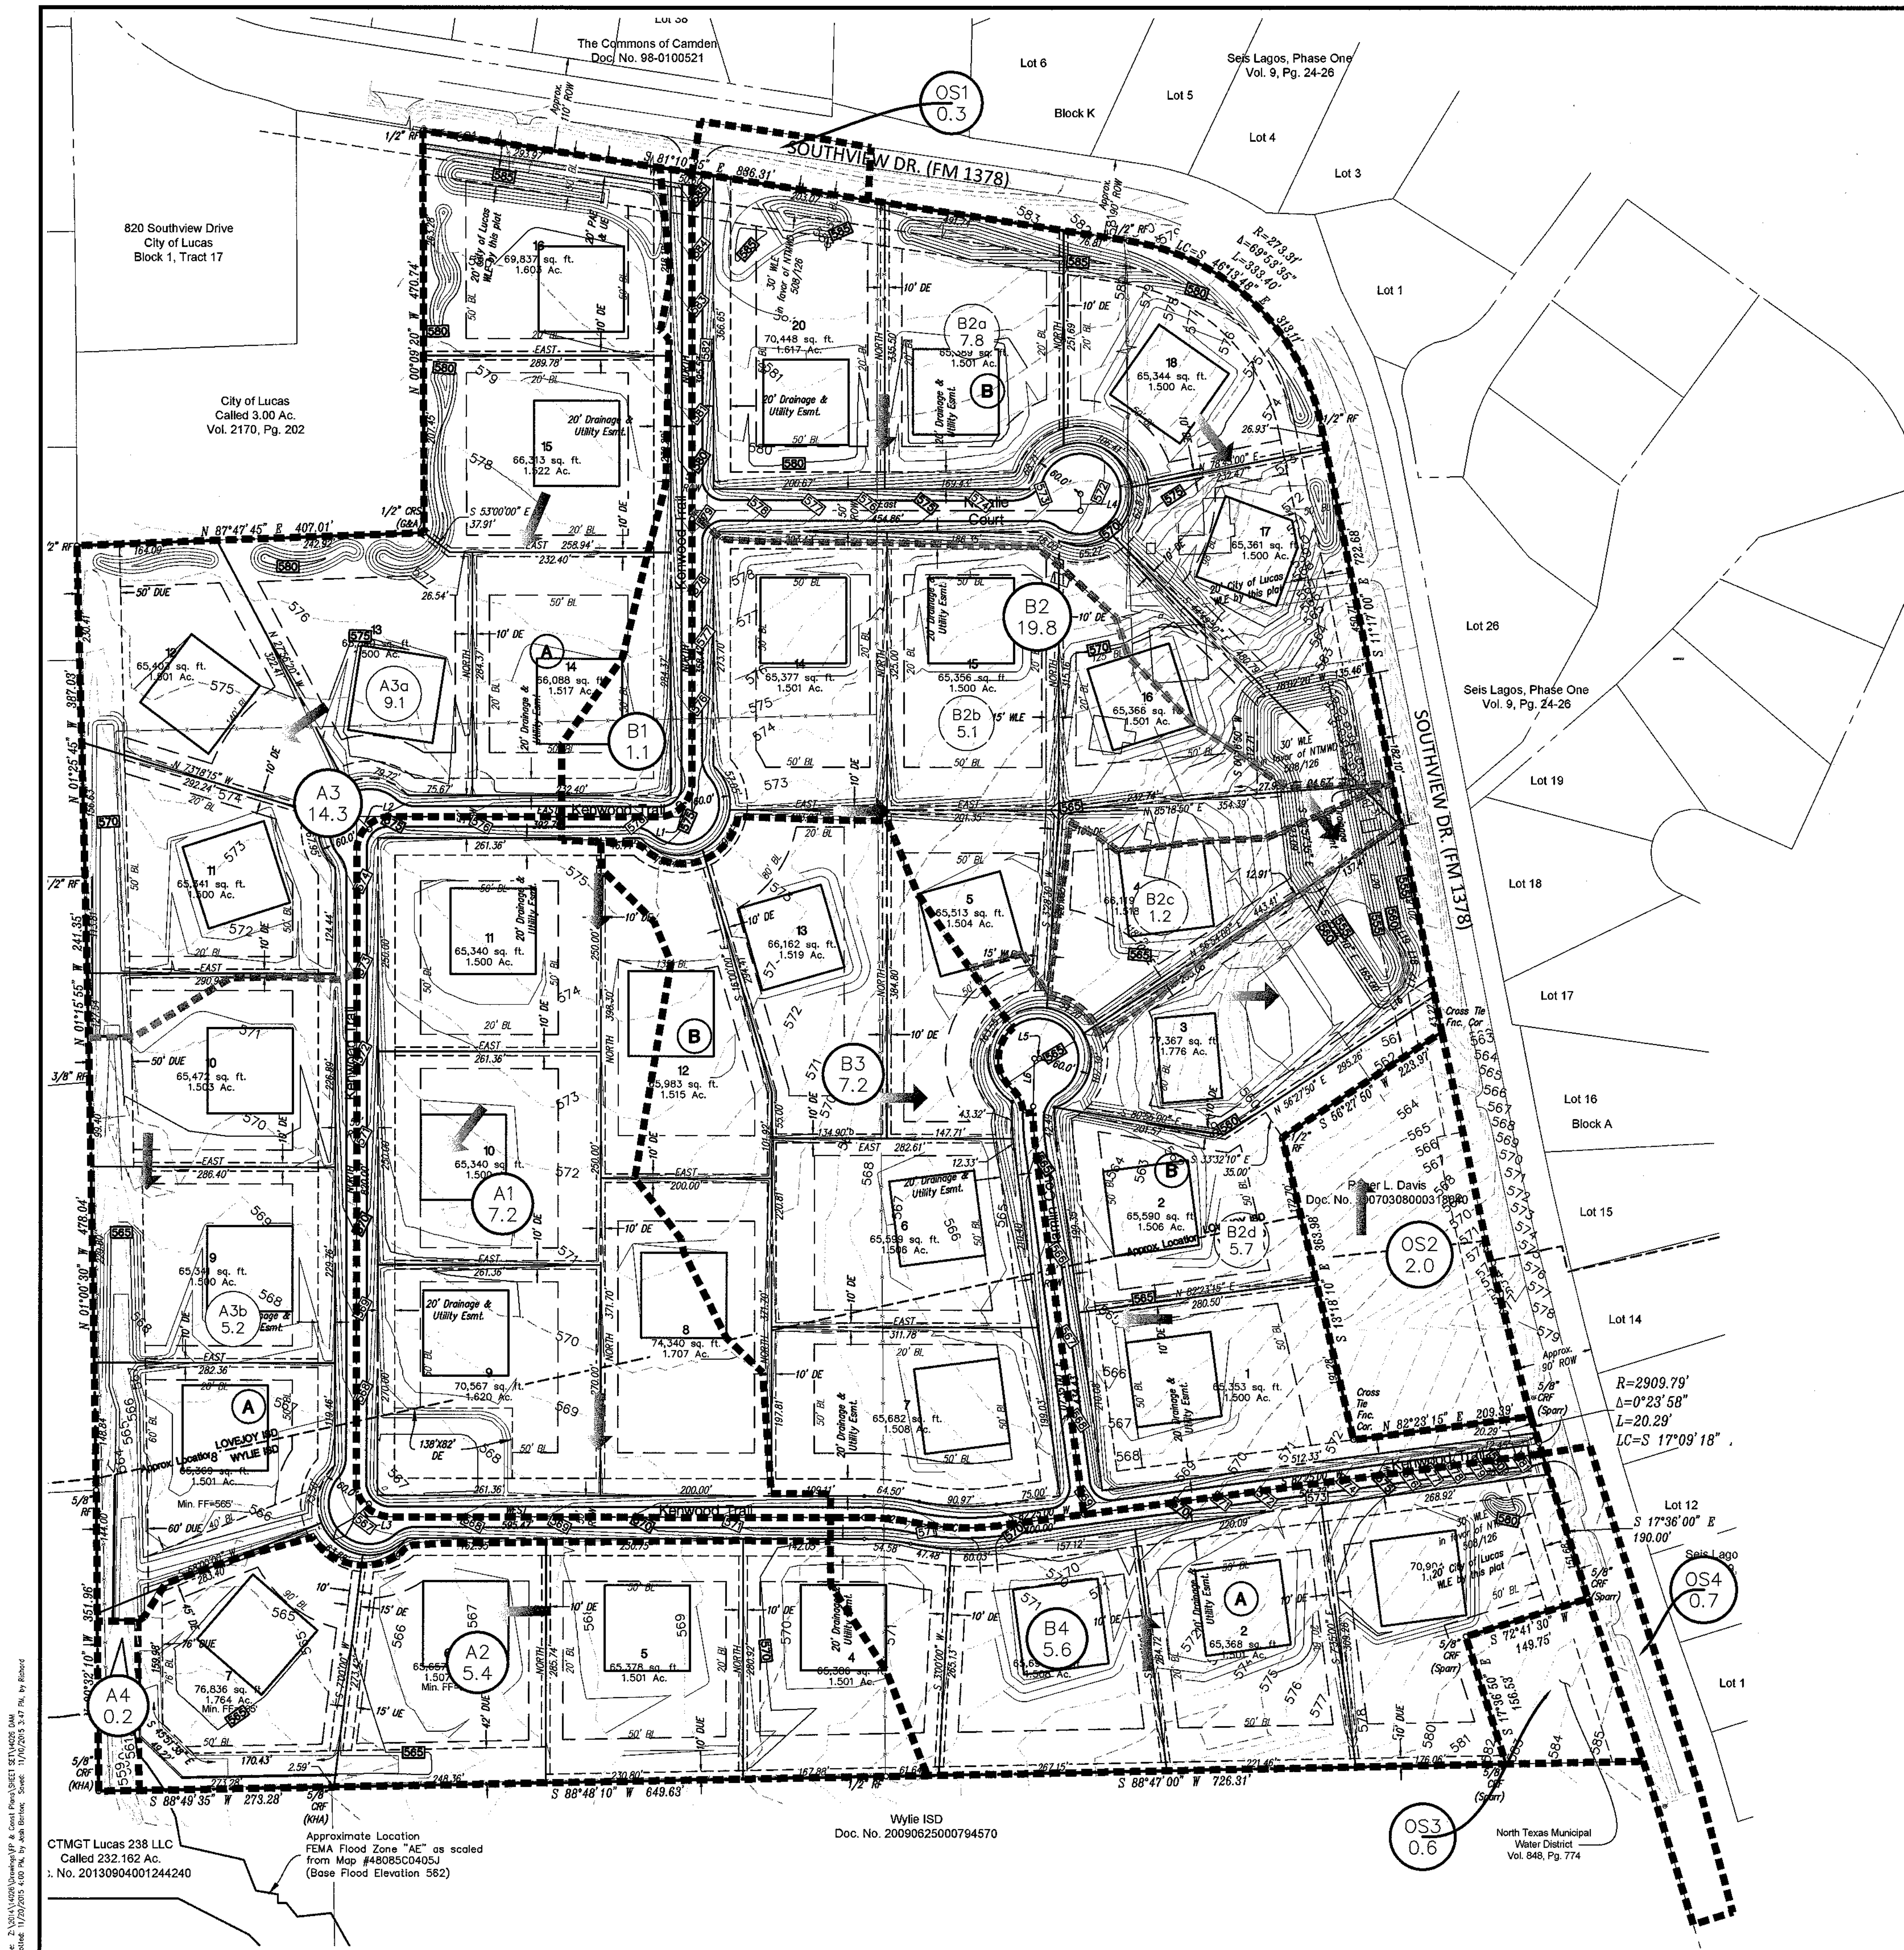

BENCHMARKS:

BM#1 - RM133 - 590.08'
Square cut on east headwall of west of bridge at White Rock Creek (East) and FM 1378. Map# 48085C04556, Dated January 19th, 1996.

TBM#2 - Square Cut - 569.45'
~981' Southwest from the Northwest corner of subject property on south edge of Brookhaven Dr.
N=7,079,521.1' E=2,557,109.8'

TBM#3 - "X" - 579.96'
~760' Northeast from the Northwest corner of subject property near the intersection of Conner Ln. & Chapel Ct.
N=7,080,175.7' E=2,558,146.1'

TBM#4 - PK Nail - 554.84'
~900' Northeast from the Northeast corner of subject property at the south edge of a cul-de-sac on Alameda Cir.
N=7,079,803.4' E=2,559,558.0'

TBM#5 - "X" - 584.19'
~1040' Southeast from the southeast corner of subject property on a headwall on the north side of the intersection of FM 1378 & Seis Lagos Trail.
N=7,076,568.5' E=2,559,653.8'

PROPOSED DRAINAGE CALCULATIONS						
Drainage Area	Area (Ac)	C	Tc (min)	I (in/hr)	Q100 (cfs)	Comments
OS1	0.3	0.45	10	9.2	1.2	SHEET FLOW TO SOUTHVIEW DRIVE
OS4	0.7	0.45	10	9.2	2.9	SHEET FLOW TO SOUTHVIEW DRIVE
A1	7.2	0.45	10	9.2	29.8	SHEET FLOW TO BAR DITCH THEN TO FLOOD ZONE
A2	5.4	0.45	10	9.2	22.4	SHEET FLOW TO STREET STORM CULVERT
A3	14.3	0.45	10	9.2	59.2	SHEET FLOW TO DRAINAGE BAR DITCH
A4	0.2	0.45	10	9.2	0.8	SHEET FLOW TO DRAINAGE SWALE THEN TO FLOOD ZONE
TOTAL A	27.1				112.2	
B1	1.1	0.45	10	9.2	4.6	SHEET FLOW TO KENDALE PATH BAR DITCH
B2	19.8	0.45	10	9.2	82.0	SHEET FLOW TO SWALE
B3	7.2	0.45	10	9.2	29.8	SHEET FLOW TO STREET STORM CULVERT
B4	5.6	0.45	10	9.2	23.2	SHEET FLOW TO DETENTION POND
	33.7				139.5	
OS2	2.0	0.45	10	9.2	8.1	SHEET FLOW TO DRAINAGE SWALE
OS3	0.6	0.45	10	9.2	2.6	SHEET FLOW TO DRAINAGE SWALE
TOTAL B	36.3				150.2	
A1	7.2	0.45	10	9.2	29.8	SHEET FLOW TO BAR DITCH ON KENWOOD TRAIL THEN TO FLOOD ZONE
A2	5.4	0.45	10	9.2	22.4	SHEET FLOW TO DETENTION A2 THEN TO FLOOD ZONE
A3a	9.1	0.45	10	9.2	37.7	SHEET FLOW TO DRAINAGE SWALE THEN TO DETENTION A3a
A3b	5.2	0.45	10	9.2	21.5	SHEET FLOW TO DRAINAGE SWALE THEN TO DETENTION A3b THEN TO FLOOD ZONE
A4	0.2	0.45	10	9.2	0.8	SHEET FLOW TO FLOOD ZONE
TOTAL A	27.1				112.2	

LEGEND		
C.R.F.	Capped Rebar Found	Overhead Power Lines
C.R.S.	Capped Rebar Set	Down Guy Wire
C.M.	Control Monument	Existing Contours
Mon.	Monument	Proposed Contours
BM	Benchmark	Concrete Pavement
FM	Fire Hydrant	Asphalt Pavement
WM	Water Meter	Wood Fence
WV	Water Valve	Chain Link Fence
W/L	Water Line	Wire Fence
ICV	Irrigation Control Valve	Masonry Wall
SSMH	Sanitary Sewer Manhole	Existing Tree
CO	Control	(FL) Flowline
UP	Utility Pole	Centerline of Creek, Swale, or Waterway
LP	Light Pole	Creek, Swale, or Waterway Embankment
TC	Top of Curb	
TP	Top of Pavement	
TW	Top of Wall	
FG	Finished Grade	
U.E.	Utility Easement	
D.E.	Drainage Easement	
B.L.	Building Line	
R.O.W.	Right-of-Way	
D.R.	Deed Records	
P.R.	Plot Records	


GENERAL NOTES

1. THE CITY OF LUCAS CONSTRUCTION STANDARDS APPLY WHETHER INDICATED ON THESE PLANS OR NOT.

AS-BUILT RECORD DRAWING

THE INFORMATION ON THESE PLANS HAS BEEN REVISED TO REFLECT CHANGES TO PUBLIC IMPROVEMENTS MADE DURING CONSTRUCTION PROVIDED TO ENGINEER BY THE CONTRACTOR. UNLESS OTHERWISE NOTED, THE CONSTRUCTION OF THE PUBLIC IMPROVEMENTS IS IN GENERAL CONFORMANCE WITH THE SPECIFICATIONS AND BASED UPON INFORMATION PROVIDED BY THE CONTRACTOR. THE RESPONSIBILITY FOR ACCURACY AND COMPLETENESS BELONGS TO THE CONTRACTOR.

Douglas W. Weaver
G & A Consultants, LLC.
Date: 11/23/2015

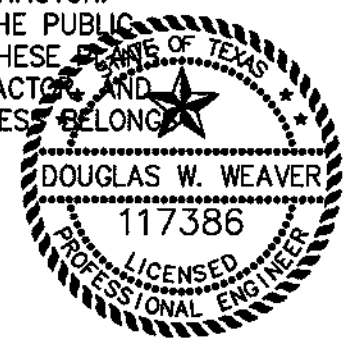

G & A CONSULTANTS, LLC.
TBPE F-1798

Drawn By: TAC
Date: 11/07/2014
Scale: 1" = 100'
Revisions:

14026

C13

OWNER/DEVELOPER
CAGG LEWIS PARK LLC
C/O LENART DEVELOPMENT COMPANY, LLC
520 CENTRAL PARKWAY E. SUITE 104
PLANO, TX 75074
Ph. (972) 422-9880
Contact Steve Lenart

File: 2/10/14/14026/Drawings/14026.dwg
Title: 11/23/2015 4:09 PM by GWA
Source: 11/23/2015 4:09 PM by GWA

CTMGT Lucas 238 LLC
Called 232.162 Ac.
No. 20130904001244240

Approximate Location
FEMA Flood Zone "AE" as scaled
from Map #48085C0405J
(Base Flood Elevation 562)

Wylie ISD
Doc. No. 20090625000794570

LEWIS PARK ESTATES
Lot 1-16, 1-20, Block A, B
LEWIS PARK ESTATES
60.858 Acres
in the
CITY OF LUCAS
COLLIN COUNTY, TEXAS

CONSULTANTS, LLC
LAND SURVEYING LANDSCAPE ARCHITECTURE
111 Hildebrand Drive • Lewisville, TX 76057 • P. 972.436.9712 • F. 972.436.9715
610 Byron Nelson Blvd. Ste 114 • Rowland, TX 76262 • P. 817.881.9712 • F. 817.880.4043
TBPE Firm No. 1798

PROPOSED DRAINAGE AREA MAP


DETENTION "A1"

Detention Computations for Proposed Development

City of Lucas

	Undeveloped	Developed	Bypass
Area	A= 7.200 AC	7.200 AC	0.000
Runoff Coefficient	C= 0.30	0.45	0.45
Time of Concentration	Tc= 20.0 MIN	10.0 MIN	10.0
Rainfall Intensity	I100= 6.90 IN/HR	9.20 IN/HR	9.20
Peak Rate of Runoff	Q100= 14.9 CFS	29.8 CFS	0.0
Allowable Outflow	Q100= 14.9 CFS		

Te MIN	I100 IN/HR	Q100 CFS	Inflow CF	Outflow CF	Storage		Required AC-FT
					CF	AC-FT	
5	11.24	36.4	10,921	6,707	4,214	0.097	0.341
10	9.20	29.8	17,876	8,942	8,933	0.205	
15	7.86	25.5	22,908	11,178	11,730	0.269	
20	6.90	22.4	26,830	13,414	13,417	0.308	
30	5.62	18.2	32,751	17,885	14,866	0.341	
40	4.78	15.5	37,180	22,356	14,824	0.340	
50	4.19	13.6	40,729	26,827	13,902	0.319	
60	3.75	12.1	43,702	31,298	12,403	0.285	
70	3.40	11.0	46,267	35,770	10,497	0.241	
80	3.12	10.1	48,529	40,241	8,288	0.190	
90	2.89	9.4	50,557	44,712	5,845	0.134	

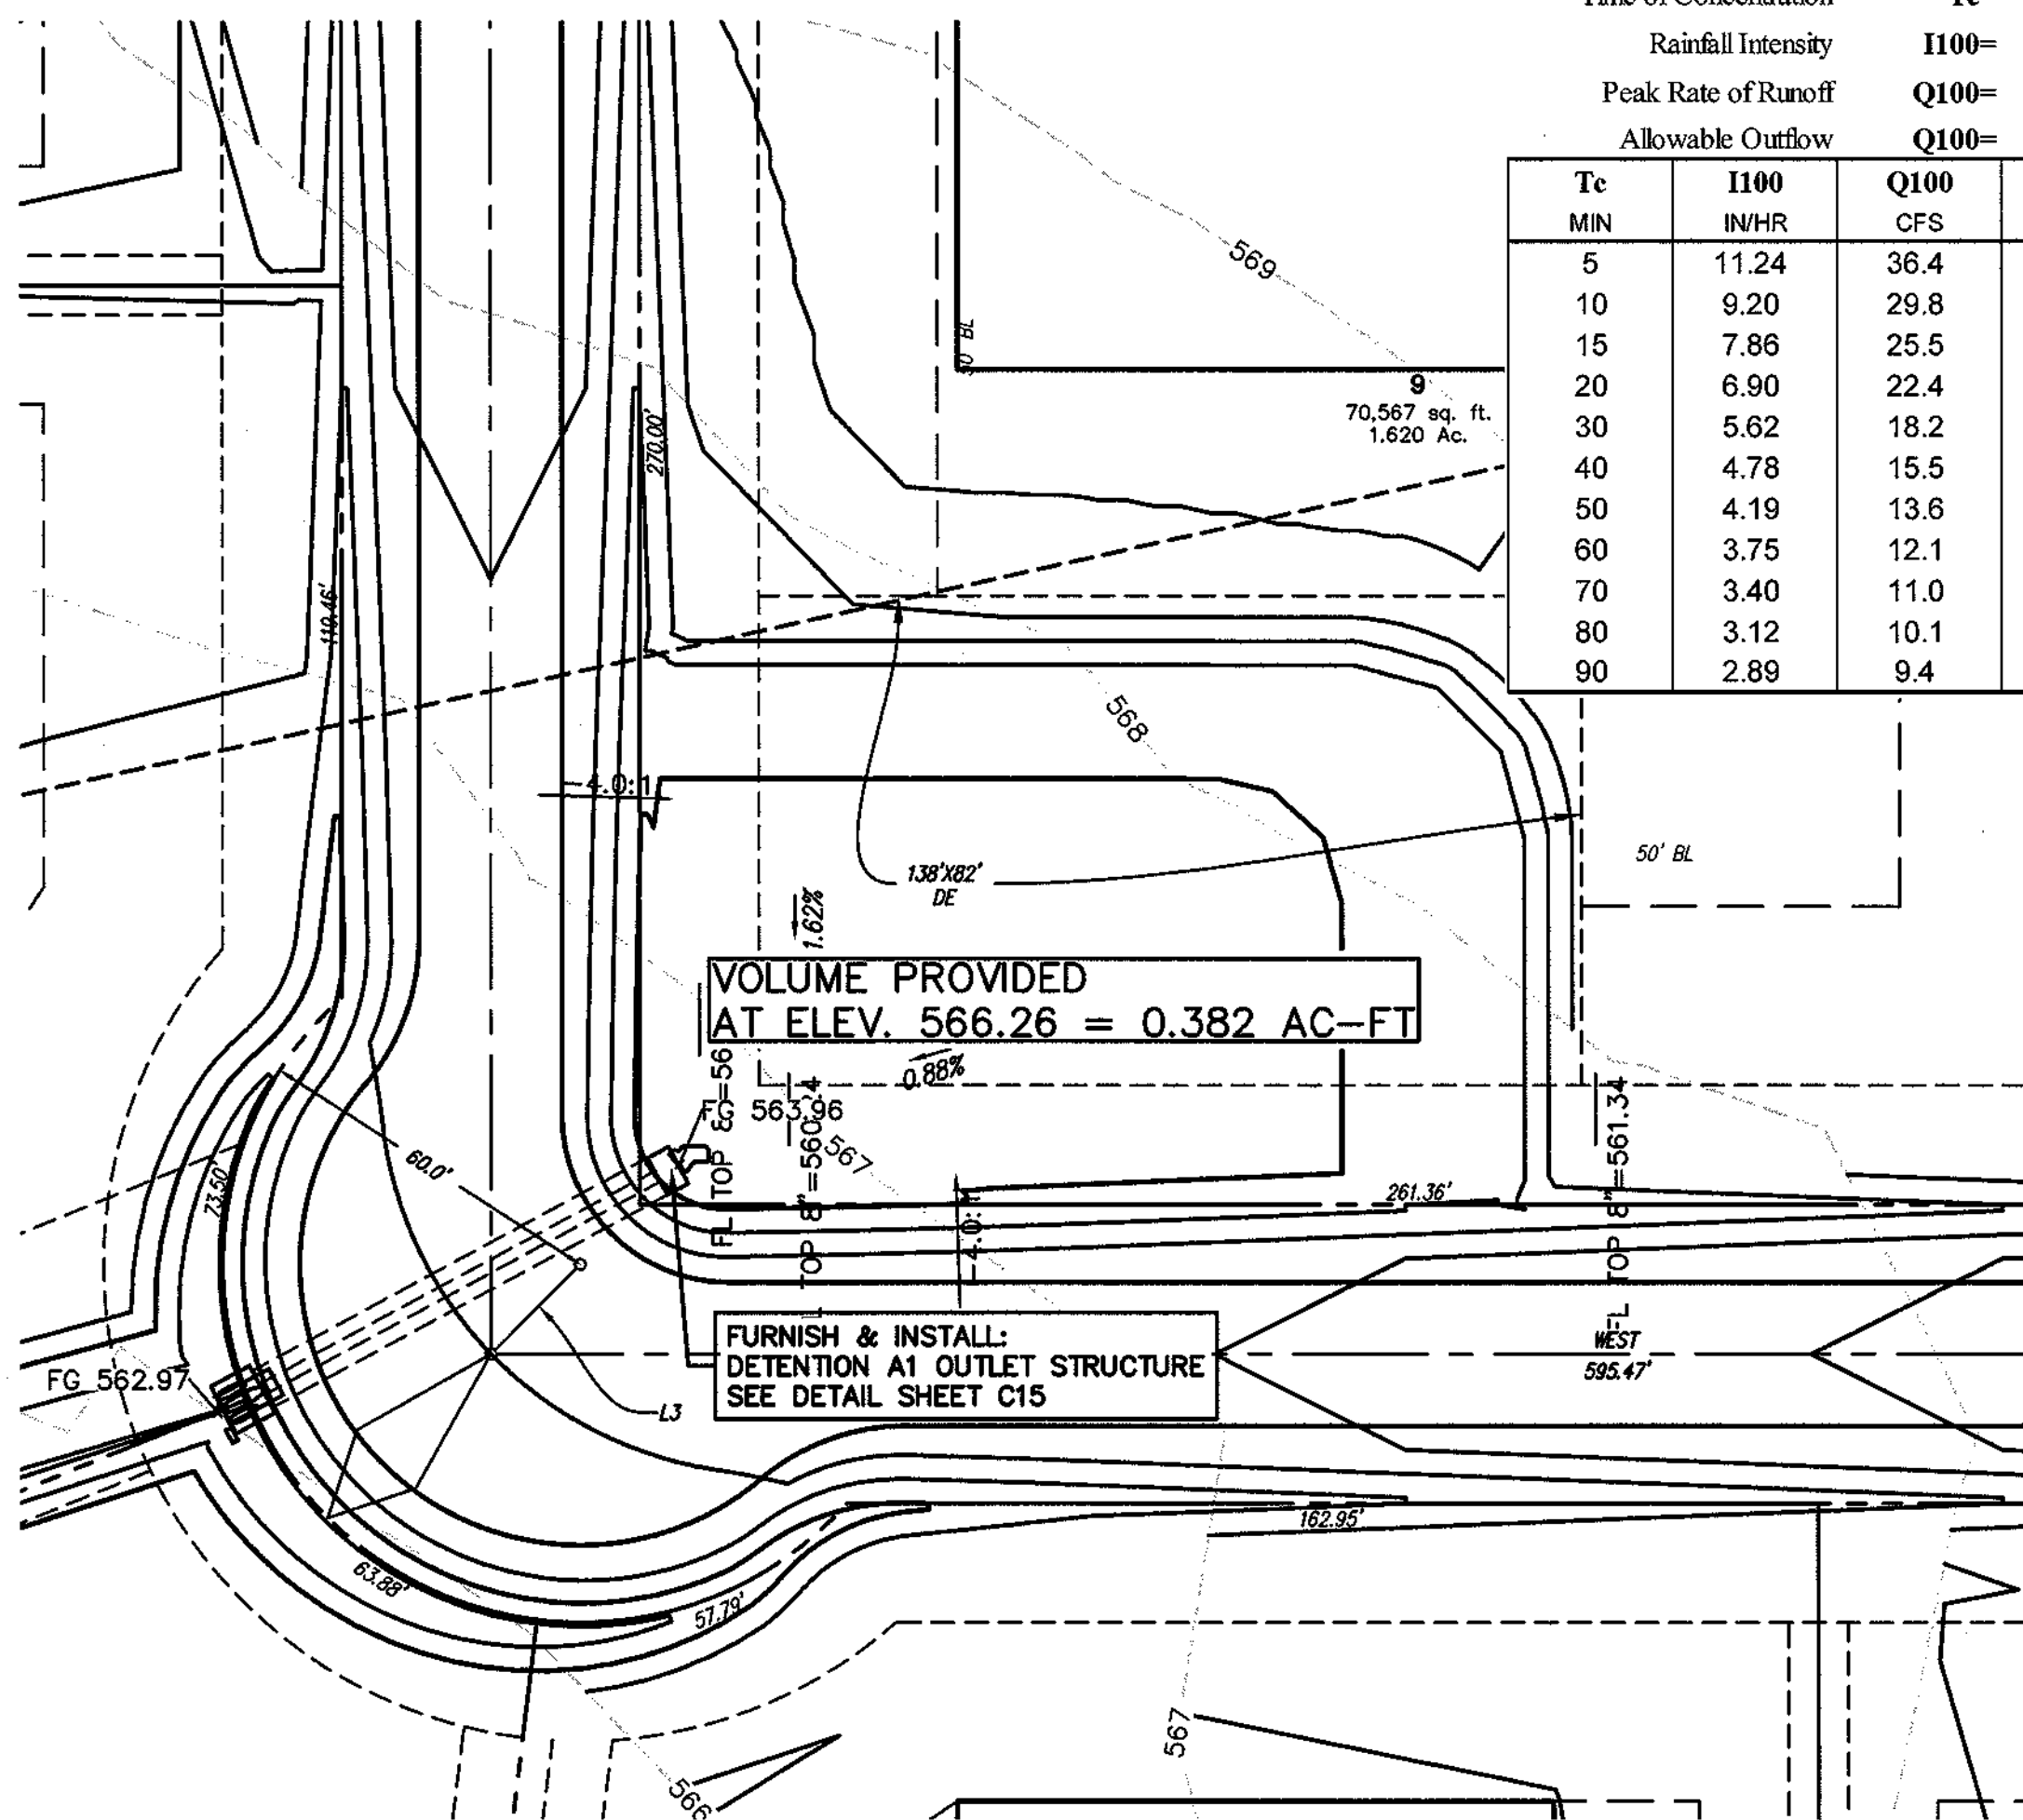


DETENTION "A2"

Detention Computations for Proposed Development

City of Lucas

	Undeveloped	Developed	Bypass
Area	A= 5.400 AC	5.400 AC	0.000
Runoff Coefficient	C= 0.30	0.45	0.45
Time of Concentration	Tc= 20.0 MIN	10.0 MIN	10.0
Rainfall Intensity	I100= 6.90 IN/HR	9.20 IN/HR	9.20
Peak Rate of Runoff	Q100= 11.2 CFS	22.4 CFS	0.0
Allowable Outflow	Q100= 11.2 CFS		

Tc MIN	I100 IN/HR	Q100 CFS	Inflow CF	Outflow CF	Storage		Required AC-FT
					CF	AC-FT	
5	11.24	27.3	8,191	5,030	3,161	0.073	0.256
10	9.20	22.3	13,407	6,707	6,700	0.154	
15	7.86	19.1	17,181	8,384	8,798	0.202	
20	6.90	16.8	20,123	10,060	10,063	0.231	
30	5.62	13.6	24,563	13,414	11,150	0.256	
40	4.78	11.6	27,885	16,767	11,118	0.255	
50	4.19	10.2	30,547	20,120	10,427	0.239	
60	3.75	9.1	32,776	23,474	9,302	0.214	
70	3.40	8.3	34,700	26,827	7,873	0.181	
80	3.12	7.6	36,396	30,181	6,216	0.143	
90	2.89	7.0	37,917	33,534	4,383	0.101	

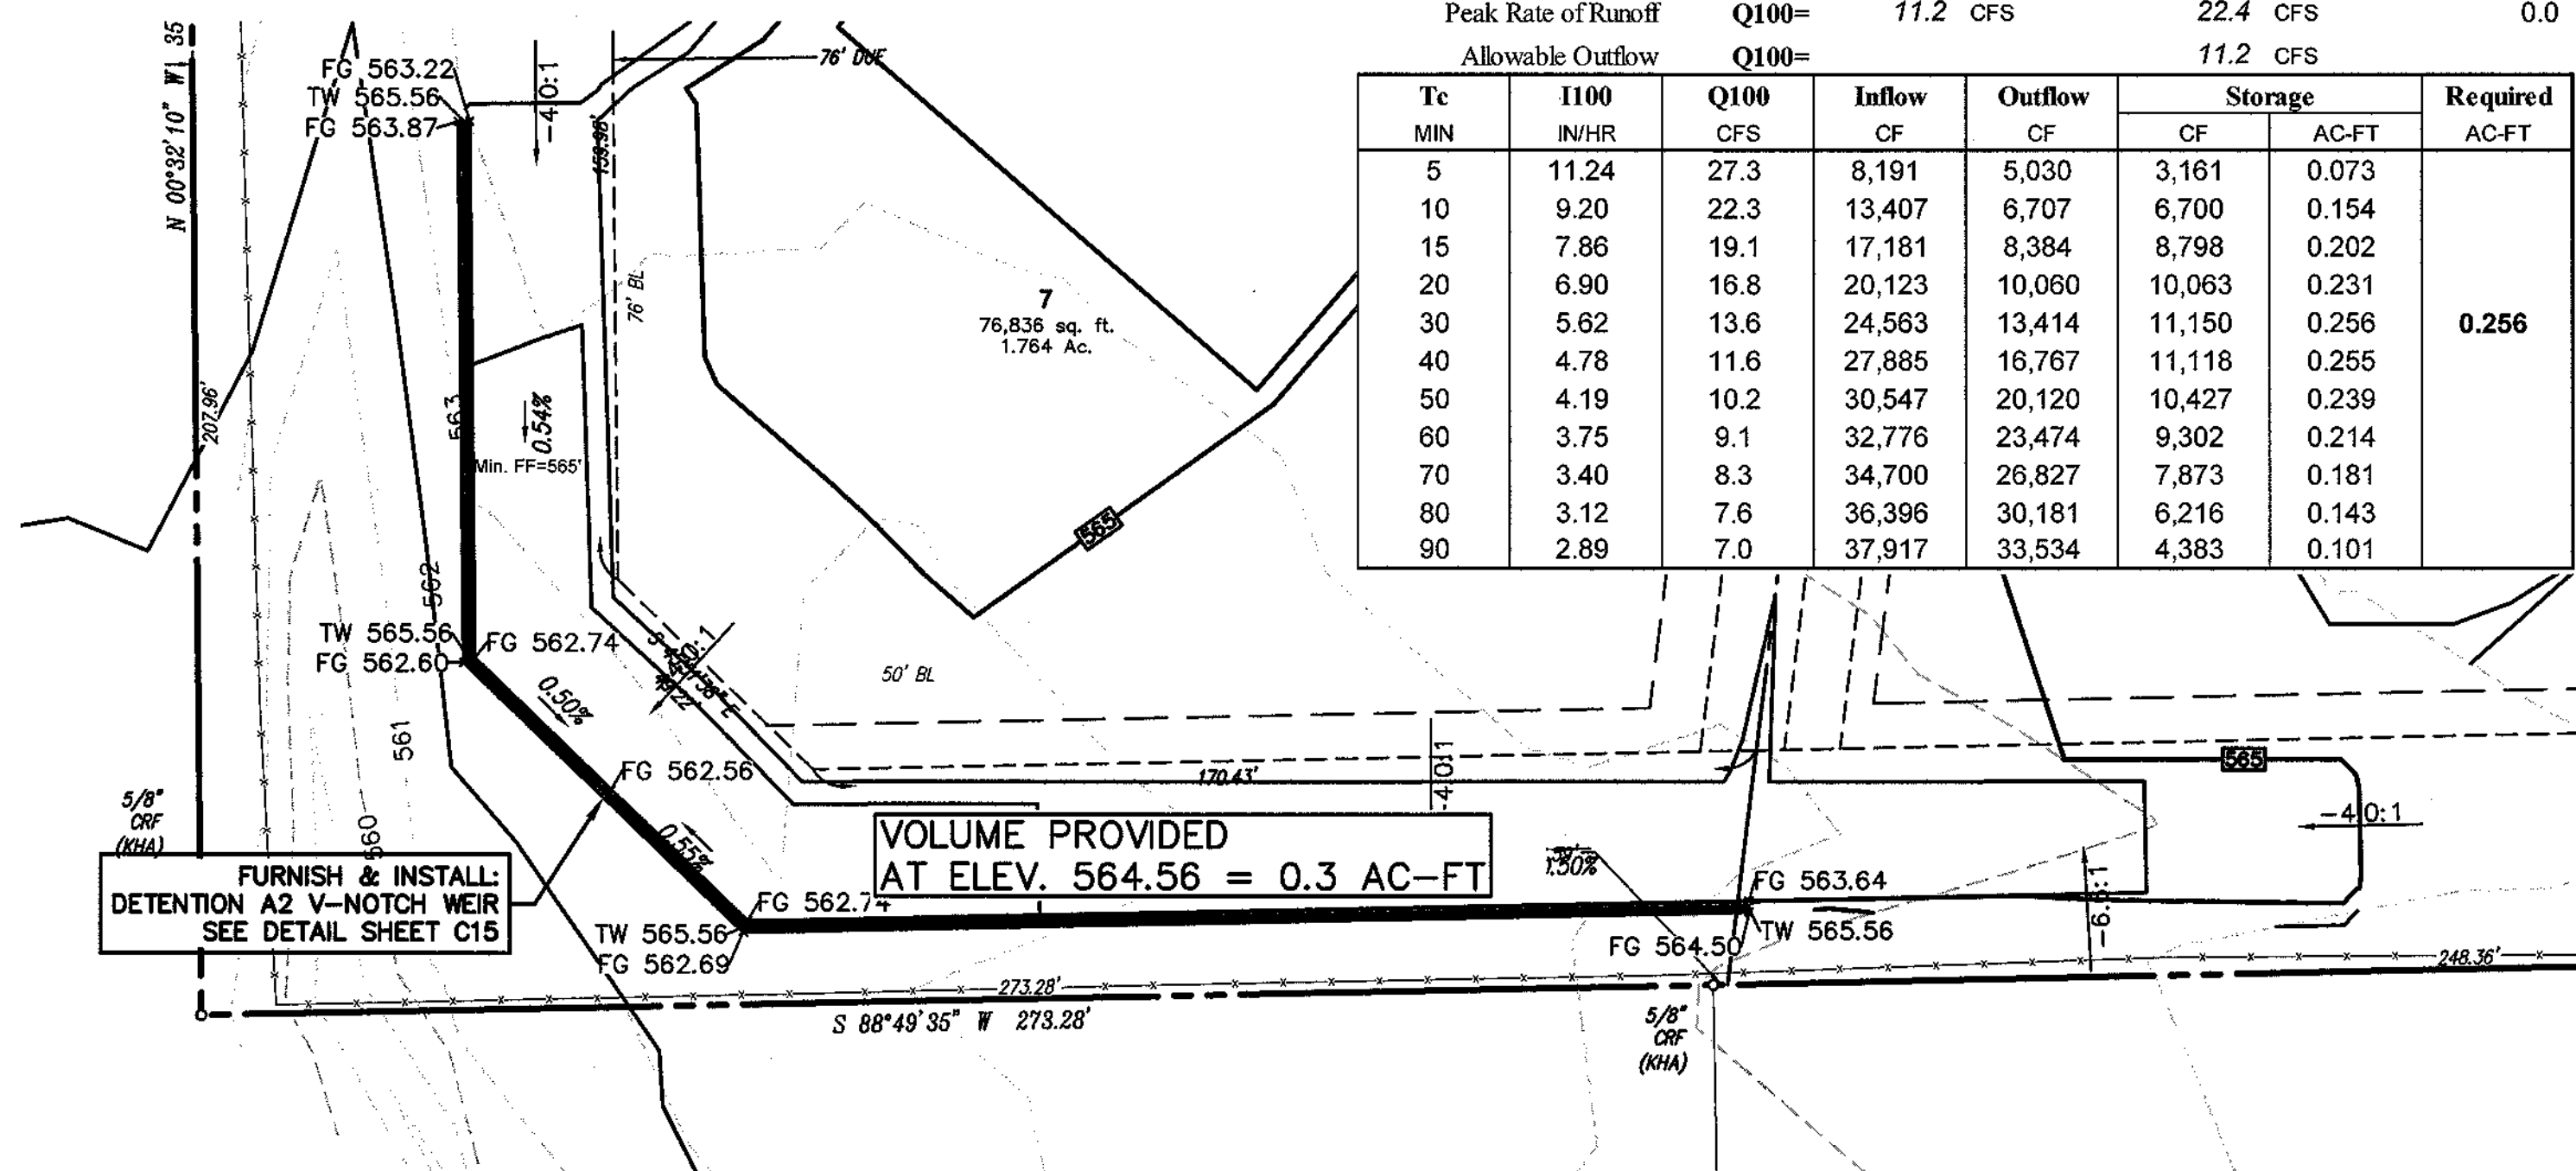



DETENTION "A3a"

Detention Computations for Proposed Development

City of Lucas

	Undeveloped	Developed	Bypass
Area	A= 9.100 AC	9.100 AC	0.000
Runoff Coefficient	C= 0.30	0.45	0.45
Time of Concentration	Tc= 20.0 MIN	10.0 MIN	10.0
Rainfall Intensity	I100= 6.90 IN/HR	9.20 IN/HR	9.20
Peak Rate of Runoff	Q100= 18.8 CFS	37.7 CFS	0.0
Allowable Outflow	Q100= 18.8 CFS		

Tc	I100	Q100	Inflow	Outflow	Storage		Required
MIN	IN/HR	CFS	CF	CF	CF	AC-FT	AC-FT
5	11.24	46.0	13,803	8,477	5,327	0.122	0.431
10	9.20	37.7	22,593	11,302	11,290	0.259	
15	7.86	32.2	28,953	14,128	14,825	0.340	
20	6.90	28.3	33,911	16,953	16,957	0.389	
30	5.62	23.0	41,394	22,604	18,790	0.431	
40	4.78	19.6	46,991	28,256	18,736	0.430	
50	4.19	17.2	51,477	33,907	17,571	0.403	
60	3.75	15.3	55,234	39,558	15,676	0.360	
70	3.40	13.9	58,476	45,209	13,267	0.305	
80	3.12	12.8	61,335	50,860	10,475	0.240	
90	2.89	11.8	63,898	56,511	7,387	0.170	

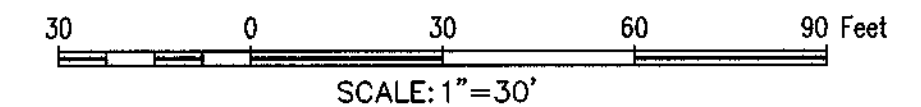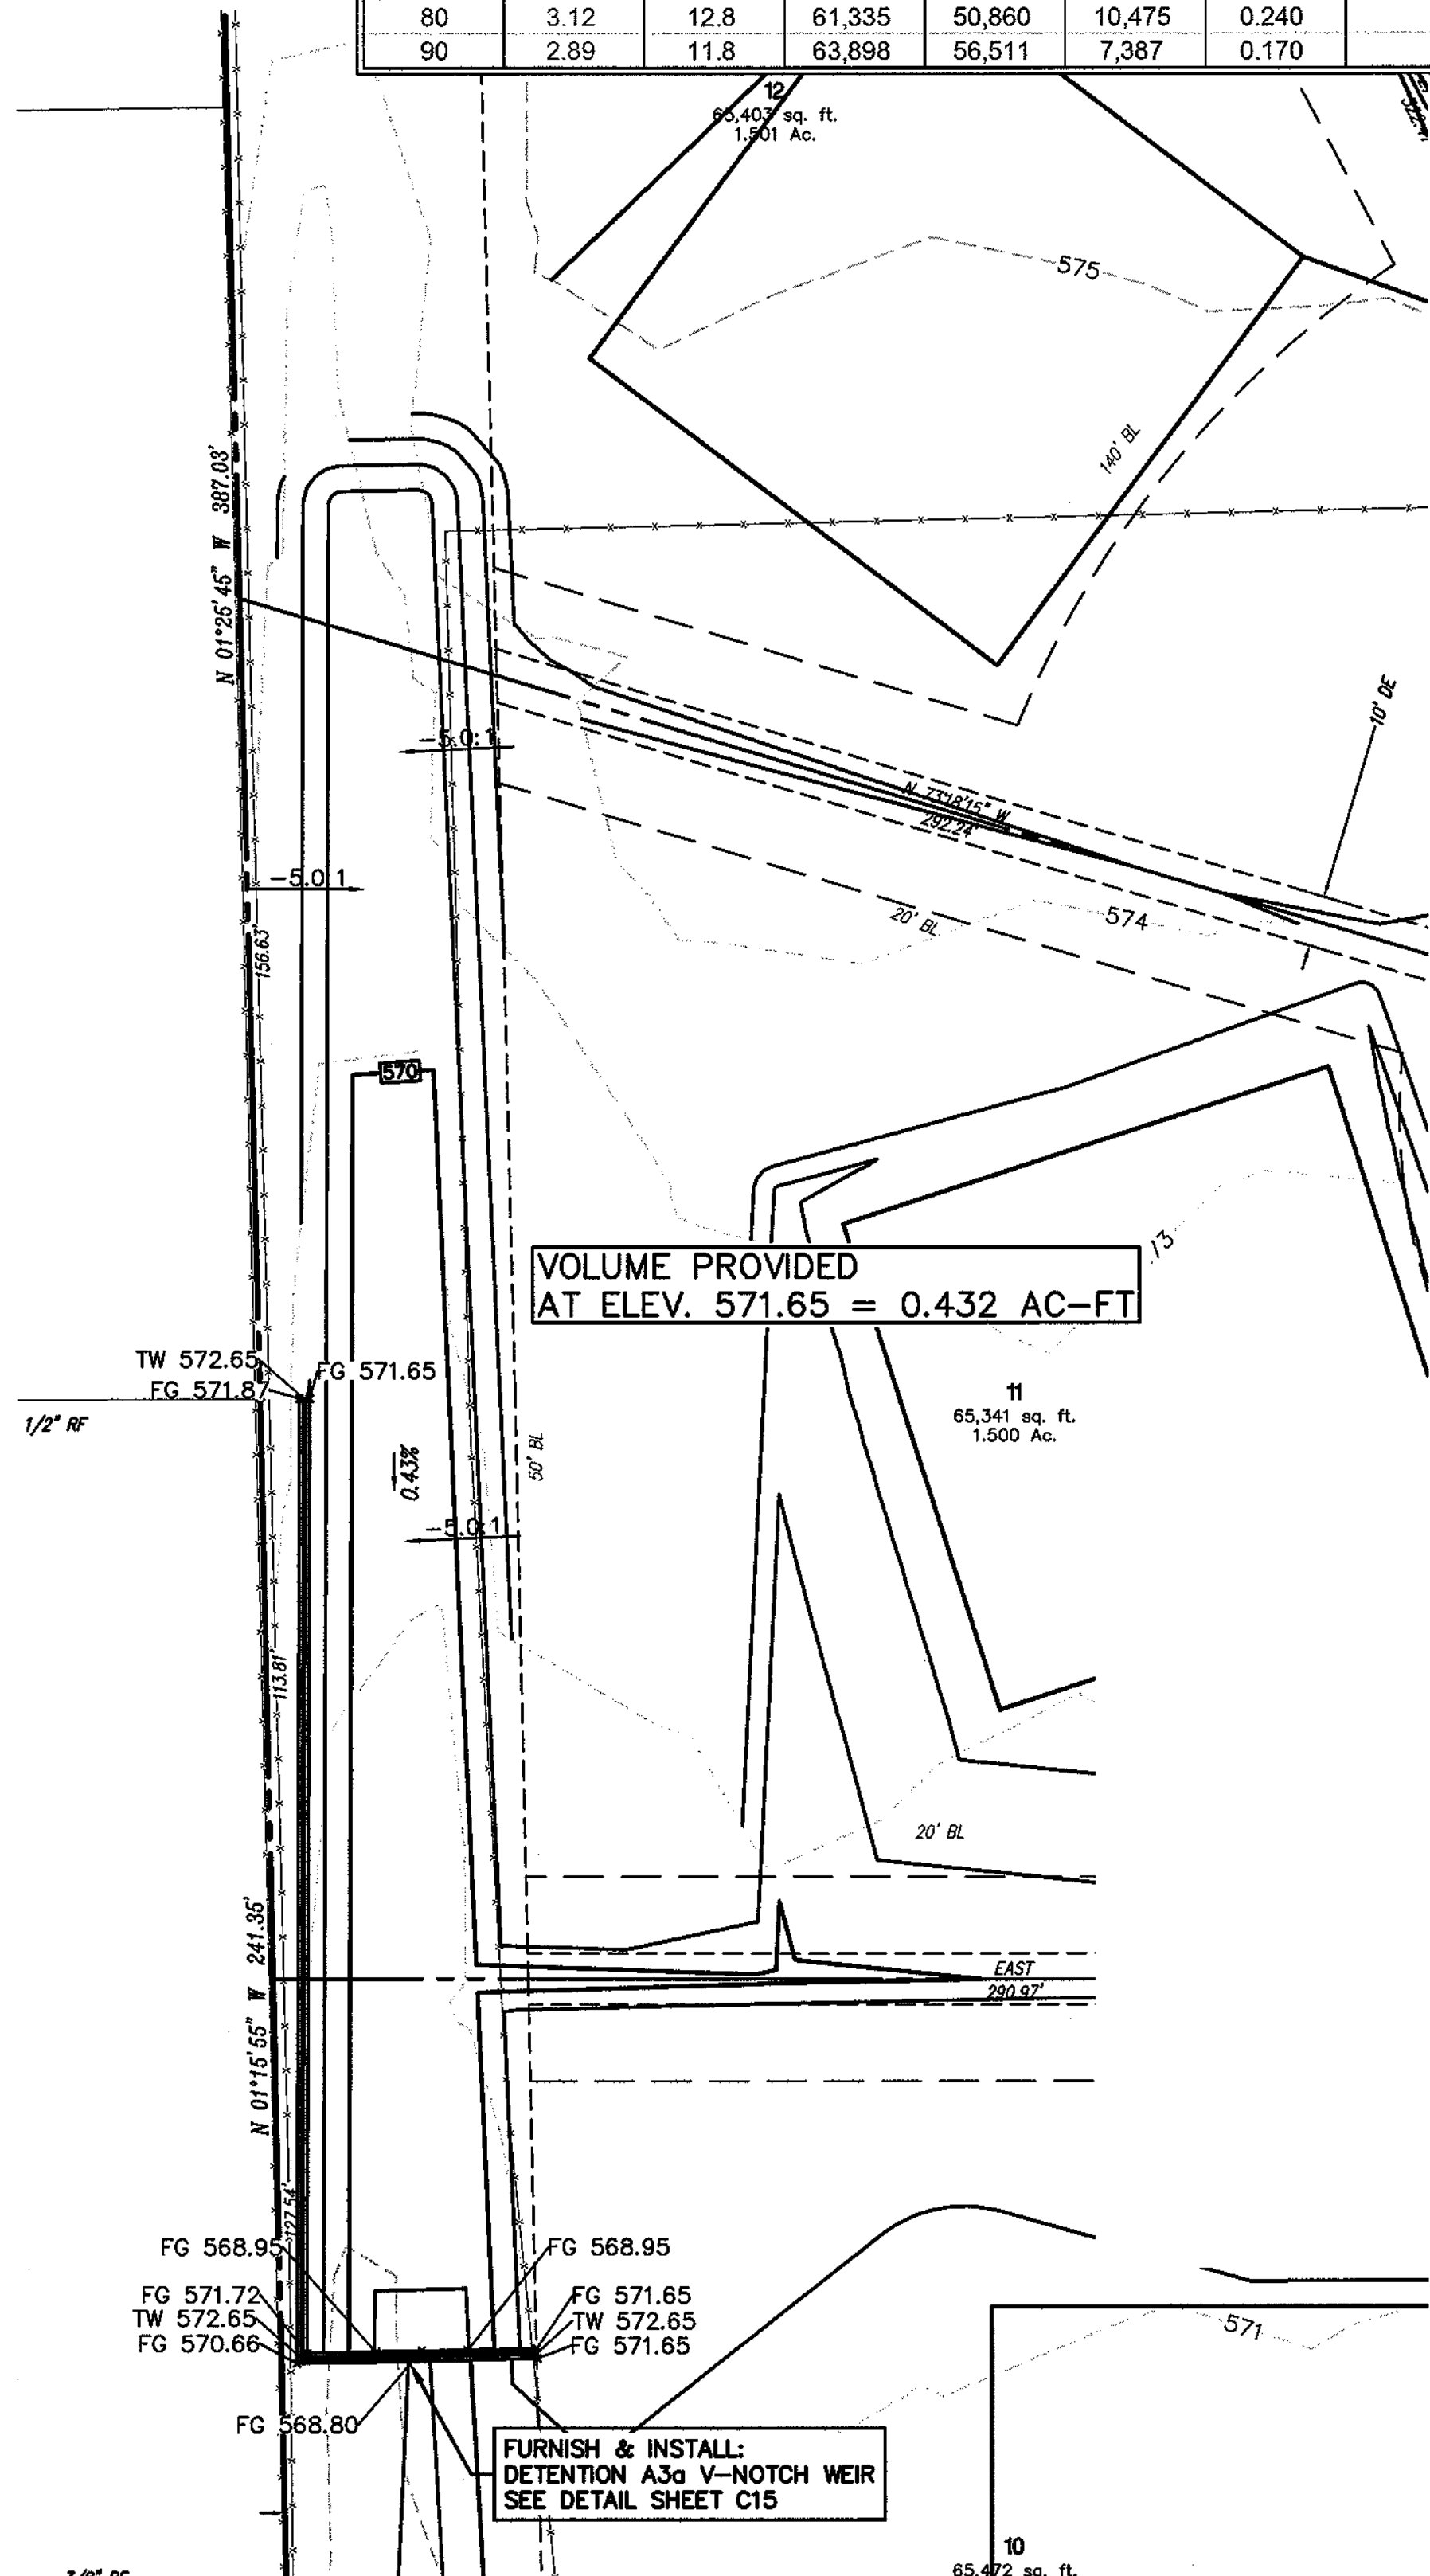

BENCHMARKS:

- BM#1 - RM133 - 590.08'
Square cut on east headwall of west of bridge at White Rock Creek (East) and FM 1378. Map# 4805C0455G, Dated January 19th, 1996.
- TBM#2 - Square Cut - 569.45'
~981' Southwest from the Northwest corner of subject property on south edge of Brookhaven Dr.
N=7,079,521.1' E=2,557,109.8'
- TBM#3 - "X" - 579.96'
~760' Northeast from the Northwest corner of subject property near the intersection of Conner Ln. & Chapel Ct.
N=7,080,175.7' E=2,558,146.1'
- TBM#4 - PK Nail - 554.84'
~900' Northeast from the Northeast corner of subject property at the south edge of a cul-de-sac on Alameda Cr.
N=7,078,803.4' E=2,559,558.0'
- TBM#5 - "X" - 584.19'
~1040' Southeast from the southeast corner of subject property on a headwall on the north side of the intersection of FM 1378 & Sals Lomas Trail.
N=7,076,568.5' E=2,559,653.8'

LEGEND

C.R.F.	Capped Rebar Found	Overhead Power Lines
C.R.S.	Capped Rebar Set	Down Guy Wire
C.M.	Control Monument	Existing Contours
Mon.	Monument	Proposed Contours
BM	Benchmark	Concrete Pavement
FH	Fire Hydrant	Asphalt Pavement
WM	Water Meter	Wood Fence
WV	Water Valve	Chain Link Fence
W/L	Water Line	Wire Fence
ICV	Irrigation Control Valve	Masonry Wall
SSMH	Sanitary Sewer Manhole	Existing Tree
CO	Sanitary Sewer Cleanout	(FL) Flowline
UP	Utility Pole	Centerline of Creek, Swale, or Waterway
LP	Light Pole	Creek, Swale, or Waterway Embankment
TC	Top of Curb	
TP	Top of Pavement	
TW	Top of Wall	
FG	Finished Grade	
U.E.	Utility Easement	
D.E.	Drainage Easement	
B.L.	Building Line	
R.O.W.	Right-of-Way	
D.R.	Deed Records	
P.R.	Plat Records	


GENERAL NOTES

- THE CITY OF LUCAS CONSTRUCTION STANDARDS APPLY WHETHER INDICATED ON THESE PLANS OR NOT.

AS-BUILT RECORD DRAWING

THE INFORMATION ON THESE PLANS HAS BEEN REVISED TO REFLECT CHANGES TO PUBLIC IMPROVEMENTS MADE DURING CONSTRUCTION PROVIDED TO ENGINEER BY THE CONTRACTOR. UNLESS OTHERWISE NOTED, THE CONSTRUCTION OF THE PUBLIC IMPROVEMENTS IS IN GENERAL CONFORMANCE WITH THESE PLANS. THE RESPONSIBILITY FOR ACCURACY AND COMPLETENESS BELONGS TO THE CONTRACTOR.

Douglas W. Weaver
G & A Consultants, LLC.
Date: 11/23/2015

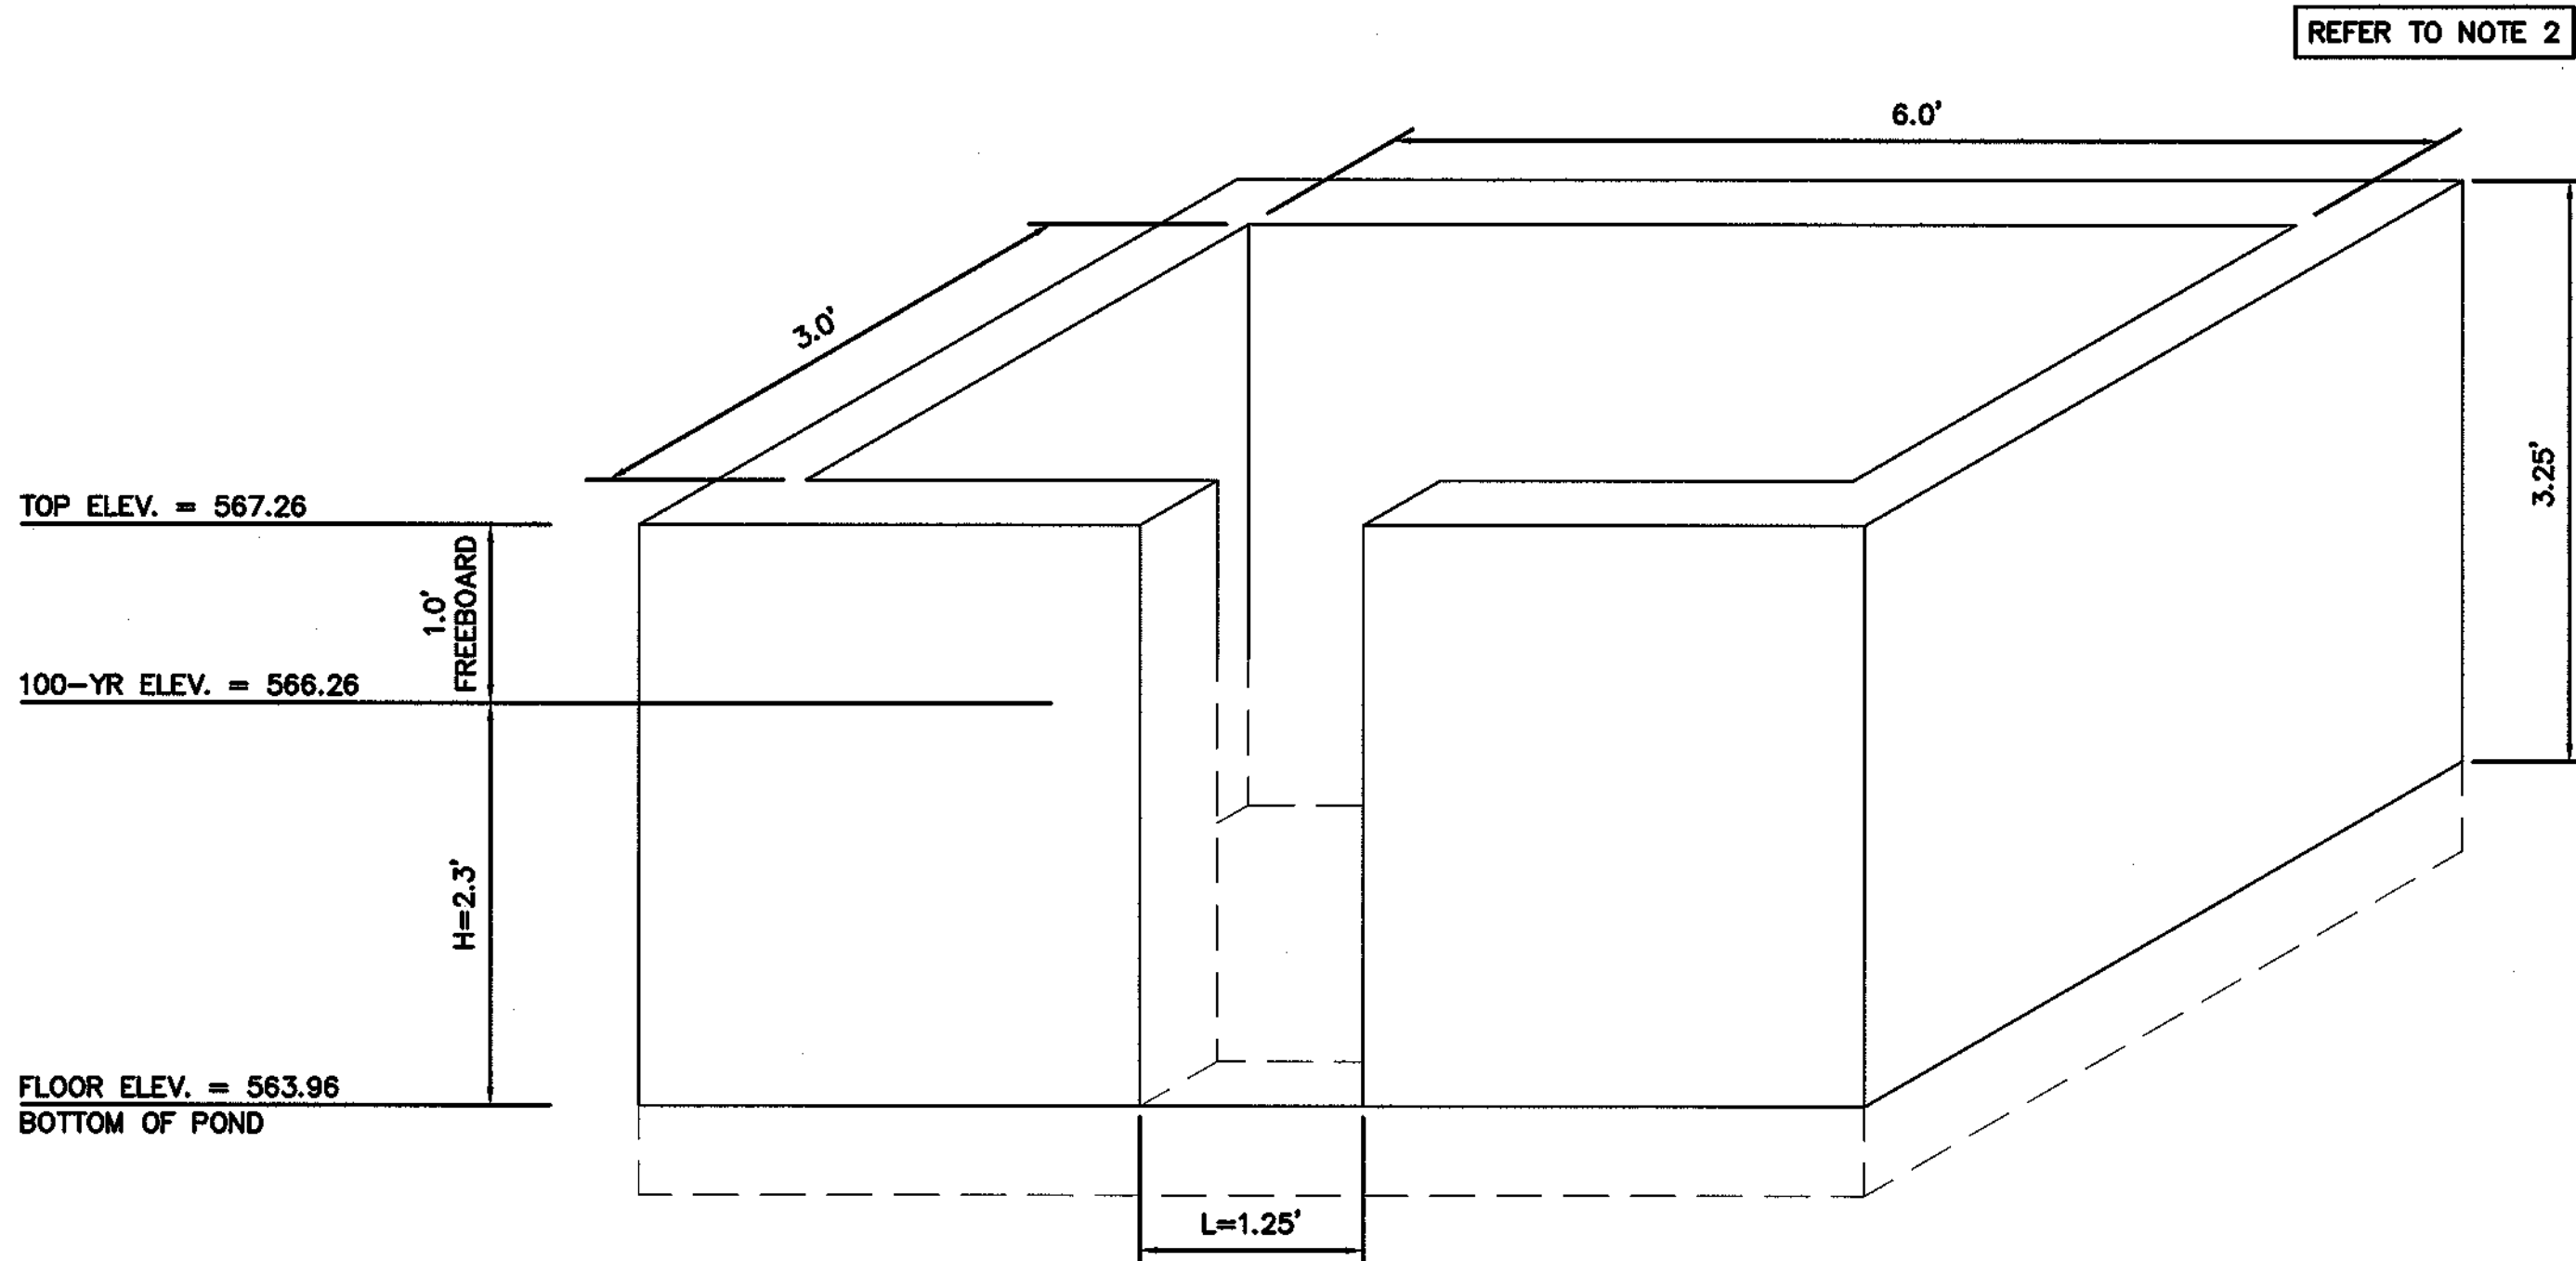

DETENTION A1 OUTLET STRUCTURE
NTS

DETENTION A1 OUTLET STRUCTURE			
Q (cfs)	Cw	L (ft)	H (ft)
13.50	3.33	1.25	2.25
Q=CwLH ^{1.5}			

BENCHMARKS:

- BM#1 - RM133 - 590.08'
Square cut on east headwall of west of bridge at White Rock Creek (East) and FM 1378. Map# 4808504555, Dated January 19th, 1996.
- TBM#2 - Square Cut - 569.45'
~981' Southwest from the Northwest corner of subject property on south edge of Brookhaven Dr.
N=7,079,521.1' E=2,557,109.8'
- TBM#3 - "X" - 579.96'
~760' Northeast from the Northwest corner of subject property near the intersection of Conner Ln. & Chapel Ct.
N=7,080,175.7' E=2,558,146.1'
- TBM#4 - PK Nail - 554.84'
~900' Northeast from the Northeast corner of subject property at the south edge of a cul-de-sac on Alameda Cir.
N=7,079,803.4' E=2,559,558.0'
- TBM#5 - "X" - 584.19'
~1040' Southeast from the southeast corner of subject property on a headwall on the north side of the intersection of FM 1378 & Seis Lagoa Trail.
N=7,076,568.5' E=2,559,653.8'

LEGEND

C.R.F.	Capped Rebar Found	Overhead Power Lines
C.R.S.	Capped Rebar Set	Down Guy Wire
C.M.	Control Monument	Existing Contours
Mon.	Monument	Proposed Contours
BM	Benchmark	Concrete Pavement
FH	Fire Hydrant	Asphalt Pavement
WM	Water Meter	Wood Fence
WV	Water Valve	Chain Link Fence
W/L	Water Line	Wire Fence
ICV	Irrigation Control Valve	Masonry Wall
SSMH	Sanitary Sewer Manhole	Existing Tree
CO	Sanitary Sewer Cleanout	(FL) Flowline
UP	Utility Pole	Centerline of Creek, Swale, or Waterway
LP	Light Pole	Creek, Swale, or Waterway Embankment
TC	Top of Curb	
TP	Top of Pavement	
TW	Top of Wall	
FG	Finished Grade	
U.E.	Utility Easement	
D.E.	Drainage Easement	
B.L.	Building Line	
R.O.W.	Right-of-Way	
D.R.	Deed Records	
P.R.	Plat Records	


GENERAL NOTES

1. THE CITY OF LUCAS CONSTRUCTION STANDARDS APPLY WHETHER INDICATED ON THESE PLANS OR NOT.
2. STRUCTURAL DESIGN IS TO BE PROVIDED BY OTHERS IF NEEDED.
3. NOT TO SCALE (NTS).

AS-BUILT
RECORD DRAWING

THE INFORMATION ON THESE PLANS HAS BEEN REVIEWED TO REFLECT CHANGES TO PUBLIC IMPROVEMENTS MADE DURING CONSTRUCTION PROVIDED TO ENGINEER BY THE CONTRACTOR. UNLESS OTHERWISE NOTED, THE CONSTRUCTION OF THESE IMPROVEMENTS IS IN GENERAL CONFORMANCE WITH THE CITY OF LUCAS STANDARDS AND THE RESPONSIBILITY FOR ACCURACY AND COMPLETENESS BELONGS TO THE CONTRACTOR.

Douglas W. Weaver
G & A Consultants, LLC.
Date: 11/23/2015

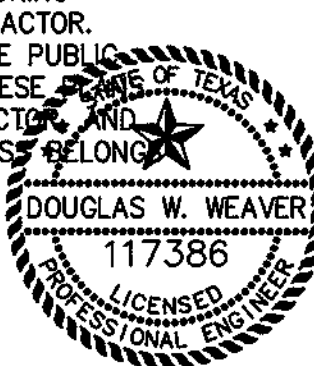

G&A CONSULTANTS, LLC.
TBPE F-1798

Drawn By: J.F.
Date: 11/07/2014
Scale: NTS
Revisions:

OWNER/DEVELOPER
CADG LEWIS PARK LLC
C/O LENART DEVELOPMENT COMPANY, LLC
520 CENTRAL PARKWAY E. SUITE 104
PLANO, TX 75074
Ph. (972) 422-9880
Contact: Steve Lenart

14026


C15

LEWIS PARK ESTATES

Lot 1-16, 1-20, Block A, B
LEWIS PARK ESTATES
60.858 Acres
in the
JAMES ANDERSON SURVEY, ABSTRACT NO. 17
CITY OF LUCAS
COLLIN COUNTY, TEXAS

DETENTION POND DETAILS
& CALCULATIONS

LEWIS PARK ESTATES

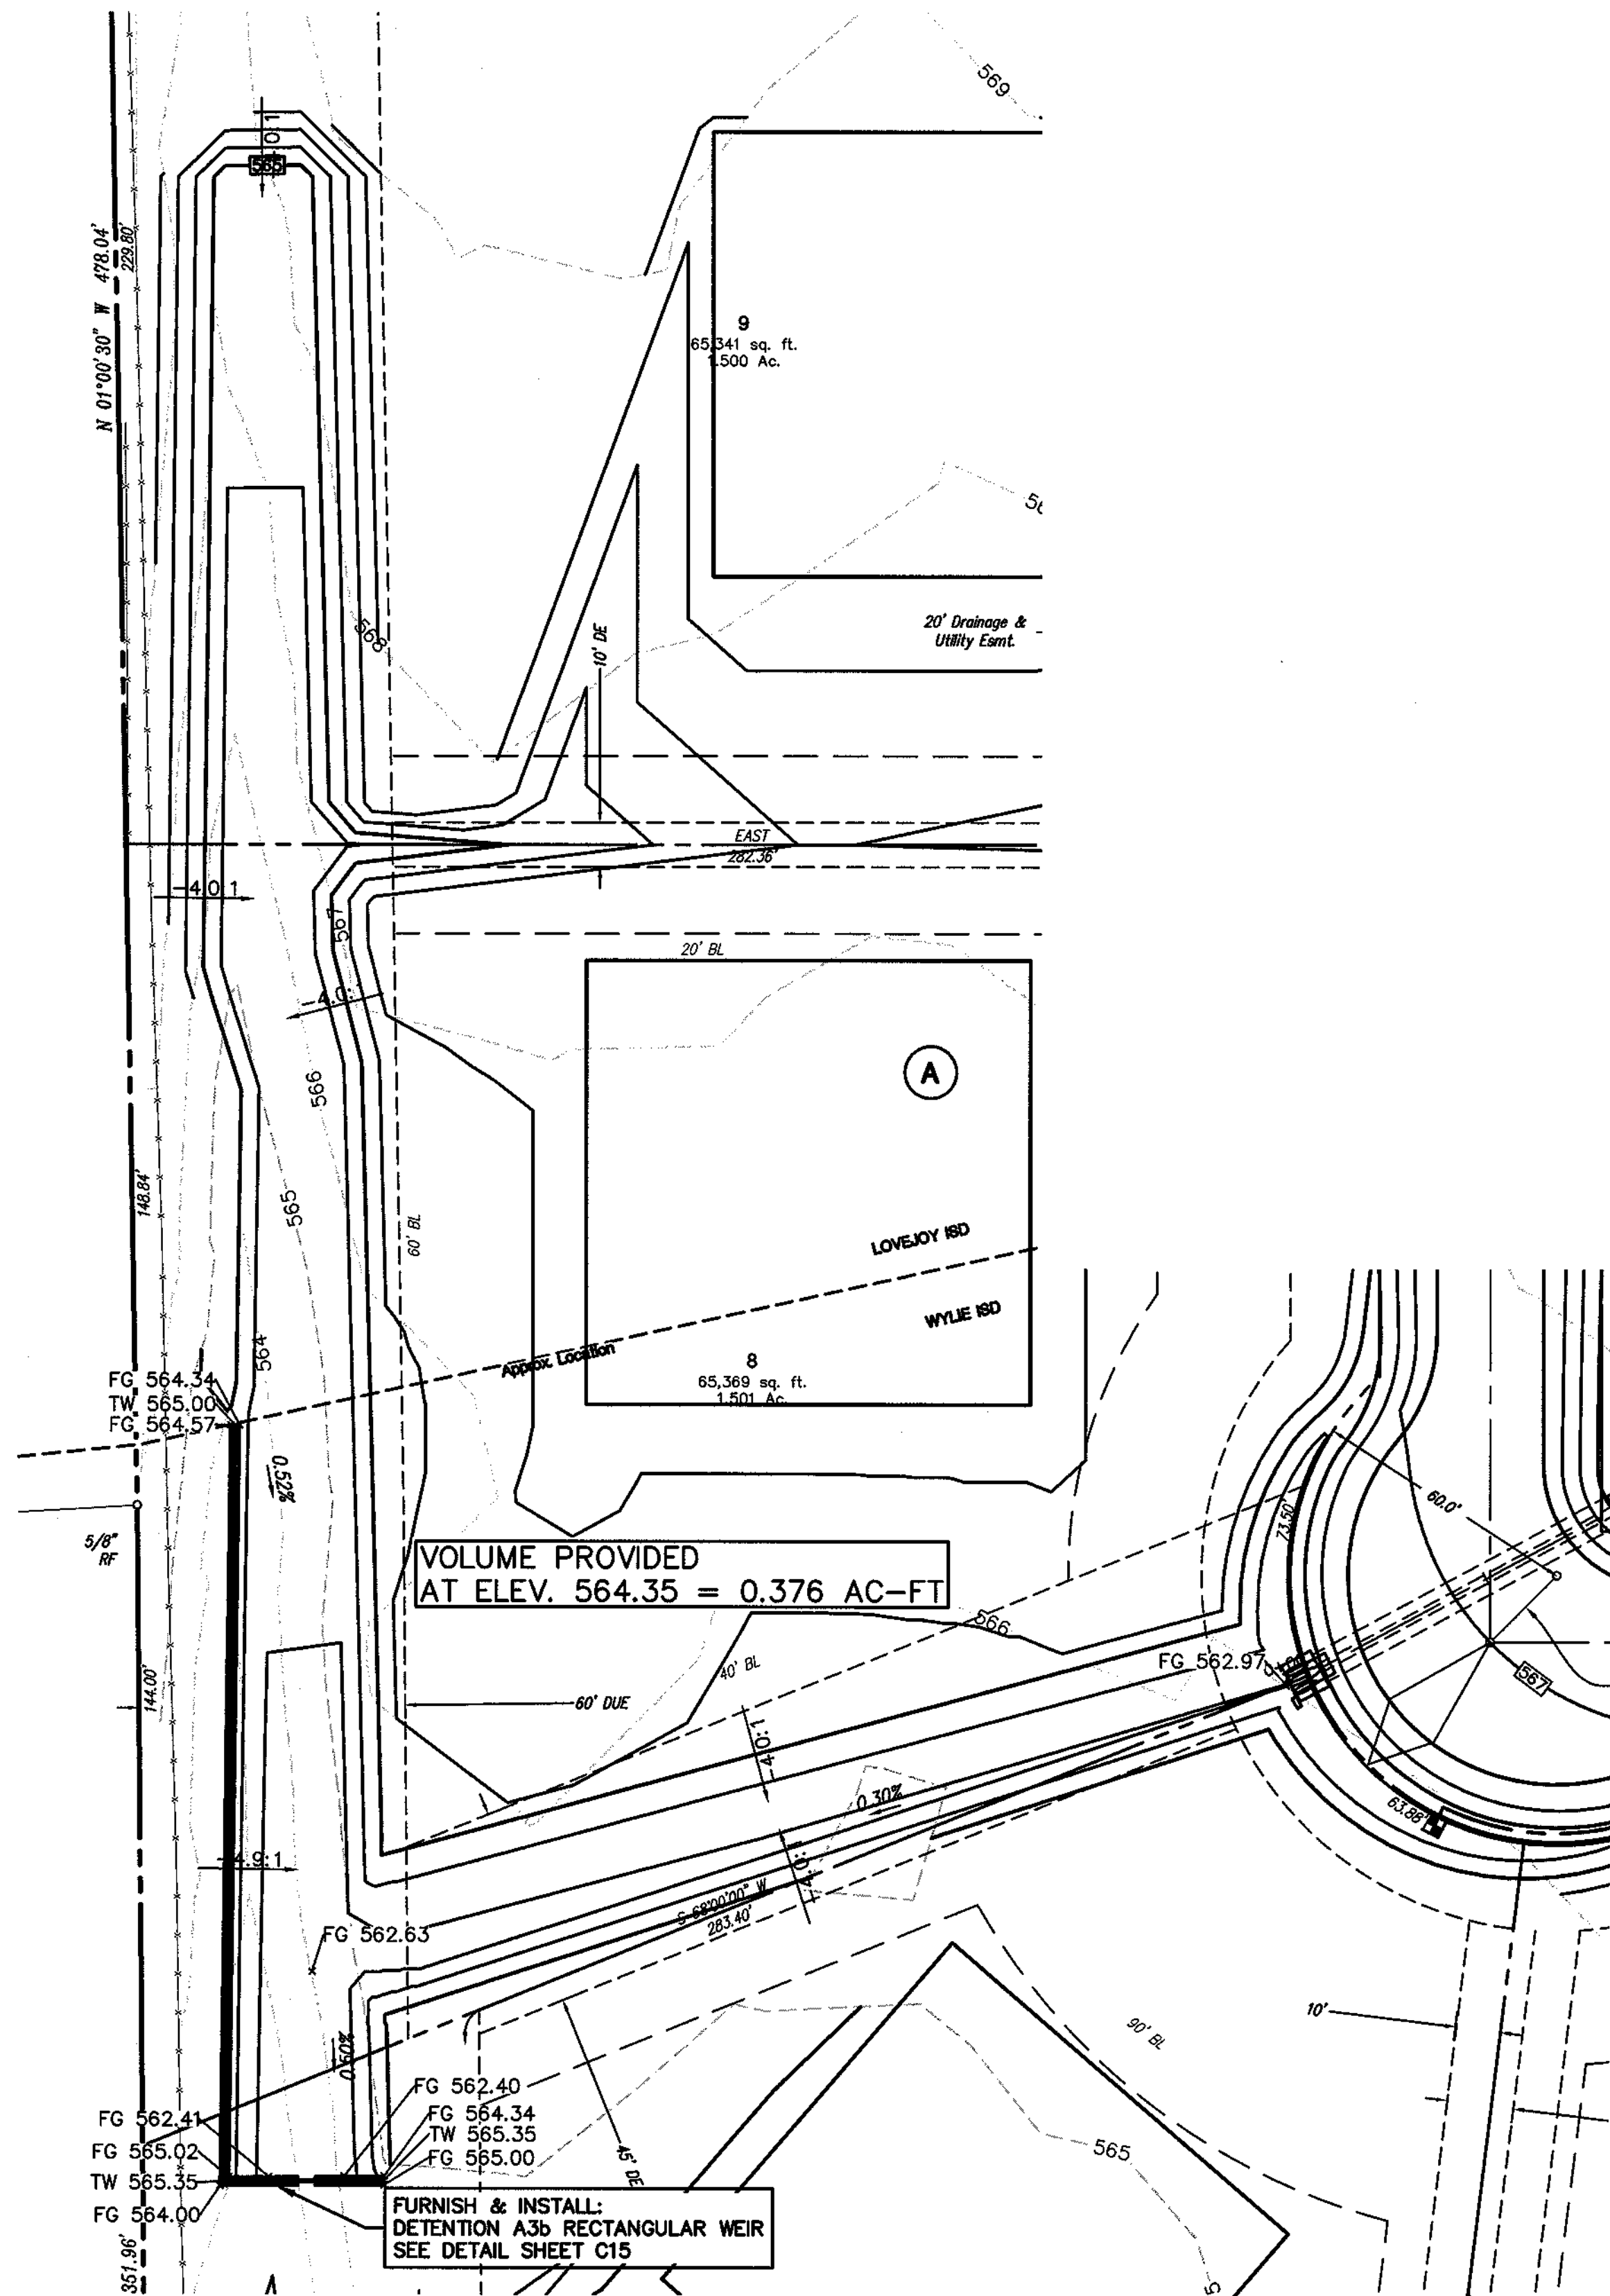

DETENTION "A3b"


Detention Computations for Proposed Development						
City of Lucas						
	Undeveloped		Developed		Bypass	
Area	A=	5,200 AC	5,200 AC		0,000	
Runoff Coefficient	C=	0.30	0.45		0.45	
Time of Concentration	Tc=	20.0 MIN	10.0 MIN		10.0	
Rainfall Intensity	I100=	6.90 IN/HR	9.20 IN/HR		9.20	
Peak Rate of Runoff	Q100=	10.8 CFS	21.5 CFS		0.0	
Allowable Outflow	Q100=		10.8 CFS			
Tc	I100	Q100	Inflow	Outflow	Storage	
MIN	IN/HR	CFS	CF	CF	CF	AC-FT
5	11.24	26.3	7,888	4,844	3,044	0.070
10	9.20	21.5	12,910	6,458	6,452	0.148
15	7.86	18.4	16,545	8,073	8,472	0.194
20	6.90	16.1	19,378	9,688	9,690	0.222
30	5.62	13.1	23,654	12,917	10,737	0.246
40	4.78	11.2	26,852	16,146	10,706	0.246
50	4.19	9.8	29,416	19,375	10,040	0.230
60	3.75	8.8	31,562	22,604	8,958	0.206
70	3.40	8.0	33,415	25,834	7,581	0.174
80	3.12	7.3	35,048	29,063	5,986	0.137
90	2.89	6.8	36,513	32,292	4,221	0.097
100	2.70	6.3	37,843	35,521	2,322	0.053
110	2.53	5.9	39,063	38,750	313	0.007
120	2.39	5.6	40,192	41,980	(1,787)	-0.041

RECTANGULAR WEIR

DETENTION AREA	Q (cfs)	Cw	L (ft)	H (ft)
A3b	41.10	3.33	3.75	2.25
Q=CwLH ^{1.5}				

RECTANGULAR WEIR ELEVATIONS

DETENTION AREA	TOP ELEV.	100-YR ELEV.	BOTTOM OF POND ELEV.
A3b	565.35	564.35	562.10

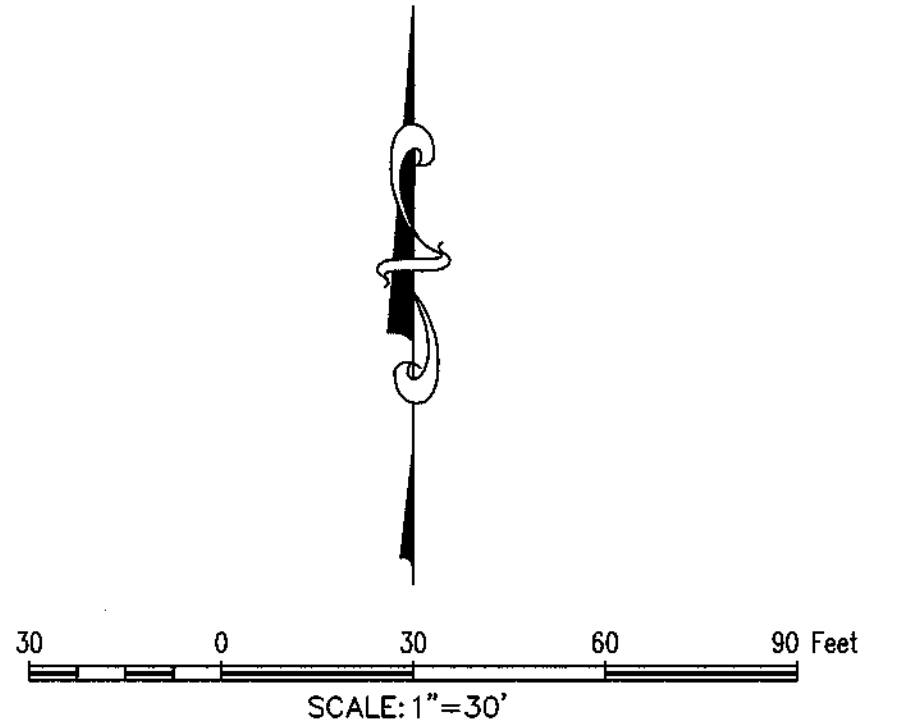

BENCHMARKS:

- BM#1 - RM133 - 590.08'
Square cut on east headwall of west of bridge at White Rock Creek (East) and FM 1378. Map# 48085004556, Dated January 19th, 1996.
- TBM#2 - Square Cut - 569.45'
~981' Southwest from the Northwest corner of subject property on south edge of Brookhaven Dr.
N=7,079,521.1' E=2,557,109.8'
- TBM#3 - "X" - 579.96'
~760' Northeast from the Northwest corner of subject property near the intersection of Corner Ln. & Chapel Ct.
N=7,080,175.7' E=2,558,146.1'
- TBM#4 - PK Nail - 554.84'
~900' Northeast from the Northeast corner of subject property at the south edge of a cul-de-sac on Alameda Cir.
N=7,079,803.4' E=2,559,558.0'
- TBM#5 - "X" - 584.19'
~1040' Southeast from the southeast corner of subject property on a headwall on the north side of the intersection of FM 1378 & Sela Lugo Trail.
N=7,076,568.5' E=2,559,653.8'


LEGEND

C.R.F.	Capped Rebar Found	Overhead Power Lines
C.R.S.	Capped Rebar Set	Down Guy Wire
C.M.	Control Monument	443 Existing Contours
Mon.	Monument	445 Proposed Contours
BM	Benchmark	Concrete Pavement
FH	Fire Hydrant	Asphalt Pavement
WM	Water Meter	Wood Fence
WV	Water Valve	Chain Link Fence
W/L	Water Line	Wire Fence
ICV	Irrigation Control Valve	Masonry Wall
SSMH	Sanitary Sewer Manhole	Existing Tree
CO	Sanitary Sewer Cleanout	(FL) Flowline
UP	Utility Pole	Centerline of Creek, Swale, or Waterway
LP	Light Pole	Creek, Swale, or Waterway Embankment
TC	Top of Curb	
TP	Top of Pavement	
TW	Top of Wall	
FG	Finished Grade	
U.E.	Utility Easement	
D.E.	Drainage Easement	
B.L.	Building Line	
R.O.W.	Right-of-Way	
D.R.	Deed Records	
P.R.	Plat Records	

GENERAL NOTES

- THE CITY OF LUCAS CONSTRUCTION STANDARDS APPLY WHETHER INDICATED ON THESE PLANS OR NOT.
- STRUCTURAL DESIGN IS TO BE PROVIDED BY OTHERS IF NEEDED.
- NOT TO SCALE (NTS).

REFER TO NOTE 2

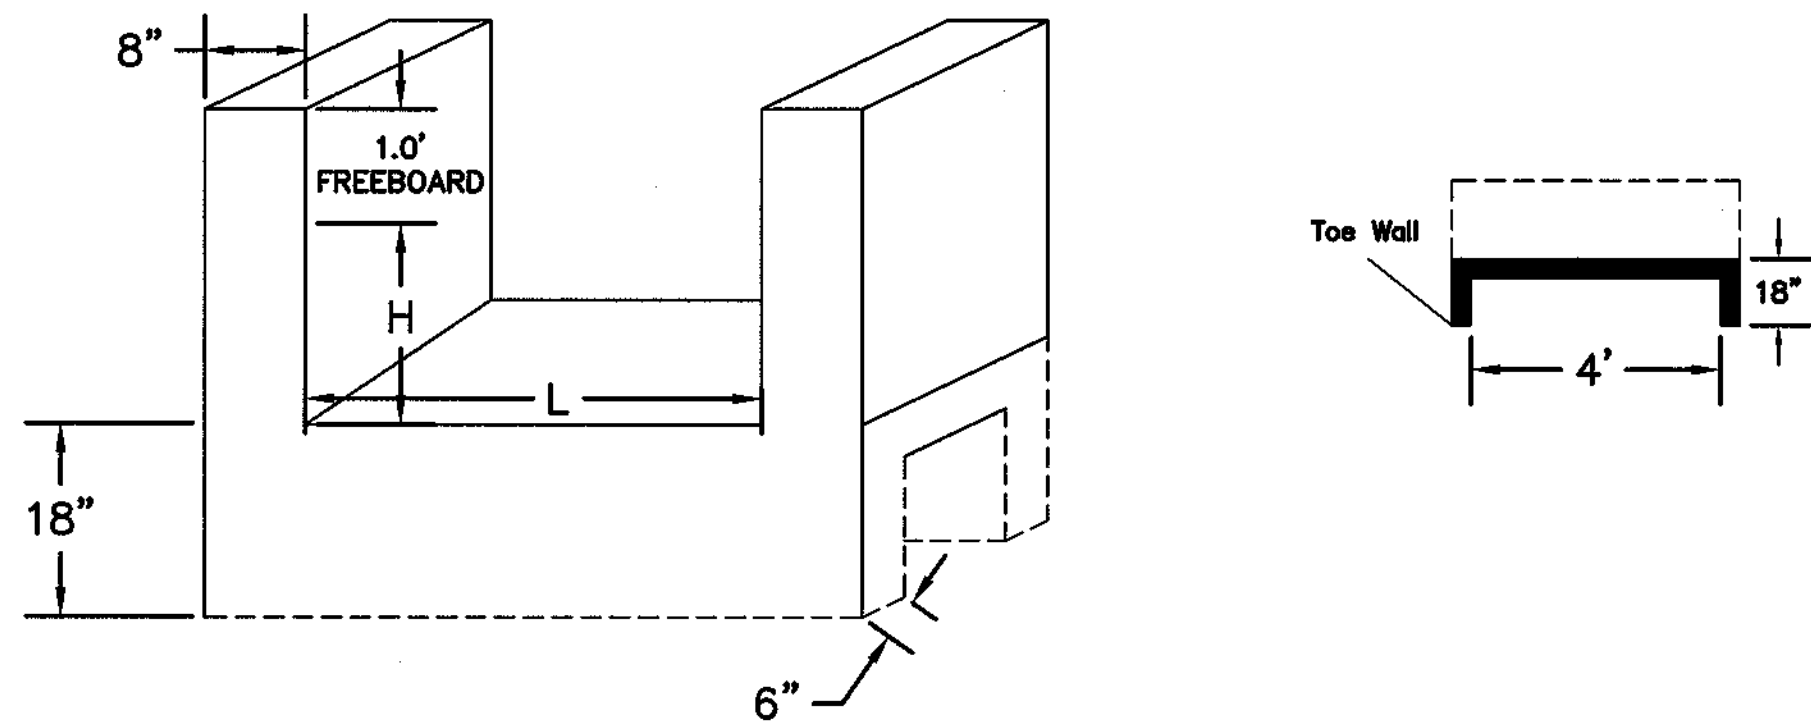

RECTANGULAR WEIR
NTS

AS-BUILT RECORD DRAWING

THE INFORMATION ON THESE PLANS HAS BEEN REVISED TO REFLECT CHANGES TO PUBLIC IMPROVEMENTS MADE DURING CONSTRUCTION PROVIDED TO ENGINEER BY THE CONTRACTOR. UNLESS OTHERWISE NOTED, THE CONSTRUCTION OF THESE PUBLIC IMPROVEMENTS IS IN GENERAL CONFORMANCE WITH THE CITY OF LUCAS, TEXAS, AND BASED UPON INFORMATION PROVIDED BY THE CONTRACTOR. THE RESPONSIBILITY FOR ACCURACY AND COMPLETENESS BELONGS TO THE CONTRACTOR.

Douglas W. Weaver
G & A Consultants, LLC.
Date: 11/23/2015

DETENTION "B"

Detention Computations for Proposed Development
City of Lucas

		Undeveloped		Developed		Bypass	
Area	A=	37.700	AC	37.700	AC	0.000	
Runoff Coefficient	C=	0.32		0.45		0.00	
Time of Concentration	Tc=	20.0	MIN	10.0	MIN	0.0	
Rainfall Intensity	I100=	6.90	IN/HR	9.20	IN/HR	0.00	
Peak Rate of Runoff	Q100=	83.3	CFS	156.1	CFS	0.0	
Allowable Outflow	Q100=			83.3	CFS		
Tc	I100	Q100	Inflow	Outflow	Storage		Required
MIN	IN/HR	CFS	CF	CF	CF	AC-FT	AC-FT
5	11.24	190.6	57,185	37,506	19,679	0.452	1.641
10	9.20	156.0	93,598	50,007	43,591	1.001	
15	7.86	133.3	119,949	62,509	57,440	1.319	
20	6.90	117.1	140,487	75,011	65,476	1.503	
30	5.62	95.3	171,489	100,015	71,474	1.641	
40	4.78	81.1	194,678	125,018	69,659	1.599	
50	4.19	71.1	213,263	150,022	63,241	1.452	
60	3.75	63.6	228,826	175,026	53,801	1.235	
70	3.40	57.7	242,257	200,030	42,227	0.969	
80	3.12	52.9	254,101	225,033	29,068	0.667	
90	2.89	49.0	264,720	250,037	14,683	0.337	




COMPOUND WEIR

DETENTION AREA	Q (cfs)	Cw	L (ft)	H (ft)	X (ft)	A (ft)
B	83.30	3.33	13.00	1.50	1.00	1.00
$Q=CwLH^{1.5} + CwA^{1.5}$						

COMPOUND WEIR ELEVATIONS



DETENTION AREA	TOP ELEV.	100-YR ELEV.	BOTTOM OF POND ELEV.
B	560.00	559.00	556.50 NORMAL WSE

Retention/Detention Pond Outlet Structure (N.T.S.)

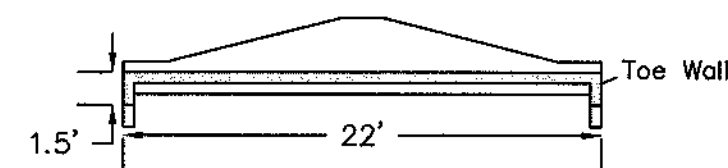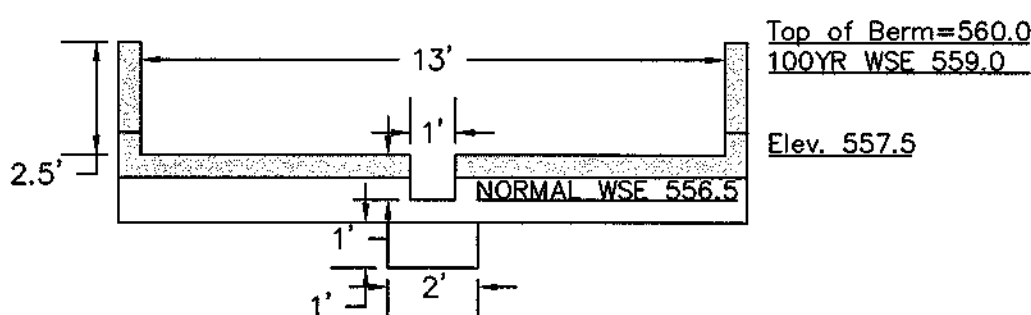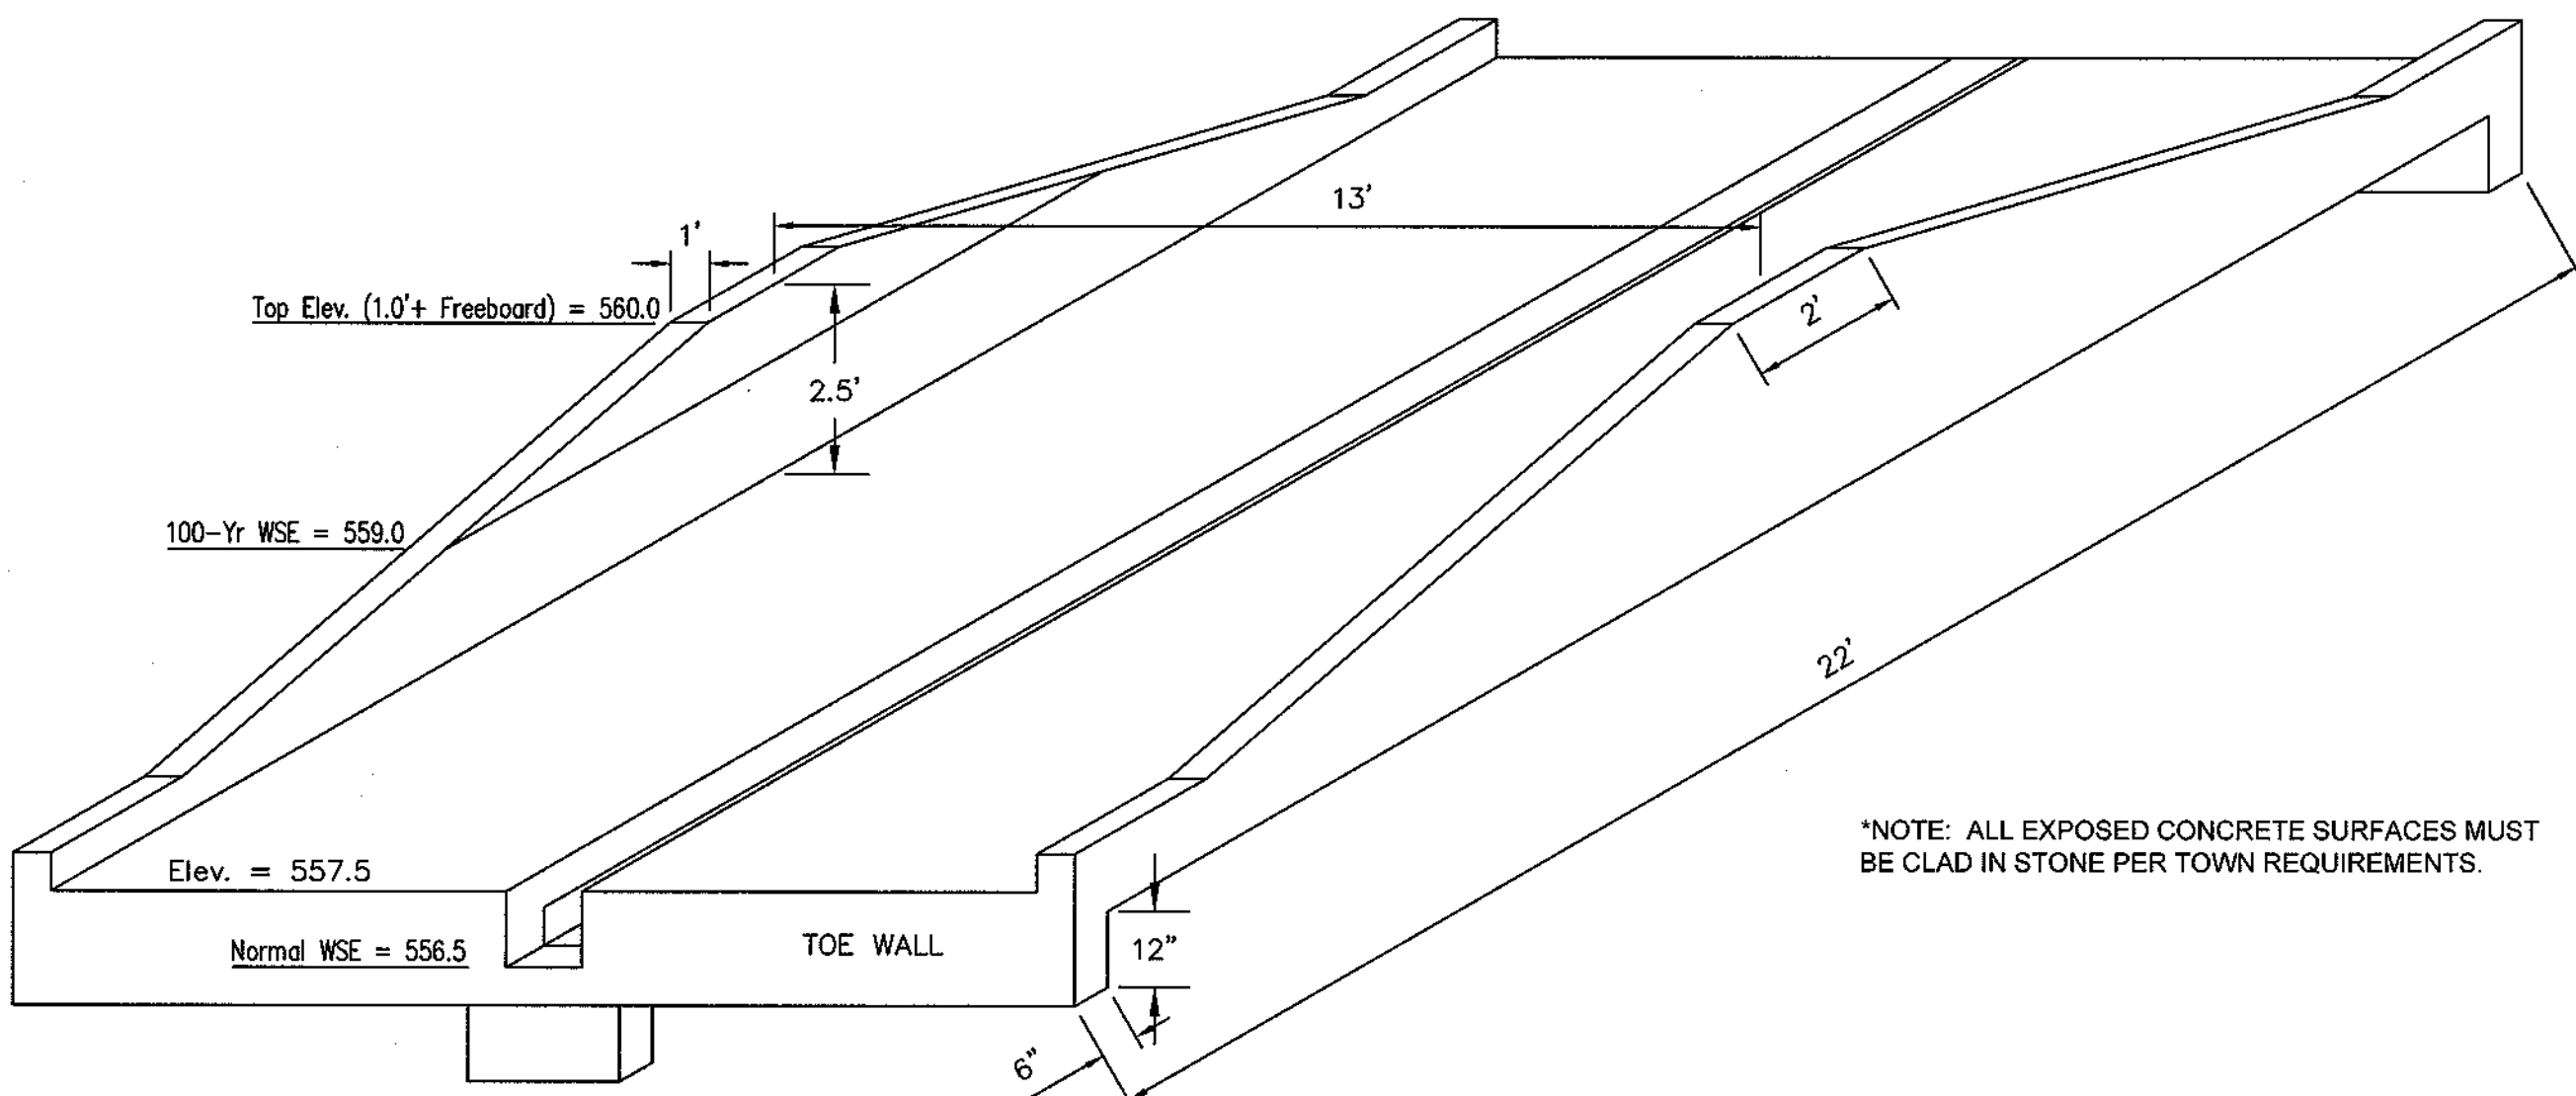

WEIR CROSS SECTIONS (N.T.S)

LENGTH = 22 FT
WIDTH = 13 FT
HEIGHT = 2.5 FT
6" 3000 PSI CONCRETE
W/ #3 REBAR 12" O.C.E.W.
& 12" TOE WALLS (INFLOW AND OUTFLOW)

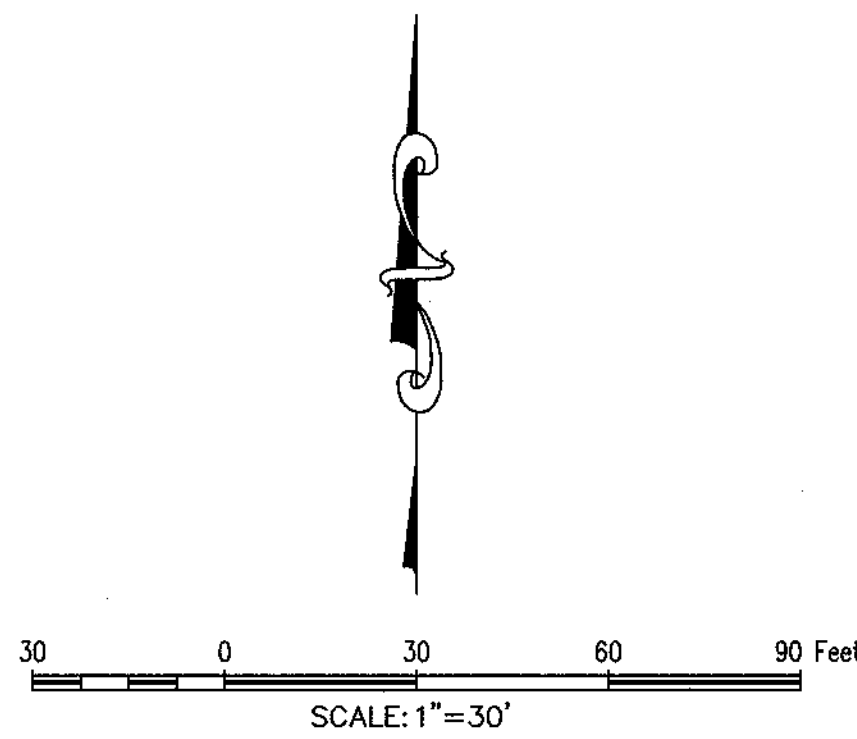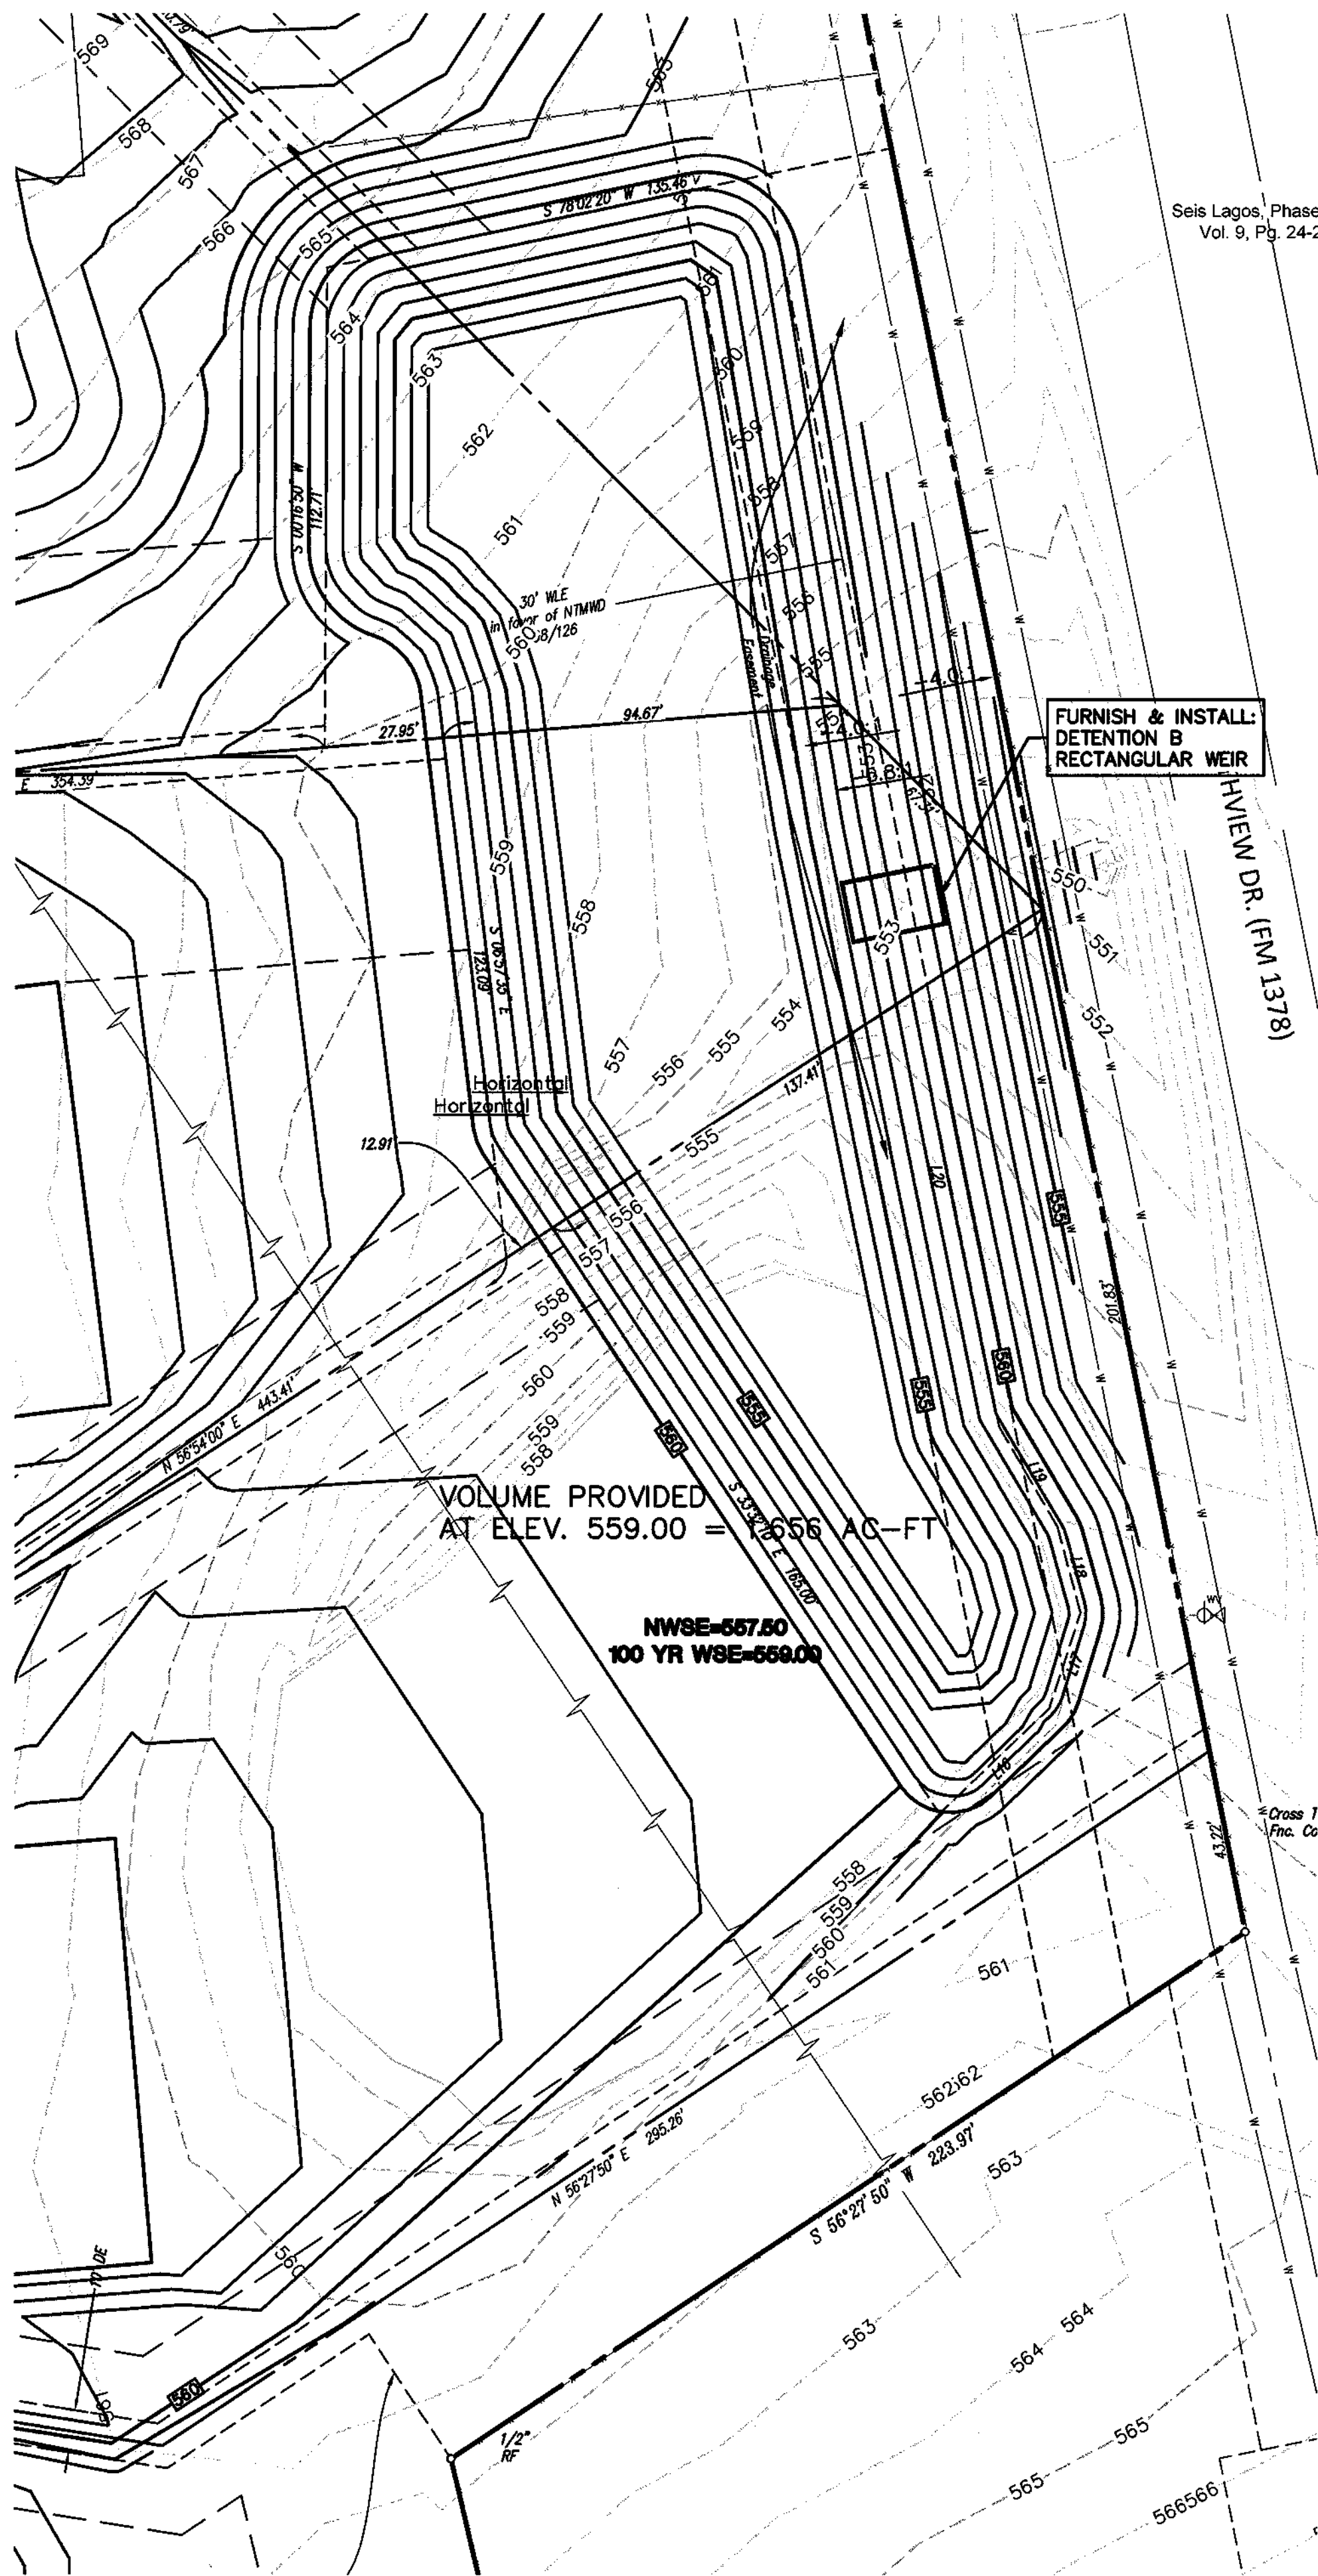

BENCHMARKS:

- BM#1 - RM133 - 590.08'
Square cut on east headwall of west of bridge at White Rock Creek (East) and FM 1378. Map# 480850455G, Dated January 19th, 1996.
- TBM#2 - Square Cut - 569.45'
~981' Southwest from the Northwest corner of subject property on south edge of Brookhaven Dr.
N=7,079,521.1' E=2,557,109.8'
- TBM#3 - "X" - 579.96'
~760' Northeast from the Northwest corner of subject property near the intersection of Conner Ln. & Chapel Ct.
N=7,080,175.7' E=2,558,146.1
- TBM#4 - PK Nail - 554.84'
~900' Northeast from the Northeast corner of subject property at the south edge of a cul-de-sac on Alameda Cir.
N=7,079,803.4' E=2,559,558.0'
- TBM#5 - "X" - 584.19'
~1040' Southeast from the southeast corner of subject property on a headwall on the north side of the intersection of FM 1378 & Seis Lagos Trail.
N=7,076,568.5' E=2,559,653.8'

LEGEND

C.R.F.	Capped Rebar Found	Overhead Power Lines
C.R.S.	Capped Rebar Set	Down Guy Wire
C.M.	Control Monument	443 Existing Contours
Mon.	Monument	445 Proposed Contours
BM	Benchmark	Concrete Pavement
FH	Fire Hydrant	Asphalt Pavement
WM	Water Meter	Wood Fence
WV	Water Valve	Chain Link Fence
W/L	Water Line	Wire Fence
ICV	Irrigation Control Valve	Masonry Wall
SSMH	Sanitary Sewer Manhole	Existing Tree
CO	Sanitary Sewer Cleanout	(FL) Flowline
UP	Utility Pole	Centerline of Creek, Swale, or Waterway
LP	Light Pole	Creek, Swale, or Waterway Embankment
TC	Top of Curb	
TP	Top of Pavement	
TW	Top of Wall	
FG	Finished Grade	
U.E.	Utility Easement	
D.E.	Drainage Easement	
B.L.	Building Line	
R.O.W.	Right-of-Way	
D.R.	Deed Records	
P.R.	Plat Records	



GENERAL NOTES

- THE CITY OF LUCAS CONSTRUCTION STANDARDS APPLY WHETHER INDICATED ON THESE PLANS OR NOT.
- STRUCTURAL DESIGN IS TO BE PROVIDED BY OTHERS IF NEEDED.
- NOT TO SCALE (NTS).

AS-BUILT RECORD DRAWING

THE INFORMATION ON THESE PLANS HAS BEEN REVISED TO REFLECT CHANGES TO PUBLIC IMPROVEMENTS MADE DURING CONSTRUCTION PROVIDED TO ENGINEER BY THE CONTRACTOR. UNLESS OTHERWISE NOTED, THE CONSTRUCTION OF THE PUBLIC IMPROVEMENTS IS IN GENERAL CONFORMANCE WITH THESE PLANS AND BASED UPON INFORMATION PROVIDED BY THE CONTRACTOR. THE RESPONSIBILITY FOR ACCURACY AND COMPLETENESS BELONGS TO THE CONTRACTOR.

Douglas W. Weaver
G & A Consultants, LLC.
Date: 11/23/2015

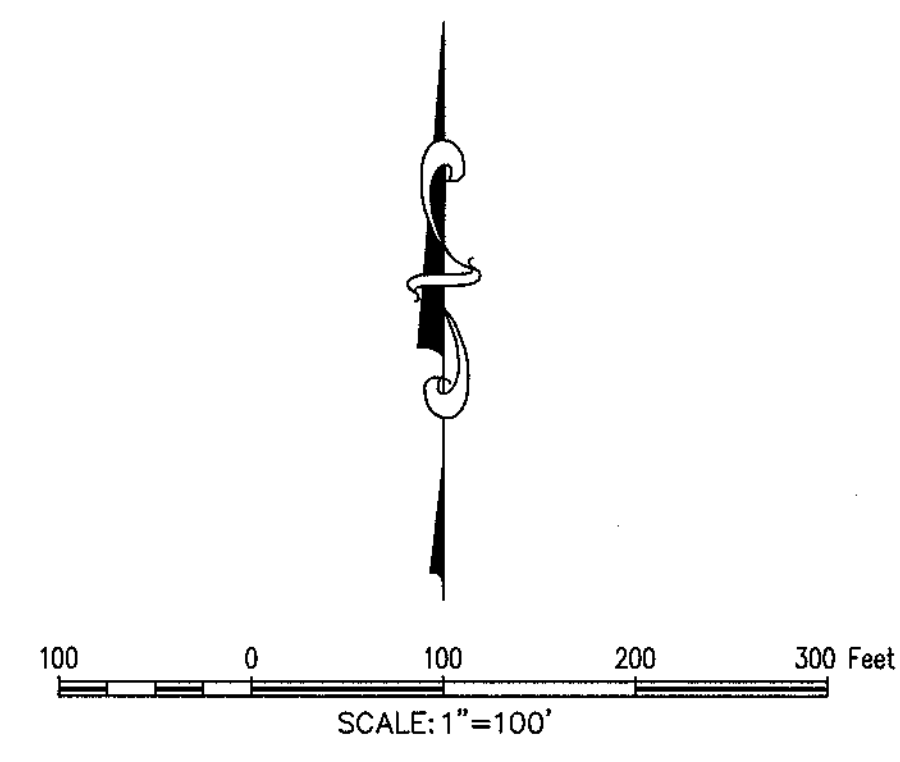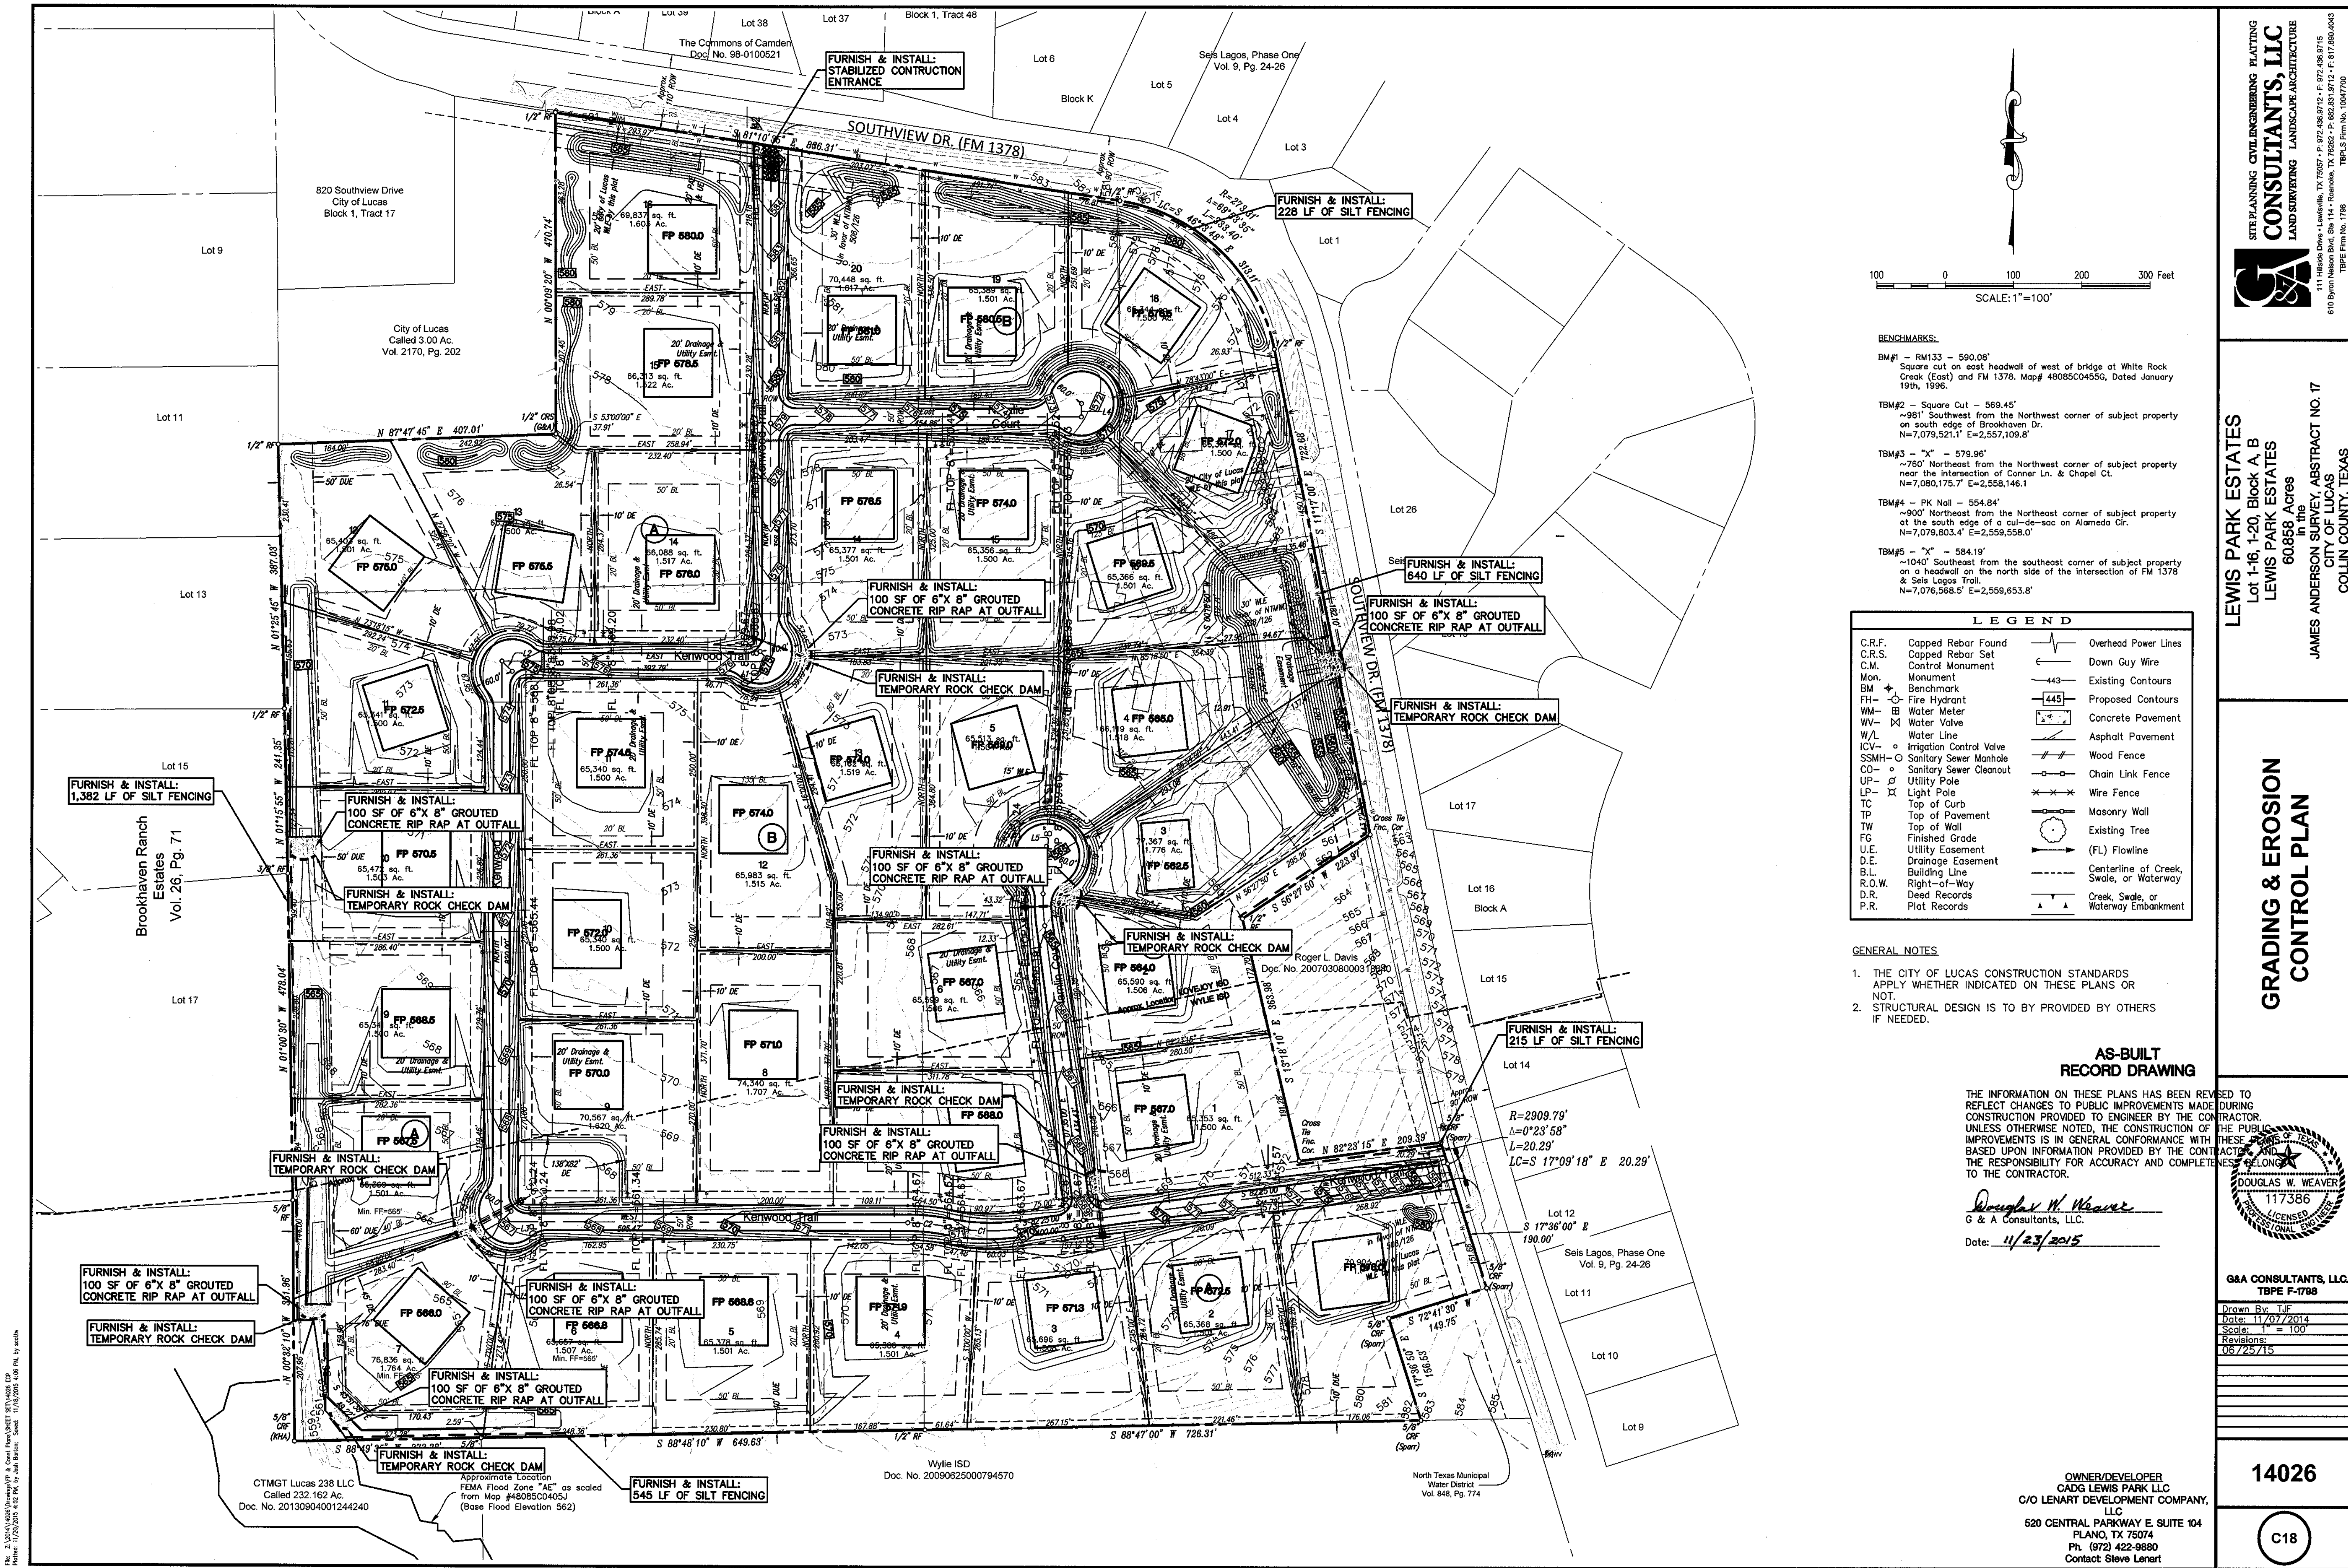

BENCHMARKS:

BM#1 - RM133 - 590.08'
Square cut on east headwall of west of bridge at White Rock Creek (East) and FM 1378. Map# 48085C0455G, Dated January 19th, 1996.

BM#2 - Square Cut - 569.45'
~981' Southwest from the Northwest corner of subject property on south edge of Brookhaven Dr.
N=7,079,521.1' E=2,557,109.8'

BM#3 - "X" - 579.96'
~760' Northeast from the Northwest corner of subject property near the intersection of Corner Ln. & Chapel Ct.
N=7,080,175.7' E=2,558,146.1'

BM#4 - PK Nail - 554.84'
~900' Northeast from the Northeast corner of subject property at the south edge of a cul-de-sac on Alameda Cir.
N=7,079,803.4' E=2,559,558.0'

BM#5 - "X" - 584.19'
~1040' Southeast from the southeast corner of subject property on a headwall on the north side of the intersection of FM 1378 & Seis Lagos Trail.
N=7,076,568.5' E=2,559,853.8'

LEGEND		
C.R.F.	Capped Rebar Found	Overhead Power Lines
C.R.S.	Capped Rebar Set	Down Guy Wire
C.M.	Control Monument	443 Existing Contours
Mon.	Monument	445 Proposed Contours
BM	Benchmark	Concrete Pavement
FH	Fire Hydrant	Asphalt Pavement
WM	Water Meter	Wood Fence
WV	Water Valve	Chain Link Fence
W/L	Water Line	Wire Fence
ICV	Irrigation Control Valve	Masonry Wall
SSMH	Sanitary Sewer Manhole	Existing Tree
CO	Sanitary Sewer Cleanout	(FL) Flowline
UP	Utility Pole	Centerline of Creek, Swale, or Waterway
LP	Light Pole	Creek, Swale, or Waterway Embankment
TC	Top of Curb	
TP	Top of Pavement	
TW	Top of Wall	
FG	Finished Grade	
U.E.	Utility Easement	
D.E.	Drainage Easement	
B.L.	Building Line	
R.O.W.	Right-of-Way	
D.R.	Deed Records	
P.R.	Plot Records	

- GENERAL NOTES**
1. THE CITY OF LUCAS CONSTRUCTION STANDARDS APPLY WHETHER INDICATED ON THESE PLANS OR NOT.
 2. STRUCTURAL DESIGN IS TO BY PROVIDED BY OTHERS IF NEEDED.

**AS-BUILT
RECORD DRAWING**

THE INFORMATION ON THESE PLANS HAS BEEN REVISED TO REFLECT CHANGES TO PUBLIC IMPROVEMENTS MADE DURING CONSTRUCTION PROVIDED TO ENGINEER BY THE CONTRACTOR. UNLESS OTHERWISE NOTED, THE CONSTRUCTION OF THESE IMPROVEMENTS IS IN GENERAL CONFORMANCE WITH THESE PLANS AND BASED UPON INFORMATION PROVIDED BY THE CONTRACTOR. THE RESPONSIBILITY FOR ACCURACY AND COMPLETENESS OF THESE AS-BUILT RECORDS IS LONG TO THE CONTRACTOR.

Douglas W. Weaver
G & A Consultants, LLC.
Date: 11/23/2015

LEWIS PARK ESTATES
Lot 1-16, Block A, B
LEWIS PARK ESTATES
60.858 Acres
in the
CITY OF LUCAS
COLLIN COUNTY, TEXAS

**GRADING & EROSION
CONTROL PLAN**

OWNER/DEVELOPER
CADG LEWIS PARK LLC
C/O LENART DEVELOPMENT COMPANY, LLC
520 CENTRAL PARKWAY E. SUITE 104
PLANO, TX 75074
Ph. (972) 422-9880
Contact Steve Lenart

14026



C18

G&A CONSULTANTS, LLC.
TBP# F-1788

Drawn By: T.J.F.
Date: 11/07/2014
Scale: 1" = 100'
Revisions:
08/25/15

CONSULTANTS, LLC
LAND SURVEYING LANDSCAPE ARCHITECTURE

111 Hillside Drive - Lewisville, TX 76047 • P: 972.486.9715 • F: 972.486.9715
610 Byron Nelson Blvd. Ste 114 - Rowland, TX 76265 • P: 817.281.9712 • F: 817.281.9715
TBP# S Firm No. 1798

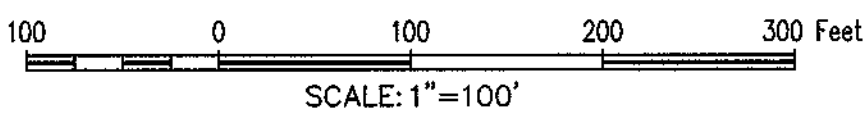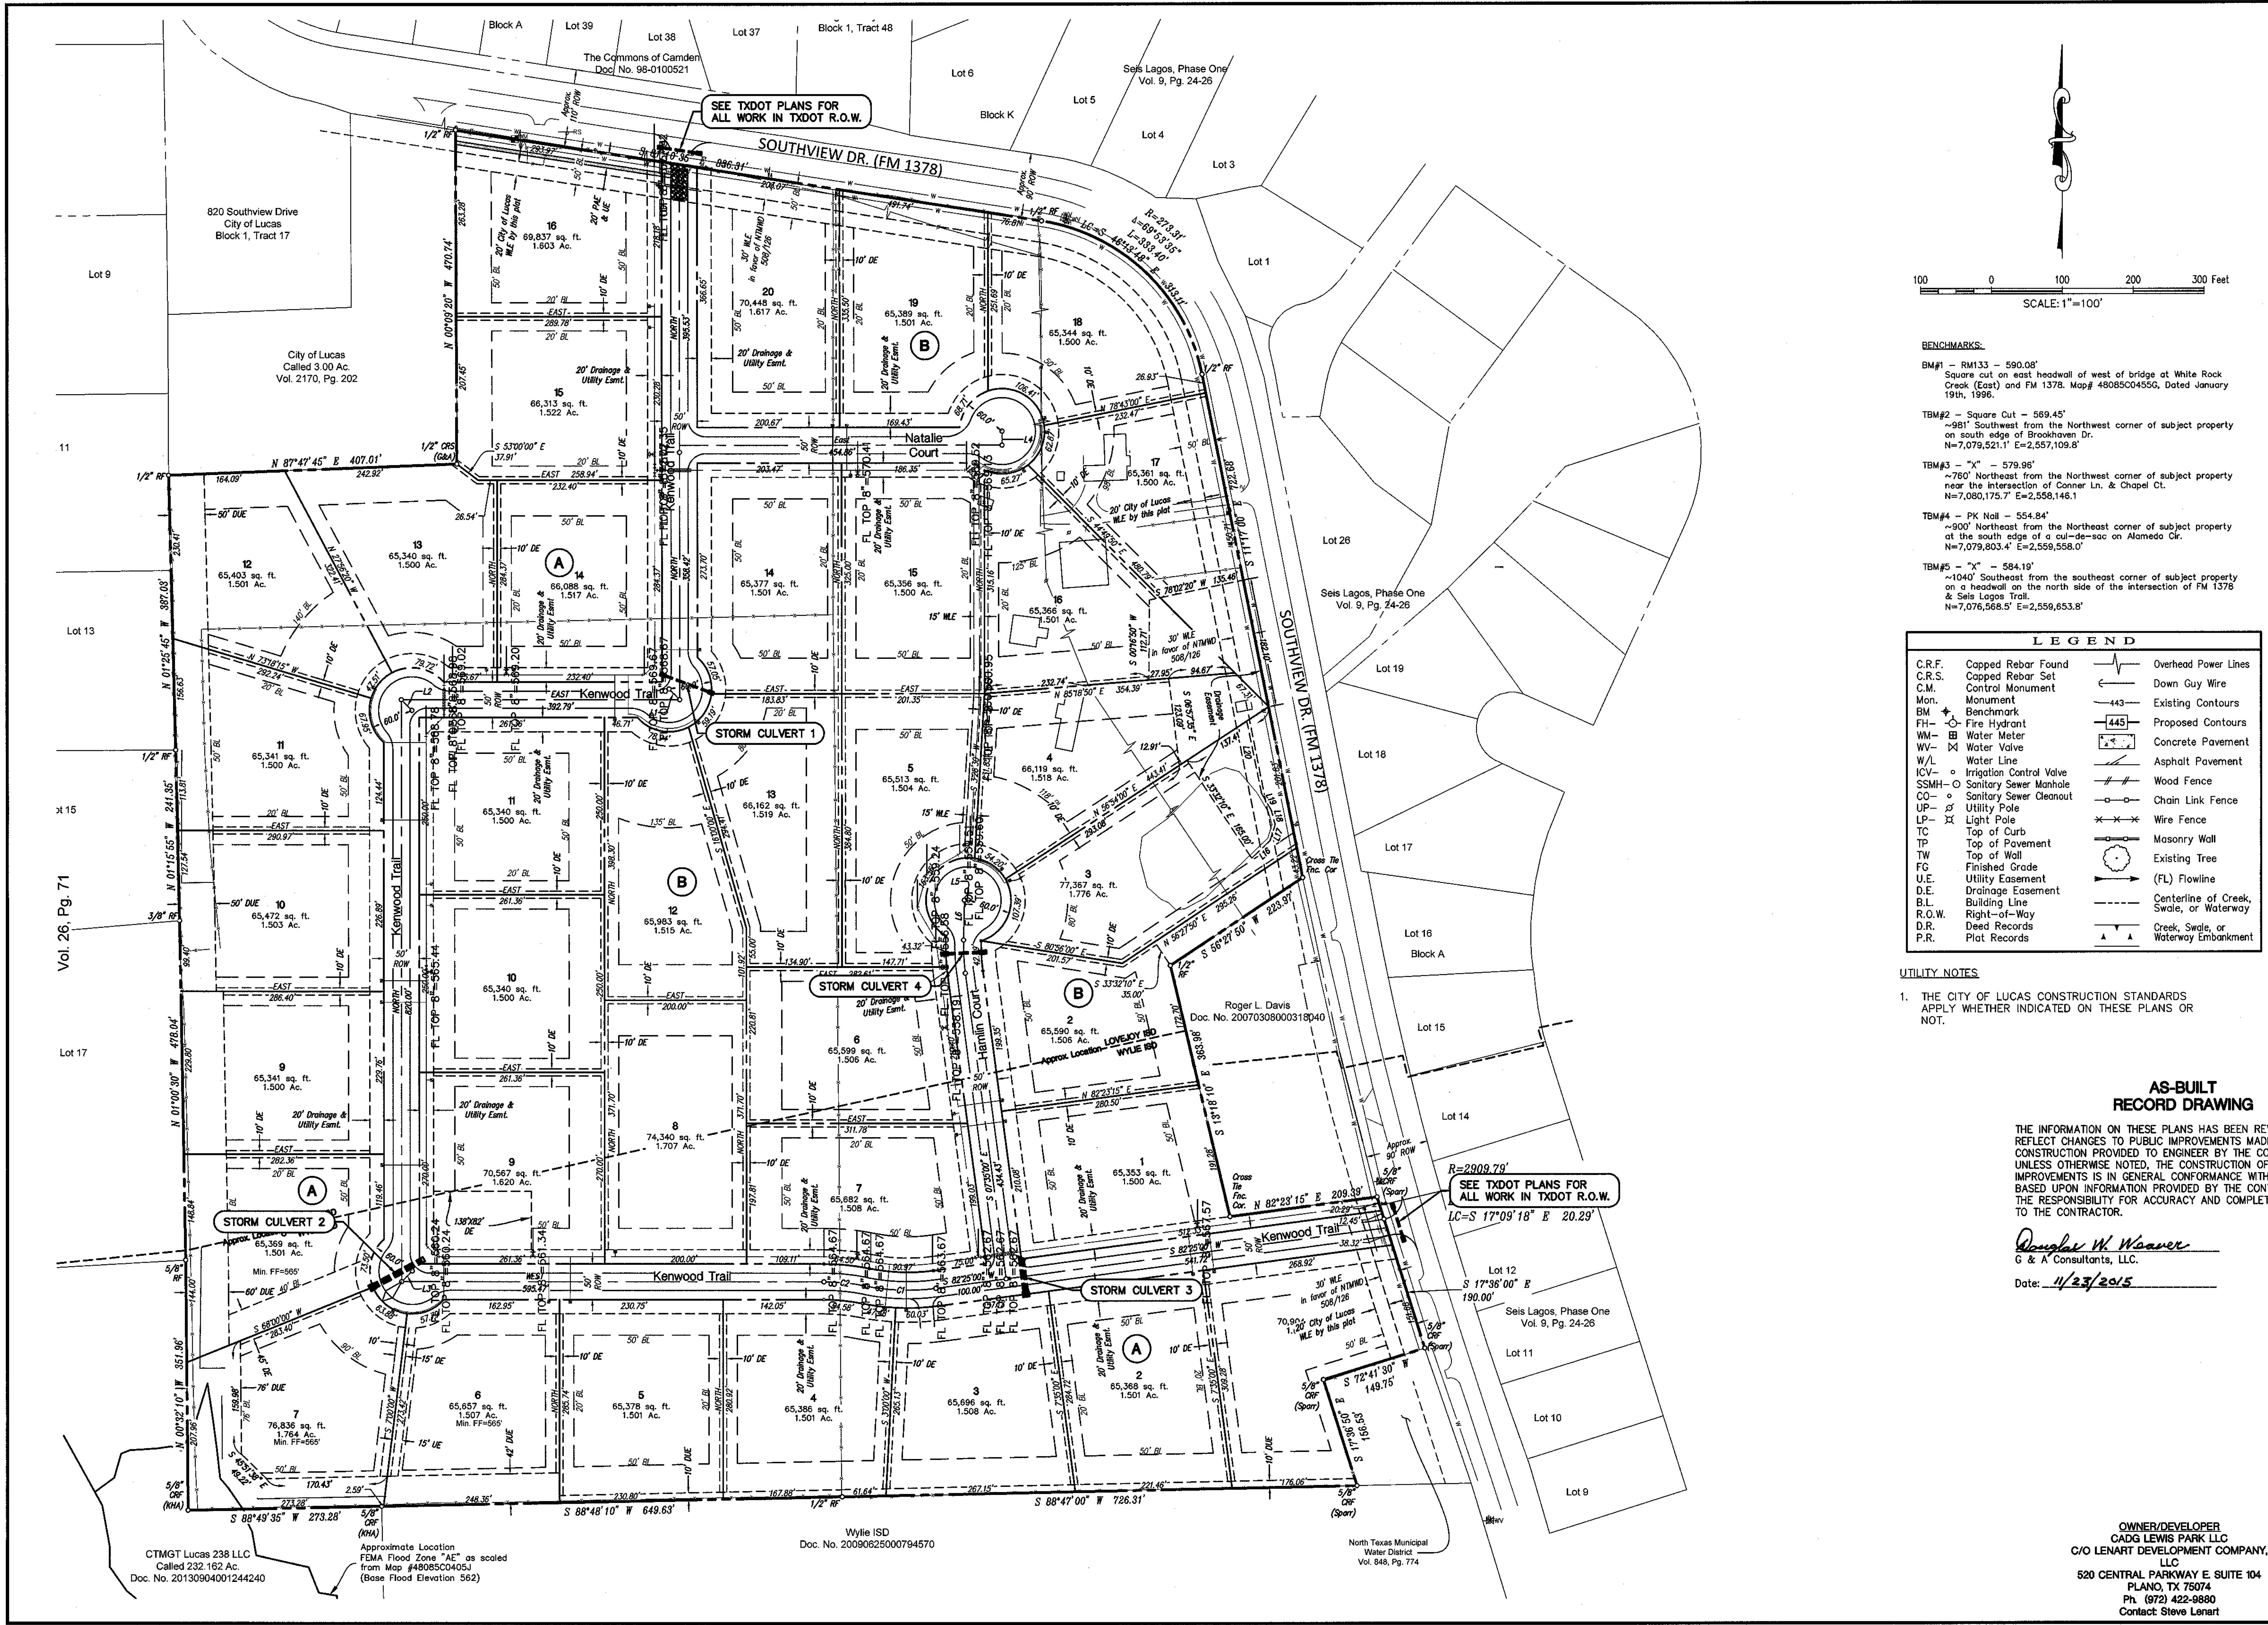

BENCHMARKS:

BM#1 - RM133 - 590.08'
Square cut on east headwall of west of bridge at White Rock Creek (East) and FM 1378. Map# 4808500455G, Dated January 19th, 1996.

TBM#2 - Square Cut - 569.45'
~981' Southwest from the Northwest corner of subject property on south edge of Brookhaven Dr.
N=7,079,521.1' E=2,557,109.8'

TBM#3 - "X" - 579.96'
~780' Northeast from the Northwest corner of subject property near the intersection of Conner Ln. & Chapel Ct.
N=7,080,175.7' E=2,558,146.1

TBM#4 - PK Nail - 554.84'
~900' Northeast from the Northeast corner of subject property on a headwall of a cul-de-sac on Alameda Cir.
N=7,079,803.4' E=2,559,558.0'

TBM#5 - "X" - 584.19'
~1040' Southeast from the southeast corner of subject property on the south edge of a cul-de-sac on Alameda Cir. & Seis Lagos Trail.
N=7,076,568.5' E=2,559,653.8'

LEGEND		
C.R.F.	Capped Rebar Found	Overhead Power Lines
C.R.S.	Capped Rebar Set	Down Guy Wire
C.M.	Control Monument	443 Existing Contours
Mon.	Monument	443 Proposed Contours
BM	Benchmark	Concrete Pavement
FH	Fire Hydrant	Asphalt Pavement
WM	Water Meter	Wood Fence
WV	Water Valve	Chain Link Fence
W/L	Water Line	Wire Fence
ICV	Irrigation Control Valve	Masonry Wall
SSMH	Sanitary Sewer Manhole	Existing Tree
CO	Sanitary Sewer Cleanout	(FL) Flowline
UP	Utility Pole	Centerline of Creek, Swale, or Waterway
LP	Light Pole	Creek, Swale, or Waterway Embankment
TC	Top of Curb	
TP	Top of Pavement	
TW	Top of Wall	
FG	Finished Grade	
U.E.	Utility Easement	
D.E.	Drainage Easement	
B.L.	Building Line	
R.O.W.	Right-of-Way	
D.R.	Deed Records	
P.R.	Plot Records	

UTILITY NOTES

1. THE CITY OF LUCAS CONSTRUCTION STANDARDS APPLY WHETHER INDICATED ON THESE PLANS OR NOT.

AS-BUILT RECORD DRAWING

THE INFORMATION ON THESE PLANS HAS BEEN REVISED TO REFLECT CHANGES TO PUBLIC IMPROVEMENTS MADE DURING CONSTRUCTION PROVIDED TO ENGINEER BY THE CONTRACTOR. UNLESS OTHERWISE NOTED, THE CONSTRUCTION OF THE PUBLIC IMPROVEMENTS IS IN GENERAL CONFORMANCE WITH THE TEXAS STANDARD SPECIFICATIONS FOR CONSTRUCTION, LATEST EDITION, AND THE RESPONSIBILITY FOR ACCURACY AND COMPLETENESS BELONGS TO THE CONTRACTOR.

Douglas W. Weaver
G & A Consultants, LLC.
Date: 11/23/2015

LEWIS PARK ESTATES
Lot 1-16, Block A, B
LEWIS PARK ESTATES
60.868 Acres
in the
CITY OF LUCAS
COLLIN COUNTY, TEXAS

STORM SEWER PLAN

CONSULTANTS, LLC
LAND SURVEYING LANDSCAPE ARCHITECTURE
111 Hillside Drive - Lewisville, TX 76047 - P: 972.436.9712 - F: 972.436.9715
610 Bryan Nelson Blvd, Ste 114 - Rowlett, TX 75081 - P: 972.831.9712 - F: 972.831.9715
TBP# S Firm No. 10047700

AS-BUILT RECORD DRAWING

THE INFORMATION ON THESE PLANS HAS BEEN REVISED TO REFLECT CHANGES TO PUBLIC IMPROVEMENTS MADE DURING CONSTRUCTION PROVIDED TO ENGINEER BY THE CONTRACTOR. UNLESS OTHERWISE NOTED, THE CONSTRUCTION OF THE PUBLIC IMPROVEMENTS IS IN GENERAL CONFORMANCE WITH THE TEXAS STANDARD SPECIFICATIONS FOR CONSTRUCTION, LATEST EDITION, AND THE RESPONSIBILITY FOR ACCURACY AND COMPLETENESS BELONGS TO THE CONTRACTOR.





Douglas W. Weaver
G & A Consultants, LLC.
Date: 11/23/2015

G&A CONSULTANTS, LLC.
TBP# F-1708

Drawn By: JWF
Date: 11/07/2014
Scale: 1" = 100'
Revisions:

14026

C19

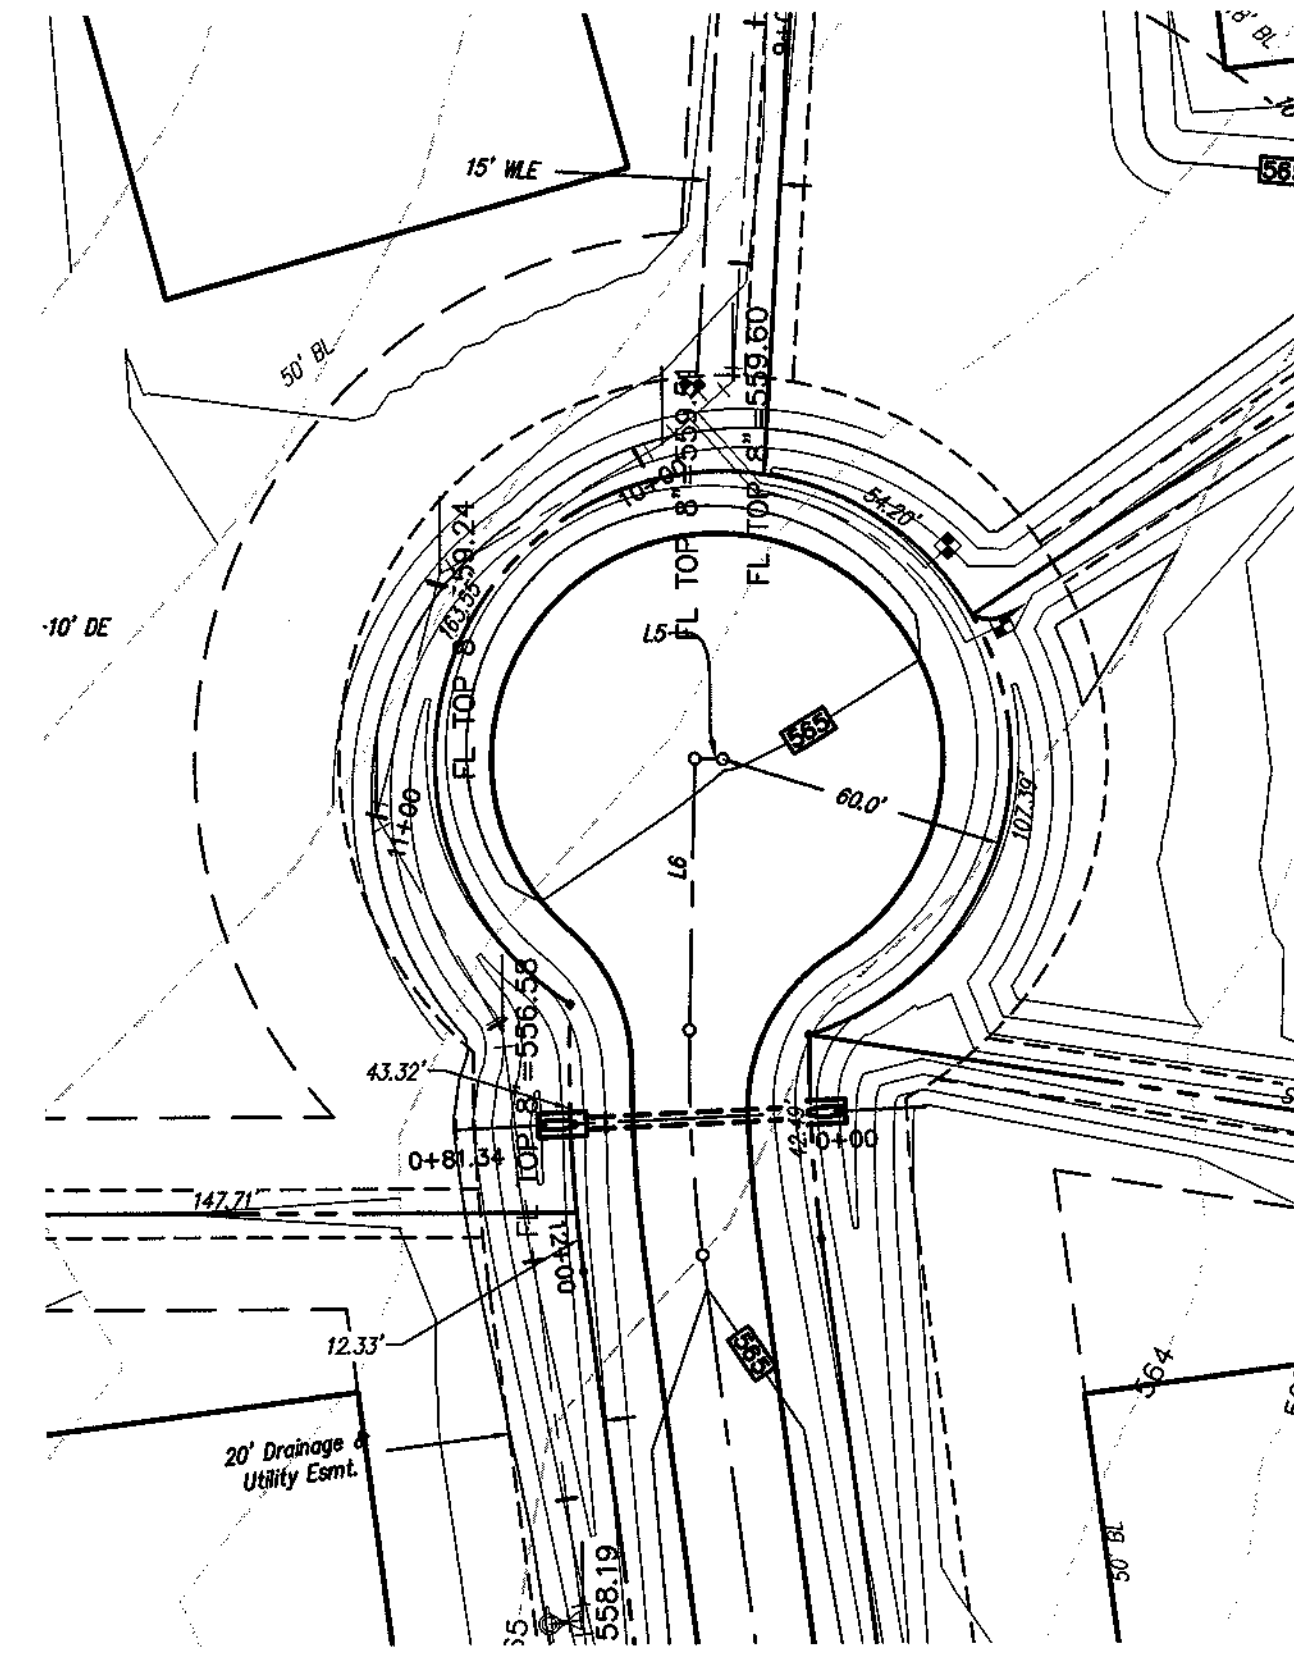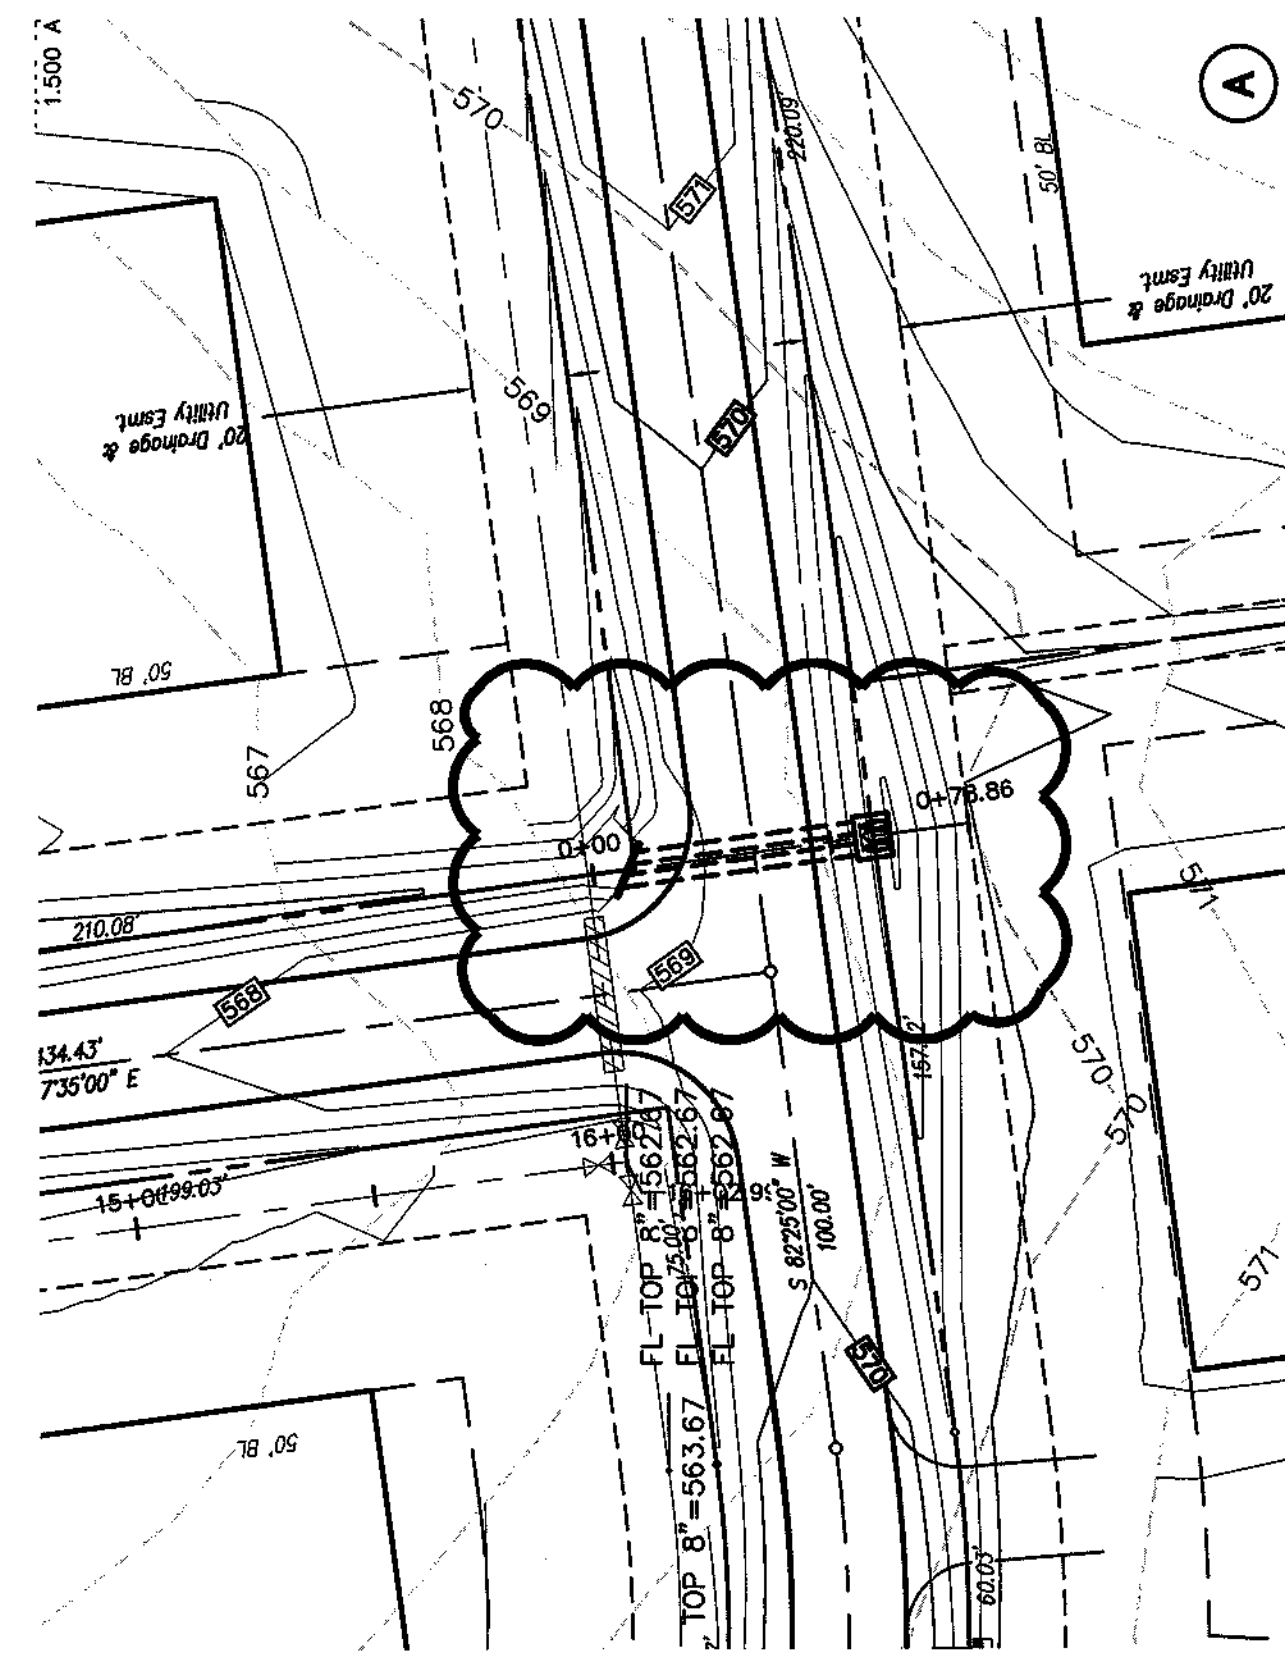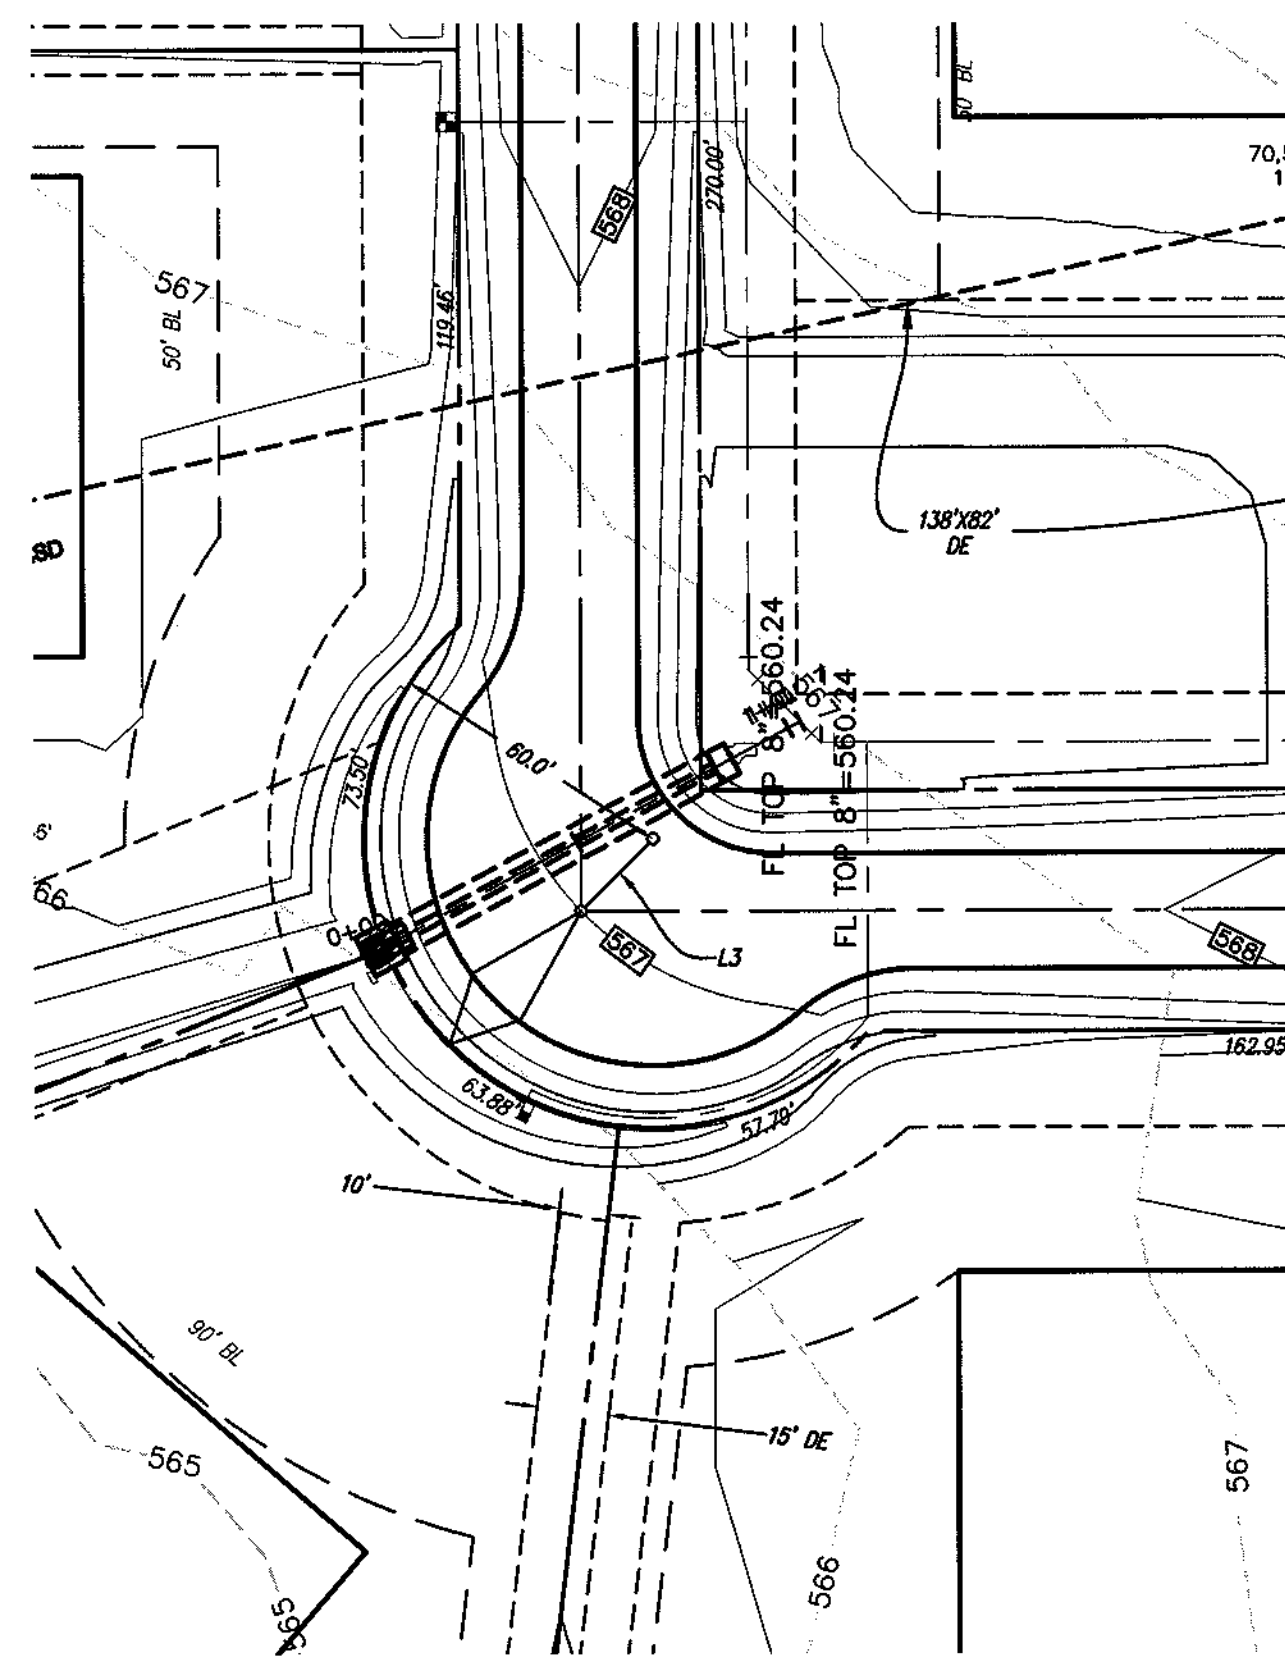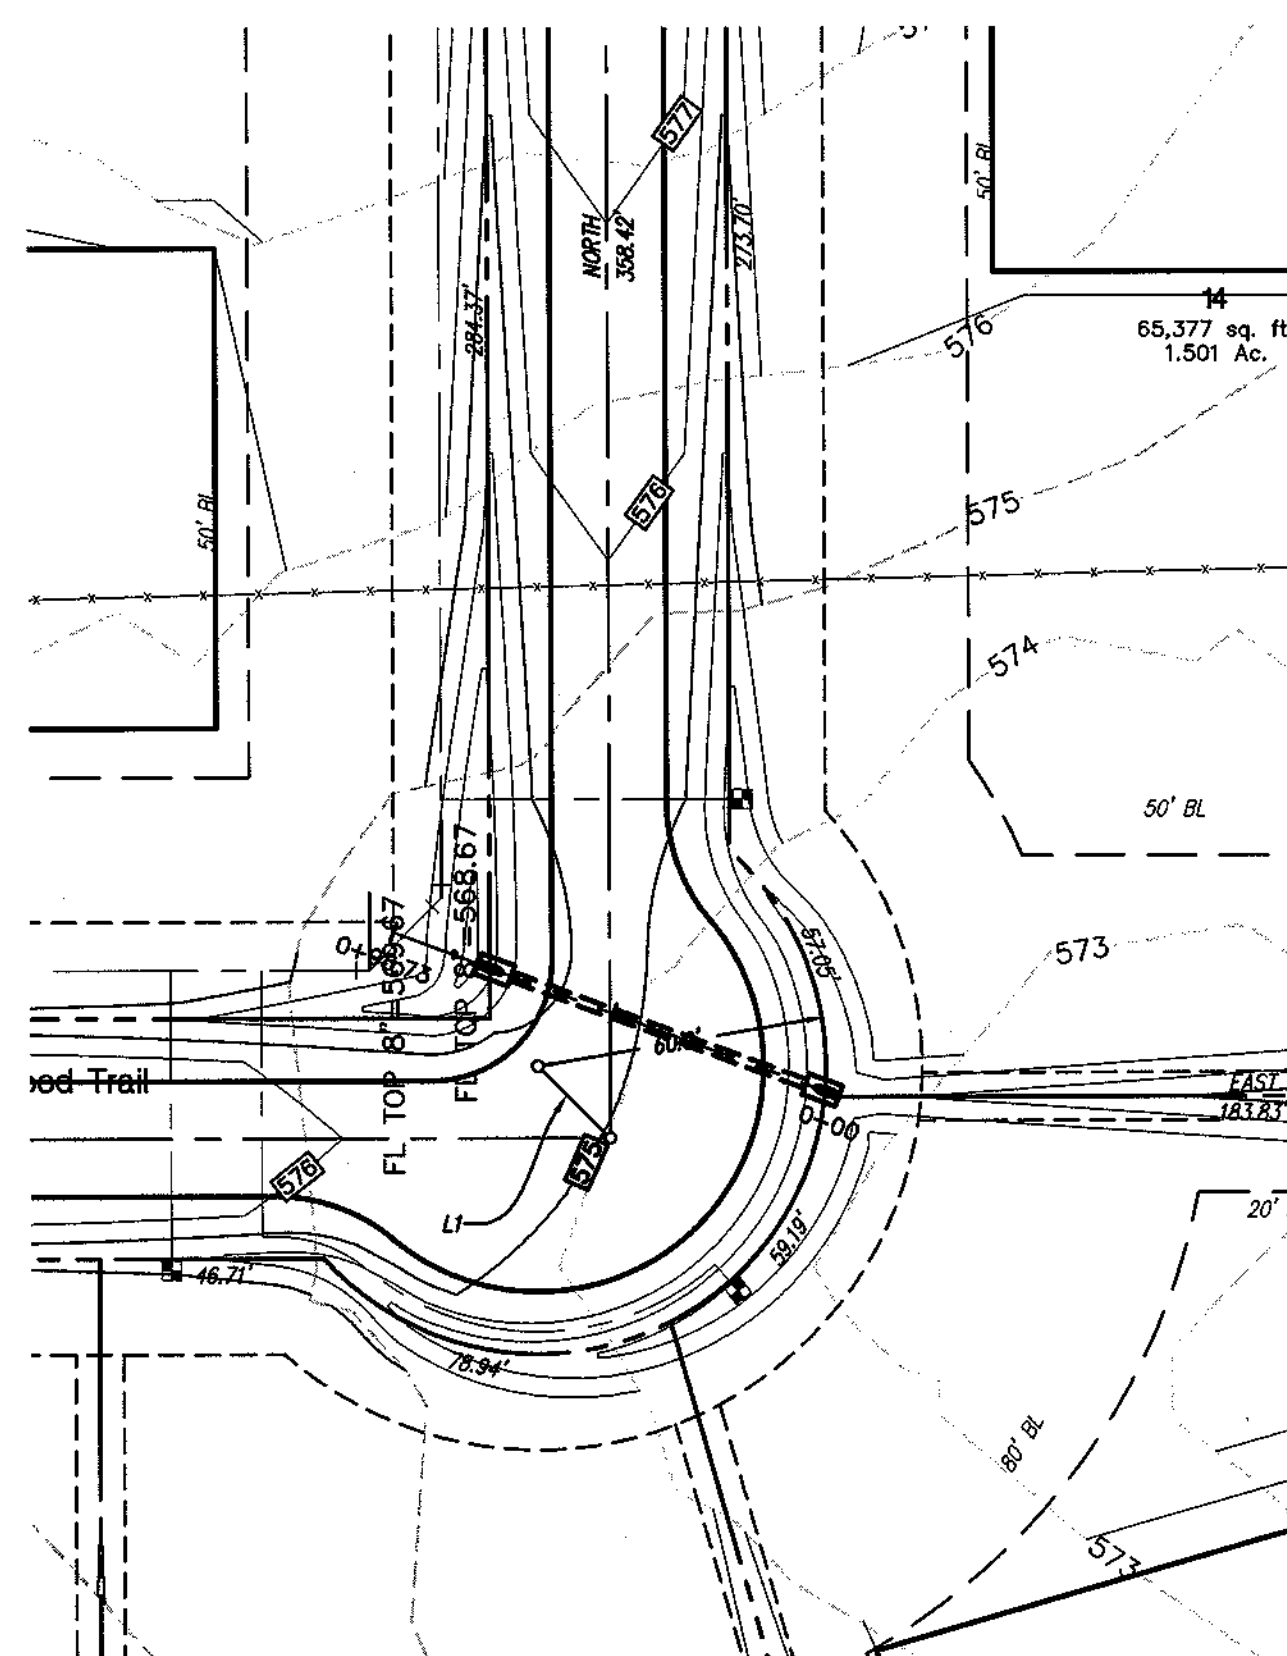


BENCHMARKS:


- BM#1 - RM133 - 590.08'
Square cut on east headwall of west of bridge at White Rock Creek (East) and FM 1378. Map# 48085004556, Dated January 19th, 1996.
- TBM#2 - Square Cut - 569.45'
~961' Southwest from the Northwest corner of subject property on south edge of Brookhaven Dr.
N=7,079,521.1' E=2,557,109.8'
- TBM#3 - "X" - 579.96'
~760' Northeast from the Northwest corner of subject property near the intersection of Conner Ln. & Chapel Ct.
N=7,080,175.7' E=2,558,146.1'
- TBM#4 - PK Nail - 554.84'
~900' Northeast from the Northeast corner of subject property at the south edge of a cul-de-sac on Alameda Cir.
N=7,079,803.4' E=2,559,558.0'
- TBM#5 - "X" - 584.19'
~1040' Southeast from the southeast corner of subject property on a headwall on the north side of the intersection of FM 1378 & Seis Lagos Trail.
N=7,076,568.5' E=2,559,653.8'

UTILITY NOTES


1. THE CITY OF LUCAS CONSTRUCTION STANDARDS APPLY WHETHER INDICATED ON THESE PLANS OR NOT.

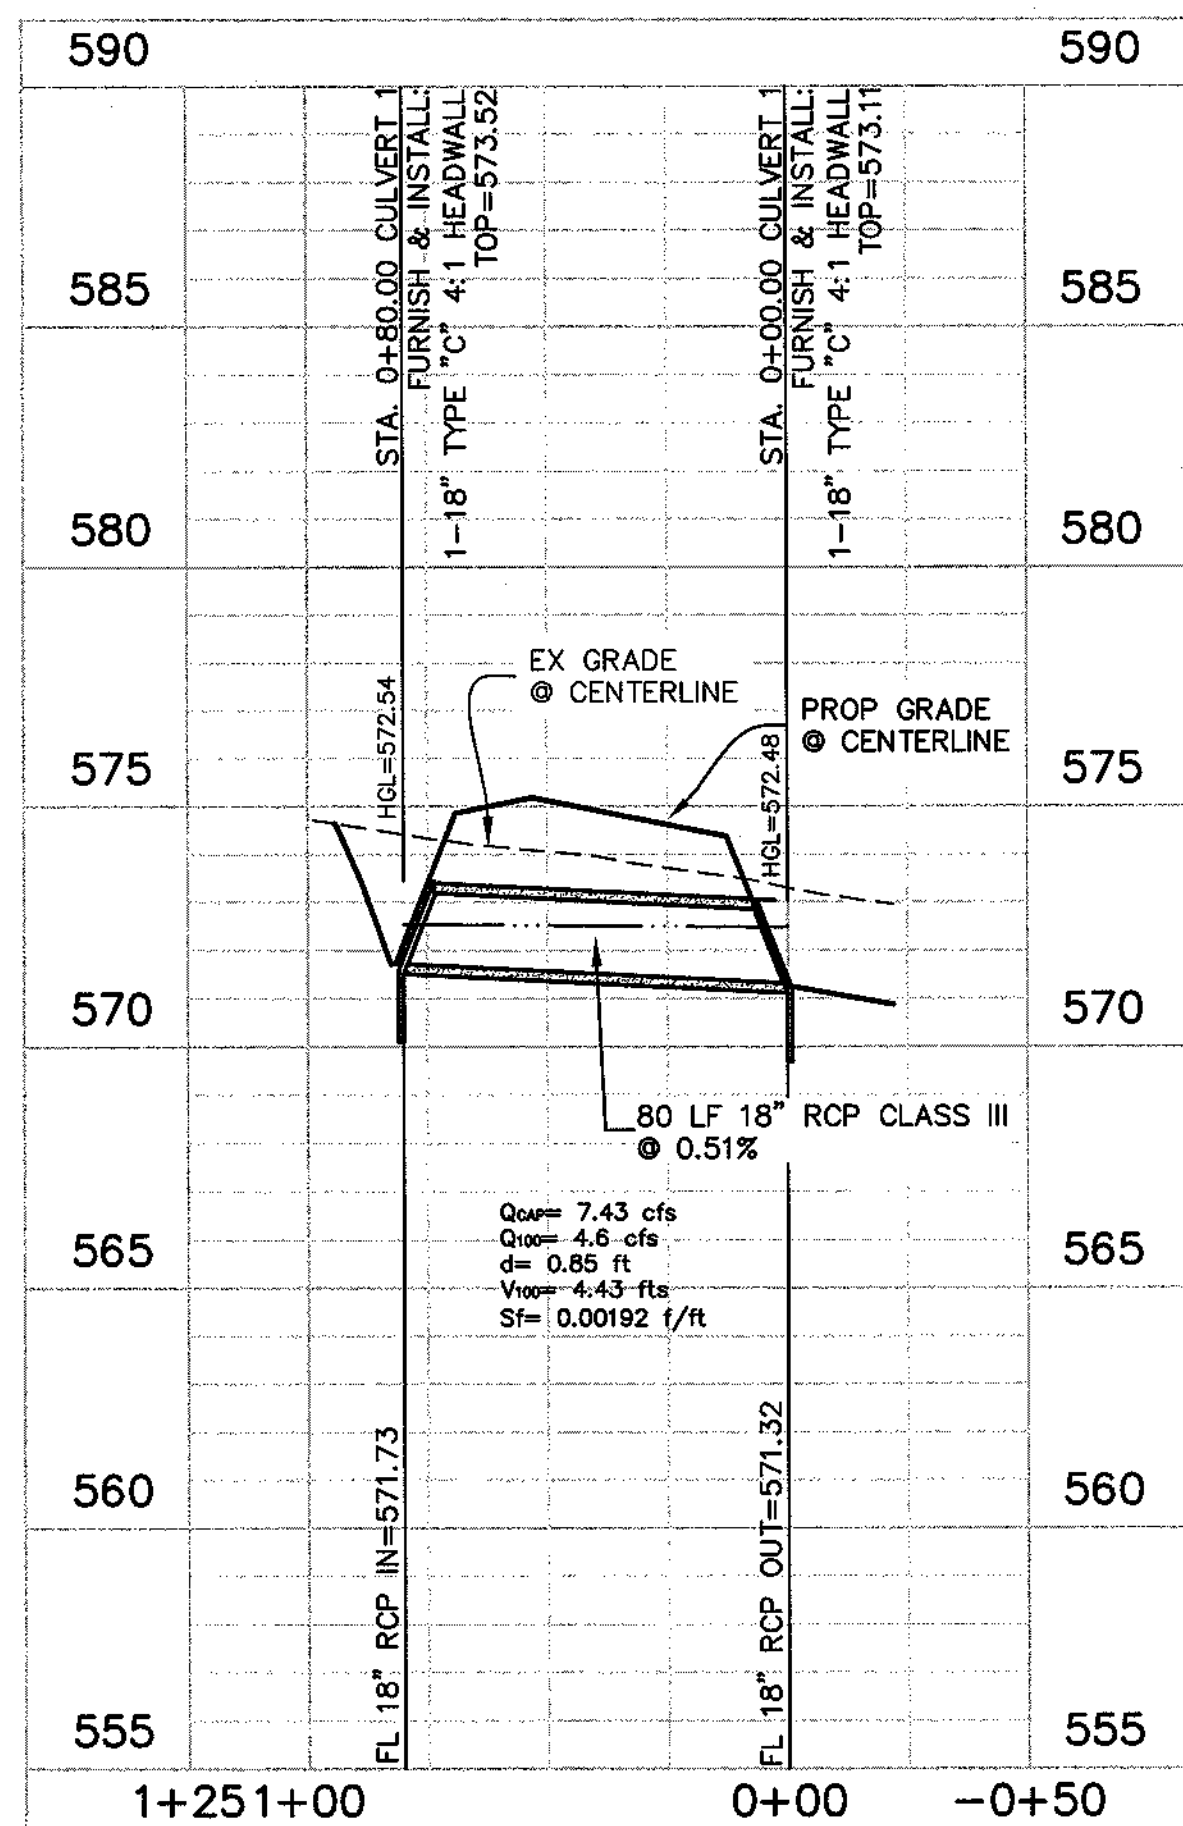


STORM CULVERT 1

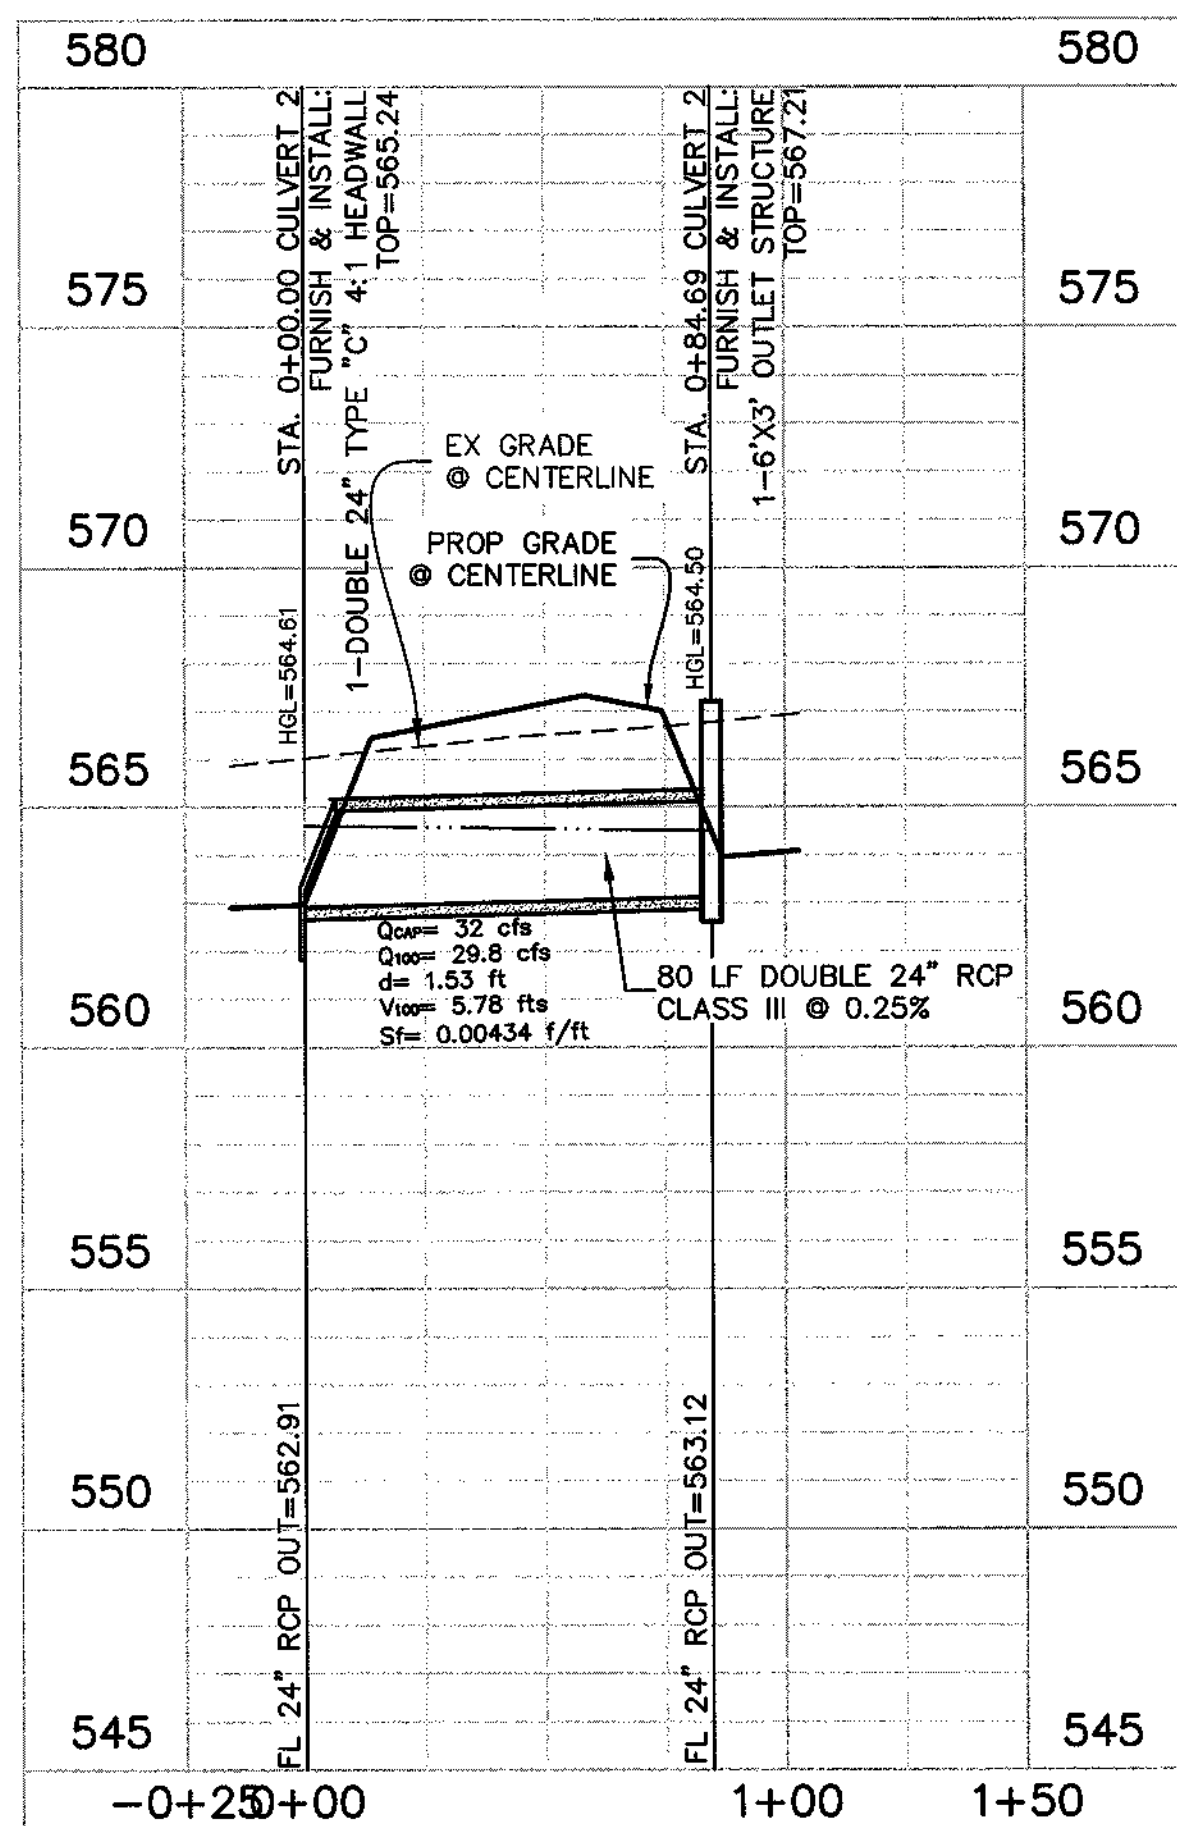

STORM SEWER CULVERT 2

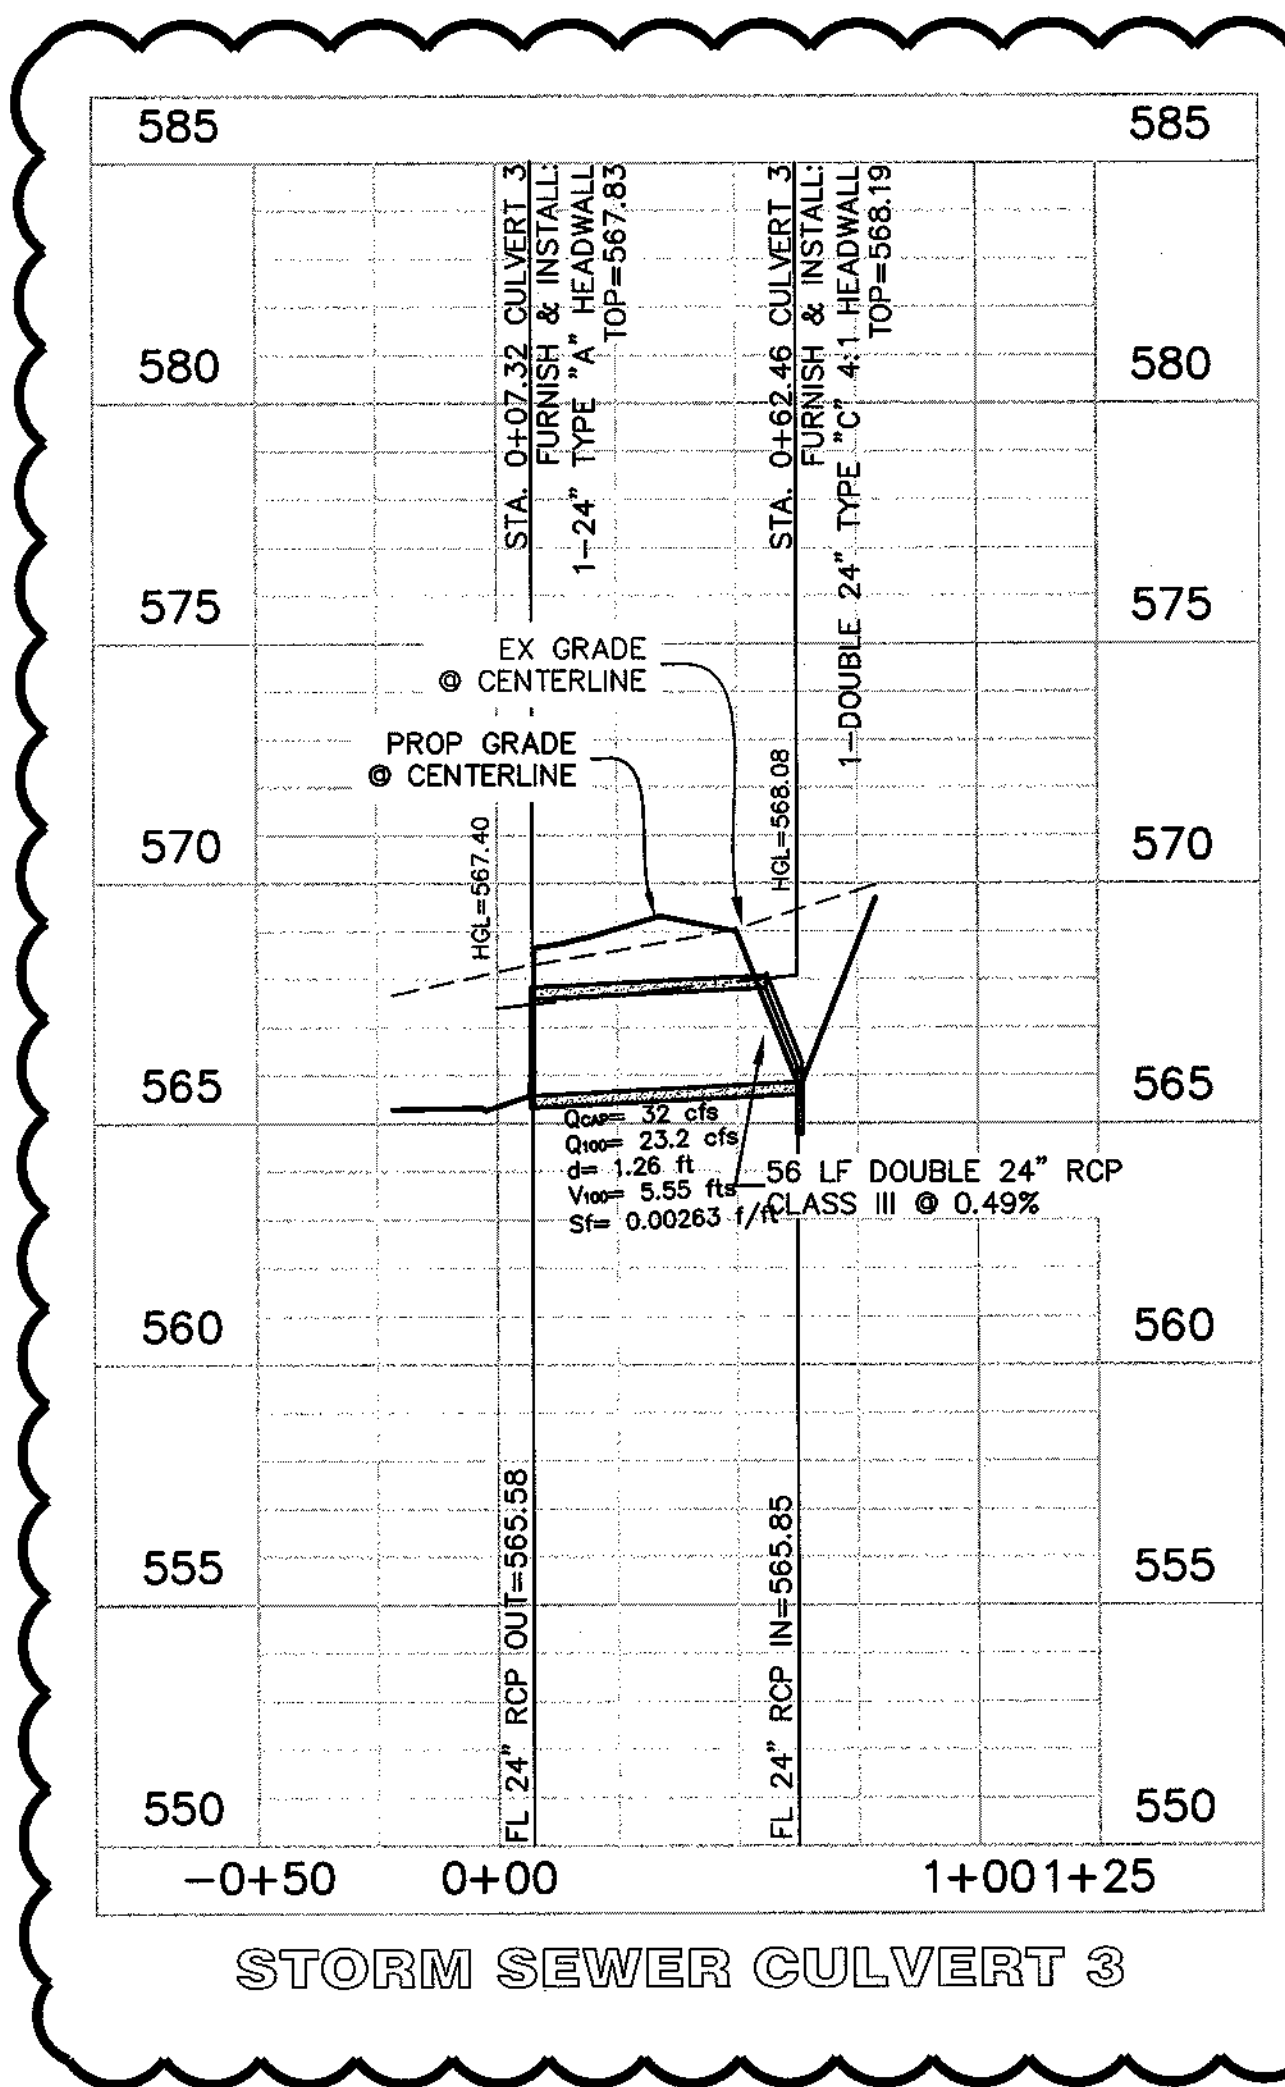

STORM SEWER CULVERT 3

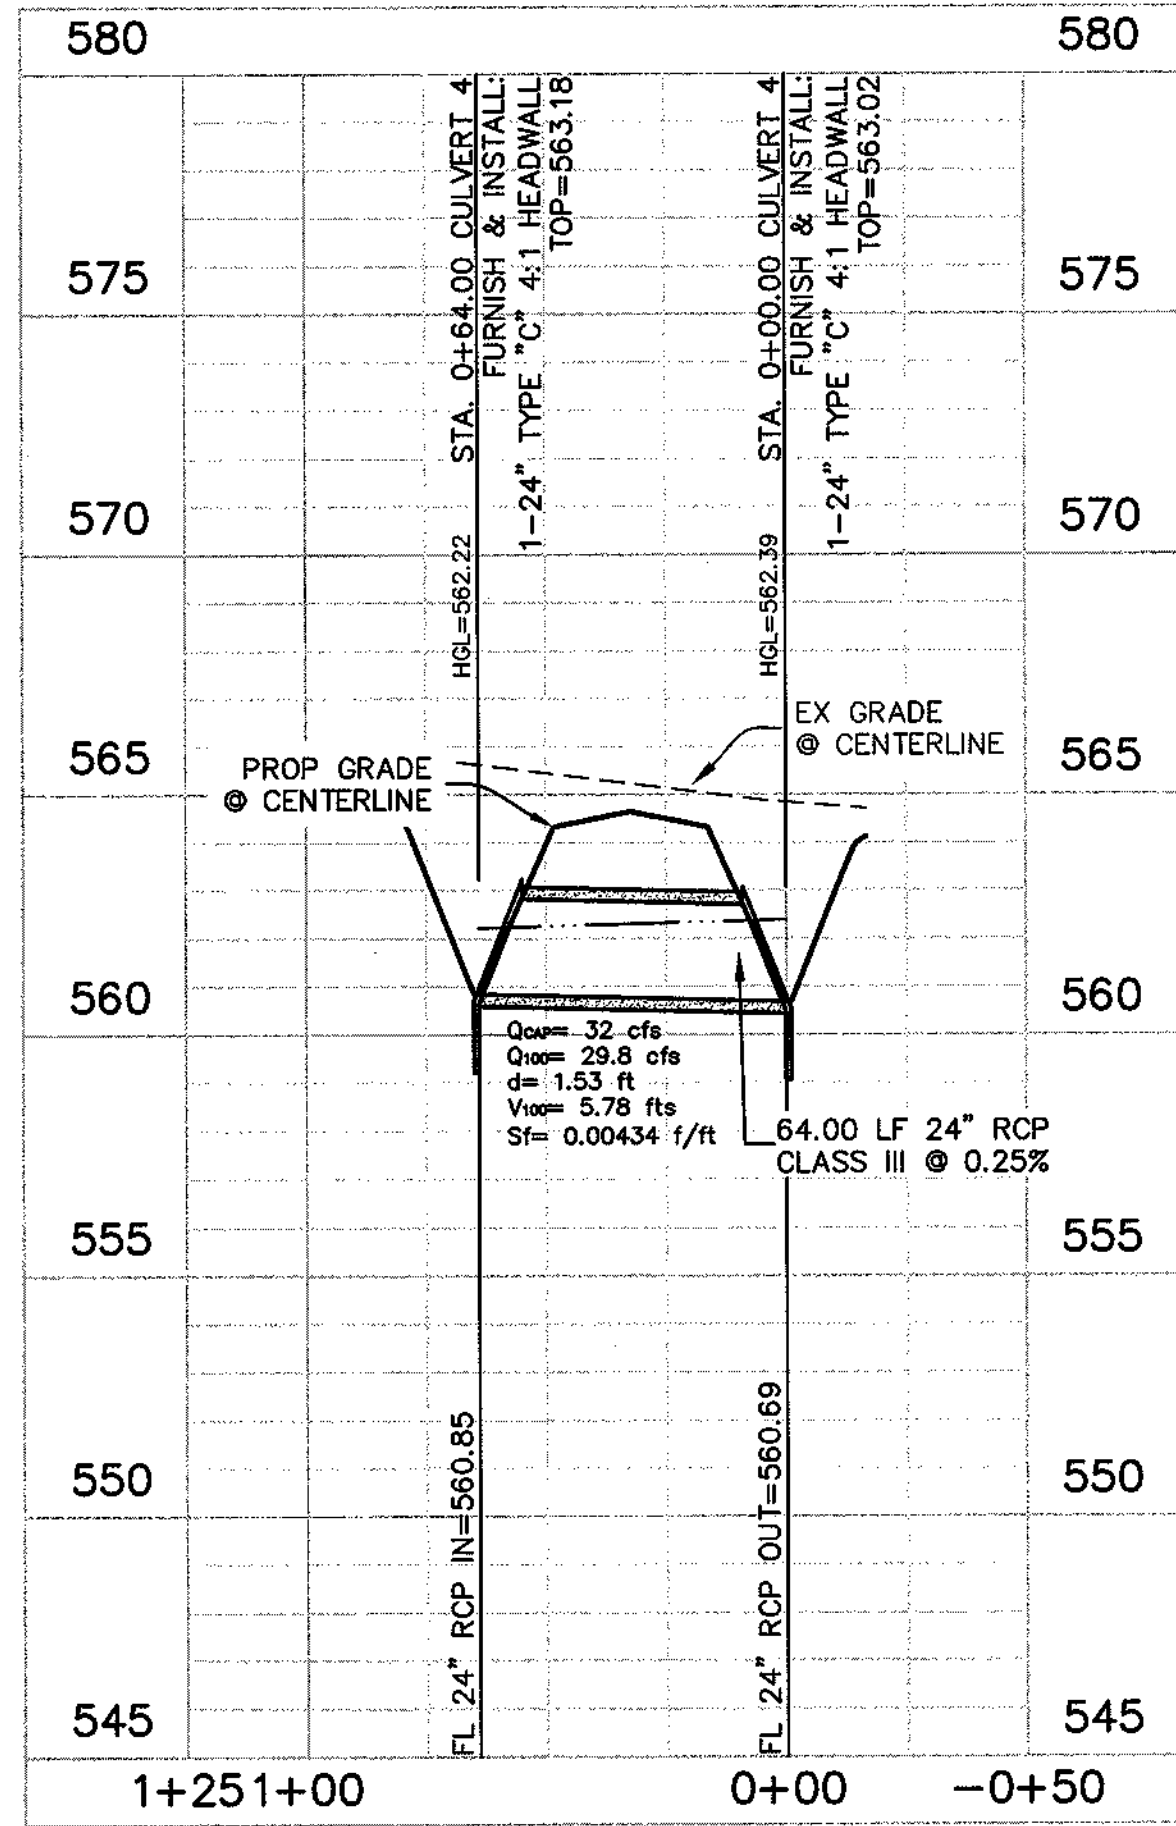


STORM CULVERT 4

AS-BUILT RECORD DRAWING

THE INFORMATION ON THESE PLANS HAS BEEN REVISED TO REFLECT CHANGES TO PUBLIC IMPROVEMENTS MADE DURING CONSTRUCTION PROVIDED TO ENGINEER BY THE CONTRACTOR. UNLESS OTHERWISE NOTED, THE CONSTRUCTION OF THE PUBLIC IMPROVEMENTS IS IN GENERAL CONFORMANCE WITH THESE PLANS. THE RESPONSIBILITY FOR ACCURACY AND COMPLETENESS REMAINS TO THE CONTRACTOR.

Douglas W. Weaver
G & A Consultants, LLC.
Date: 11/23/2015

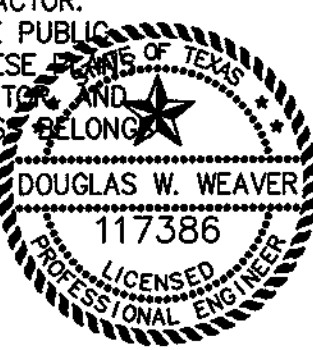

G & A CONSULTANTS, LLC.
TBPE F-1798

Drawn By: JTF
Date: 11/07/2014
Scale: H 1"=40'; V 1"=4'
Revisions:
06/08/15

OWNER/DEVELOPER
CADG LEWIS PARK LLC
C/O LENART DEVELOPMENT COMPANY, LLC
520 CENTRAL PARKWAY E SUITE 104
PLANO, TX 75074
Ph. (972) 422-9880
Contact: Steve Lenart

STORM SEWER PROFILE

LEWIS PARK ESTATES
Lot 1-16, 1-20, Block A, B

LEWIS PARK ESTATES
60.858 Acres
in the



JAMES ANDERSON SURVEY, ABSTRACT NO. 17
CITY OF LUCAS
COLLIN COUNTY, TEXAS

SITE PLANNING CIVIL ENGINEERING PLANNING
CONSULTANTS, LLC
LAND SURVEYING LANDSCAPE ARCHITECTURE
111 Hillside Drive • Lewisville, TX 75057 • P: 972.438.9712 • F: 972.438.9715
610 Byron Nelson Blvd. Ste. 114 • Rowlett, TX 75081 • P: 972.331.9712 • F: 972.331.9715
TBPE Firm No. 1798

LEWIS PARK ESTATES

14026

C20

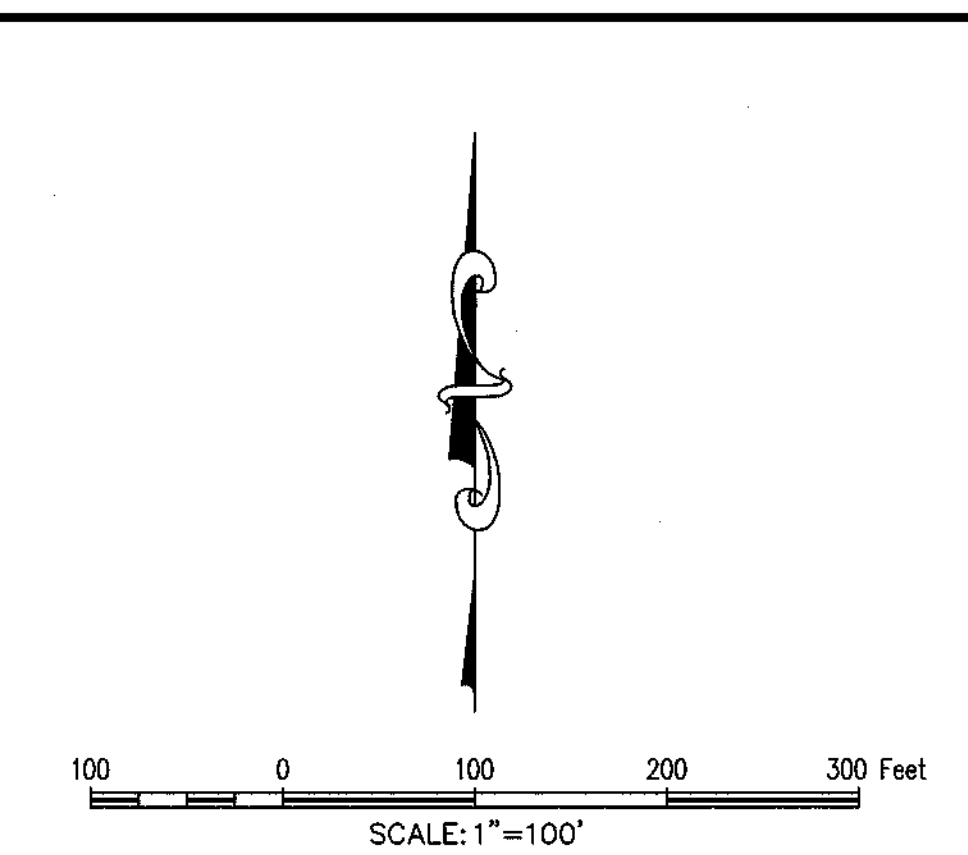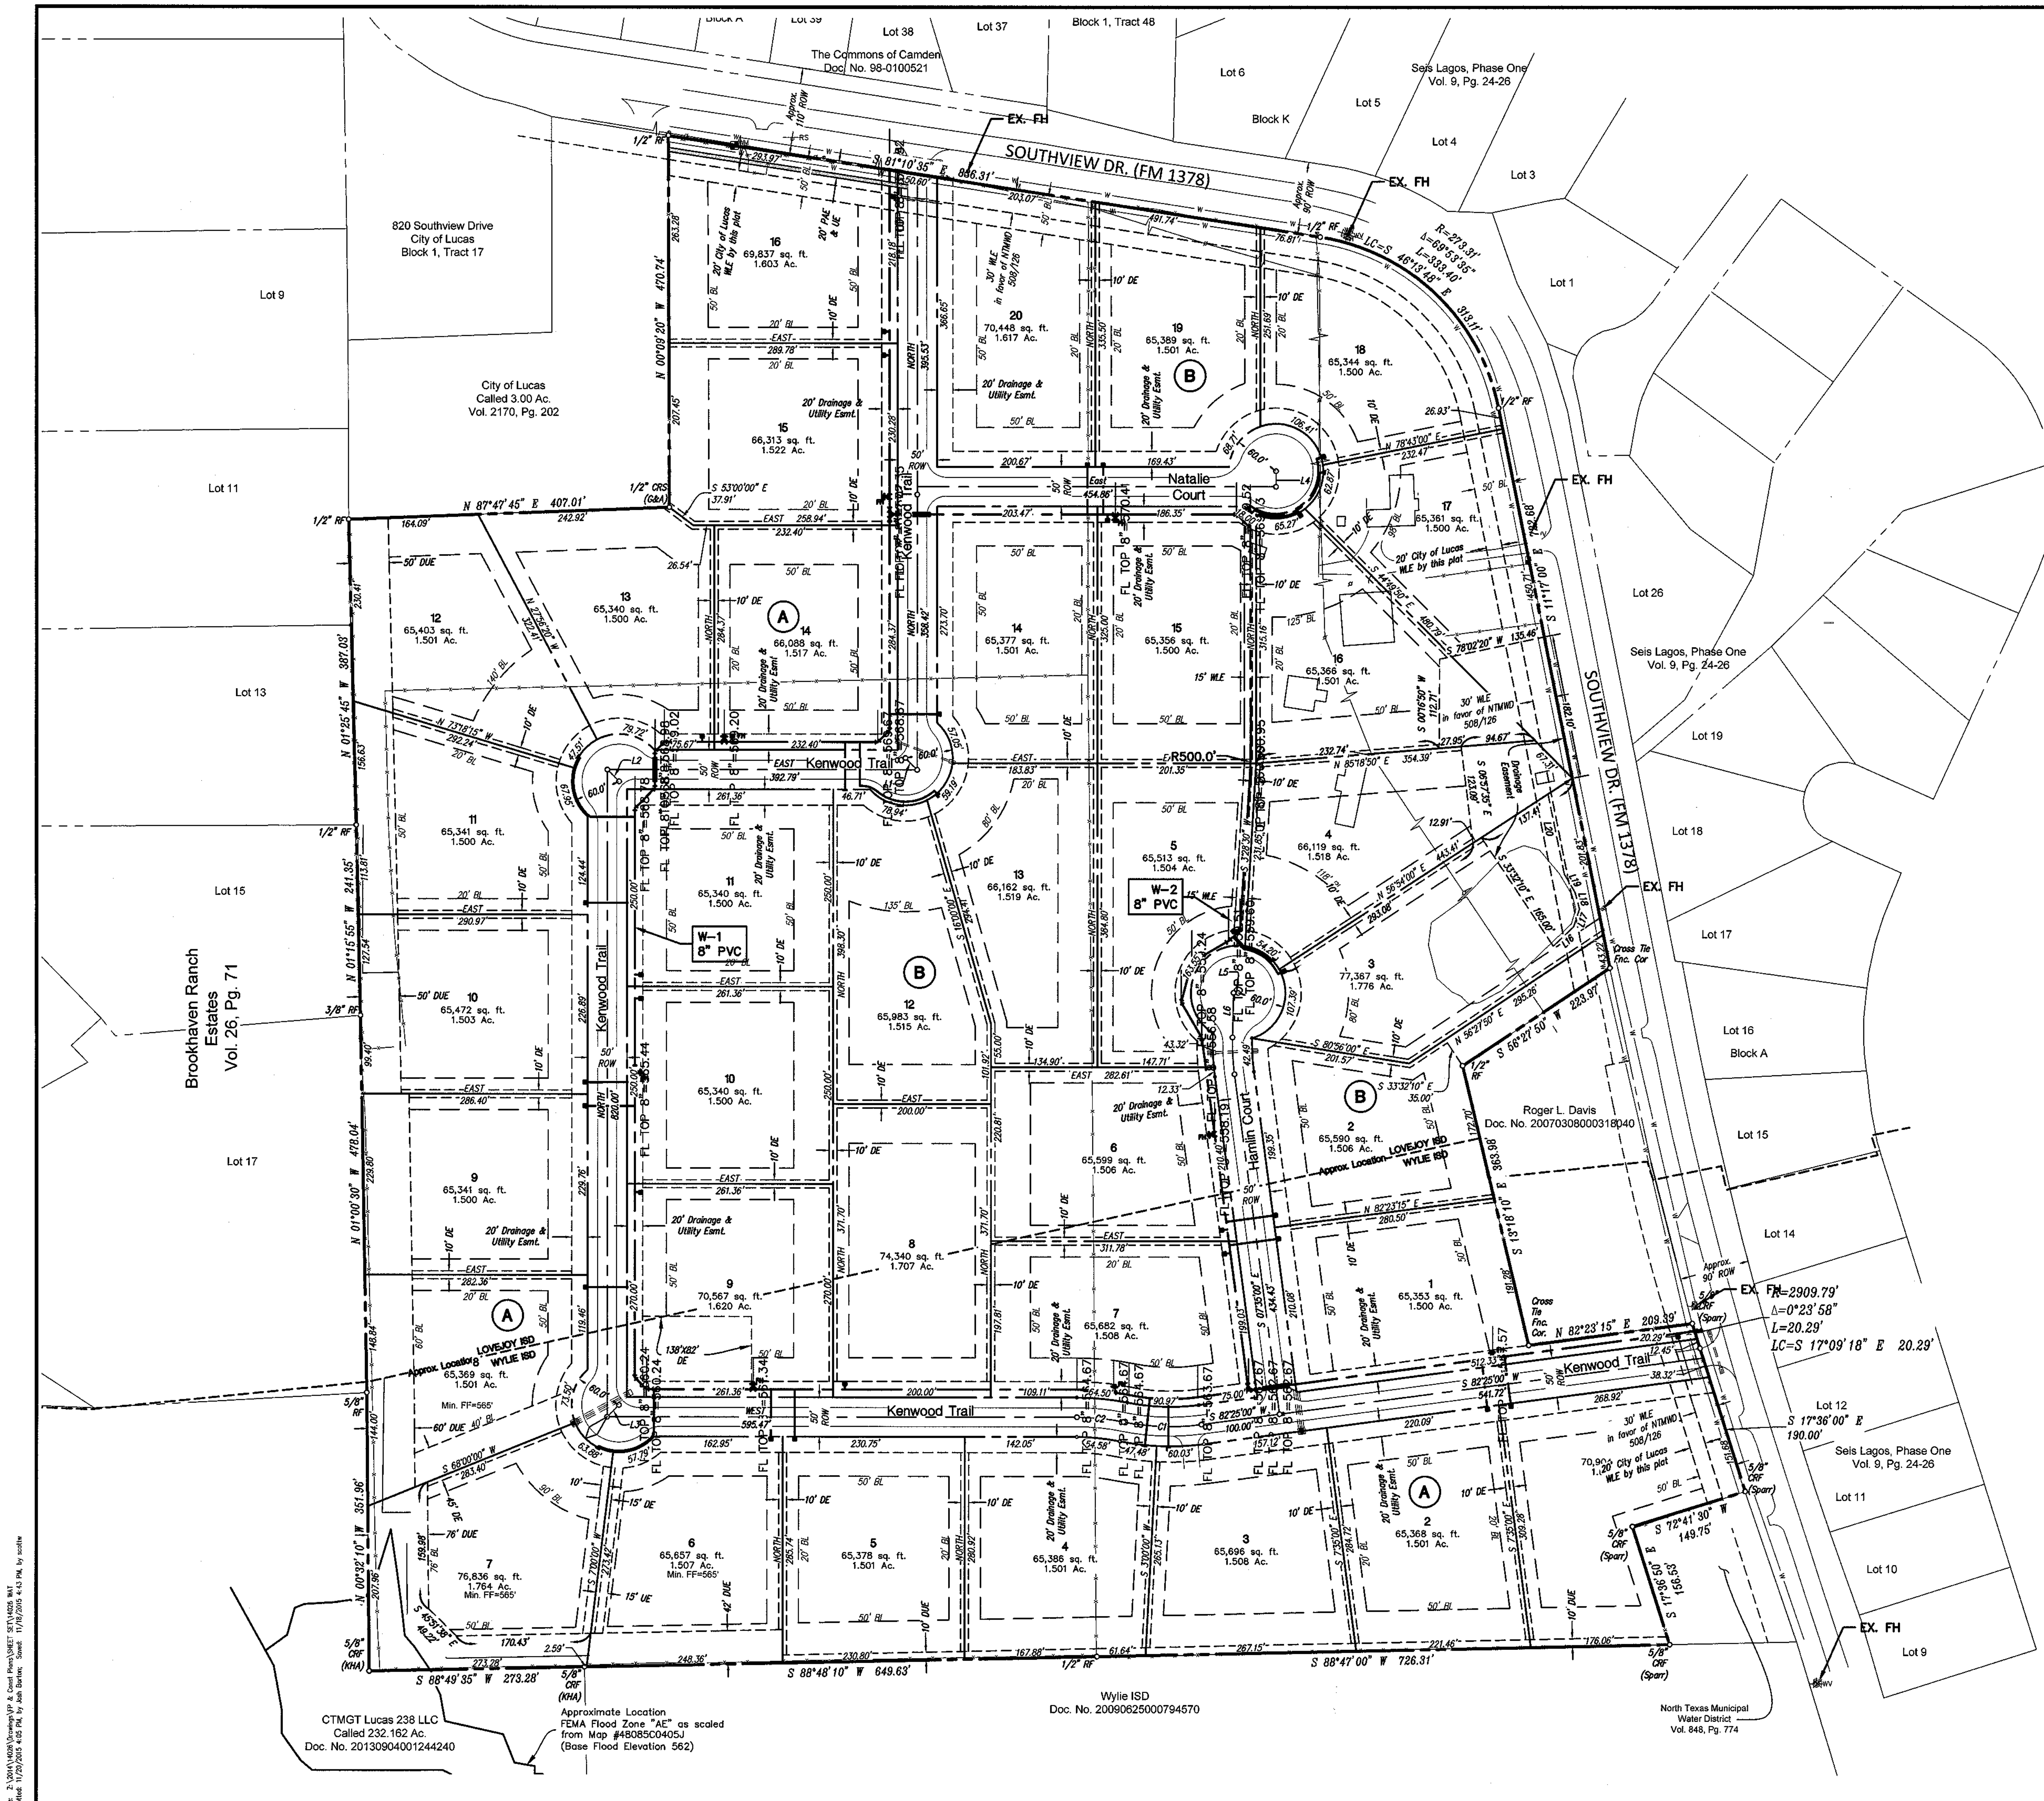

BENCHMARKS:

BM#1 - RM133 - 590.08'
Square cut on east headwall of west of bridge at White Rock Creek (East) and FM 1378. Map# 48085C0455G, Dated January 19th, 1996.

TBM#2 - Square Cut - 569.45'
~981' Southwest from the Northwest corner of subject property on south edge of Brookhaven Dr.
N=7,079,521.1' E=2,557,109.8'

TBM#3 - "X" - 579.96'
~760' Northeast from the Northwest corner of subject property near the intersection of Corner Ln. & Chapel Ct.
N=7,080,175.7' E=2,558,146.1'

TBM#4 - PK Nail - 554.84'
~900' Northeast from the Northeast corner of subject property at the south edge of a cul-de-sac on Alameda Cir.
N=7,079,803.4' E=2,559,558.0'

TBM#5 - "X" - 584.19'
~1040' Southeast from the southeast corner of subject property on a headwall on the north side of the intersection of FM 1378 & Seis Lagos Trail.
N=7,076,368.5' E=2,559,653.8'

LEGEND		
C.R.F.	Capped Rebar Found	Overhead Power Lines
C.R.S.	Capped Rebar Set	Down Guy Wire
C.M.	Control Monument	443 Existing Contours
Mon.	Monument	445 Proposed Contours
BM	Benchmark	Concrete Pavement
FH	Fire Hydrant	Asphalt Pavement
WM	Water Meter	Wood Fence
WV	Water Valve	Chain Link Fence
W/L	Water Line	Wire Fence
ICV	Irrigation Control Valve	Masonry Wall
SSMH	Sanitary Sewer Manhole	Existing Tree
CO	Sanitary Sewer Cleanout	(FL) Flowline
UP	Utility Pole	Centerline of Creek, Swale, or Waterway
LP	Light Pole	Creek, Swale, or Waterway Embankment
TC	Top of Curb	
TP	Top of Pavement	
TW	Top of Wall	
FG	Finished Grade	
U.E.	Utility Easement	
D.E.	Drainage Easement	
B.L.	Building Line	
R.O.W.	Right-of-Way	
D.R.	Deed Records	
P.R.	Pilot Records	

**AS-BUILT
RECORD DRAWING**

THE INFORMATION ON THESE PLANS HAS BEEN REVISED TO REFLECT CHANGES TO PUBLIC IMPROVEMENTS MADE DURING CONSTRUCTION PROVIDED TO ENGINEER BY THE CONTRACTOR. UNLESS OTHERWISE NOTED, THE CONSTRUCTION OF THE PUBLIC IMPROVEMENTS IS IN GENERAL CONFORMANCE WITH THESE PLANS. THE RESPONSIBILITY FOR ACCURACY AND COMPLETENESS BELONGS TO THE CONTRACTOR.

Douglas W. Weaver
G & A Consultants, LLC.
Date: 11/23/2015

- UTILITY NOTES**
1. THE CITY OF LUCAS CONSTRUCTION STANDARDS APPLY WHETHER INDICATED ON THESE PLANS OR NOT.
 2. ALL FIRE HYDRANTS TO BE WATEROUS FIRE HYDRANTS OR EQUAL, APPROVED BY CITY OF LUCAS PUBLIC WORKS DIRECTOR.
 3. ALL FITTINGS TO BE FORD BRASS OR EQUAL, APPROVED BY CITY OF LUCAS PUBLIC WORKS DIRECTOR.
 4. ALL METERS AND SERVICE TAPS SHALL BE 1" POLY OR LARGER.
 5. ALL UTILITY WORK WITHIN TXDOT ROW REQUIRES SEPARATE PERMIT FROM TXDOT.

OWNER/DEVELOPER
GADG LEWIS PARK, LLC
C/O LENART DEVELOPMENT COMPANY, LLC
520 CENTRAL PARKWAY E. SUITE 104
PLANO, TX 75074
Ph. (972) 422-9880
Contact: Steve Lenart



CONSULTANTS, LLC
LAND SURVEYING LANDSCAPE ARCHITECTURE
111 Hillside Drive • Lewisville, TX 76047 • P. 972.438.9712 • F. 972.438.9715
610 Byron Nelson Blvd. Ste. 114 • Round Rock, TX 76766 • P. 866.831.9712 • F. 817.866.4043
TBPES Firm No. 1798

LEWIS PARK ESTATES
Lot 1-16, 1-20, Block A, B
LEWIS PARK ESTATES
60858 Acres
in the
JAMES ANDERSON SURVEY, ABSTRACT NO. 17
CITY OF LUCAS
COLLIN COUNTY, TEXAS

OVERALL WATER PLAN

14026

C21

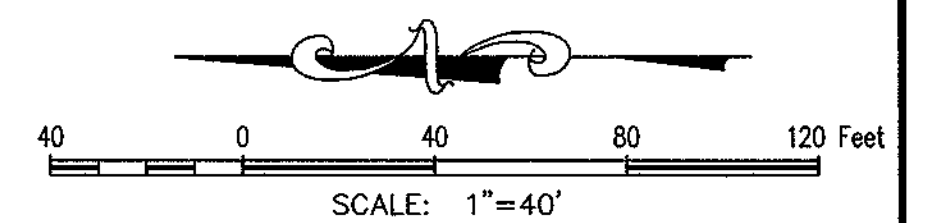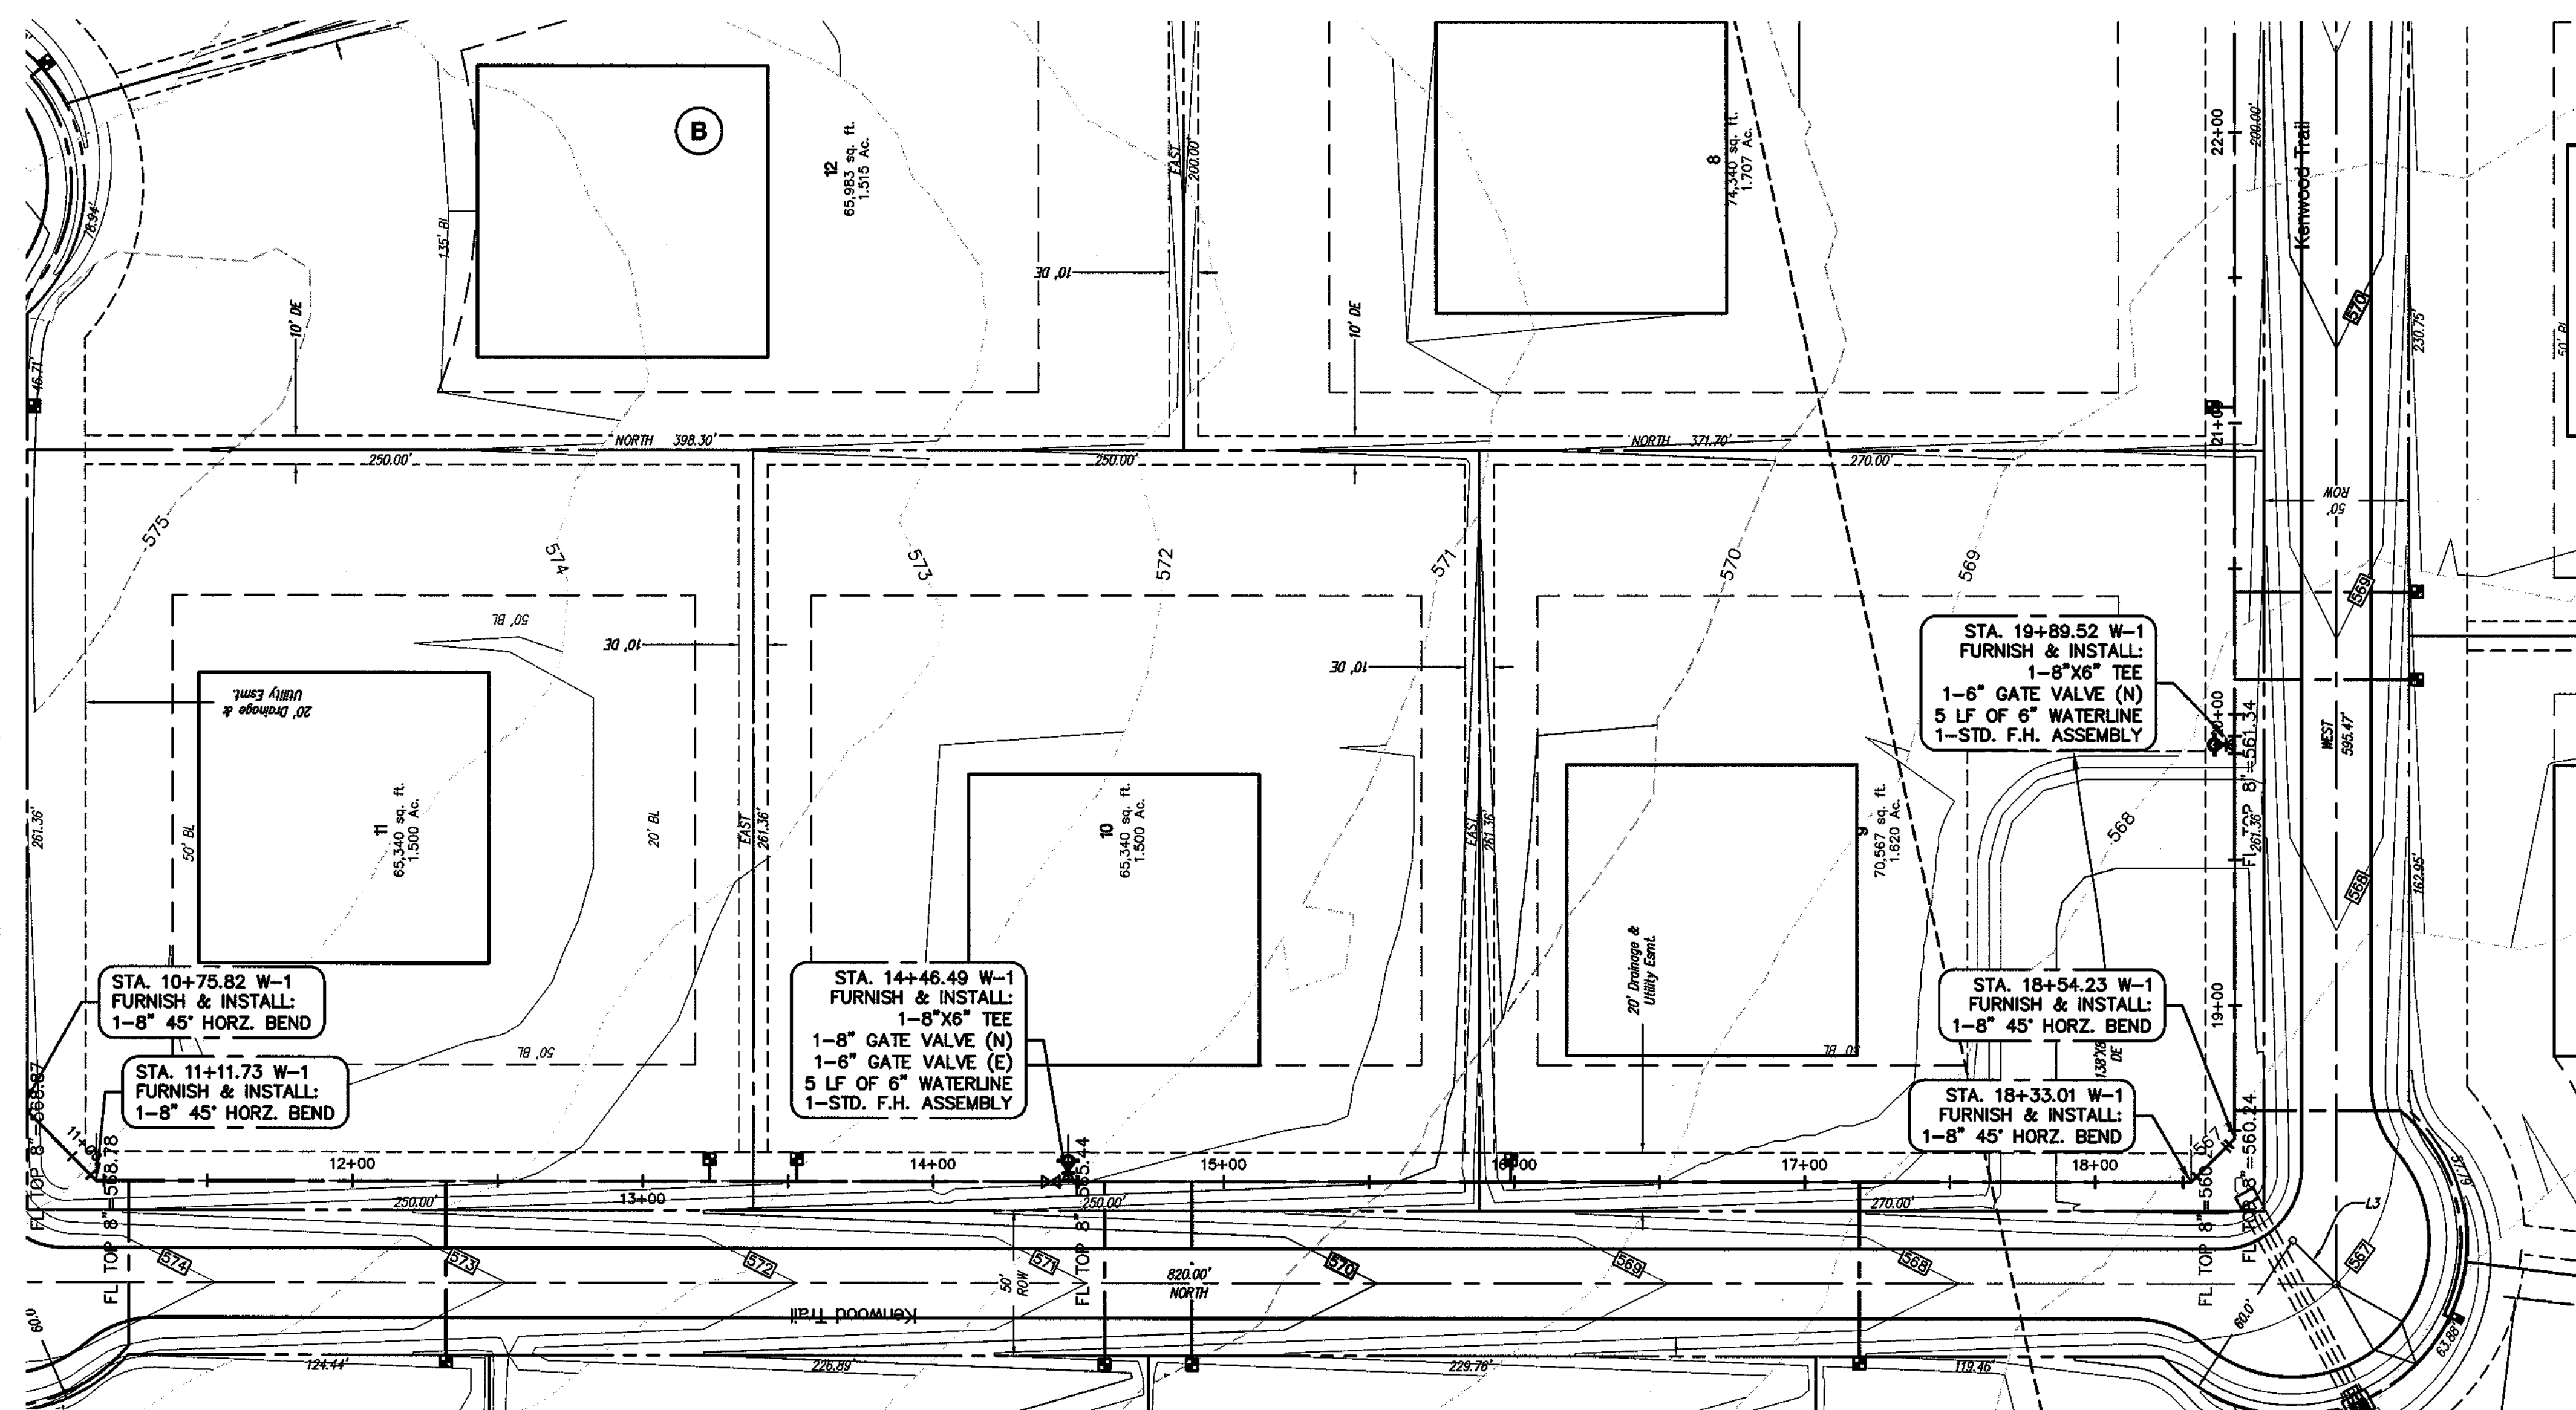

BENCHMARKS:

BM#1 = RM133 - 590.08'
Square cut on east headwall of west of Bridge at White Rock Creek (East) and FM 1378. Map# 48085C0455G, Dated January 19th, 1996.

TM#2 - Square Cut - 569.45'
~981' Southwest from the Northwest corner of subject property on south edge of Brookhaven Dr.
N = 7,079,521.1' E = 557,106.8'

TM#3 = "X" - 579.96'
~760' Southwest from the Northwest corner of subject property near the Intersection of Conner Ln. & Chapel Ct.
N = 7,080,175.7' E = 2,558,146.1

TM#4 = PK Nail - 554.84'
~900' Northeast from the Northwest corner of subject property at the south edge of a cut-de-sac on Alameda Cir.
N = 7,079,803.4' E = 2,559,558.0'

TM#5 = "X" - 584.19'
~1040' Southeast from the southeast corner of subject property on headwall of the north side of the intersection of FM 1378 & Seis Lopea Trail.
N = 7,076,568.5' E = 2,559,653.8'


UTILITY NOTES

1. THE CITY OF LUCAS CONSTRUCTION STANDARDS APPLY WHETHER INDICATED ON THESE PLANS OR NOT.
2. ALL T.C.E.Q. SEPARATION REQUIREMENTS MUST BE MET.
3. THE CONTRACTOR SHALL FIELD VERIFY LOCATIONS AND DEPTHS OF EXISTING UTILITIES PRIOR TO START OF CONSTRUCTION.
4. ALL WATER MAINS SHALL HAVE MINIMUM COVER OF 48 INCHES PER TOWN STANDARDS.
5. ALL UTILITY DEEPS MUST BE INSTALLED BEFORE PAVING CAN BEGIN.
6. FIRE HYDRANT ASSEMBLY INCLUDES 6" LEAD WITH 90° BEND PER TOWN STANDARD CONSTRUCTION DETAILS.
7. ALL FIRE HYDRANTS TO BE WATEROUS FIRE HYDRANTS OR EQUAL, APPROVED BY CITY OF LUCAS.
8. ALL FITTINGS TO BE FORD BRASS OR EQUAL, APPROVED BY CITY OF LUCAS PUBLIC WORKS DIRECTOR.
9. ALL METERS AND SERVICE TAPS SHALL BE 1" POLY OR LARGER.

**AS-BUILT
RECORD DRAWING**

THE INFORMATION ON THESE PLANS HAS BEEN REVISED TO REFLECT CHANGES TO PUBLIC IMPROVEMENTS MADE DURING CONSTRUCTION PROVIDED TO ENGINEER BY THE CONTRACTOR. UNLESS OTHERWISE NOTED, THE CONSTRUCTION OF THE PUBLIC IMPROVEMENTS IS IN GENERAL CONFORMANCE WITH THESE PLANS BASED UPON INFORMATION PROVIDED BY THE CONTRACTOR, AND THE RESPONSIBILITY FOR ACCURACY AND COMPLETENESS BELONGS TO THE CONTRACTOR.

Douglas W. Weaver
G & A Consultants, LLC.
Date: 11/23/2015

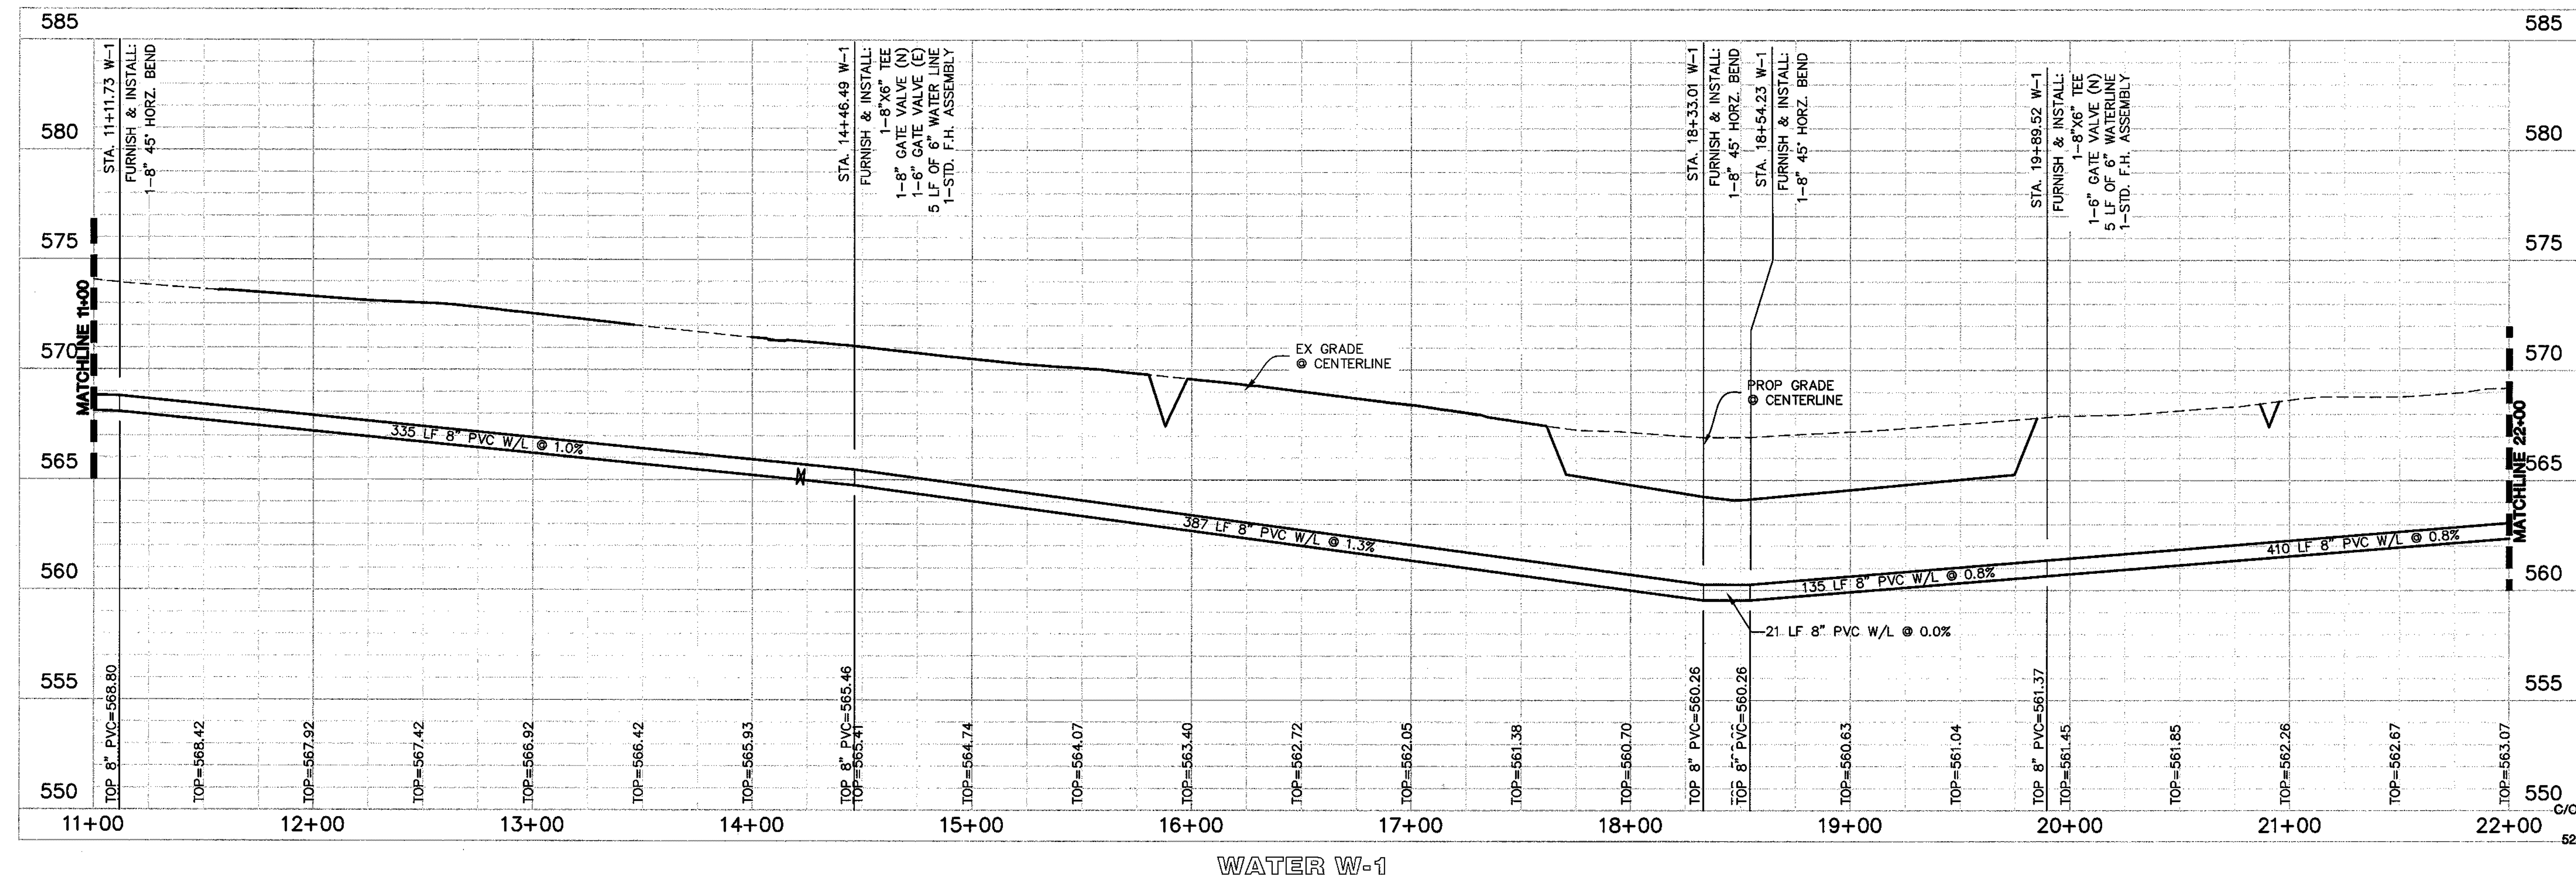


G&A

SITE PLANNING CIVIL ENGINEERING PLANNING
CONSULTANTS, LLC
LAND SURVEYING LANDSCAPE ARCHITECTURE

111 Hillside Drive • Lewisville, TX 75057 • P: 972.498.9719 • F: 972.406.9715
100 Byron Nelson Blvd., Ste 114 • Roundrock, TX 76682 • P: 682.283.1312 • F: 817.890.4043
TEPE Firm No. 1798
TBP18 Firm No. 1004700

LEWIS PARK ESTATES
 Lot 1-16, 1-20, Block A, B
LEWIS PARK ESTATES
 60.858 Acres
 in the
JAMES ANDERSON SURVEY, ABSTRACT NO. 17
CITY OF LUCAS
COLLIN COUNTY, TEXAS

**WATER PLAN & PROFILE
LINE W-1 STA 11+00 TO STA
22+00**

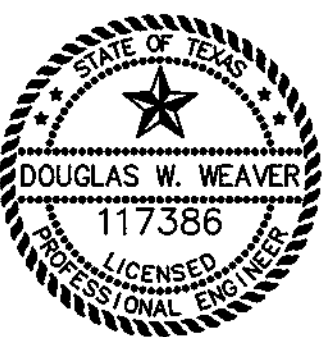


R&A CONSULTANTS, LLC.
TBPE F-1798

Drawn By: AC
Date: 11/07/2014
Scale: H 1"=40'; V 1"=4'
Revisions:

14026

C25

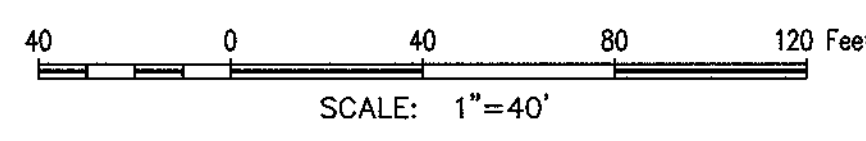

BENCHMARKS:

BM#1 ~ M1333 ~ 590.08'
Square cut on east headwall of west of bridge at White Rock Creek (East) and Mill 1378. Map# 490865C04556, Dated January 19th, 1996.


TBM#2 ~ Square Cut ~ 569.45'
~981' Southwest from the Northwest corner of subject property on south edge of Brookhaven Dr.
N=7,079,521.1' E=2,557,109.8'

TBM#3 ~ "x" ~ 579.96'
~760' Northeast from the Northwest corner of subject property near the intersection of Conner Ln. & Chapel Ct.
N=7,080,175.7' E=2,558,146.1'

TBM#4 ~ "P" Nail ~ 554.84'
~900' Northeast from the Northeast corner of subject property on the south edge of a cul-de-sac on Alameda Cir.
N=7,079,803.4' E=2,559,558.0'


TBM#5 ~ "x" ~ 584.19'
~1040' Southeast from the southeast corner of subject property on a headwall on the north side of the intersection of FM 13 & the Logos Trail.
N=7,076,568.5' E=2,559,853.8'

- ### UTILITY NOTES
1. THE CITY OF LUCAS CONSTRUCTION STANDARDS APPLY WHETHER INDICATED ON THESE PLANS OR NOT.
 2. ALL T.C.E.Q. SEPARATION REQUIREMENTS MUST BE MET.
 3. THE CONTRACTOR SHALL FIELD VERIFY LOCATIONS AND DEPTHS OF EXISTING UTILITIES PRIOR TO START OF CONSTRUCTION.
 4. ALL WATER MAINS SHALL HAVE MINIMUM COVER OF 4 INCHES PER TOWN STANDARDS.
 5. ALL UTILITY ELEVATES MUST BE INSTALLED BEFORE PAVING CAN BEGIN.
 6. FIRE HYDRANT ASSEMBLY INCLUDES 6" LEAD WITH 90° BEND PER TOWN STANDARD CONSTRUCTION DETAILS.
 7. ALL FIRE HYDRANTS TO BE WATEROUS FIRE HYDRANTS OR EQUAL, APPROVED BY CITY OF LUCAS PUBLIC WORKS DIRECTOR.
 8. ALL FITTINGS TO BE FORD BRASS OR EQUAL, APPROVED BY CITY OF LUCAS PUBLIC WORKS DIRECTOR.
 9. ALL METERS AND SERVICE TAPS SHALL BE 1" POLY OR LARGER.

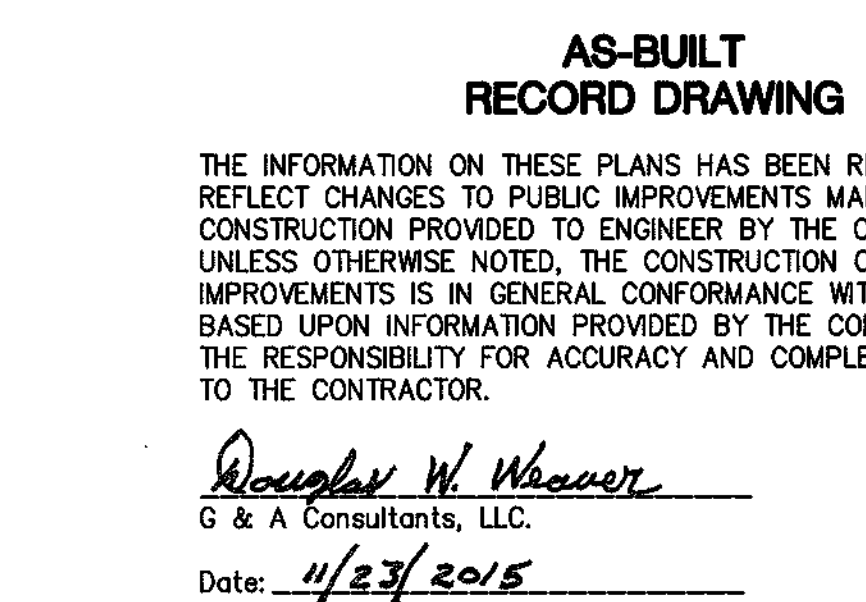


OWNER/DEVELOPER
CADG LEWIS PARK LLC
C/O LENART DEVELOPMENT COMPANY
LLC
520 CENTRAL PARKWAY E. SUITE 104
PLANO, TX 75074
Ph. (972) 422-9880
Contact: Steve Lenart

File: I:\DATA\14026\14026.dwg
Plotted: 11/23/2015 2:08 PM, by John Brown. Sheet: 11/23/2015 2:08 PM, by jpb

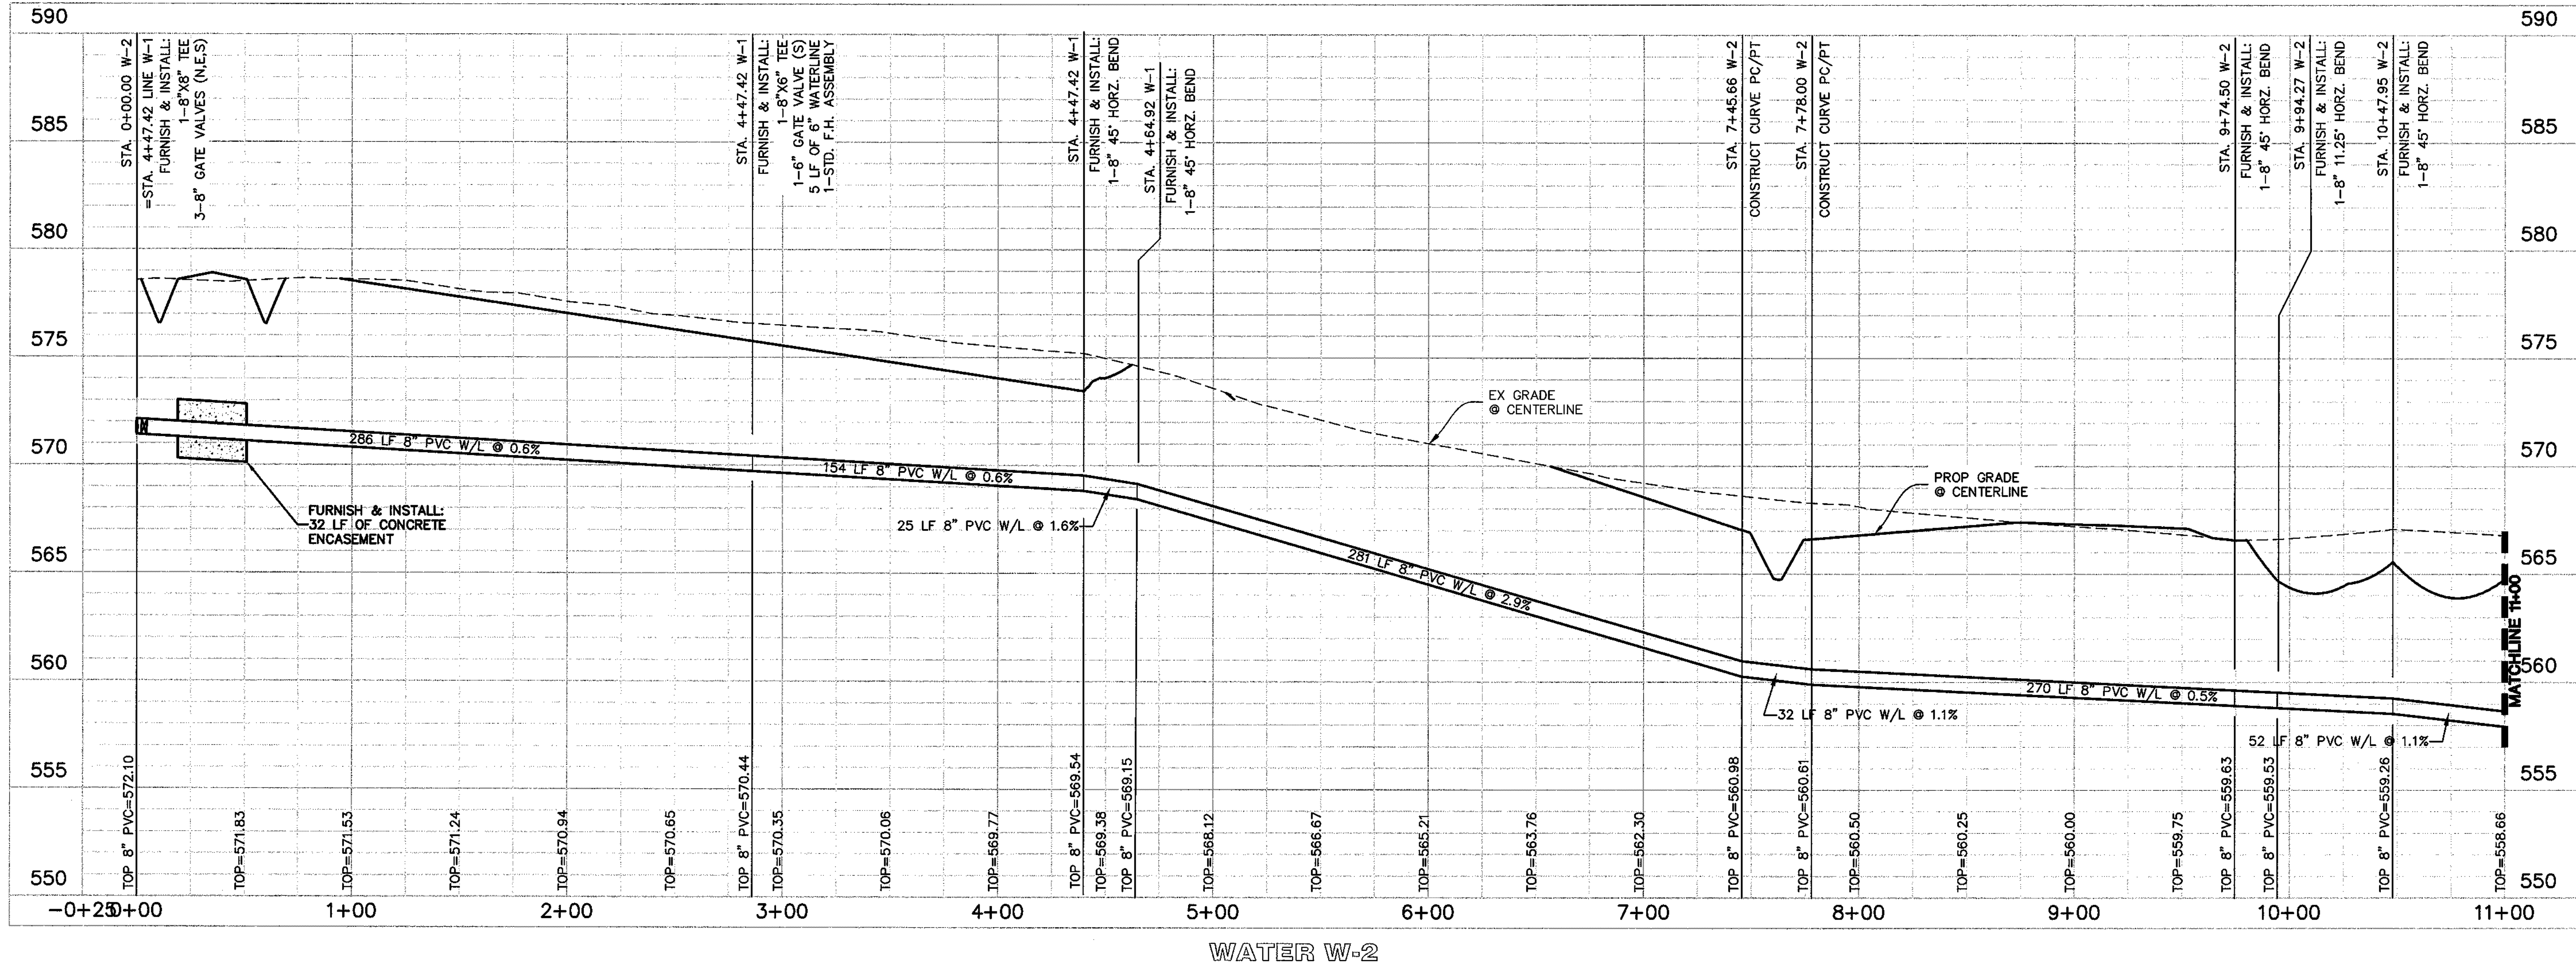

WATER W-2

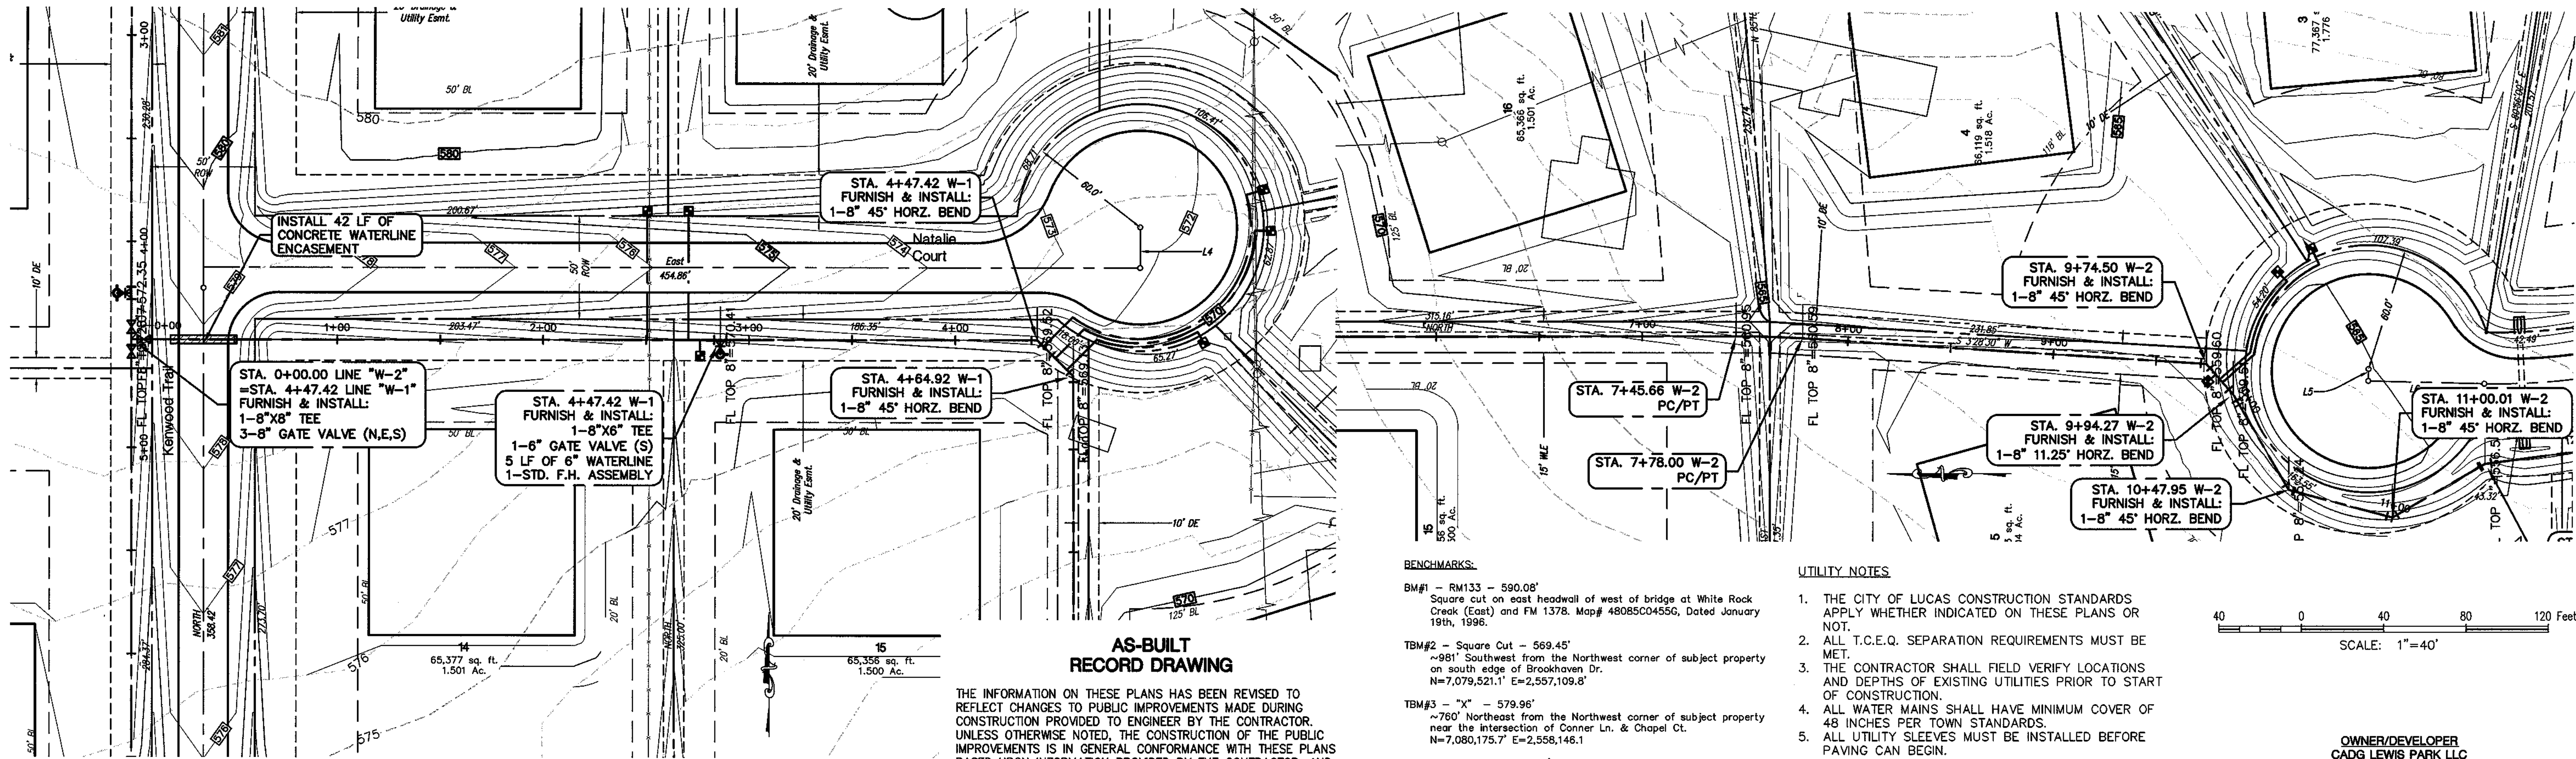

AS-BUILT
RECORD DRAWING

THE INFORMATION ON THESE PLANS HAS BEEN REVISED TO REFLECT CHANGES TO PUBLIC IMPROVEMENTS MADE DURING CONSTRUCTION PROVIDED TO ENGINEER BY THE CONTRACTOR. UNLESS OTHERWISE NOTED, THE CONSTRUCTION OF THE PUBLIC IMPROVEMENTS IS IN GENERAL CONFORMANCE WITH THESE PLANS BASED UPON INFORMATION PROVIDED BY THE CONTRACTOR, AND THE RESPONSIBILITY FOR ACCURACY AND COMPLETENESS BELONGS TO THE CONTRACTOR.

Douglas W. Weaver
G & A Consultants, LLC.

Date: 11/23/2015

BENCHMARKS:


- BM#1 - RM133 - 590.08'
Square cut on east headwall of west of bridge at White Rock Creek (East) and FM 1378. Map# 48085C0455G, Dated January 19th, 1996.
- TBM#2 - Square Cut - 569.45'
~981' Southwest from the Northwest corner of subject property on south edge of Brookhaven Dr.
N=7,079,521.1' E=2,557,109.8'
- TBM#3 - "X" - 579.96'
~760' Northeast from the Northwest corner of subject property near the intersection of Conner Ln. & Chapel Ct.
N=7,080,175.7' E=2,558,148.1'
- TBM#4 - PK Nail - 554.84'
~900' Northeast from the Northeast corner of subject property at the south edge of a cul-de-sac on Alameda Cir.
N=7,079,803.4' E=2,559,558.0'
- TBM#5 - "X" - 584.19'
~1040' Southeast from the southeast corner of subject property on a headwall on the north side of the intersection of FM 1378 & Sala Lopez Trail.
N=7,076,568.5' E=2,559,653.8'

UTILITY NOTES

1. THE CITY OF LUCAS CONSTRUCTION STANDARDS APPLY WHETHER INDICATED ON THESE PLANS OR NOT.
2. ALL T.C.E.Q. SEPARATION REQUIREMENTS MUST BE MET.
3. THE CONTRACTOR SHALL FIELD VERIFY LOCATIONS AND DEPTHS OF EXISTING UTILITIES PRIOR TO START OF CONSTRUCTION.
4. ALL WATER MAINS SHALL HAVE MINIMUM COVER OF 48 INCHES PER TOWN STANDARDS.
5. ALL UTILITY SLEEVES MUST BE INSTALLED BEFORE PAVING CAN BEGIN.
6. FIRE HYDRANT ASSEMBLY INCLUDES 6" LEAD WITH 90° BEND PER TOWN STANDARD CONSTRUCTION DETAILS.
7. ALL FIRE HYDRANTS TO BE WATEROUS FIRE HYDRANTS OR EQUAL, APPROVED BY CITY OF LUCAS PUBLIC WORKS DIRECTOR.
8. ALL FITTINGS TO BE FORD BRASS OR EQUAL, APPROVED BY CITY OF LUCAS PUBLIC WORKS DIRECTOR.
9. ALL METERS AND SERVICE TAPS SHALL BE 1" POLY OR LARGER.

OWNER/DEVELOPER
CADG LEWIS PARK LLC
C/O LENART DEVELOPMENT COMPANY, LLC
520 CENTRAL PARKWAY E. SUITE 104
PLANO, TX 75074
Ph. (972) 422-9880
Contact Steve Lenart

WATER PLAN & PROFILE
LINE W-2 STA 0+00 TO STA 11+00

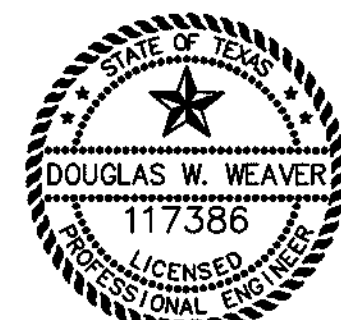

G&A CONSULTANTS, LLC.
TBPE F-1798
Drawn By: AC
Date: 11/07/2014
Scale: H 1"=40'; V 1"=4'
Revisions:

14026

C27

LEWIS PARK ESTATES

Lot 1-16, 1-20, Block A B

LEWIS PARK ESTATES

60.858 Acres
in the
JAMES ANDERSON SURVEY, ABSTRACT NO. 17



CITY OF LUCAS
COLLIN COUNTY, TEXAS

SITE PLANNING CIVIL ENGINEERING PLANNING
CONSULTANTS, LLC
LAND SURVEYING LANDSCAPE ARCHITECTURE



111 Hillside Drive - Lewisville, TX 75057 - P: 972.458.9712 - F: 972.458.9715
610 Bryant Street - Suite 100 - Rockwall, TX 75087 - P: 972.458.9715
TUBE Print No. 1798 TBPLS Firm No. 1007702

LEWIS PARK ESTATES

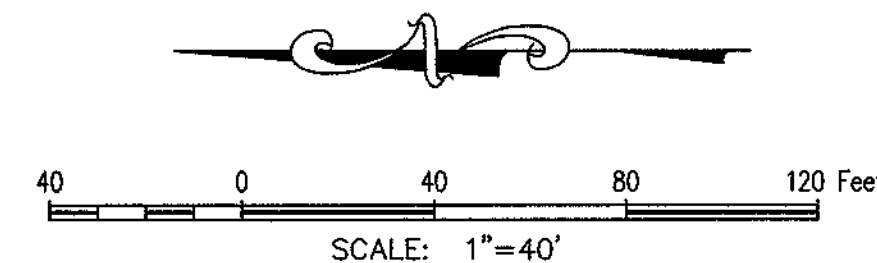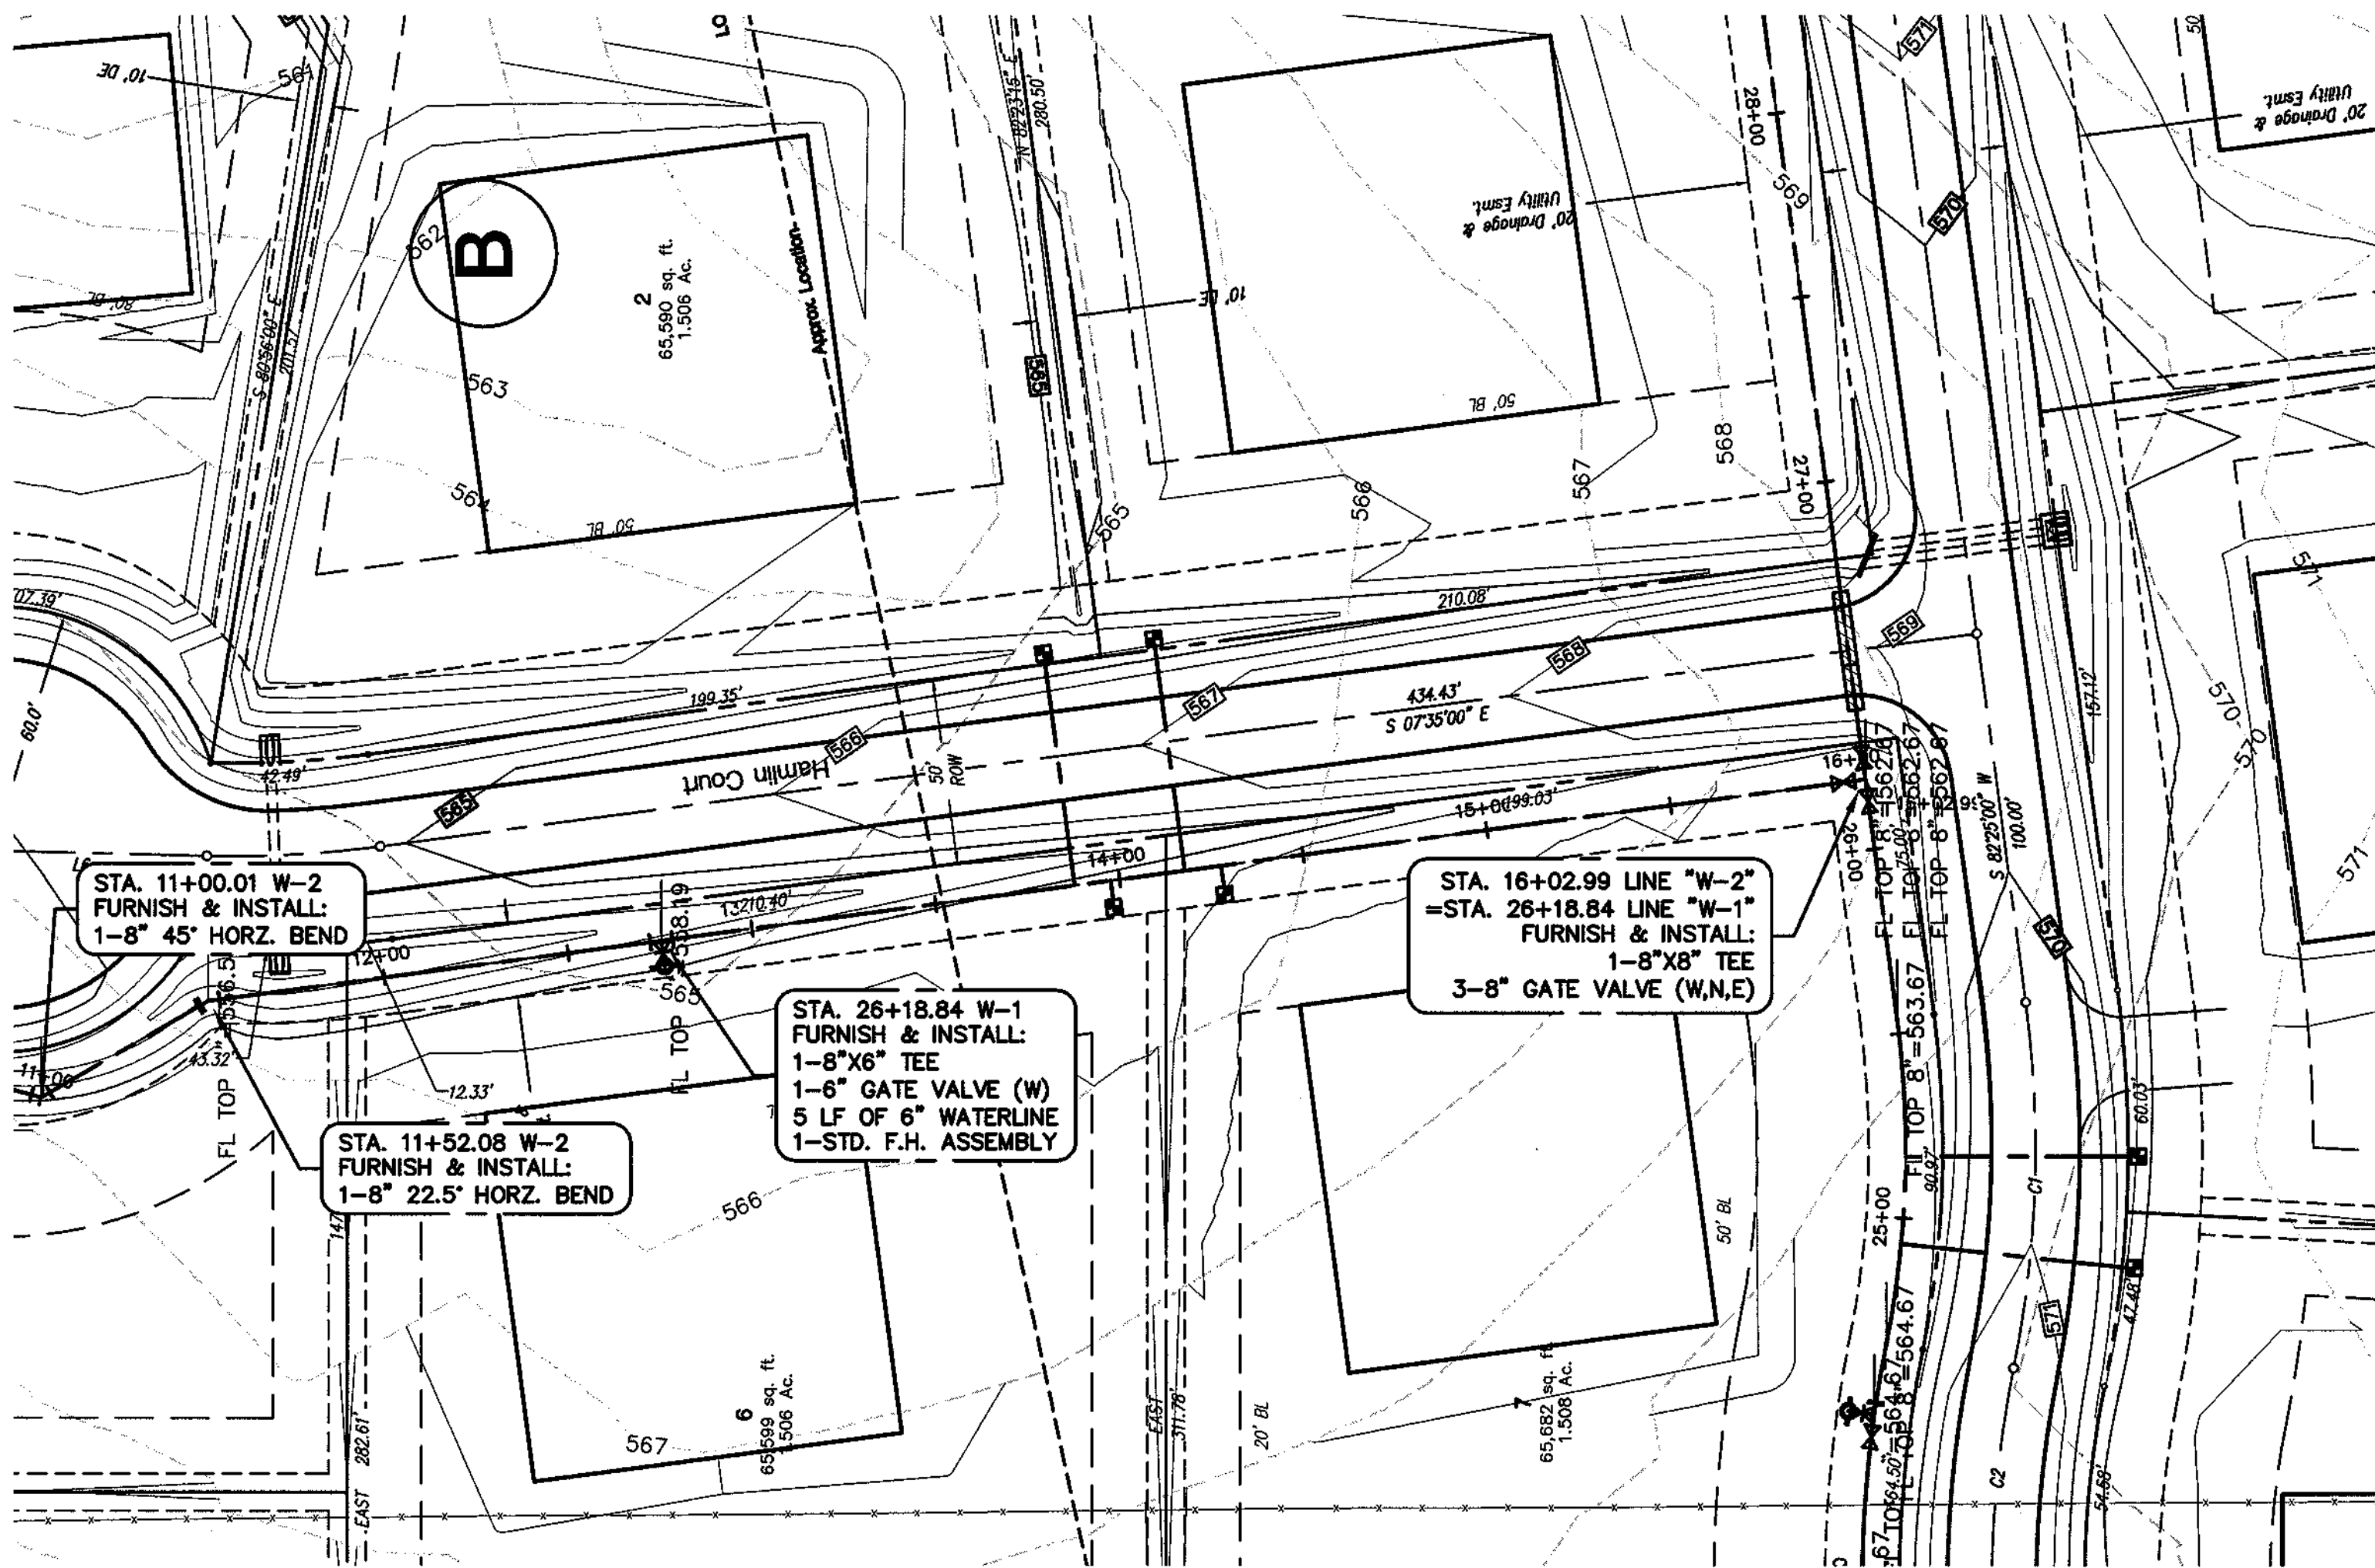


BENCHMARKS:

- BM#1 - RM133 - 590.08'
Square cut on east headwall of west of bridge at White Rock Creek (East) and FM 1378. Map# 48085C04556, Dated January 19th, 1996.
- TBM#2 - Square Cut - 569.45'
~881' Southwest from the Northwest corner of subject property on south edge of Brookhaven Dr.
N=7,079,521.1' E=2,557,109.8'
- TBM#3 - "X" - 579.96'
~760' Northeast from the Northwest corner of subject property near the intersection of Conner Ln. & Chapel Ct.
N=7,080,175.7' E=2,558,146.1'
- TBM#4 - PK Nail - 554.84'
~900' Northeast from the Northeast corner of subject property at the south edge of a cul-de-sac on Alameda Cir.
N=7,079,803.4' E=2,559,558.0'
- TBM#5 - "X" - 584.19'
~1040' Southeast from the southeast corner of subject property on a headwall on the north side of the intersection of FM 1378 & Sels Lagoon Trail.
N=7,076,568.5' E=2,559,653.8'

UTILITY NOTES

1. THE CITY OF LUCAS CONSTRUCTION STANDARDS APPLY WHETHER INDICATED ON THESE PLANS OR NOT.
2. ALL T.C.E.Q. SEPARATION REQUIREMENTS MUST BE MET.
3. THE CONTRACTOR SHALL FIELD VERIFY LOCATIONS AND DEPTHS OF EXISTING UTILITIES PRIOR TO START OF CONSTRUCTION.
4. ALL WATER MAINS SHALL HAVE MINIMUM COVER OF 48 INCHES PER TOWN STANDARDS.
5. ALL UTILITY SLEEVES MUST BE INSTALLED BEFORE PAVING CAN BEGIN.
6. FIRE HYDRANT ASSEMBLY INCLUDES 6" LEAD WITH 90° BEND PER TOWN STANDARD CONSTRUCTION DETAILS.
7. ALL FIRE HYDRANTS TO BE WATEROUS FIRE HYDRANTS OR EQUAL, APPROVED BY CITY OF LUCAS PUBLIC WORKS DIRECTOR.
8. ALL FITTINGS TO BE FORD BRASS OR EQUAL, APPROVED BY CITY OF LUCAS PUBLIC WORKS DIRECTOR.
9. ALL METERS AND SERVICE TAPS SHALL BE 1" POLY OR LARGER.

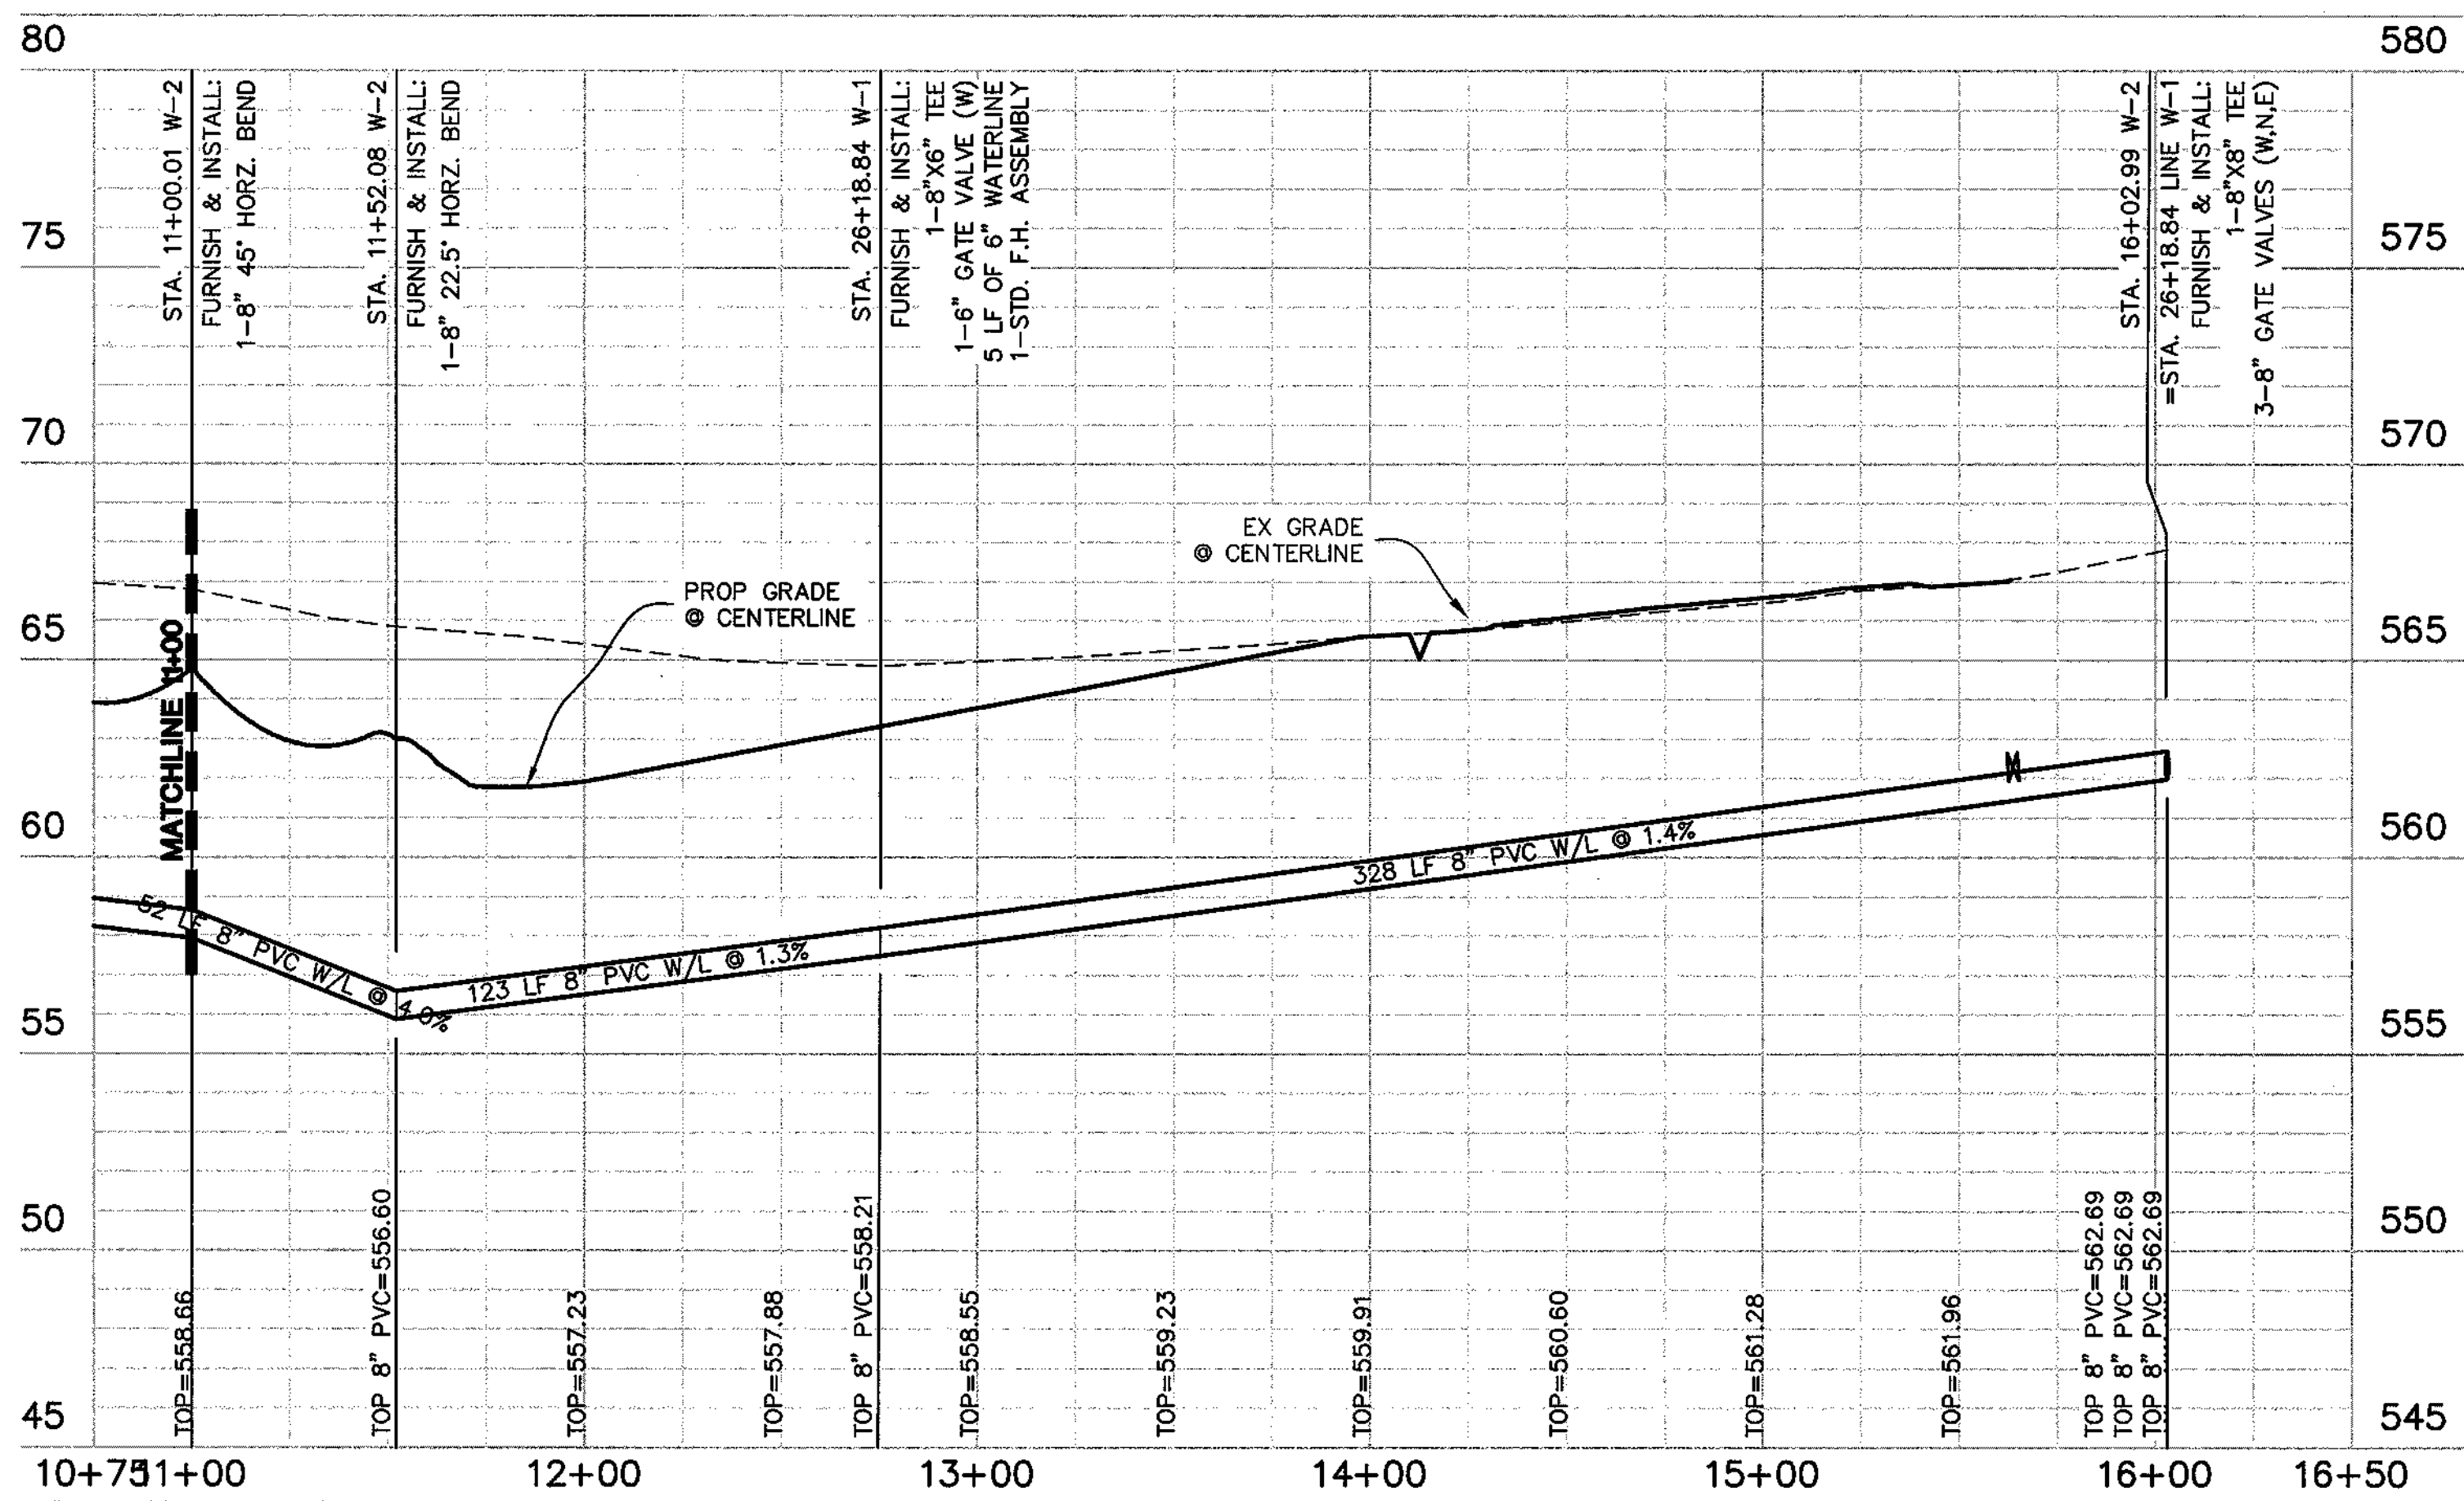


**AS-BUILT
RECORD DRAWING**

THE INFORMATION ON THESE PLANS HAS BEEN REVISED TO REFLECT CHANGES TO PUBLIC IMPROVEMENTS MADE DURING CONSTRUCTION PROVIDED TO ENGINEER BY THE CONTRACTOR. UNLESS OTHERWISE NOTED, THE CONSTRUCTION OF THE PUBLIC IMPROVEMENTS IS IN GENERAL CONFORMANCE WITH THE CITY OF LUCAS AND BASED UPON INFORMATION PROVIDED BY THE CONTRACTOR. THE RESPONSIBILITY FOR ACCURACY AND COMPLETENESS OF THESE PLANS IS LONG TO THE CONTRACTOR.

Douglas W. Weaver
G & A Consultants, LLC.

Date: 11/23/2015

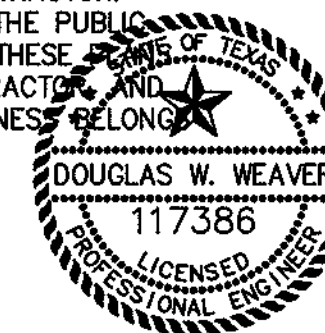

G&A CONSULTANTS, LLC.
TBPE F-1798

Drawn By: AC
Date: 11/07/2014
Scale: H 1"=40'; V 1"=4'
Revisions:

OWNER/DEVELOPER
CADG LEWIS PARK LLC
C/O LENART DEVELOPMENT COMPANY,
LLC
520 CENTRAL PARKWAY E. SUITE 104
PLANO, TX 75074
Ph (972) 422-9880
Fax Value
Contact: Steve Lenart

14026

C28

LEWIS PARK ESTATES





Lot 1-16, 1-20, Block A, B
LEWIS PARK ESTATES
60.858 Acres
in the
JAMES ANDERSON SURVEY, ABSTRACT NO. 17
CITY OF LUCAS
COLLIN COUNTY, TEXAS

**WATER PLAN & PROFILE
LINE W-2 STA 11+00 TO STA
15+69.48**

SITE PLANNING CIVIL ENGINEERING PLATTING
CONSULTANTS, LLC
LAND SURVEYING LANDSCAPE ARCHITECTURE
111 Hillside Drive • Lewisville, TX 76047 • P: 972.486.9710 • F: 972.486.9715
610 Byron Nelson Blvd, Ste 114 • Rowland, TX 76262 • P: 817.880.5712 • F: 817.880.4443
TBPE Firm No. 1798

LEWIS PARK ESTATES

File: E:\0000\Drawings\14026\14026-SETUP.DWG Date: 11/17/2015 10:23 AM by: [redacted]

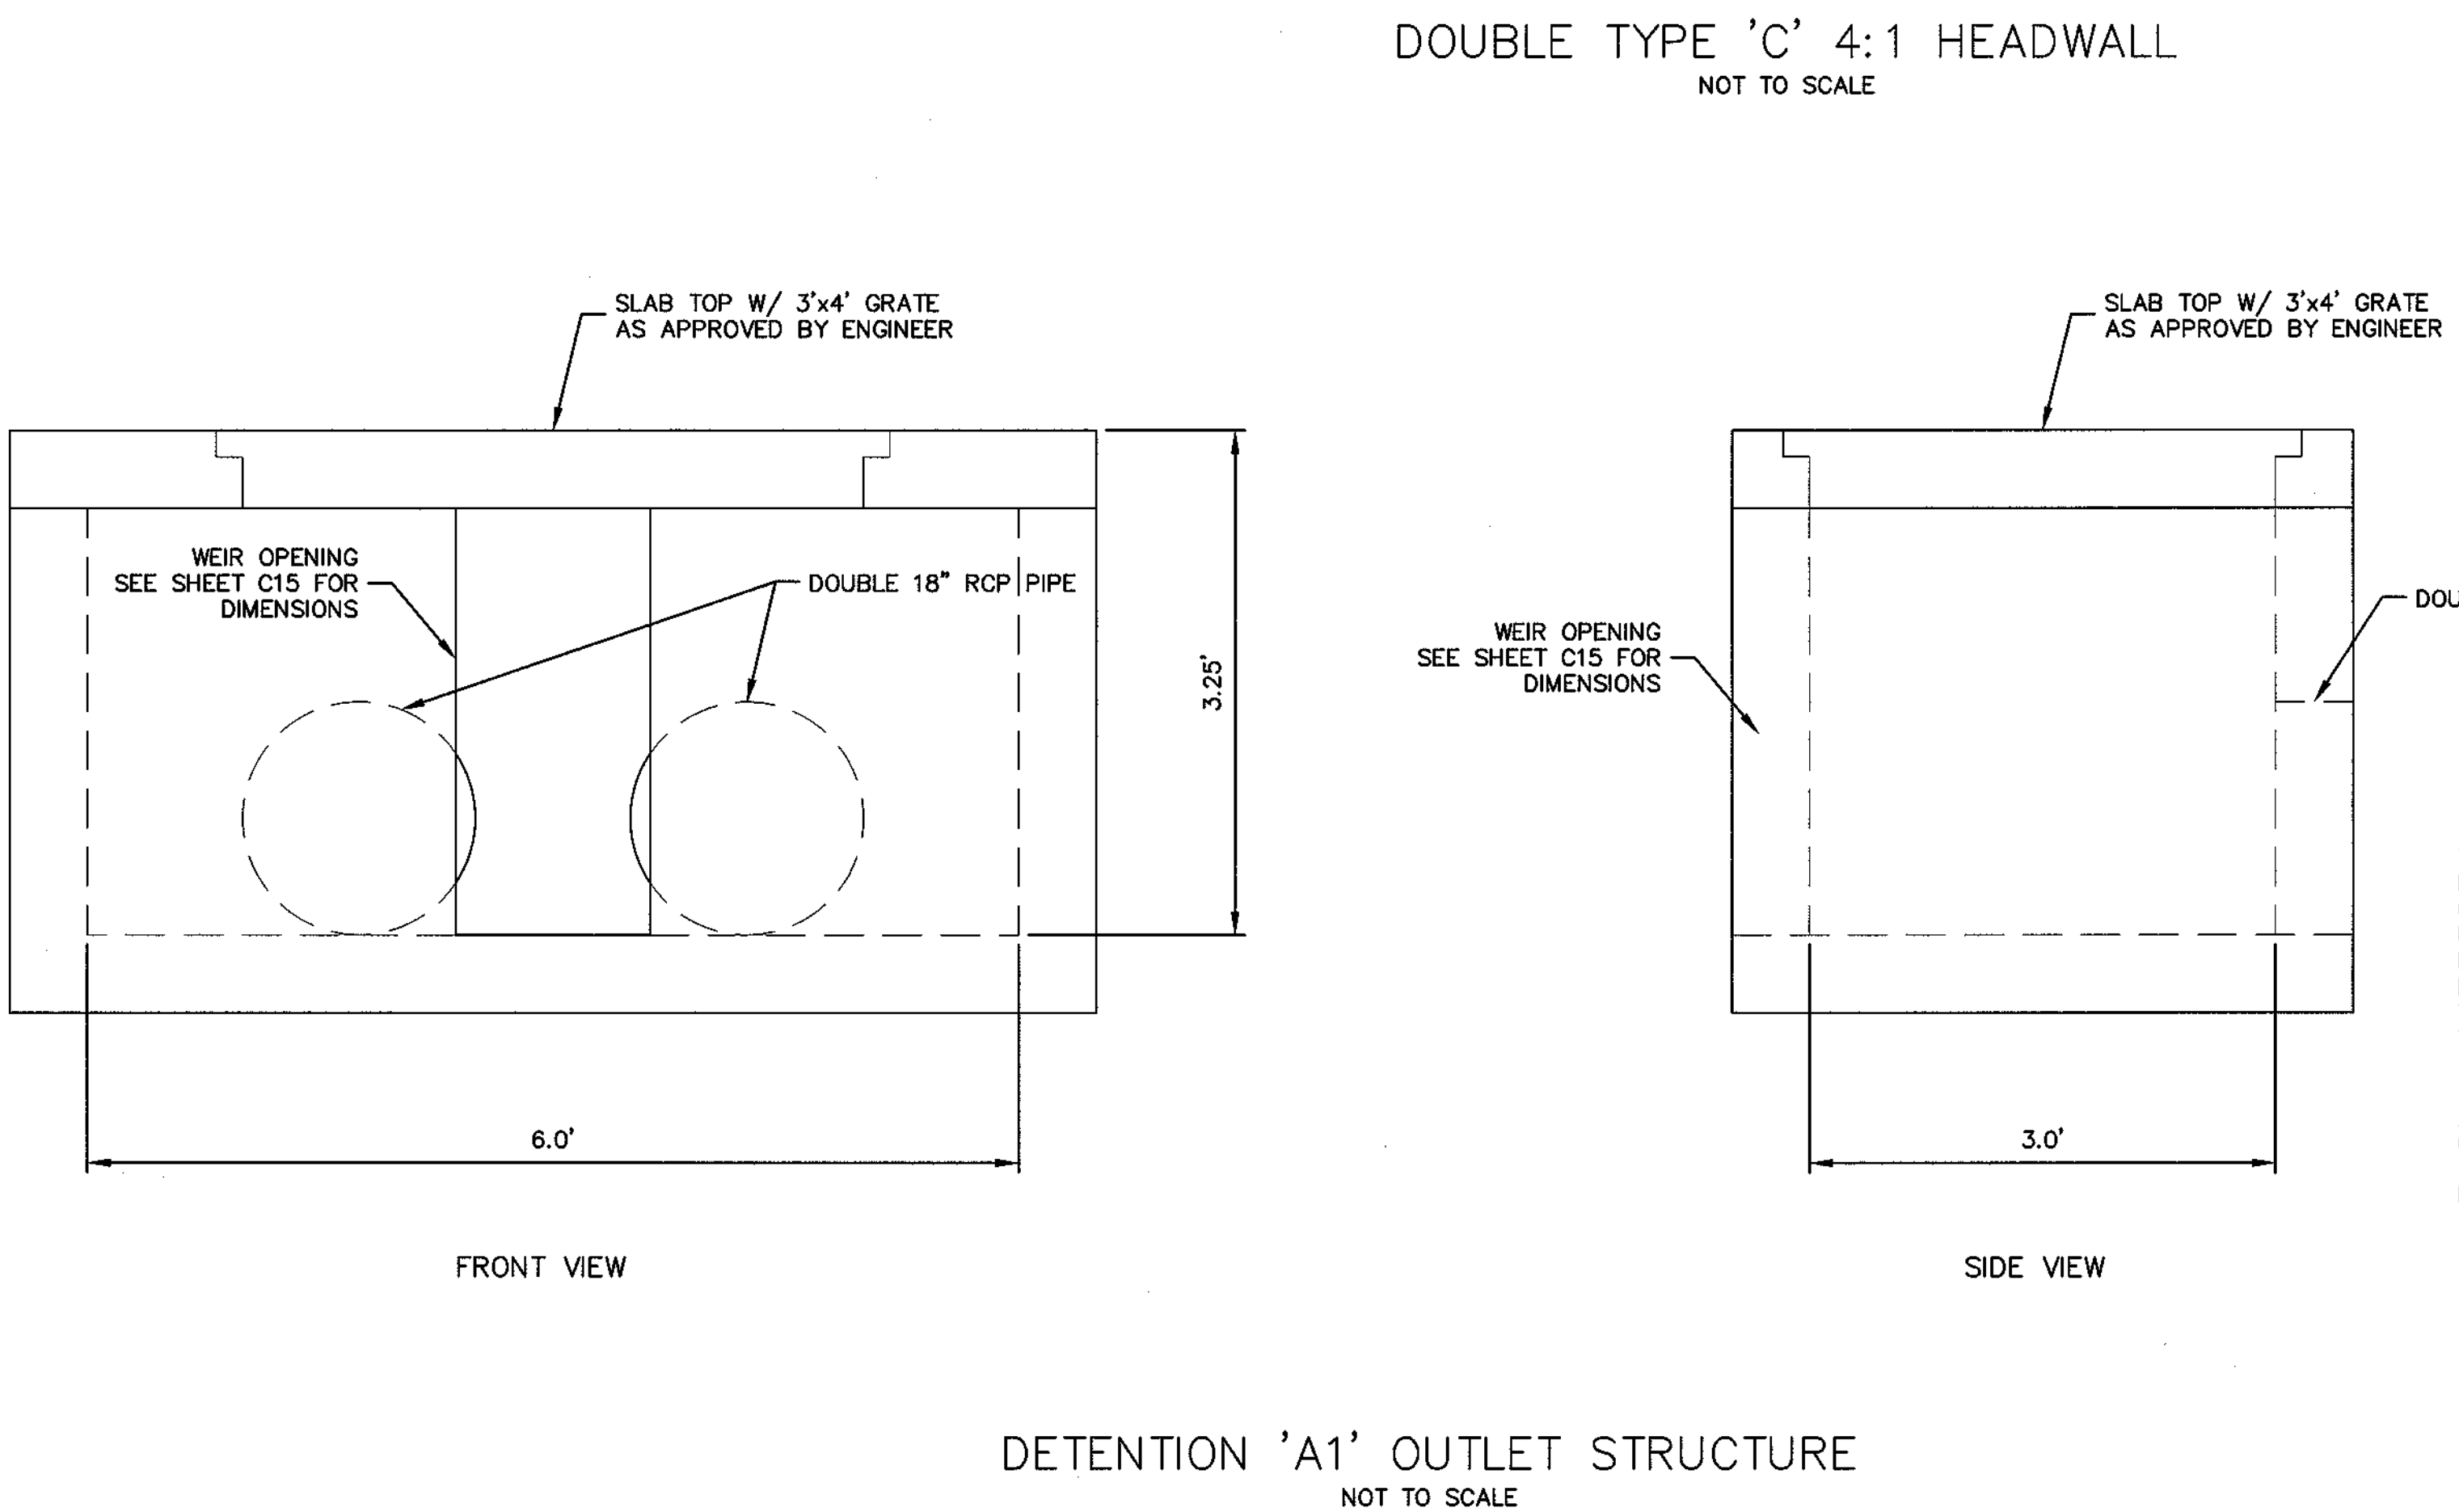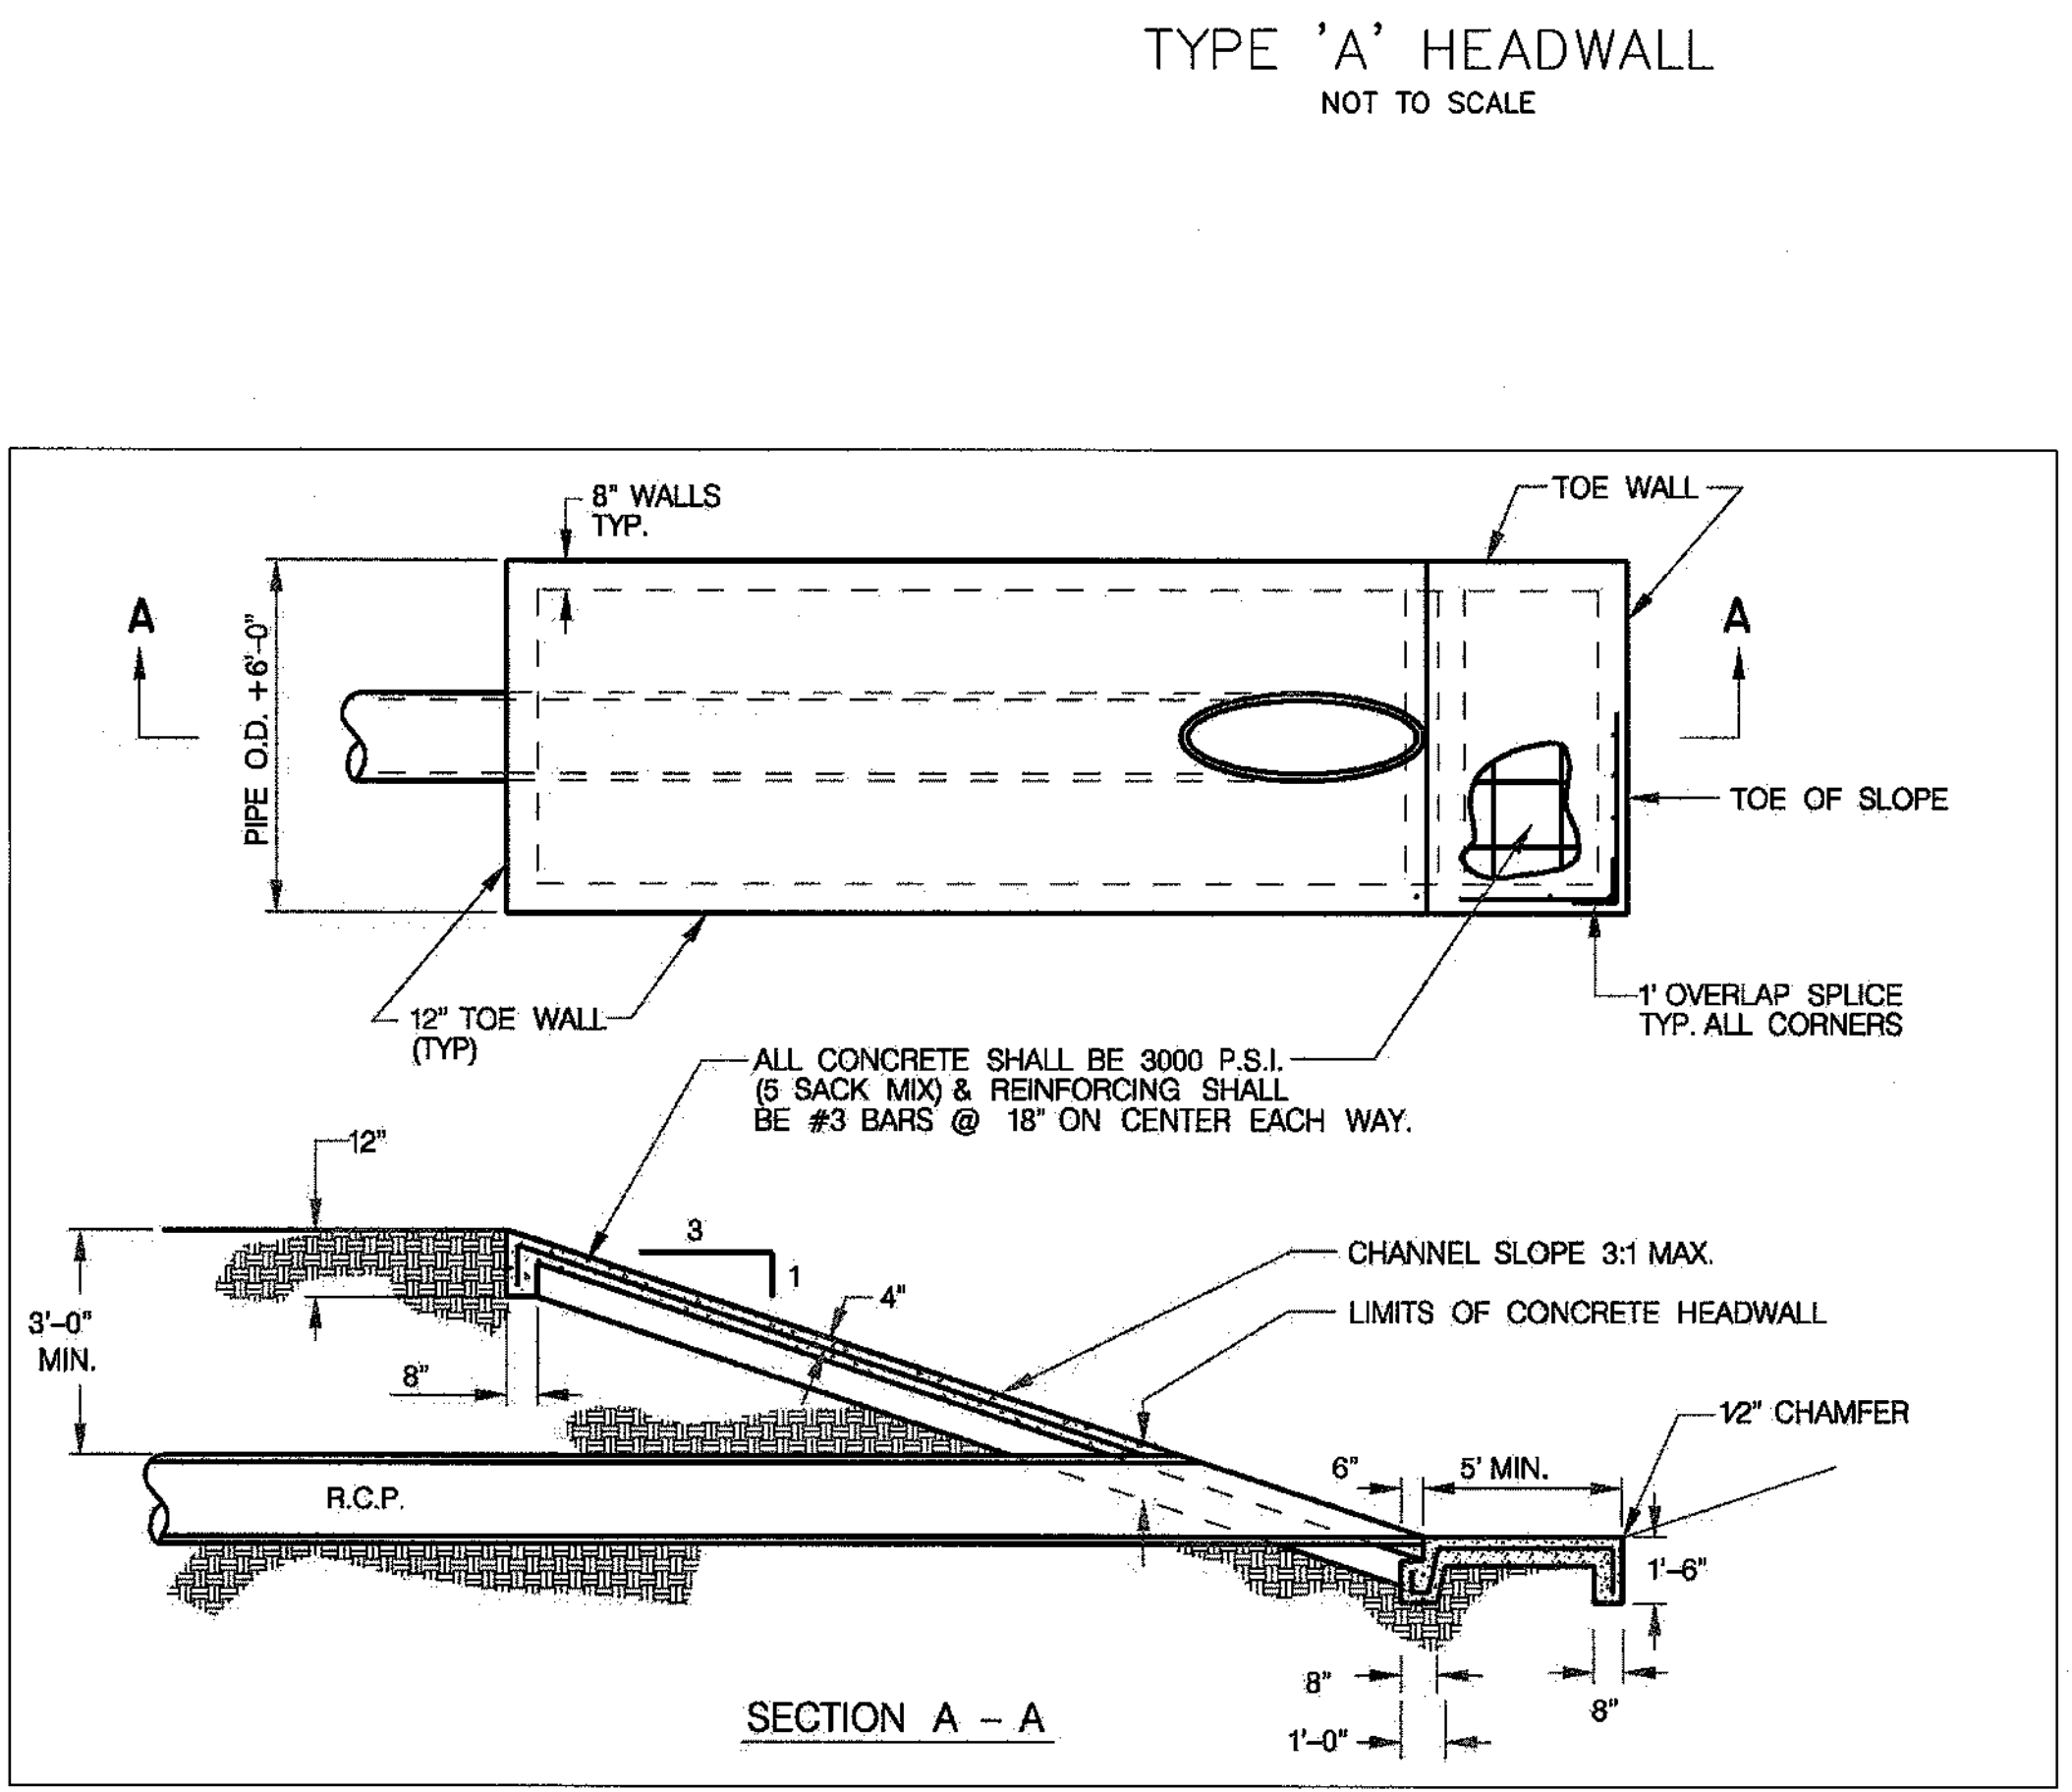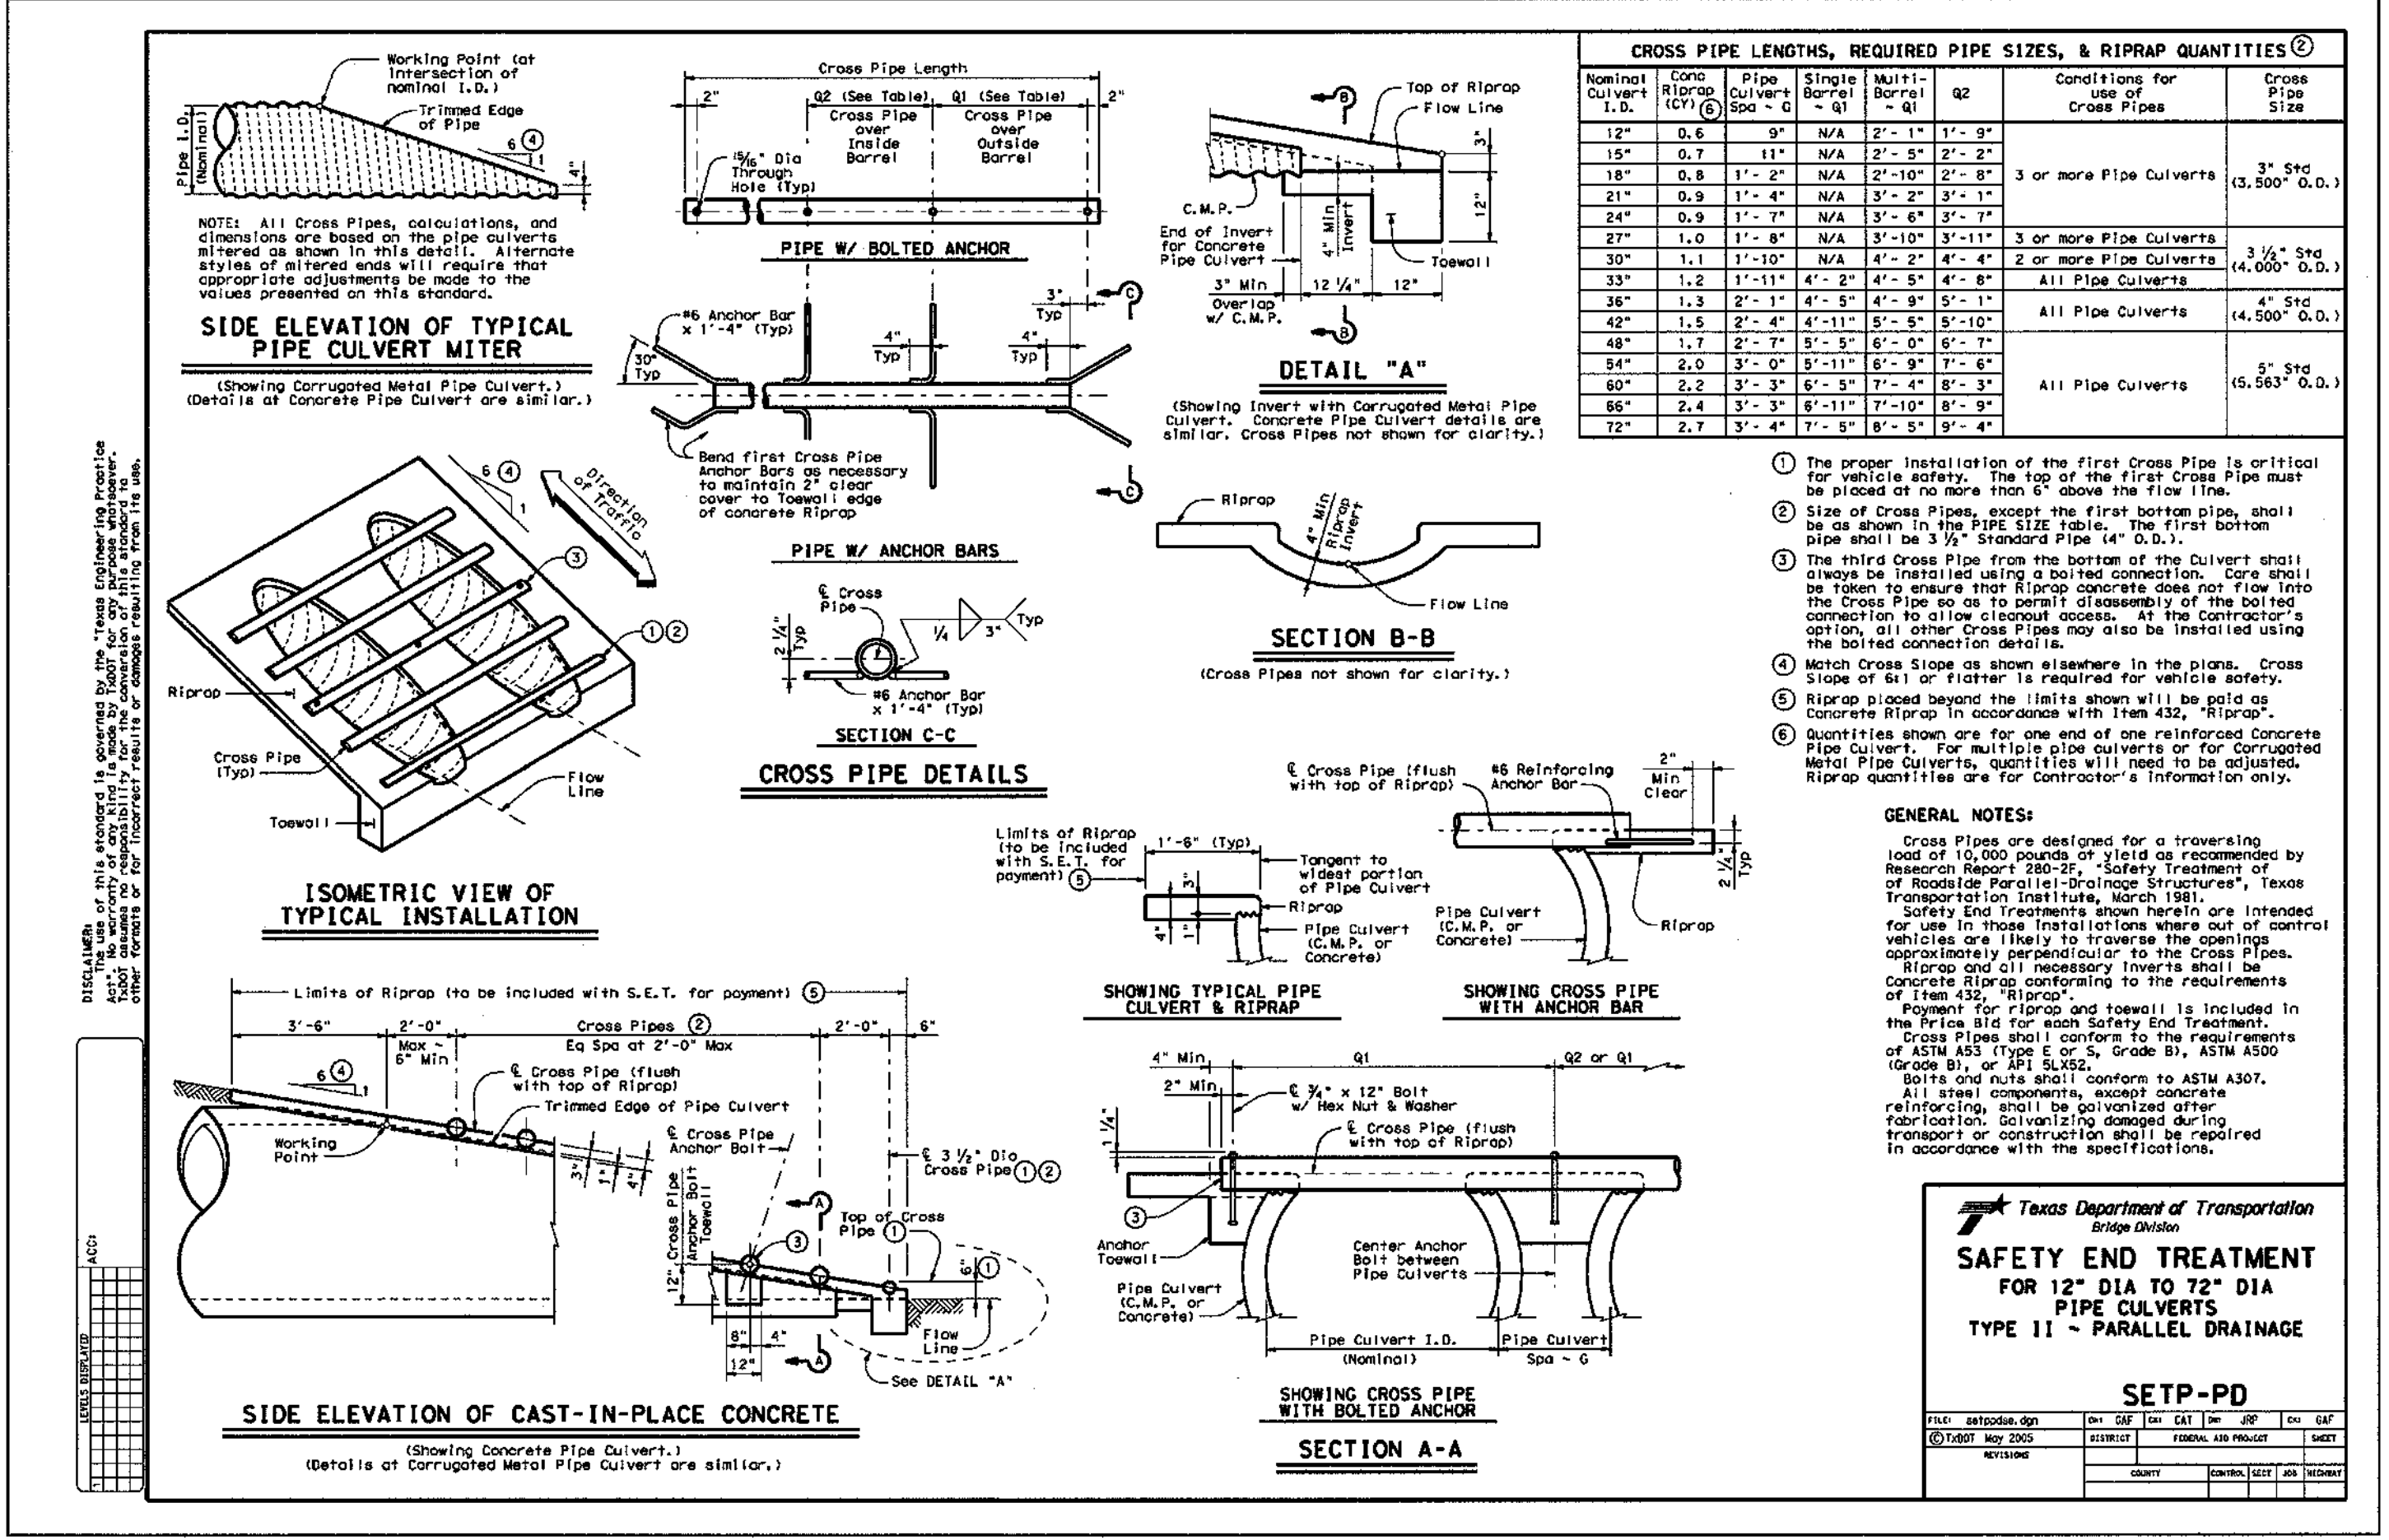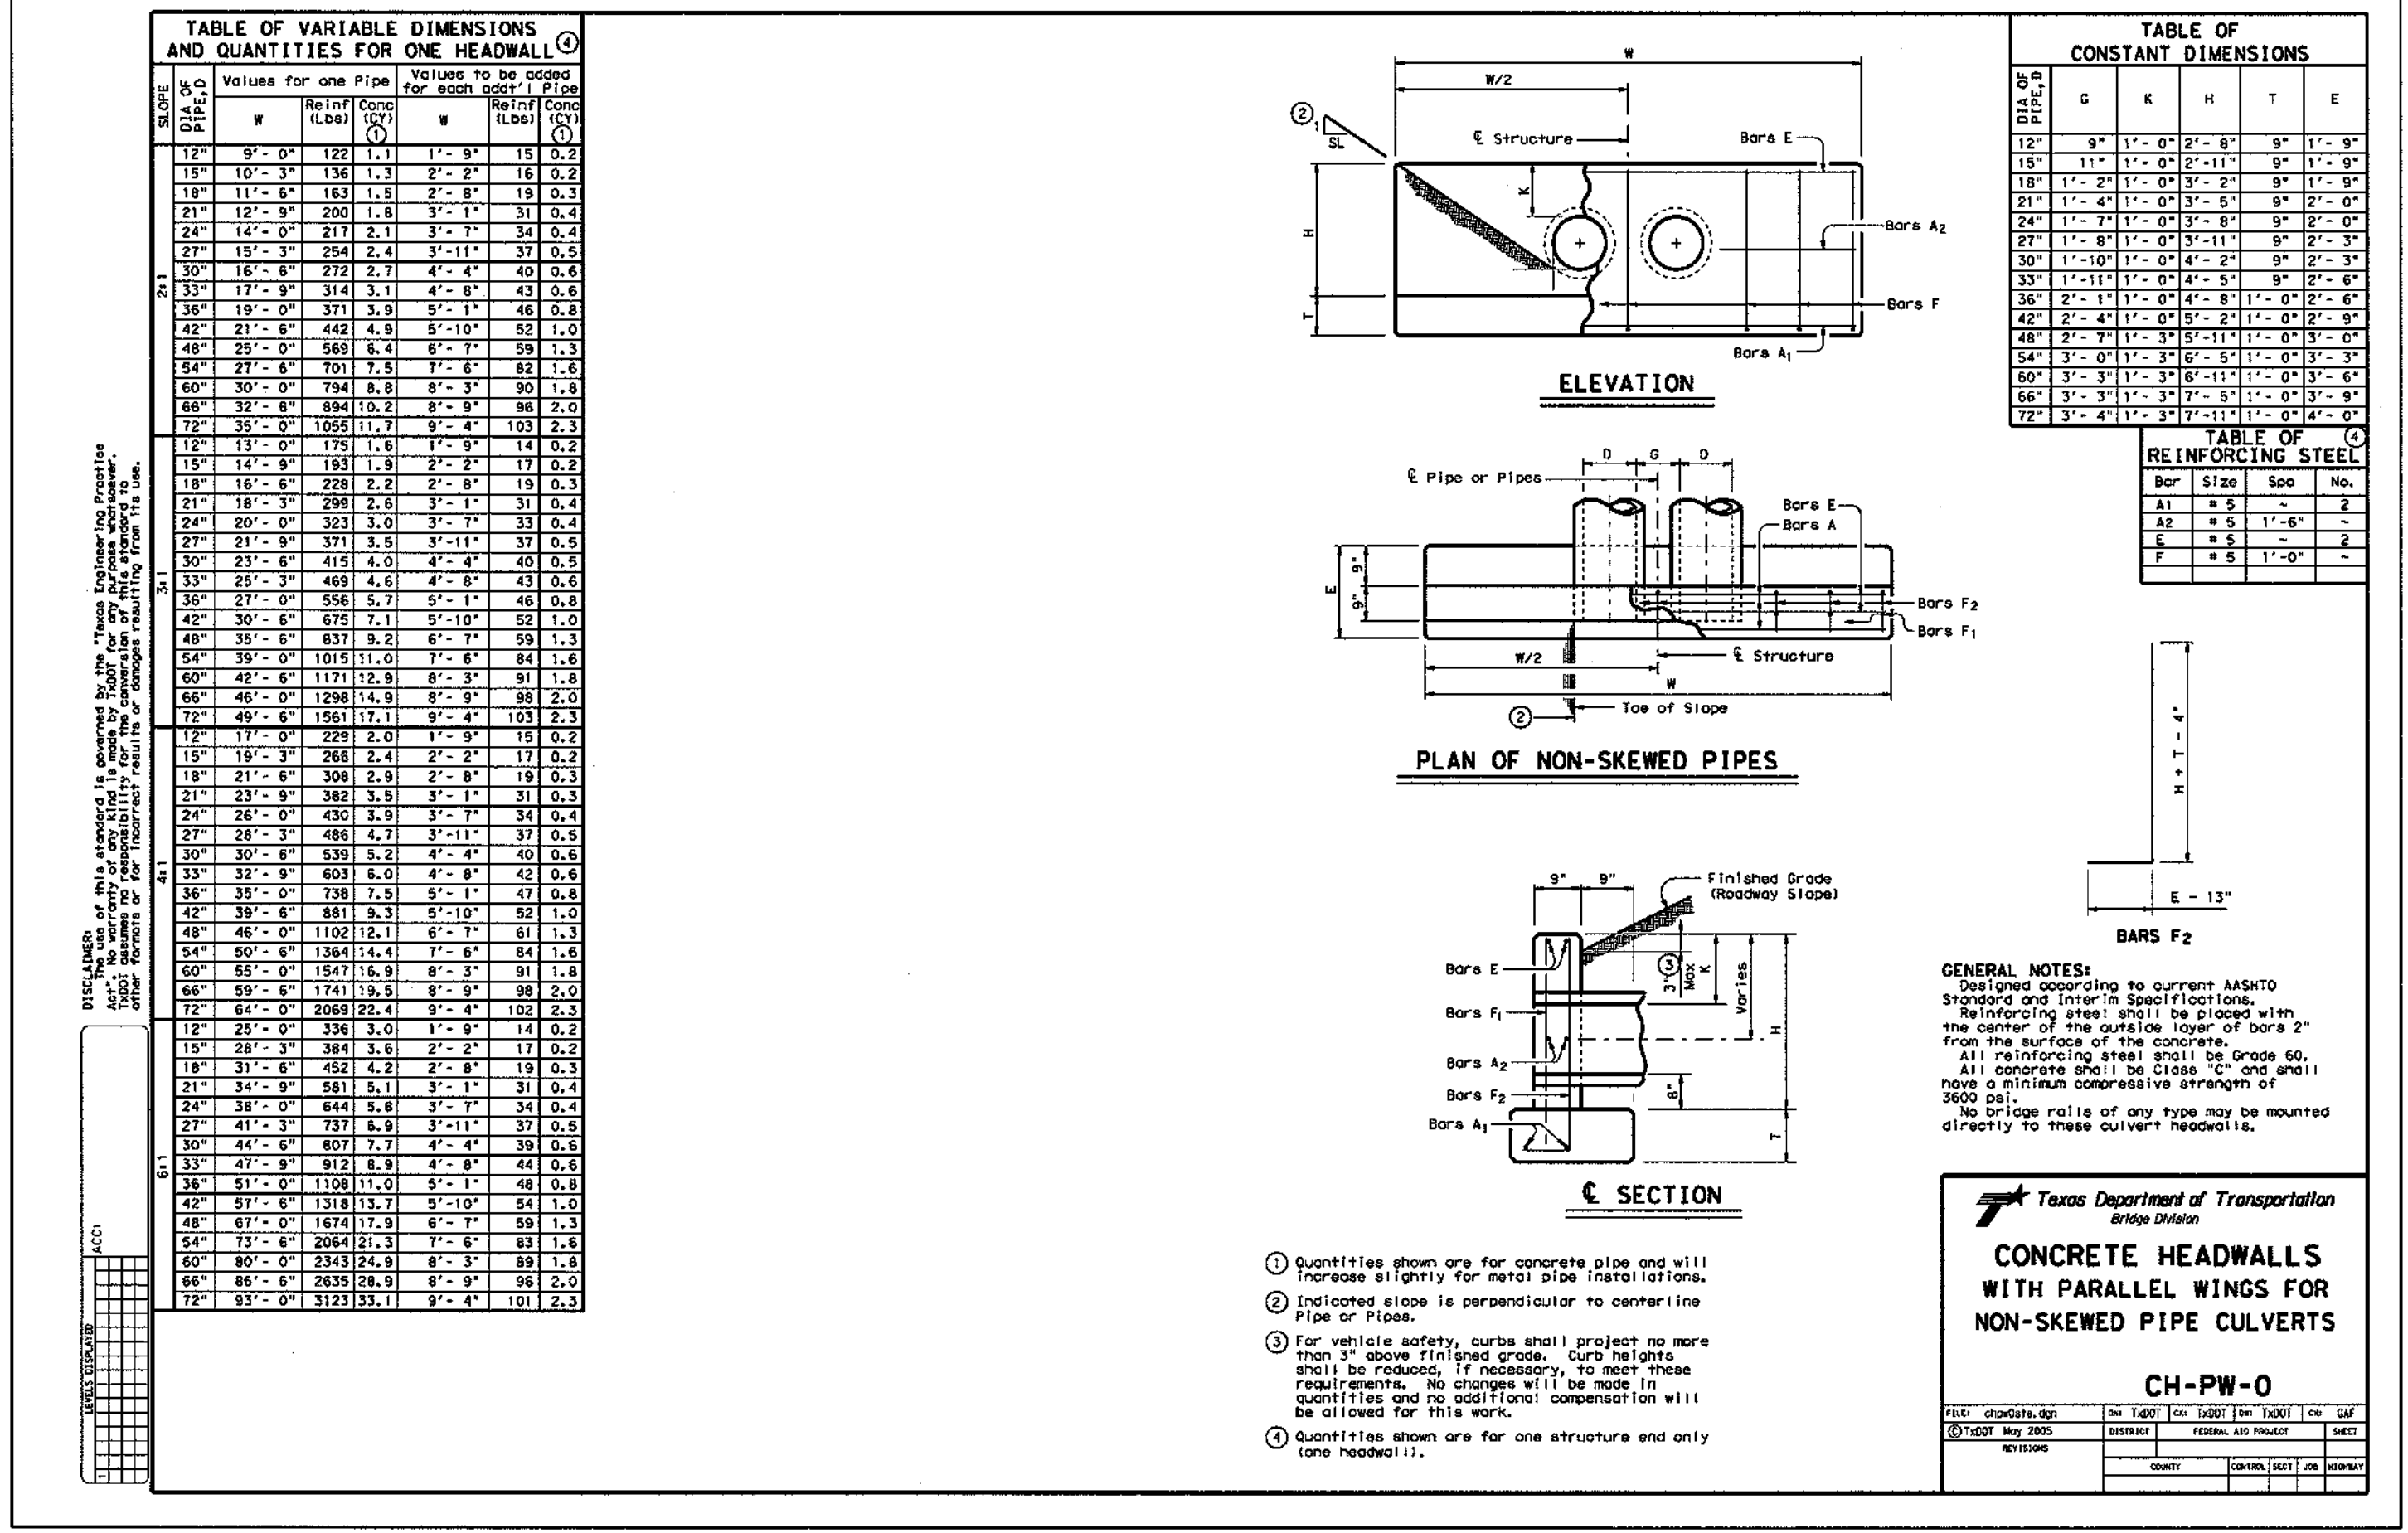

TYPE 'C' 4:1 HEADWALL NOT TO SCALE

DETENTION 'A1' OUTLET STRUCTURE NOT TO SCALE

LEWIS PARK ESTATES
Lot 1-16, 1-20, Block A, B
LEWIS PARK ESTATES
60858 Acres
in the
CITY OF LUCAS
COLLIN COUNTY, TEXAS

JAMES ANDERSON SURVEY, ABSTRACT NO. 17

STORM DRAINAGE DETAILS

AS-BUILT RECORD DRAWING

THE INFORMATION ON THESE PLANS HAS BEEN REVISED TO REFLECT CHANGES TO PUBLIC IMPROVEMENTS MADE DURING CONSTRUCTION PROVIDED TO ENGINEER BY THE CONTRACTOR. UNLESS OTHERWISE NOTED, THE CONSTRUCTION OF THE PUBLIC IMPROVEMENTS IS IN GENERAL CONFORMANCE WITH THE SPECIFICATIONS AND BASED UPON INFORMATION PROVIDED BY THE CONTRACTOR, AND THE RESPONSIBILITY FOR ACCURACY AND COMPLETENESS BELONGS TO THE CONTRACTOR.

Douglas W. Weaver
G & A Consultants, LLC.

Date: 11/23/2015


G & A CONSULTANTS, LLC.
TBE F-1798

Drawn By: T.J.F.
Date: 11/07/2014
Scale: 1/8" = 1'-0"
Revisions:


14026

C29

OWNER/DEVELOPER
CADG LEWIS PARK, LLC
C/O LENART DEVELOPMENT COMPANY, LLC
520 CENTRAL PARKWAY E. SUITE 104
PLANO, TX 75074
Ph. (972) 422-9880
Contact Steve Lenart

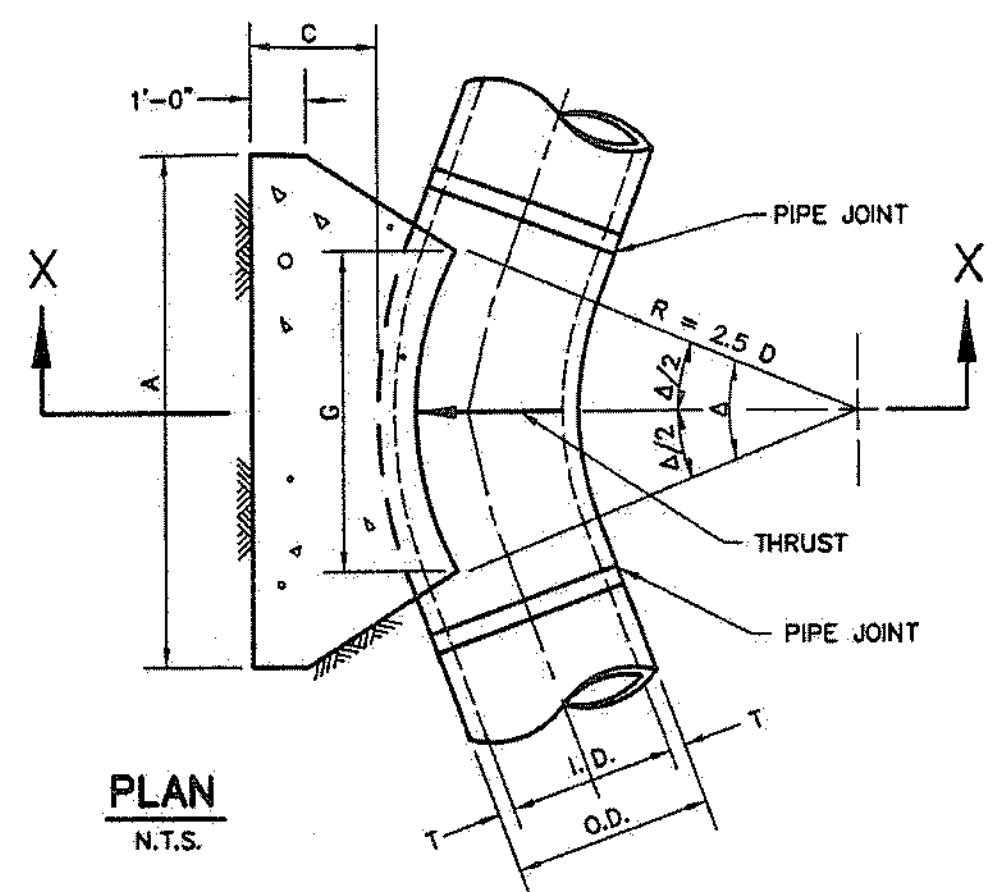

REFER TO
STD. DWG. No. 4040
FOR GENERAL NOTES.

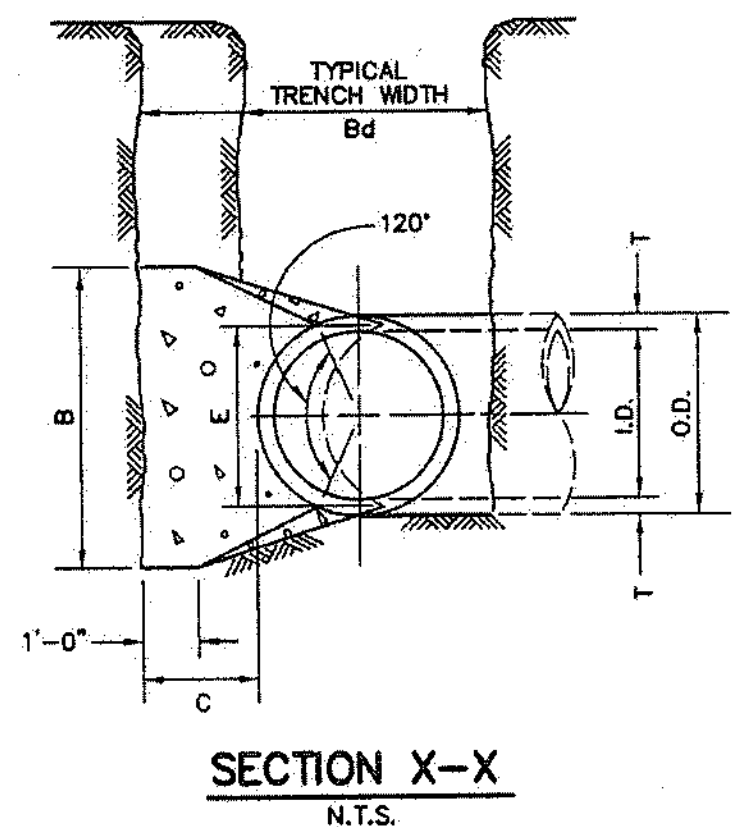

**HORIZONTAL THRUST BLOCK
AT PIPE BEND**



North Central Texas Council of Governments
STANDARD SPECIFICATION REFERENCE
6.7.
DATE: NOV. '96
STANDARD DRAWING NO.: 4010A

I.D. (IN.)	T (IN.)	Δ = 11.25° (FT.)	Δ = 22.50° (FT.)	E (FT.)
4.6,8	0.4	1.5	1.5	0.9
10,12	0.5	1.5	1.5	1.2
16,18	0.6	1.5	1.5	1.6
20	0.7	1.5	1.5	1.8
24	0.9	1.5	1.5	2.1
30	2.9	1.5	1.9	2.6
36	4.5	1.5	2.3	3.3
42	5.0	1.8	2.6	3.8
48	5.5	2.0	3.0	4.3
54	6.0	2.3	3.4	4.8
60	6.5	2.5	3.8	5.3
66	6.8	2.6	4.1	5.7
72	7.5	3.0	4.5	6.3
78	7.5	3.3	4.9	6.7
84	8.0	3.5	5.3	7.2
90	8.5	3.8	5.6	7.7
96	9.0	4.0	6.0	8.2

Δ = 11.25°												Δ = 22.50°											
EARTH						ROCK						EARTH						ROCK					
I.D. (IN.)	G (FT.)	THRUST (TONS)	A (FT.)	B (FT.)	VOL. (C.Y.)	I.D. (IN.)	G (FT.)	THRUST (TONS)	A (FT.)	B (FT.)	VOL. (C.Y.)	I.D. (IN.)	G (FT.)	THRUST (TONS)	A (FT.)	B (FT.)	VOL. (C.Y.)	I.D. (IN.)	G (FT.)	THRUST (TONS)	A (FT.)	B (FT.)	VOL. (C.Y.)
4.6,8	0.4	1.0	1.0	1.5	0.1	10,12	1.1	4.4	2.0	2.5	0.3	16,18	1.6	9.9	3.0	3.5	0.6	20	2.9	1.5	1.9	2.6	3.3
10,12	0.6	2.2	1.5	1.5	0.1	10,12	1.1	4.4	2.0	2.5	0.3	16,18	1.6	9.9	3.0	3.5	0.6	20	2.9	1.5	1.9	2.6	3.3
16,18	0.8	5.0	2.0	2.5	0.3	16,18	1.6	9.9	3.0	3.5	0.6	20	2.9	1.5	1.9	2.6	3.3	24	4.5	1.5	2.3	3.3	4.8
20	0.9	6.2	2.0	3.5	0.4	20	1.8	12.3	3.5	3.5	0.7	24	4.3	34.9	9.0	4.0	2.3	5.5	3.5	1.2	20	6.6	44.4
24	1.1	8.9	3.0	3.5	0.5	24	2.2	17.7	4.0	4.5	1.0	30	3.0	54.0	12.0	5.0	4.8	7.5	4.0	2.2	30	9.9	75.0
30	1.4	10.4	3.0	3.5	0.6	30	2.7	20.7	5.0	4.5	1.5	36	3.3	58.9	12.0	5.0	4.8	7.5	4.0	2.2	36	11.9	108.0
36	1.7	15.0	3.5	4.5	0.9	36	3.3	29.8	5.5	5.5	2.3	42	4.0	84.9	14.5	6.0	8.2	9.5	4.5	3.8	42	13.9	147.0
42	1.9	20.4	4.5	5.0	1.5	42	3.8	40.5	7.0	6.0	3.9	48	4.4	109.9	15.0	7.0	12.8	11.0	5.5	6.3	48	15.9	192.0
48	2.2	26.6	4.5	6.0	2.0	48	4.4	52.9	8.0	7.0	5.7	54	4.9	150.9	16.0	8.0	18.4	13.0	6.0	9.2	54	17.9	243.0
54	2.5	33.7	6.0	6.0	3.0	54	4.9	67.0	9.0	8.0	8.0	60	5.5	178.7	17.0	9.0	20.0	14.0	6.5	12.9	60	19.9	299.8
60	2.7	41.6	6.0	7.0	3.8	60	5.5	82.7	9.5	9.0	10.6	66	6.0	202.3	18.0	10.0	22.0	15.0	7.0	14.0	66	21.8	362.8
66	3.0	50.3	6.5	8.0	5.1	66	6.0	100.1	10.5	10.0	14.1	72	6.6	233.9	19.0	11.0	24.0	16.0	8.0	15.0	72	23.8	431.8
72	3.3	59.9	7.5	8.0	6.3	72	6.6	119.1	11.0	11.0	17.6	78	7.1	269.5	20.0	12.0	26.0	17.0	9.0	16.0	78	25.7	506.7
78	3.6	70.2	8.0	9.0	8.1	78	7.1	139.8	12.0	12.0	22.5	84	7.6	298.5	21.0	13.0	27.0	18.0	10.0	17.0	84	27.7	587.7
84	3.8	81.5	8.5	10.0	10.3	84	7.6	162.1	13.0	12.5	27.2	90	8.2	339.5	22.0	14.0	28.0	19.0	11.0	18.0	90	29.0	674.6
90	4.1	93.5	9.5	10.0	12.2	90	8.2	186.1	14.0	13.5	33.7	96	8.7	211.7	15.0	14.5	31.0	20.0	12.0	19.0	96	31.6	767.5
96	4.4	106.4	10.0	11.0	15.0	96	8.7	211.7	15.0	14.5	41.2												

TABLES OF DIMENSIONS AND QUANTITIES


**HORIZONTAL THRUST BLOCK
AT PIPE BEND**




North Central Texas Council of Governments
STANDARD SPECIFICATION REFERENCE
6.7.
DATE: NOV. '96
STANDARD DRAWING NO.: 4010B

Δ = 30°												Δ = 45°											
EARTH						ROCK						EARTH						ROCK					
I.D. (IN.)	G (FT.)	THRUST (TONS)	A (FT.)	B (FT.)	VOL. (C.Y.)	I.D. (IN.)	G (FT.)	THRUST (TONS)	A (FT.)	B (FT.)	VOL. (C.Y.)	I.D. (IN.)	G (FT.)	THRUST (TONS)	A (FT.)	B (FT.)	VOL. (C.Y.)	I.D. (IN.)	G (FT.)	THRUST (TONS)	A (FT.)	B (FT.)	VOL. (C.Y.)
4.6,8	1.0	2.6	2.0	1.5	0.2	10	1.5	0.2	10	1.5	0.2	16.8	1.5	3.9	2.0	2.0	0.2	1.5	1.5	0.1			
10	1.5	5.9	2.5	2.0	0.3	20	1.5	0.2	10	1.5	0.2	16.8	2.2	8.7	3.5	2.5	0.5	2.0	2.5	0.3			
16.8	2.2	13.2	3.5	4.0	0.8	2.5	3.0	0.4	16.8	3.2	19.5	4.5	4.5	1.2	3.0	2.5	0.3	3.5	0.6				
20	2.4	16.3	4.5	4.0	1.0	3.0	3.0	0.5	20	3.8	24.1	5.5	4.5	1.5	3.5	3.5	0.7						
24	2.9	23.4	6.0	4.0	1.4	3.5	3.5	0.7	24	4.3	34.6	8.0	4.5	2.3	4.5	4.0	1.1						
30	3.6	27.5	6.5	5.0	1.9	3.5	4.0	0.9	30	5.4	40.6	8.5	5.0	3.2	5.5	4.0	1.6						
36	4.4	39.5	7.0	6.0	3.4	4.5	4.5	1.6	36	6.5	58.5	10.0	6.0	5.3	6.5	4.5	2.6						
42	5.1	53.8	8.0	7.0	5.1	5.5	5.0	2.5	42	7.5	79.6	11.5	7.0	8.1	8.0	5.0	4.2						
48	5.8	70.3	9.0	8.0	7.4	6.0	6.0	3.7	48	8.6	104.0	13.0	8.0	11.9	9.0	6.0	6.3						
54	6.5	89.0	10.0	9.0	10.3	7.0	6.5	5.3	54	9.7	131.5	15.0	9.0	17.1	10.5	6.5	8.9						
60	7.3	110.0	11.0	10.0	13.9	7.5	7.5	7.3	60	10.7	162.4	16.5	10.0	23.1	11.0	7.5	12.0						
66	8.0	132.9	12.5	11.0	18.9	8.5	8.0	8.6	66	11.8	196.5	18.0	11.0	30.1	12.0	8.5	16.2						
72	8.7	158.2	13.5	12.0	24.0	9.0	9.0	12.3	72	12.9	233.9	19.5	12.0	38.6	14.0	8.5	20.7						
78	9.4	185.6	14.5	13.0	30.0	10.0	9.5	15.6	78	13.9	274.5	21.5	13.0	49.8	14.5	9.5	25.9						
84	10.1	215.3	15.5	14.0	37.1	10.5	10.5	19.5	84	15.0	318.4	23.0	14.0	61.2	15.5	10.5	32.6						
90	10.9	247.1	16.5	15.0	45.0	11.5	11.0	23.9	90	16.1	355.5	24.5	15.0	74.5	17.5	10.5	39.6						
96	11.6	281.2	18.0	16.0	55.5	12.5	11.5	28.9	96	17.1	415.6	26.0	16.0	89.5	18.5	11.5	48.5						


Δ = 67.50°												Δ = 90°																																						
EARTH						ROCK						EARTH						ROCK																																
I.D. (IN.)	G (FT.)	THRUST (TONS)	A (FT.)	B (FT.)	VOL. (C.Y.)	I.D. (IN.)	G (FT.)	THRUST (TONS)	A (FT.)	B (FT.)	VOL. (C.Y.)	I.D. (IN.)	G (FT.)	THRUST (TONS)	A (FT.)	B (FT.)	VOL. (C.Y.)	I.D. (IN.)	G (FT.)	THRUST (TONS)	A (FT.)	B (FT.)	VOL. (C.Y.)																											
4,6,8	2.1	5.6	3.0	2.0	0.3	2.0	1.5	0.2	4,6,8	2.7	7.1	5.5	1.5	0.4	2.0	2.0	0.2	10,12	3.1	12.6	5.5	2.5	0.8	10,12	4.0	16.0	6.5	2.5	1.0	3.5	2.5	0.5	16,18	4.7	28.3	7.5	4.0	1.9	5.5	3.0	1.0	16,18	6.0	36.0	9.0	4.0	2.4	4.5	4.0	1.0
20	5.2	34.9	9.0	4.0	2.3	5.5	3.5	1.2	20	6.6	44.4	10.0	4.5	3.1	6.0	4.0	1.5	30	9.9	75.0	15.0	5.0	6.7	10.0	4.0	3.3	40	13.9	147.0	21.0	7.0	17.8	14.0	5.5	8.7	40	15.9	192.0	24.0	8.0	26.2	16.0	6.0	12.4						
24	6.2	50.3	11.5	4.5	3.5	6.5	4.0	1.6	24	7.9	64.0	14.5	4.5	5.0	8.0	4.0	2.1	36	11.9	108.0	18.0	6.0	11.4	12.0	4.5	5.3	48	15.9	192.0	24.0	8.0	26.2	16.0	6.0	12.4	48	17.9	243.0	27.0	9.0	36.9	18.0	7.0	18.1						
36	9.4	84.9	14.5	6.0	8.2	9.5	4.5	3.8	36	11.9	108.0	18.0	6.0	11.4	12.0	4.5	5.3	48	15.9	192.0	24.0	8.0	26.2	16.0	6.0	12.4	60	19.9	299.8	30.0	10.0	50.3	20.0	7.5	24.0	60	21.8	362.8	33.0	11.0	66.2	22.0	8.5	32.5						
42	10.9	115.5	17.0	7.0	12.8	11.0	5.5	6.3	42	13.9	147.0	21.0	7.0	17.8	14.0	5.5	8.7	54	17.9	243.0	27.0	9.0	36.9	18.0	7.0	18.1	66	21.8	362.8	33.0	11.0	66.2	22.0	8.5	32.5	66	23.8	431.8	36.0	12.0	85.6	24.0	9.0	41.0						
48	12.5	150.9	19.0	8.0	18.4	13.0	6.0	9.2	48	15.9	192.0	24.0	8.0	26.2	16.0	6.0	12.4	60	19.9	299.8	30.0	10.0	50.3	20.0	7.5	24.0	72	23.8	431.8	36.0	12.0	85.6	24.0	9.0	41.0	72	25.7	506.7	39.0	13.0	108.2	26.0	10.0	53.2						
54	14.0	191.0	21.5	9.0	26.0	15.0	6.5	12.9	54	17.9	243.0	27.0	9.0	36.9	18.0	7.0	18.1	66	21.8	362.8	33.0	11.0	66.2	22.0	8.5	32.5	78	25.7	506.7	39.0	13.0	108.2	26.0	10.0	53.2	78	27.7	587.7	42.0	14.0	134.4	28.0	10.5	64.8						
60	15.6	235.8	24.0	10.0	35.6	16.0	7.5	17.6	60	19.9	299.8	30.0	10.0	50.3	20.0	7.5	24.0	72	23.8	431.8	36.0	12.0	85.6	24.0	9.0	41.0	84	27.7	587.7	42.0	14.0	134.4	28.0	10.5	64.8	84	29.6	674.5	45.0	15.0	164.9	30.0	11.5	81.2						
66	17.1	285.3	26.0	11.0	46.0	18.0	8.0	23.0	66	21.8	362.8	33.0	11.0	66.2	22.0	8.5	32.5	78	25.7	506.7	39.0	13.0	108.2	26.0	10.0	53.2	96	29.6	674.5	45.0	15.0	164.9	30.0	11.5	81.2	96	31.6	767.5	48.0	16.0	199.9	32.0	12.0	95.1						

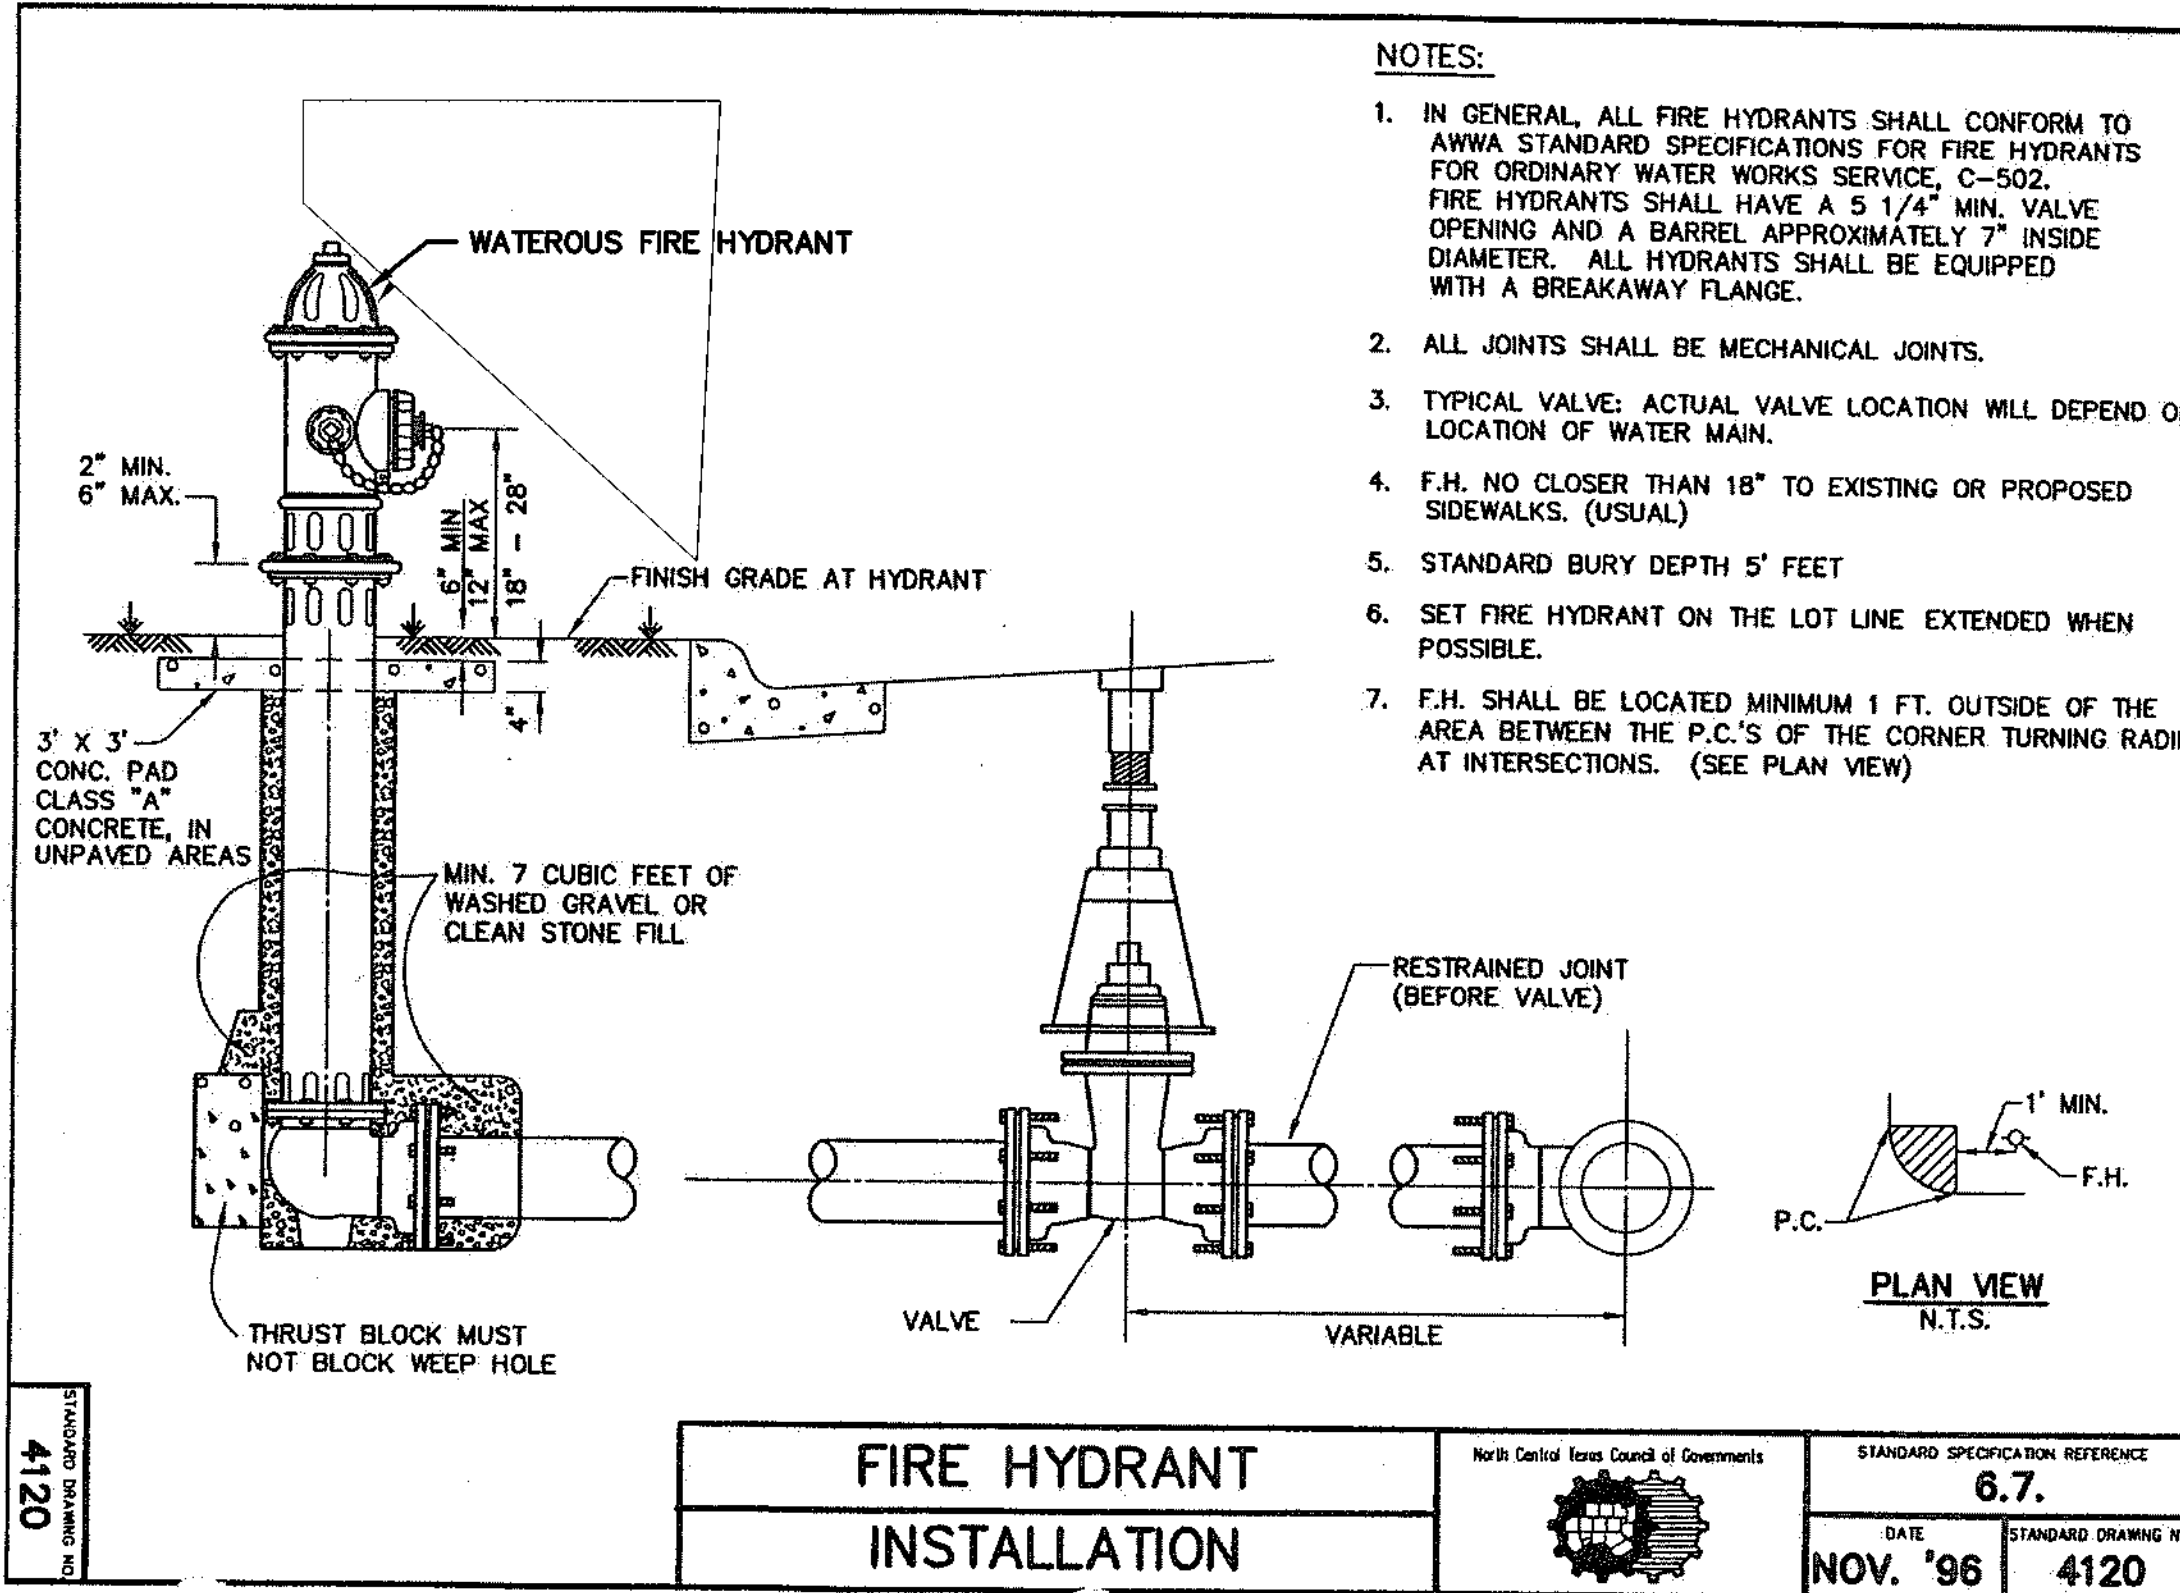


- NOTES:
1. IN GENERAL, ALL FIRE HYDRANTS SHALL CONFORM TO AWWA STANDARD SPECIFICATIONS FOR FIRE HYDRANTS FOR ORDINARY WATER WORKS SERVICE, C-502. FIRE HYDRANTS SHALL HAVE A 5 1/4" MIN. VALVE OPENING AND A BARREL APPROXIMATELY 7" INSIDE DIAMETER. ALL HYDRANTS SHALL BE EQUIPPED WITH A BREAKAWAY FLANGE.
 2. ALL JOINTS SHALL BE MECHANICAL JOINTS.
 3. TYPICAL VALVE: ACTUAL VALVE LOCATION WILL DEPEND ON LOCATION OF WATER MAIN.
 4. F.H. NO CLOSER THAN 18" TO EXISTING OR PROPOSED SIDEWALKS. (USUAL)
 5. STANDARD BURY DEPTH 5' FEET
 6. SET FIRE HYDRANT ON THE LOT LINE EXTENDED WHEN POSSIBLE.
 7. F.H. SHALL BE LOCATED MINIMUM 1 FT. OUTSIDE OF THE AREA BETWEEN THE P.C.'S OF THE CORNER TURNING RADI AT INTERSECTIONS. (SEE PLAN VIEW)

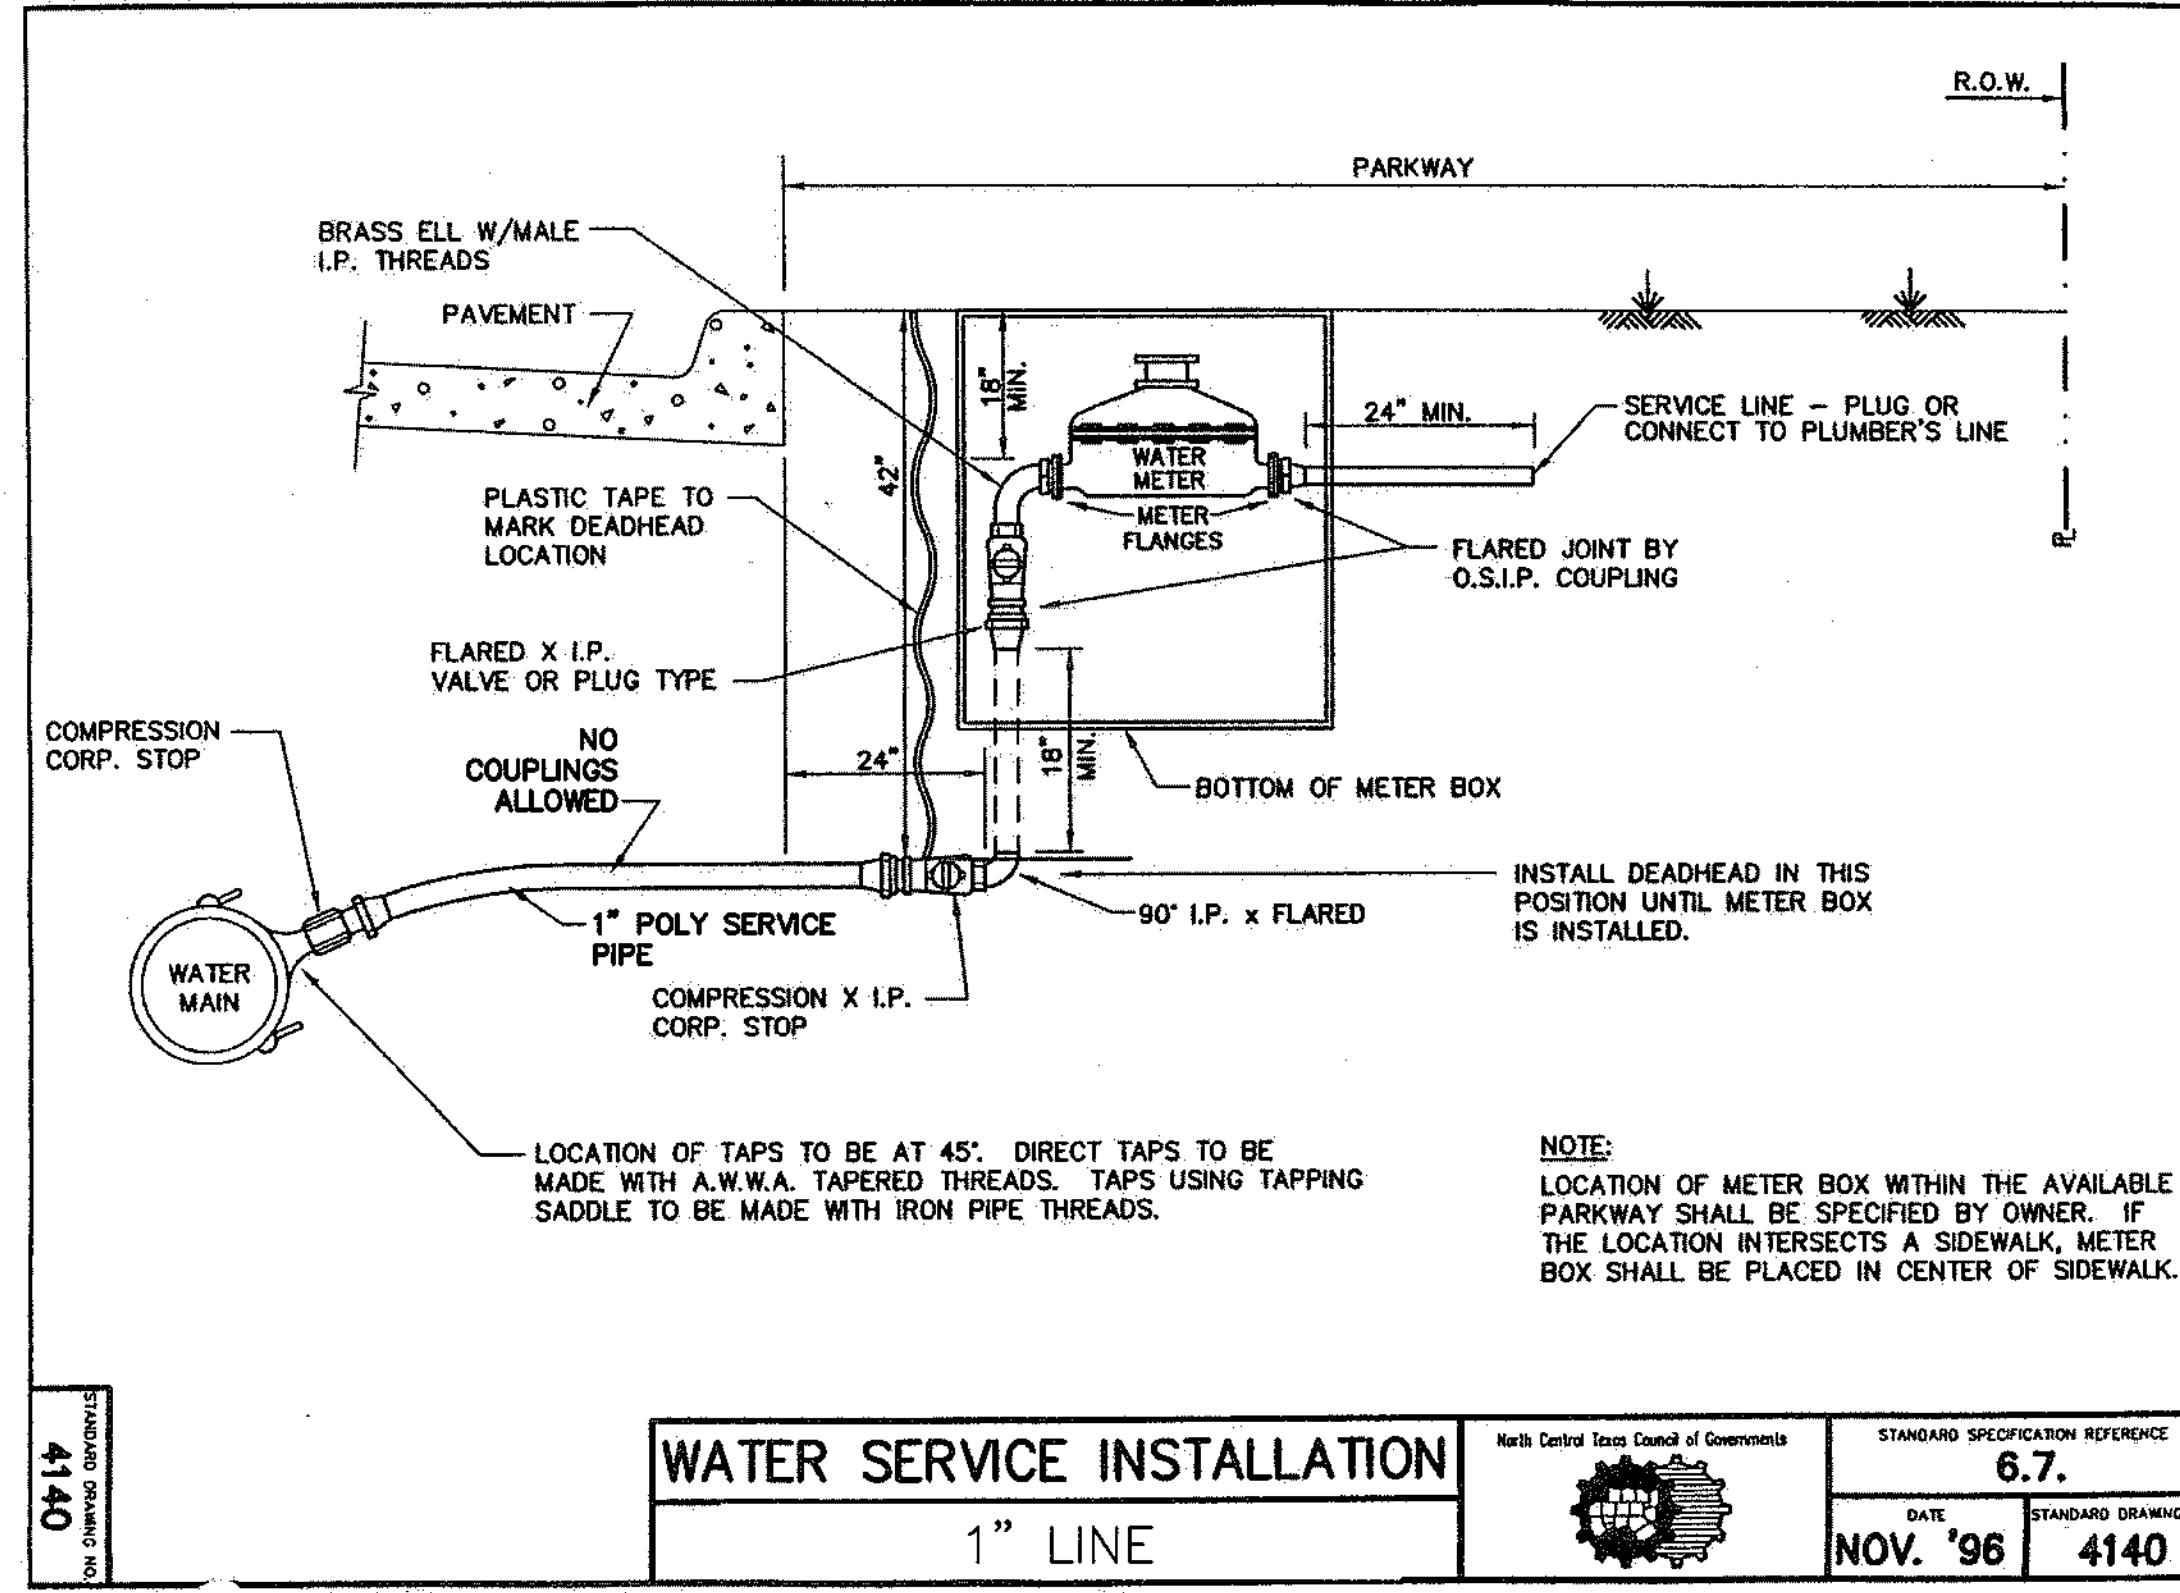

- GENERAL NOTES:
1. ALL FIRE HYDRANTS TO BE WATEROUS FIRE HYDRANTS OR EQUAL, APPROVED BY CITY OF LUCAS PUBLIC WORKS DIRECTOR.
 2. ALL FITTINGS TO BE FORD BRASS OR EQUAL, APPROVED BY CITY OF LUCAS PUBLIC WORKS DIRECTOR.
 3. ALL METERS AND SERVICE TAPS SHALL BE 1" POLY OR LARGER.

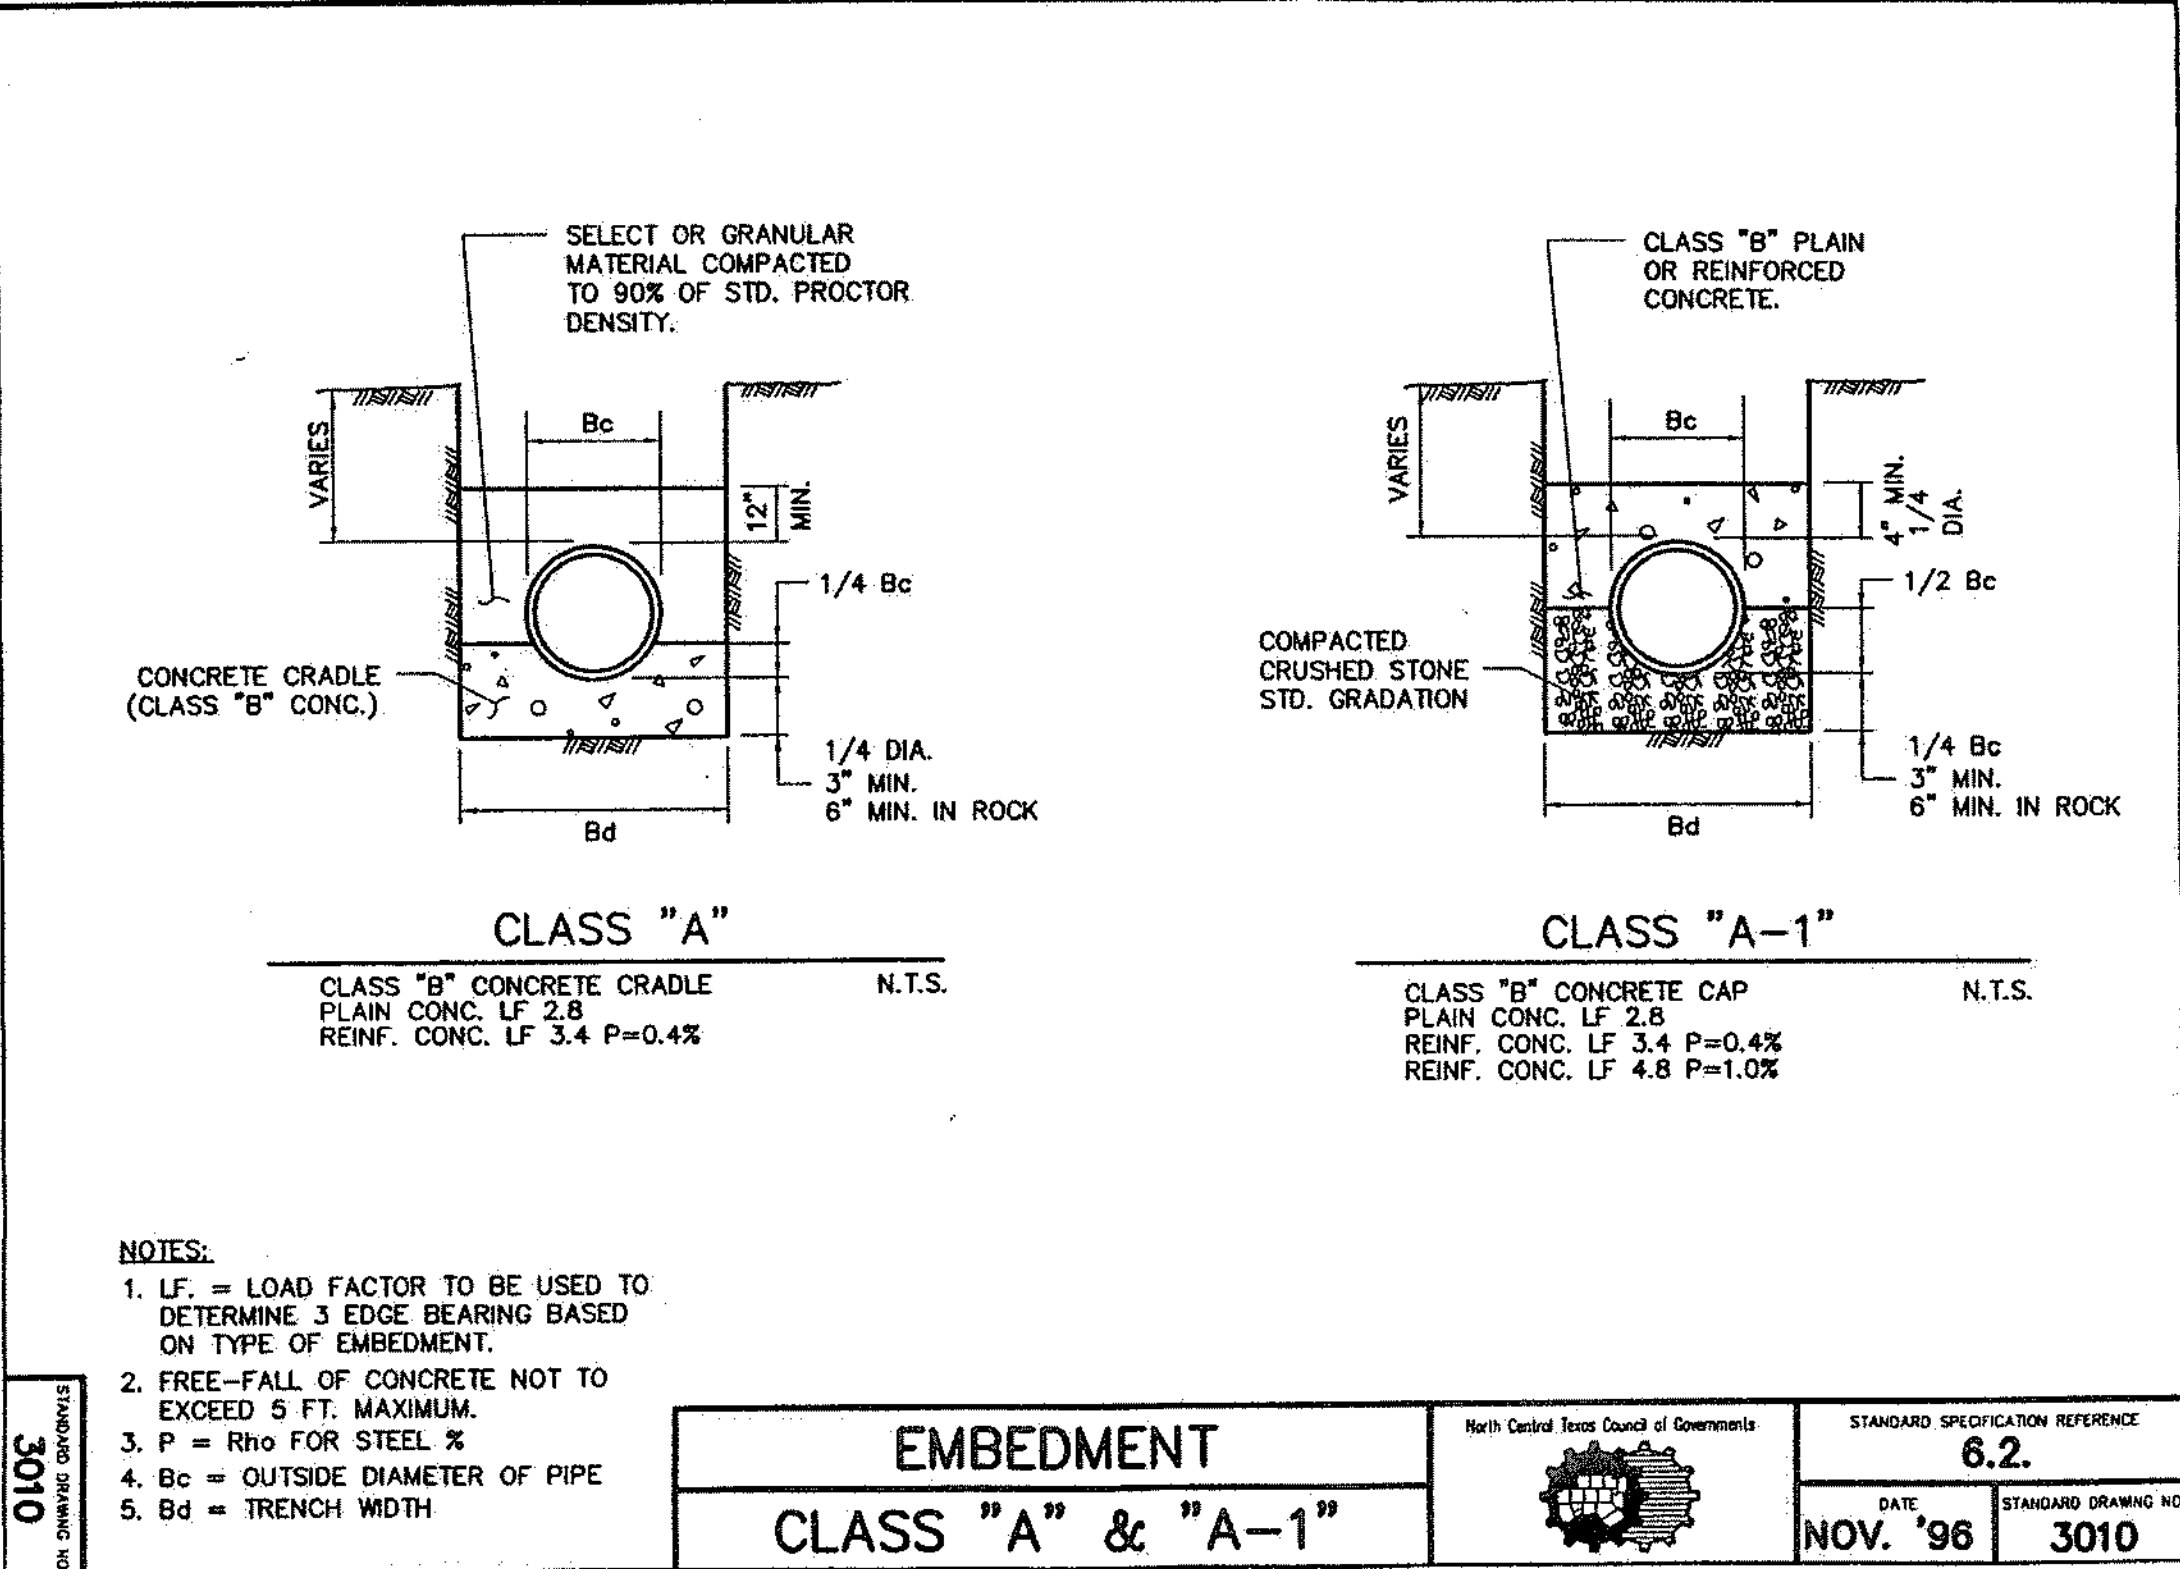

- NOTES:
1. LF = LOAD FACTOR TO BE USED TO DETERMINE 3 EDGE BEARING BASED ON TYPE OF EMBEDMENT.
 2. FREE-FALL OF CONCRETE NOT TO EXCEED 5 FT. MAXIMUM.
 3. P = RATIO FOR STEEL %
 4. Bc = OUTSIDE DIAMETER OF PIPE
 5. Bd = TRENCH WIDTH

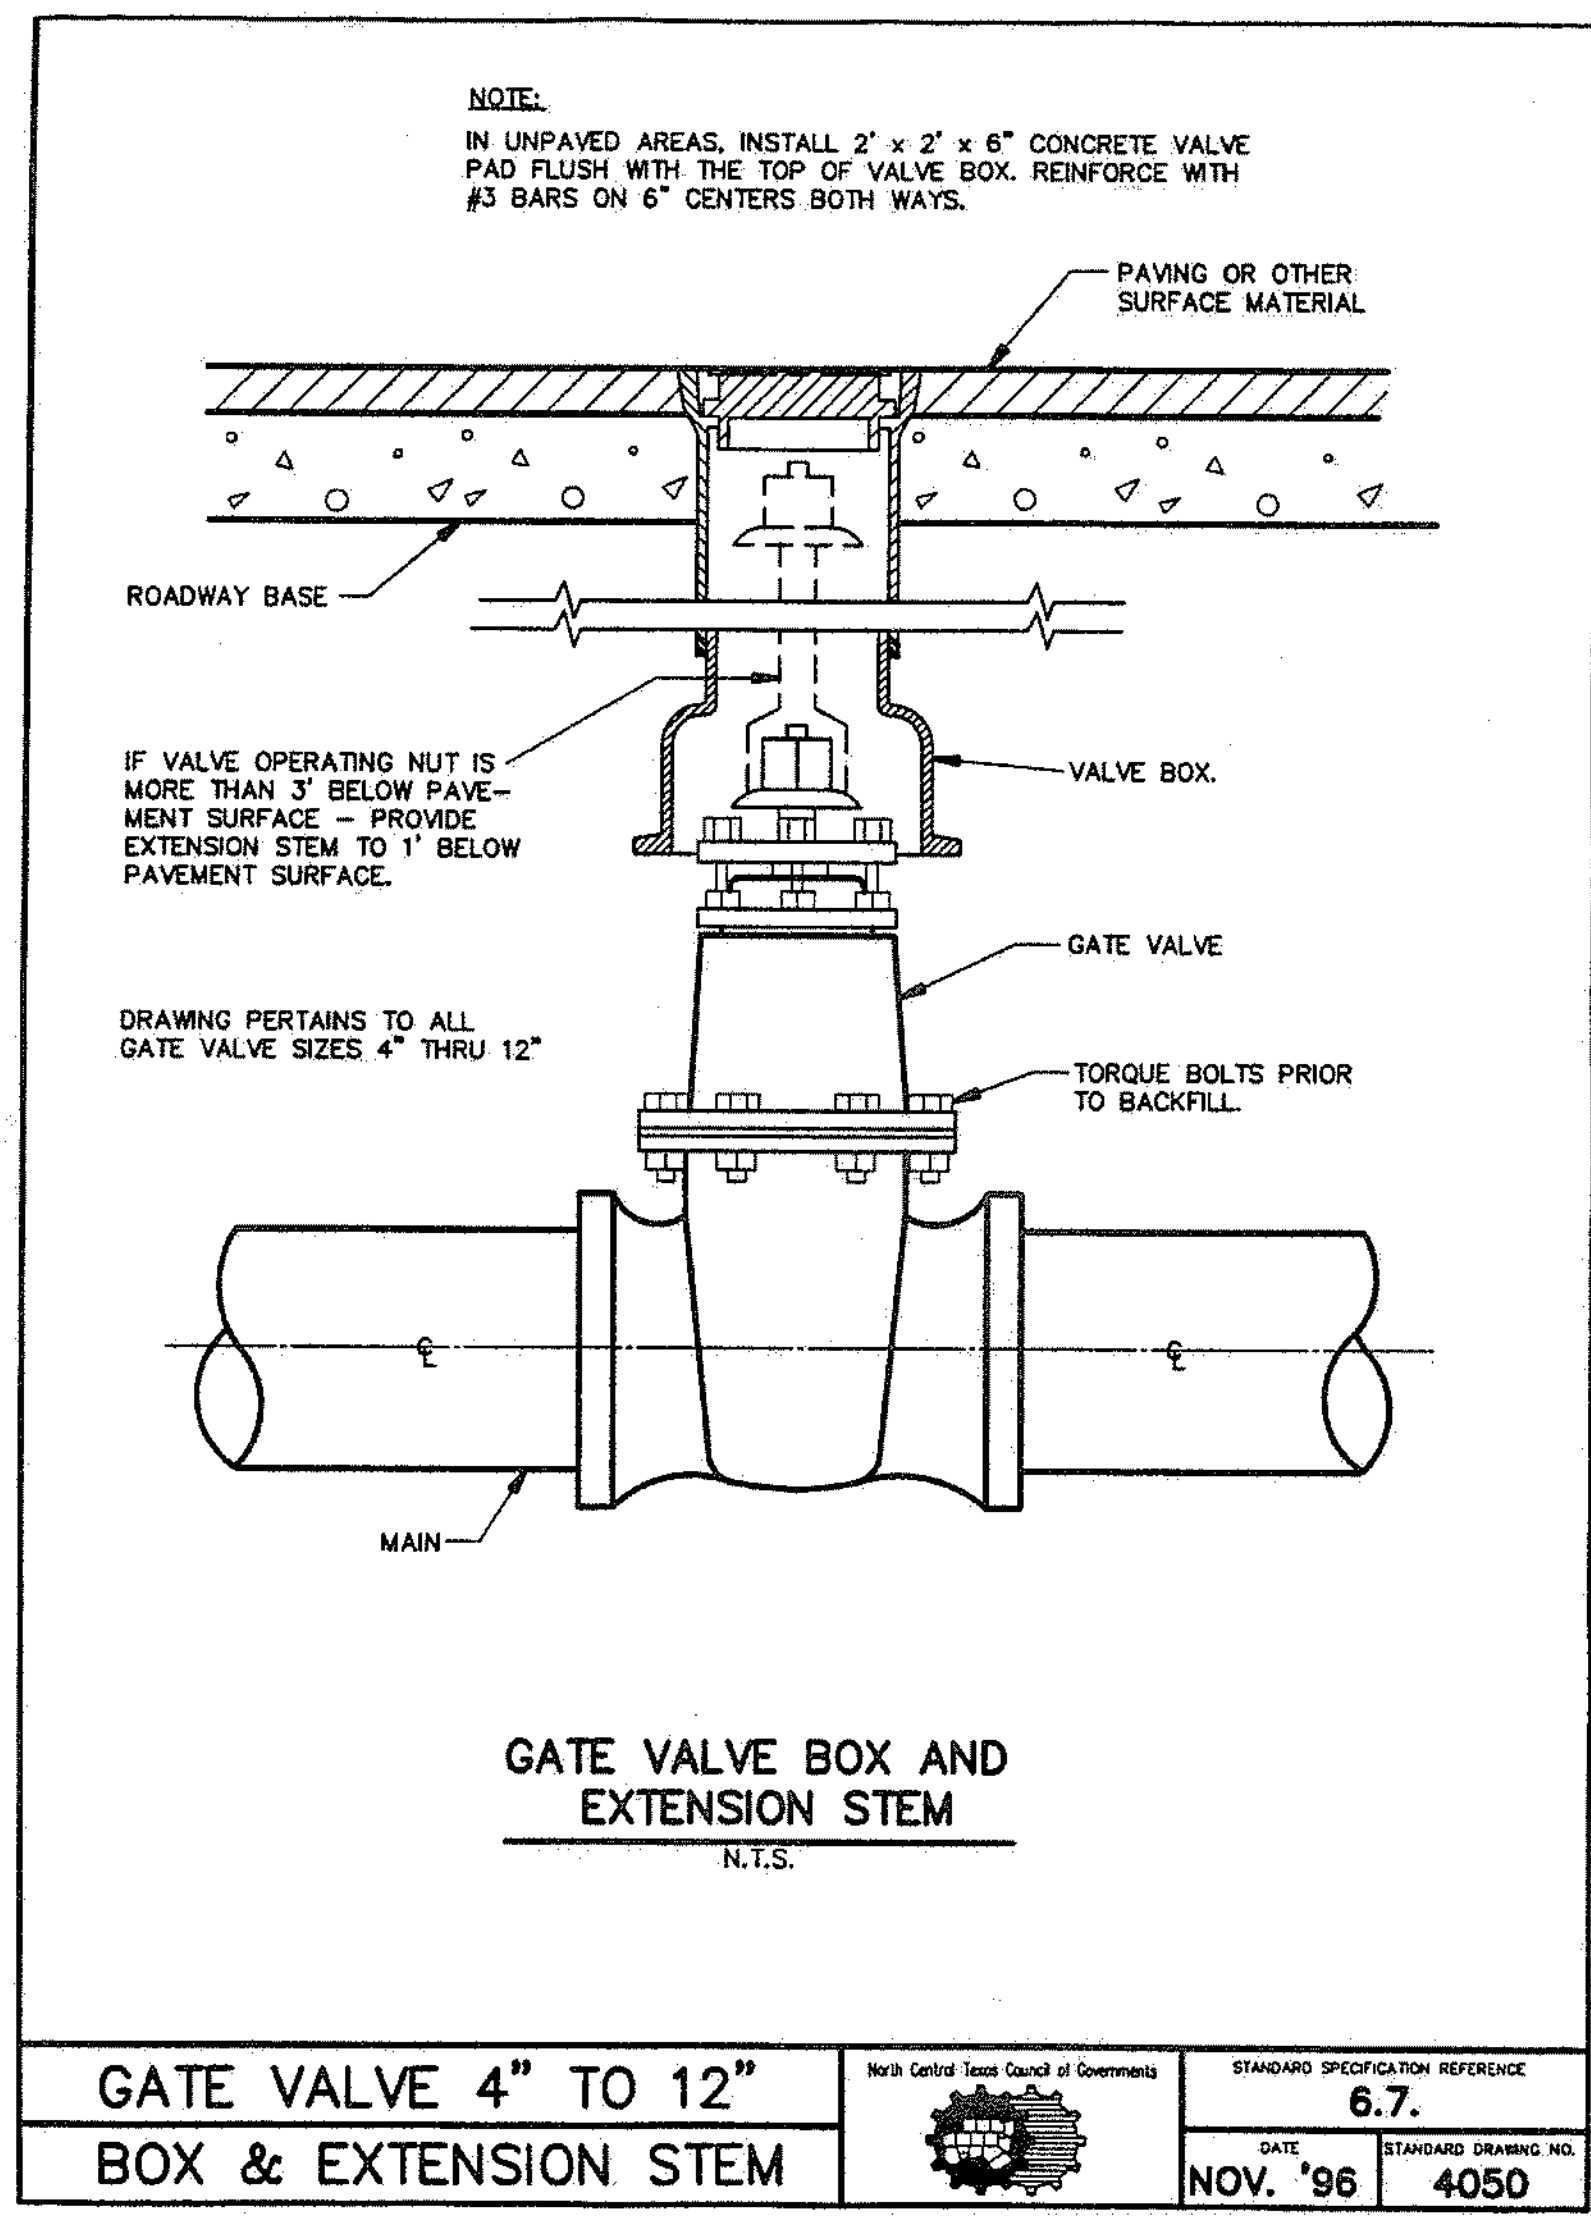

NOTE:
IN UNPAVED AREAS, INSTALL 2' x 2' x 6" CONCRETE VALVE PAD FLUSH WITH THE TOP OF VALVE BOX. REINFORCE WITH #3 BARS ON 6" CENTERS BOTH WAYS.

AS-BUILT
RECORD DRAWING

THE INFORMATION ON THESE PLANS HAS BEEN REVISED TO REFLECT CHANGES TO PUBLIC IMPROVEMENTS MADE DURING CONSTRUCTION PROVIDED TO ENGINEER BY THE CONTRACTOR. UNLESS OTHERWISE NOTED, THE CONSTRUCTION OF THE PUBLIC IMPROVEMENTS IS IN GENERAL CONFORMANCE WITH THESE PLANS. THE CONTRACTOR SHALL BE RESPONSIBLE FOR THE ACCURACY AND COMPLETENESS OF THE INFORMATION PROVIDED TO THE ENGINEER. THE RESPONSIBILITY FOR ACCURACY AND COMPLETENESS OF THE INFORMATION PROVIDED TO THE ENGINEER SHALL BE THE RESPONSIBILITY OF THE CONTRACTOR.

Douglas W. Weaver
G & A Consultants, LLC.
Date: 11/23/2015

STEFANING CIVIL ENGINEERING PLANNING
CONSULTANTS, LLC
LAND SURVEYING LANDSCAPE ARCHITECTURE

111 Hillside Drive • Lawrenceville, TX 75057 • P: 972.438.9712 • F: 972.438.9715
611 Dallas Drive, Suite 114 • Rowlett, TX 75081 • P: 862.831.9712 • F: 817.880.4943
TBE Firm No. 1798

LEWIS PARK ESTATES
Lot 1-16, 1-20, Block A, B
LEWIS PARK ESTATES
60858 Acres
in the
JAMES ANDERSON SURVEY, ABSTRACT NO. 17
CITY OF LUCAS
COLLIN COUNTY, TEXAS

STANDARD WATER DETAILS

OWNER/DEVELOPER
CADG LEWIS PARK LLC
C/O LENART DEVELOPMENT COMPANY, LLC
520 CENTRAL PARKWAY E. SUITE 104
PLANO, TX 75074
Ph. (972) 422-9880
Contact: Steve Lenart

14026


C31

DISCLAIMER: This drawing is prepared by the Texas Engineering Practice Company, Inc. (TEPCO) for the use of the Engineer. It is not to be used for any other purpose without the written consent of TEPCO. The Engineer is not responsible for the accuracy or completeness of the information provided by the client or for the results of the use of this drawing.

ACI

DISCLAIMER: This drawing is prepared by the Texas Engineering Practice Company, Inc. (TEPCO) for the use of the Engineer. It is not to be used for any other purpose without the written consent of TEPCO. The Engineer is not responsible for the accuracy or completeness of the information provided by the client or for the results of the use of this drawing.

ACI

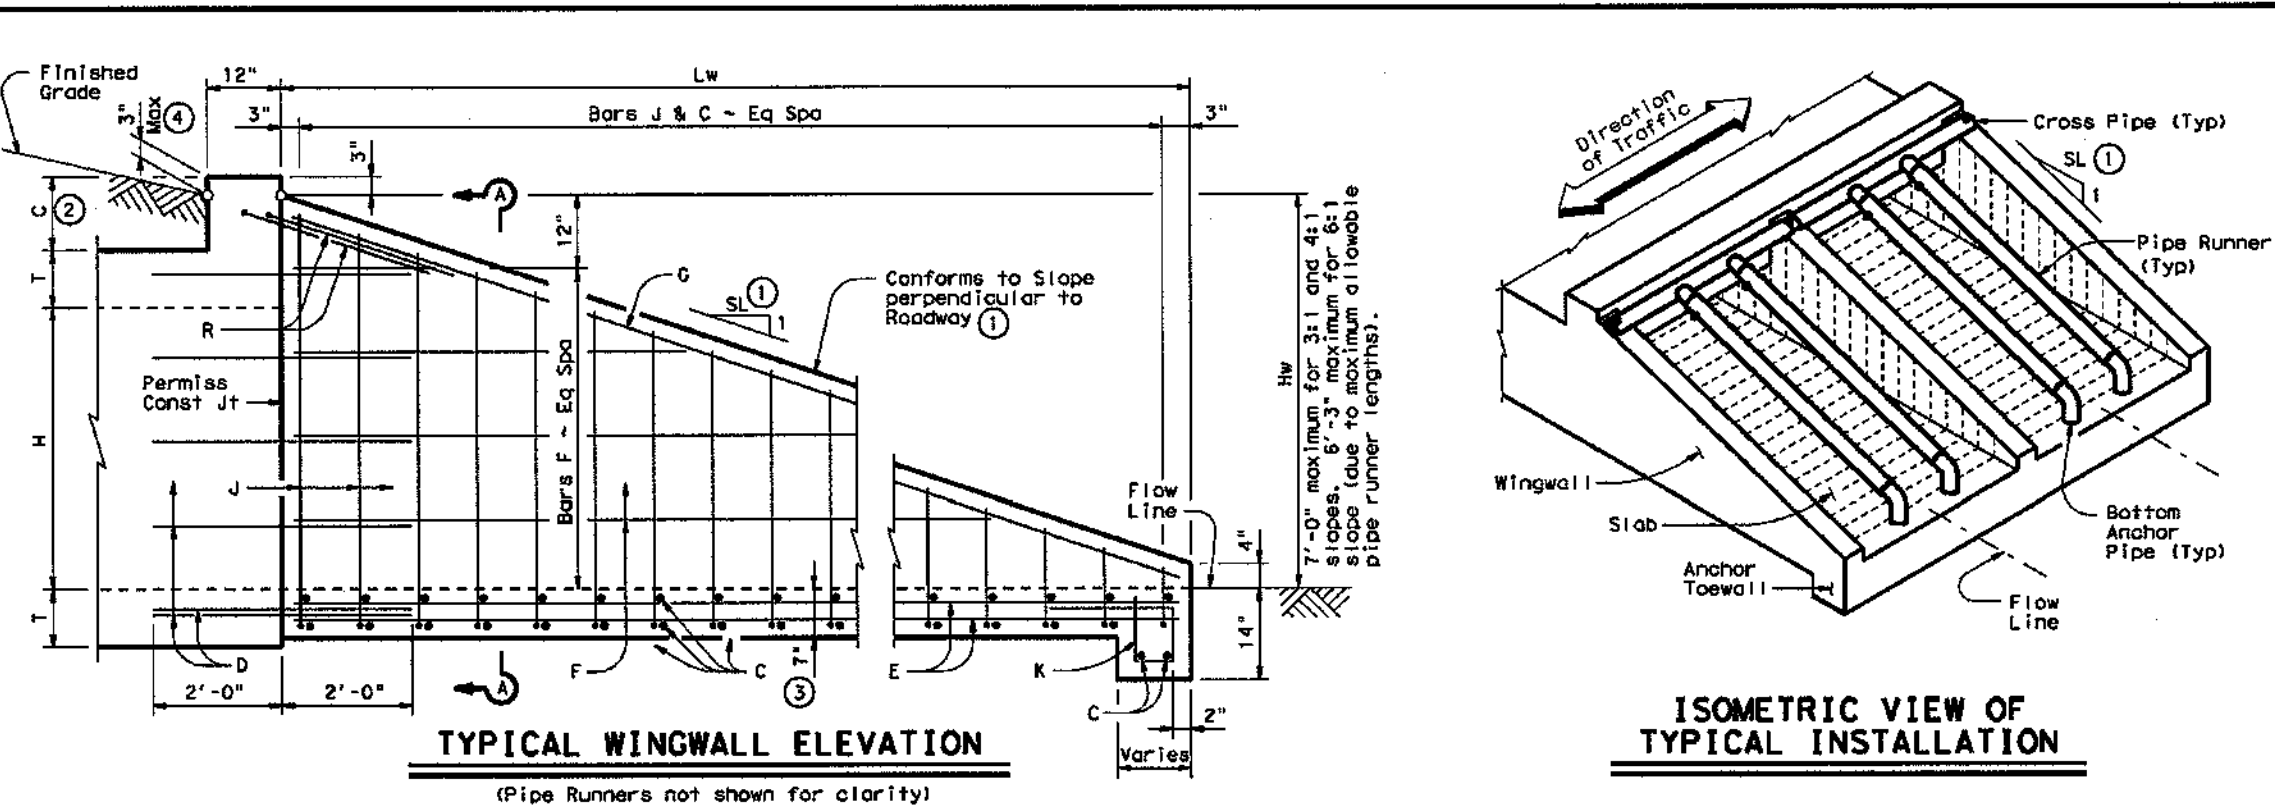

Formulas: (All values are in feet)
 $H_w = H + T + C - 0.250'$
 $L_w = (H_w - 0.333') (SL)$
For Cast-in-place culverts:
 $Atw = (N) (SL) + (N+1) (U)$
For Precast culverts:
 $Atw = (N) (2U+S) + (N+1) (0.500')$
Total Wingwall Area ($S.F.$)
 $= (L_w) (H_w + 0.333') (L_w) (N+1)$
Total Concrete Volume ($C.Y.$)
 $= (Wingwall Area) (0.583') + (L_w) (Atw) (0.583') + (Atw) (1.167') (1.167' - 0.583') + (27)$
Pipe Runner Length (L_w) ($K1$) $= (1.917')$
Total Reinforcing (Lbs)
 $= (1.250') (L_w) (Atw) + (4.43') (Atw) + (K2) (H_w) (N+1) (WEL)$
 C = Height of Curb above top of Top Slab
 H_w = Height of Wingwall
 K = Constant Value for use in formulas
Slope $SL:1$ $K1$ $K2$
 $3:1$ 1.054 7.45
 $4:1$ 1.031 8.49
 $6:1$ 1.014 10.30
 Atw = Anchor Towall Length
 L_w = Length of Wingwall
 N = Number of Culvert Boreis
 $SL:1$ = Side Slope Ratio (Horizontal : 1 Vertical)
See applicable box culvert standard for H , S , T , and U values.

GENERAL NOTES:
Designed according to current AASHTO Standard and Interim Specifications.
The Safety End Treatments shown herein are intended for use in those installations where out of control vehicles are likely to traverse the openings approximately perpendicular to the Pipe Runners.
Pipe Runners are designed for a traversing load of 1,800 pounds at yield as recommended by Research Report 280-1, "Safety Treatment of Roadside Cross-Drainage Structures", Texas Transportation Institute, March 1981.
All reinforcing steel shall be Grade 60. All reinforcing shall be adjusted as necessary to provide a minimum clear cover of $1\frac{1}{4}"$.
All concrete shall be Class "C" and shall have a minimum compressive strength of 3600 psi.
The quantities for Pipe Runners, reinforcing steel, and concrete, resulting from the formulas given herein are for Contractor's Information only.
Pipe Runners, Cross Pipes, and Anchor Pipes shall conform to the requirements of ASTM A53 Type E or F, Grade B, ASTM A500 (Grade B), or API 5LX52.
Bolts and nuts shall conform to ASTM A307. All steel components, except the concrete reinforcing, shall be galvanized after fabrication. Galvanizing done during transport or construction shall be repaired in accordance with the specifications.
See BCS standard sheet for additional dimensions and information.
Alternate design drawings bearing the seal of a professional engineer will be acceptable for precast construction of the Safety End Treatments.


SHEET 1 OF 2

Texas Department of Transportation
Bridge Division

SAFETY END TREATMENT FOR 0° SKEW BOX CULVERTS (MAXIMUM HW = 7'-0") TYPE 1 - CROSS DRAINAGE


SETB-CD

FILE	DATE	BY	CHK	APP	REV	DATE	BY	CHK	APP
SETB-CD	11/20/2015	JT	JT	JT	1				

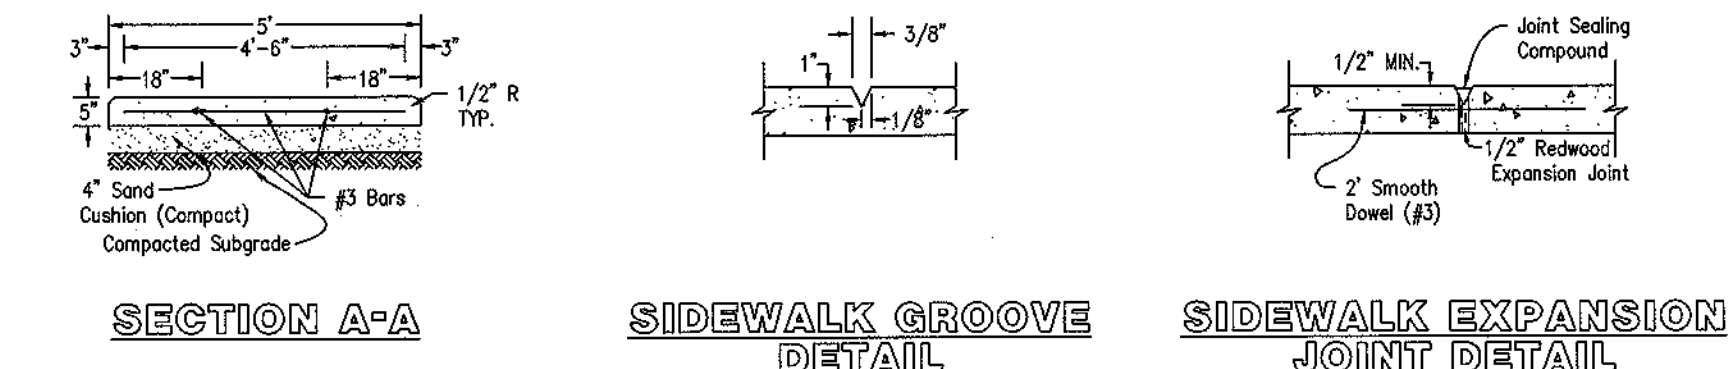

SIDEWALK NOTES:

- REQUIRED MIN. COMPRESSIVE STRENGTH OF CONC. = 3000 PSI @ 28 DAYS.
- A MIN. 4" SAND CUSHION SHALL BE PLACED ON A SUBGRADE COMPACTED TO 95% STD. PROCTOR DENSITY AND SAND SHALL BE COMPACTED TO 95% STD. PROCTOR DENSITY.
- FORMS SHALL BE SET TRUE TO LINE AND GRADE AND SHALL BE A MIN. OF 5'-1/2" DEEP.
- FORMS SHALL BE SET UP SO THAT NO CONCRETE MAY FLOW UNDER THEM.

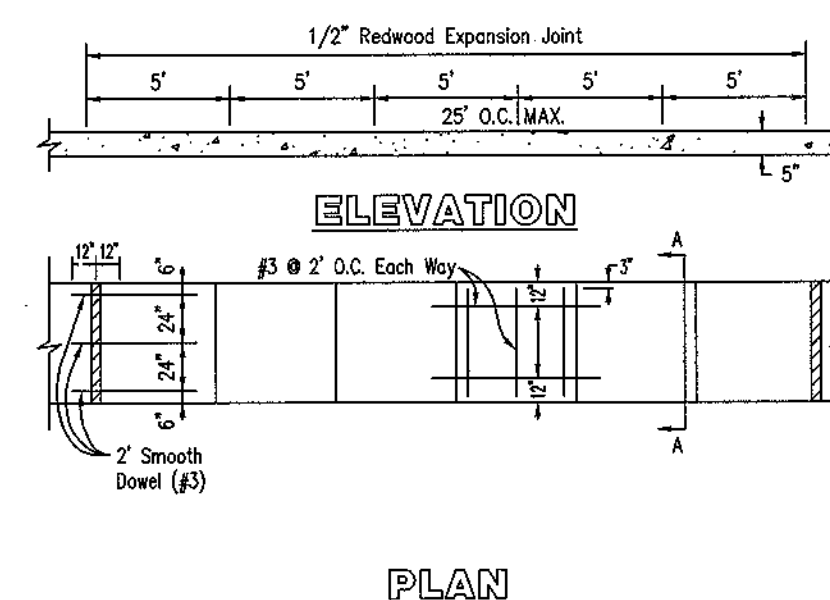

DETAIL OF SIDEWALK



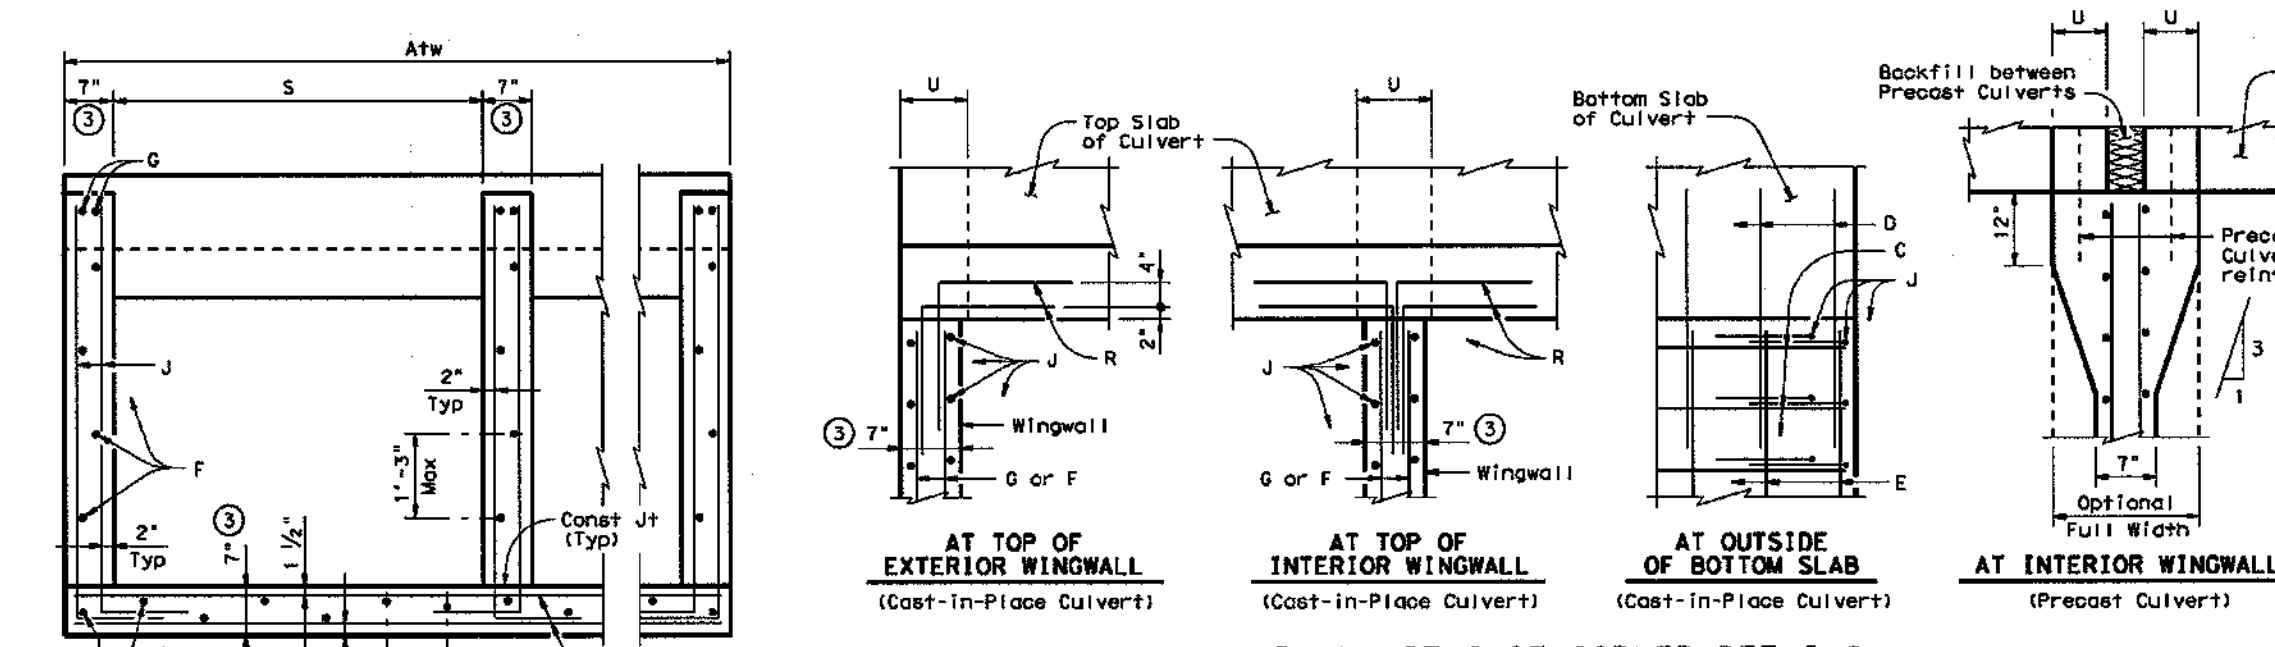


TABLE OF REINFORCING BAR SIZES & SPACING




Bar	Size	Spacing
C	#4	10" Max
D	#4	max F & E
E	#4	1'-0" Max
F	#4	1'-0" Max
G	#6	Shown
H	#4	1'-0" Max
I	#4	10" Max
J	#4	1'-0" Max
K	#4	1'-0" Max
L	#4	Shown

- Recommended values of slope are 3:1, 4:1, & 6:1. Slope shall be 3:1 or flatter.
- 0" min to 5'-0" max. Estimated curb heights are shown elsewhere in the plans. For structures without rolling and curbs taller than 1'-0", refer to ECD standard.
- Wingwall and slab thicknesses may be the same as the adjacent culvert wall and slab thicknesses (7" minimum). If thicknesses greater than the minimum (7") are used, no changes will be made in quantities and no additional compensation will be allowed.
- For vehicle safety, curbs shall project no more than 3" above finished grade. Curb heights shall be reduced, if necessary, to meet these requirements. Changes will be made in quantities and no additional compensation will be allowed for this work.
- For culverts with $C+0'$, the precast culvert reinforcing may extend 1'-0" minimum into Wingwall. Wingwall Bars D and R may be omitted. Otherwise, refer to the "Wingwall Connection Detail" on the SDP-WB standard.

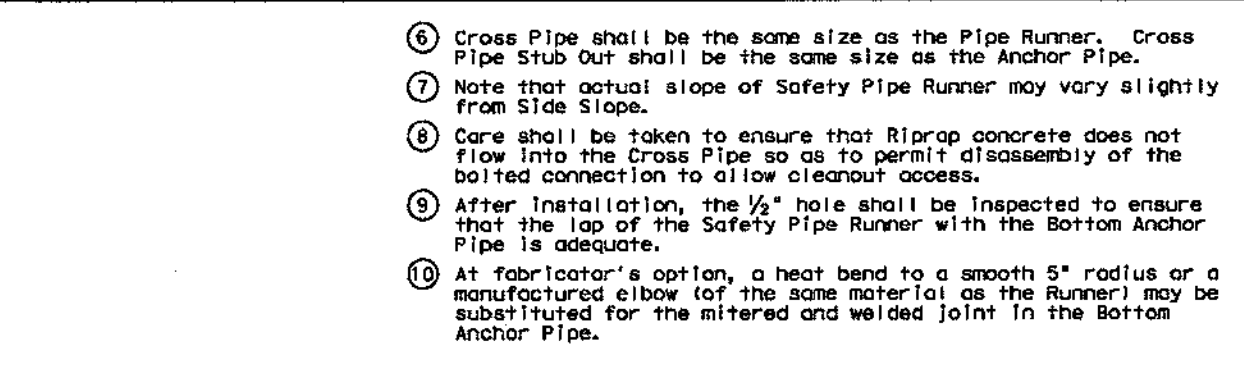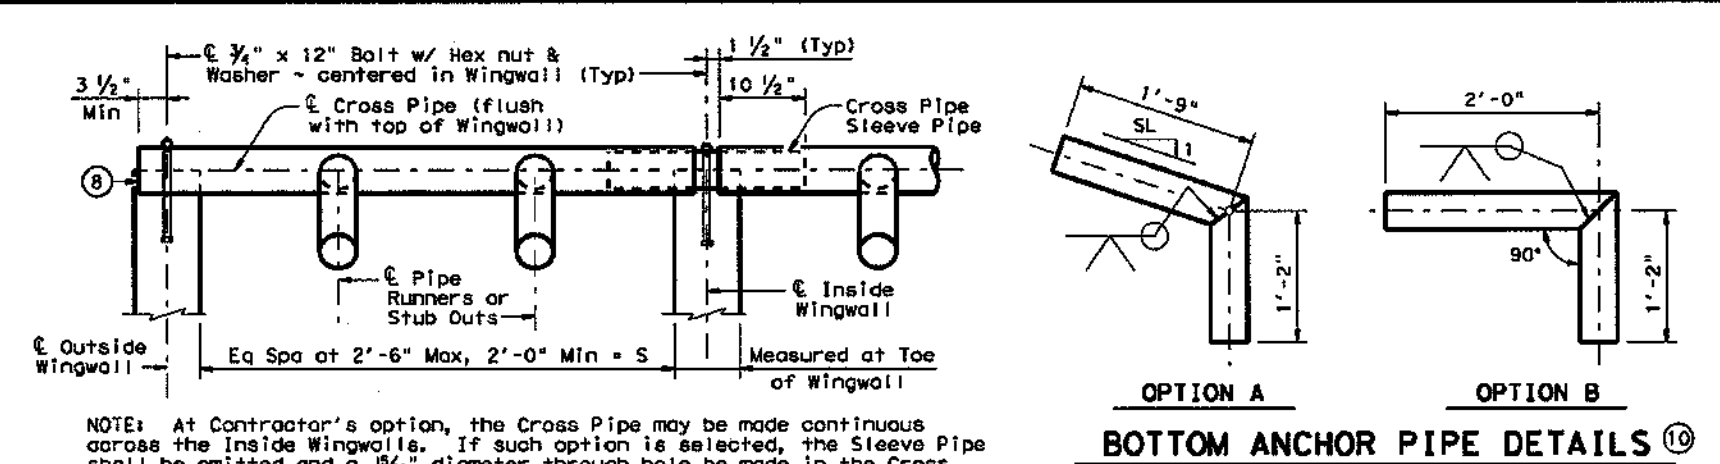

MAXIMUM PIPE RUNNER LENGTHS & REQUIRED PIPE RUNNER AND ANCHOR PIPE SIZES

Maximum Pipe Runner Length	Required Pipe Runner Size		Required Anchor Pipe Size	
	Pipe Size	Pipe O.D.	Pipe Size	Pipe O.D.
10'-0"	3" STD	3.500"	2" STD	2.375"
15'-0"	4" STD	4.500"	3" STD	3.500"
20'-0"	5" STD	5.563"	4" STD	4.500"

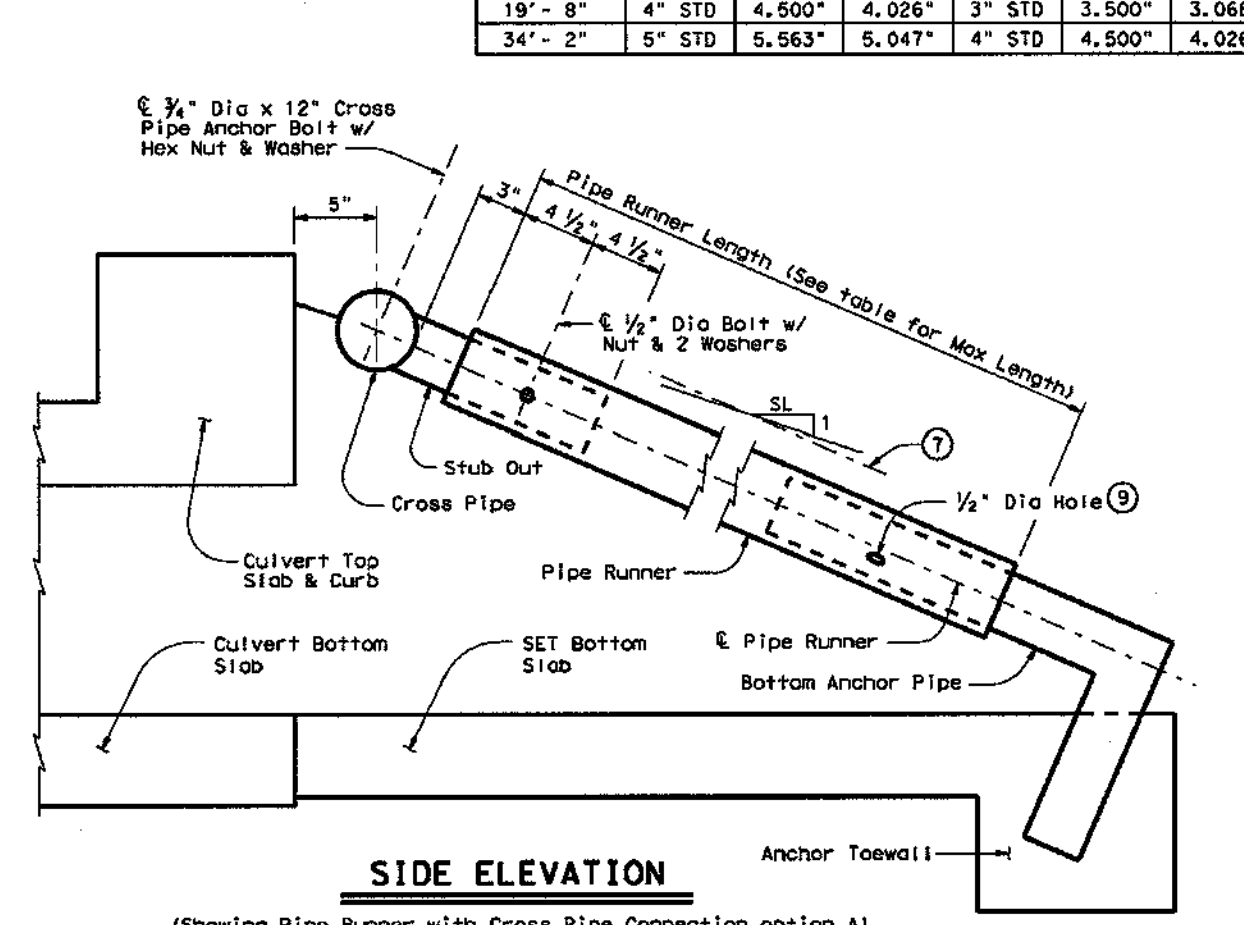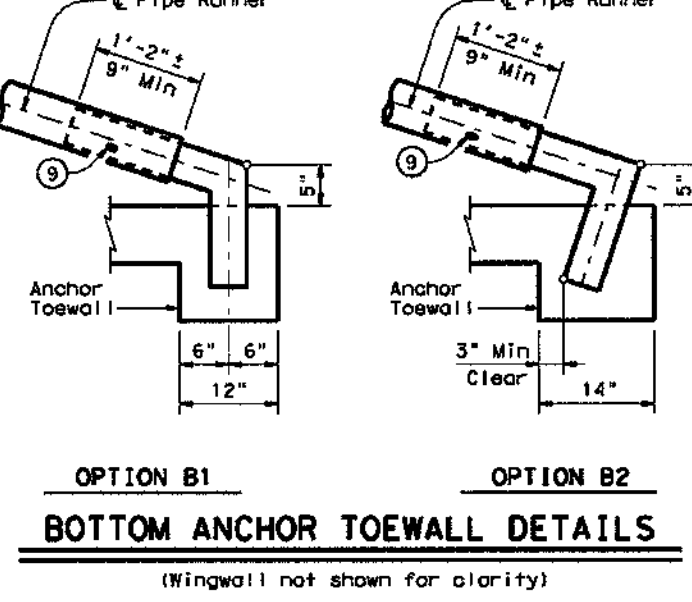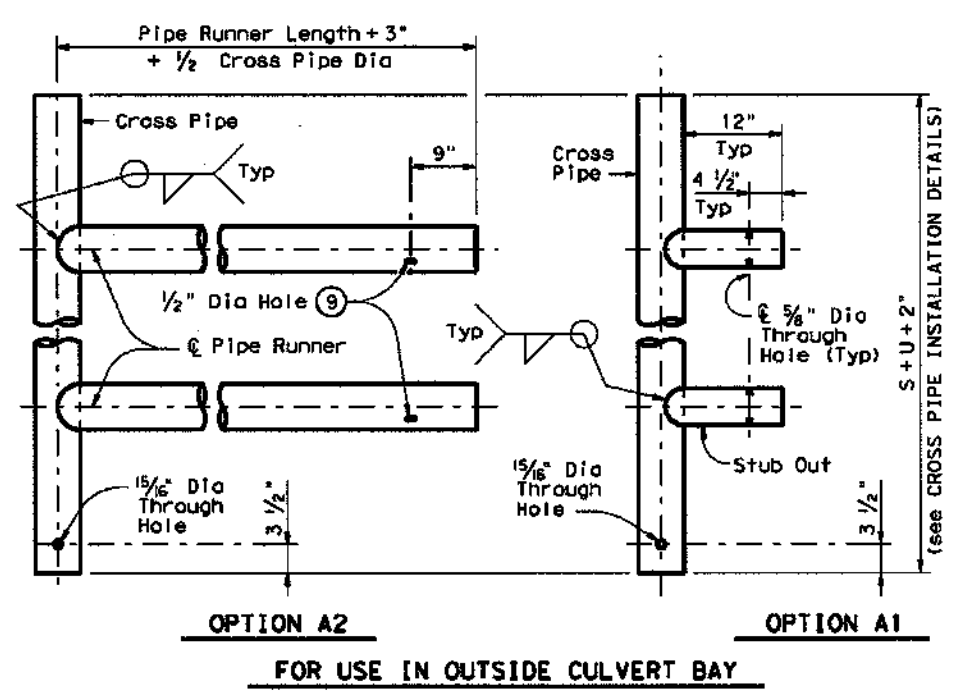

SHEET 2 OF 2

Texas Department of Transportation
Bridge Division

SAFETY END TREATMENT FOR 0° SKEW BOX CULVERTS (MAXIMUM HW = 7'-0") TYPE 1 - CROSS DRAINAGE

SETB-CD

FILE	DATE	BY	CHK	APP	REV	DATE	BY	CHK	APP
SETB-CD	11/20/2015	JT	JT	JT	1				

AS-BUILT RECORD DRAWING

THE INFORMATION ON THESE PLANS HAS BEEN REVISED TO REFLECT CHANGES TO PUBLIC IMPROVEMENTS MADE DURING CONSTRUCTION PROVIDED TO ENGINEER BY THE CONTRACTOR. UNLESS OTHERWISE NOTED, THE CONSTRUCTION OF THE PUBLIC IMPROVEMENTS IS IN GENERAL CONFORMANCE WITH THESE PLANS. THE RESPONSIBILITY FOR ACCURACY AND COMPLETENESS BELONGS TO THE CONTRACTOR.

Douglas W. Weaver
G & A Consultants, LLC.
Date: 11/23/2015

G&A CONSULTANTS, LLC.
TBPE F-7798

Drawn By: TJF
Date: 11/07/2014
Scale: 1" = 1'
Revisions:

OWNER/DEVELOPER
CADG LEWIS PARK LLC
C/O LENART DEVELOPMENT COMPANY, LLC
520 CENTRAL PARKWAY E. SUITE 104
PLANO, TX 75074
Ph: (972) 422-9880
Contact: Steve Lenart

14026

C33

LEWIS PARK ESTATES
Lot 1-16, 1-20, Block A, B
LEWIS PARK ESTATES
60,858 Acres
in the
JAMES ANDERSON SURVEY, ABSTRACT NO. 17
CITY OF LUCAS
COLLIN COUNTY, TEXAS

LEWIS PARK ESTATES
SITE PLANNING CIVIL ENGINEERING PLANNING
CONSULTANTS, LLC
LAND SURVEYING LANDSCAPE ARCHITECTURE
11111 Dallas Drive - Lewisville, TX 76067 - P: 972.438.9712 - F: 972.438.9716
611 Dallas Drive, Suite 114 - Rowlett, TX 75081 - P: 882.831.9712 - F: 817.880.4043
TBPE Firm No. 1798