


DEVELOPMENT PLANS FOR BARRATT LAKE ESTATES LUCAS, TEXAS

INDEX

1	TITLE
2	PLAT
3	PLAT
4	VAQUERO WAY (STA. 0+00 TO 12+00)
5	VAQUERO WAY (STA. 12+00 TO END)
6	VAQUERO WAY NORTH
7	DERBY DRIVE
8	COWBOY COURT
9	GRADING PLAN
10	GRADING PLAN
11	WATER PLAN
12	EXISTING CONDITIONS DRAINAGE AREA MAP
13	PROPOSED CONDITIONS DRAINAGE AREA MAP
14	STORM SEWER PLAN AND PROFILES LINES 'D-1', 'D-2' AND 'D-3'
15	STORM SEWER PLAN AND PROFILES LINE 'D-6'
16	NORTHWEST DETENTION POND PLAN
17	NORTHEAST DETENTION POND PLAN
18	SOUTHEAST DETENTION POND PLAN
19	SIGNAGE AND STREET LIGHT PLAN
20	EROSION CONTROL PLAN
21	STANDARD DETAILS

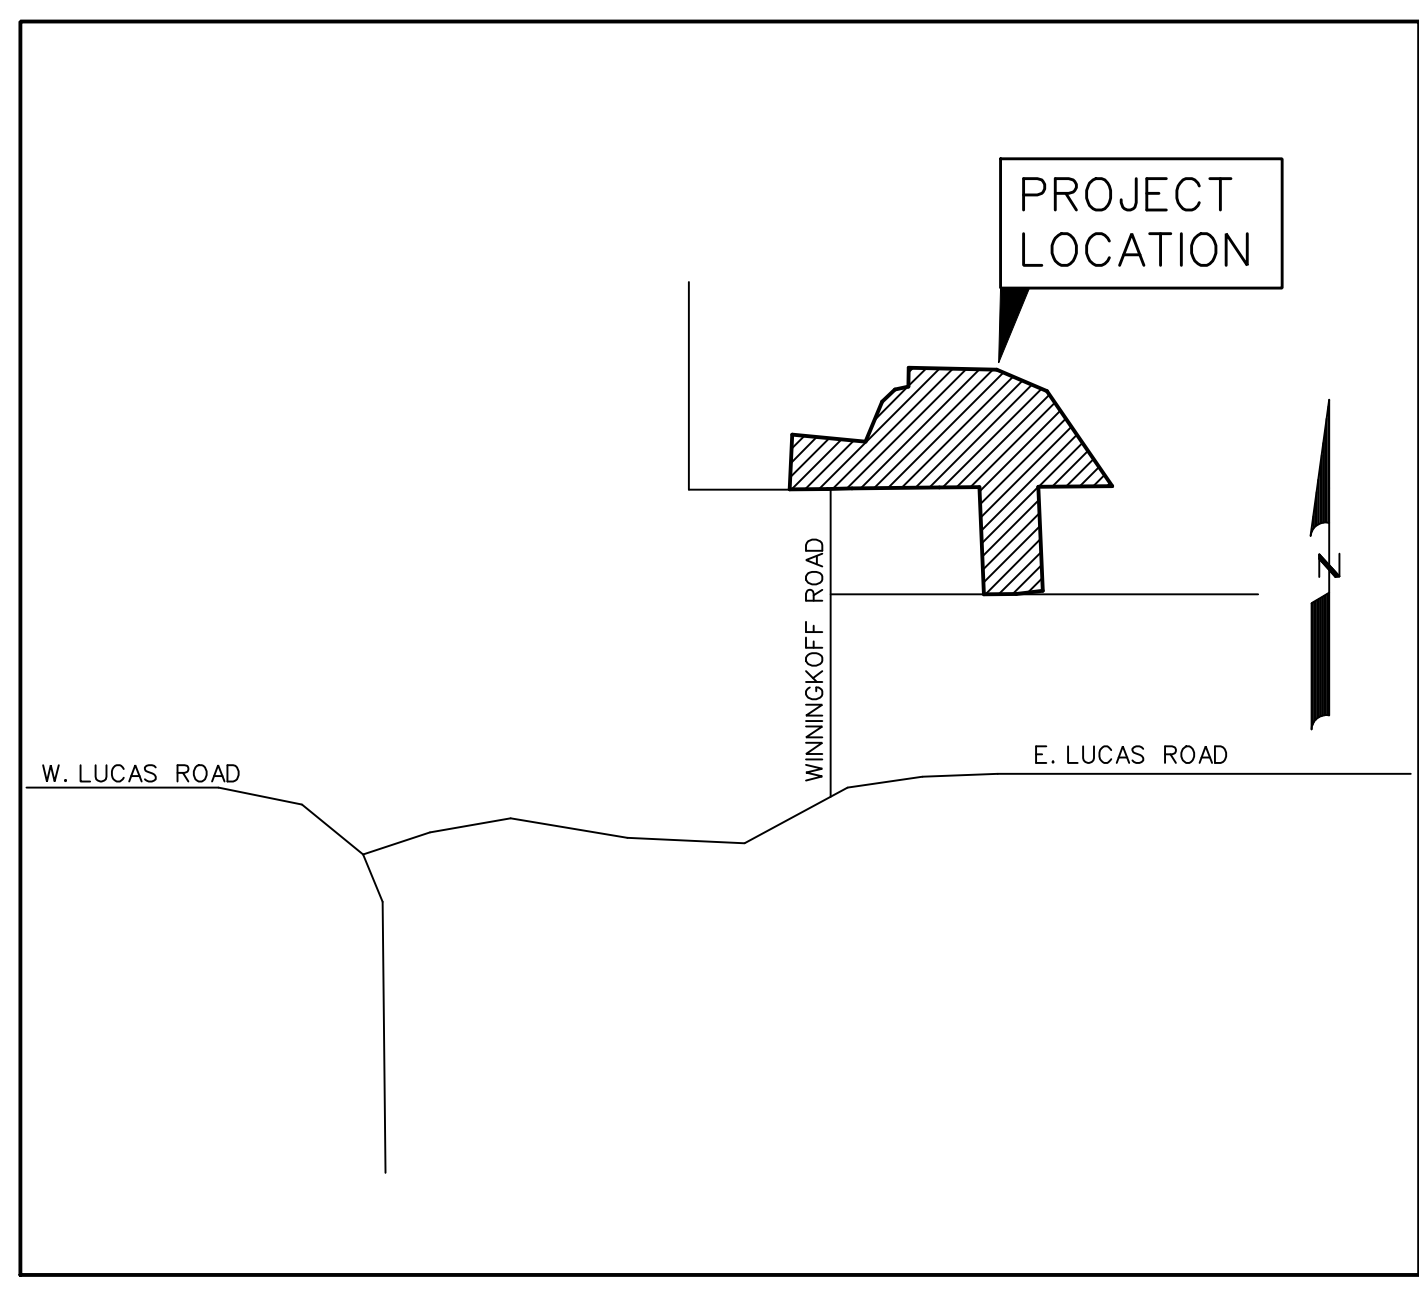

LOCATION MAP

PREPARED FOR
BARRATT LAKES ESTATE, LLC.

P.O. BOX 863264
PLANO, TEXAS 75086

CORWIN ENGINEERING, INC. — CONSULTING ENGINEERS

200 W. BELMONT, SUITE E


TBPE FIRM #5951

ALLEN, TEXAS 75013



AS-BUILT FEBRUARY 2023
INFORMATION PROVIDED BY
CONTRACTORS AND DEVELOPER
(NOT FIELD VERIFIED)

NO.	REVISIONS	DATE

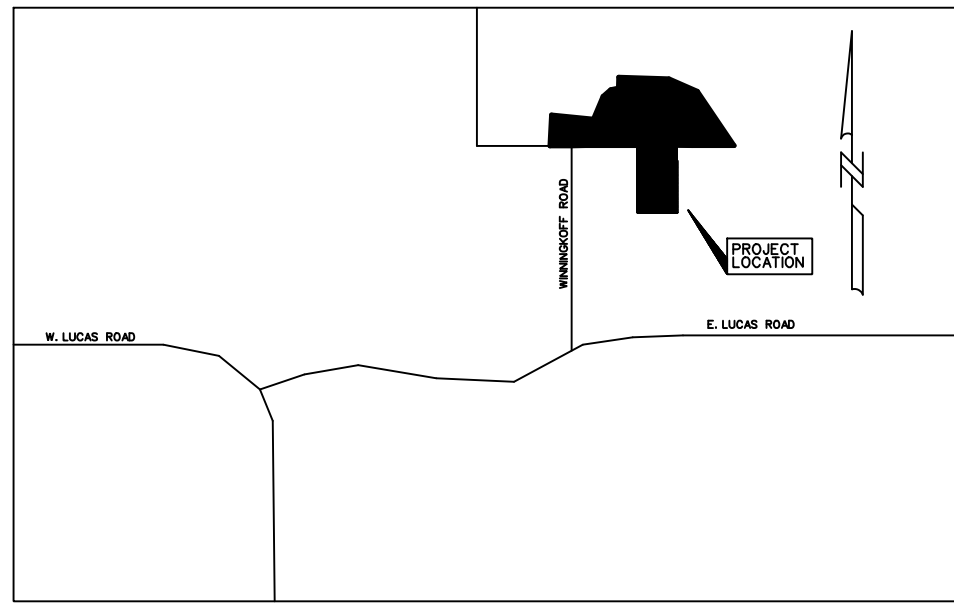


VICINITY MAP
Scale: NTS

0 50 100 200
SCALE: 1" = 100'



LOT 3, BLOCK A
RICHARD RIZOS
ROLLING HILLS ESTATES
VOL. H, PG. 10

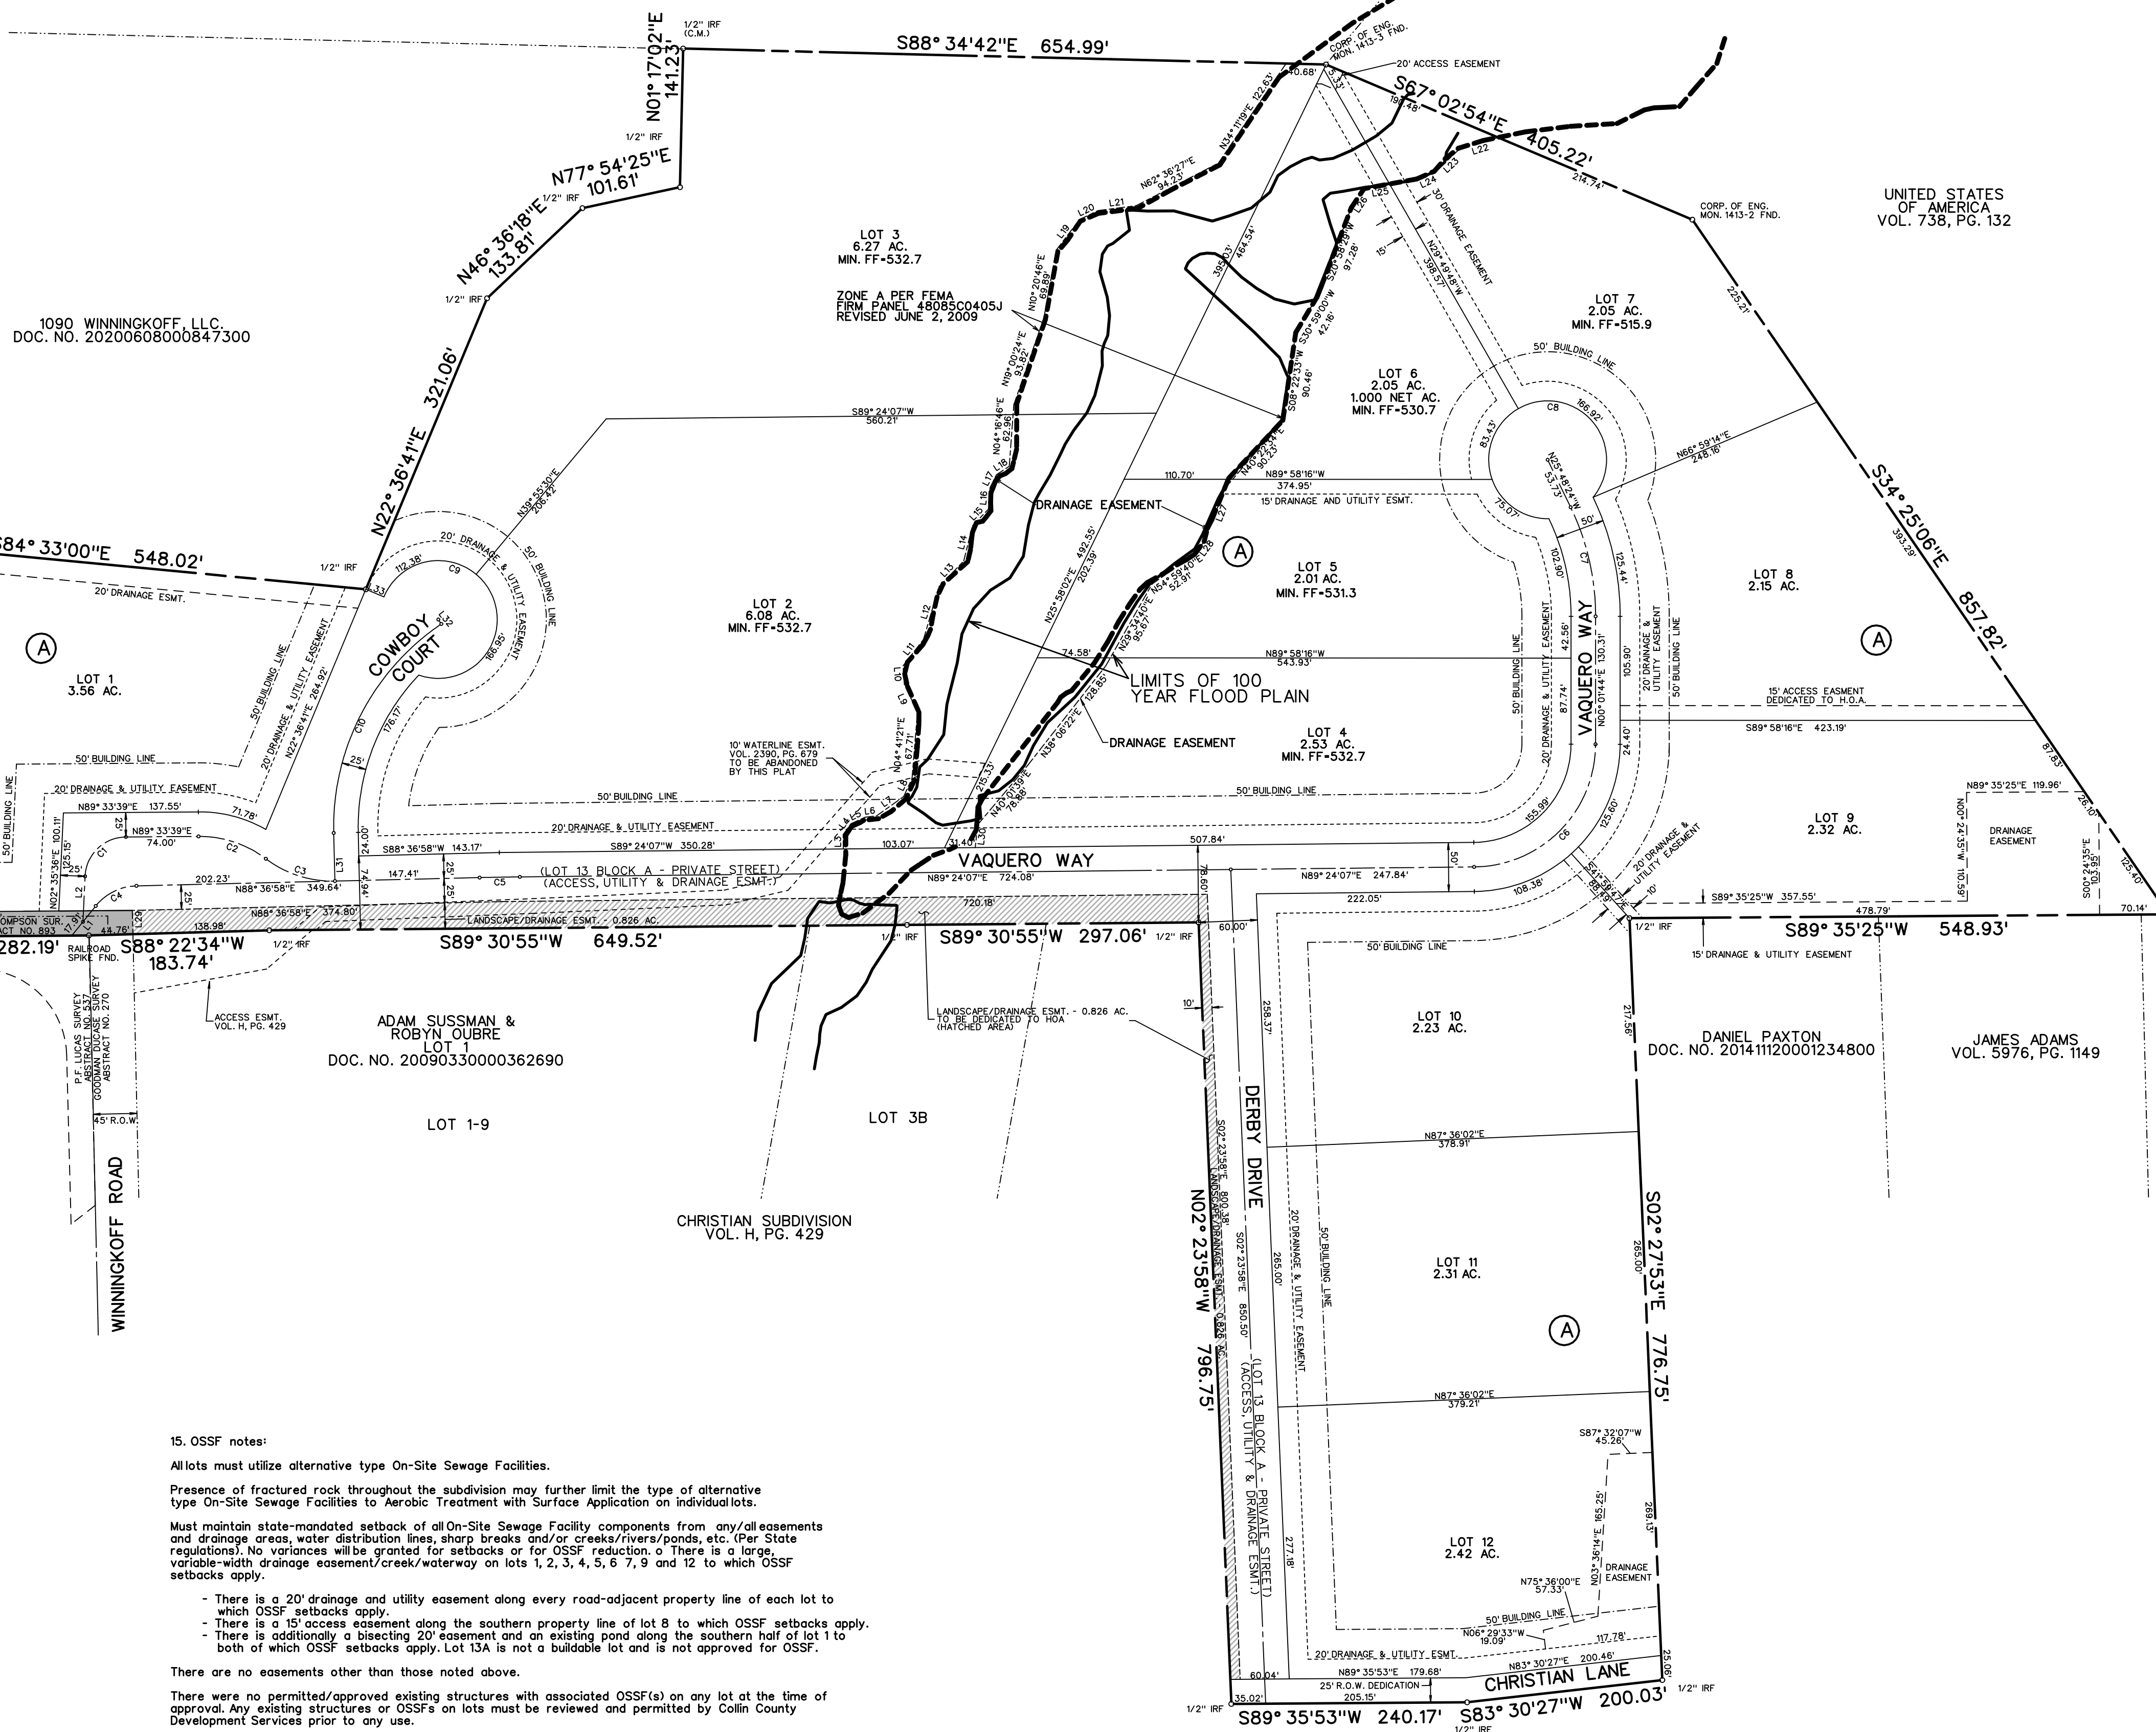

CURVE TABLE

CURVE NO.	DELTA	RADIUS	LENGTH	CHORD	BEARING
C1.	86°58'03"	42.00'	63.75'	57.80'	N46°04'37"E
C2.	37°37'21"	112.00'	73.54'	73.23'	S71°37'41"E
C3.	38°34'01"	112.00'	75.38'	73.97'	S72°06'01"E
C4.	49°46'50"	55.00'	41.79'	46.30'	N63°45'33"E
C5.	00°47'09"	2988.00'	40.99'	40.99'	N89°00'33"E
C6.	89°22'33"	125.00'	194.98'	175.81'	N44°42'56"E
C7.	25°50'08"	255.00'	114.98'	114.01'	N12°53'20"W
C8.	49°14'56"	60.00'	325.42'	50.00'	N64°11'41"E
C9.	268°44'11"	60.00'	279.33'	87.23'	N24°01'13"W
C10.	57°14'22"	250.00'	249.75'	239.50'	N27°14'09"E

LINE TABLE

LINE NO.	BEARING	DISTANCE
1.	N 38°50'08" E	38.62'
2.	N 02°35'36" E	46.40'
3.	N 00°35'53" W	14.71'
4.	N 36°17'06" E	13.56'
5.	N 65°12'33" W	15.96'
6.	N 33°24'48" W	11.67'
7.	N 54°37'06" E	33.91'
8.	N 24°35'03" W	20.36'
9.	N 25°05'09" W	31.62'
10.	N 03°58'11" W	18.62'
11.	N 37°53'36" E	34.01'
12.	N 16°05'48" E	55.48'
13.	N 43°44'22" E	36.93'
14.	N 13°51'21" E	114.62'
15.	N 43°51'15" E	23.69'
16.	N 04°07'10" W	22.05'
17.	N 26°32'55" W	14.62'
18.	N 56°53'47" E	15.60'
19.	N 37°09'54" W	39.17'
20.	N 64°00'05" E	20.99'
21.	N 82°43'33" W	39.27'
22.	S 73°02'23" W	41.72'
23.	S 46°40'43" W	33.67'
24.	S 65°33'05" W	20.21'
25.	S 80°56'51" W	54.60'
26.	S 33°39'31" W	23.41'
27.	S 21°41'45" W	58.70'
28.	S 36°13'21" W	16.24'
29.	N 01°18'48" W	24.08'
30.	S 06°31'35" W	23.60'
31.	N 01°23'02" E	43.00'
32.	S 34°08'40" W	5.47'
33.	N 67°23'19" W	20.00'

NOTES

- Bearing are referenced to a 14.985 acre tract, as recorded in Doc. No. 20210114000088080, in the Deed Records of Collin County, Texas.
- All lot lines are radial or perpendicular to the street unless otherwise noted by bearing.
- 1/2" iron rods with "CORWIN ENGR. INC." caps set at all boundary corners, block corners, points of curvature, points of tangency, and angle points in public right-of-way unless otherwise noted.
- "Notice: Selling a portion of this addition by metes and bounds is a violation of city ordinance and state law and is subject to fines and withholding of utilities and building permits."
- Lots or portions of lots within the floodplain or areas of special flood hazard as depicted on FEMA FIRM Panel 48065C0405J, Revised June 2, 2009, require a development permit prior to issuance of a building permit or commencement of construction including site grading, on all or part of those lots.
- Access to Christian Lane is limited to emergency access only.
- Private streets are dedicated to and maintained by the Homeowners Association (H.O.A.).
- All lots must utilize alternative type On-Site Sewage Facilities.
- Must maintain state-mandated setback of all On-Site Sewage Facility components from any/all easements and drainage areas.
- Final grading, per the grading plan, will be required prior to installation/operation of On-Site Sewage Facilities.
- Individual site evaluations and OSSF design plans must be submitted to and approved by Collin County for each lot prior to construction of any OSSF system.
- All drainage easements shall be owned/maintained by the HOA.
- All landscape easements shall be maintained by the HOA.
- Lot 1 driveways shall only connect to Cowboy Court. Lot 1 has no access to Winningkoff Road nor Vaquero Way.

15. OSSF notes:

All lots must utilize alternative type On-Site Sewage Facilities.
 Presence of fractured rock throughout the subdivision may further limit the type of alternative type On-Site Sewage Facilities to Aerobic Treatment with Surface Application on individual lots.
 Must maintain state-mandated setback of all On-Site Sewage Facility components from any/all easements and drainage areas, water distribution lines, sharp breaks and/or creeks/streams/ponds, etc. (Per State regulations). No variances will be granted for setbacks or for OSSF reduction. There is a large, variable-width drainage easement/creek/waterway on lots 1, 2, 3, 4, 5, 6, 7, 9 and 12 to which OSSF setbacks apply.
 - There is a 20' drainage and utility easement along every road-adjacent property line of each lot to which OSSF setbacks apply.
 - There is a 15' access easement along the southern property line of lot 8 to which OSSF setbacks apply.
 - There is additionally a bisecting 20' easement and an existing pond along the southern half of lot 1 to both of which OSSF setbacks apply. Lot 13A is not a buildable lot and is not approved for OSSF.
 There are no easements other than those noted above.
 There were no permitted/approved existing structures with associated OSSF(s) on any lot at the time of approval. Any existing structures or OSSF(s) on lots must be reviewed and permitted by Collin County Development Services prior to any use.
 A portion of lots 2, 3, 4, 5, 6 and 7 is located within the 100-year flood plain: a Any OSSF that is located within the 100-year flood plain may be subject to special planning requirements or may be restricted from being within the flood plain.
 - Any future structures and OSSF's must follow Flood Plain regulations in effect at the time of permitting.
 - A pre-planning meeting with RS/PE and Development Services is recommended prior to any development planning.
 Tree removal and/or grading for OSSF may be required on individual lots.
 There are no water wells noted in this subdivision and no water wells are allowed without prior approval from Collin County Development Services.
 Each lot is limited to a maximum of 5,000 gallons of treated/disposed sewage each day.
 Individual site evaluations and OSSF design plans (meeting all State and County requirements) must be submitted to and approved by Collin County for each lot prior to construction of any OSSF system.

FINAL PLAT
BARRATT LAKE ESTATES
 LOTS 1-13 BLOCK A
 OUT OF THE
 JOHN THOMPSON SURVEY ABSTRACT NO. 893
 GOODMAN DUCASE SURVEY, ABSTRACT NO. 270
 IN THE
 CITY OF LUCAS
 COLLIN COUNTY, TEXAS
 ZONING: R-2
 OWNER
BARRATT LAKE ESTATES, LLC.
 PO BOX 863264
 PLANO, TEXAS 75086
 PREPARED BY
CORWIN ENGINEERING, INC.
 TBPELS FIRM #5951
 200 W. BELMONT, SUITE E
 ALLEN, TEXAS 75013
 972-396-1200
 FEBRUARY 2023 SCALE: 1"=100'
SHEET 1 OF 2

TOTAL RESIDENTIAL LOTS **12**
 TOTAL ACRES **41.512**

NOW, THEREFORE, KNOW ALL MEN BY THESE PRESENTS:

THAT BARRATT LAKE ESTATES, LLC., acting herein by and through its duly authorized officers, does hereby certify and adopt this final plat designating the herein above described property as BARRATT LAKES ESTATES, an addition to the City of Lucas. The streets shown on this plat as access easements are for the use and benefit of the owners of the property in this subdivision, their leaseses, invitees and licensees. By acceptance of a deed conveying title to any lot in this subdivision, the owner thereof shall be deemed to have agreed and acknowledged and does certify the following:

1. The streets are private streets and are dedicated to the City of Lucas as Access, Utility, and Drainage Easements. The City has no responsibility or liability to make any repairs to such streets as long as they are private streets, except repairs made necessary by reason of installation, repair or replacement of municipal utilities located therein or in the utility easements adjacent thereto.

2. So long as such streets are private, the sole responsibility for maintenance and replacement thereof shall be borne by the owners of the lots in this subdivision and/or any homeowners' association hereafter established for the owners of lots in this subdivision (the "Association"). Such maintenance and replacement shall be in conformance with the requirements, standards, and specifications of the City of Lucas, as presently in effect or as same may be hereafter amended. This provision may be enforced by specific performance or by any other remedy allowed by law.

3. Neither the property owners within this subdivision nor the Association nor any other association or other organization or entity representing them shall have the right to request dedication (whether by voluntary or involuntary act or omission) of such private streets to the City unless and until the City has inspected such streets and determined that, at the time in question, they meet the City's standards. If the City desires to accept a dedication of said streets, the Association, its successors or assigns, or the owners of the lots in the subdivision will make, at the owners' or the Association's expense, all repairs required by the City to comply with then City standards. The City shall have sole discretion to accept or reject a proposed dedication of the private streets to the City. Before dedication, all public improvements and dedications shall be free and clear of all debt, liens, and/or encumbrances.

4. The easements and public use areas, as shown, are dedicated for the benefit of the owners of the property in this subdivision, their leasees, invitees and licensees use forever, for the purposes indicated on this plat.

5. The provisions hereof shall be binding upon and enforceable against all property owners in this subdivision, their successors and assigns and the Association and its successors and assigns. The provisions hereof may be enforced by the City, any property owner in the subdivision, and/or the Association.

6. These covenants and restrictions shall run with the land and be binding on the owners of the property in this subdivision, their successors and assigns, the Association, its successors and assigns and all parties claiming by, through and under them. In the event a replat is requested on all or part of this property, the City may require any similar or additional restrictions and covenants in its sole discretion. These covenants and restrictions shall terminate when all the access easements shown on this plat are included within a replat of all or part of this property and are dedicated to the City as public streets and alleys. In addition, all modifications to this document shall be by means of plat and approved by the City of Lucas.

7. If the owners of the property in this subdivision should open the private streets to the public, such use shall be considered a temporary license only. The owners of property in this subdivision through the Association reserve the right to close the street to the public at any time prior to formal dedication of the street to the public, and acceptance of the same by the City.

8. The owners of property in this subdivision and the Association shall allow access to the subdivision and the streets in the subdivision to all City employees and contractors acting on behalf of the City and all governmental service vehicles, including, without limitation, law enforcement, fire, ambulance, sanitation, inspection and health vehicles. In addition, Utility Easements may also be used for the mutual use and accommodation of all public utilities desiring to use or using the same unless the easement limits the use to particular utilities, said use by public utilities being subordinate to the City's use thereof. The City of Lucas and public utilities shall, at all times, have the full right of ingress and egress to or from their respective easements for the purpose of constructing, reconstructing, inspecting, patrolling, maintaining, reading meters, and adding to or removing all or parts of their respective systems without the necessity of procuring permission from anyone.

9. The owners of property within this subdivision hereby agree and recognize that the entire subdivision is benefited by the City allowing the owners to maintain and control access to the private streets shown hereon, and that the City is benefited by having the value of the property enhanced for ad valorem tax purposes and not being under any maintenance obligations with respect to the private streets and alleys. For purposes of enforcement of these covenants, the benefits shall constitute sufficient and valid consideration.

10. The owner of each lot affected by a drainage easement across the rear portion of such lot may not construct any improvements within such lot except those improvements which (a) do not impeded the natural flow of water across the property affected by such drainage easement (such as swimming pools and open fences) and (b) are built in accordance with and pursuant to a building permit issued by the City. In no event shall BARRATT LAKES ESTATES, LLC., the City, the Association or any of their successors or assigns have any liability for any improvements built in any drainage or utility easement. Each lot owner shall build in such area at his or her own risk and shall indemnify BARRATT LAKES ESTATES, LLC., the City, the Association and their successors and assigns against any and all losses, damages and liability arising out of or associated with the construction of improvements on such owner's lot in any drainage or utility easement.

11. No buildings, fences, trees, shrubs or other improvements or growths shall be constructed or placed upon, over or across the easements as shown, except that landscape improvements may be placed in Landscape Easements, if approved by the HOA. Landscaping may be placed in/ or near other easements with city approval. The City and public utility entities shall have the right to remove and keep removed all or parts of any buildings, fences, trees, shrubs or other improvements or growths which may in any way endanger or interfere with the construction, maintenance, or efficiency of their respective systems in said easements. The City of Lucas is not responsible for replacing any improvements in, under, or over any easements caused by maintenance or repair.

12. Invalidation of any word, phrase, sentence, paragraph, covenant or restriction by court judgment or otherwise, shall not affect the validity of the other covenants or restrictions contained herein.

This plat approved subject to all platting ordinances, rules, regulations and resolutions of the City of Lucas, Texas.

WITNESS, my hand, this the ____ day of _____, 2023.

BY:

Stephen Dinapoli
President

THE STATE OF TEXAS
COUNTY OF COLLIN

BEFORE ME, the undersigned, a Notary Public for the State of Texas, on this day personally appeared STEPHEN DINAPOLI, known to me to be the person whose name is subscribed to the foregoing instrument and acknowledged to me that the same is his act and deed in the capacity therein stated and for the purposes and considerations therein expressed.

WITNESS MY HAND AND SEAL OF OFFICE, this the ____ day of _____, 2023.

NOTARY PUBLIC, STATE OF TEXAS

LEGAL DESCRIPTION

WHEREAS, BARRATT LAKE ESTATES, LLC., is the owner of a tract of land situated in the John Thompson Survey, Abstract No. 893 and Goodman Ducase Survey, Abstract No. 270, being all of a 14.985 acre tract and a 14.088 acre tract, as described in Doc. No. 20210114000088080 in the Deed Records of Collin County, Texas, and a 4.417 acre tract, as described in 20210107000041130 in said Deed Records and a 8.0 acre tract, as described in Doc. No. 202104080007053300 in said Deed Records and being more particularly described as follows:

BEGINNING, at a PK nailset at the southwest corner of said 4.417 acre tract being in Winningkoff Road (Variable R.O.W.);

THENCE, North 02° 37' 29" East, along the west line of said 4.417 acre tract, for a distance of 407.18 feet, to a 1/2 inch iron rod found at the northwest corner of said 4.417 acre tract;

THENCE, South 84° 33' 00" East, along the north line of said 4.417 acre tract, for a distance of 548.02 feet, to a 1/2 inch iron rod found at the northeast corner of said 4.417 acre tract and being in the west line of said 14.088 acre tract;

THENCE, North 22° 36' 41" East, along the west line of said 14.088 acre tract, for a distance of 321.06 feet, to a 1/2 inch iron rod found;

THENCE, North 46° 36' 18" East, continuing along said west line, for a distance of 133.81 feet, to a 1/2 inch iron rod found;

THENCE, North 77° 54' 25" East, continuing along said west line, for a distance of 101.61 feet, to a 1/2 inch iron rod found;

THENCE, North 01° 17' 02" East, continuing along said west line, for a distance of 141.23 feet, to a 1/2 inch iron rod found at the northwest corner of said 14.088 acre tract;

THENCE, South 88° 34' 42" East, along the north line of said 14.088 acre tract, for a distance of 654.99 feet, to a Corp. of Engineer Monument stamped 1413-3 found at the northeast corner of said 14.088 acre tract and the northwest corner of said 14.985 acre tract;

THENCE, South 67° 02' 54" East, along the north line of said 14.985 acre tract, for a distance of 405.22 feet, to a Corp. of Engineer Monument stamped 1413-2 found;

THENCE, South 34° 25' 06" East, continuing along said north line, for a distance of 857.82 feet, to a Corp. of Engineer Monument Stamped 1413-1 found, at the most easterly corner of said 14.985 acre tract;

THENCE, South 89° 35' 25" West, along the south line of said 14.985 acre tract, for a distance of 548.93 feet, to a 1/2 inch iron rod found at the northeast corner of said 8.0 acre tract;

THENCE, South 02° 27' 53" East, departing said south line and with the east line of said 8.0 acre tract, for a distance of 776.75 feet, to a 1/2 inch iron rod found at the southeast corner of said 8.0 acre tract;

THENCE, South 83° 30' 27" West, along the south line of said 8.0 acre tract, for a distance of 200.03 feet, to a 1/2 inch iron rod found;

THENCE, South 89° 35' 53" West, continuing along said south line, for a distance of 240.17 feet, to a 1/2 inch iron rod found at the southwest corner of said 8.0 acre tract;

THENCE, North 02° 23' 58" West, along the west line of said 8.0 acre tract, for a distance of 796.75 feet, to a 1/2 inch iron rod found at the northwest corner of said 8.0 acre tract being in south line of said 14.985 acre tract;

THENCE, South 89° 30' 55" West, along the south line of said 14.985 acre tract, for a distance of 297.06 feet, to a 1/2 inch iron rod found at the southwest corner of said 14.985 acre tract and being the southeast corner of said 14.088 acre tract;

THENCE, South 89° 30' 55" West, along the south line of said 14.088 acre tract, for a distance of 649.52 feet, to a 1/2 inch iron rod found;

THENCE, South 88° 22' 34" West, continuing along said south line, for a distance of 183.74 feet, to a Railroad spike found at the southwest corner of said 14.088 acre tract and being the southeast corner of said 4.417 acre tract;

THENCE, South 89° 33' 39" West, along the south line of said 4.417 acre tract, for a distance of 282.19 feet, to the POINT OF BEGINNING and containing 41.512 acres of land.

SURVEYOR'S CERTIFICATE

I, WARREN L. CORWIN, a registered Professional Land Surveyor in the State of Texas, do hereby certify that I prepared this plat from actual and accurate survey of the land and that the corner monuments shown thereon were properly placed, under my personal supervision, in accordance with the subdivision regulations of the City of Lucas, Texas.

THE STATE OF TEXAS
COUNTY OF COLLIN

Before me, the undersigned, a Notary Public in and for the State of Texas, on this day personally appeared WARREN L. CORWIN, known to me to be the person whose name is subscribed to the foregoing instrument, and acknowledged to me that he executed same for the purpose and consideration therein expressed.

Given under my hand and seal of office, this ____ day of _____, 2023.

NOTARY PUBLIC, STATE OF TEXAS

This plat is hereby approved by the Planning and Zoning Commission of the City of Lucas, Texas

Chairman, Planning and Zoning Commission
Dusty Kuykendall

Date

ATTEST:

Signature

Date

Name & Title

The Director of Public Works of the City of Lucas, Texas hereby certifies that to the best of his/her knowledge or belief, this subdivision plat conforms to all requirements of the Code of Ordinances and with engineering construction standards and processes adopted by the City of Lucas, Texas as to which his/her approval is required.

Director of Public Works
Scott Holden

Date

The Development Services Director of the City of Lucas, Texas hereby certifies that to the best of his/her knowledge or belief, this subdivision plat conforms to all requirements of the Code of Ordinances, or as may have been amended or modified, as allowed, by the Planning and Zoning Commission as to which his/her approval is required.

Development Services Director
Joseph Hilbourn


Date

Health Department Certification:

I, as a representative of Collin County Development Services, do hereby certify that the on-site sewage facilities described on this plat conform to the applicable OSSF laws of the State of Texas, that site evaluations have been submitted representing the site conditions in the area in which on-site sewage facilities are planned to be used.



Designated Representative for Collin County Development Services

FINAL PLAT
BARRATT LAKE ESTATES
LOTS 1-13 BLOCK A
OUT OF THE
JOHN THOMPSON SURVEY ABSTRACT NO. 893
GOODMAN DUCASE SURVEY, ABSTRACT NO. 270
IN THE
CITY OF LUCAS
COLLIN COUNTY, TEXAS
ZONING: R-2
OWNER
BARRATT LAKE ESTATES, LLC.
PO BOX 863264
PLANO, TEXAS 75086
PREPARED BY
CORWIN ENGINEERING, INC.
TBPELS FIRM #5951
200 W. BELMONT, SUITE E
ALLEN, TEXAS 75013
972-396-1200
FEBRUARY 2023

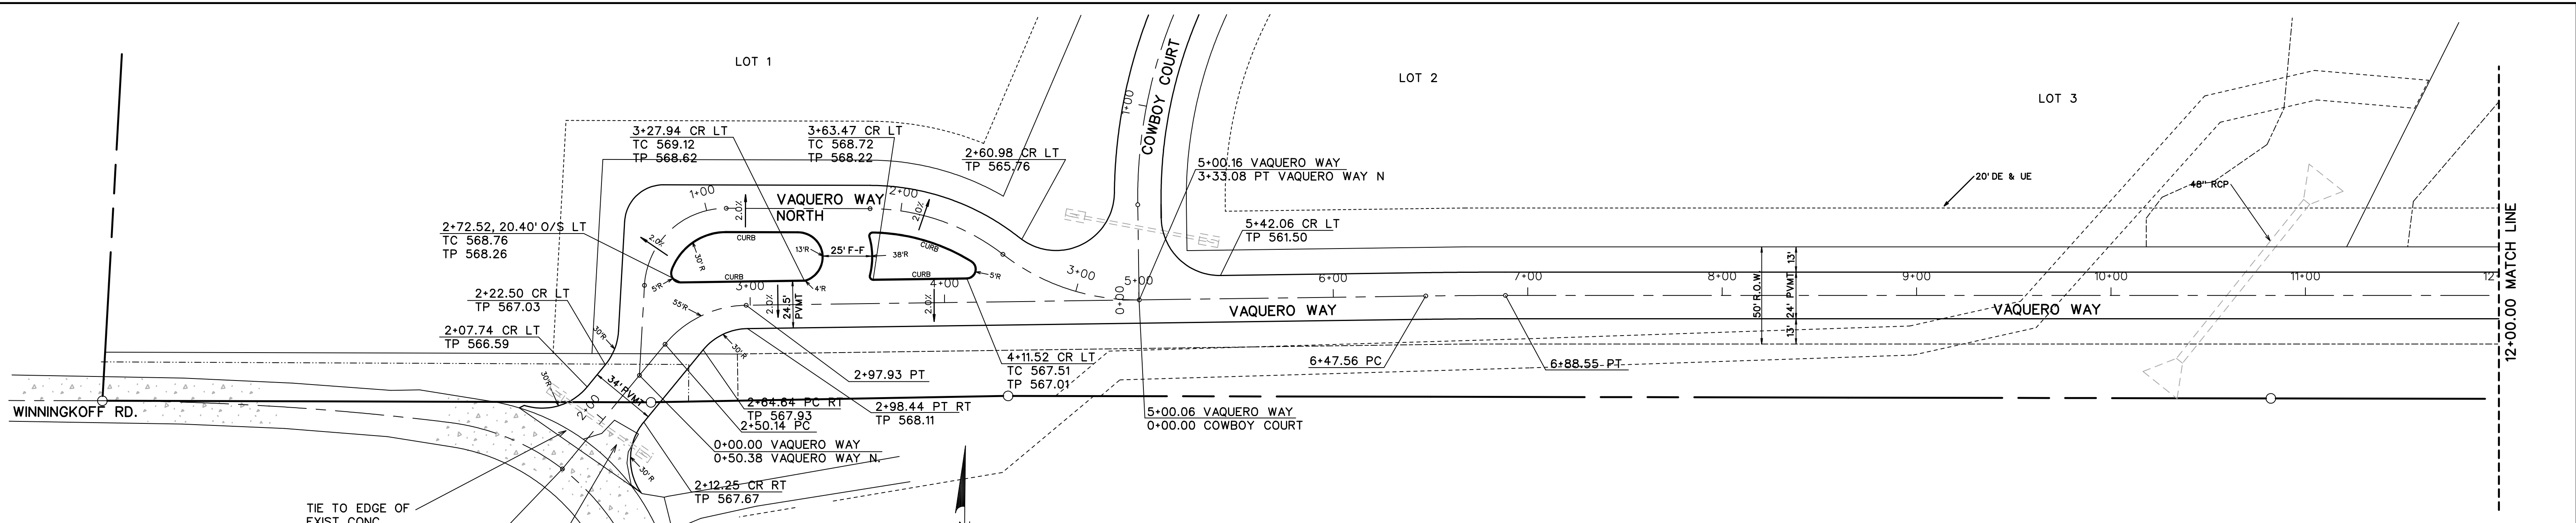


TIE TO EDGE OF EXIST. CONC.
1+67.05 VAQUERO WAY EX WINNINGKOFF RD

REMOVE EXIST CONC. DRIVE

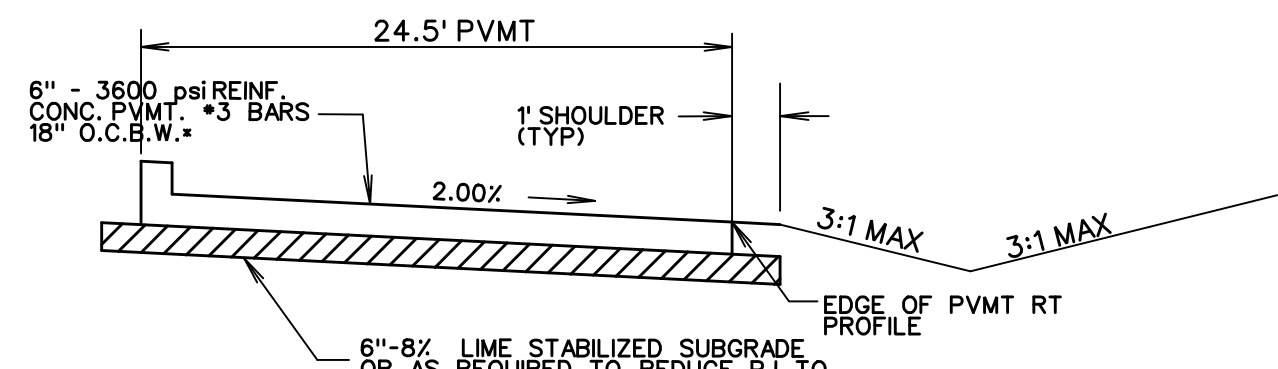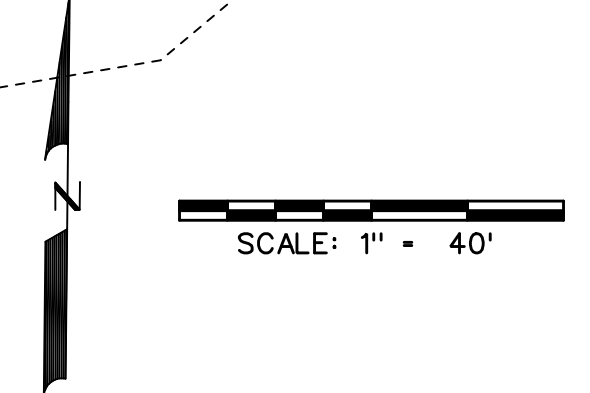


STREET A SECTION 0+00 TO 1+70

THE PAVEMENT CROSS SECTION(S) SHALL BE REVISED UPON THE COMPLETION OF A GEOTECHNICAL REPORT AS REQUIRED BY THE CITY ENGINEER.

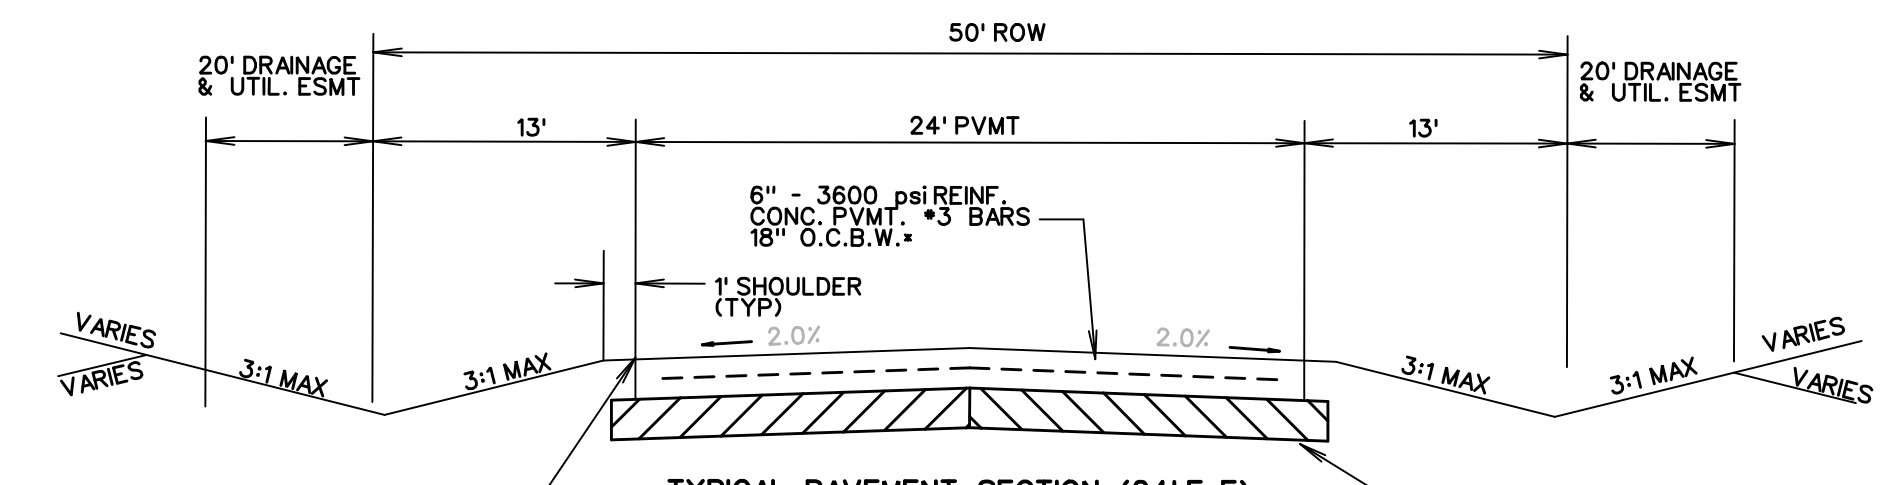

TYPICAL PAVEMENT SECTION (24' E-E)
N.T.S.

THE PAVEMENT CROSS SECTION(S) SHALL BE REVISED UPON THE COMPLETION OF A GEOTECHNICAL REPORT AS REQUIRED BY THE CITY ENGINEER.

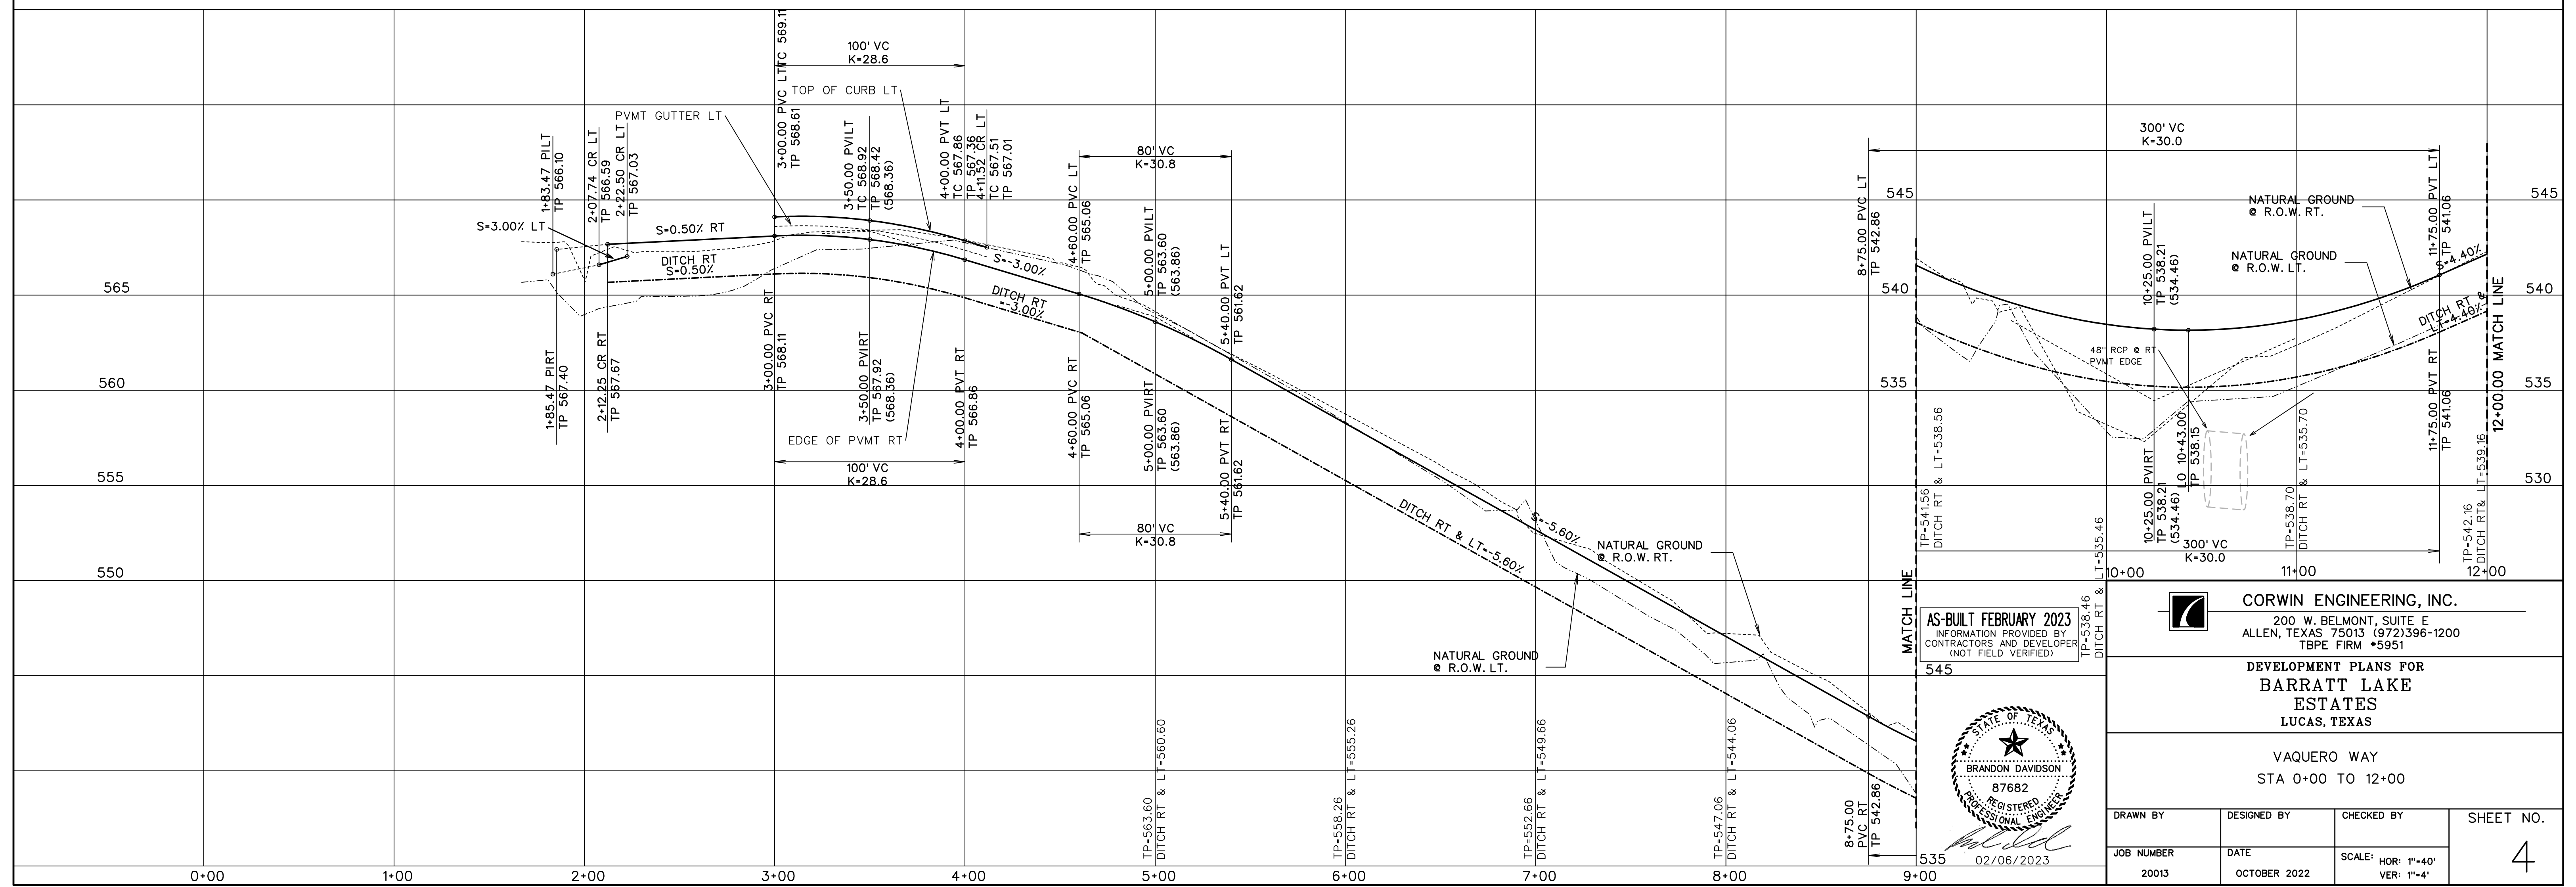

AS-BUILT FEBRUARY 2023
INFORMATION PROVIDED BY CONTRACTORS AND DEVELOPER (NOT FIELD VERIFIED)





CORWIN ENGINEERING, INC.
200 W. BELMONT, SUITE E
ALLEN, TEXAS 75013 (972)396-1200
TBPE FIRM #5951


DEVELOPMENT PLANS FOR BARRATT LAKE ESTATES
LUCAS, TEXAS

VAQUERO WAY
STA 0+00 TO 12+00

DRAWN BY	DESIGNED BY	CHECKED BY	SHEET NO.
20013	OCTOBER 2022	SCALE: HOR: 1"=40' VER: 1"=4'	4

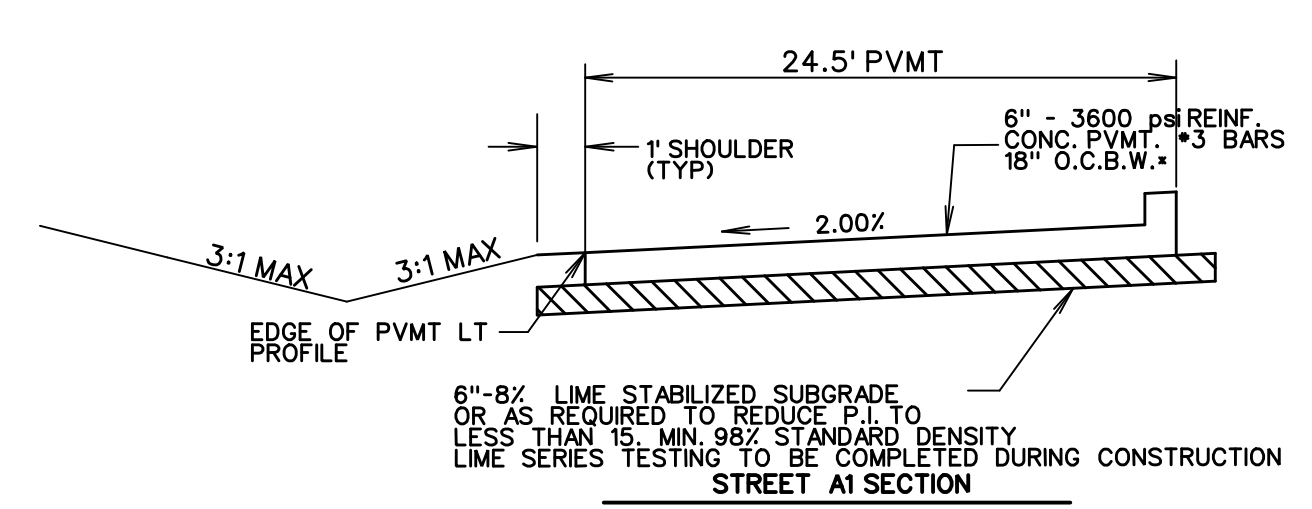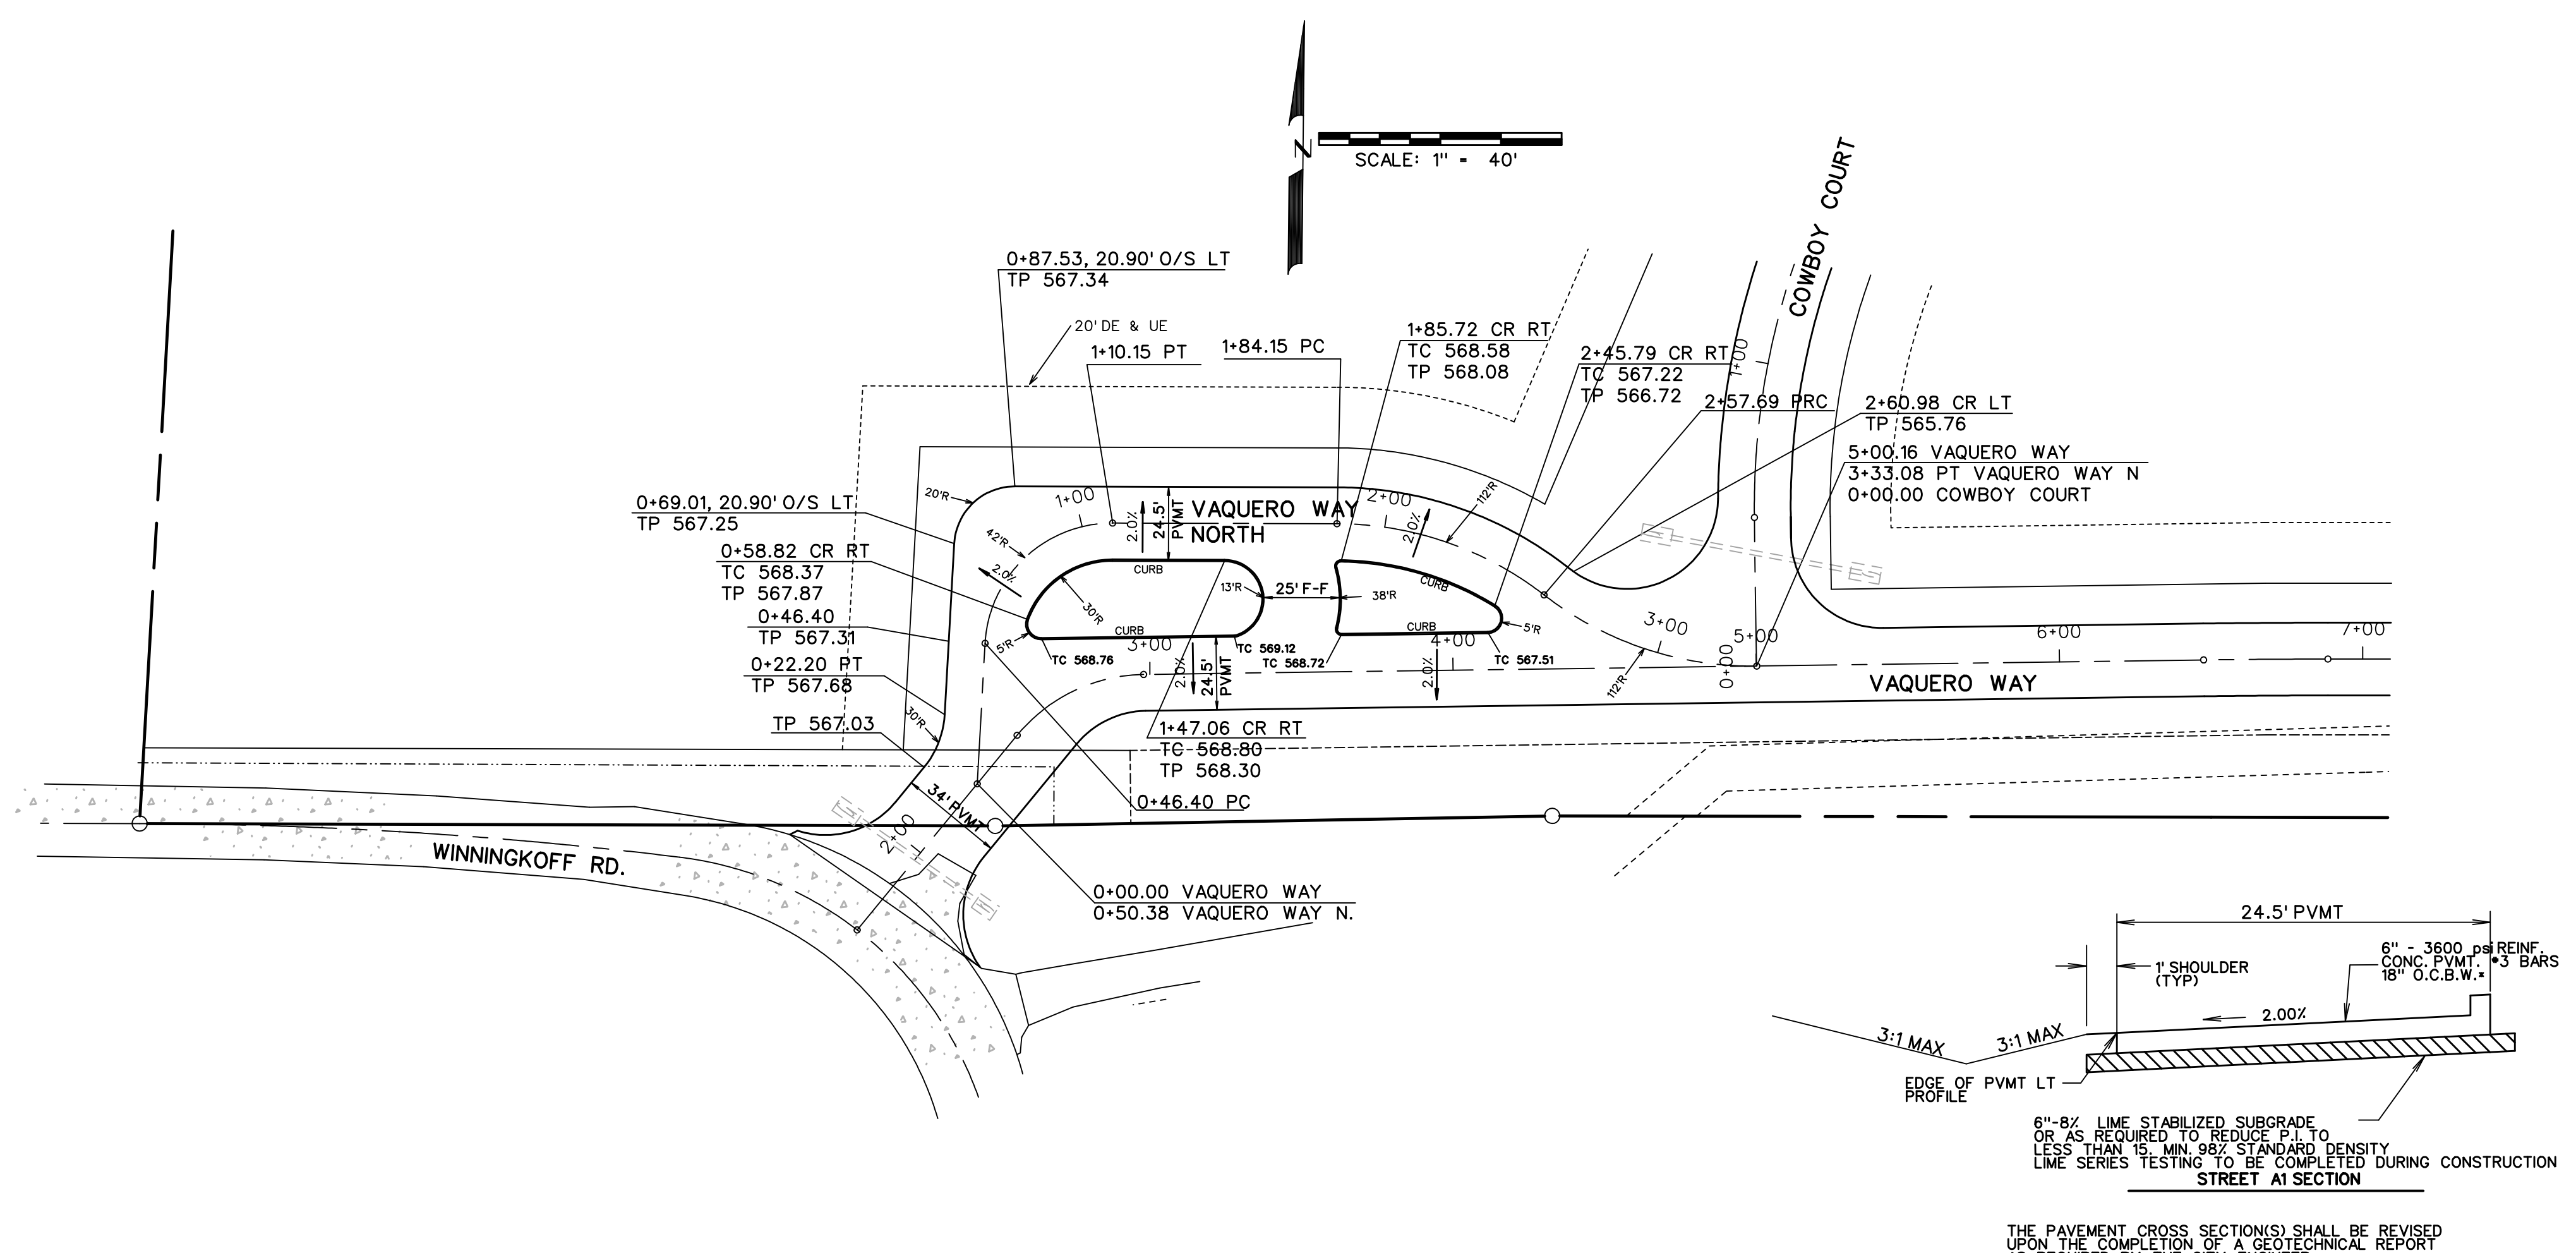

THE PAVEMENT CROSS SECTION(S) SHALL BE REVISED UPON THE COMPLETION OF A GEOTECHNICAL REPORT AS REQUIRED BY THE CITY ENGINEER.

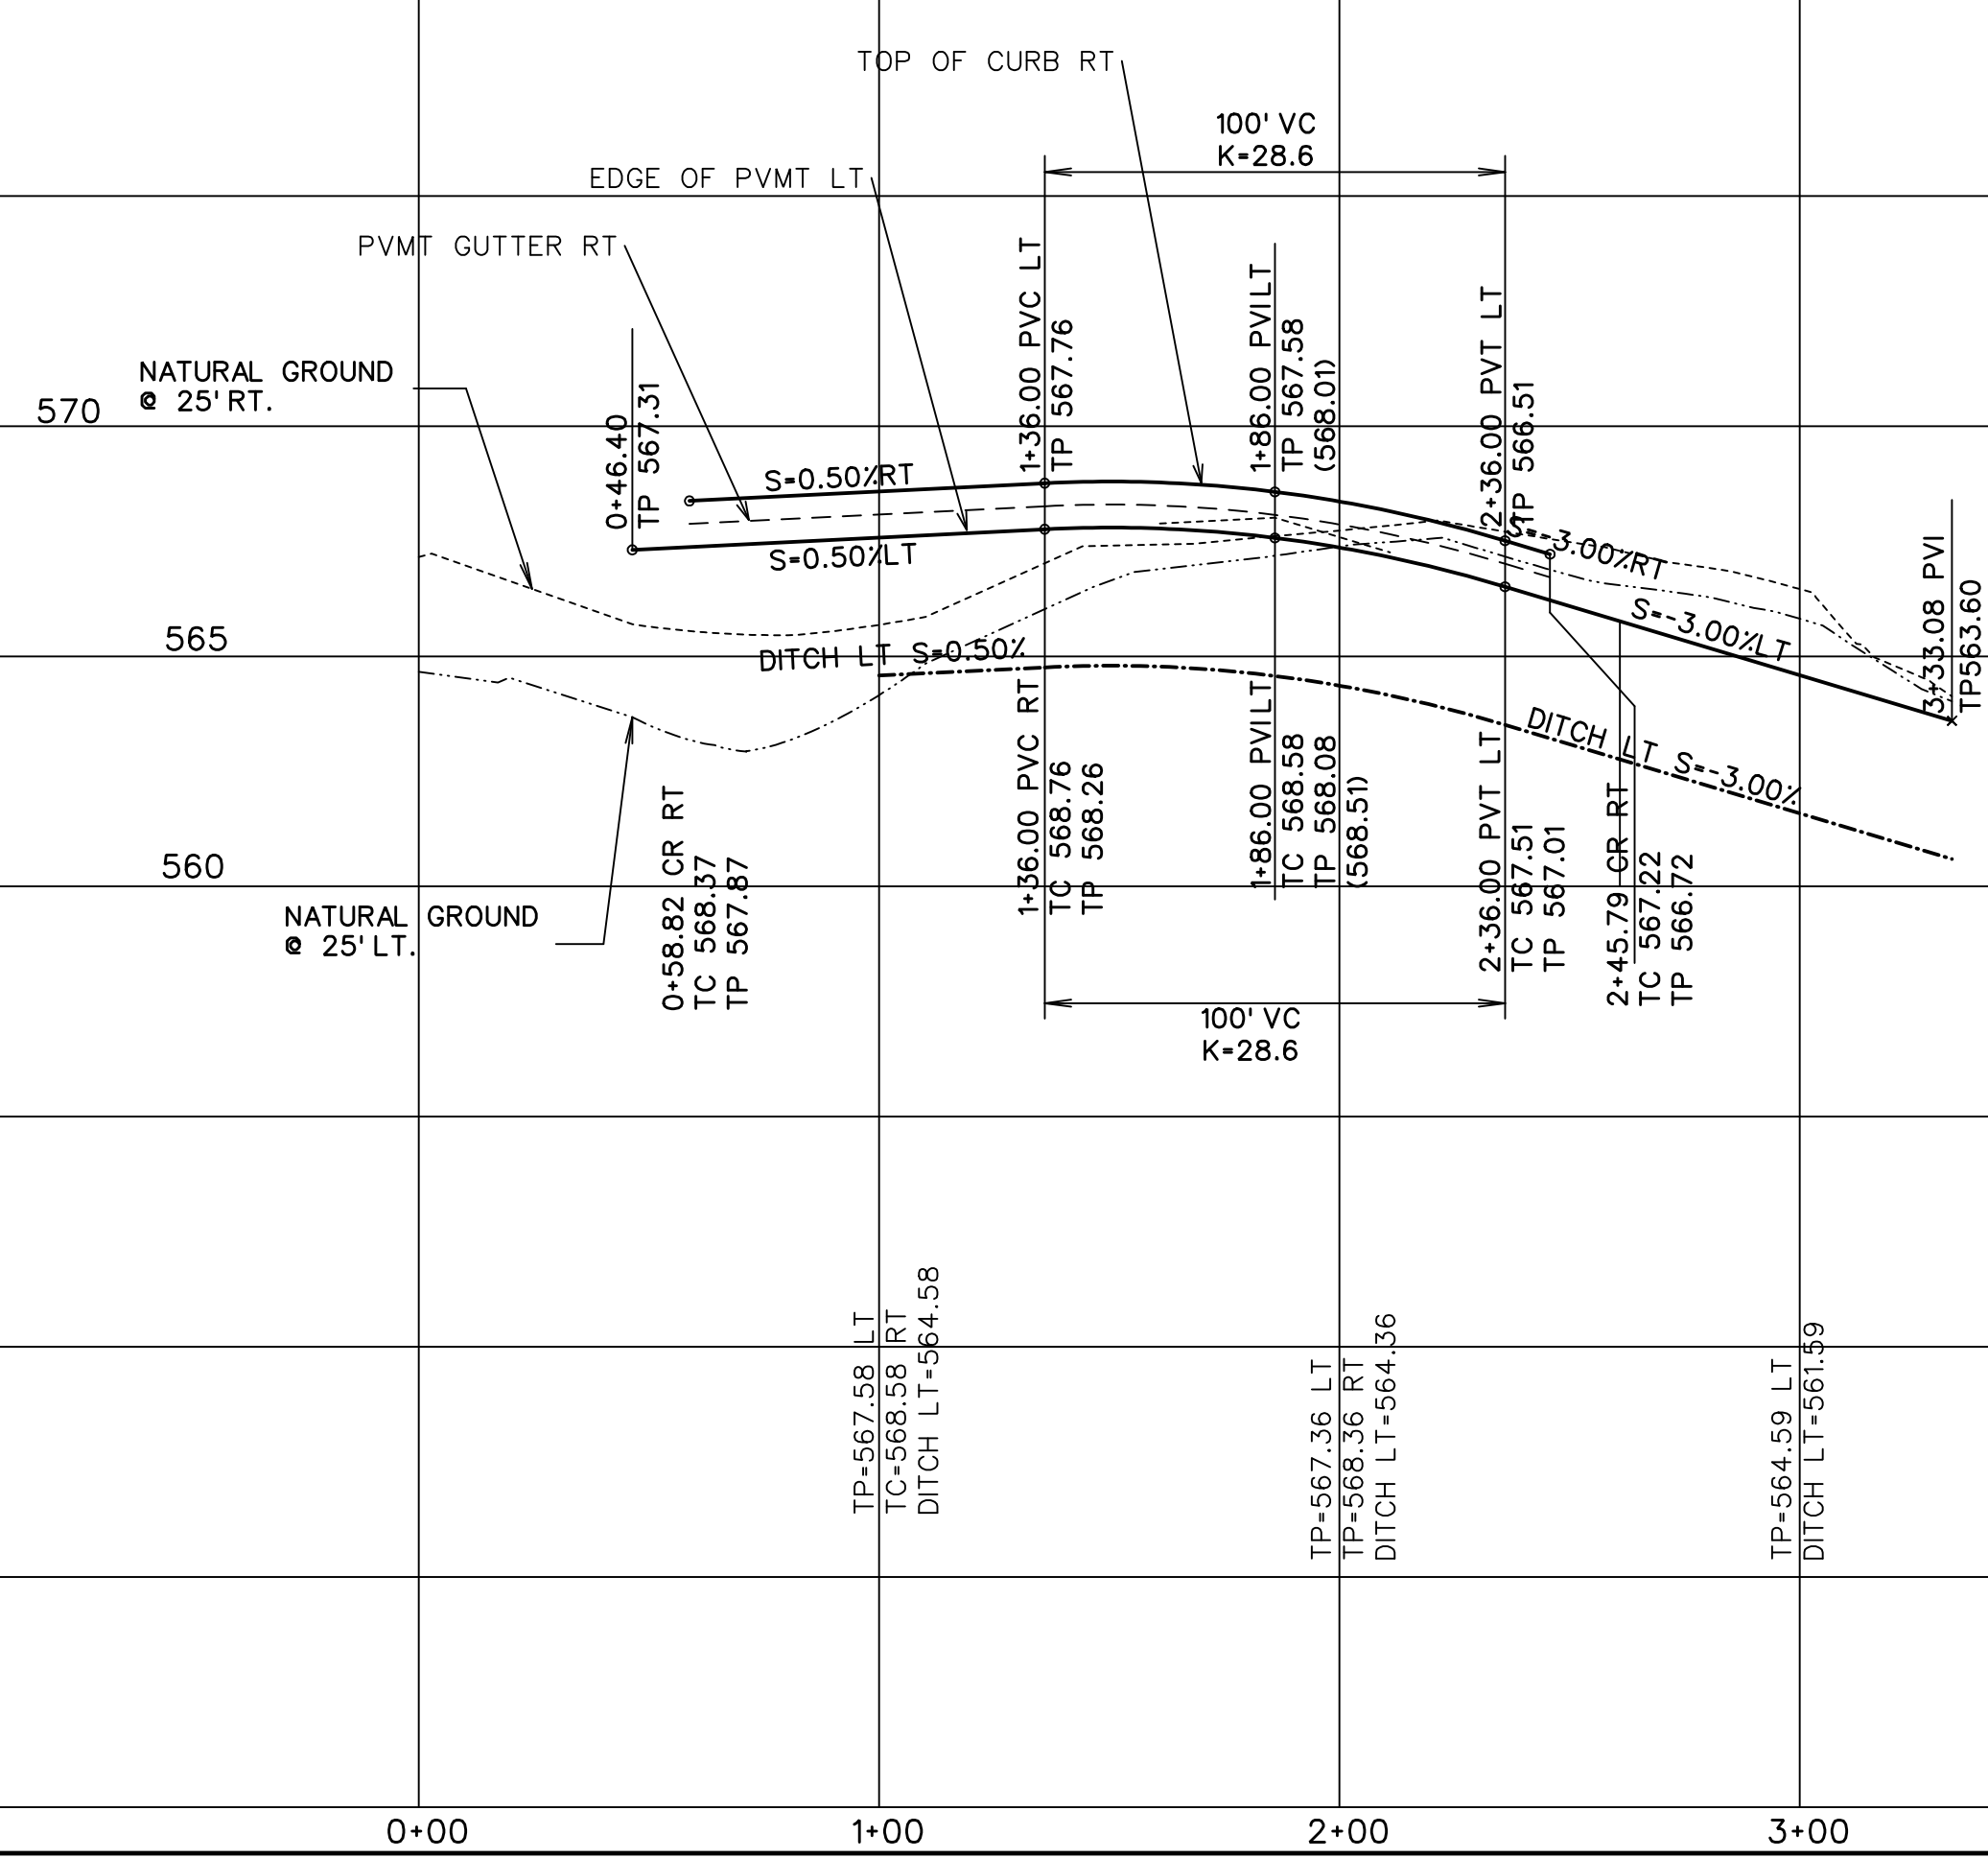

AS-BUILT FEBRUARY 2023
INFORMATION PROVIDED BY
CONTRACTORS AND DEVELOPER
(NOT FIELD VERIFIED)





CORWIN ENGINEERING, INC.
200 W. BELMONT, SUITE E
ALLEN, TEXAS 75013 (972)396-1200
TBPE FIRM #5951

DEVELOPMENT PLANS FOR
**BARRATT LAKE
ESTATES**
LUCAS, TEXAS

VAQUERO WAY NORTH

DRAWN BY	DESIGNED BY	CHECKED BY	SHEET NO.
JOB NUMBER	DATE	SCALE: HOR: 1"=40' VER: 1"=4'	6
20013	OCTOBER 2022		

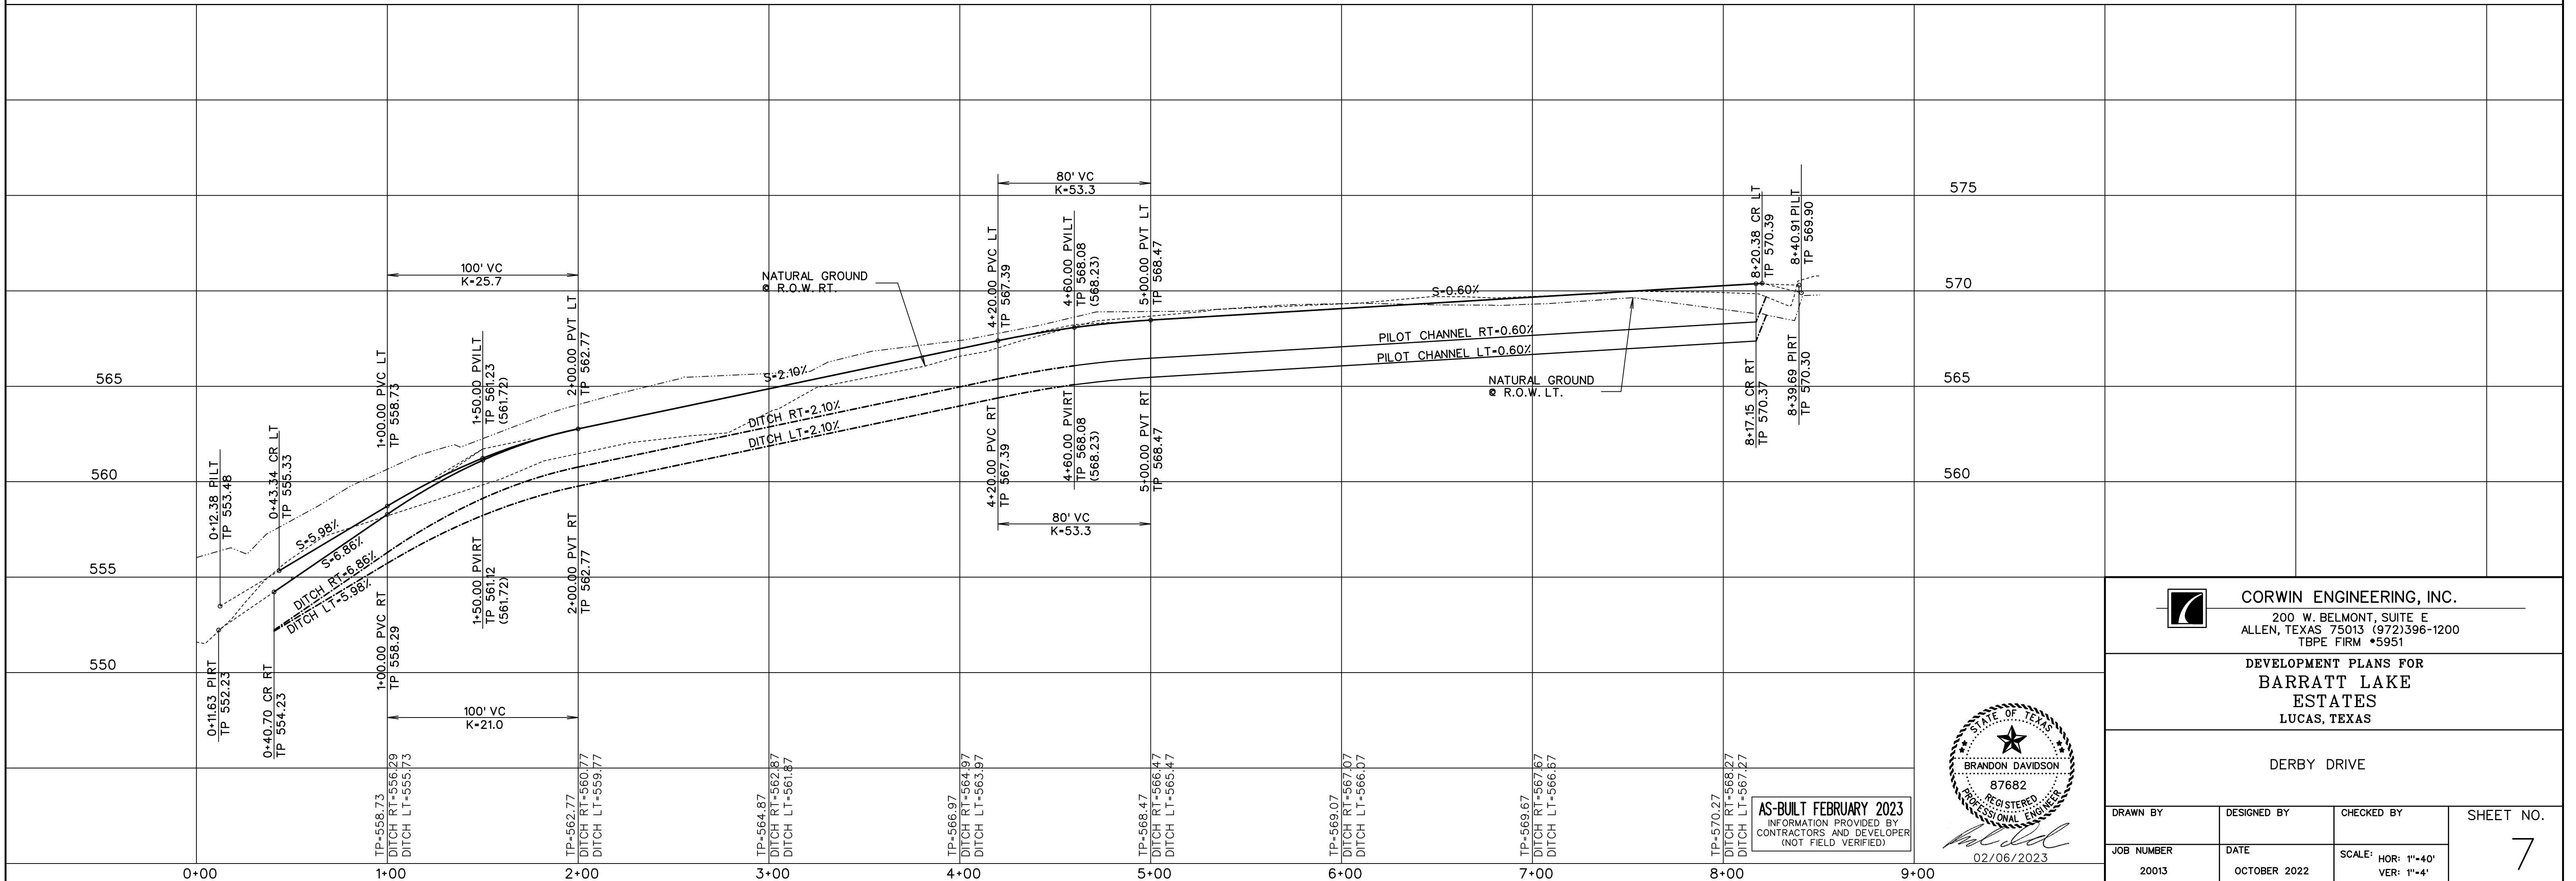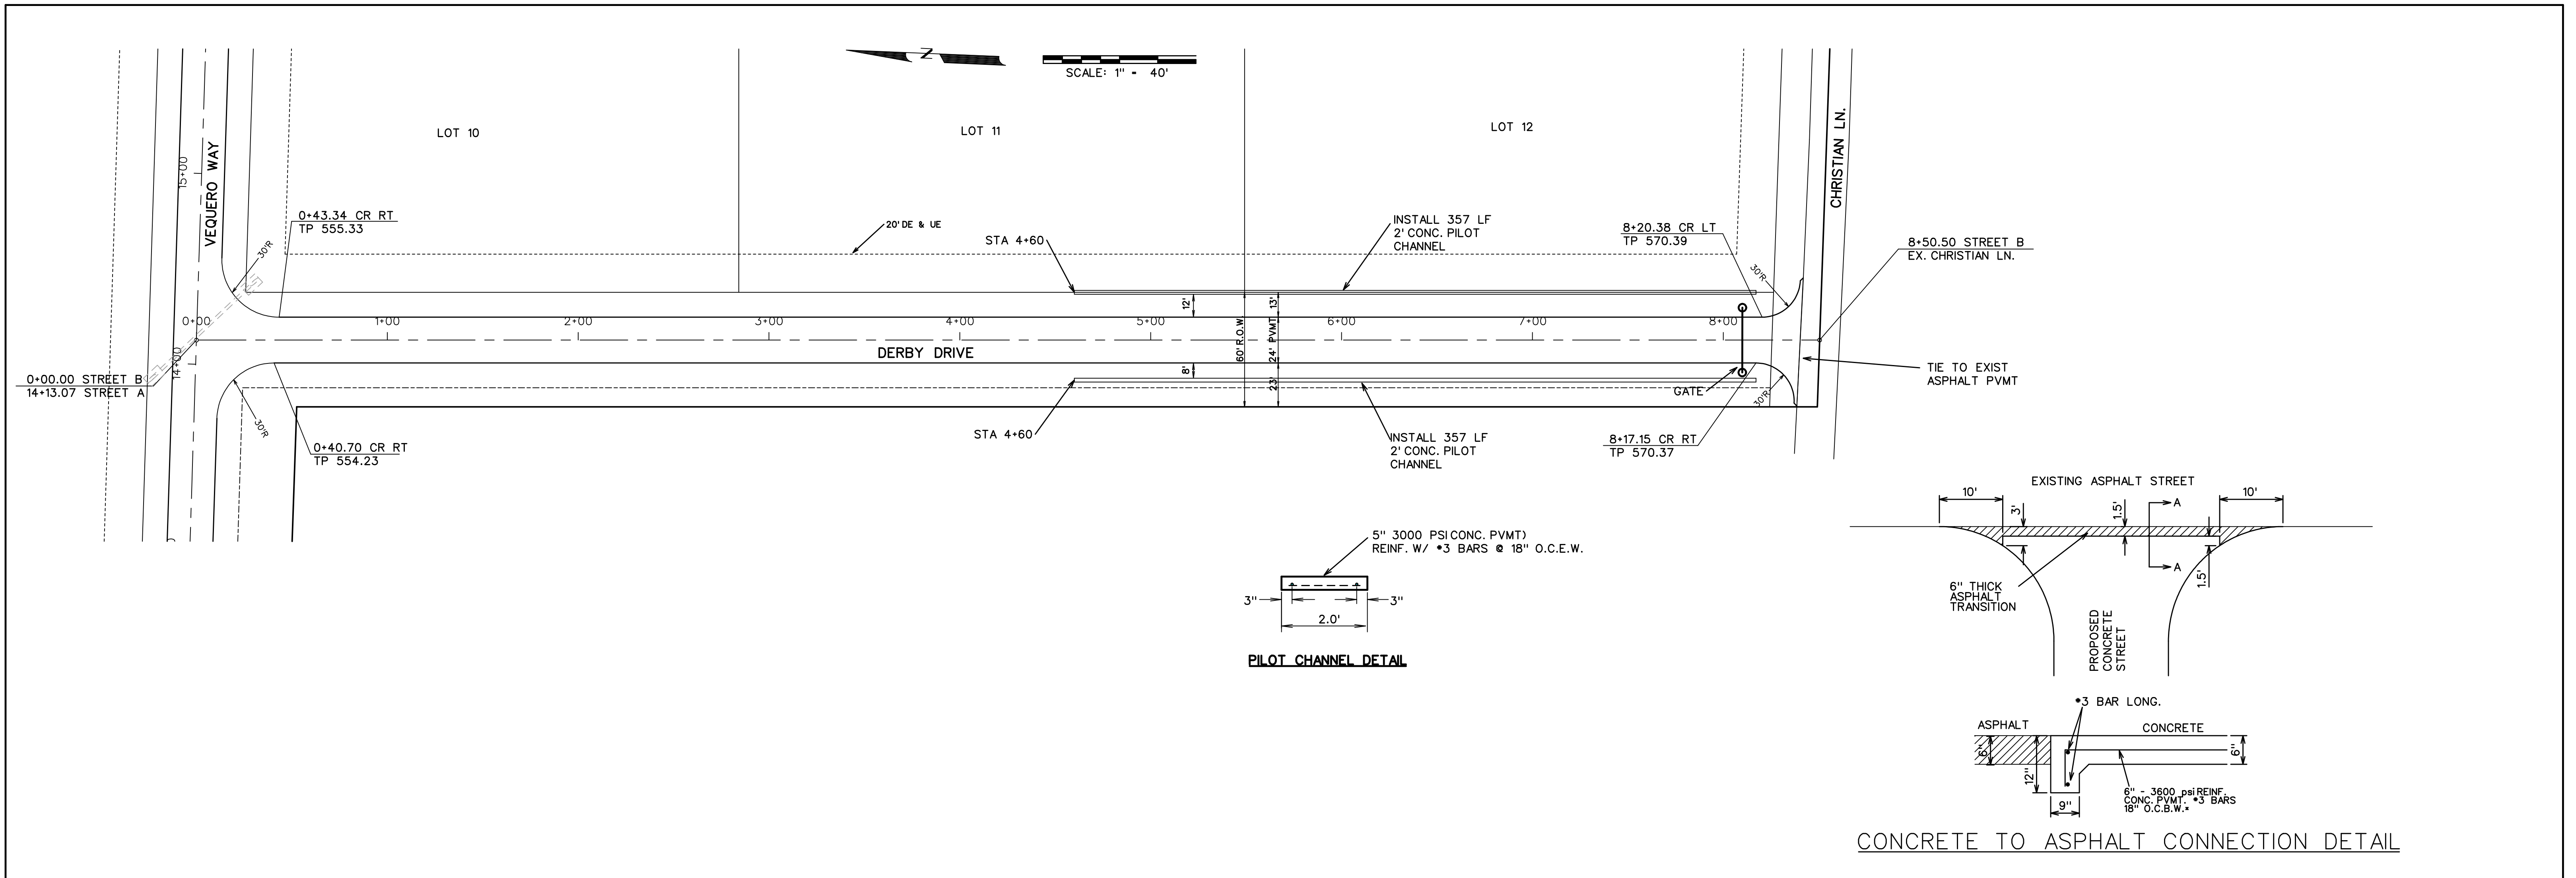



SCALE: 1" = 50'

LOT 2

LOT 6

ZONE A PER FEMA
FIRM PANEL 48085C0405J
REVISED JUNE 2, 2009

LOT 5

LOT 3

LOT 4

LOT 1

COWBOY COURT

YAQUERO WAY

WINNINGKOFF RD


DRAINAGE
EASEMENT

DRAINAGE
EASEMENT

LEGEND

- SPOT ELEVATION 706.2
- EXIST. CONTOUR -700-
- PROP. CONTOUR -704-
- RETAINING WALL - - - - -
- TOP OF WALL GRADE 1706.2
- BOTTOM OF WALL GRADE 8706.2

MATCH LINE

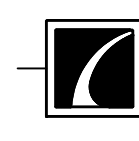


CORWIN ENGINEERING, INC.
200 W. BELMONT, SUITE E
ALLEN, TEXAS 75013 (972)396-1200
TBPE FIRM #5951

DEVELOPMENT PLANS FOR
BARRATT LAKE
ESTATES
LUCAS, TEXAS




GRADING PLAN

AS-BUILT FEBRUARY 2023
INFORMATION PROVIDED BY
CONTRACTORS AND DEVELOPER
(NOT FIELD VERIFIED)

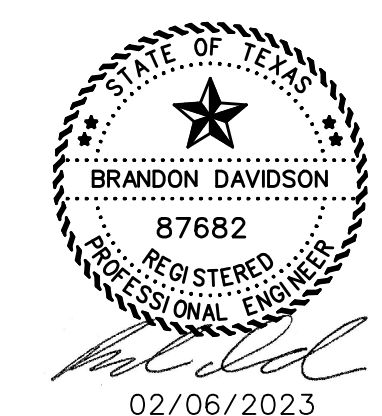


DRAWN BY	DESIGNED BY	CHECKED BY	SHEET NO. 9
JOB NUMBER 20013	DATE OCTOBER 2022	SCALE: 1"=50'	

02/06/2023

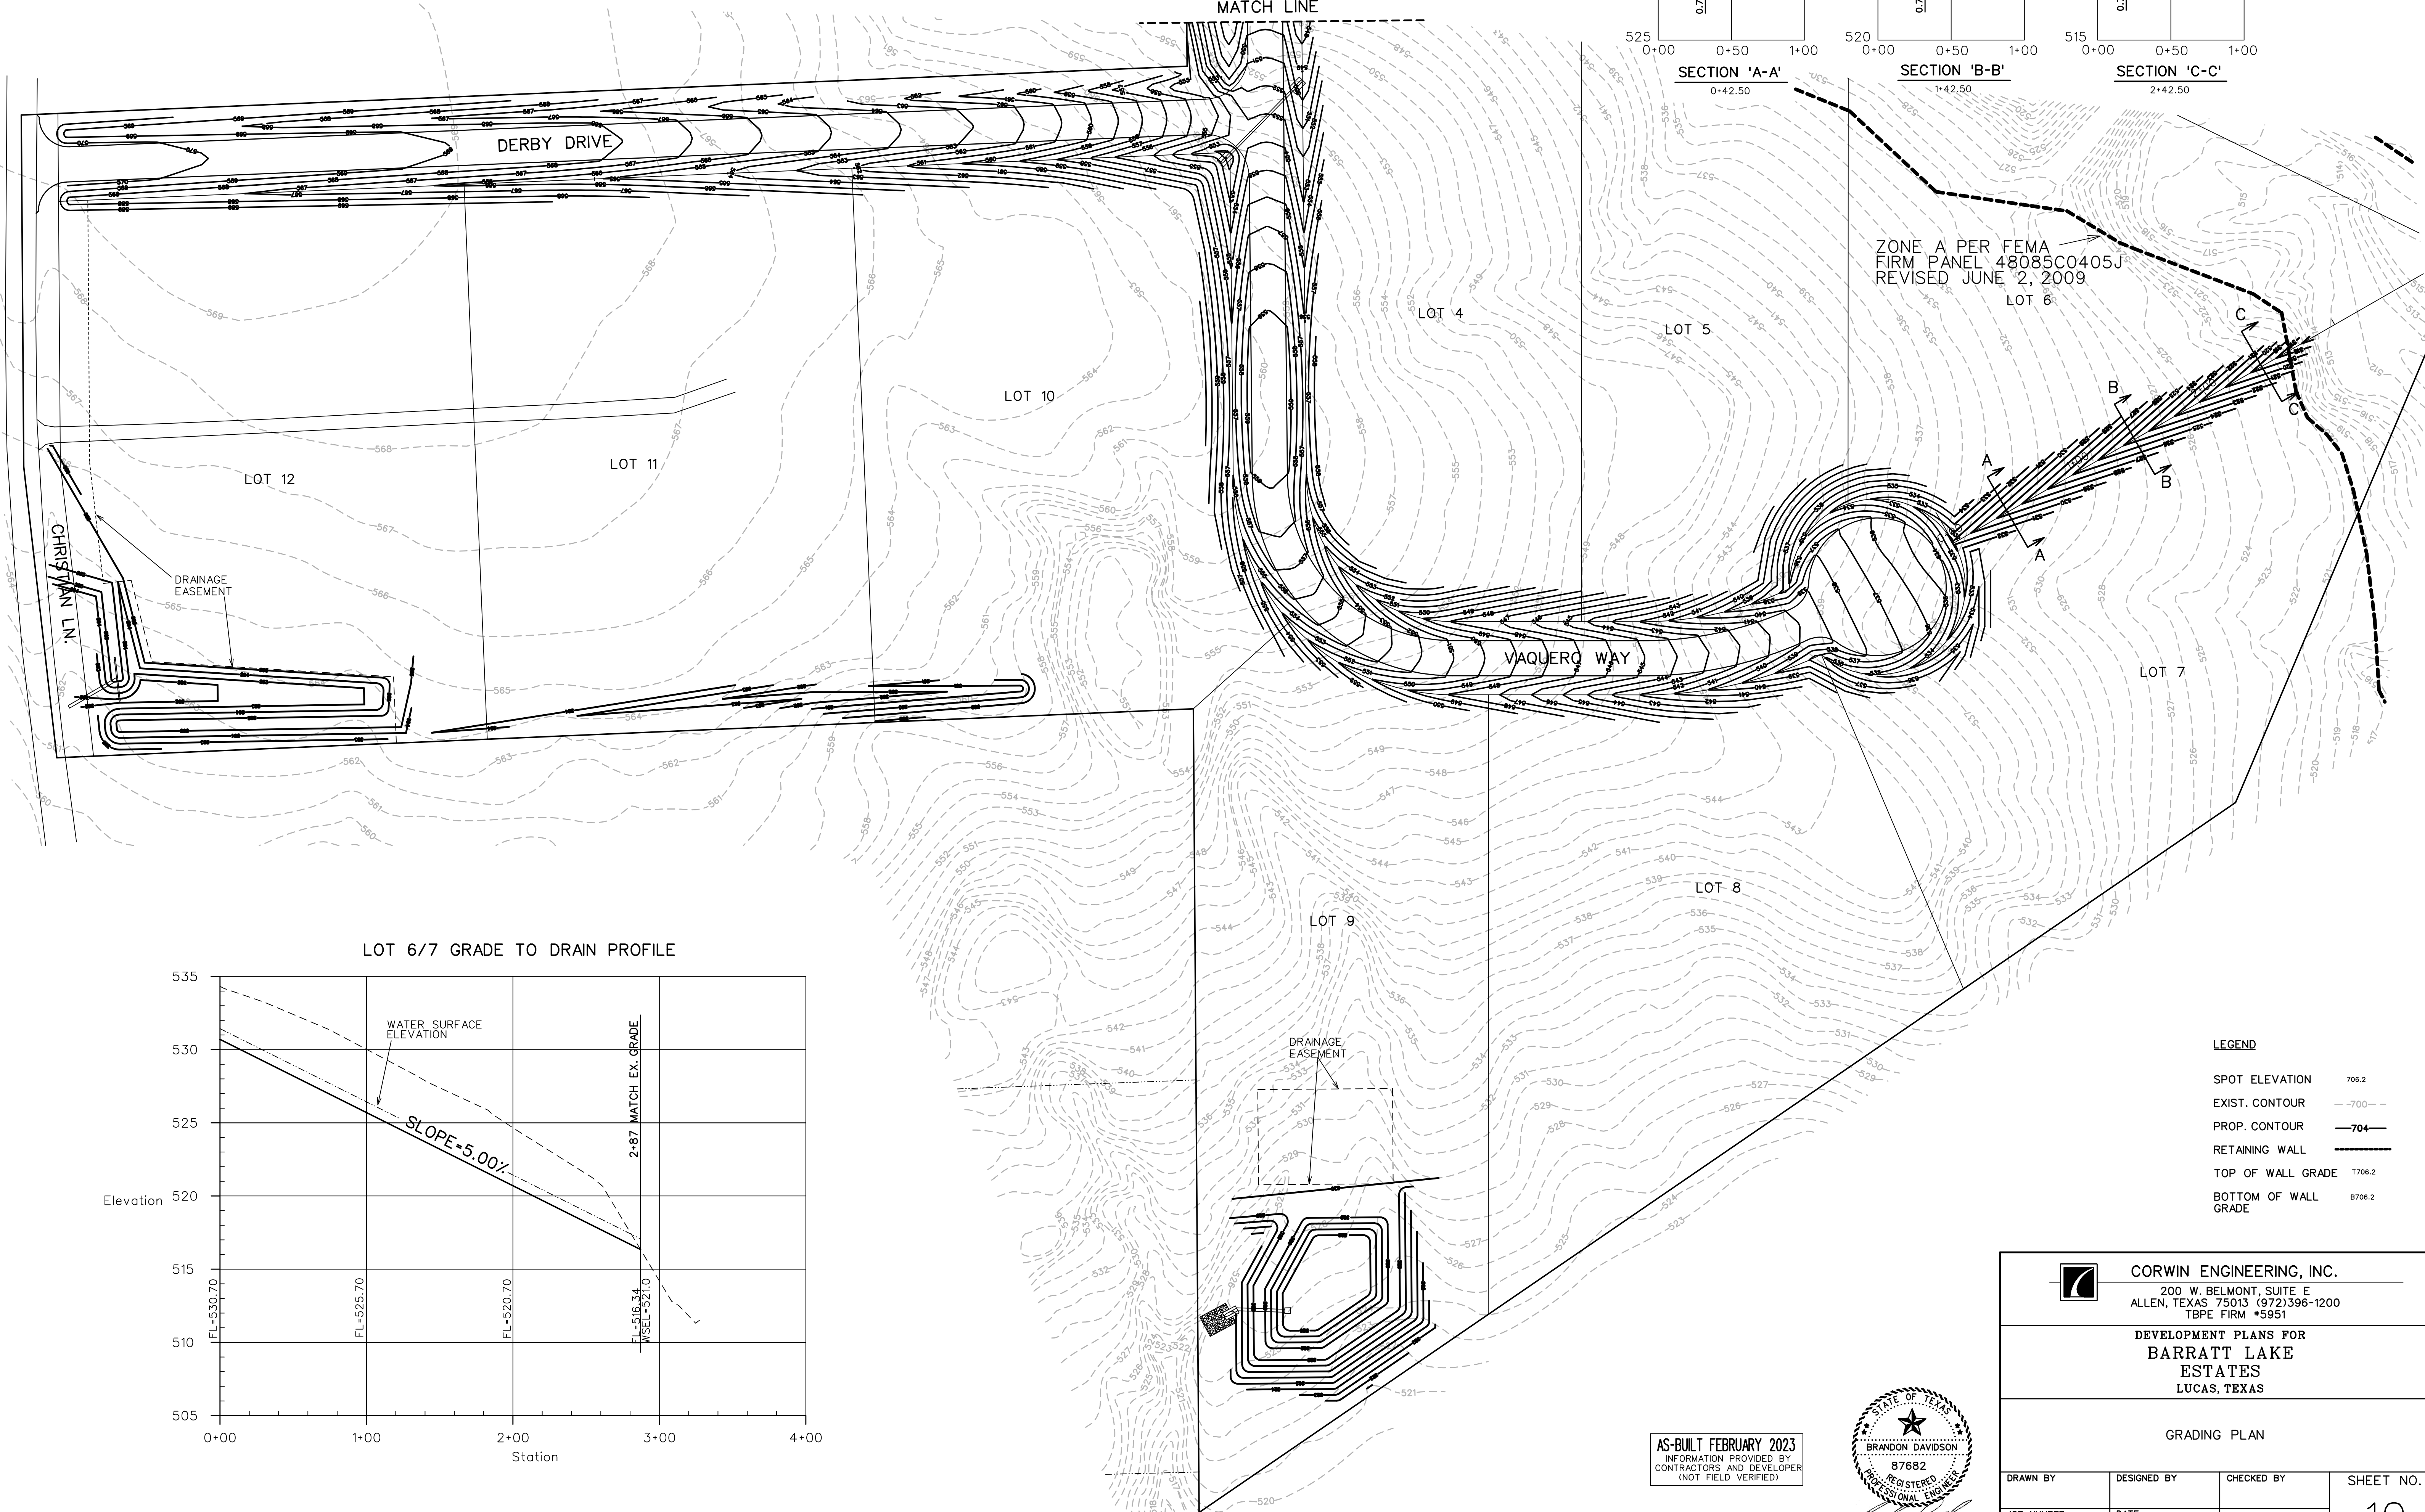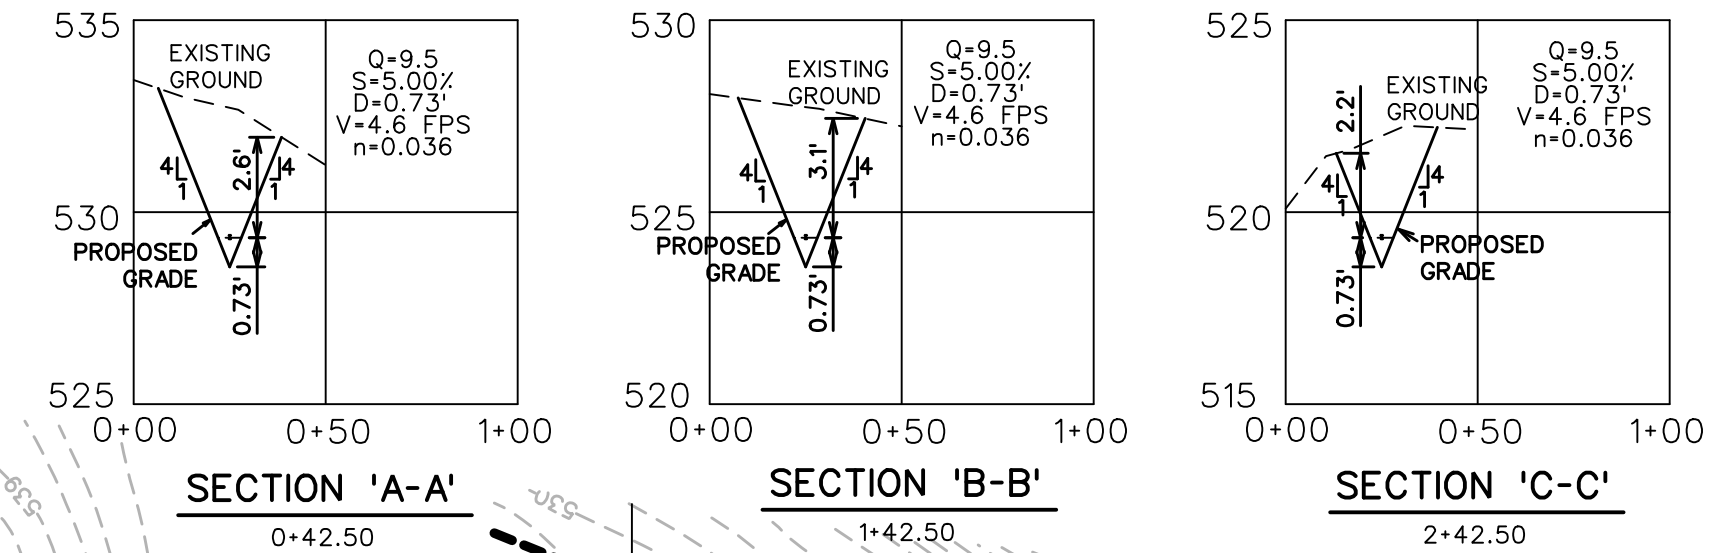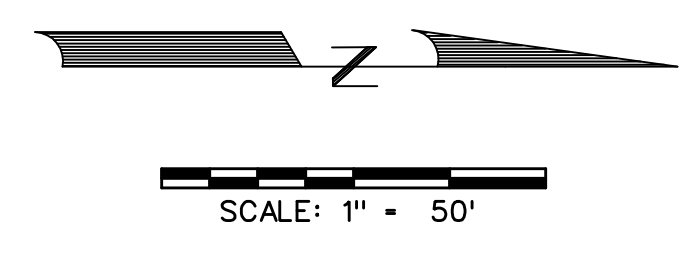

ZONE A PER FEMA
FIRM PANEL 48085C0405J
REVISED JUNE 2, 2009


LOT 6/7 GRADE TO DRAIN PROFILE

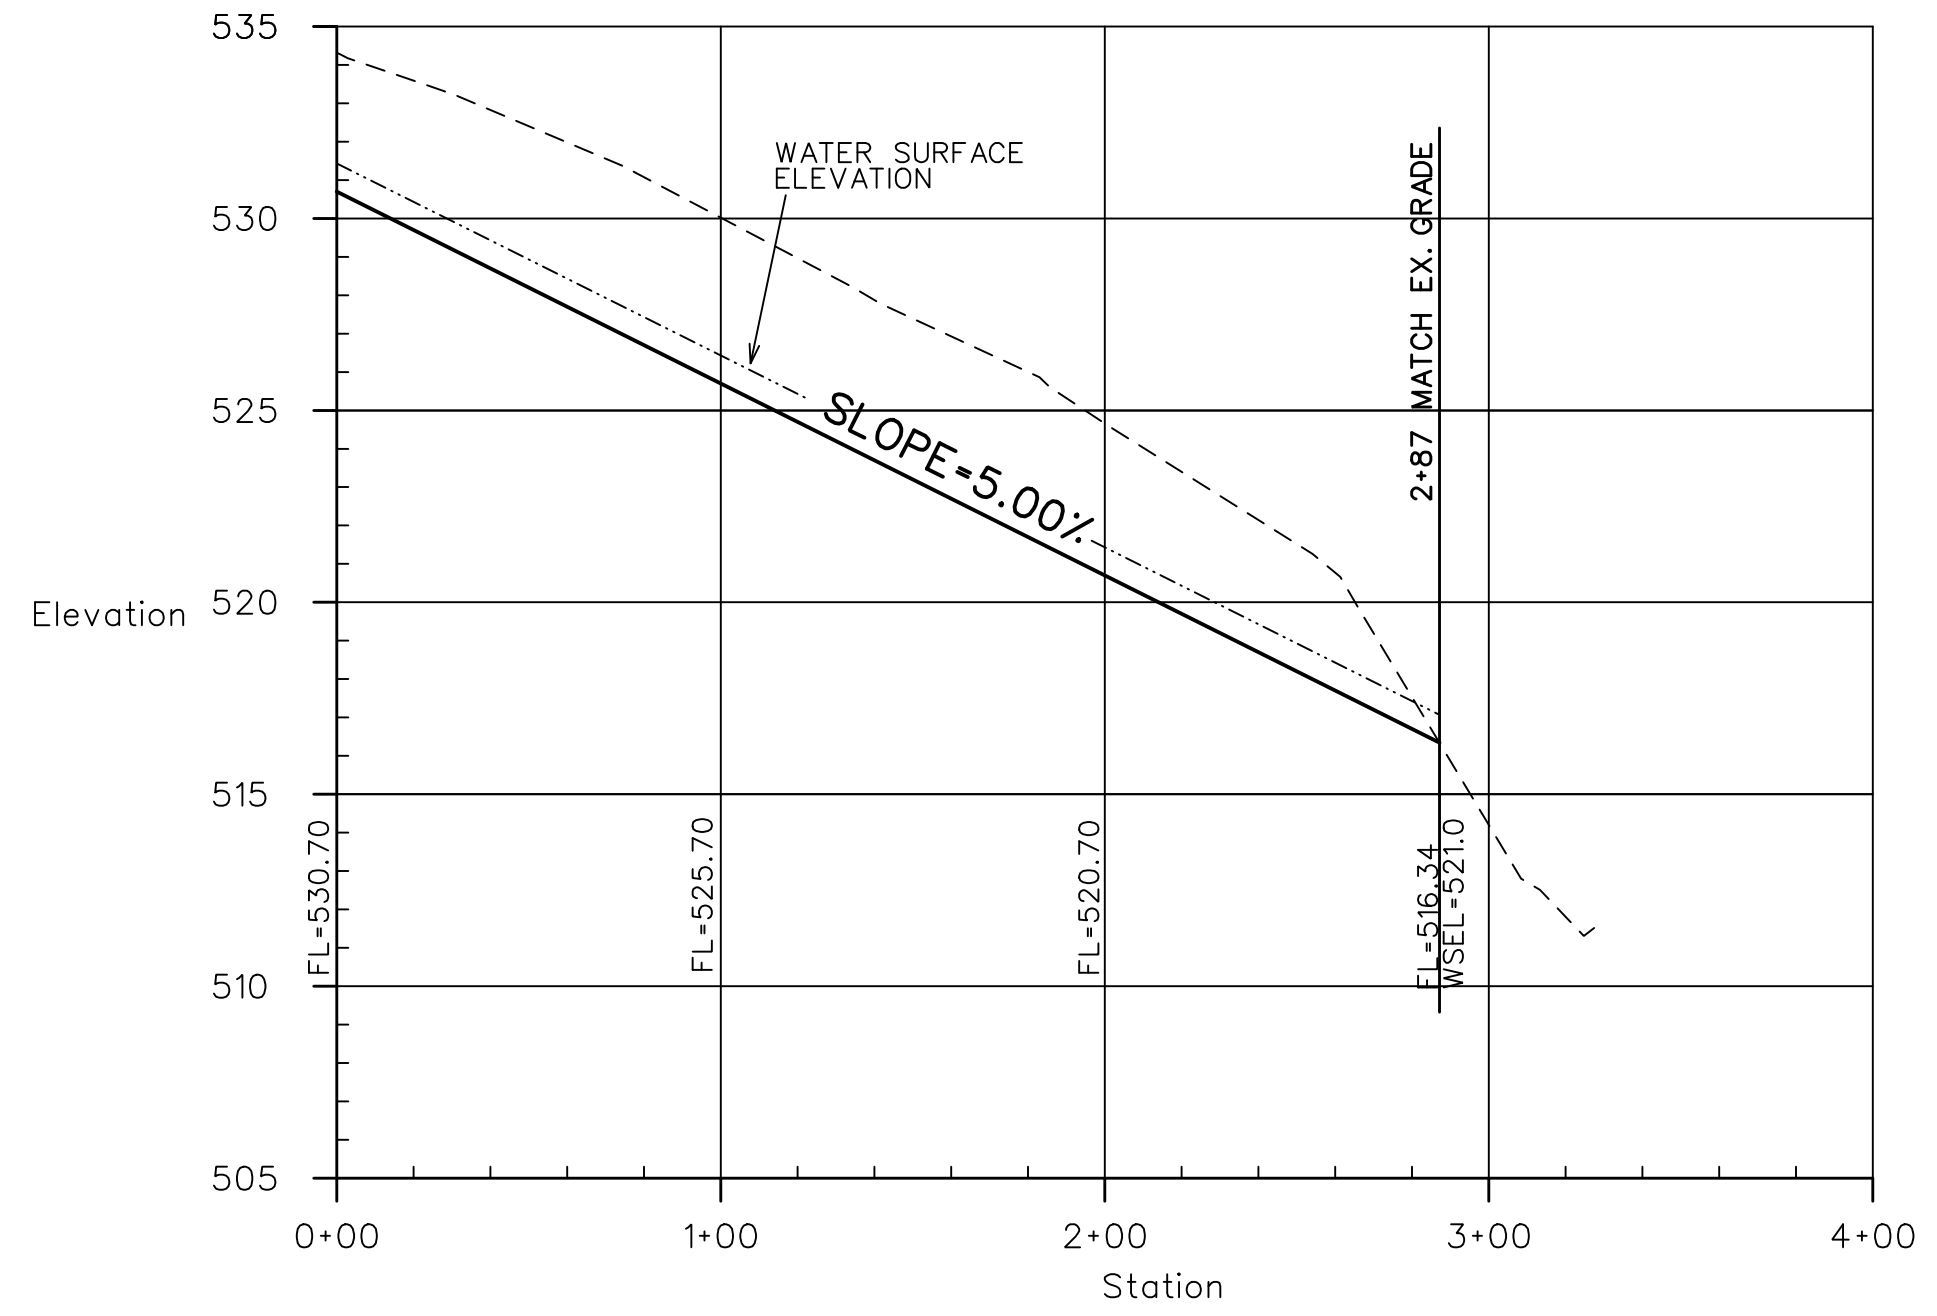

LEGEND

- SPOT ELEVATION 706.2
- EXIST. CONTOUR -700-
- PROP. CONTOUR -704-
- RETAINING WALL - - - - -
- TOP OF WALL GRADE 1706.2
- BOTTOM OF WALL GRADE 8706.2

AS-BUILT FEBRUARY 2023
INFORMATION PROVIDED BY
CONTRACTORS AND DEVELOPER
(NOT FIELD VERIFIED)

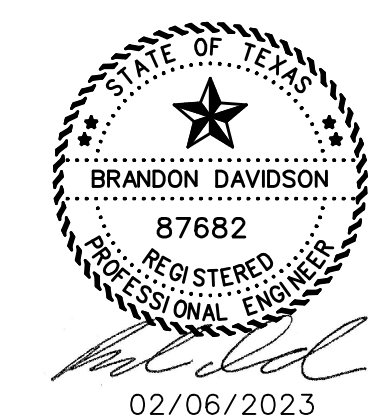





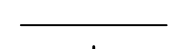
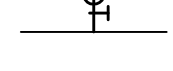
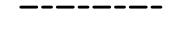
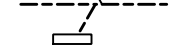
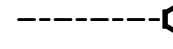
CORWIN ENGINEERING, INC.
200 W. BELMONT, SUITE E
ALLEN, TEXAS 75013 (972)396-1200
TBPE FIRM #5951

**DEVELOPMENT PLANS FOR
BARRATT LAKE
ESTATES
LUCAS, TEXAS**

GRADING PLAN

DRAWN BY	DESIGNED BY	CHECKED BY	SHEET NO.
JOB NUMBER	DATE	SCALE:	10
20013	OCTOBER 2022	1"=50'	

LEGEND


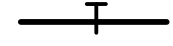
-  PROP. WATER LINE
-  PROP. FIRE HYDRANT AND VALVE
-  PROP. GATE VALVE
-  PROP. FLUSH VALVE
-  EXIST. WATER LINE
-  EXIST. FIRE HYDRANT AND VALVE
-  PROP. STORM SEWER
-  PROP. CURB INLETS
-  PROP. CONC. HEADWALL

NOTES:

1. ALL VALVES, FIRE HYDRANTS, METER BOXED, ETC. SHALL BE MARKED WITH A STAKE A MINIMUM OF 3 FEET ABOVE THE FIXTURE AND PAINTED ORANGE.
2. INDIVIDUAL SITE EVALUATIONS AND OSSF (ON-SITE SEWAGE FACILITIES) DESIGN PLANS MUST BE SUBMITTED TO AND APPROVED BY COLLIN COUNTY FOR EACH LOT PRIOR TO CONSTRUCTION OF ANY OSSF SYSTEM.
3. TCEQ SEPARATION CLEARANCES AND REQUIREMENTS TO BE FOLLOWED BY CONTRACTOR FOR INSTALLATION OF WATER LINE.

CONTRACTOR SHALL VERIFY ALL EXISTING UTILITIES FOR LOCATION AND ELEVATION PRIOR TO CONSTRUCTION. EXISTING UTILITIES SHOWN ARE APPROXIMATE AND MAY VARY IN ACTUAL LOCATION.

SCALE: 1" = 100'

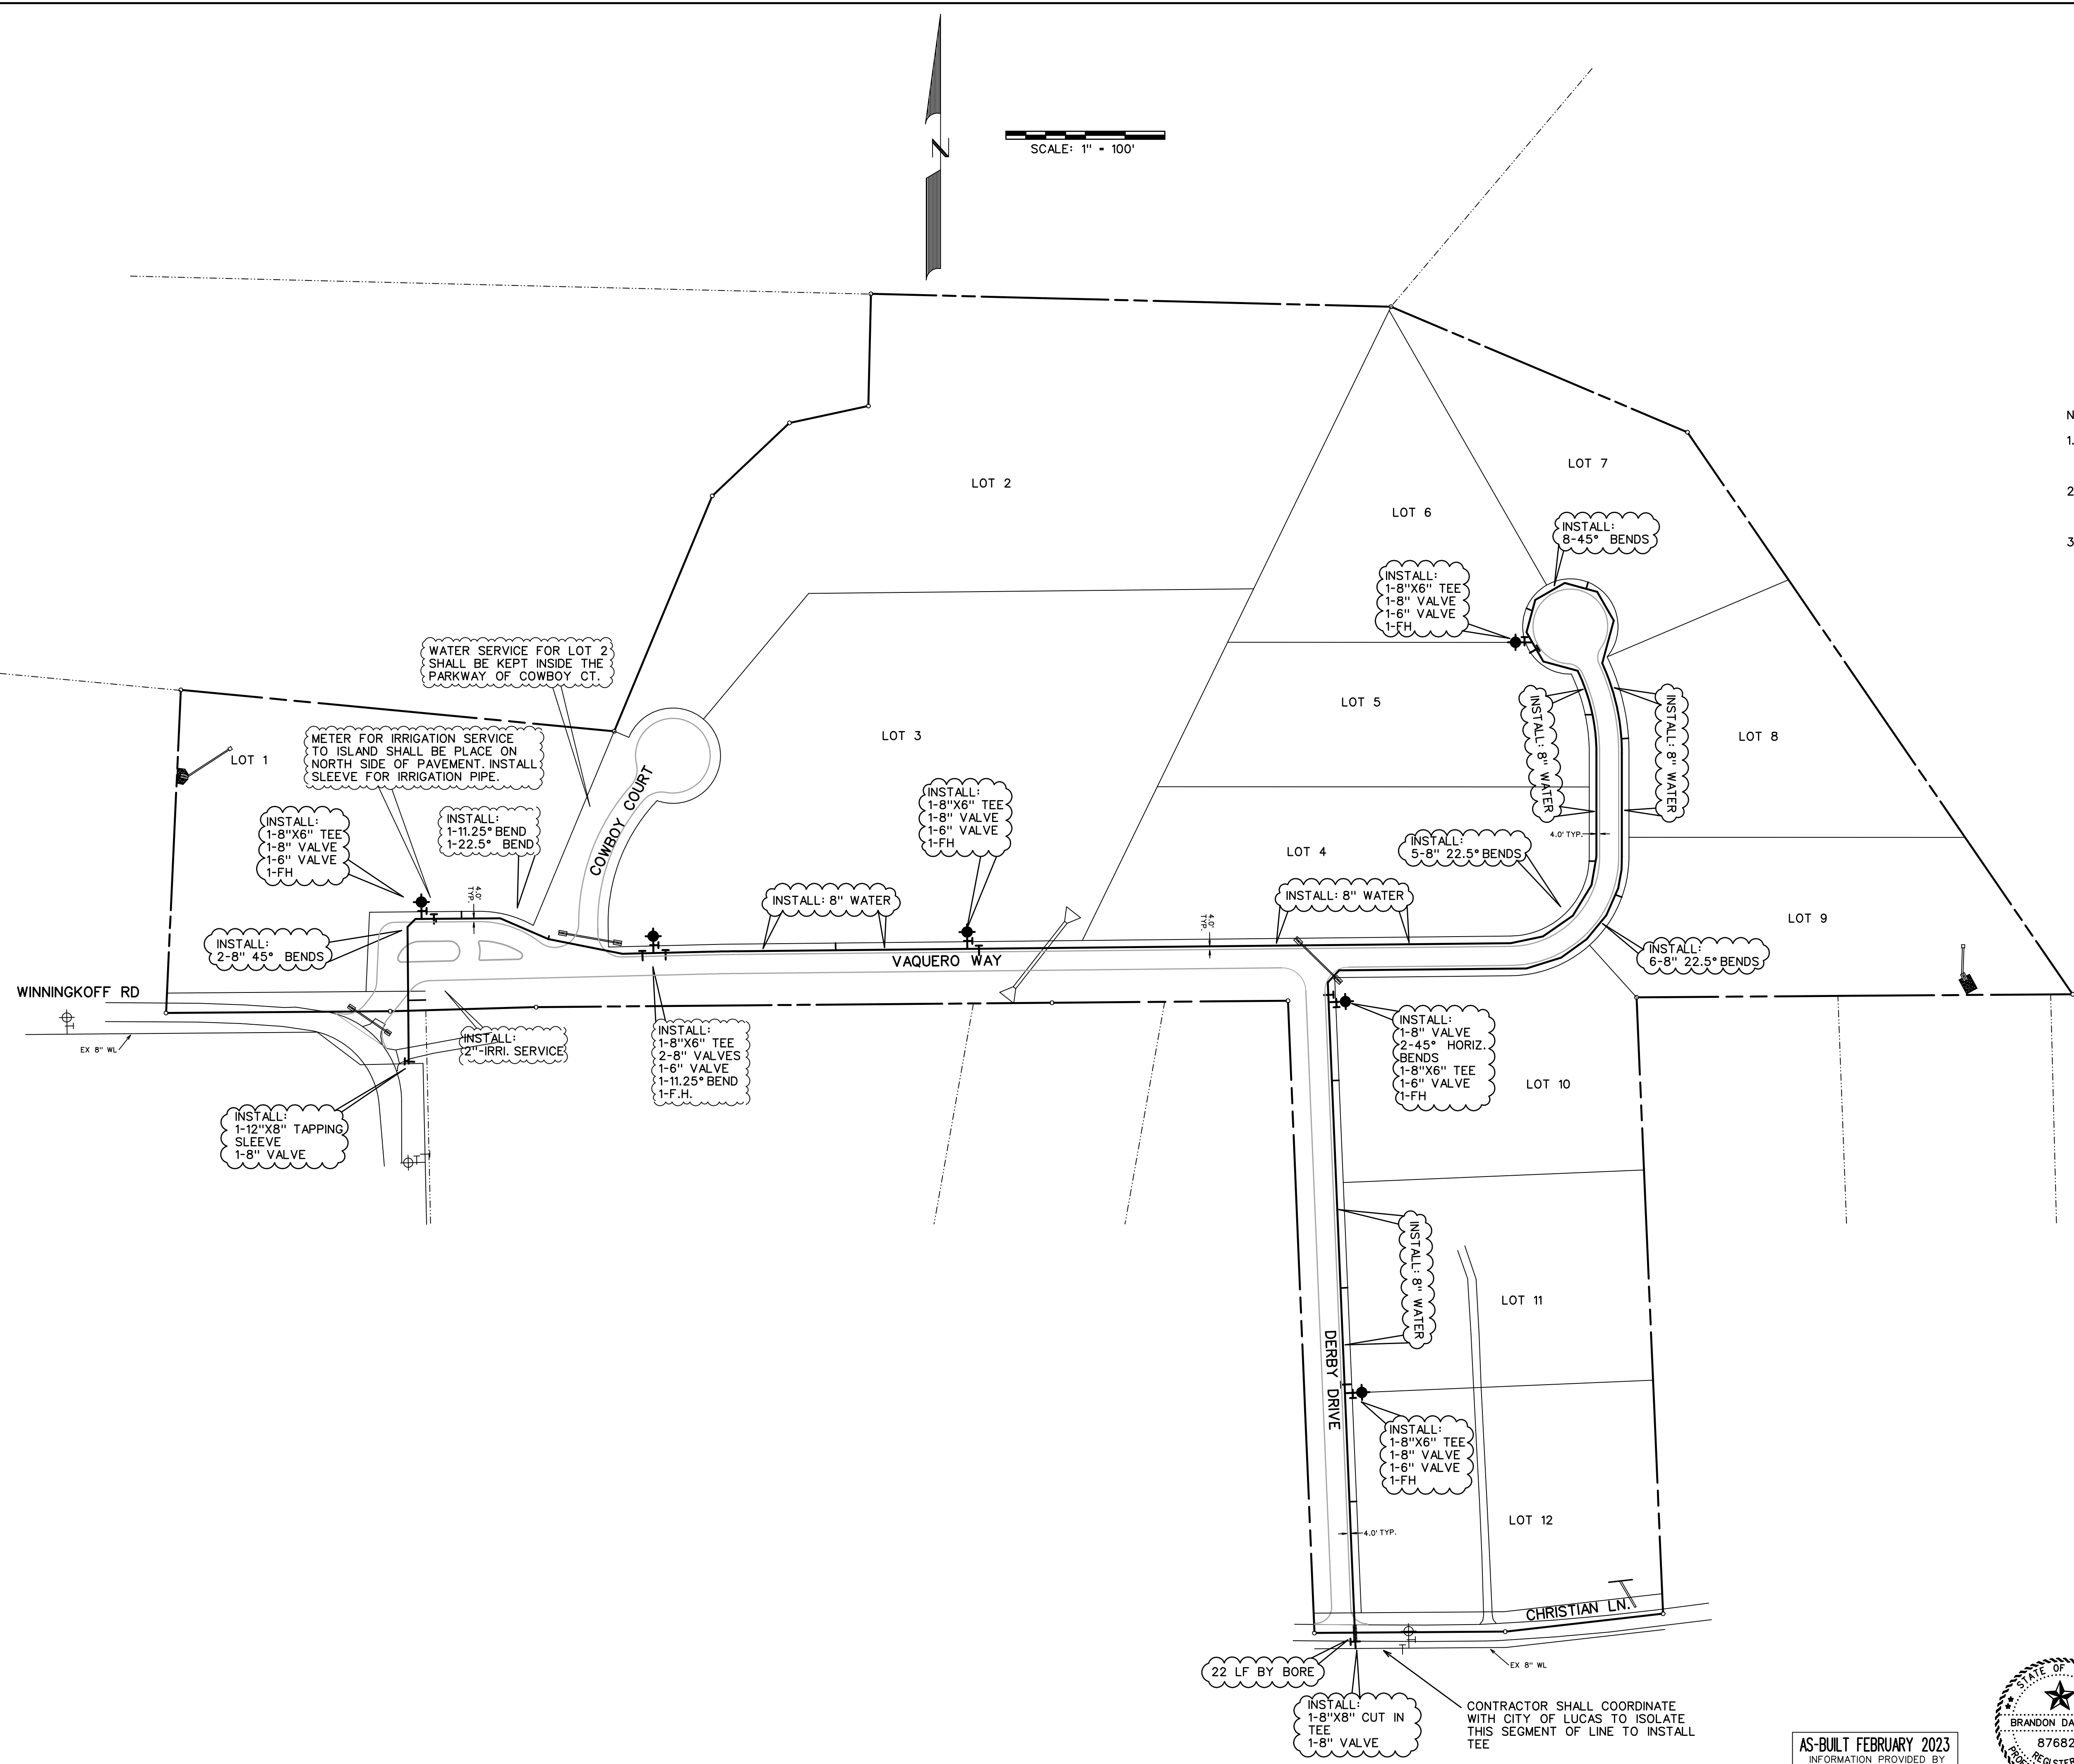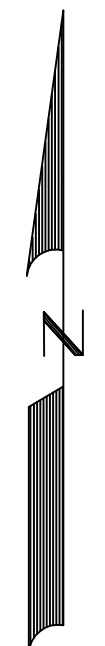

1	REVISED WATERLINE TO 4.0' OFF PAVEMENT		2/15/22
NO.	REVISIONS	BY	DATE


CORWIN ENGINEERING, INC.
 200 W. BELMONT, SUITE E
 ALLEN, TEXAS 75013 (972)396-1200
 TBPE FIRM #5951

**DEVELOPMENT PLANS FOR
 BARRATT LAKE
 ESTATES
 LUCAS, TEXAS**


WATER PLAN

DRAWN BY	DESIGNED BY	CHECKED BY	SHEET NO.
JOB NUMBER	DATE	SCALE:	11
20013	OCTOBER 2022	1"=100'	


AS-BUILT FEBRUARY 2023
 INFORMATION PROVIDED BY
 CONTRACTORS AND DEVELOPER
 (NOT FIELD VERIFIED)

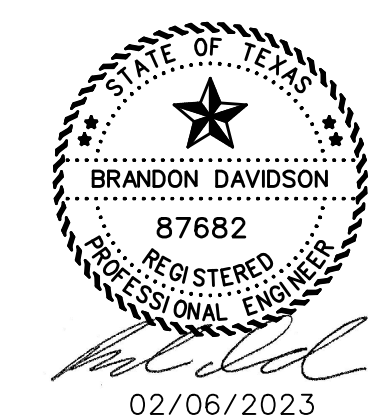

22 LF BY BORE
 INSTALL: 1-8"X8" CUT IN TEE
 1-8" VALVE
 CONTRACTOR SHALL COORDINATE WITH CITY OF LUCAS TO ISOLATE THIS SEGMENT OF LINE TO INSTALL TEE

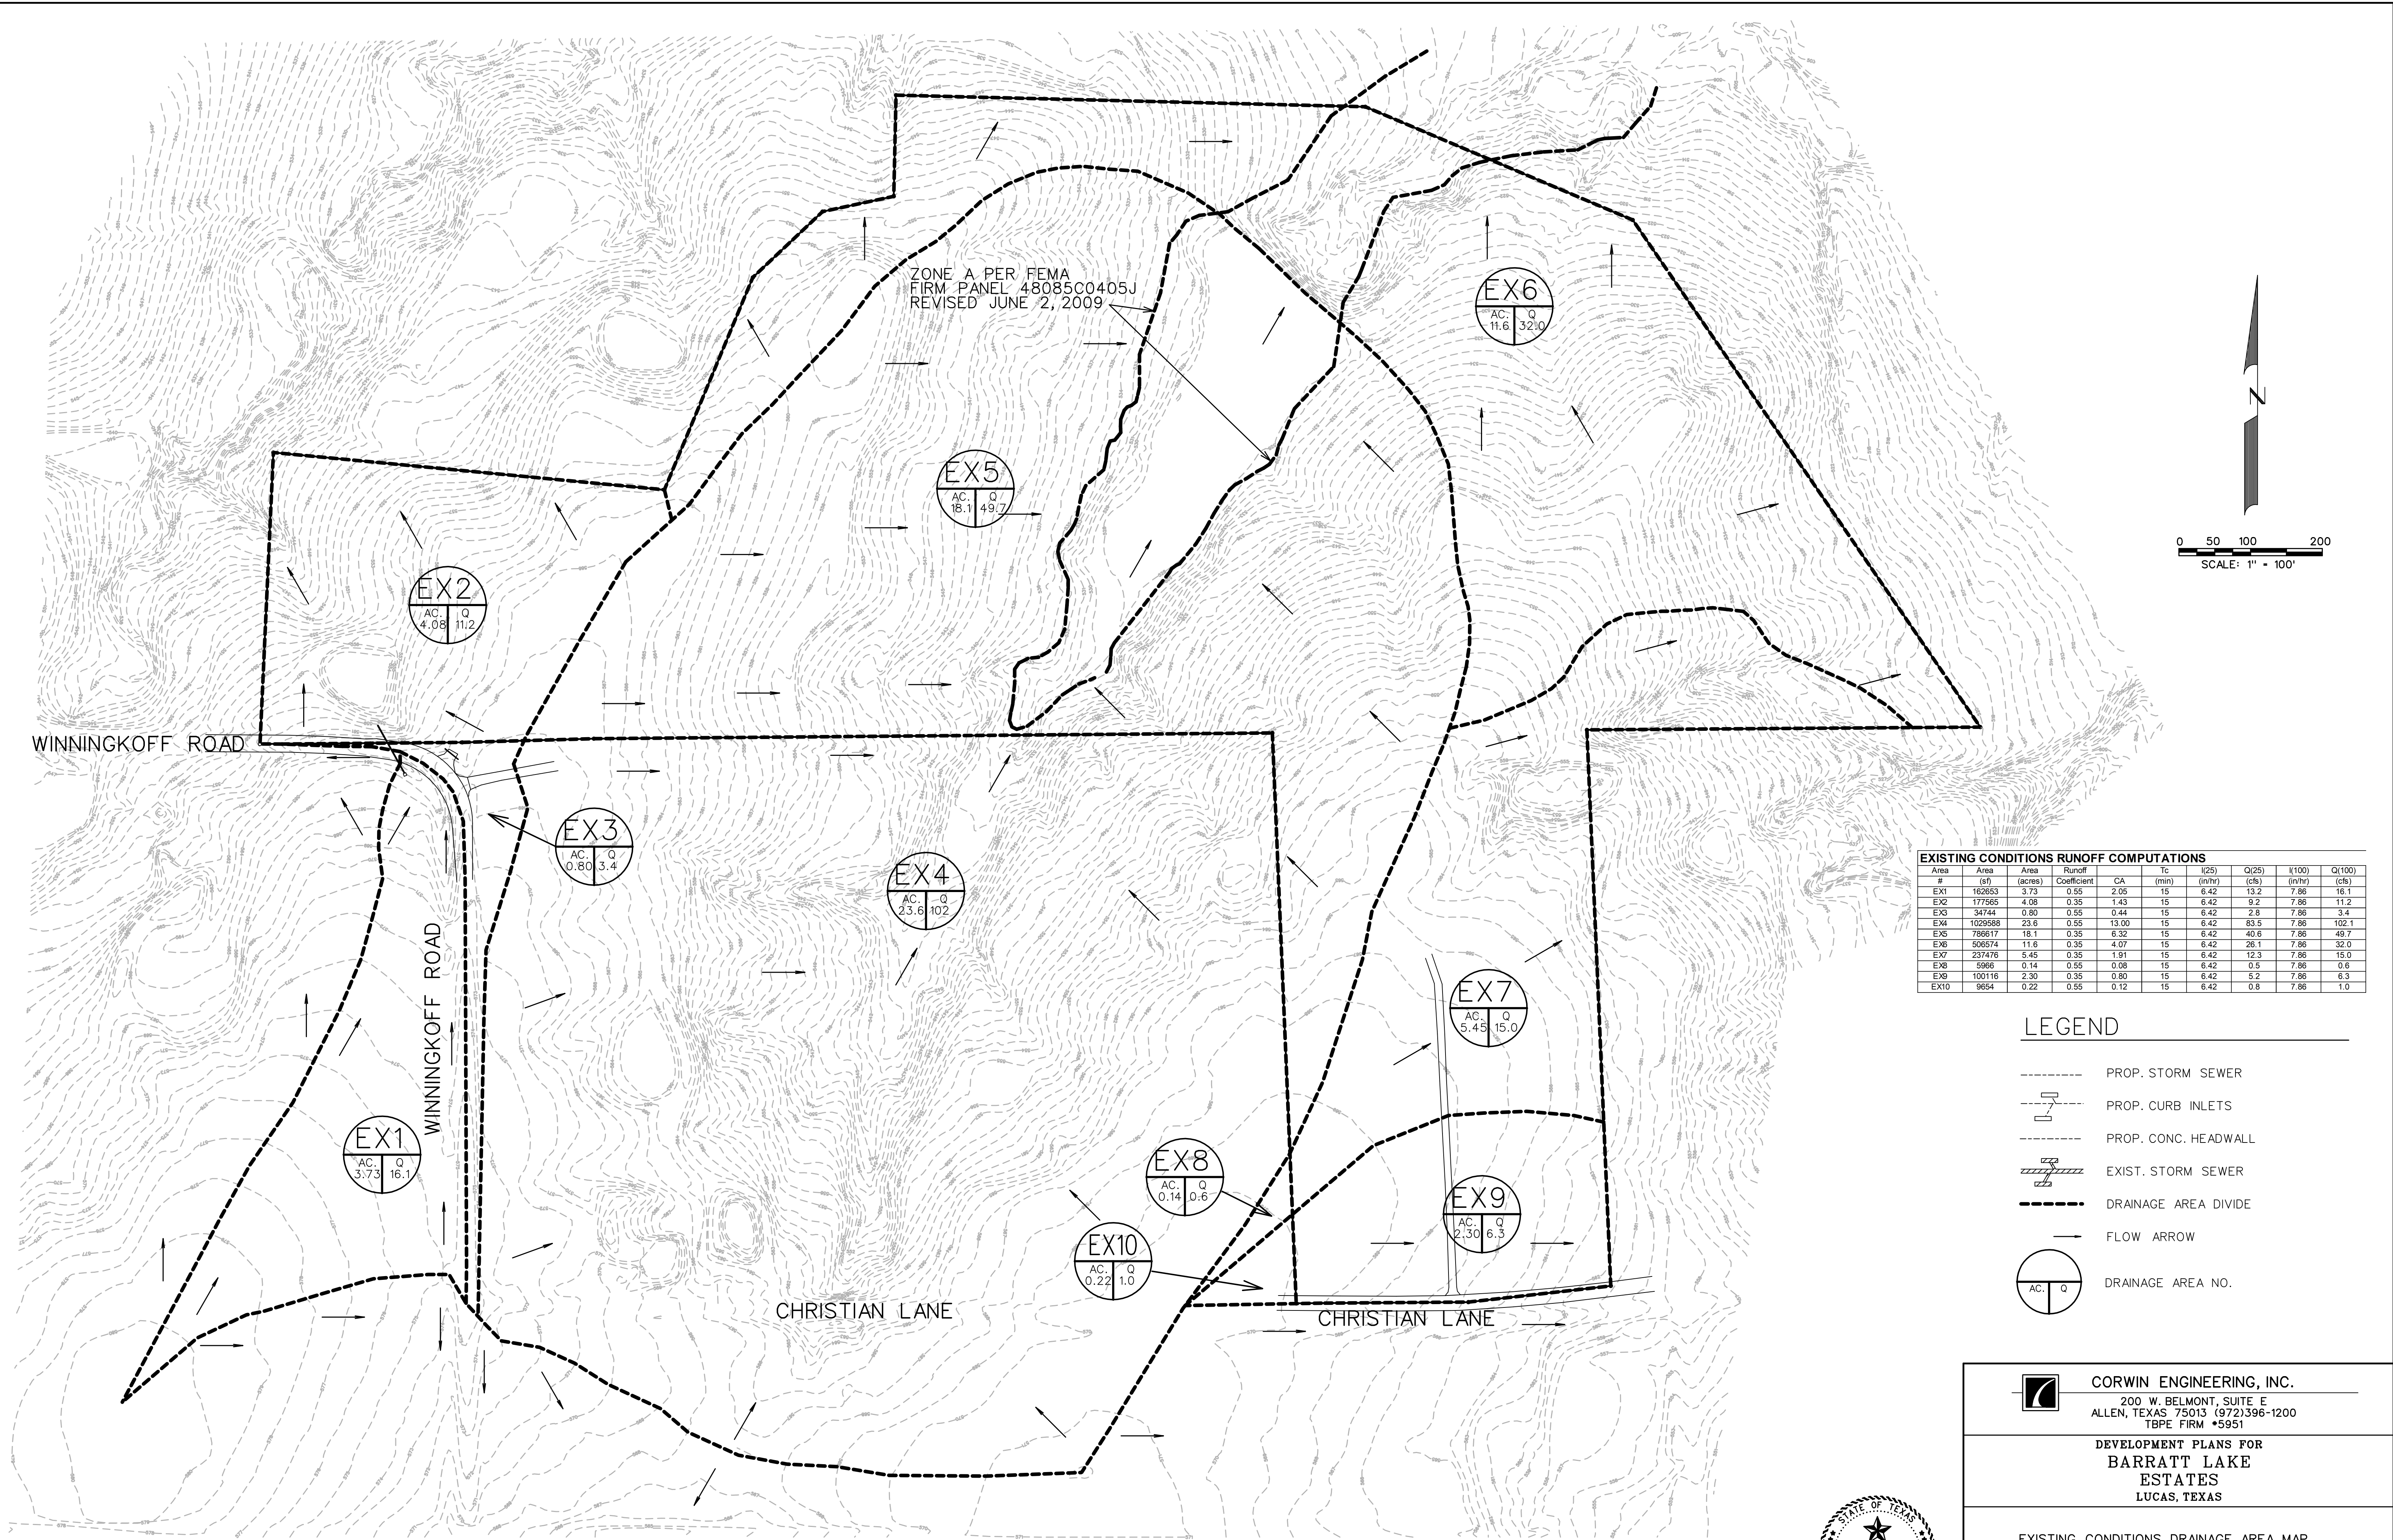

ZONE A PER FEMA
FIRM PANEL 48085C0405J
REVISED JUNE 2, 2009

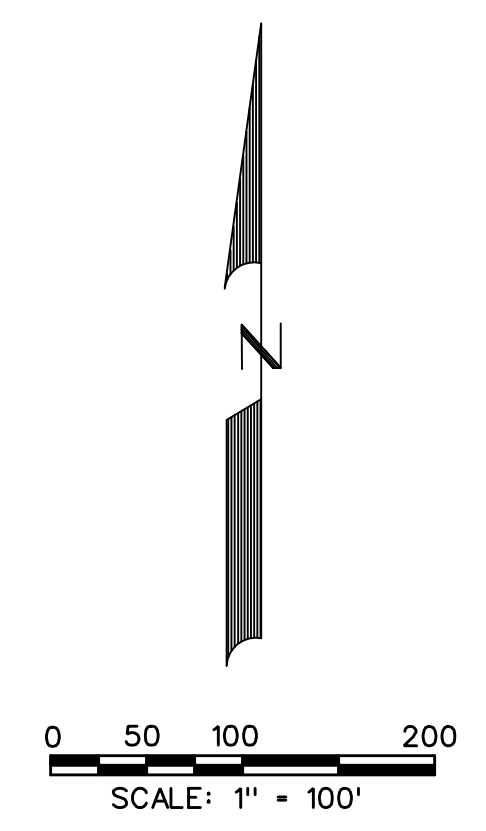

EXISTING CONDITIONS RUNOFF COMPUTATIONS

Area #	Area (sq)	Area (acres)	Runoff Coefficient	CA (mm)	Tc (min)	Q(25) (cfs)	Q(25) (m ³ /hr)	Q(100) (cfs)	Q(100) (m ³ /hr)
EX1	162653	3.73	0.55	2.05	15	6.42	13.2	7.86	16.1
EX2	177565	4.08	0.35	1.43	15	6.42	9.2	7.86	11.2
EX3	34744	0.80	0.55	0.44	15	6.42	2.8	7.86	3.4
EX4	1029588	23.6	0.55	13.00	15	6.42	83.5	7.86	102.1
EX5	786617	18.1	0.35	6.32	15	6.42	40.6	7.86	49.7
EX6	506574	11.6	0.35	4.07	15	6.42	26.1	7.86	32.0
EX7	237476	5.45	0.35	1.91	15	6.42	12.3	7.86	15.0
EX8	5966	0.14	0.55	0.08	15	6.42	0.5	7.86	0.6
EX9	100116	2.30	0.35	0.80	15	6.42	5.2	7.86	6.3
EX10	9654	0.22	0.55	0.12	15	6.42	0.8	7.86	1.0

LEGEND

- PROP. STORM SEWER
- PROP. CURB INLETS
- PROP. CONC. HEADWALL
- EXIST. STORM SEWER
- DRAINAGE AREA DIVIDE
- FLOW ARROW
- DRAINAGE AREA NO.


CORWIN ENGINEERING, INC.
200 W. BELMONT, SUITE E
ALLEN, TEXAS 75013 (972)396-1200
TBPE FIRM #5951

**DEVELOPMENT PLANS FOR
BARRATT LAKE
ESTATES
LUCAS, TEXAS**

EXISTING CONDITIONS DRAINAGE AREA MAP

DRAWN BY	DESIGNED BY	CHECKED BY	SHEET NO.
JOB NUMBER	DATE	SCALE:	12
20013	OCTOBER 2022	1"=100'	



AS-BUILT FEBRUARY 2023
INFORMATION PROVIDED BY
CONTRACTORS AND DEVELOPER
(NOT FIELD VERIFIED)

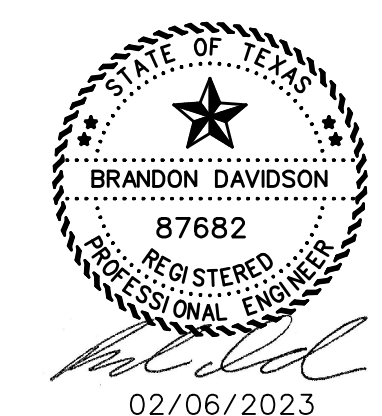

02/06/2023

DRIVEWAY CULVERT CALCULATIONS

OUTLET CONTROL												INLET CONTROL											
Block	Lot	Receives Drainage From Lots	Drainage Area (sf)	Flow (cfs)	Ditch Slope	Pipe Size (in)	No. of Barrels	Area (per barrel) (sf)	Full Flow Velocity (fps)	Hydraulic Head (ft)	Slope (ft/ft)	Outlet Flowline (ft)	Starting Tailwater (ft)	Length (ft)	Headwater Elevation (ft)	Upstream Soffit Elev. (ft)	Headwater Required (ft)	Inlet Flowline (ft)	Headwater Elevation (ft)	Inlet or Outlet Control?	U/S Elev. (ft)	U/S vs. Soffit (ft)	
A	1	1	18129	1.2	0.50%	18	1	1.7671	0.7	0.01	0.0001	0.00	1.50	28	1.51	1.64	0.02	0.14	0.91	Outlet Control	1.51	-0.13	
A	2	2	15122	1.0	3.00%	18	1	1.7671	0.6	0.01	0.0001	0.00	1.50	28	1.51	2.34	0.01	0.84	1.60	Outlet Control	1.60	-0.74	
A	3	2-3	19835	1.4	5.60%	18	1	1.7671	0.8	0.01	0.0002	0.00	1.50	28	1.51	3.07	0.03	1.57	2.34	Outlet Control	2.34	-0.72	
A	4	4,10-12	33900	2.3	5.60%	18	1	1.7671	1.3	0.03	0.0005	0.00	1.50	28	1.53	3.07	0.08	1.57	2.39	Outlet Control	2.39	-0.67	
A	5	4-5	93342	6.4	5.20%	18	1	1.7671	3.6	0.21	0.0037	0.00	1.50	28	1.71	2.96	0.57	1.46	2.78	Outlet Control	2.78	-0.18	
A	6	4-6	53094	3.7	4.60%	18	1	1.7671	2.1	0.07	0.0012	0.00	1.50	28	1.57	2.79	0.18	1.29	2.22	Outlet Control	2.22	-0.57	
A	7	7-10	54720	3.8	4.60%	18	1	1.7671	2.1	0.07	0.0013	0.00	1.50	28	1.57	2.79	0.20	1.29	2.23	Outlet Control	2.23	-0.55	
A	8	8-10	31406	2.2	4.60%	18	1	1.7671	1.2	0.02	0.0004	0.00	1.50	28	1.52	2.79	0.06	1.29	2.10	Outlet Control	2.10	-0.69	
A	9	9-10	23479	1.6	4.60%	18	1	1.7671	0.9	0.01	0.0002	0.00	1.50	28	1.51	2.79	0.04	1.29	2.07	Outlet Control	2.07	-0.71	
A	10	10-12	74193	5.1	4.60%	18	1	1.7671	2.9	0.13	0.0024	0.00	1.50	28	1.63	2.79	0.36	1.29	2.40	Outlet Control	2.40	-0.39	
A	11	11-12	28913	2.1	4.60%	18	1	1.7671	1.2	0.02	0.0004	0.00	1.50	28	1.52	2.79	0.06	1.29	2.10	Outlet Control	2.10	-0.69	
A	12	12	10099	0.7	2.10%	18	1	1.7671	0.4	0.00	0.0000	0.00	1.50	28	1.50	2.09	0.01	0.59	1.34	Outlet Control	1.50	-0.59	

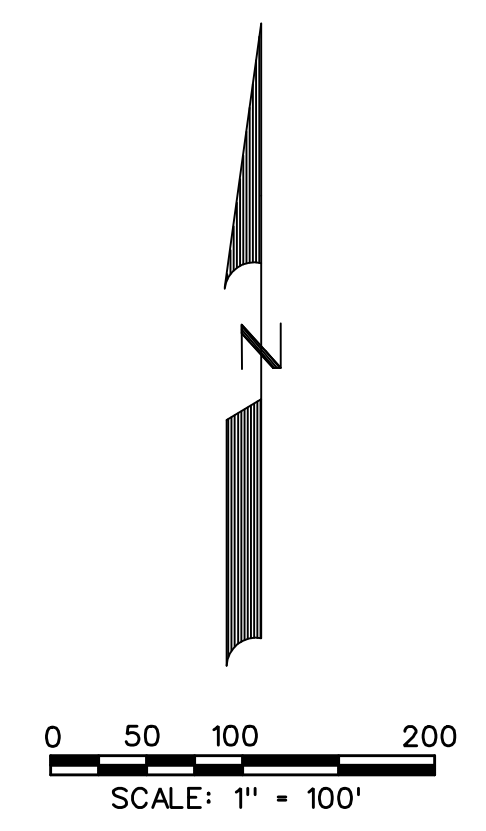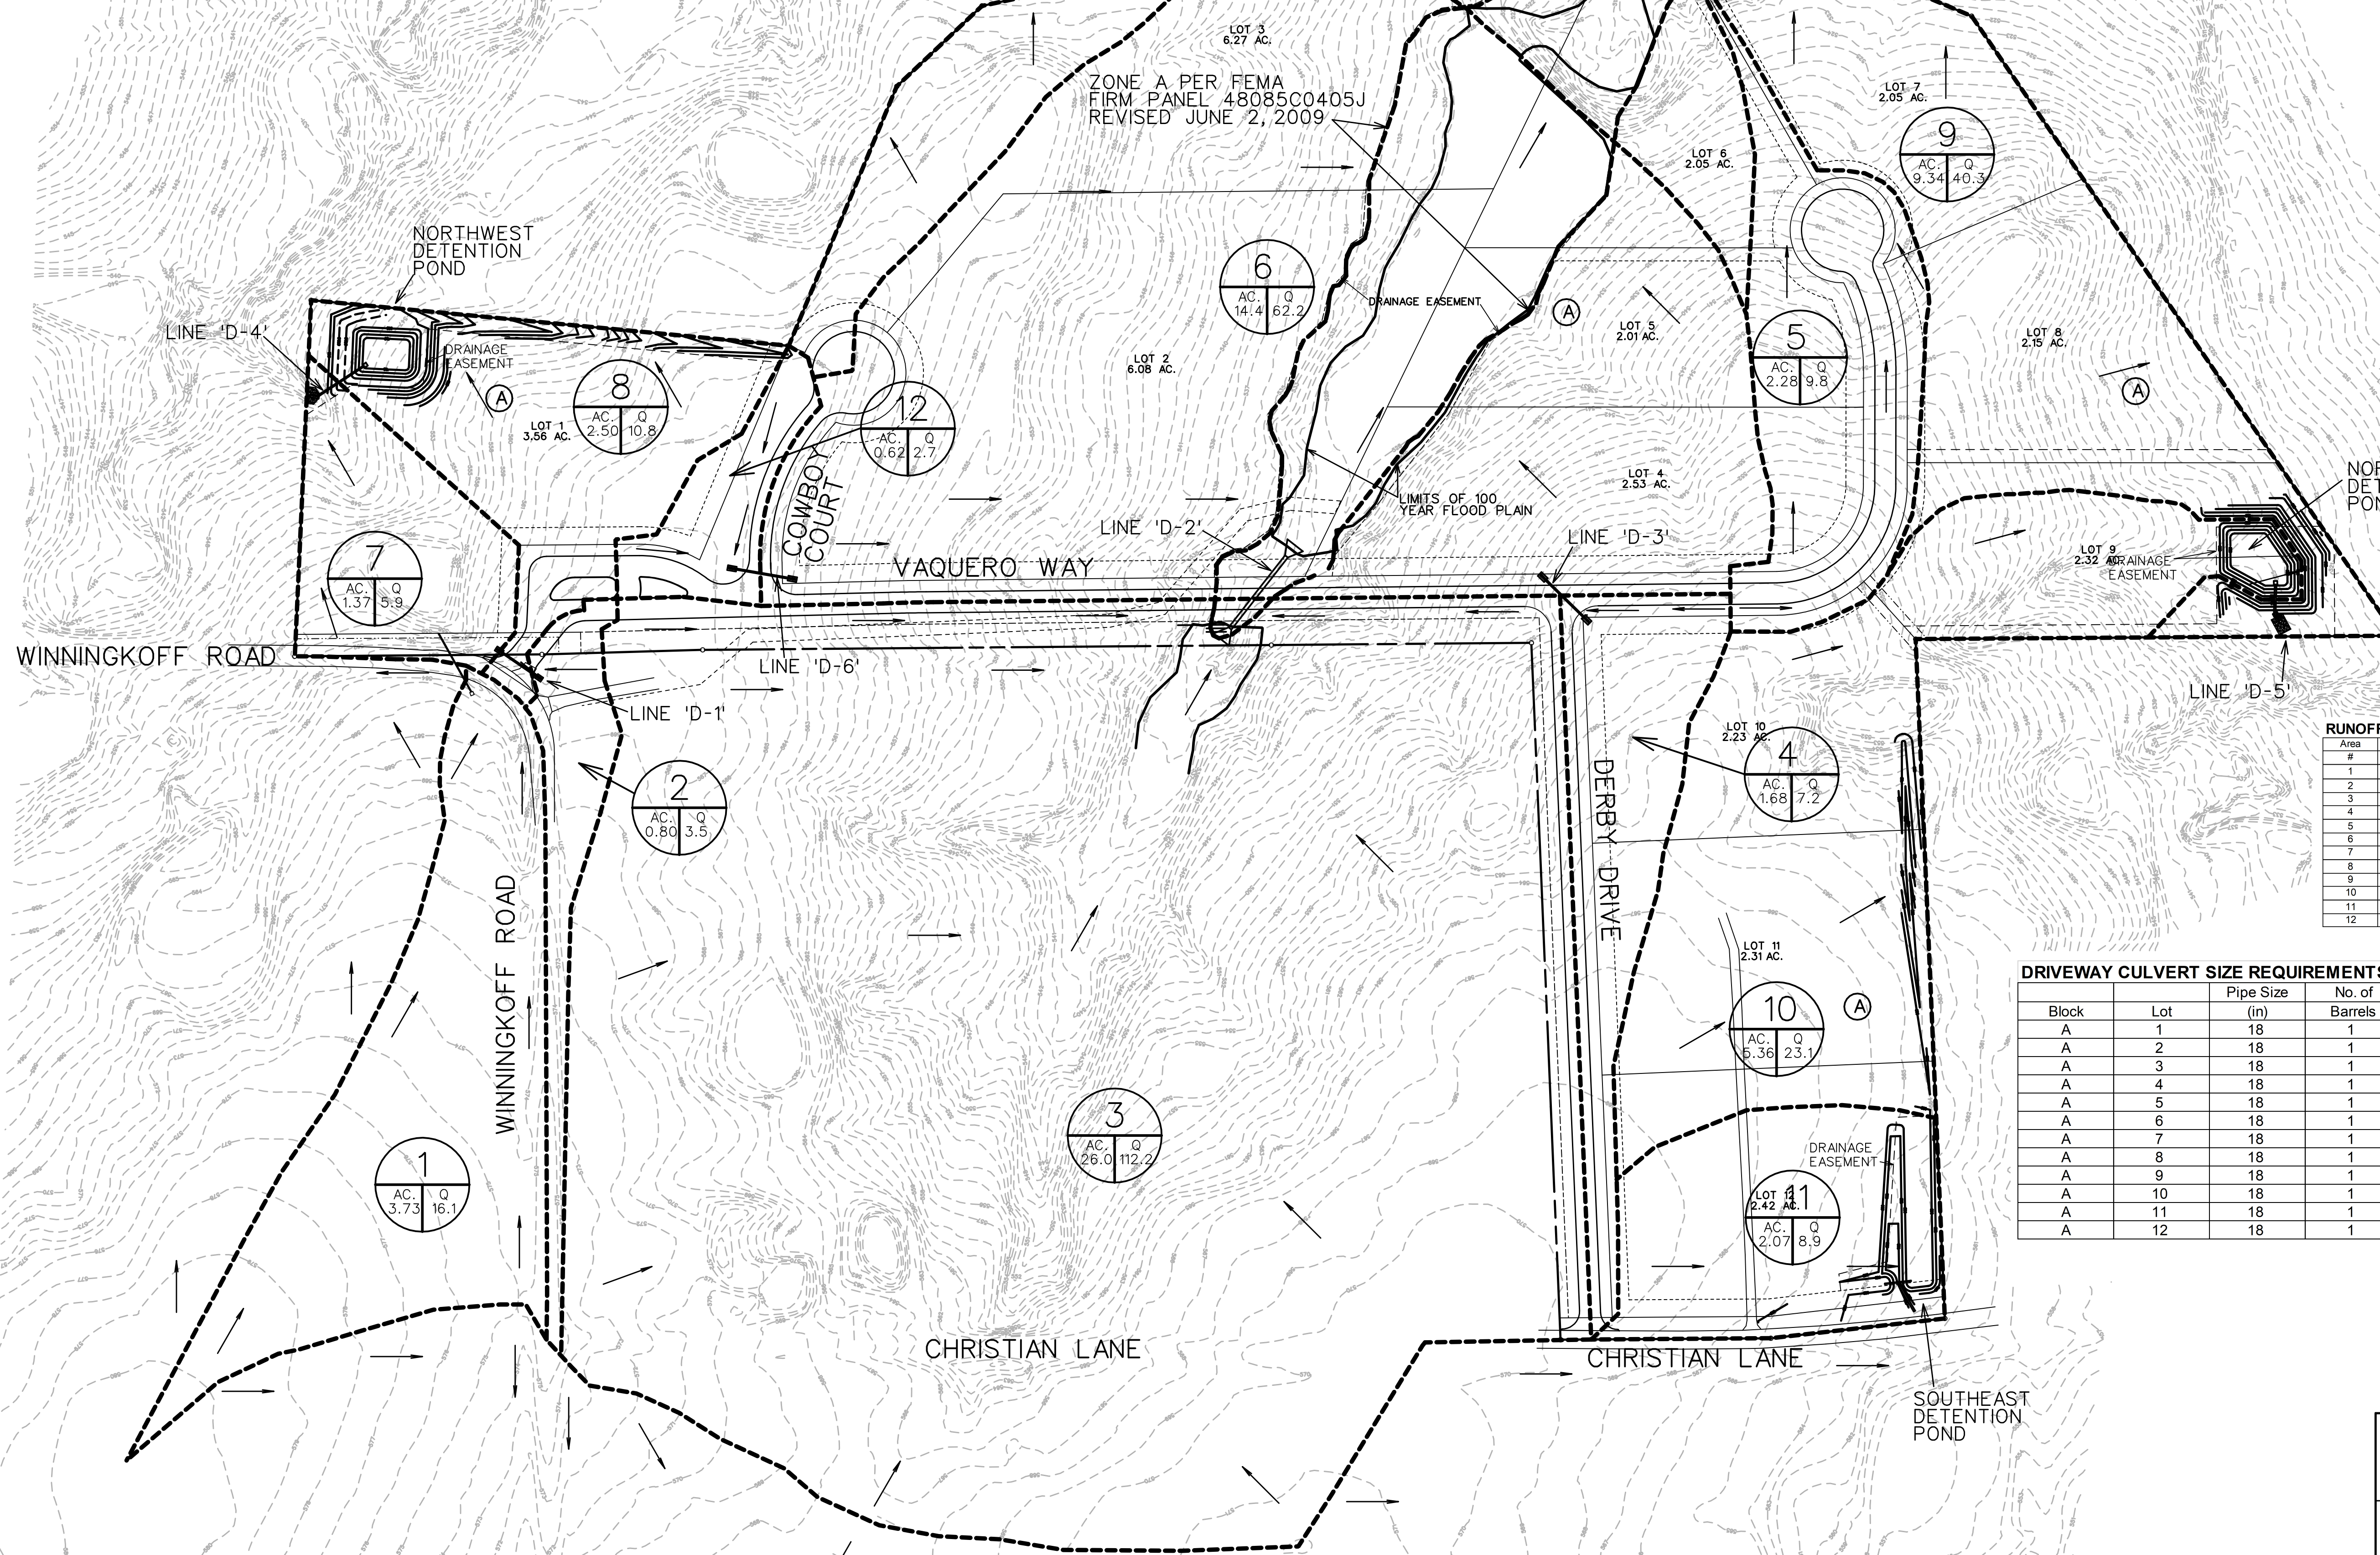


RUNOFF COMPUTATIONS


#	Area (sf)	Area (acres)	Coefficient	CA	Tc (min)	Q(25) (in/hr)	Q(50) (cfs)	Q(100) (in/hr)	Q(100) (cfs)
1	162653	3.73	0.55	2.05	15	6.42	13.2	7.86	16.1
2	35063	0.80	0.55	0.44	15	6.42	2.8	7.86	3.5
3	1131392	26.0	0.55	14.29	15	6.42	91.7	7.86	112.2
4	72975	1.68	0.55	0.92	15	6.42	5.9	7.86	7.2
5	99227	2.28	0.55	1.25	15	6.42	8.0	7.86	9.8
6	627636	14.4	0.55	7.92	15	6.42	50.9	7.86	62.2
7	59646	1.37	0.55	0.75	15	6.42	4.8	7.86	5.9
8	108739	2.50	0.55	1.37	15	6.42	8.8	7.86	10.8
9	406634	9.34	0.55	5.13	15	6.42	33.0	7.86	40.3
10	233322	5.36	0.55	2.95	15	6.42	18.9	7.86	23.1
11	89992	2.07	0.55	1.14	15	6.42	7.3	7.86	8.9
12	26666	0.62	0.55	0.34	15	6.42	2.2	7.86	2.7

DRIVEWAY CULVERT SIZE REQUIREMENTS

Block	Lot	Pipe Size (in)	No. of Barrels
A	1	18	1
A	2	18	1
A	3	18	1
A	4	18	1
A	5	18	1
A	6	18	1
A	7	18	1
A	8	18	1
A	9	18	1
A	10	18	1
A	11	18	1
A	12	18	1

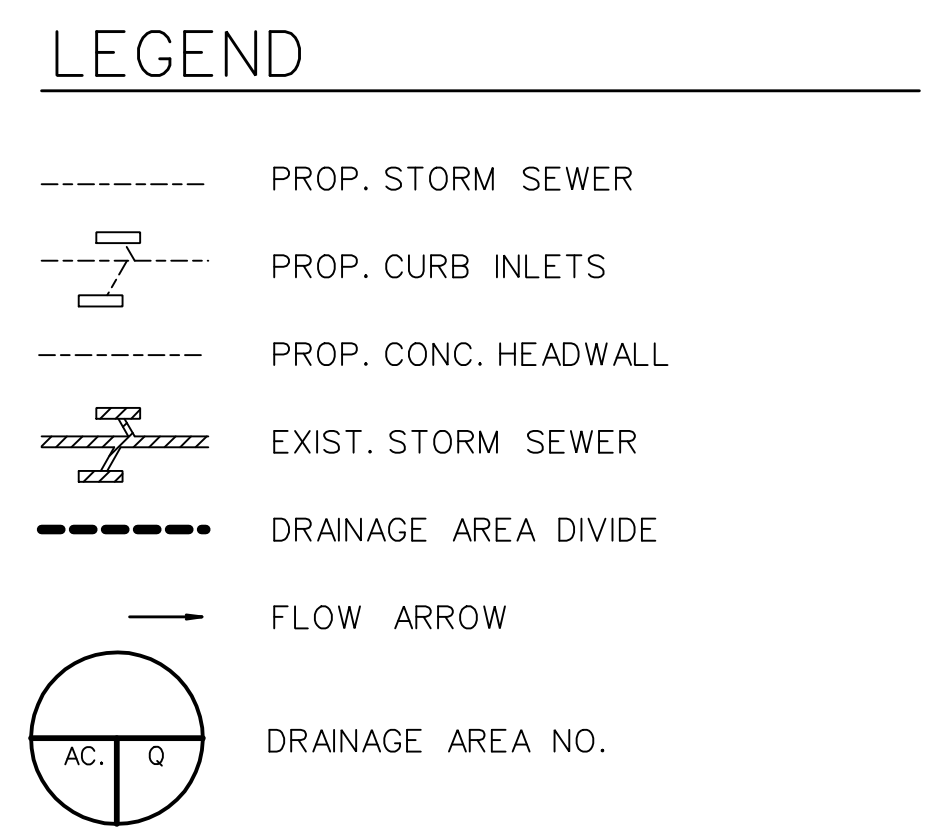

AS-BUILT FEBRUARY 2023
INFORMATION PROVIDED BY
CONTRACTORS AND DEVELOPER
(NOT FIELD VERIFIED)


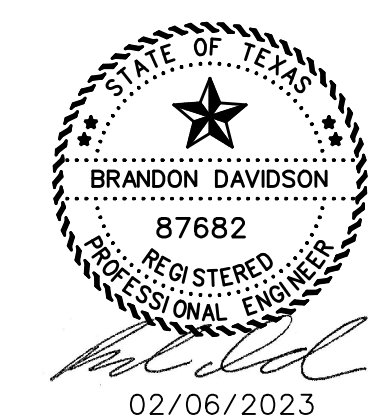


CORWIN ENGINEERING, INC.
200 W. BELMONT, SUITE E
ALLEN, TEXAS 75013 (972)396-1200
TBPE FIRM #5951


**DEVELOPMENT PLANS FOR
BARRATT LAKE
ESTATES
LUCAS, TEXAS**

PROPOSED CONDITIONS DRAINAGE AREA MAP

DRAWN BY	DESIGNED BY	CHECKED BY	SHEET NO.
JOB NUMBER	DATE	SCALE:	13
20013	OCTOBER 2022	1"=100'	

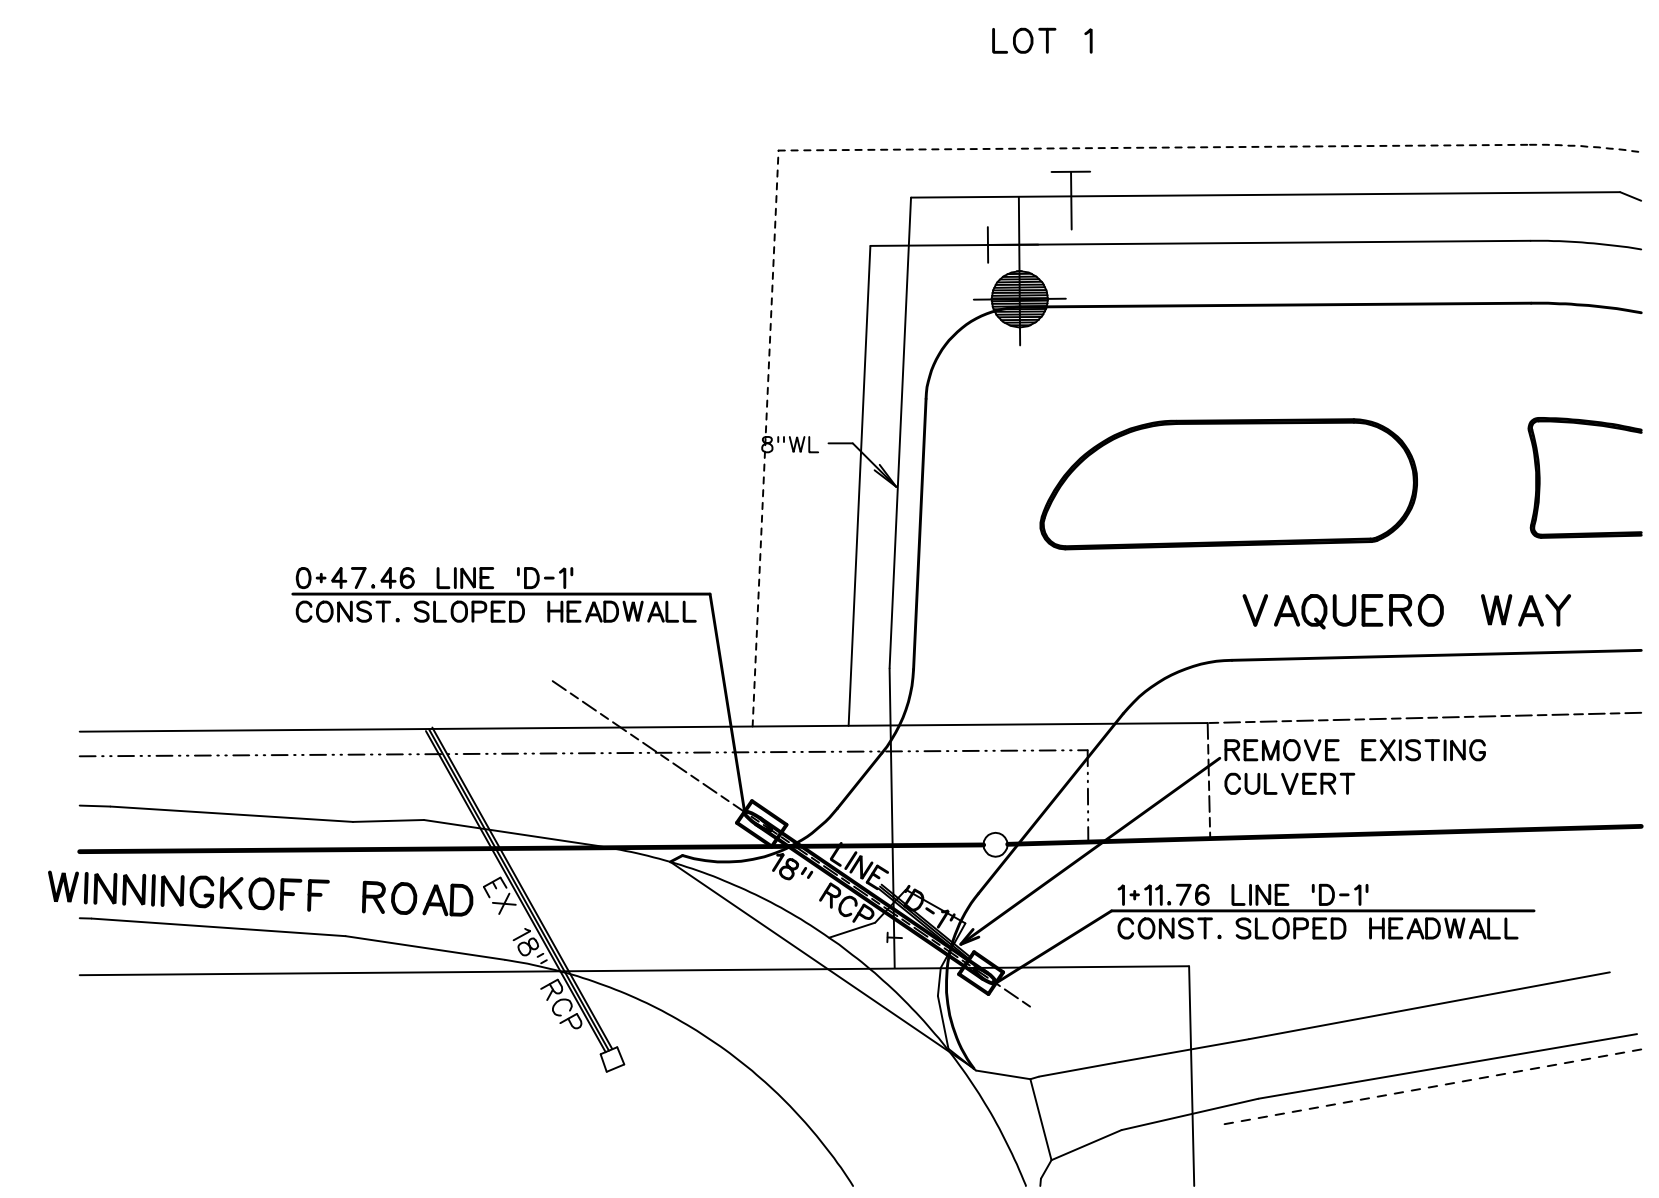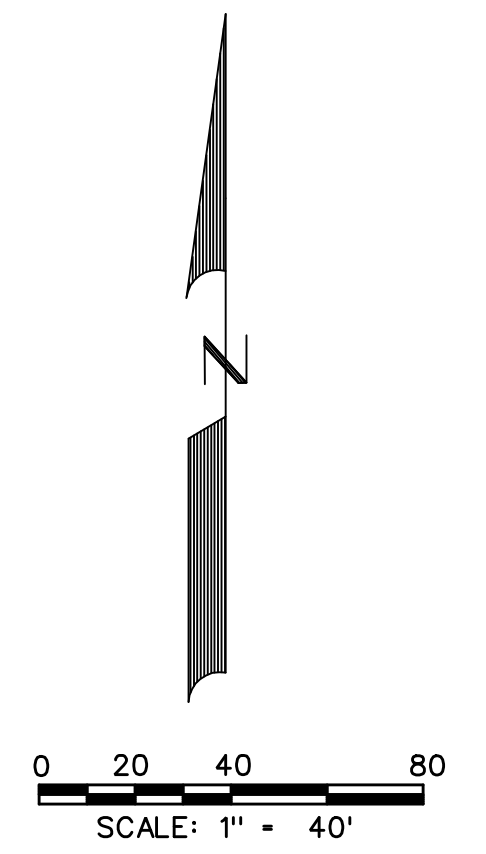

LINE 'D-1'

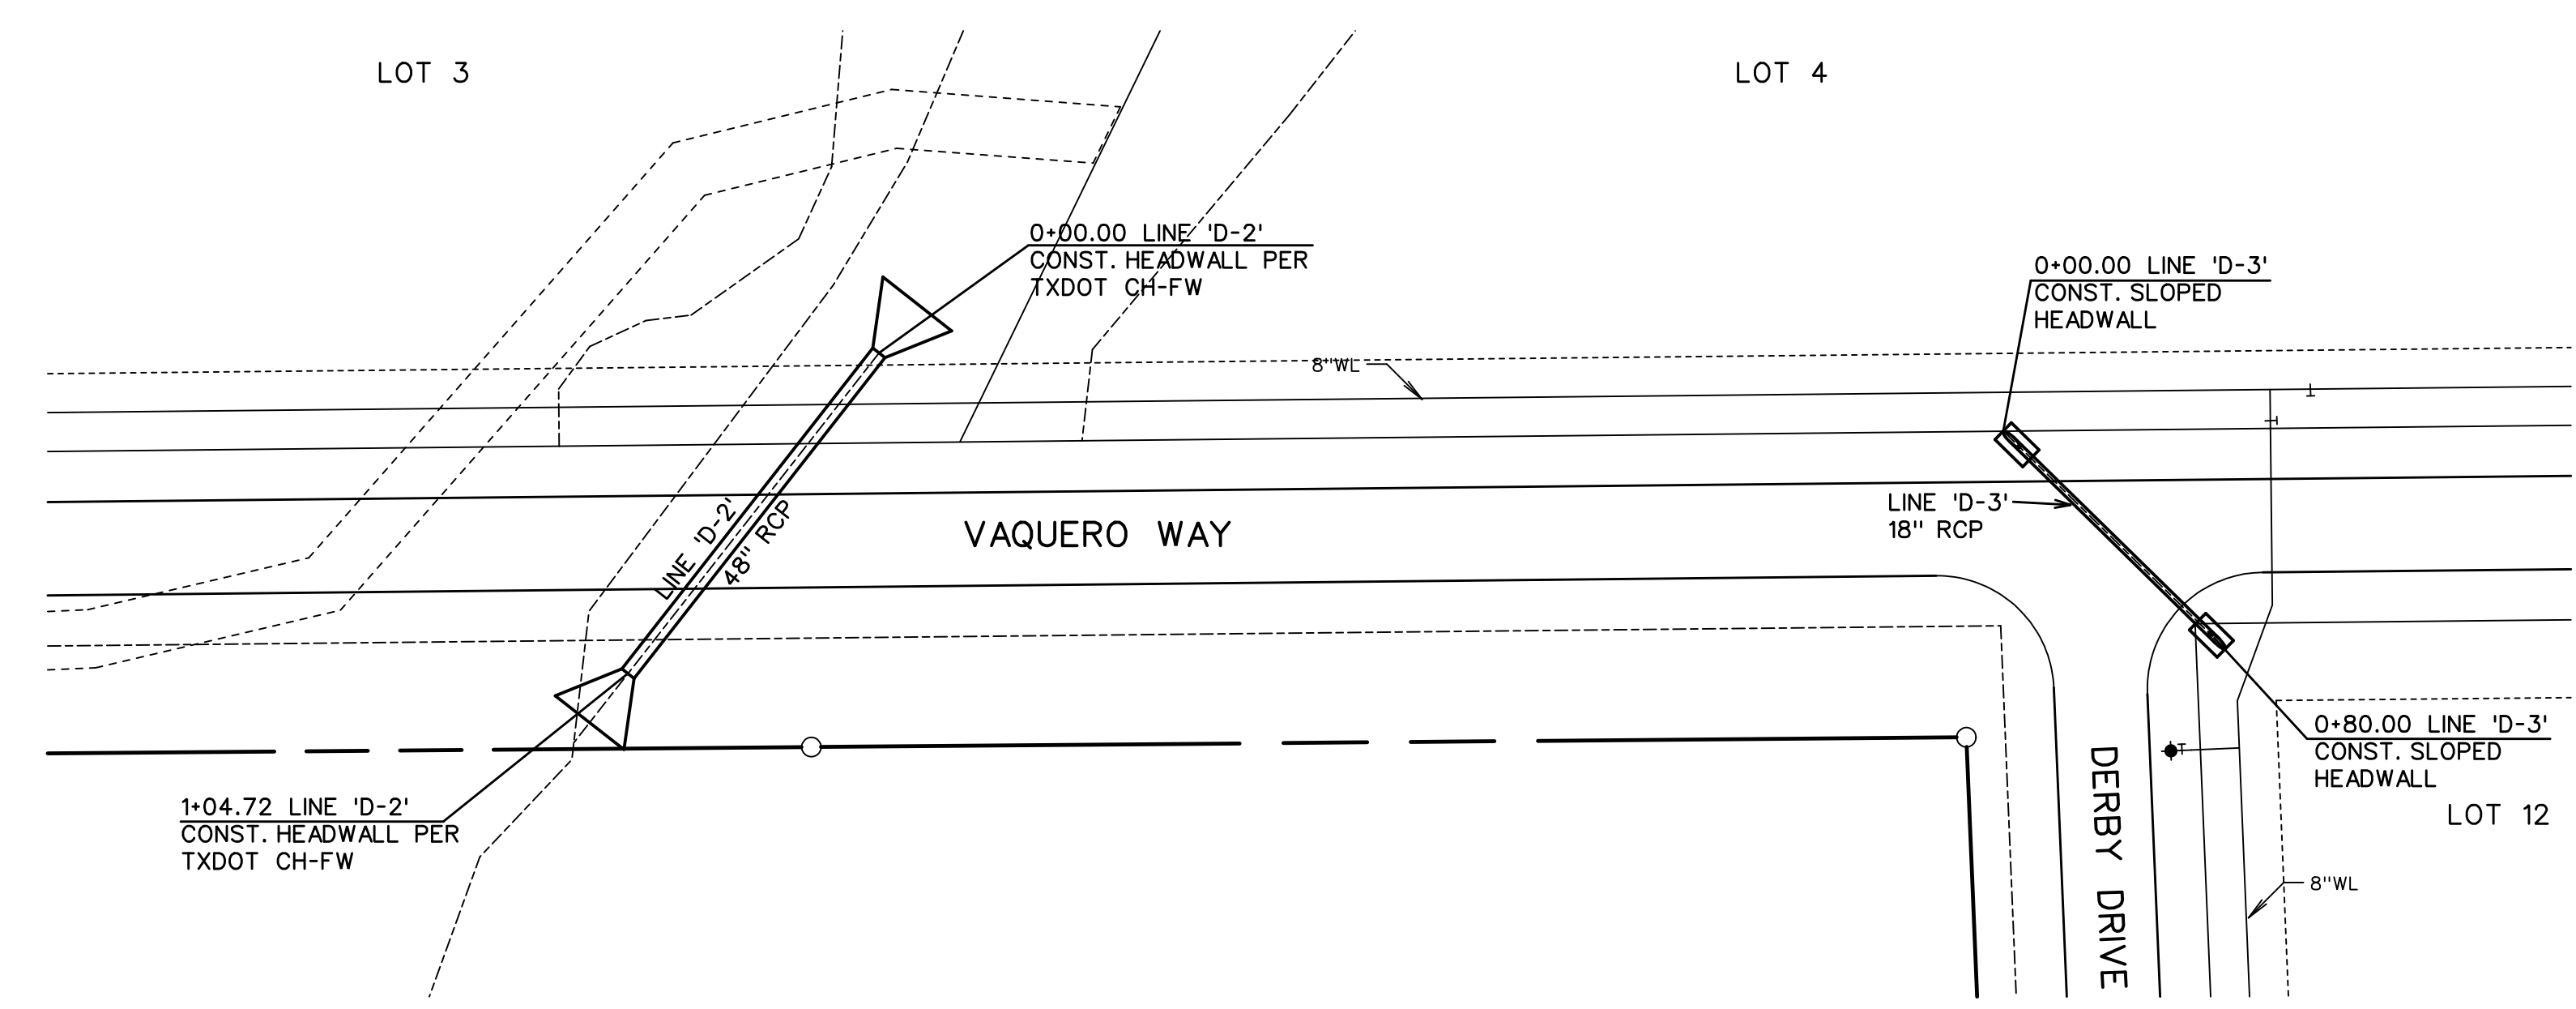

LINE 'D-2'

LINE 'D-3'

- LEGEND**
- (B) - BLOCK LABEL
 - (I) - INLET NUMBER
 - (1) - CURVE NUMBER
 - - SANITARY SEWER
 - ⊕ - WATER
 - ==== - PROPOSED STORM SEWER
 - //// - EXISTING STORM SEWER

LINE 'D-1'		LINE 'D-2'		LINE 'D-3'	
<p>18" RCP $Q_{100} = 3.5$ cfs $V_{100} = 2.0$ fps $S = 0.0011$ CAP = 17.6 cfs PARTIAL FLOW</p>		<p>48" RCP $Q_{100} = 112.3$ cfs $V_{100} = 8.9$ fps $S = 0.0061$ CAP = 112.3 cfs</p>		<p>18" RCP $Q_{100} = 7.2$ cfs $V_{100} = 4.1$ fps $S = 0.0048$ CAP = 7.4 cfs PARTIAL FLOW</p>	
570	570	540	540	560	560
565	565	535	535	555	555
560	560	530	530	550	550
555	555	525	525	545	545
<p>18" CLASS IV RCP @ 2.80% PROPOSED GRADE EXISTING GROUND 0+47.46 LINE 'D-1' CONST. SLOPED HEADWALL 1+11.76 LINE 'D-1' CONST. SLOPED HEADWALL 8" WL 1+06.09 8" WL FL=561.35 0+86.05 8" WL FL=562.30 18" FL=563.36 18" FL=565.16</p>		<p>48" RCP @ 0.50% PROPOSED GRADE EXISTING GROUND 0+00.00 LINE 'D-2' CONST. HEADWALL PER TXDOT CH-FW 1+04.72 LINE 'D-2' CONST. HEADWALL PER TXDOT CH-FW 8" WL HW=533.76 TW=530.64 48" FL=528.48 48" FL=529.00</p>		<p>18" RCP @ 2.98% PROPOSED GRADE EXISTING GROUND 0+00.00 LINE 'D-3' CONST. SLOPED HEADWALL 0+80.00 LINE 'D-3' CONST. SLOPED HEADWALL 8" WL 18" FL=548.62 18" FL=551.00</p>	
LINE 'D-1'		LINE 'D-2'		LINE 'D-3'	
0+00	1+00	0+00	1+00	0+00	1+00

AS-BUILT FEBRUARY 2023
 INFORMATION PROVIDED BY
 CONTRACTORS AND DEVELOPER
 (NOT FIELD VERIFIED)




CORWIN ENGINEERING, INC.
 200 W. BELMONT, SUITE E
 ALLEN, TEXAS 75013 (972)396-1200
 TBPE FIRM #5951

DEVELOPMENT PLANS FOR
BARRATT LAKE ESTATES
 LUCAS, TEXAS

STORM SEWER PLAN AND PROFILE
 LINES 'D-1', 'D-2' AND 'D-3'

DRAWN BY	DESIGNED BY	CHECKED BY	SHEET NO.
JOB NUMBER	DATE	SCALE: HOR: 1"=40' VER: 1"=4'	14
20013	OCTOBER 2022		

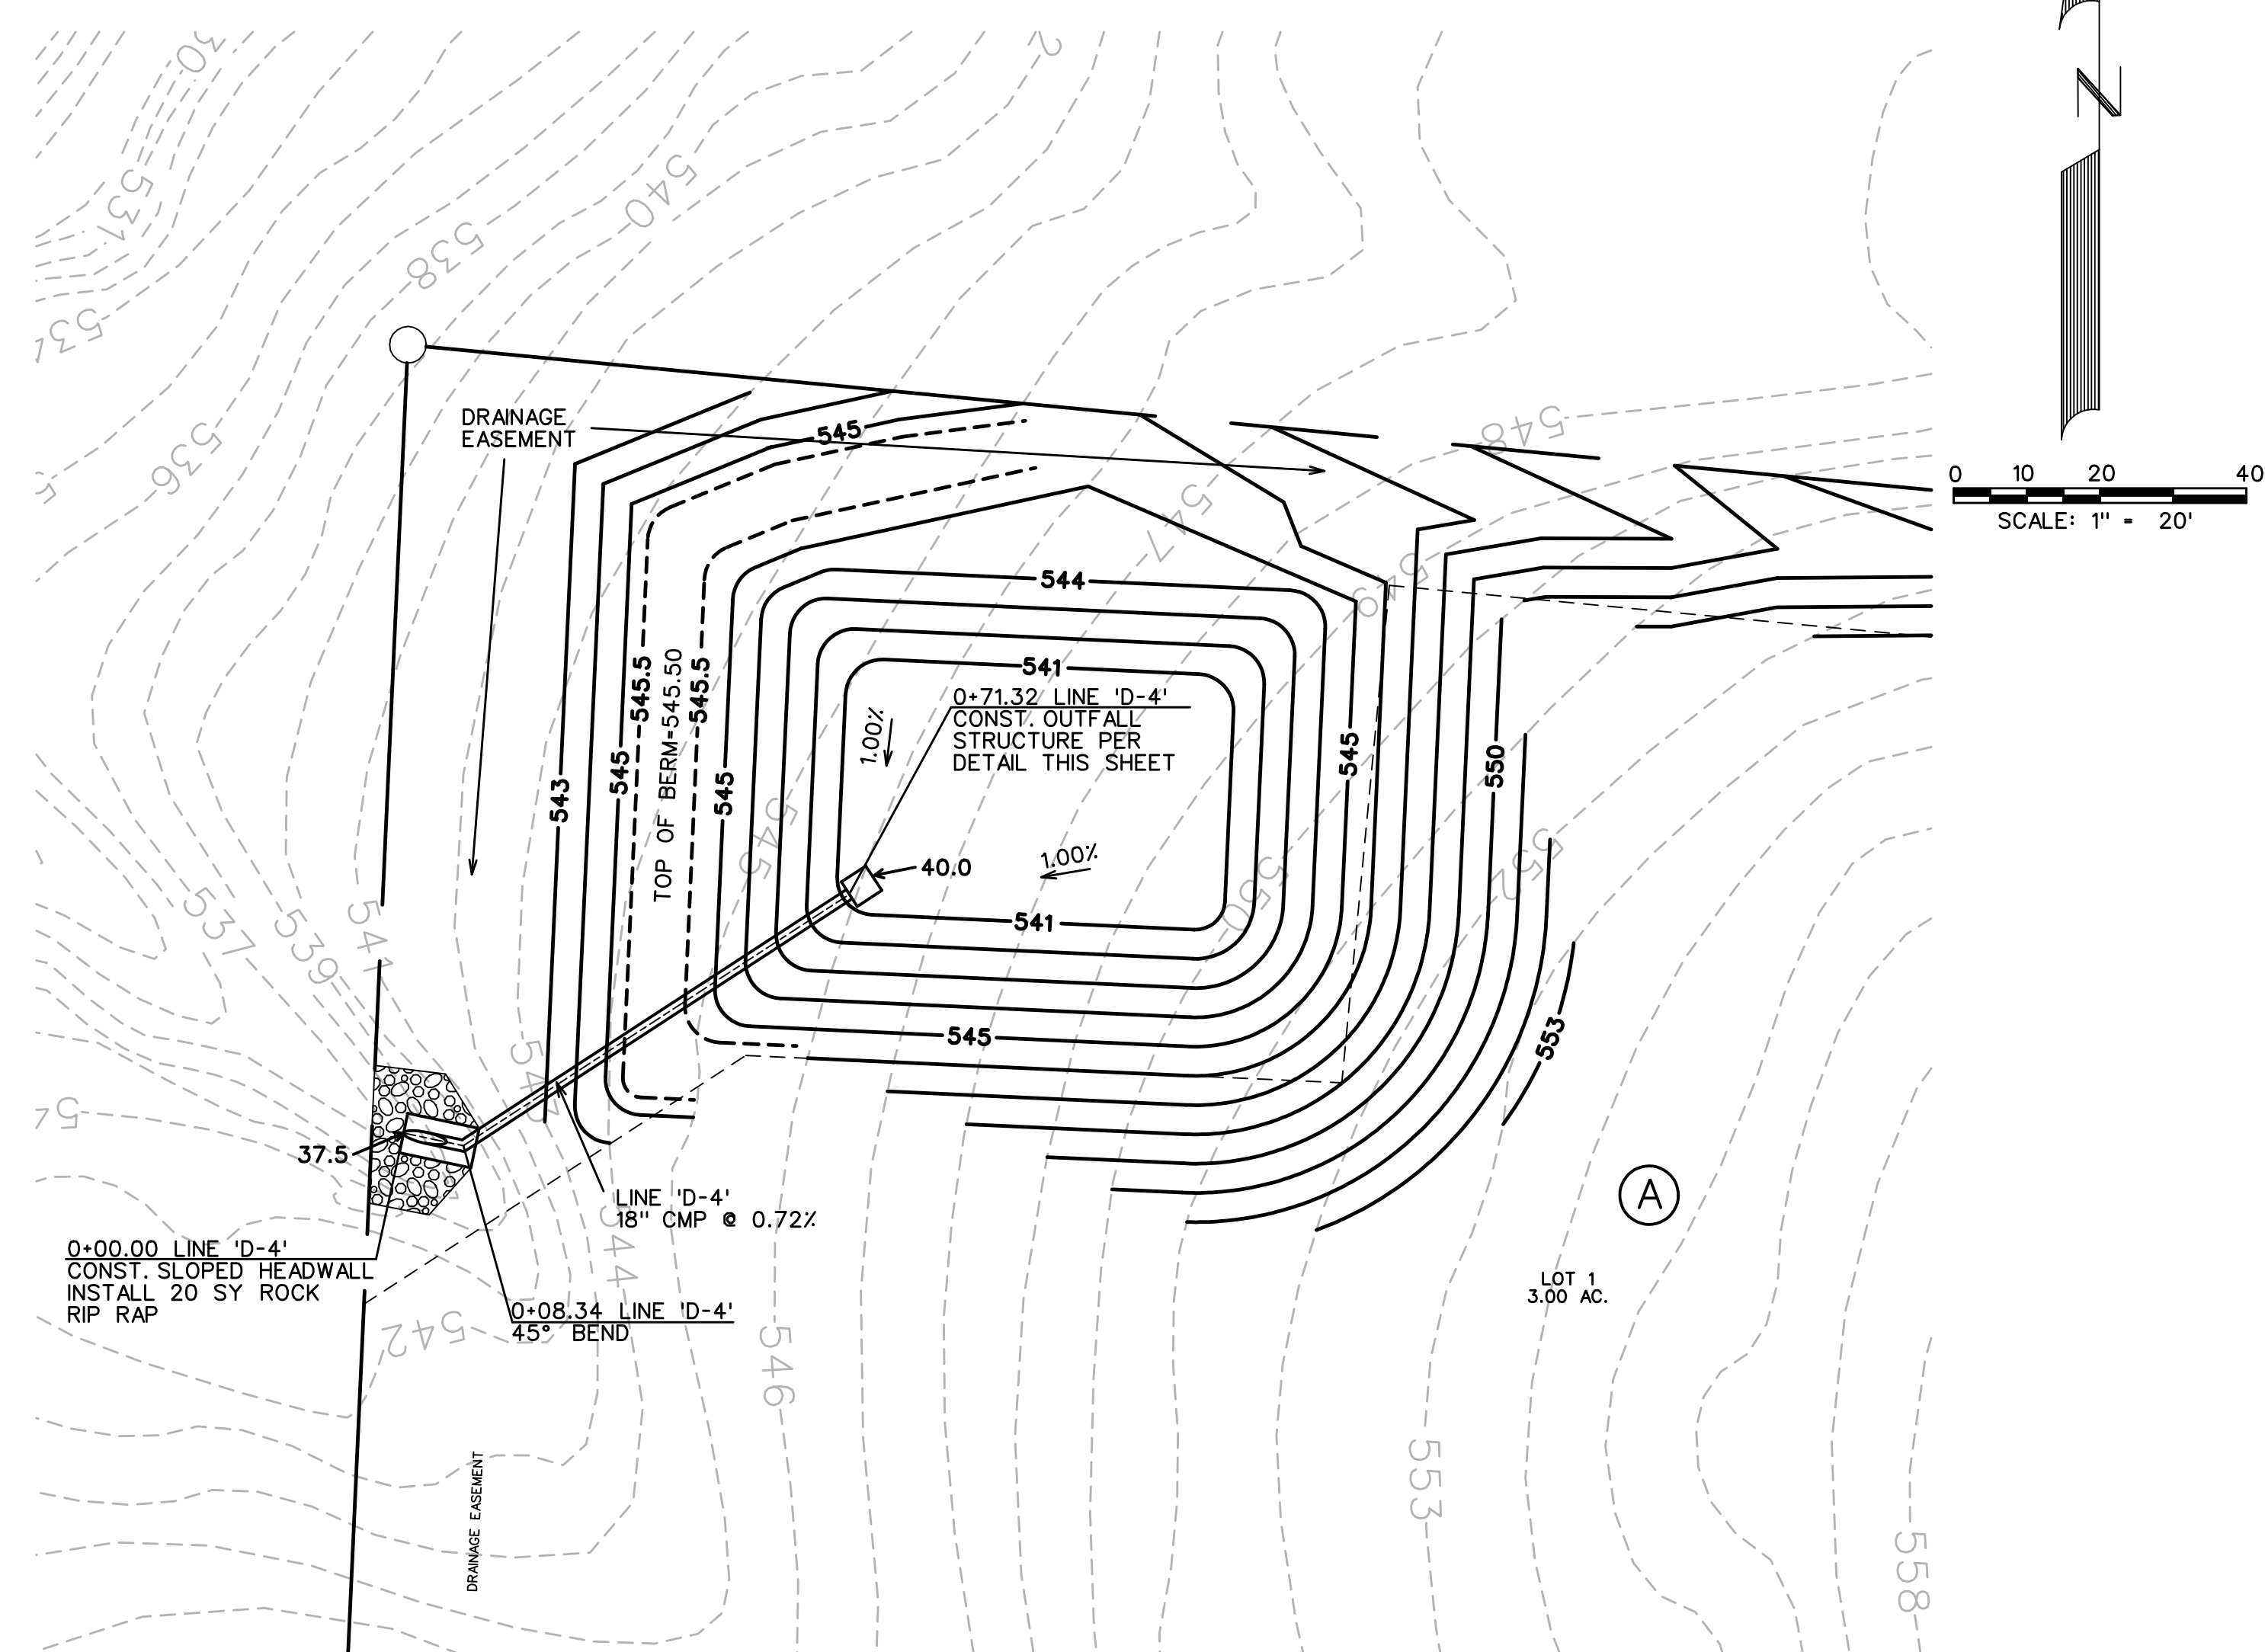

Stage-Discharge Table Opening #1 - 0.7' w x 0.5' h opening Opening #2 - 2' Weir @ 544.35

Stage	H	Area	Discharge	Weir Length	Depth of Flow Over Weir	Weir Discharge	Total Discharge	Allowable Discharge	Above (Below)
540.00	0	0	0	0	0	0	0		
541.00	0.75	0.35	1.5			1.5			
542.00	1.75	0.35	2.2			2.2			
542.75	2.50	0.35	2.7			2.7	2.7	2.7	(0.0) 2-year
543.00	2.75	0.35	2.8			2.8			
543.25	3.01	0.35	2.9			2.9	3.3	(0.4)	5-year
544.00	3.75	0.35	3.3			3.3			
543.95	3.70	0.35	3.2			3.2	4.3	(1.1)	25-year
544.48	4.23	0.35	3.5	12.0	0.13	1.9	5.3	5.3	0.0 100-year
545.00	4.75	0.35	3.7	12.0	0.65	20.9	24.6		
546.00	5.75	0.35	4.0	12.0	1.65	84.7	88.7		

Elevation-Storage Table

Elevation (cf)	Volume
540	0
541	917
542	3131
543	6163
544	10128
545	15251

Elevation Calculations

Event	Maximum Release Rate	Storage Requirement	Occurs at Elevation
2-year	2.7	5411	542.75
5-year	3.3	7204	543.26
25-year	4.3	9878	543.95
100-year	5.3	12583	544.48

Northwest Detention Pond
2-Year Storm
Pre-Project Runoff Calculations

Area #	Area (sf)	Area (acres)	Coefficient	Tc (min)	Rainfall Intensity (in/hr)	Q - Undeveloped (cfs)
EX1-EX3	374962	8.61	0.40	15	4.00	13.9
1.7	222299	5.10	0.55	15	4.00	11.2
Allowed Release=						2.7

Post-Project Runoff Calculations

Area #	Area (sf)	Area (acres)	Coefficient	Tc (min)	Rainfall Intensity (in/hr)	Post Development (cfs)	Difference between Pre and Post Development Conditions
2.8	143802	3.30	0.55	15	4.00	7.3	4.6

5-Year Storm
Pre-Project Runoff Calculations

Area #	Area (sf)	Area (acres)	Coefficient	Tc (min)	Rainfall Intensity (in/hr)	Q - Undeveloped (cfs)
EX1-EX3	374962	8.61	0.40	15	4.91	17.1
1.7	222299	5.10	0.55	15	4.91	13.8
Allowed Release=						3.3

Post-Project Runoff Calculations

Area #	Area (sf)	Area (acres)	Coefficient	Tc (min)	Rainfall Intensity (in/hr)	Post Development (cfs)	Difference between Pre and Post Development Conditions
2.8	143802	3.30	0.55	15	4.91	8.9	5.6

25-Year Storm
Pre-Project Runoff Calculations

Area #	Area (sf)	Area (acres)	Coefficient	Tc (min)	Rainfall Intensity (in/hr)	Q - Undeveloped (cfs)
EX1-EX3	374962	8.61	0.40	15	6.42	22.3
1.7	222299	5.10	0.55	15	6.42	18.0
Allowed Release=						4.3

Post-Project Runoff Calculations

Area #	Area (sf)	Area (acres)	Coefficient	Tc (min)	Rainfall Intensity (in/hr)	Post Development (cfs)	Difference between Pre and Post Development Conditions
2.8	143802	3.30	0.55	15	6.42	11.7	7.3

100-Year Storm
Pre-Project Runoff Calculations

Area #	Area (sf)	Area (acres)	Coefficient	Tc (min)	Rainfall Intensity (in/hr)	Q - Undeveloped (cfs)
EX1-EX3	374962	8.61	0.40	15	7.86	27.3
1.7	222299	5.10	0.55	15	7.86	22.1
Allowed Release=						5.3

Post-Project Runoff Calculations

Area #	Area (sf)	Area (acres)	Coefficient	Tc (min)	Rainfall Intensity (in/hr)	Post Development (cfs)	Difference between Pre and Post Development Conditions
2.8	143802	3.30	0.55	15	7.86	14.3	9.0

2 Year Storm

Storm Duration	Inflow Duration	Area (AC)	Future "C"	Future "K"	Future "CA"	Rainfall intensity	Inflow (cfs)	Inflow Volume (cubic ft.)	Outflow Volume (cubic ft.)	Storage Volume (cubic ft.)	Storage Volume (acre-ft.)	Outflow (cfs)
10	25	3.30	0.55	1.00	1.82	4.82	8.7	5248	2020	3228	0.07	2.7
20	35	3.30	0.55	1.00	1.82	3.44	6.2	7488	2827	4661	0.11	2.7
30	45	3.30	0.55	1.00	1.82	2.71	4.9	8867	3635	6232	0.12	2.7
40	55	3.30	0.55	1.00	1.82	2.28	4.1	9854	4443	6411	0.12	2.7
50	65	3.30	0.55	1.00	1.82	1.95	3.5	10620	5251	5369	0.12	2.7
60	75	3.30	0.55	1.00	1.82	1.72	3.1	11247	6059	5188	0.12	2.7
70	85	3.30	0.55	1.00	1.82	1.54	2.8	11778	6865	4911	0.11	2.7
80	95	3.30	0.55	1.00	1.82	1.40	2.5	12238	7674	4664	0.10	2.7

Maximum Storage Required 5411

5 Year Storm

Storm Duration	Inflow Duration	Area (AC)	Future "C"	Future "K"	Future "CA"	Rainfall intensity	Inflow (cfs)	Inflow Volume (cubic ft.)	Outflow Volume (cubic ft.)	Storage Volume (cubic ft.)	Storage Volume (acre-ft.)	Outflow (cfs)
10	25	3.30	0.55	1.00	1.82	5.82	10.6	6337	2483	3854	0.09	3.3
20	35	3.30	0.55	1.00	1.82	4.28	7.8	9321	3476	5845	0.13	3.3
30	45	3.30	0.55	1.00	1.82	3.43	6.2	11214	4469	6744	0.16	3.3
40	55	3.30	0.55	1.00	1.82	2.89	5.2	12586	5463	7124	0.16	3.3
50	65	3.30	0.55	1.00	1.82	2.51	4.6	13660	6456	7204	0.17	3.3
60	75	3.30	0.55	1.00	1.82	2.22	4.0	14542	7449	7093	0.16	3.3
70	85	3.30	0.55	1.00	1.82	2.01	3.6	15290	8442	6848	0.16	3.3
80	95	3.30	0.55	1.00	1.82	1.83	3.3	15941	9435	6505	0.15	3.3

Maximum Storage Required 7204

25 Year Storm



Storm Duration	Inflow Duration	Area (AC)	Future "C"	Future "K"	Future "CA"	Rainfall intensity	Inflow (cfs)	Inflow Volume (cubic ft.)	Outflow Volume (cubic ft.)	Storage Volume (cubic ft.)	Storage Volume (acre-ft.)	Outflow (cfs)
10	25	3.30	0.55	1.00	1.82	7.55	13.7	8226	3244	4982	0.11	4.3
20	35	3.30	0.55	1.00	1.82	5.62	10.2	12242	4541	7701	0.18	4.3
30	45	3.30	0.55	1.00	1.82	4.54	8.3	14853	5839	9014	0.21	4.3
40	55	3.30	0.55	1.00	1.82	3.85	7.0	16782	7137	9645	0.22	4.3
50	65	3.30	0.55	1.00	1.82	3.36	6.1	18313	8434	9678	0.23	4.3
60	75	3.30	0.55	1.00	1.82	3.00	5.4	19584	9732	9853	0.23	4.3
70	85	3.30	0.55	1.00	1.82	2.71	4.9	20674	11029	9645	0.22	4.3
80	95	3.30	0.55	1.00	1.82	2.48	4.5	21630	12327	9304	0.21	4.3

Maximum Storage Required 9878

100 Year Storm

Storm Duration	Inflow Duration	Area (AC)	Future "C"	Future "K"	Future "CA"	Rainfall intensity	Inflow (cfs)	Inflow Volume (cubic ft.)	Outflow Volume (cubic ft.)	Storage Volume (cubic ft.)	Storage Volume (acre-ft.)	Outflow (cfs)
10	25	3.30	0.55	1.00	1.82	9.20	16.7	10017	3969	6048	0.14	5.3
20	35	3.30	0.55	1.00	1.82	6.90	12.5	15036	5556	9479	0.22	5.3
30	45	3.30	0.55	1.00	1.82	5.62	10.2	18354	7144	11210	0.26	5.3
40	55	3.30	0.55	1.00	1.82	4.78	8.7	20835	8732	12104	0.28	5.3
50	65	3.30	0.55	1.00	1.82	4.19	7.6	22825	10319	12805	0.29	5.3
60	75	3.30	0.55	1.00	1.82	3.75	6.8	24490	11907	12583	0.29	5.3
70	85	3.30	0.55	1.00	1.82	3.40	6.2	25928	13494	12433	0.29	5.3
80	95	3.30	0.55	1.00	1.82	3.12	5.7	27195	15082	12113	0.28	5.3

Maximum Storage Required 12583

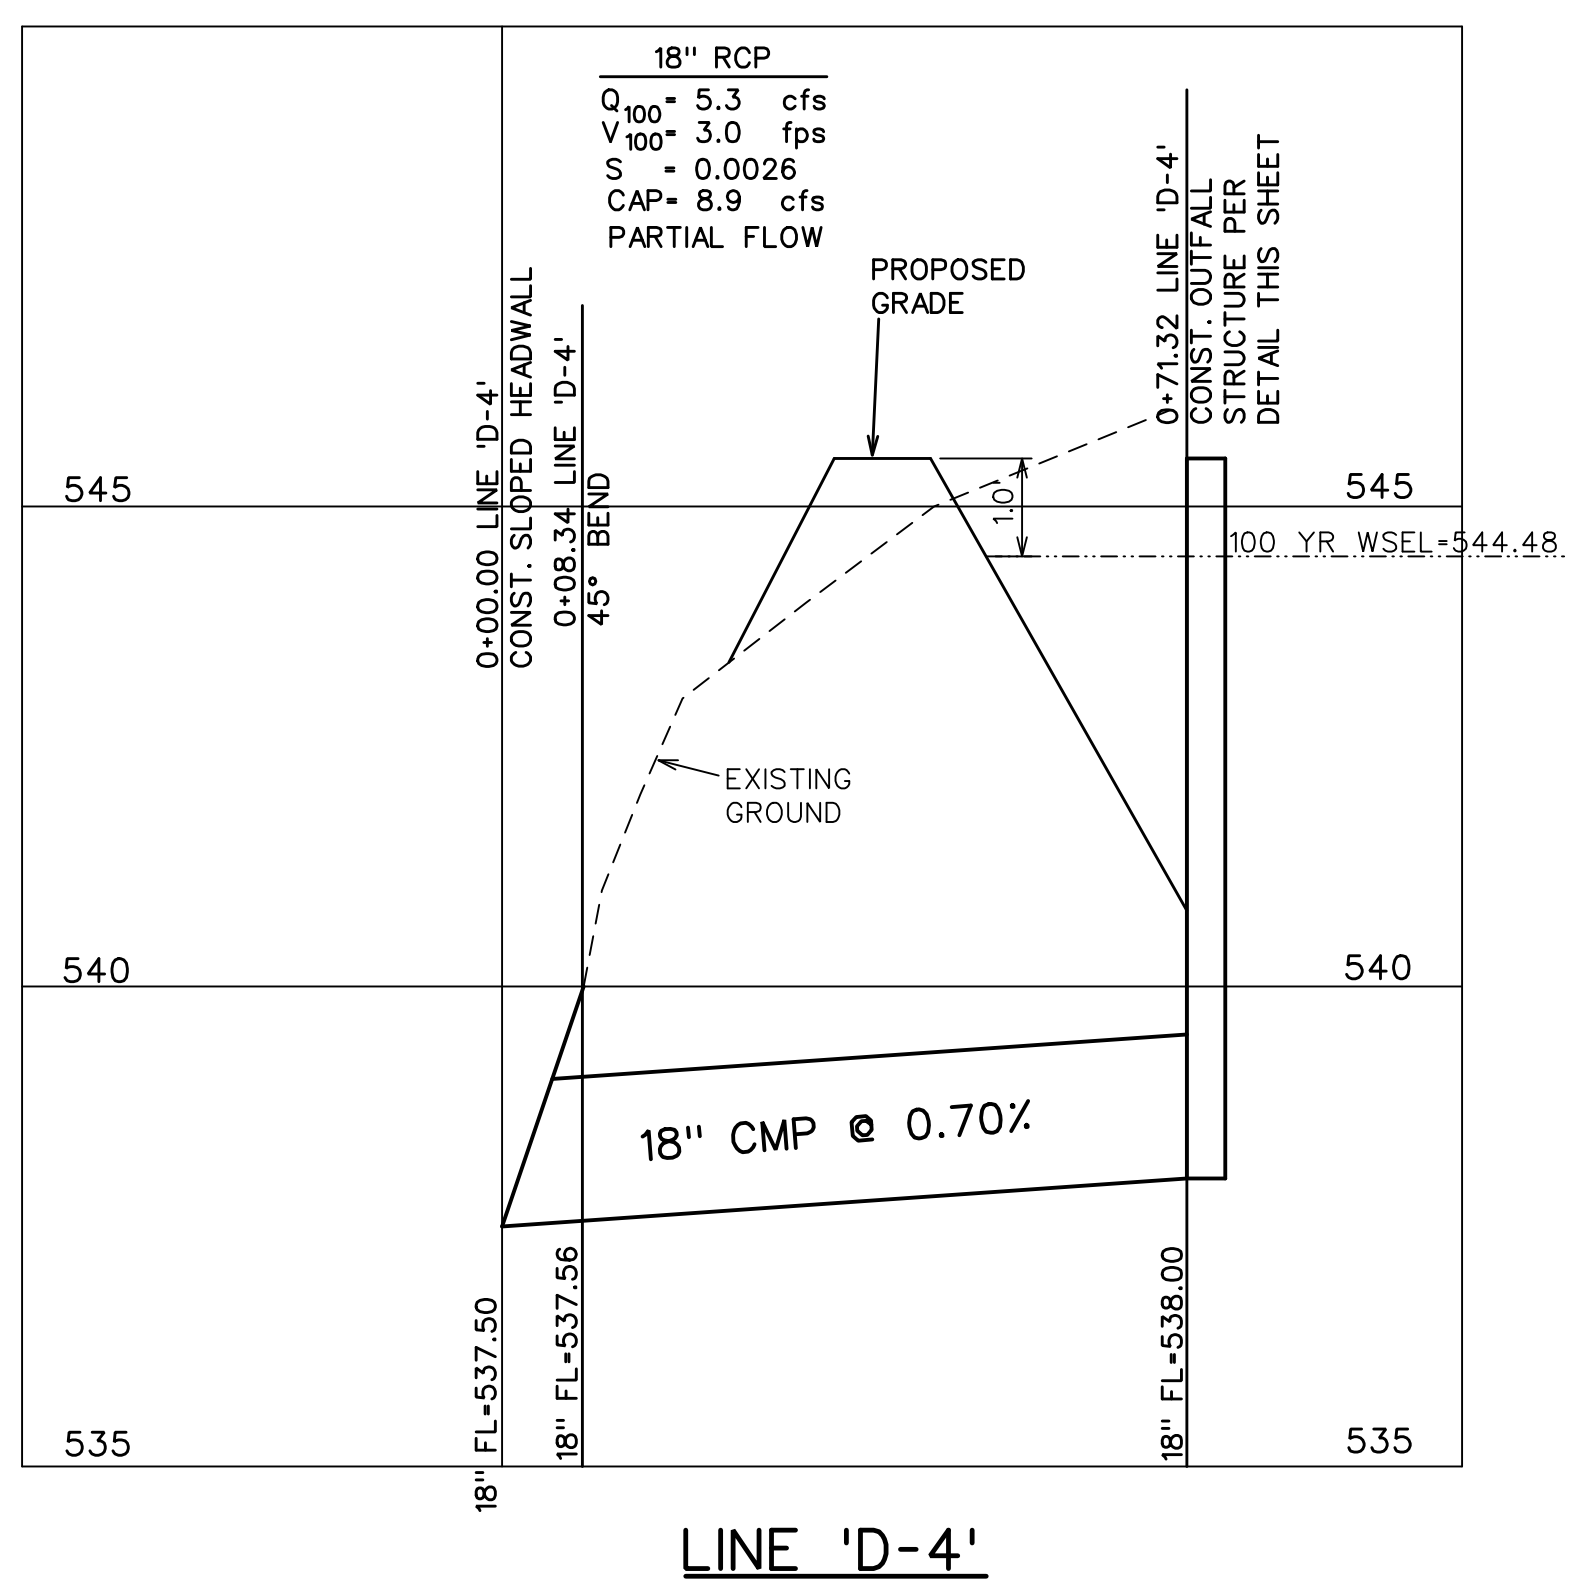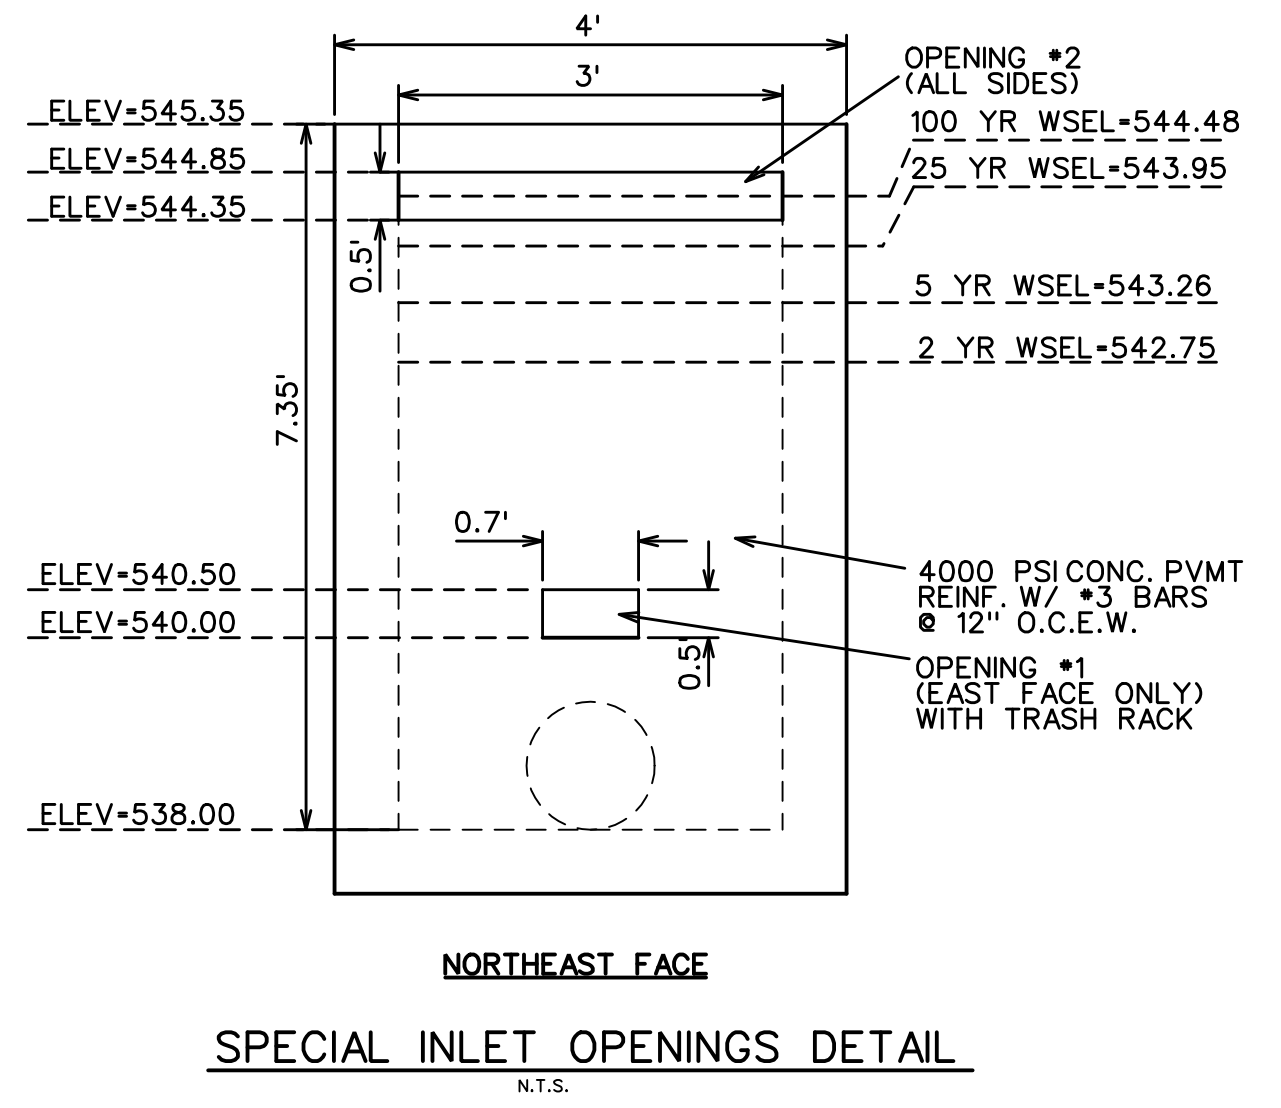

AS-BUILT FEBRUARY 2023
INFORMATION PROVIDED BY CONTRACTORS AND DEVELOPER (NOT FIELD VERIFIED)




CORWIN ENGINEERING, INC.
200 W. BELMONT, SUITE E
ALLEN, TEXAS 75013 (972)396-1200
TBPE FIRM #5951

DEVELOPMENT PLANS FOR
BARRATT LAKE
ESTATES
LUCAS, TEXAS

NORTHWEST DETENTION POND PLAN

DRAWN BY	DESIGNED BY	CHECKED BY	SHEET NO.
JOB NUMBER	DATE	SCALE: 1"=20'	16
20013	OCTOBER 2022		

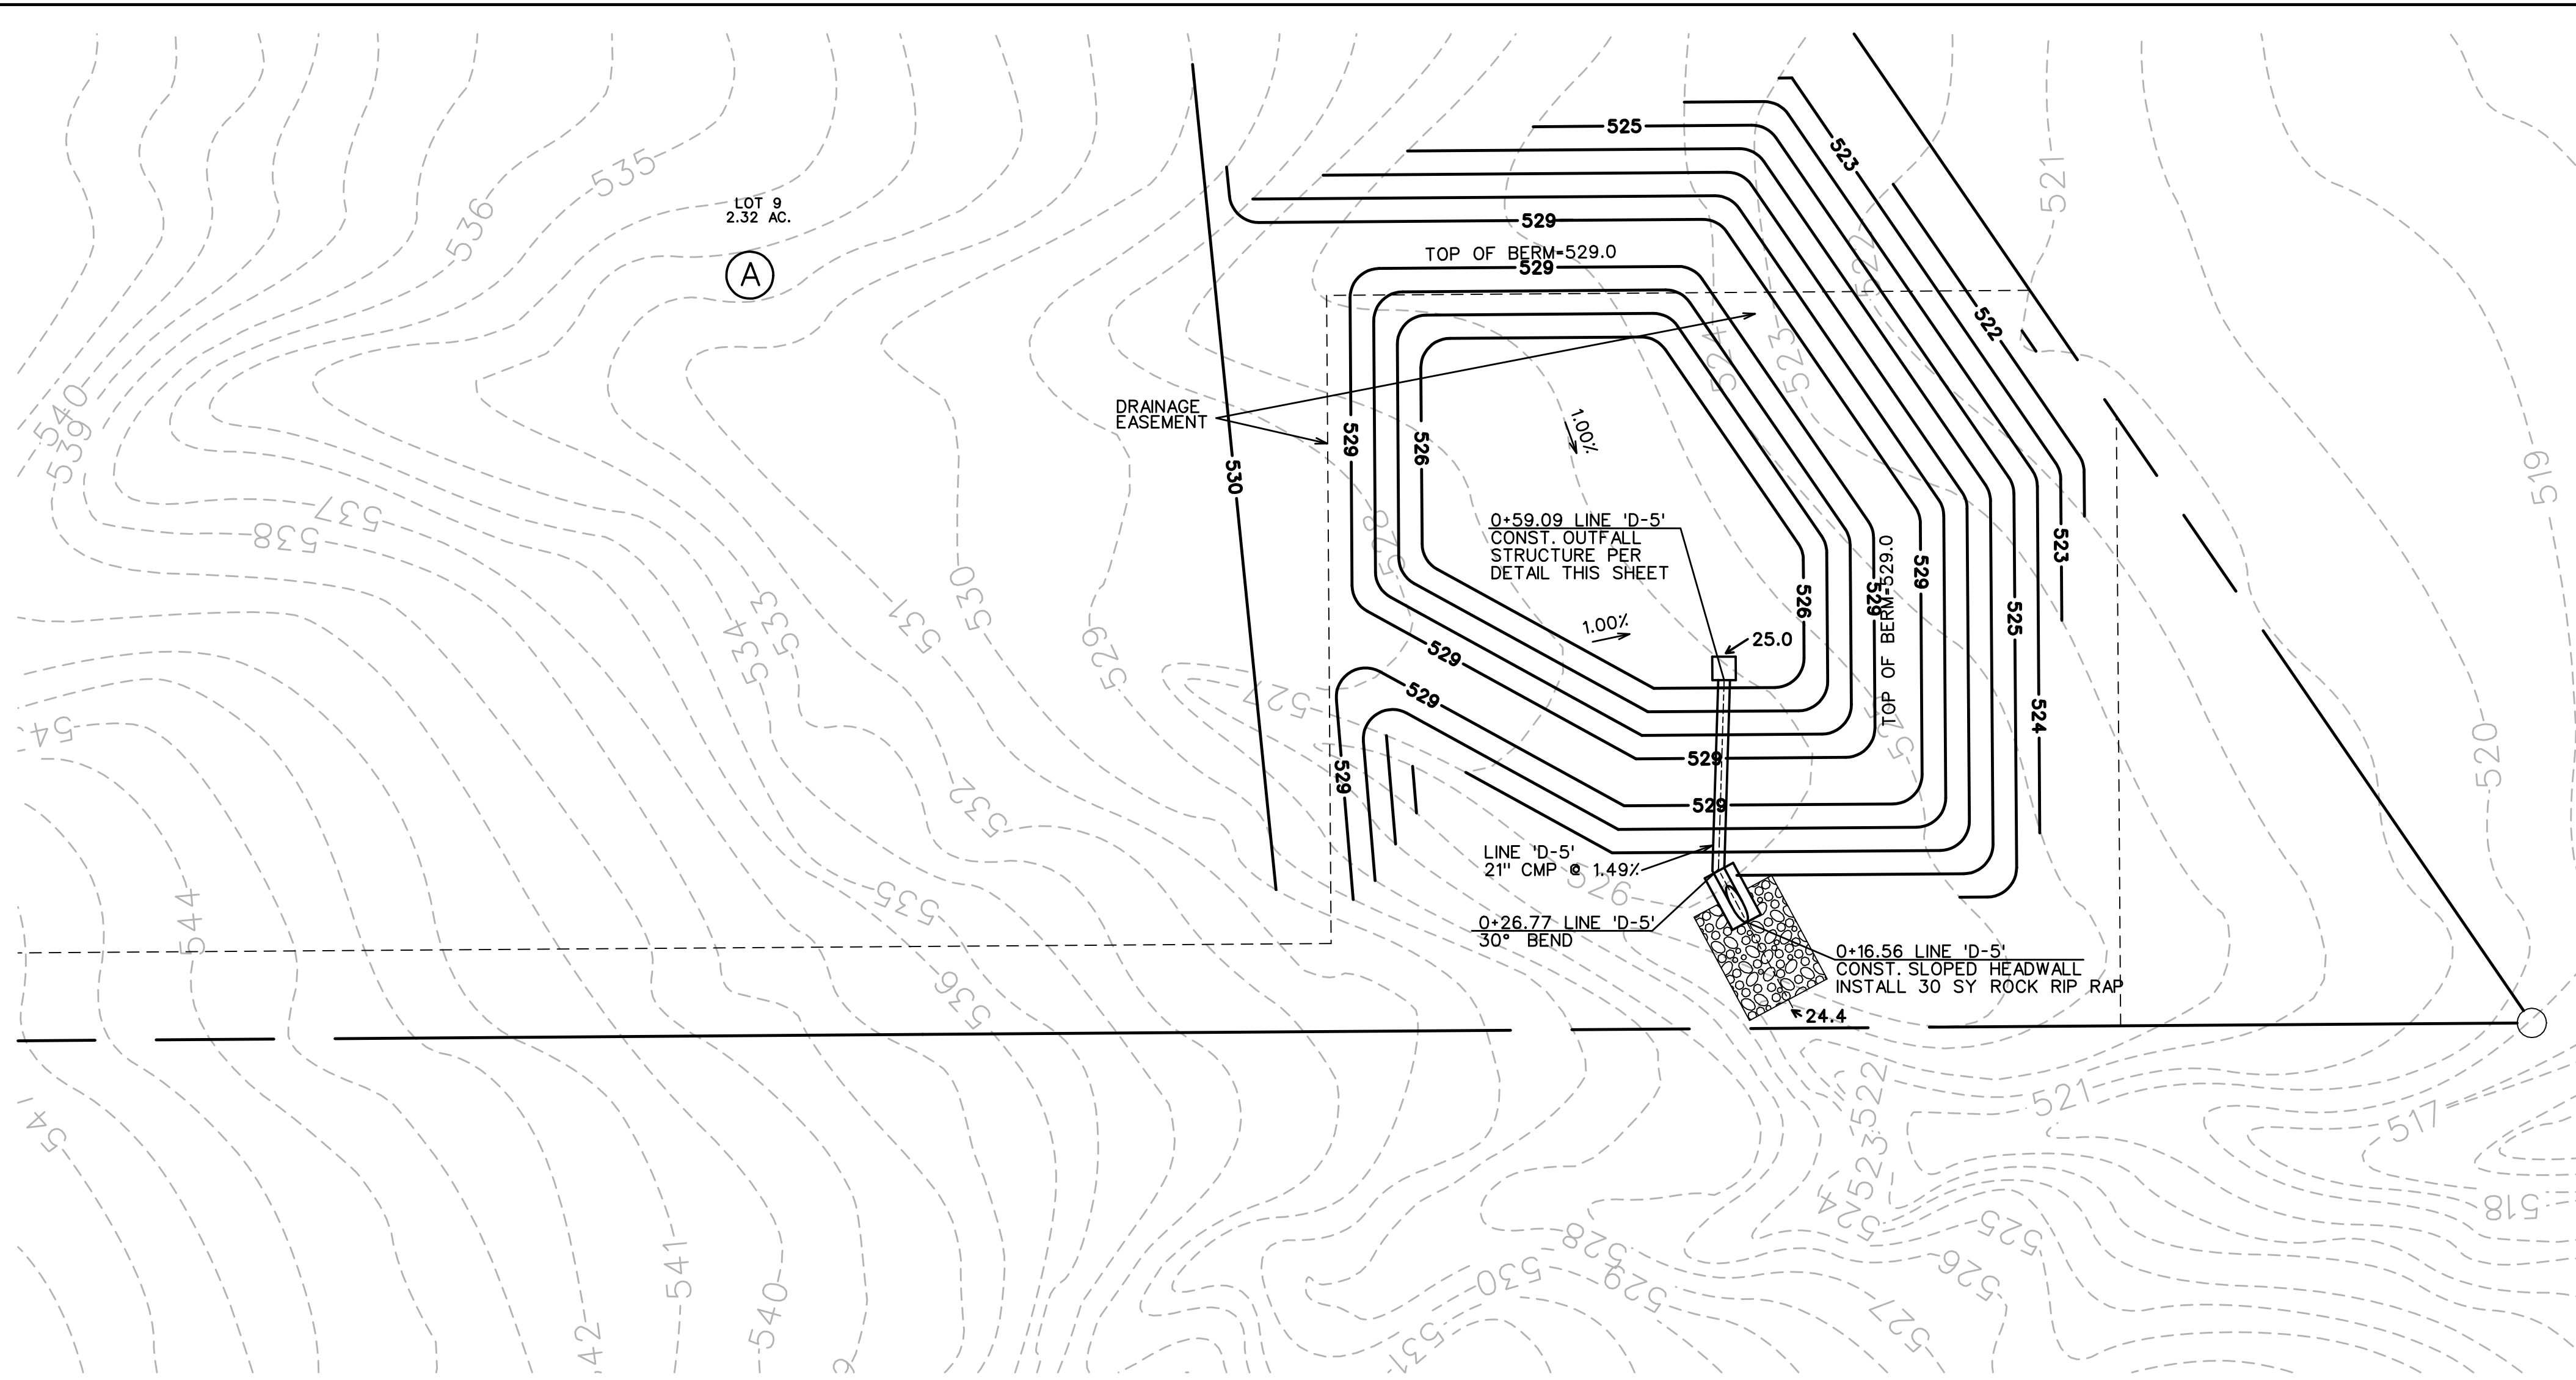

Northeast Detention Pond
2-Year Storm
Pre-Project Runoff Calculations

Area #	Area (sf)	Area (acres)	Existing Runoff Coefficient	Tc - Existing (min)	Rainfall Intensity (in/hr)	Q - Undeveloped (cfs)
EX7-EX8	243442	5.59	0.35	15	4.00	7.9
Allowed Release= 7.9						

Post-Project Runoff Calculations

Area #	Area (sf)	Area (acres)	Proposed Runoff Coefficient	Tc - Existing (min)	Rainfall Intensity (in/hr)	Post Development Q (cfs)	Difference between Pre and Post Development Conditions
10	233322	5.36	0.55	15	4.00	11.5	3.8

5-Year Storm
Pre-Project Runoff Calculations

Area #	Area (sf)	Area (acres)	Existing Runoff Coefficient	Tc - Existing (min)	Rainfall Intensity (in/hr)	Q - Undeveloped (cfs)
EX7-EX8	243442	5.59	0.35	15	4.91	9.7
Allowed Release= 9.7						

Post-Project Runoff Calculations

Area #	Area (sf)	Area (acres)	Existing Runoff Coefficient	Tc - Existing (min)	Rainfall Intensity (in/hr)	Post Development Q (cfs)	Difference between Pre and Post Development Conditions
10	233322	5.36	0.55	15	4.91	14.5	4.7

25-Year Storm
Pre-Project Runoff Calculations

Area #	Area (sf)	Area (acres)	Existing Runoff Coefficient	Tc - Existing (min)	Rainfall Intensity (in/hr)	Q - Undeveloped (cfs)
EX7-EX8	243442	5.59	0.35	15	6.42	12.7
Allowed Release= 12.7						

Post-Project Runoff Calculations

Area #	Area (sf)	Area (acres)	Existing Runoff Coefficient	Tc - Existing (min)	Rainfall Intensity (in/hr)	Post Development Q (cfs)	Difference between Pre and Post Development Conditions
10	233322	5.36	0.55	15	6.42	18.9	6.2

100-Year Storm
Pre-Project Runoff Calculations

Area #	Area (sf)	Area (acres)	Existing Runoff Coefficient	Tc - Existing (min)	Rainfall Intensity (in/hr)	Q - Undeveloped (cfs)
EX7-EX8	243442	5.59	0.35	15	7.86	15.6
Allowed Release= 15.6						

Post-Project Runoff Calculations

Area #	Area (sf)	Area (acres)	Existing Runoff Coefficient	Tc - Existing (min)	Rainfall Intensity (in/hr)	Post Development Q (cfs)	Difference between Pre and Post Development Conditions
10	233322	5.36	0.55	15	7.86	23.1	7.6

Storm Duration	Inflow Duration	Area (AC.)	Future "C"	Future "KF"	Future "CA"	Rainfall Intensity	Inflow (cfs)	Inflow Volume (cubic ft.)	Outflow Volume (cubic ft.)	Storage Volume (cubic ft.)	Storage (acre-ft.)	Outflow (cfs)
10	25	5.36	0.55	1.00	2.95	4.82	14.2	8514	5946	2568	0.06	7.9
20	35	5.36	0.55	1.00	2.95	3.44	10.1	12150	8325	3825	0.09	7.9
30	45	5.36	0.55	1.00	2.95	2.71	8.0	14387	10704	3684	0.08	7.9
40	55	5.36	0.55	1.00	2.95	2.28	6.7	15988	13082	2906	0.07	7.9
50	65	5.36	0.55	1.00	2.95	1.95	5.7	17231	15461	1770	0.04	7.9
Maximum Storage Required 3825												

Storm Duration	Inflow Duration	Area (AC.)	Future "C"	Future "KF"	Future "CA"	Rainfall Intensity	Inflow (cfs)	Inflow Volume (cubic ft.)	Outflow Volume (cubic ft.)	Storage Volume (cubic ft.)	Storage (acre-ft.)	Outflow (cfs)
10	25	5.36	0.55	1.00	2.95	5.82	17.1	10282	7311	2971	0.07	9.7
20	35	5.36	0.55	1.00	2.95	4.28	12.6	15123	10236	4888	0.11	9.7
30	45	5.36	0.55	1.00	2.95	3.43	10.1	18194	13160	5034	0.12	9.7
40	55	5.36	0.55	1.00	2.95	2.89	8.5	20421	16084	4337	0.10	9.7
50	65	5.36	0.55	1.00	2.95	2.51	7.4	22164	19009	3155	0.07	9.7
Maximum Storage Required 6034												

Storm Duration	Inflow Duration	Area (AC.)	Future "C"	Future "KF"	Future "CA"	Rainfall Intensity	Inflow (cfs)	Inflow Volume (cubic ft.)	Outflow Volume (cubic ft.)	Storage Volume (cubic ft.)	Storage (acre-ft.)	Outflow (cfs)
10	25	5.36	0.55	1.00	2.95	7.55	22.2	13346	9552	3795	0.09	12.7
20	35	5.36	0.55	1.00	2.95	5.62	16.6	19863	13372	6491	0.15	12.7
30	45	5.36	0.55	1.00	2.95	4.54	13.4	24100	17193	6907	0.16	12.7
40	55	5.36	0.55	1.00	2.95	3.85	11.3	27229	21013	6216	0.14	12.7
50	65	5.36	0.55	1.00	2.95	3.36	9.9	29713	24834	4879	0.11	12.7
Maximum Storage Required 6907												

Storm Duration	Inflow Duration	Area (AC.)	Future "C"	Future "KF"	Future "CA"	Rainfall Intensity	Inflow (cfs)	Inflow Volume (cubic ft.)	Outflow Volume (cubic ft.)	Storage Volume (cubic ft.)	Storage (acre-ft.)	Outflow (cfs)
10	25	5.36	0.55	1.00	2.95	9.20	27.1	16253	11886	4367	0.10	15.6
20	35	5.36	0.55	1.00	2.95	6.90	20.3	24396	18361	6035	0.16	15.6
30	45	5.36	0.55	1.00	2.95	5.62	16.5	29779	21035	8744	0.20	15.6
40	55	5.36	0.55	1.00	2.95	4.78	14.1	33806	25710	8096	0.19	15.6
50	65	5.36	0.55	1.00	2.95	4.19	12.3	37033	30384	6649	0.15	15.6
Maximum Storage Required 8744												

Elevation-Storage Table



Elevation (cfs)	Volume
525	0
526	1506
527	4979
528	9437
529	14986

Elevation Calculations

Event	Maximum Release Rate	Storage Requirement	Occurs at Elevation
2-year	2.7	3825	526.74
5-year	3.3	5034	527.01
25-year	4.3	6907	527.43
100-year	13.2	8744	527.84

Stage-Discharge Table Opening #1 - 1.1' x 1.0' h opening

Stage	H	Orifice 1		Weir	Depth of Flow Over Weir	2' Weir @ 527	
		Area	Discharge			Discharge	Total Discharge
525.00	0	0	0	0	0	0	0
526.00	0.50	1.10	3.7	0	0	3.7	3.7
526.74	1.24	1.10	5.9	0	0	5.9	5.9
527.00	1.50	1.10	6.5	0	0	6.5	6.5
527.01	1.51	1.10	6.5	0	0	6.5	6.5
527.43	1.93	1.10	7.4	2.0	0.43	1.9	9.2
527.84	2.34	1.10	8.1	2.0	0.84	5.1	13.2
528.00	2.50	1.10	8.4	2.0	1.00	6.7	15.0
529.00	3.50	1.10	9.9	2.0	2.00	18.8	28.7

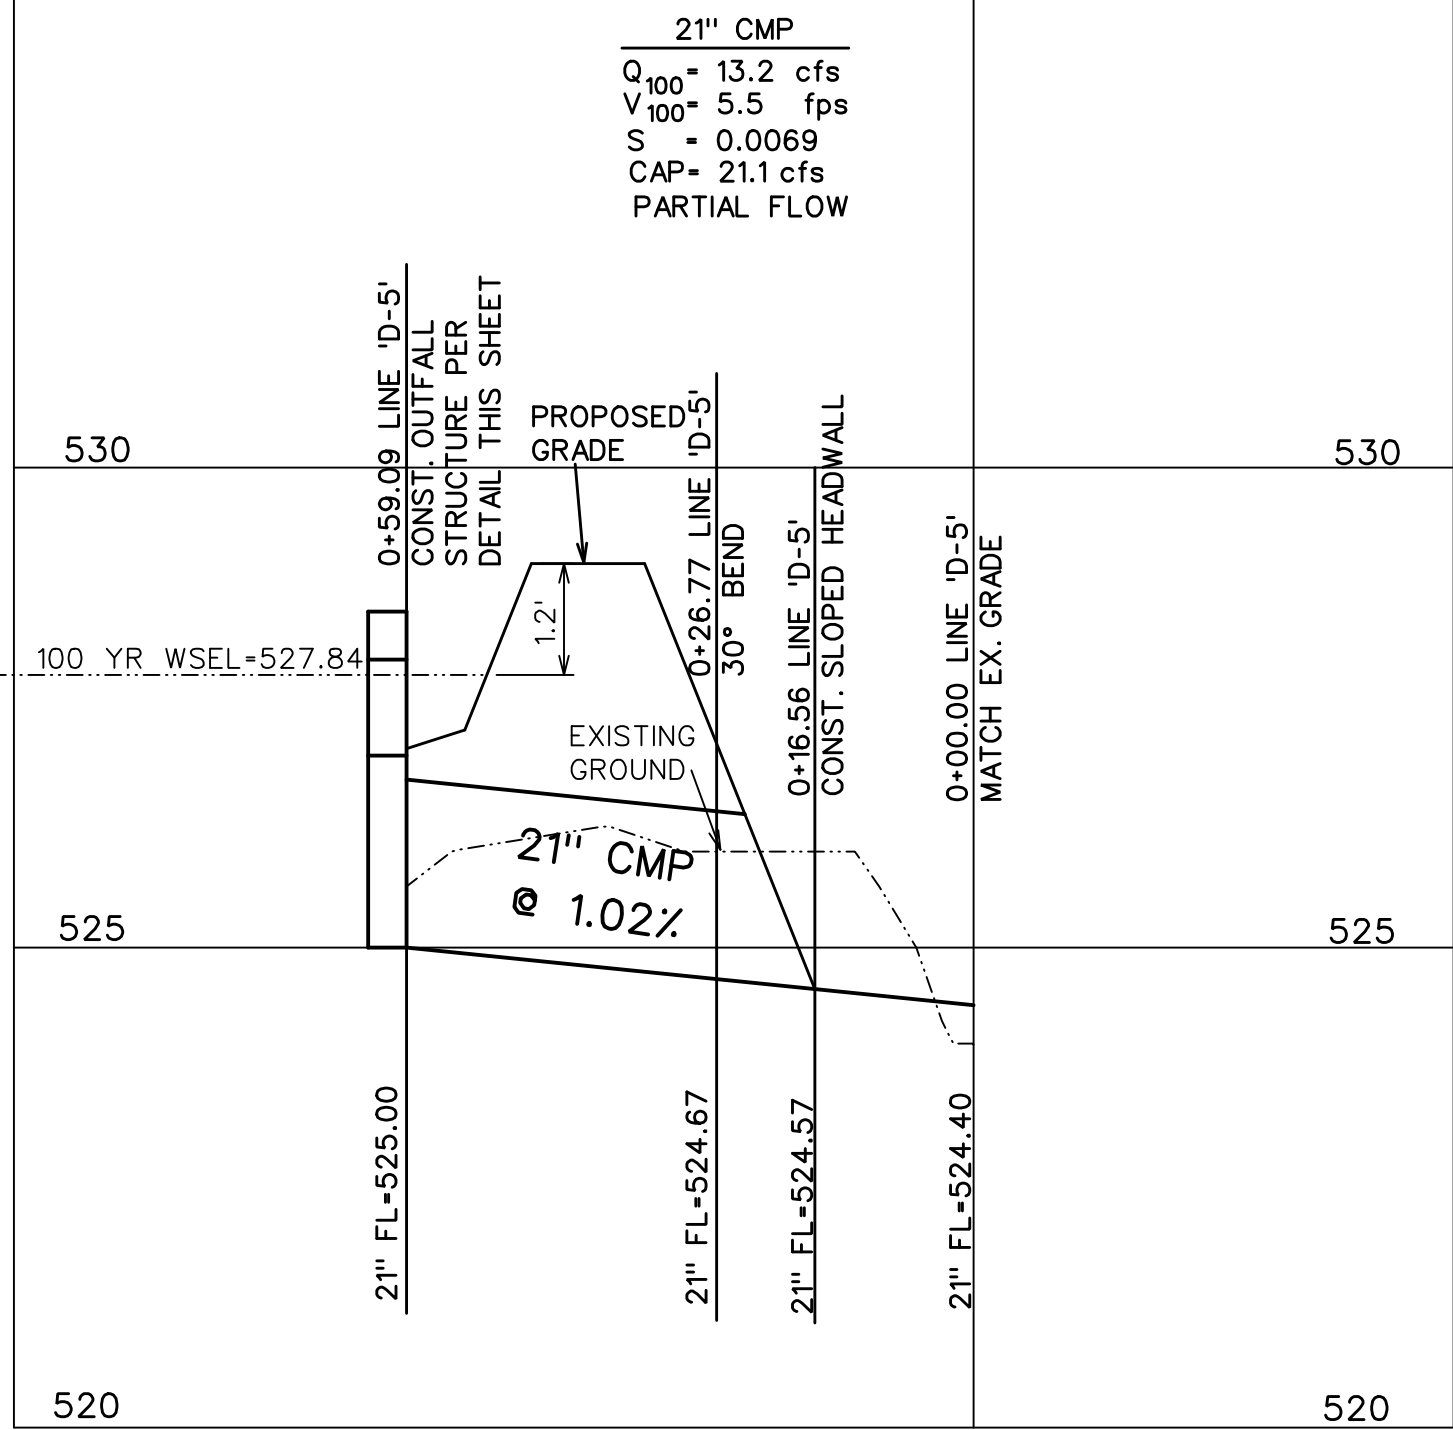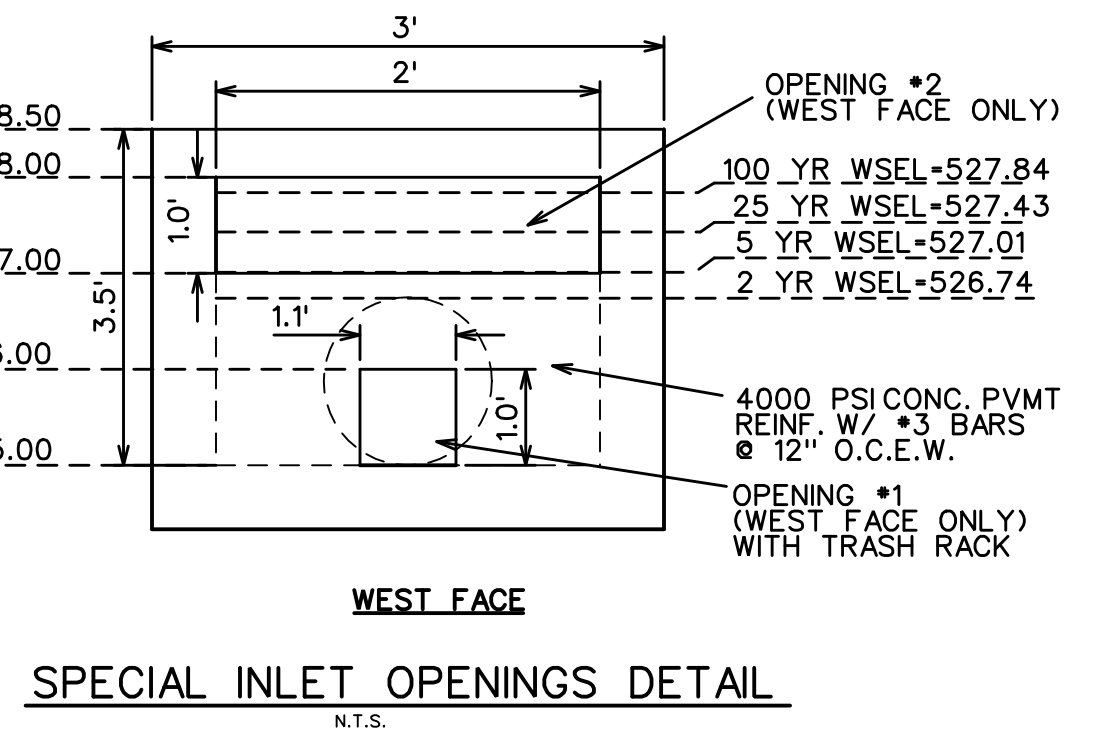

AS-BUILT FEBRUARY 2023
 INFORMATION PROVIDED BY CONTRACTORS AND DEVELOPER (NOT FIELD VERIFIED)




CORWIN ENGINEERING, INC.
 200 W. BELMONT, SUITE E
 ALLEN, TEXAS 75013 (972)396-1200
 TBPE FIRM #5951

DEVELOPMENT PLANS FOR BARRATT LAKE ESTATES LUCAS, TEXAS

NORTHEAST DETENTION POND PLAN

DRAWN BY	DESIGNED BY	CHECKED BY	SHEET NO.
JOB NUMBER	DATE	SCALE: 1"=20'	17
20013	OCTOBER 2022		

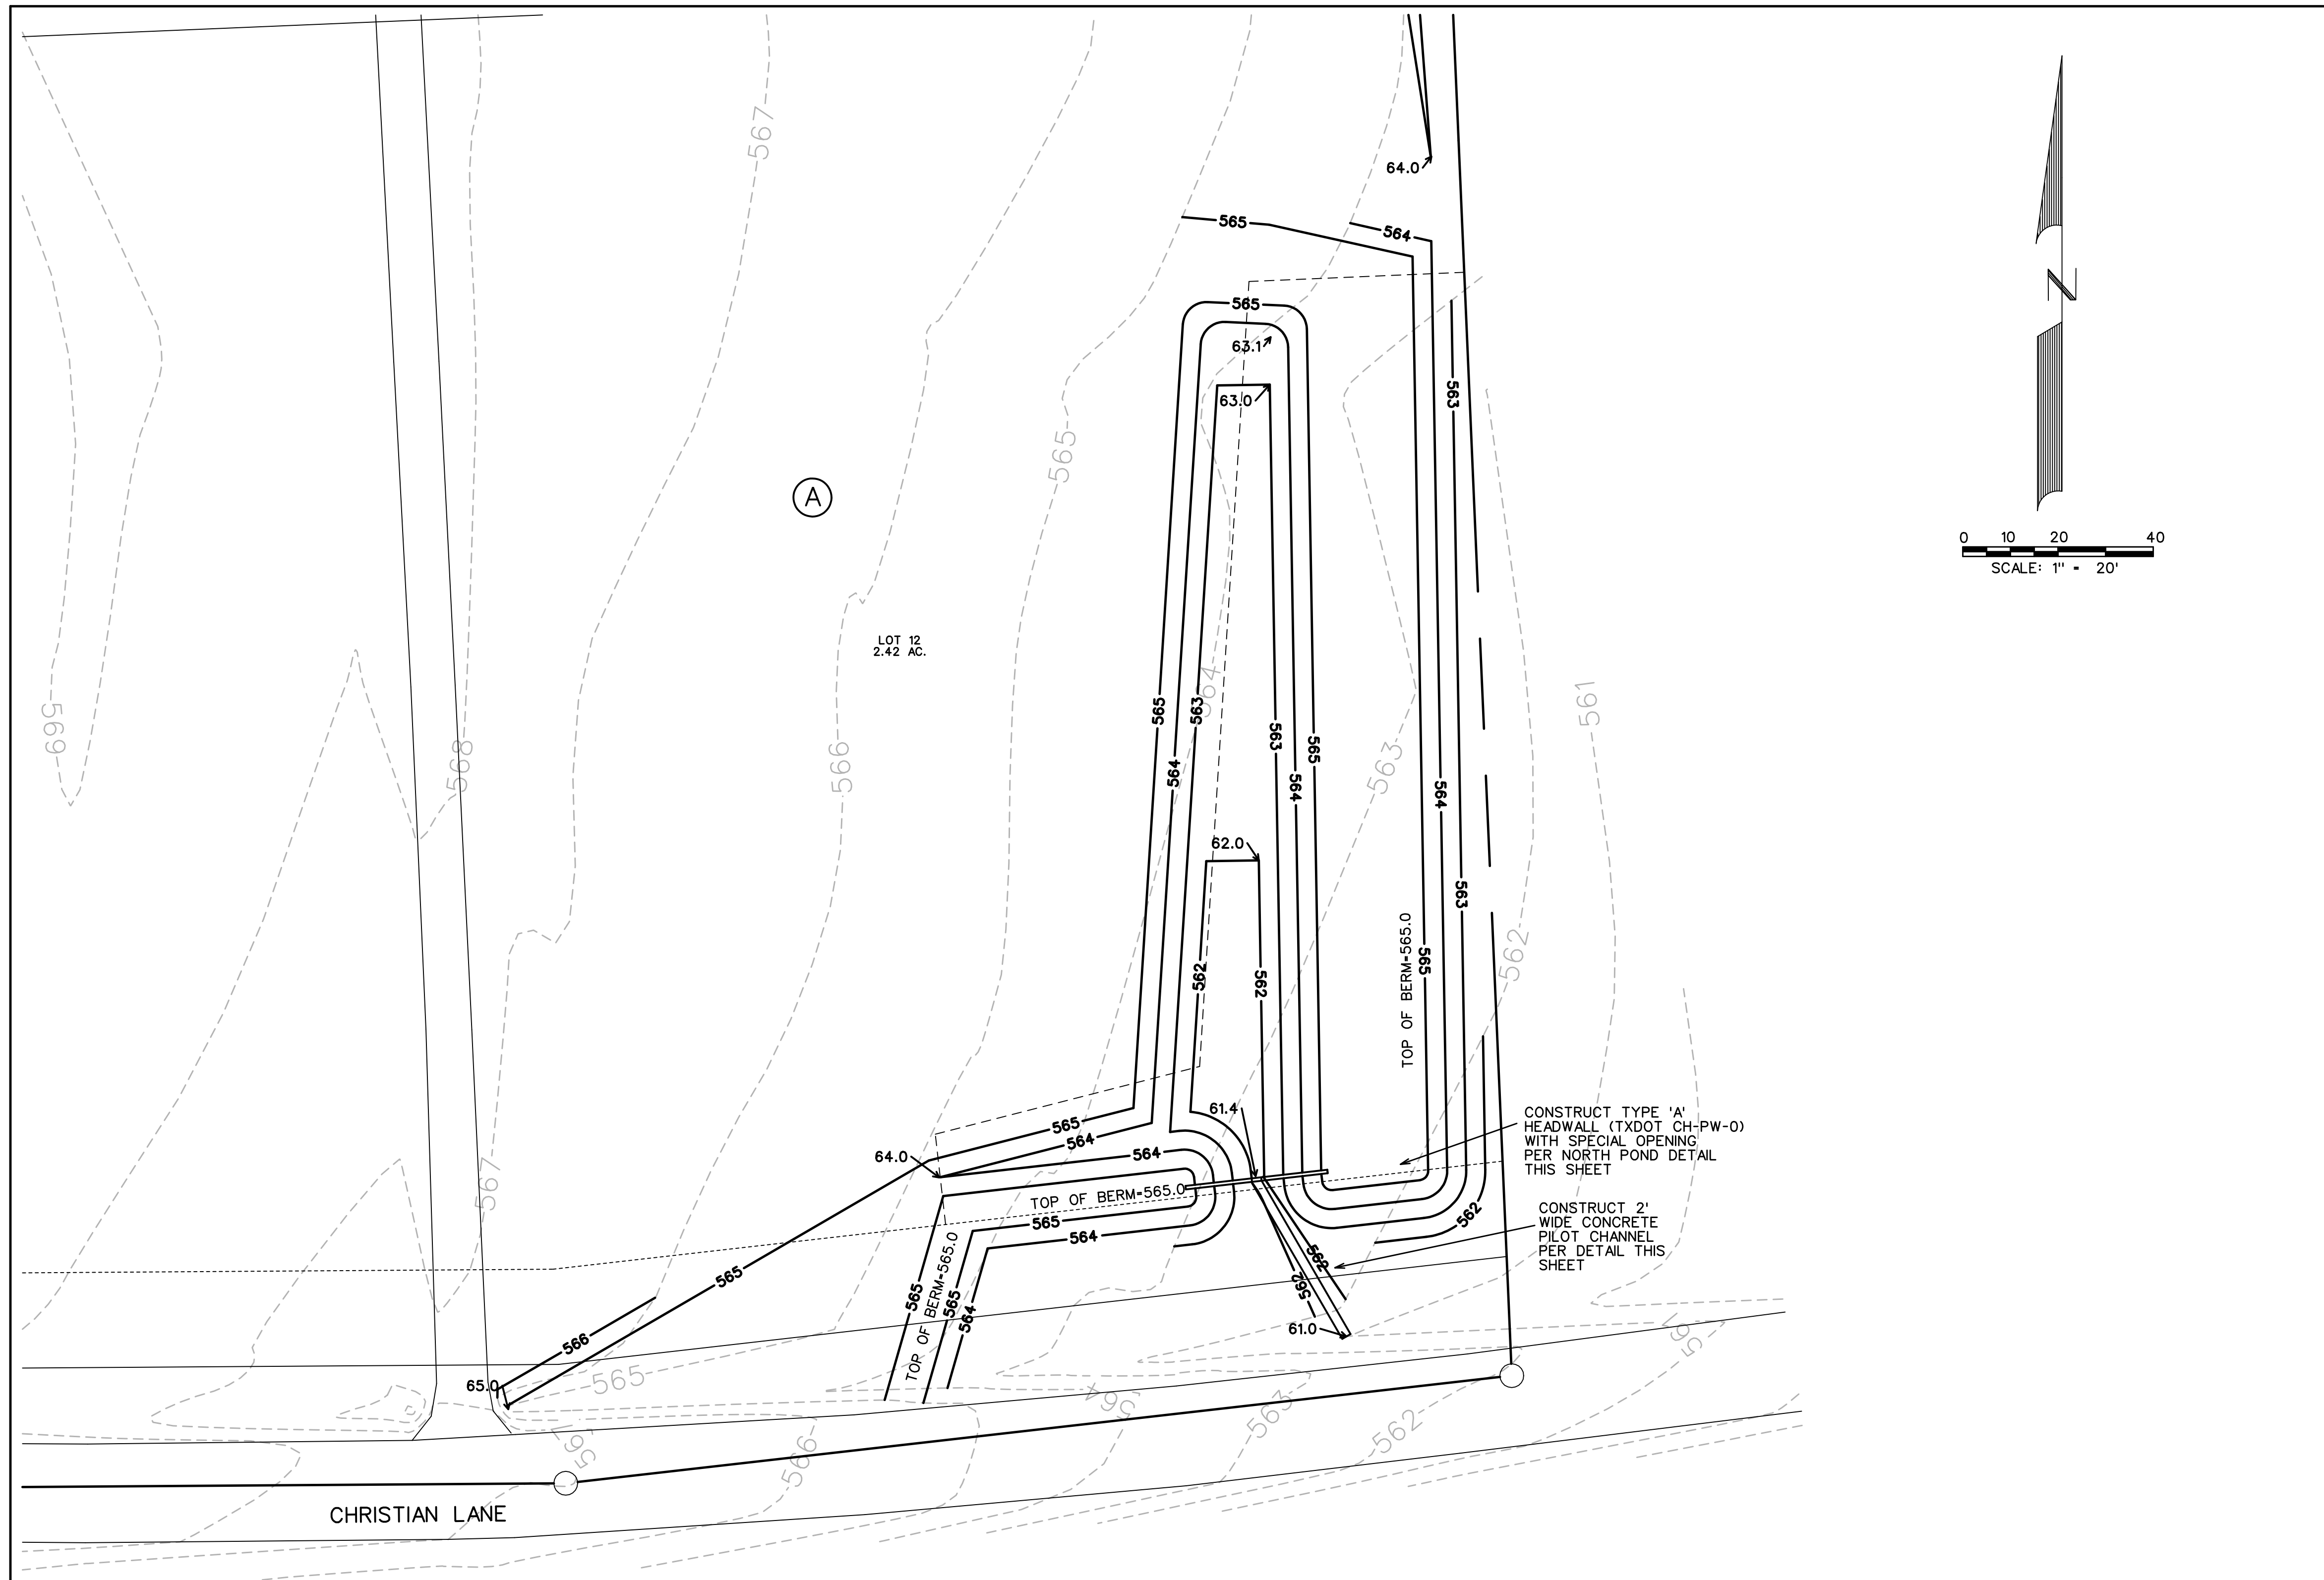

**Southeast Detention Pond
2-Year Storm**

Pre-Project Runoff Calculations

Area #	Area (sf)	Area (acres)	Existing Runoff Coefficient	Tc - Existing (min)	Rainfall Intensity (in/hr)	Q - Undeveloped (cfs)
EXIST-EX10	215714	2.52	0.37	15	4.00	3.7
Allowed Release=						3.7

Post-Project Runoff Calculations

Area #	Area (sf)	Area (acres)	Proposed Runoff Coefficient	Tc - Existing (min)	Rainfall Intensity (in/hr)	Post Developm (cfs)	Difference between Pre and Post Development Conditions
11	89992	2.07	0.55	15	4.00	4.5	0.8
Allowed Release=						4.5	

5-Year Storm

Pre-Project Runoff Calculations

Area #	Area (sf)	Area (acres)	Existing Runoff Coefficient	Tc - Existing (min)	Rainfall Intensity (in/hr)	Q - Undeveloped (cfs)
EXIST-EX10	215714	2.52	0.37	15	4.91	4.6
Allowed Release=						4.6

Post-Project Runoff Calculations

Area #	Area (sf)	Area (acres)	Existing Runoff Coefficient	Tc - Existing (min)	Rainfall Intensity (in/hr)	Post Developm (cfs)	Difference between Pre and Post Development Conditions
11	89992	2.07	0.55	15	4.91	5.6	1.0
Allowed Release=						5.6	

25-Year Storm

Pre-Project Runoff Calculations

Area #	Area (sf)	Area (acres)	Existing Runoff Coefficient	Tc - Existing (min)	Rainfall Intensity (in/hr)	Q - Undeveloped (cfs)
EXIST-EX10	215714	2.52	0.37	15	6.42	5.9
Allowed Release=						5.9

Post-Project Runoff Calculations

Area #	Area (sf)	Area (acres)	Existing Runoff Coefficient	Tc - Existing (min)	Rainfall Intensity (in/hr)	Post Developm (cfs)	Difference between Pre and Post Development Conditions
11	89992	2.07	0.55	15	6.42	7.3	1.3
Allowed Release=						7.3	

100-Year Storm

Pre-Project Runoff Calculations

Area #	Area (sf)	Area (acres)	Existing Runoff Coefficient	Tc - Existing (min)	Rainfall Intensity (in/hr)	Q - Undeveloped (cfs)
EXIST-EX10	215714	2.52	0.37	15	7.86	7.3
Allowed Release=						7.3

Post-Project Runoff Calculations

Area #	Area (sf)	Area (acres)	Existing Runoff Coefficient	Tc - Existing (min)	Rainfall Intensity (in/hr)	Post Developm (cfs)	Difference between Pre and Post Development Conditions
11	89992	2.07	0.55	15	7.86	8.9	1.6
Allowed Release=						8.9	

2 Year

Storm Duration	Inflow Duration	Area (AC.)	Future "C"	Future "KF"	Future "CA"	Rainfall intensity	Inflow (cfs)	Inflow Volume (cubic ft.)	Outflow Volume (cubic ft.)	Storage Volume (cubic ft.)	Storage Volume (acre-ft.)	Outflow (cfs)
10	25	2.07	0.55	1.00	1.14	4.82	5.5	3284	2262	1022	0.02	3.0
20	35	2.07	0.55	1.00	1.14	3.44	3.9	4686	3167	1519	0.03	3.0
30	45	2.07	0.55	1.00	1.14	2.71	3.1	5549	4072	1477	0.03	3.0
40	55	2.07	0.55	1.00	1.14	2.26	2.6	6166	4977	1190	0.03	3.0
50	65	2.07	0.55	1.00	1.14	1.95	2.2	6646	5882	764	0.02	3.0
Maximum Storage Required											1519	

5 Year

Storm Duration	Inflow Duration	Area (AC.)	Future "C"	Future "KF"	Future "CA"	Rainfall intensity	Inflow (cfs)	Inflow Volume (cubic ft.)	Outflow Volume (cubic ft.)	Storage Volume (cubic ft.)	Storage Volume (acre-ft.)	Outflow (cfs)
10	25	2.07	0.55	1.00	1.14	5.82	6.6	3966	2600	1366	0.03	3.5
20	35	2.07	0.55	1.00	1.14	4.28	4.9	5833	3640	2193	0.05	3.5
30	45	2.07	0.55	1.00	1.14	3.43	3.9	7018	4680	2337	0.05	3.5
40	55	2.07	0.55	1.00	1.14	2.89	3.3	7877	5720	2156	0.05	3.5
50	65	2.07	0.55	1.00	1.14	2.51	2.8	8548	6760	1788	0.04	3.5
Maximum Storage Required											2337	

25 Year

Storm Duration	Inflow Duration	Area (AC.)	Future "C"	Future "KF"	Future "CA"	Rainfall intensity	Inflow (cfs)	Inflow Volume (cubic ft.)	Outflow Volume (cubic ft.)	Storage Volume (cubic ft.)	Storage Volume (acre-ft.)	Outflow (cfs)
10	25	2.07	0.55	1.00	1.14	7.55	8.6	5148	3143	2005	0.05	4.2
20	35	2.07	0.55	1.00	1.14	5.62	6.4	7851	4400	3451	0.07	4.2
30	45	2.07	0.55	1.00	1.14	4.54	5.2	9295	5657	3639	0.08	4.2
40	55	2.07	0.55	1.00	1.14	3.85	4.4	10502	6914	3588	0.08	4.2
50	65	2.07	0.55	1.00	1.14	3.36	3.8	11480	8171	3289	0.08	4.2
Maximum Storage Required											3639	

100 Year

Storm Duration	Inflow Duration	Area (AC.)	Future "C"	Future "KF"	Future "CA"	Rainfall intensity	Inflow (cfs)	Inflow Volume (cubic ft.)	Outflow Volume (cubic ft.)	Storage Volume (cubic ft.)	Storage Volume (acre-ft.)	Outflow (cfs)
10	25	2.07	0.55	1.00	1.14	9.20	10.4	6289	3965	2303	0.05	5.3
20	35	2.07	0.55	1.00	1.14	6.90	7.8	9409	5552	3858	0.09	5.3
30	45	2.07	0.55	1.00	1.14	5.62	6.4	11486	7138	4348	0.10	5.3
40	55	2.07	0.55	1.00	1.14	4.78	5.4	13039	8724	4315	0.10	5.3
50	65	2.07	0.55	1.00	1.14	4.19	4.8	14284	10310	3974	0.09	5.3
Maximum Storage Required											4348	

Elevation-Storage Table



Elevation (cf)	Volume
561.4	0
562	193
563	1996
564	5760
565	11497

Elevation Calculations


Event	Maximum Release Rate	Storage Requirement	Occurs at Elevation
2-year	2.7	1519	562.74
5-year	3.3	2337	563.09
25-year	4.3	3639	563.44
100-year	7.3	4348	563.62

Stage-Discharge Table

Stage	Orifice #1 - 1.2' w x 0.5' h opening			2' Weir @ Elev 563.3		
	H	Area	Discharge	Weir Length	Depth of Flow Over Weir	Weir Discharge
561.40	0	0	0			0.0
562.00	0.35	0.60	1.7			1.7
562.74	1.09	0.60	3.0			3.0
563.09	1.44	0.60	3.5			3.5
563.00	1.35	0.60	3.4			3.4
563.44	1.78	0.60	3.9	2.0	0.13	0.3
563.62	1.97	0.60	4.1	2.0	0.32	1.2
564.00	2.35	0.60	4.4	2.0	0.70	3.9
565.00	3.35	0.60	5.3	2.0	1.70	14.8

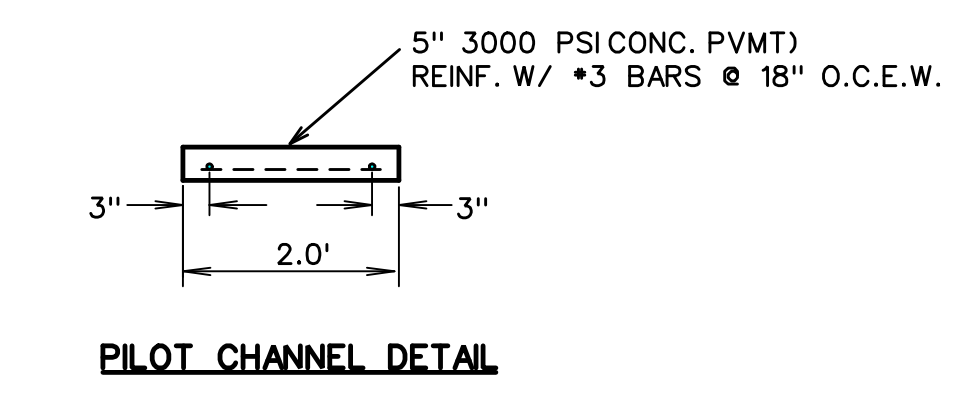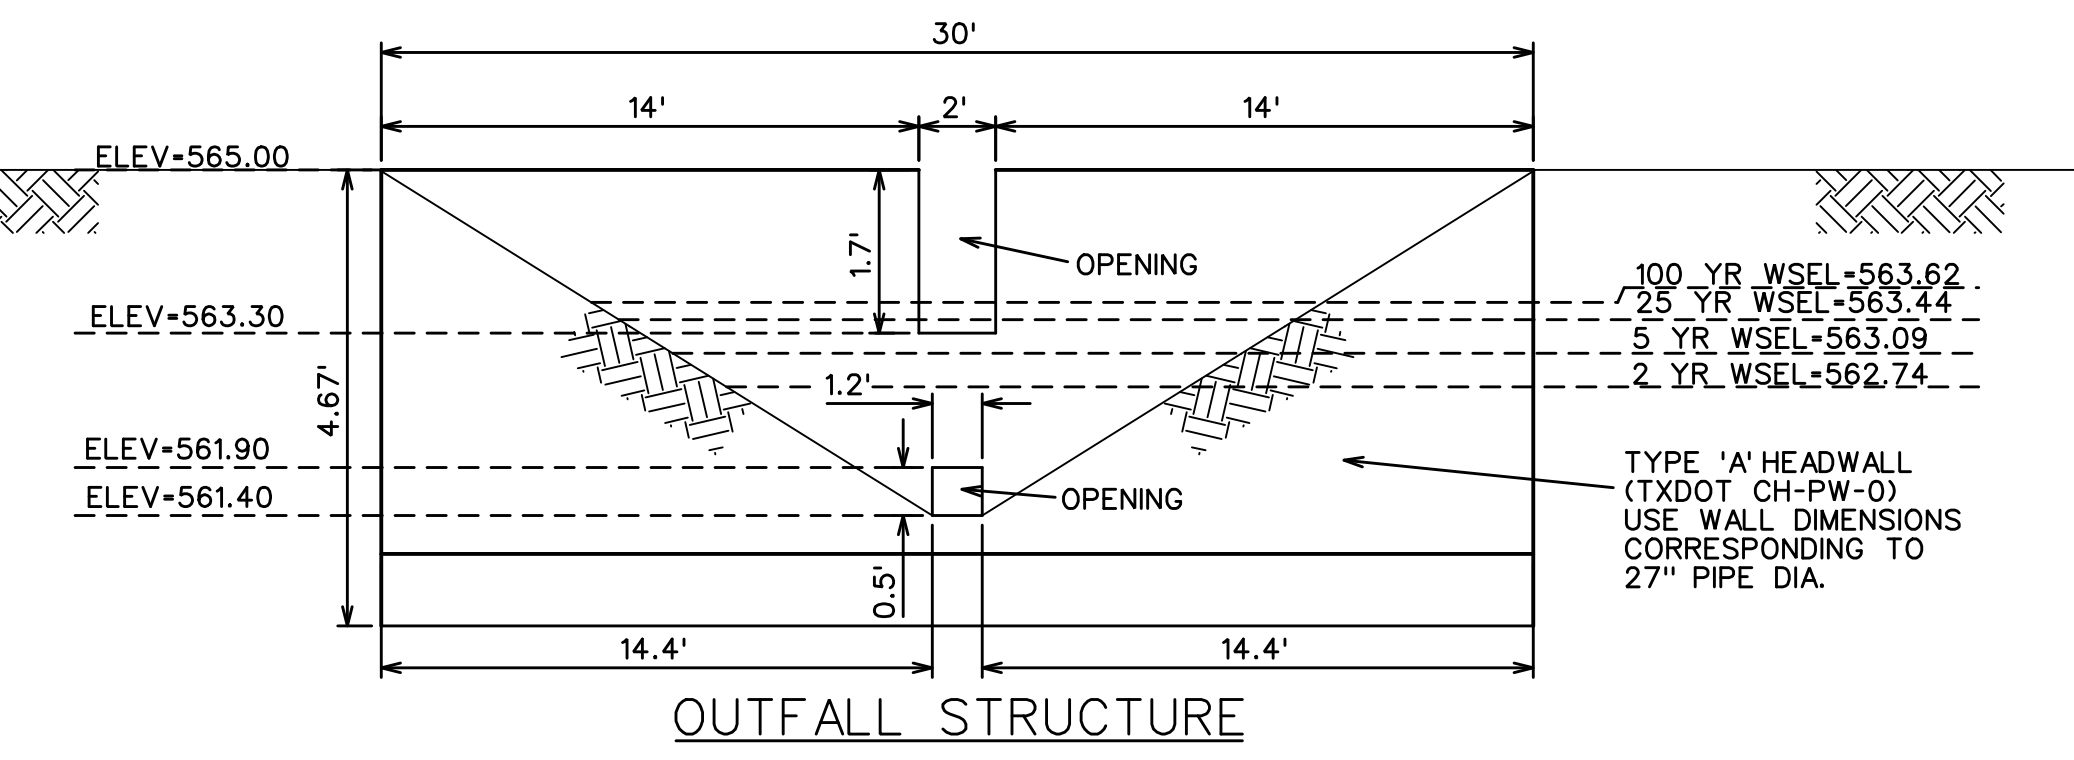

AS-BUILT FEBRUARY 2023
INFORMATION PROVIDED BY CONTRACTORS AND DEVELOPER (NOT FIELD VERIFIED)

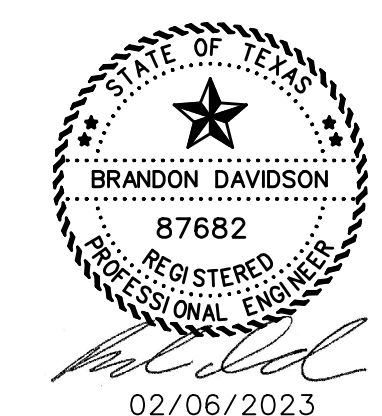

CORWIN ENGINEERING, INC.
200 W. BELMONT, SUITE E
ALLEN, TEXAS 75013 (972)396-1200
TBPE FIRM #5951


DEVELOPMENT PLANS FOR
BARRATT LAKE ESTATES
LUCAS, TEXAS

SOUTHEAST DETENTION POND PLAN

DRAWN BY	DESIGNED BY	CHECKED BY	SHEET NO.
JOB NUMBER	DATE	SCALE: 1"=20'	18
20013	OCTOBER 2022		



SCALE: 1" = 80'

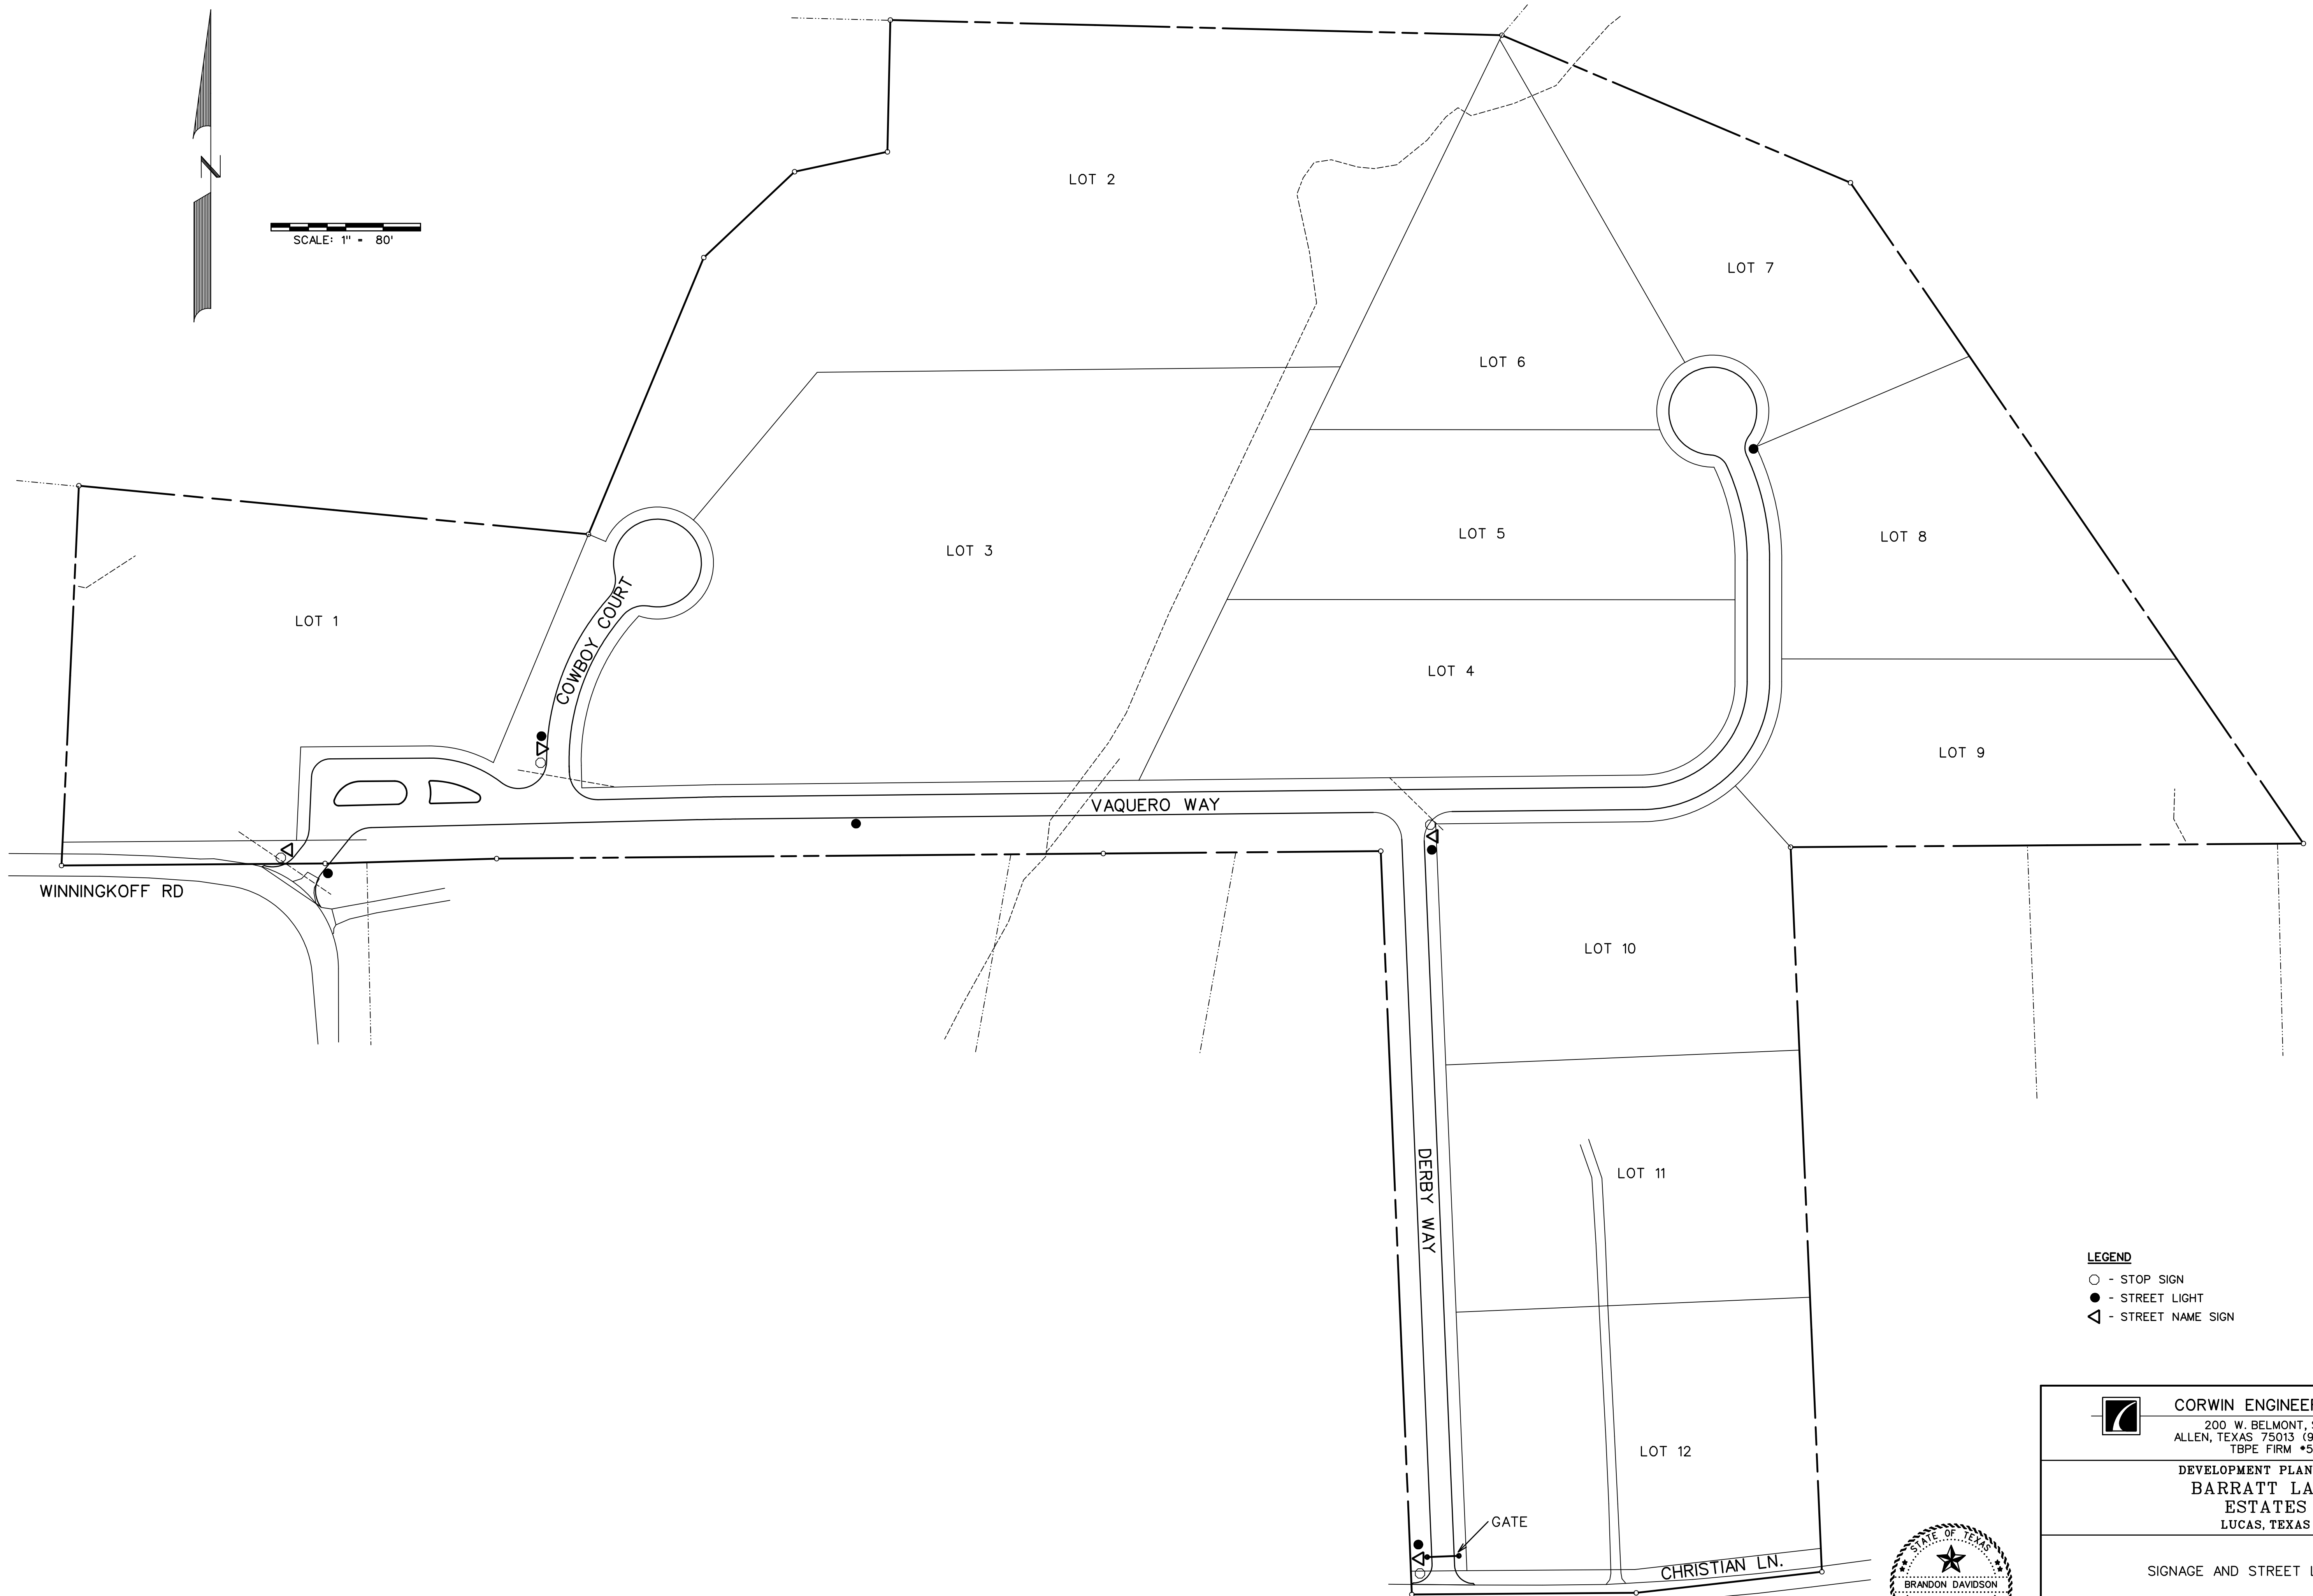

- LEGEND**
- - STOP SIGN
 - - STREET LIGHT
 - ◁ - STREET NAME SIGN




CORWIN ENGINEERING, INC.
 200 W. BELMONT, SUITE E
 ALLEN, TEXAS 75013 (972)396-1200
 TBPE FIRM #5951

**DEVELOPMENT PLANS FOR
 BARRATT LAKE
 ESTATES
 LUCAS, TEXAS**

SIGNAGE AND STREET LIGHT PLAN

DRAWN BY	DESIGNED BY	CHECKED BY	SHEET NO. 19
JOB NUMBER 20013	DATE OCTOBER 2022	SCALE: 1"=80'	




AS-BUILT FEBRUARY 2023
 INFORMATION PROVIDED BY
 CONTRACTORS AND DEVELOPER
 (NOT FIELD VERIFIED)

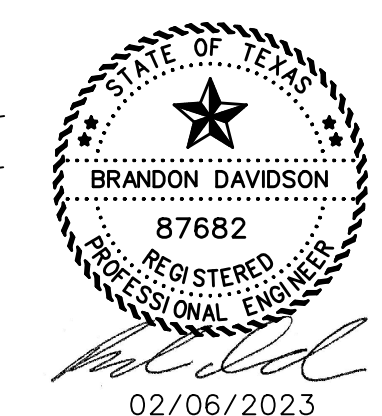





SCALE: 1" = 80'

- NOTES:
1. GRADING CONTRACTOR TO INSTALL TEMPORARY STABILIZED ENTRANCE.
 2. INSTALL SILT FENCE AS SHOWN, (TS-600 POLY FELT) PER C.O.G. SPECIFICATIONS.
 3. PERFORM GRADING.
 4. AFTER GRADING INSTALL SILT FENCE DITCH PROTECTION.
 5. PERFORM UTILITY CONSTRUCTION.
 6. PAVING CONTRACTOR SHALL REMOVE TEMPORARY STABILIZED ENTRANCE.
 7. PRIOR TO CITY ACCEPTANCE THE PAVING CONTRACTOR SHALL BE RESPONSIBLE FOR REMOVING ANY MUD OR SILT WHICH COLLECTS ON THE EXISTING AND NEW PAVEMENT.
 8. ALL DISTURBED AREAS TO BE VEGETATED PRIOR TO FINAL ACCEPTANCE.

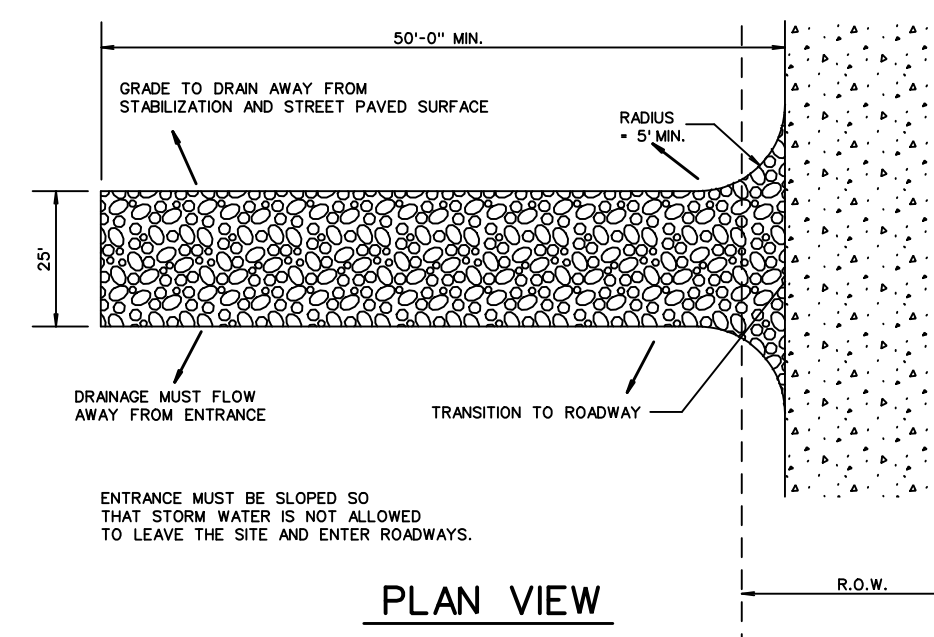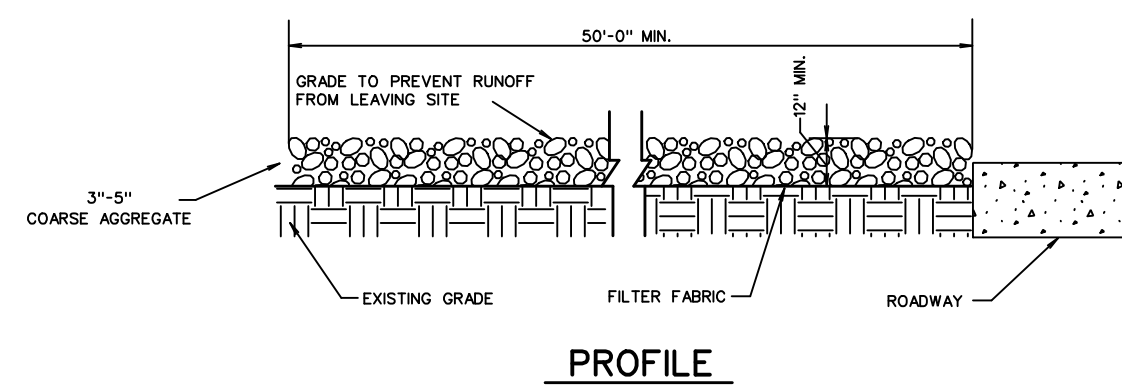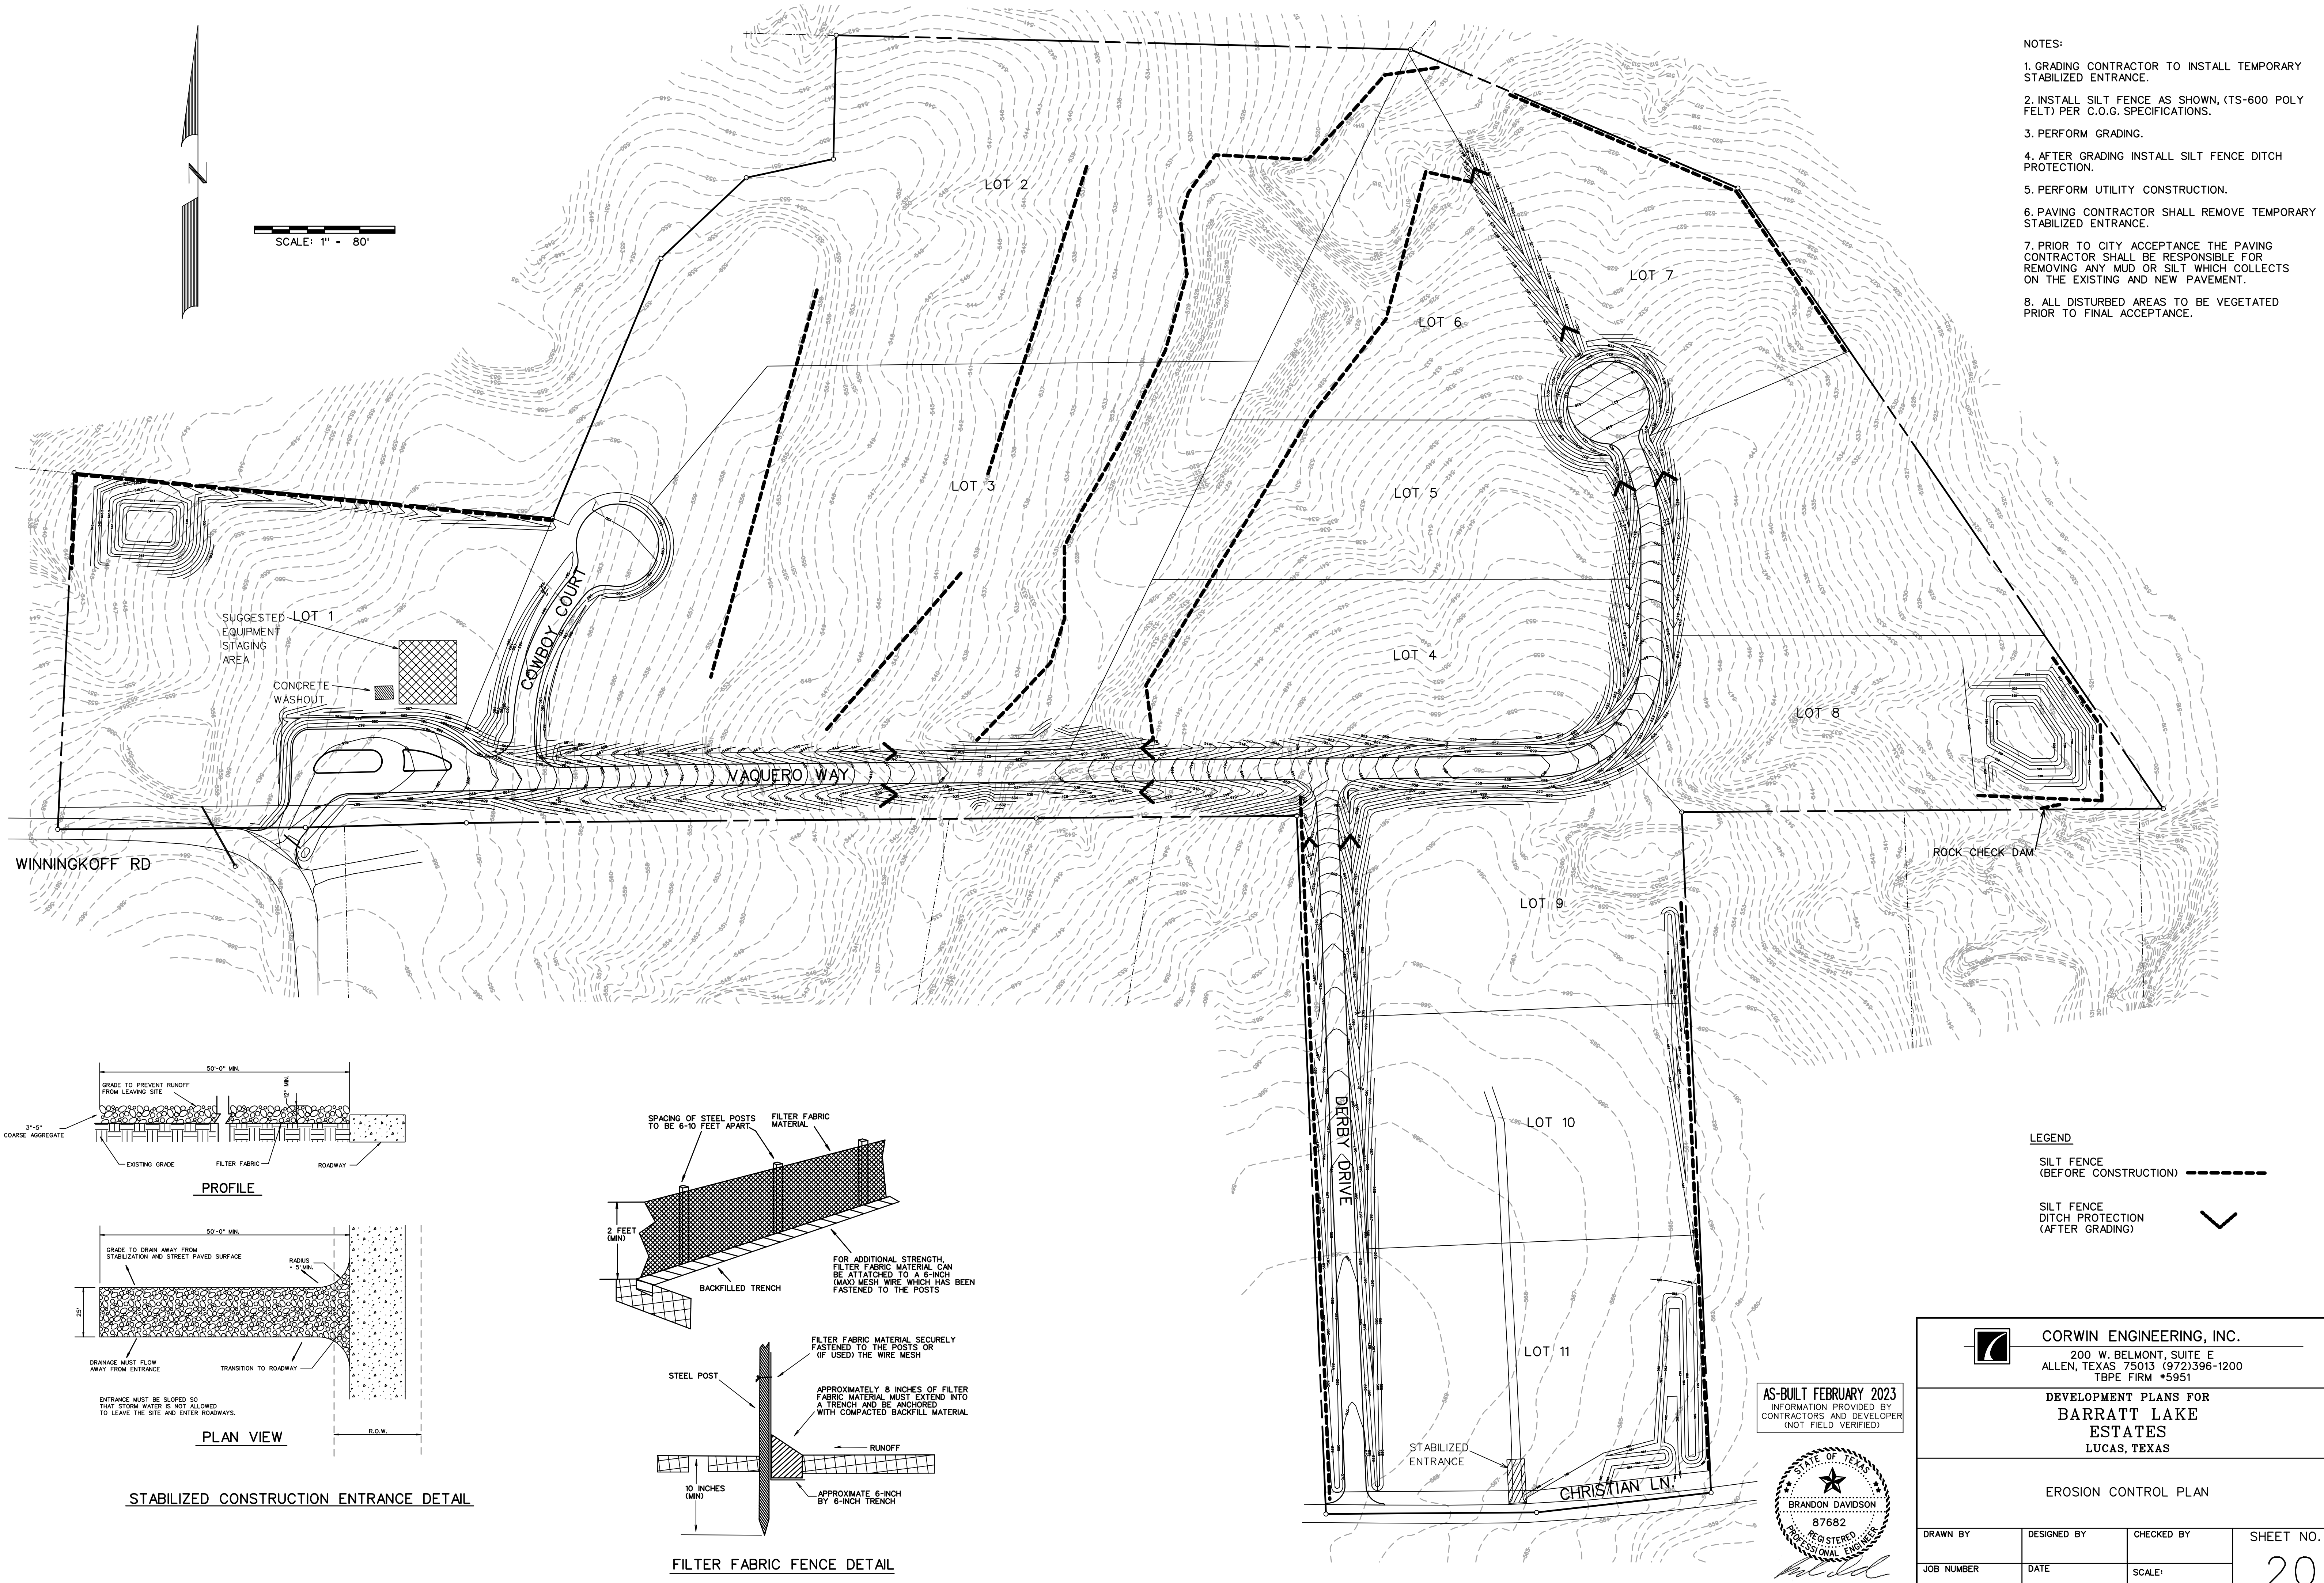

STABILIZED CONSTRUCTION ENTRANCE DETAIL

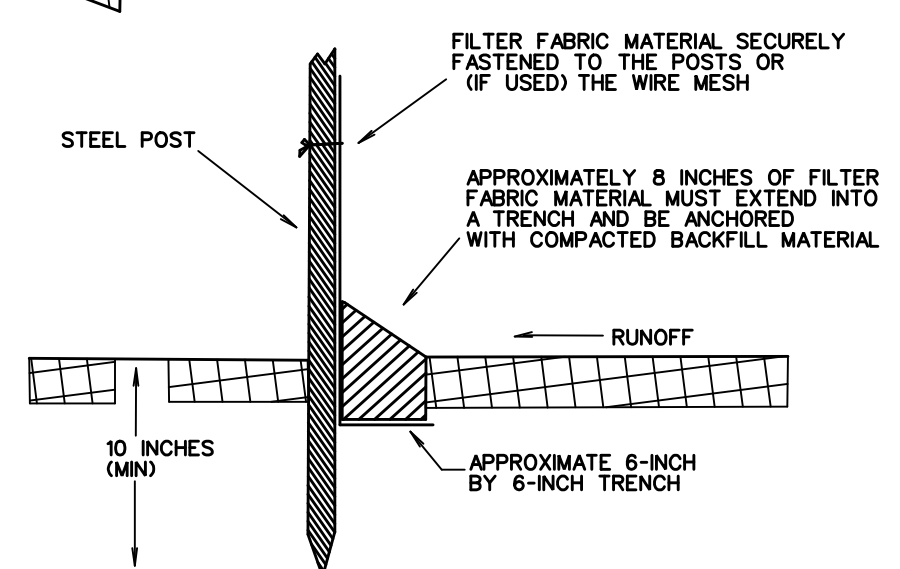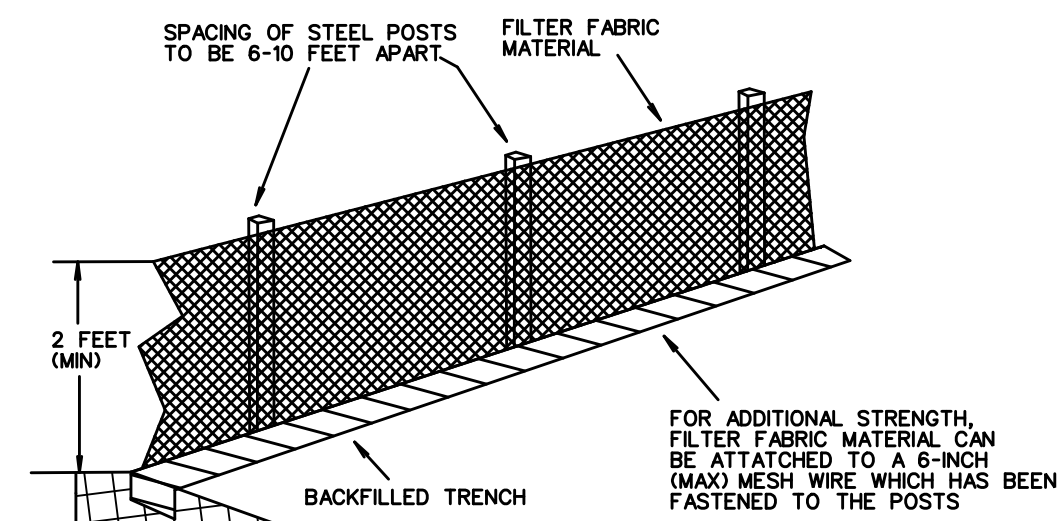

FILTER FABRIC FENCE DETAIL

- LEGEND
- SILT FENCE (BEFORE CONSTRUCTION) - - - - -
 - SILT FENCE DITCH PROTECTION (AFTER GRADING) - V -

CORWIN ENGINEERING, INC.
 200 W. BELMONT, SUITE E
 ALLEN, TEXAS 75013 (972)396-1200
 TBPE FIRM #5951

DEVELOPMENT PLANS FOR
BARRATT LAKE ESTATES
 LUCAS, TEXAS

EROSION CONTROL PLAN			
DRAWN BY	DESIGNED BY	CHECKED BY	SHEET NO.
JOB NUMBER	DATE	SCALE:	20
20013	OCTOBER 2022	1"=80'	

AS-BUILT FEBRUARY 2023
 INFORMATION PROVIDED BY
 CONTRACTORS AND DEVELOPER
 (NOT FIELD VERIFIED)

