



CITY OF PETALUMA

POST OFFICE BOX 61
PETALUMA, CA 94953-0061

ADDENDUM NO. 2

Traffic Signal Timing – Communication Upgrades City Project No. TBD

June 1, 2020

This Addendum No. 2 modifies the Bidding Documents for Traffic Signal Timing – Communication Upgrade Project, City Project No. TBD, and shall become part of the Contract Documents for this Project. The following sections of the Contract Documents shall be modified as follows:

NOTICE INVITING BIDS

8. CONTRACTOR'S LICENSE CLASSIFICATION: *In accordance with the provisions of California Public Contract Code Section 3300, the CITY has determined that the CONTRACTOR shall possess a valid ~~Class A~~ C-10 license at the time that the Contract is awarded. Failure to possess the specified license shall render the Bid as non-responsive and shall act as a bar to award of the Contract to any bidder not possessing said license at the time of award.*

PLANS

Revised plan sheets attached

SPECIAL PROVISIONS

50c.1 CONSTRUCTION AREA SIGN

Construction area signs and Three (3) portable changeable message signs (PCMS) shall be furnished, installed, maintained, and removed when no longer required in accordance with the provisions in Section 12, "Construction Area Traffic Control Devices", of the Standard Specification.

Portable changeable message signs are not required for this project. Required arrow boards will be required if construction requires taking a lane.

920b. SUBMITTAL

Remove and replace entire paragraph with the followings: **Contractor shall provide the Engineer with submittal for conduits and fiber optic**

Teresa Barrett
Mayor

D'Lynda Fischer
Mike Healy
Gabe Kearney
Dave King
Kevin McDonnell
Kathy Miller
Councilmembers

Public Works & Utilities

City Engineer
11 English Street
Petaluma, CA 94952
Phone (707) 778-4303

Environmental Services

Ellis Creek Water
Recycling Facility
3890 Cypress Drive
Petaluma, CA 94954
Phone (707) 776-3777
Fax: (707) 656-4067

Parks & Facility Maintenance

840 Hopper St. Ext.
Petaluma, CA 94952
Phone (707) 778-4303
Fax (707) 206-6065

Transit Division

555 N. McDowell Blvd.
Petaluma, CA 94954
Phone (707) 778-4421

Utilities & Field Operations

202 N. McDowell Blvd.
Petaluma, CA 94954
Phone (707) 778-4546
Fax (707) 206-6034

E-Mail: publicworks@
cityofpetaluma.org

All other items of the documents shall remain unchanged. **A signed copy of this Addendum and the attached acknowledgement form shall be attached to the bid proposal. Failure to do so may cause rejection of your bid as being non-responsive.**

A handwritten signature in black ink that reads "Jeff Stutsman". The signature is written in a cursive, flowing style.

Jeff Stutsman
Traffic Engineer
Public Works & Utilities Department

ADDENDUM NO. 2

**Traffic Signal Timing Communication Upgrade
City Project No. TBD**

June 1, 2020

ACKNOWLEDGEMENT

Receipt of Addendum No. 2 is hereby acknowledged by _____
(Contractor's Name)



on the _____ day of _____, 2020.

By: _____

Signature

Title

Company

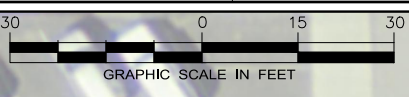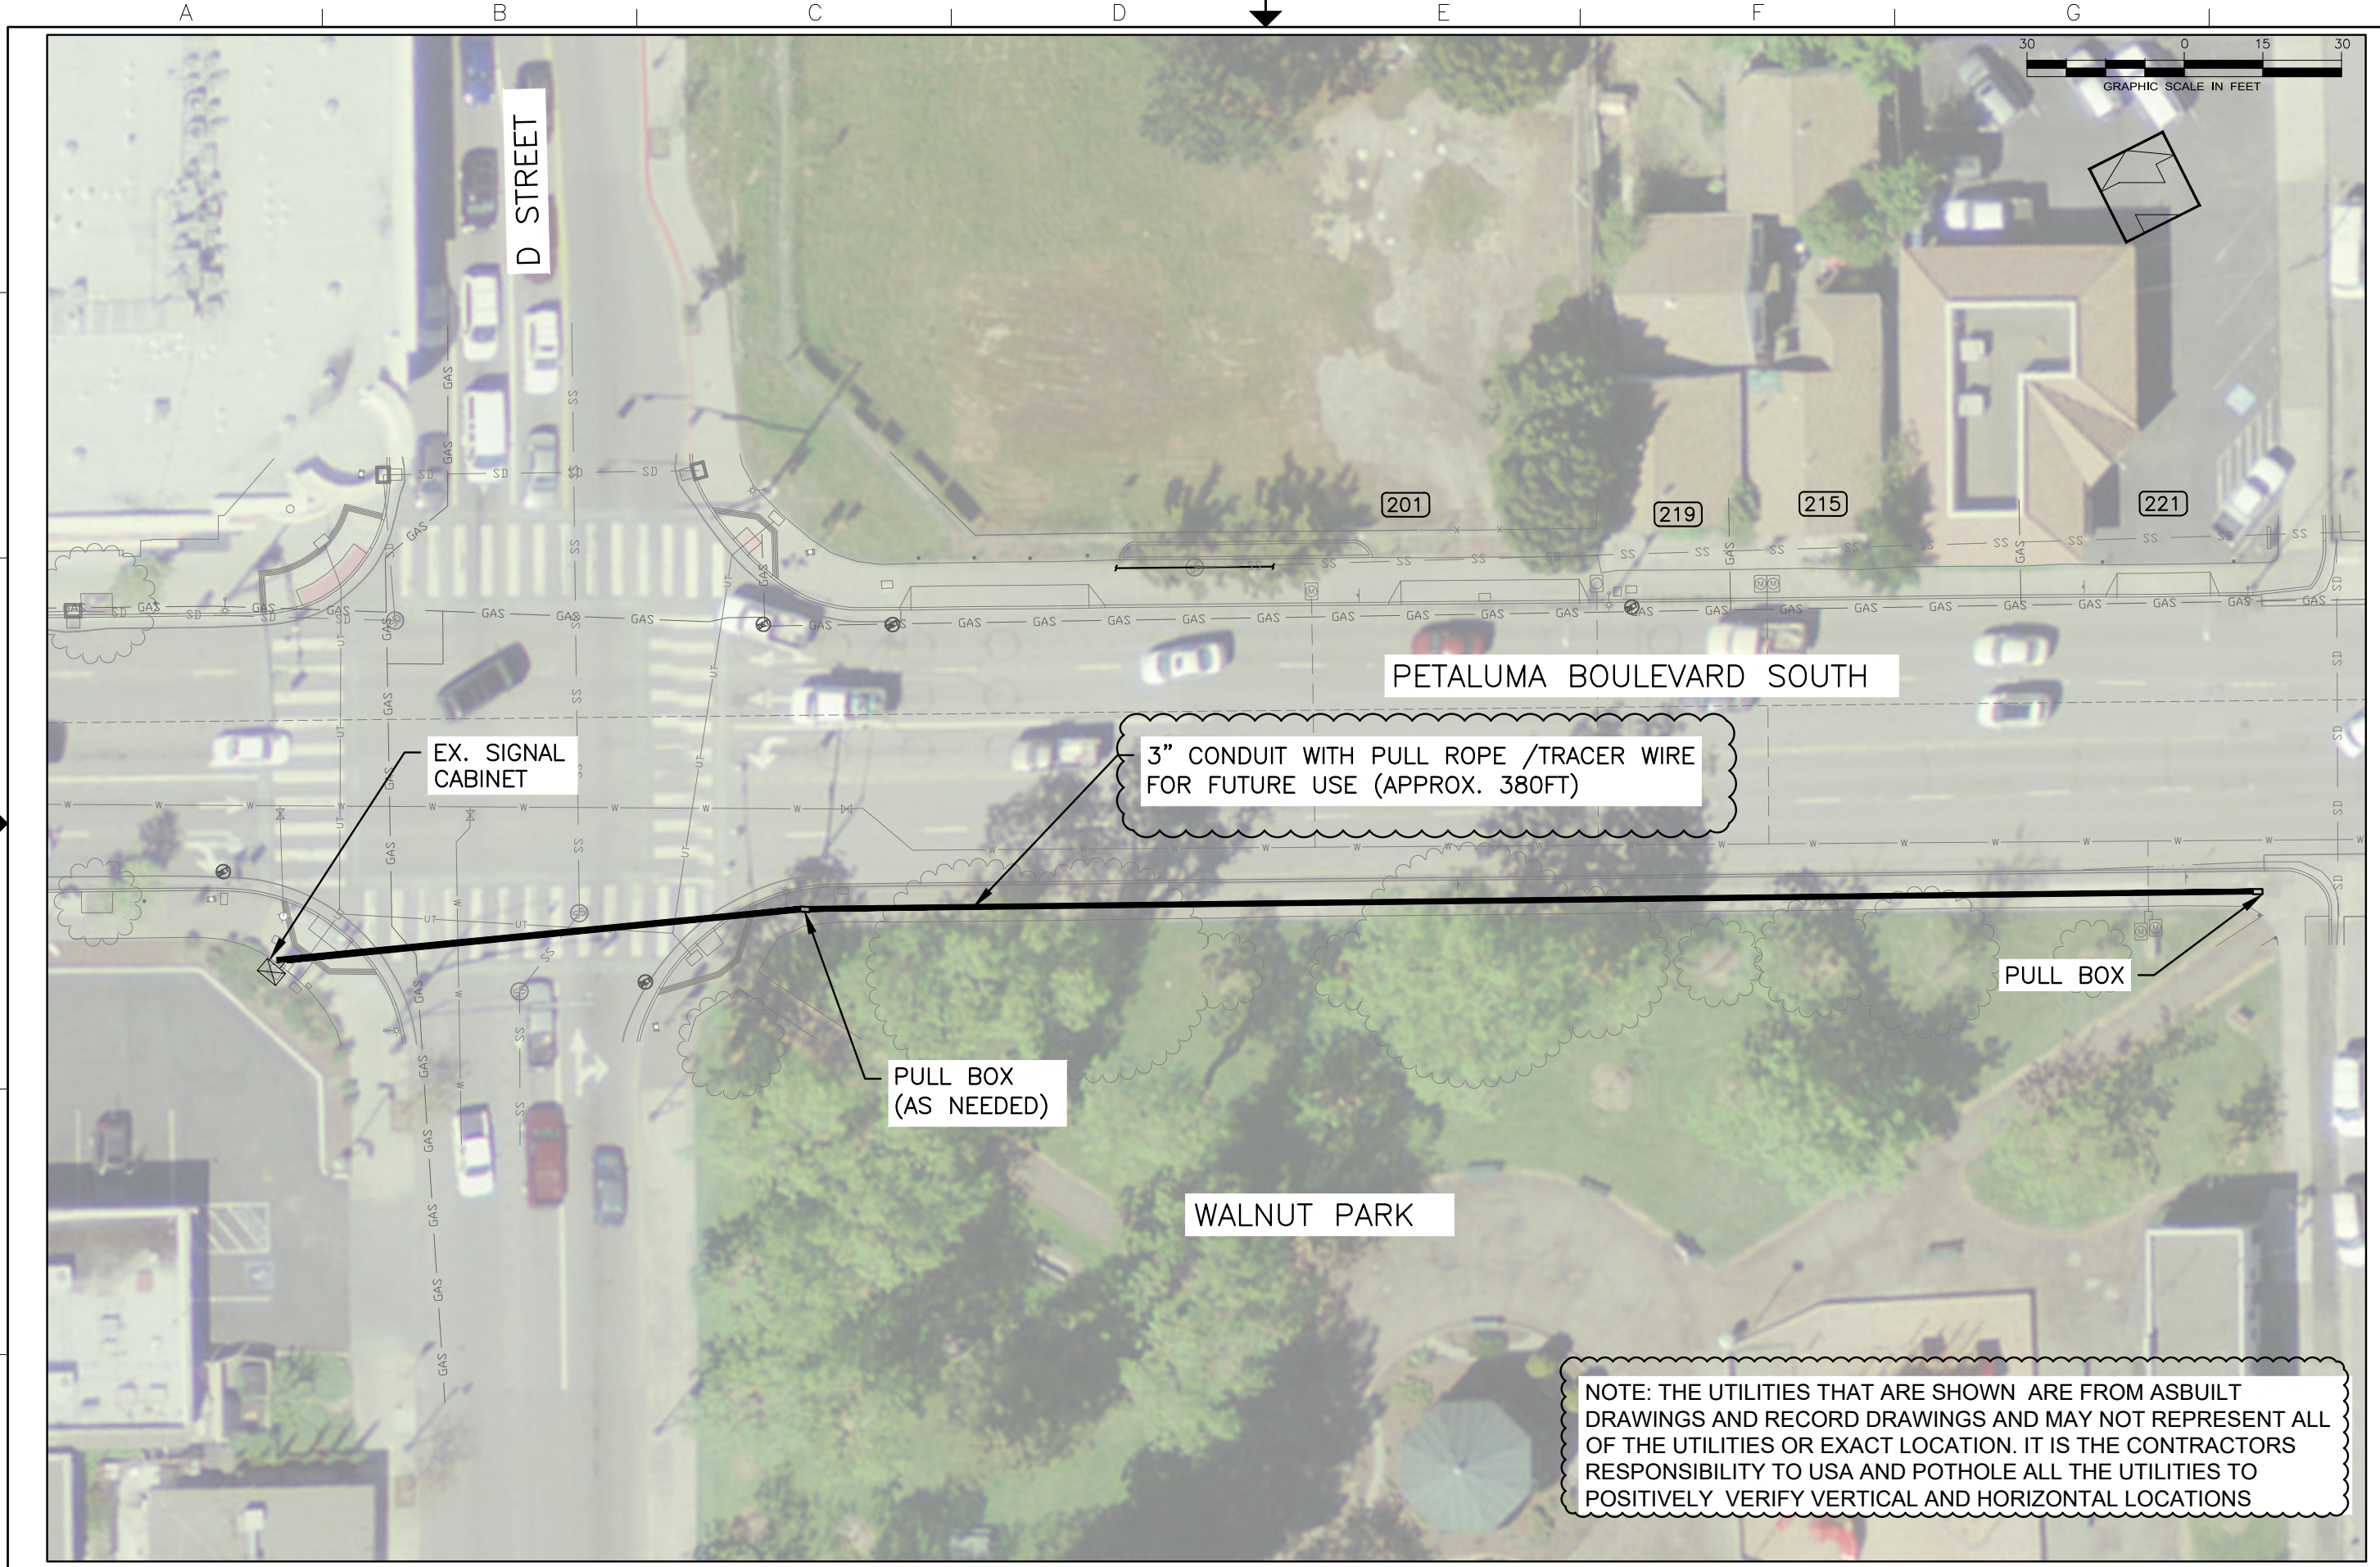

D STREET

201

219

215

221

PETALUMA BOULEVARD SOUTH

EX. SIGNAL CABINET

3" CONDUIT WITH PULL ROPE /TRACER WIRE FOR FUTURE USE (APPROX. 380FT)

PULL BOX

PULL BOX (AS NEEDED)


WALNUT PARK

NOTE: THE UTILITIES THAT ARE SHOWN ARE FROM ASBUILT DRAWINGS AND RECORD DRAWINGS AND MAY NOT REPRESENT ALL OF THE UTILITIES OR EXACT LOCATION. IT IS THE CONTRACTORS RESPONSIBILITY TO USA AND POTHOLE ALL THE UTILITIES TO POSITIVELY VERIFY VERTICAL AND HORIZONTAL LOCATIONS


PLAN

DATE: JULY -2020
 DESIGNED BY: JS
 DRAWN BY: JS
 CHECKED BY: JB

PROJECT NO.
 TBD

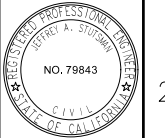



CITY OF PETALUMA
 PUBLIC WORKS & UTILITIES
 202 N. McDowell Blvd., PETALUMA, CALIFORNIA, 94954
 PH. 707-778-4546 FAX. 707-778-4508

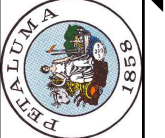

SIGNAL AND COMMUNICATION UPGRADES

PETALUMA BLVD S

SHEET
C1
 3 of 5

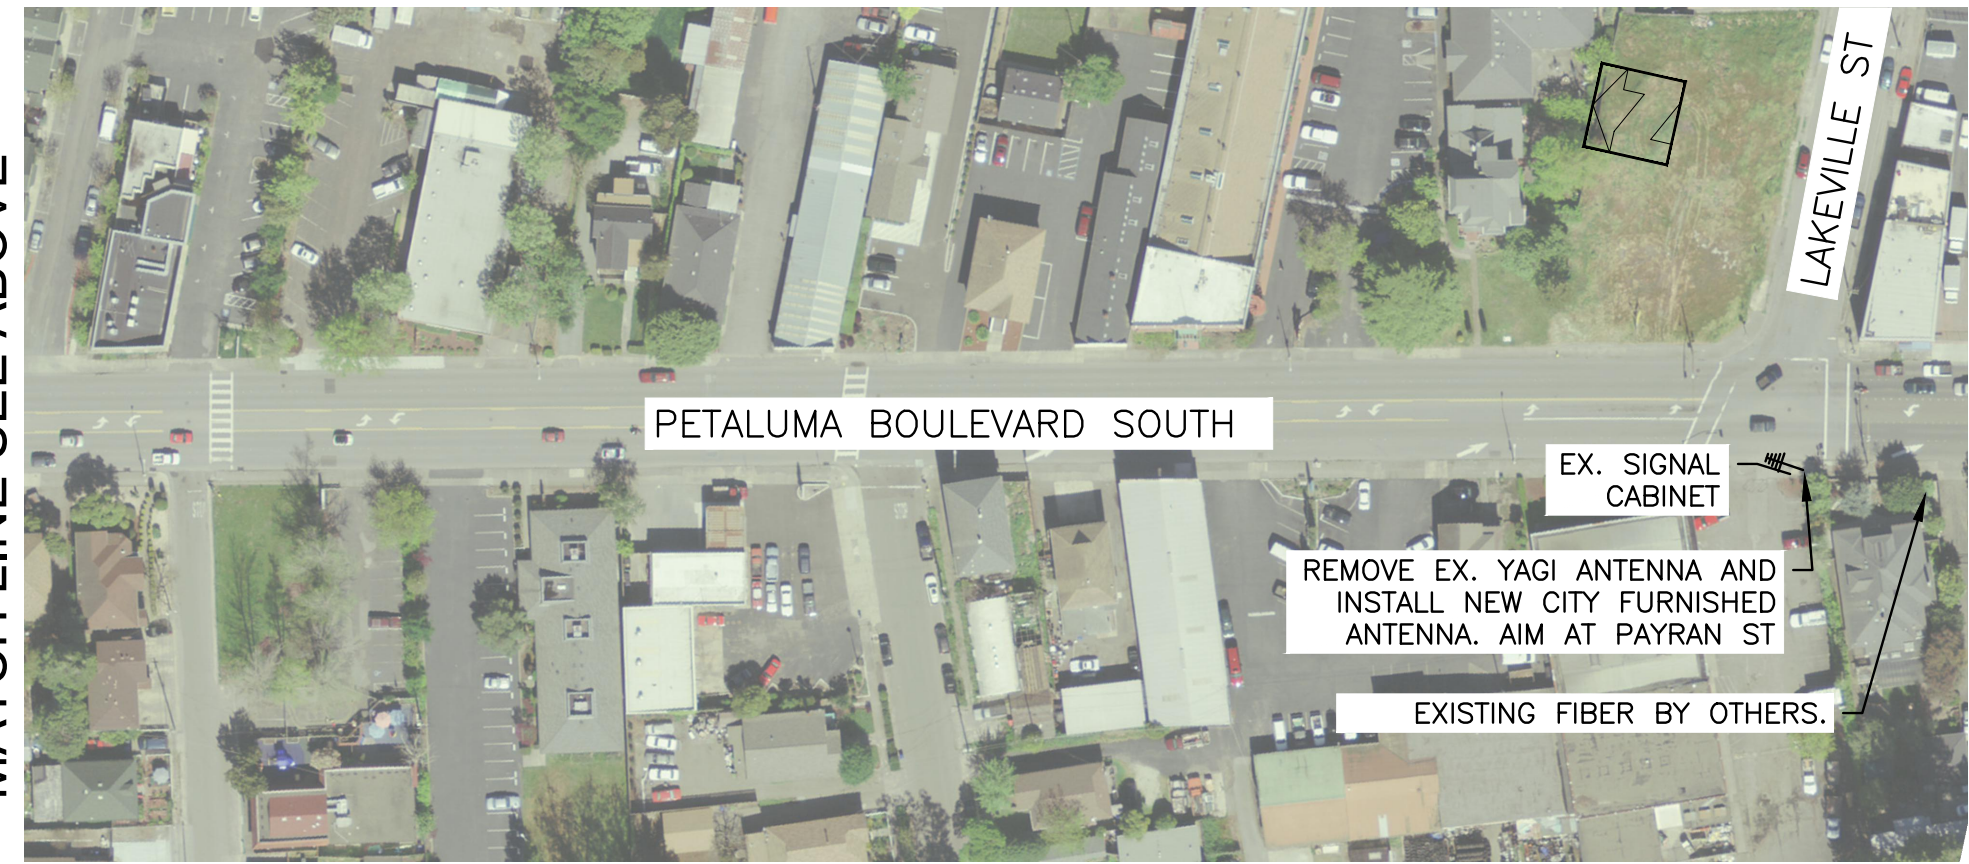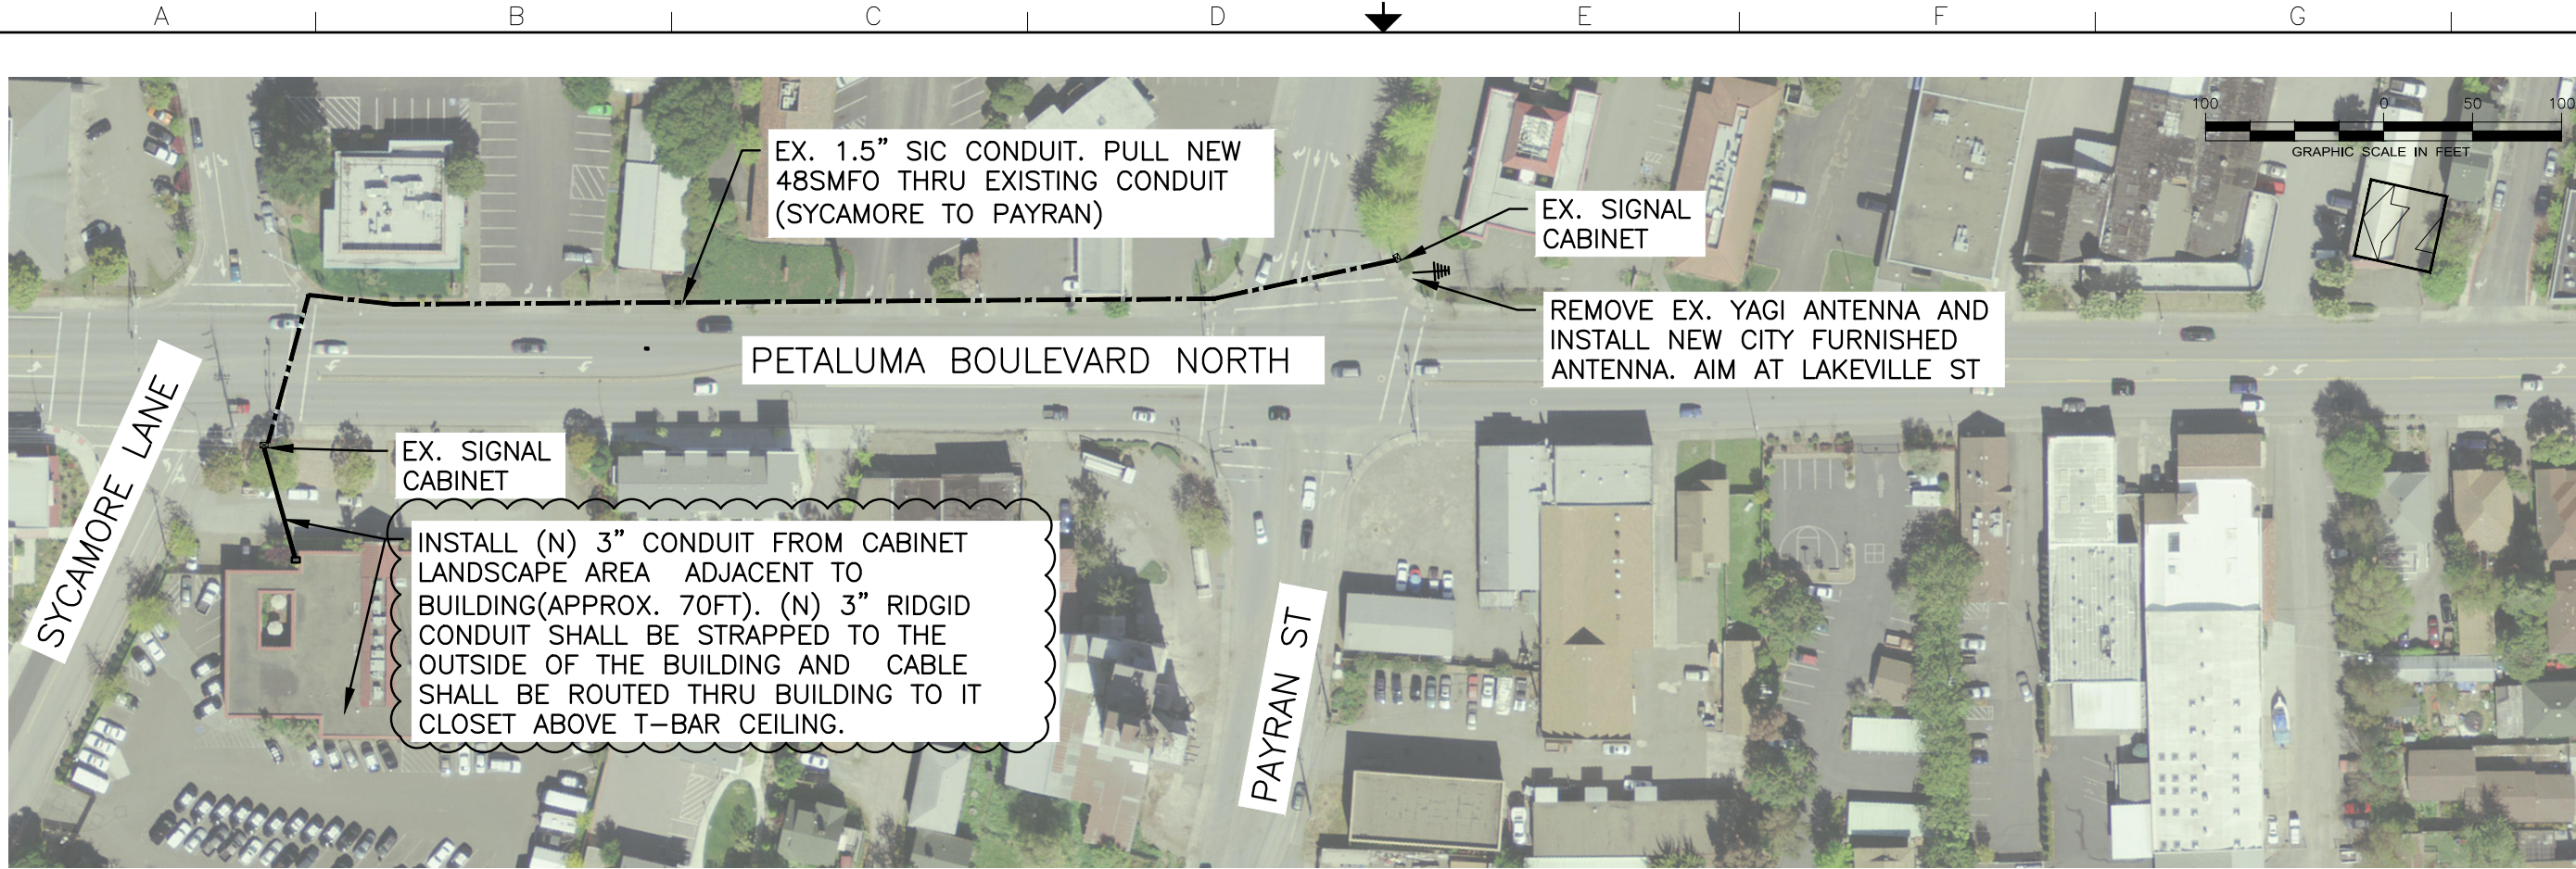

2

3

4

5

6

MATCH LINE SEE BELOW

DATE: JULY -2020
 DESIGNED BY: JS
 DRAWN BY: JS
 CHECKED BY: JB

PROJECT NO.
 TBD



CITY OF PETALUMA
 PUBLIC WORKS & UTILITIES
 202 N. McDowell Blvd., PETALUMA, CALIFORNIA, 94954
 PH. 707-778-4546 FAX. 707-778-4508



SIGNAL AND COMMUNICATION UPGRADES
 PETALUMA BLVD N

SHEET
C2
 4 of 5

1

2

3

4

5

6