



DISH Wireless L.L.C. SITE ID:

SFSFO01158A

DISH Wireless L.L.C. SITE ADDRESS:

**1300 COMMERCE ST
PETALUMA, CA 94954**

SCOPE OF WORK	
THIS IS NOT AN ALL INCLUSIVE LIST. CONTRACTOR SHALL UTILIZE SPECIFIED EQUIPMENT PART OR ENGINEER APPROVED EQUIVALENT. CONTRACTOR SHALL VERIFY ALL NEEDED EQUIPMENT TO PROVIDE A FUNCTIONAL SITE. THE PROJECT GENERALLY CONSISTS OF THE FOLLOWING:	
SECTOR SCOPE OF WORK: <ul style="list-style-type: none"> INSTALL (3) PROPOSED ANTENNA RF SCREEN (1 PER SECTOR) INSTALL (3) PROPOSED PANEL ANTENNAS (1 PER SECTOR) INSTALL PROPOSED JUMPERS INSTALL (6) PROPOSED RRU's (2 PER SECTOR) INSTALL (3) PROPOSED OVER VOLTAGE PROTECTION DEVICE (OVP) (1 PER SECTOR) INSTALL (3) PROPOSED POWER AND FIBER TRUNK CABLES 	
EQUIPMENT SCOPE OF WORK: <ul style="list-style-type: none"> INSTALL (1) PROPOSED METAL PLATFORM WITH H-FRAME INSTALL (1) PROPOSED BBU IN CABINET INSTALL (1) PROPOSED EQUIPMENT CABINET INSTALL (1) PROPOSED POWER CONDUIT INSTALL (1) PROPOSED TELCO CONDUIT INSTALL (1) PROPOSED NEMA 3 TELCO-FIBER BOX INSTALL (1) PROPOSED GPS UNIT 	

SITE INFORMATION	PROJECT DIRECTORY
PROPERTY OWNER: PUBLIC STORAGE INC ADDRESS: PO BOX 25025 GLENDALE, CA 91201-5025	APPLICANT: DISH Wireless L.L.C. 5701 SOUTH SANTA FE DRIVE LITTLETON, CO 80120
STRUCTURE TYPE: ROOFTOP	SITE DESIGNER: THE CBR GROUP 2840 HOWE ROAD, SUITE E MARTINEZ, CA 94553 (925) 246-3212
COUNTY: SONOMA	SITE ACQUISITION: PHAN FRONTERA phan@thecbrgroup.com
LATITUDE (NAD 83): 38.257311	CONSTRUCTION MANAGER: JAMES GONZALEZ jim@thecbrgroup.com
LONGITUDE (NAD 83): -122.640886	
ZONING JURISDICTION: CITY OF PETALUMA	
ZONING DISTRICT: I - INDUSTRIAL	
PARCEL NUMBER: 007-630-001-000	
OCCUPANCY GROUP: U	
CONSTRUCTION TYPE: II-B	
POWER COMPANY: X	
TELEPHONE COMPANY: X	



5701 SOUTH SANTA FE DRIVE
LITTLETON, CO 80120



2840 HOWE ROAD, SUITE E
MARTINEZ, CA 94553
www.TheCBRGroup.com



IT IS A VIOLATION OF LAW FOR ANY PERSON, UNLESS THEY ARE ACTING UNDER THE DIRECTION OF A LICENSED PROFESSIONAL ENGINEER, TO ALTER THIS DOCUMENT.

DRAWN BY: CHECKED BY: APPROVED BY:
JG/WM

RFDS REV #: 02/02/2022 REV 4

CONSTRUCTION DOCUMENTS

SUBMITTALS		
REV	DATE	DESCRIPTION
A	02/10/2022	90% CD'S ISSUED FOR REVIEW
B	04/19/2022	100% CONSTRUCTION DRAWINGS
C	06/11/2022	PLAN CHECK COMMENTS

A&E PROJECT NUMBER
SFSFO01158A

DISH Wireless L.L.C.
PROJECT INFORMATION

SFSFO01158A
1300 COMMERCE ST
PETALUMA, CA 94954

SHEET TITLE
TITLE SHEET

SHEET NUMBER
T-1

SITE PHOTO



UNDERGROUND SERVICE ALERT
UTILITY NOTIFICATION CENTER OF CALIFORNIA
(800) 642-2444
WWW.CALIFORNIA811.ORG
CALL 2-14 WORKING DAYS UTILITY NOTIFICATION PRIOR TO CONSTRUCTION

GENERAL NOTES

THE FACILITY IS UNMANNED AND NOT FOR HUMAN HABITATION. A TECHNICIAN WILL VISIT THE SITE AS REQUIRED FOR ROUTINE MAINTENANCE. THE PROJECT WILL NOT RESULT IN ANY SIGNIFICANT DISTURBANCE OR EFFECT ON DRAINAGE, NO SANITARY SEWER SERVICE, POTABLE WATER, OR TRASH DISPOSAL IS REQUIRED AND NO COMMERCIAL SIGNAGE IS PROPOSED.


11"x17" PLOT WILL BE HALF SCALE UNLESS OTHERWISE NOTED

CONTRACTOR SHALL VERIFY ALL PLANS, EXISTING DIMENSIONS, AND CONDITIONS ON THE JOB SITE, AND SHALL IMMEDIATELY NOTIFY THE ENGINEER IN WRITING OF ANY DISCREPANCIES BEFORE PROCEEDING WITH THE WORK.

DIRECTIONS

DIRECTIONS FROM SAN FRANCISCO INTERNATIONAL AIRPORT:
X GET ON I-380 W FROM INTERNATIONAL TERMINAL ARRIVALS LEVEL
X TAKE I-280 N TO CA-1 N/JUNIPERO SERRA BLVD. TAKE EXIT 49B FROM I-280 N
X GET ON US-101 N FROM 19TH AVE
X FOLLOW US-101 N TO E WASHINGTON ST IN PETALUMA. TAKE EXIT 474 FROM US-101 N
X FOLLOW N MCDOWELL BLVD TO COMMERCE ST
X USE THE 2ND FROM THE RIGHT LANE TO TURN RIGHT ONTO E WASHINGTON ST
X USE THE LEFT 2 LANES TO TURN LEFT AT THE 1ST CROSS STREET ONTO N MCDOWELL BLVD
X TURN LEFT ONTO COMMERCE ST

VICINITY MAP

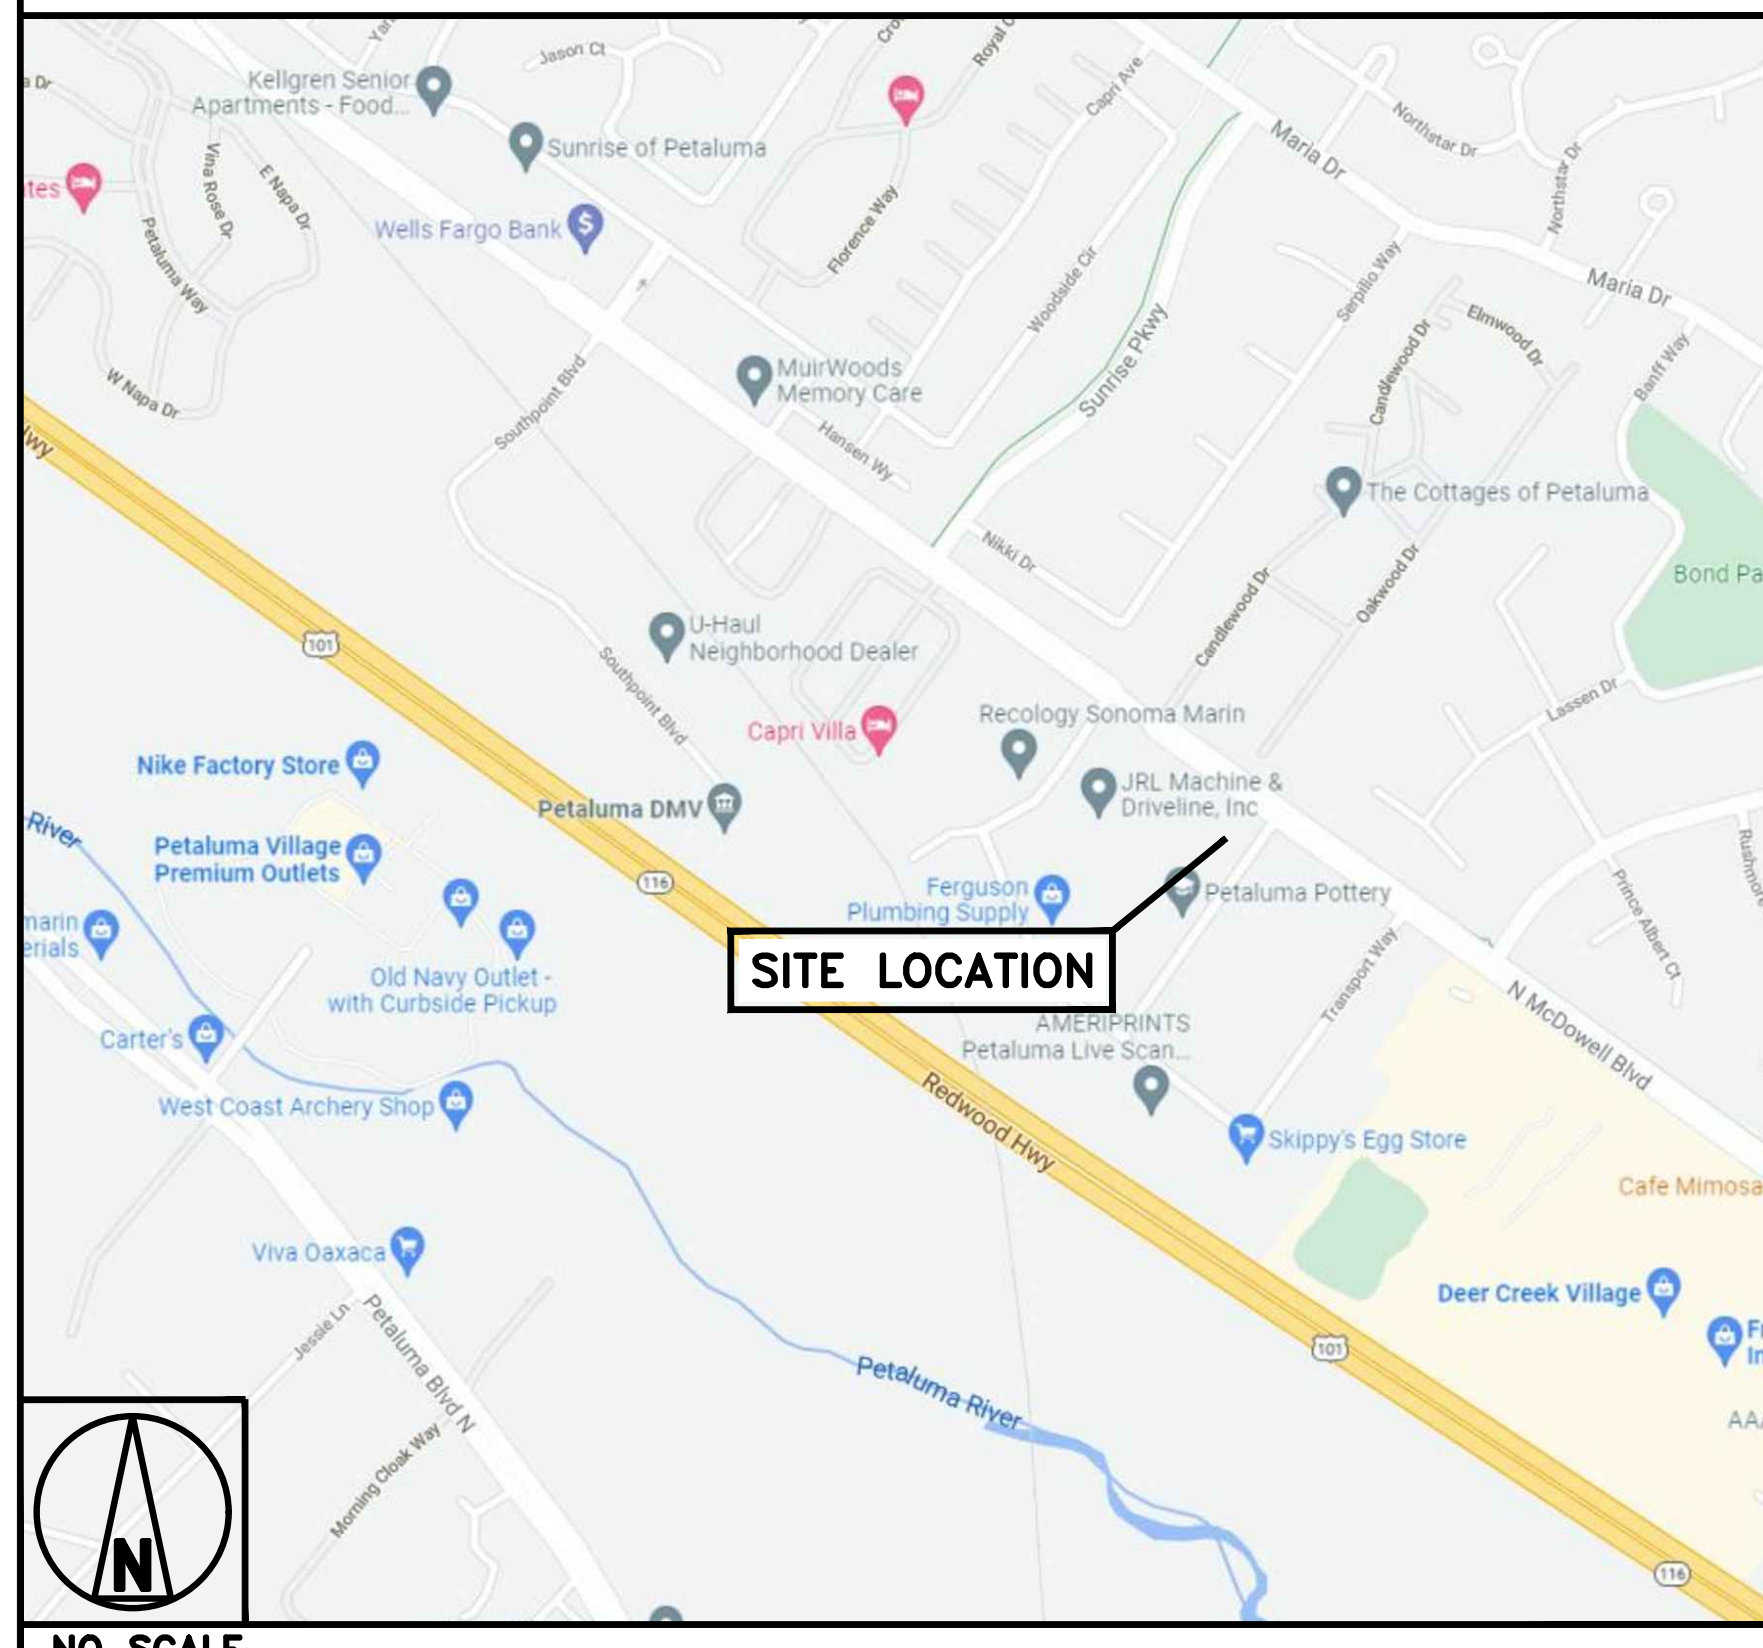

CALIFORNIA CODE OF COMPLIANCE

ALL WORK SHALL BE PERFORMED AND MATERIALS INSTALLED IN ACCORDANCE WITH THE CURRENT EDITIONS OF THE FOLLOWING CODES AS ADOPTED BY THE LOCAL GOVERNING AUTHORITIES. NOTHING IN THESE PLANS IS TO BE CONSTRUED TO PERMIT WORK NOT CONFORMING TO THESE CODES

CODE TYPE	CODE
BUILDING	2019 CALIFORNIA BUILDING CODE (CBC)/2018 IBC
MECHANICAL	2019 CALIFORNIA MECHANICAL CODE (CMC)/2018 UMC
ELECTRICAL	2019 CALIFORNIA ELECTRICAL CODE (CEC)/2020 NEC

SHEET INDEX

SHEET NO.	SHEET TITLE
T-1	TITLE SHEET
T-2	EME REPORT (PAGES 1-8)
T-3	EME REPORT (PAGES 9-16)
T-4	EME REPORT (PAGES 17-20)
A-1	OVERALL SITE PLAN
A-2	ENLARGED BUILDING PLAN
A-3	ANTENNA PLAN, RRU PLAN AND SCHEDULE
A-4	EXISTING AND PROPOSED SOUTHWEST ELEVATIONS
A-5	EXISTING AND PROPOSED SOUTHEAST ELEVATIONS
A-6	EQUIPMENT PLATFORM AND H-FRAME DETAILS
A-7	EQUIPMENT DETAILS
A-8	EQUIPMENT DETAILS
S-1	STRUCTURAL DETAILS
S-2	STRUCTURAL DETAILS
S-3	STRUCTURAL DETAILS
S-4	STRUCTURAL NOTES
E-1	ELECTRICAL/FIBER ROUTE PLAN AND NOTES
E-2	ELECTRICAL DETAILS
E-3	ELECTRICAL ONE-LINE, FAULT CALCS & PANEL SCHEDULE
G-1	GROUNDING PLANS AND NOTES
G-2	GROUNDING DETAILS
G-3	GROUNDING DETAILS
RF-1	RF CABLE COLOR CODE
GN-1	LEGEND AND ABBREVIATIONS
GN-2	GENERAL NOTES
GN-3	GENERAL NOTES
GN-4	GENERAL NOTES
GN-5	RF SIGNAGE

**Appendix A
Certifications**

Preparer Certification

I, Andy Crum, state that:

- I am an employee of EnviroBusiness Inc. (d/b/a EBI Consulting), which provides RF-EME safety and compliance services to the wireless communications industry.
- I have successfully completed RF-EME safety training, and I am aware of the potential hazards from RF-EME and would be classified "occupational" under the FCC regulations.
- I am fully aware of and familiar with the Rules and Regulations of both the Federal Communications Commissions (FCC) and the Occupational Safety and Health Administration (OSHA) with regard to Human Exposure to Radio Frequency Radiation.
- I have reviewed the data provided by the client and incorporated it into this Site Compliance Report such that the information contained in this report is true and accurate to the best of my knowledge.

Andy Crum

EBI Consulting • 21 B Street • Burlington, MA 01803 • 1.800.786.2346

Reviewed and Approved by:



sealed 11Apr2022

Michael McGuire
Electrical Engineer
mike@h2dc.com


Note that EBI's scope of work is limited to an evaluation of the Radio Frequency – Electromagnetic Energy (RF-EME) field generated by the antennas and broadcast equipment noted in this report. The engineering and design of the building and related structures, as well as the impact of the antennas and broadcast equipment on the structural integrity of the building, are specifically excluded from EBI's scope of work.

EBI Consulting • 21 B Street • Burlington, MA 01803 • 1.800.786.2346

**Appendix B
Radio Frequency Electromagnetic Energy
Safety Information and Signage Plans**


EBI Consulting • 21 B Street • Burlington, MA 01803 • 1.800.786.2346

Nearest Walking Surface (Main Roof Level) Simulation

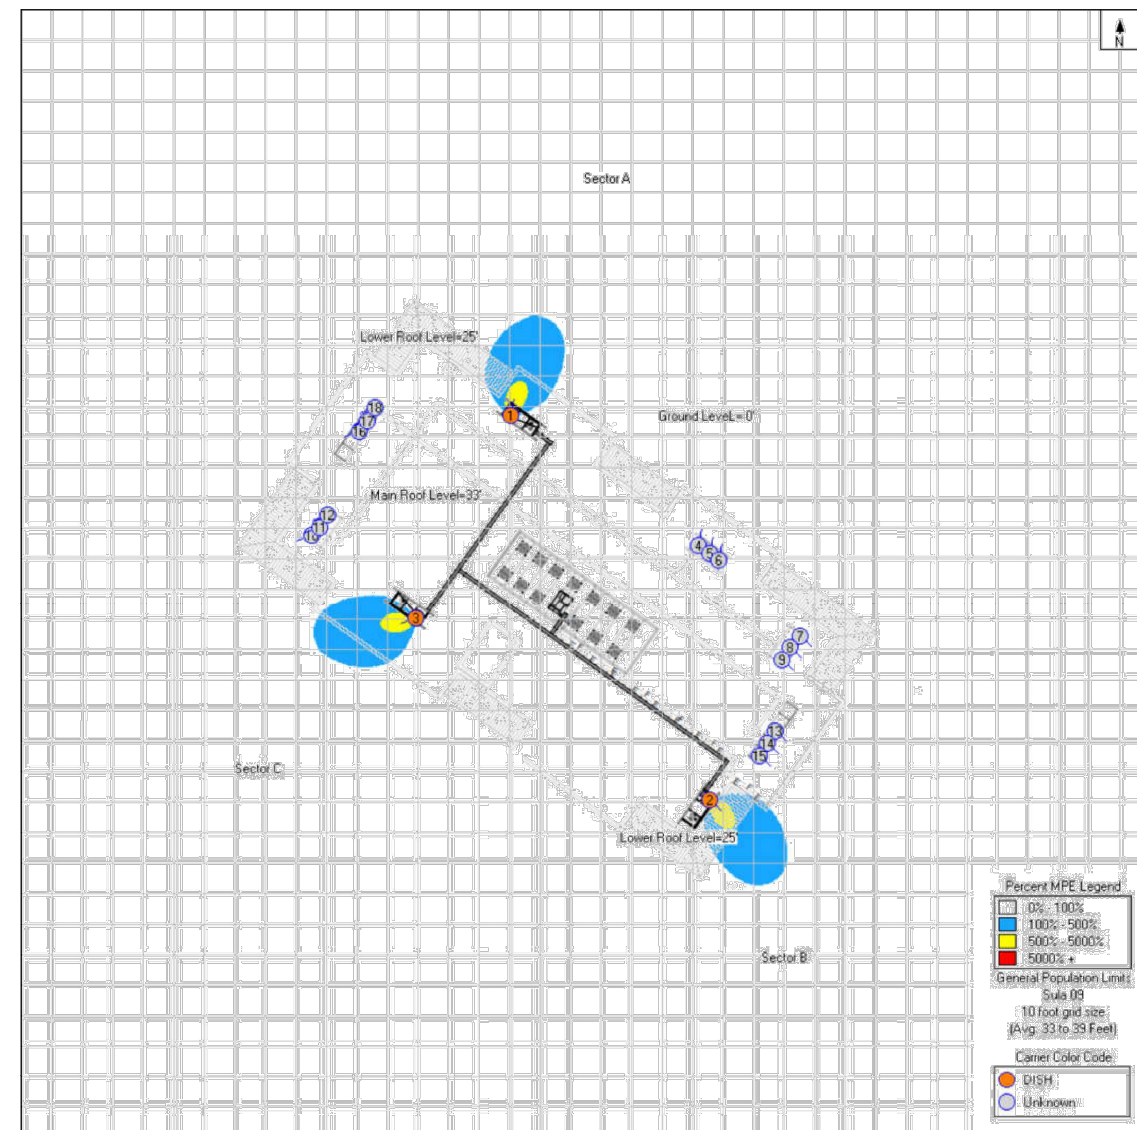


EBI Consulting • 21 B Street • Burlington, MA 01803 • 1.800.786.2346

Lower Roof Level Simulation

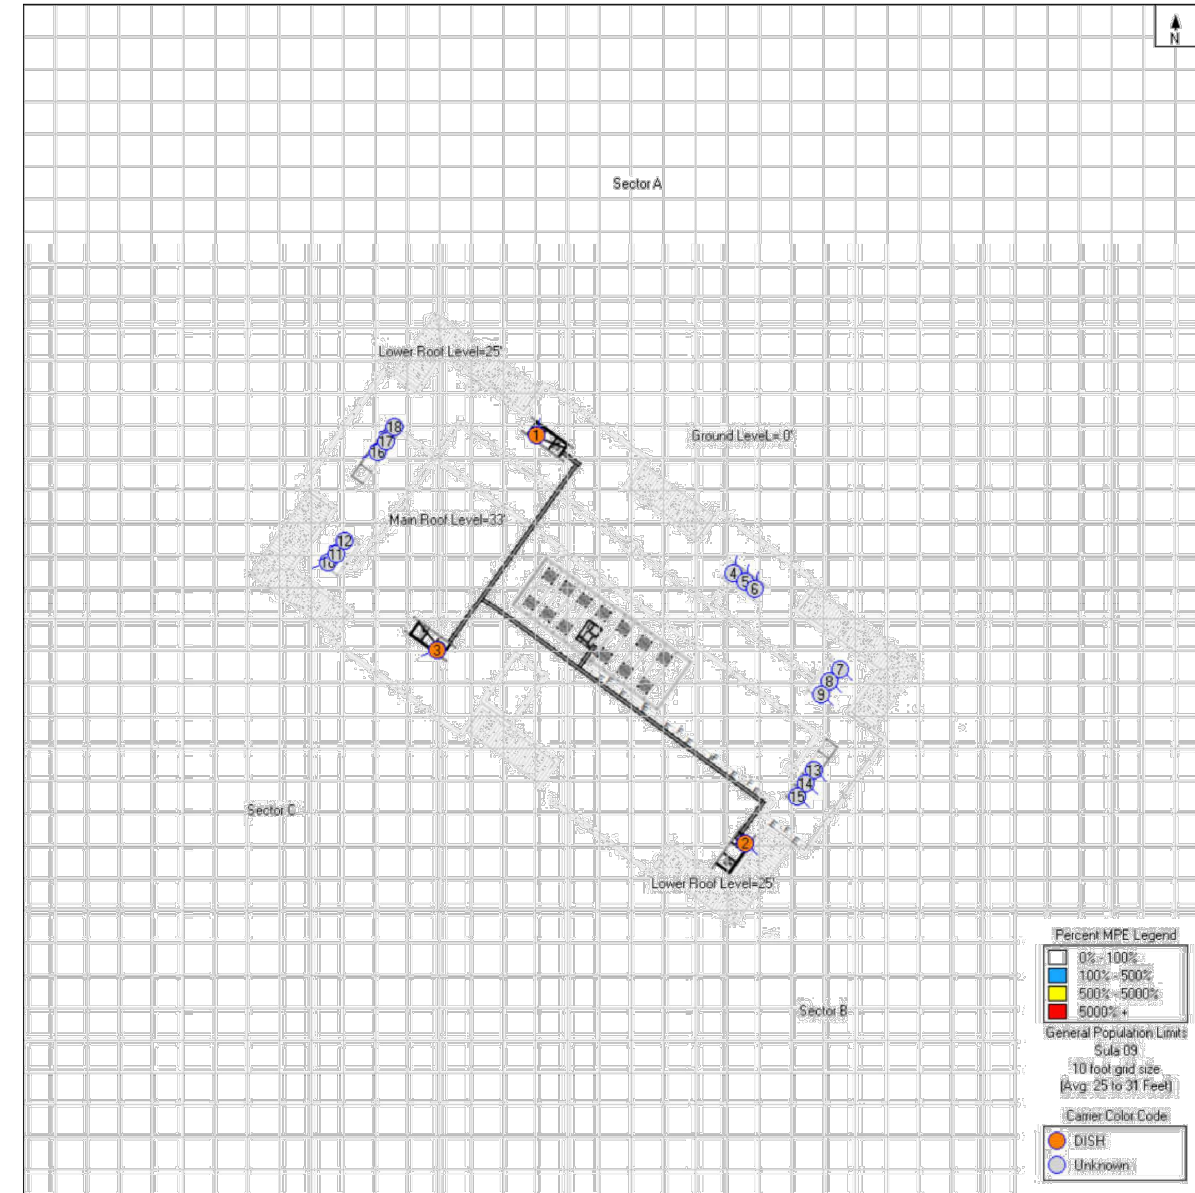


EBI Consulting • 21 B Street • Burlington, MA 01803 • 1.800.786.2346

Ground Level Simulation

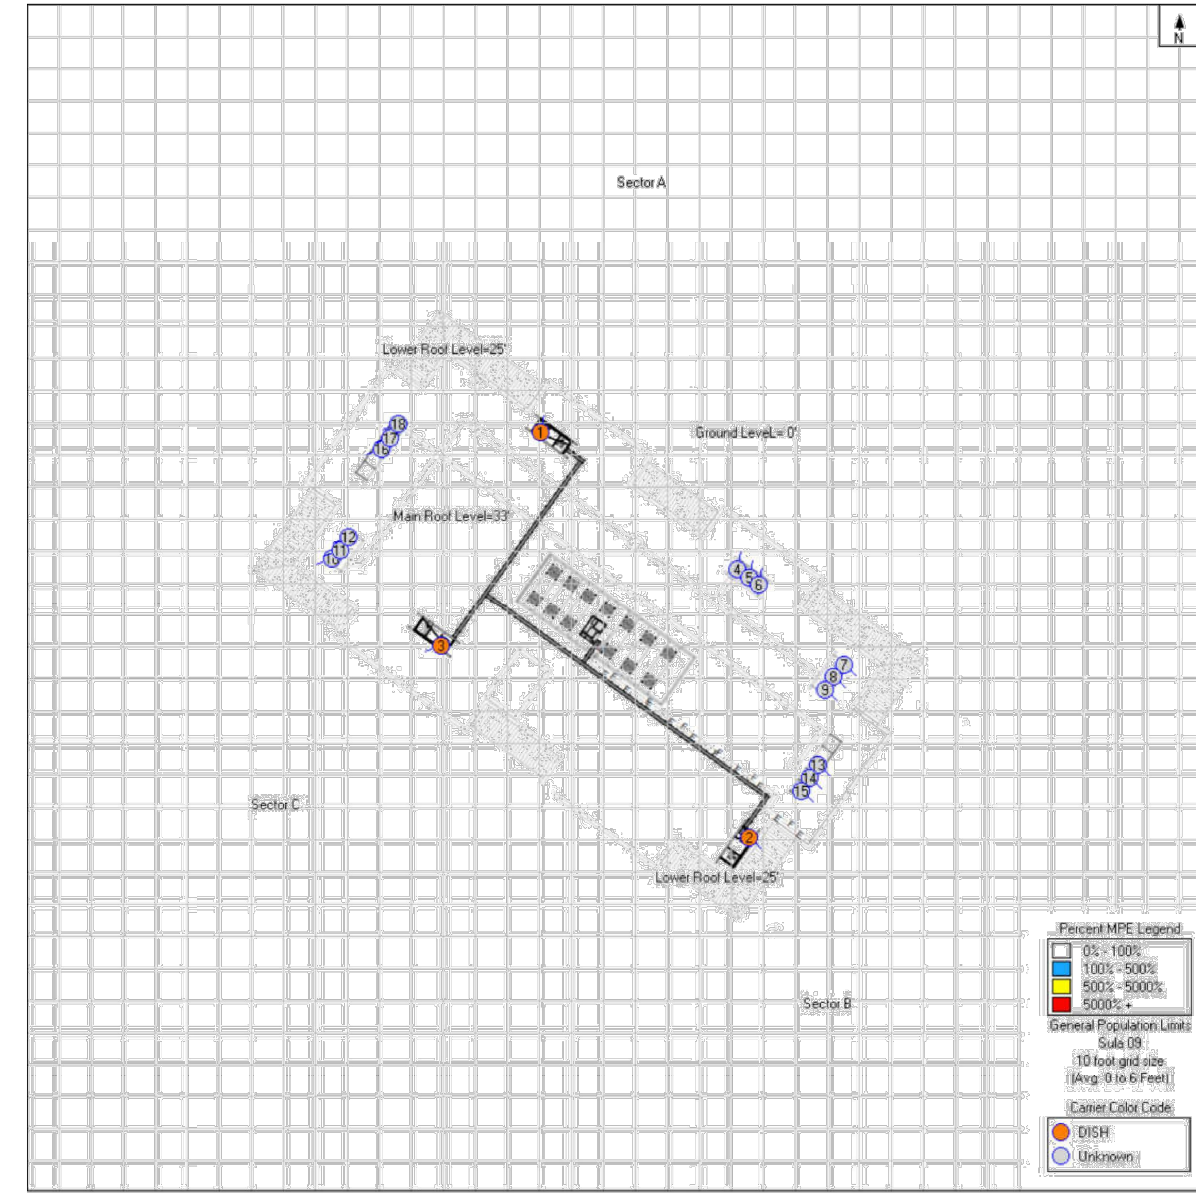

EBI Consulting • 21 B Street • Burlington, MA 01803 • 1.800.786.2346

Dish Wireless Safety (Signage) Plan

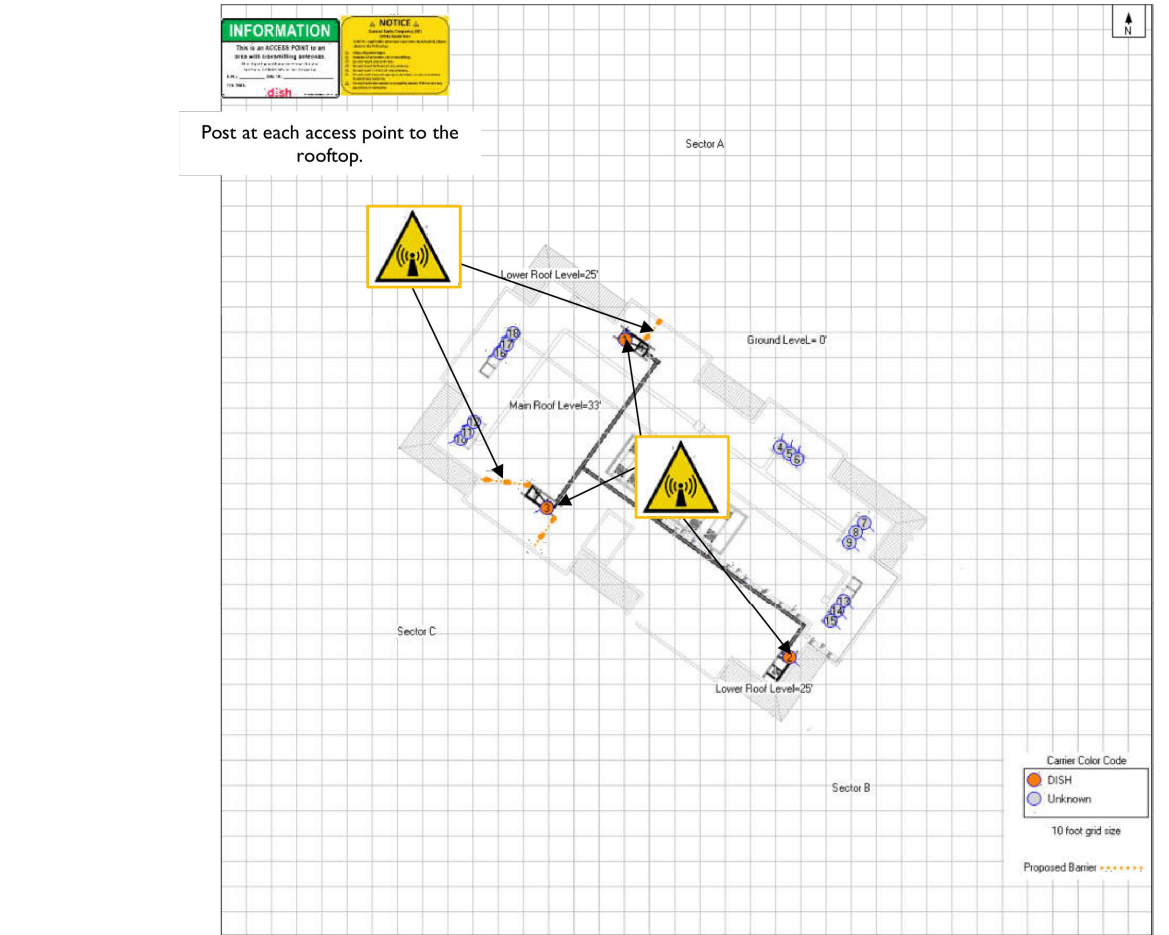

Sign	Posting Instructions	Required Signage / Mitigation
	Information Information signs are used to provide contact information for any questions or concerns for personnel accessing the site.	Securely post at the main rooftop access door and every point of access to the site in a manner conspicuous to all individuals entering thereon as indicated in the signage plan.
	Notice Used to notify individuals they are entering an area where the power density emitted from transmitting antennas may exceed the FCC's MPE limit for the general public or occupational exposures.	Securely post at the main rooftop access door and every point of access to the site in a manner conspicuous to all individuals entering thereon as indicated in the signage plan.
	Caution Used to notify individuals that they are entering a hot spot where either the general public or occupational FCC's MPE limit is or could be exceeded.	Post every 8ft on the barriers
	Warning Used to notify individuals that they are entering a hot zone where the occupational FCC's MPE limit has been exceeded by 10x.	Post behind each Dish Wireless antenna and every 8ft on the barriers
		N/A

EBI Consulting • 21 B Street • Burlington, MA 01803 • 1.800.786.2346



5701 SOUTH SANTA FE DRIVE
LITTLETON, CO 80120



2840 HOWE ROAD, SUITE E
MARTINEZ, CA 94553
www.TheCBRGroup.com

IT IS A VIOLATION OF LAW FOR ANY PERSON, UNLESS THEY ARE ACTING UNDER THE DIRECTION OF A LICENSED PROFESSIONAL ENGINEER, TO ALTER THIS DOCUMENT.

DRAWN BY: CHECKED BY: APPROVED BY:
JG/WM

RFDS REV #: 02/02/2022 REV 4

CONSTRUCTION DOCUMENTS

SUBMITTALS

REV	DATE	DESCRIPTION
A	02/10/2022	90% CD'S ISSUED FOR REVIEW
B	04/19/2022	100% CONSTRUCTION DRAWINGS
C	06/11/2022	PLAN CHECK COMMENTS

A&E PROJECT NUMBER
SFSFO01158A

DISH Wireless L.L.C.
PROJECT INFORMATION

SFSFO01158A
1300 COMMERCE ST
PETALUMA, CA 94954

SHEET TITLE
EME REPORT
(PAGES 9–16)

SHEET NUMBER

T-3

Appendix C

**Federal Communications
Commission (FCC) Requirements**

The FCC has established Maximum Permissible Exposure (MPE) limits for human exposure to Radiofrequency Electromagnetic (RF-EMF) energy fields, based on exposure limits recommended by the National Council on Radiation Protection and Measurements (NCRP) and, over a wide range of frequencies, the exposure limits developed by the Institute of Electrical and Electronics Engineers, Inc. (IEEE) and adopted by the American National Standards Institute (ANSI) to replace the 1982 ANSI guidelines. Limits for localized absorption are based on recommendations of both ANSI/IEEE and NCRP.

The FCC guidelines incorporate two separate tiers of exposure limits that are based upon occupational/controlled exposure limits (for workers) and general public/uncontrolled exposure limits for members of the general public.

Occupational/controlled exposure limits apply to situations in which persons are exposed as a consequence of their employment and in which those persons who are exposed have been made fully aware of the potential for exposure and can exercise control over their exposure. Occupational/controlled exposure limits also apply where exposure is of a transient nature as a result of incidental passage through a location where exposure levels may be above general public/uncontrolled limits (see below), as long as the exposed person has been made fully aware of the potential for exposure and can exercise control over his or her exposure by leaving the area or by some other appropriate means.

General public/uncontrolled exposure limits apply to situations in which the general public may be exposed or in which persons who are exposed as a consequence of their employment may not be made fully aware of the potential for exposure or cannot exercise control over their exposure. Therefore, members of the general public would always be considered under this category when exposure is not employment-related, for example, in the case of a telecommunications tower that exposes persons in a nearby residential area.

Table 1 and Figure 1 (below), which are included within the FCC's OET Bulletin 65, summarize the MPE limits for RF emissions. These limits are designed to provide a substantial margin of safety. They vary by frequency to take into account the different types of equipment that may be in operation at a particular facility and are "time-averaged" limits to reflect different durations resulting from controlled and uncontrolled exposures.


The FCC's MPEs are measured in terms of power (mW) over a unit surface area (cm²). Known as the power density, the FCC has established an occupational MPE of 5 milliwatts per square centimeter (mW/cm²) and an uncontrolled MPE of 1 mW/cm² for equipment operating in the 1900 MHz frequency range. For the Dish Wireless equipment operating at 600 MHz or 850 MHz, the FCC's occupational MPE is 2.83 mW/cm² and an uncontrolled MPE of 0.57 mW/cm². For the Dish Wireless equipment operating at 1900 MHz, the FCC's occupational MPE is 5.0 mW/cm² and an uncontrolled MPE limit of 1.0 mW/cm². These limits are considered protective of these populations.

Table 1: Limits for Maximum Permissible Exposure (MPE)

(A) Limits for Occupational/Controlled Exposure				
Frequency Range (MHz)	Electric Field Strength (E) (V/m)	Magnetic Field Strength (H) (A/m)	Power Density (S) (mW/cm ²)	Averaging Time [E], [H], or S (minutes)
0.3-3.0	614	1.63	(100) ^f	6
3.0-30	1842/f	4.89/f	(900/f) ^f	6
30-300	61.4	0.163	1.0	6
300-1,500	--	--	f/300	6
1,500-100,000	--	--	5	6
(B) Limits for General Public/Uncontrolled Exposure				
Frequency Range (MHz)	Electric Field Strength (E) (V/m)	Magnetic Field Strength (H) (A/m)	Power Density (S) (mW/cm ²)	Averaging Time [E], [H], or S (minutes)
0.3-1.34	614	1.63	(100) ^f	30
1.34-30	824/f	2.19/f	(180/f) ^f	30
30-300	27.5	0.073	0.2	30
300-1,500	--	--	f/1,500	30
1,500-100,000	--	--	1.0	30

f = Frequency in (MHz)
* Plane-wave equivalent power density

Figure 1. FCC Limits for Maximum Permissible Exposure (MPE)
Plane-wave Equivalent Power Density

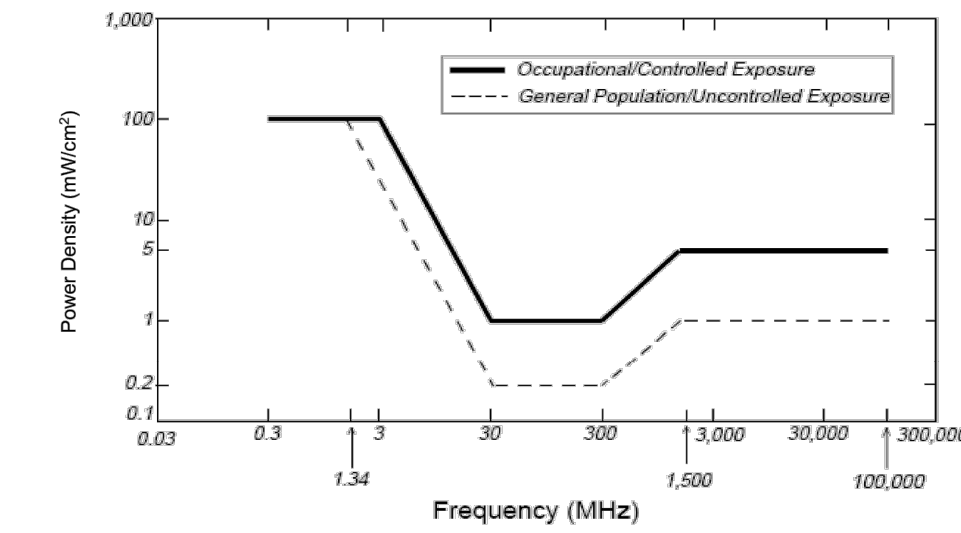

Based on the above, the most restrictive thresholds for exposures of unlimited duration to RF energy for several personal wireless services are summarized below:

Personal Wireless Service	Approximate Frequency	Occupational MPE	Public MPE
Microwave (Point-to-Point)	5,000 - 80,000 MHz	5.00 mW/cm ²	1.00 mW/cm ²
Broadband Radio (BRS)	2,400 MHz	5.00 mW/cm ²	1.00 mW/cm ²
Wireless Communication (WCS)	2,300 MHz	5.00 mW/cm ²	1.00 mW/cm ²
Advanced Wireless (AWS)	2,100 MHz	5.00 mW/cm ²	1.00 mW/cm ²
Personal Communication (PCS)	1,950 MHz	5.00 mW/cm ²	1.00 mW/cm ²
Cellular Telephone	870 MHz	2.90 mW/cm ²	0.58 mW/cm ²
Specialized Mobile Radio (SMR)	855 MHz	2.85 mW/cm ²	0.57 mW/cm ²
Long Term Evolution (LTE)	700 MHz	2.33 mW/cm ²	0.47 mW/cm ²
Most Restrictive Frequency Range	30-300 MHz	1.00 mW/cm ²	0.20 mW/cm ²

MPE limits are designed to provide a substantial margin of safety. These limits apply for continuous exposures and are intended to provide a prudent margin of safety for all persons, regardless of age, gender, size, or health.

Personal Communication (PCS) facilities used by Dish Wireless in this area will potentially operate within a frequency range of 600 to 2100 MHz. Facilities typically consist of: 1) electronic transceivers (the radios or cabinets) connected to wired telephone lines; and 2) antennas that send the wireless signals created by the transceivers to be received by individual subscriber units (PCS telephones). Transceivers are typically connected to antennas by coaxial cables.

Because of the short wavelength of PCS services, the antennas require line-of-site paths for good propagation, and are typically installed above ground level. Antennas are constructed to concentrate energy towards the horizon, with as little energy as possible scattered towards the ground or the sky. This design, combined with the low power of PCS facilities, generally results in no possibility for exposure to approach Maximum Permissible Exposure (MPE) levels, with the exception of areas directly in front of the antennas.

FCC Compliance Requirement

A site is considered out of compliance with FCC regulations if there are areas that exceed the FCC exposure limits and there are no RF hazard mitigation measures in place. Any carrier which has an installation that contributes more than 5% of the applicable MPE must participate in mitigating these RF hazards.



5701 SOUTH SANTA FE DRIVE
LITTLETON, CO 80120



2840 HOWE ROAD, SUITE E
MARTINEZ, CA 94553
www.TheCBRGroup.com

IT IS A VIOLATION OF LAW FOR ANY PERSON, UNLESS THEY ARE ACTING UNDER THE DIRECTION OF A LICENSED PROFESSIONAL ENGINEER, TO ALTER THIS DOCUMENT.

DRAWN BY:	CHECKED BY:	APPROVED BY:
JG/WM	---	---

RFDS REV #: 02/02/2022 REV 4

CONSTRUCTION DOCUMENTS

SUBMITTALS		
REV	DATE	DESCRIPTION
A	02/10/2022	90% CD'S ISSUED FOR REVIEW
B	04/19/2022	100% CONSTRUCTION DRAWINGS
C	06/11/2022	PLAN CHECK COMMENTS

A&E PROJECT NUMBER
SFSFO01158A

DISH Wireless L.L.C.
PROJECT INFORMATION
SFSFO01158A
1300 COMMERCE ST
PETALUMA, CA 94954

SHEET TITLE
EME REPORT
(PAGES 17-20)

SHEET NUMBER
T-4

NOTES


1. CONTRACTOR SHALL FIELD VERIFY ALL DIMENSIONS.
2. CONTRACTOR SHALL MAINTAIN A 10'-0" MINIMUM SEPARATION BETWEEN THE PROPOSED GPS UNIT, TRANSMITTING ANTENNAS AND EXISTING GPS UNITS.



5701 SOUTH SANTA FE DRIVE
LITTLETON, CO 80120



2840 HOWE ROAD, SUITE E
MARTINEZ, CA 94553
www.TheCBRGroup.com

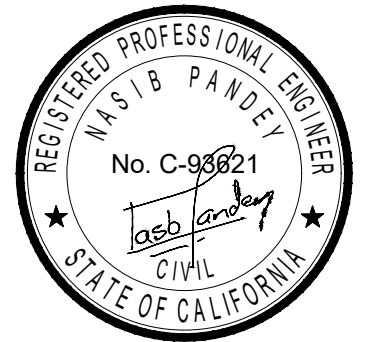

IT IS A VIOLATION OF LAW FOR ANY PERSON, UNLESS THEY ARE ACTING UNDER THE DIRECTION OF A LICENSED PROFESSIONAL ENGINEER, TO ALTER THIS DOCUMENT.

DRAWN BY: JG/WM
CHECKED BY: ---
APPROVED BY: ---

RFDS REV #: 02/02/2022 REV 4

CONSTRUCTION DOCUMENTS

SUBMITTALS		
REV	DATE	DESCRIPTION
A	02/10/2022	90% CD'S ISSUED FOR REVIEW
B	04/19/2022	100% CONSTRUCTION DRAWINGS
C	06/11/2022	PLAN CHECK COMMENTS

A&E PROJECT NUMBER
SFSF001158A



DISH Wireless L.L.C.
PROJECT INFORMATION

SFSF001158A
1300 COMMERCE ST
PETALUMA, CA 94954


SHEET TITLE
OVERALL
SITE PLAN

SHEET NUMBER

A-1

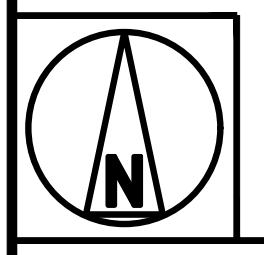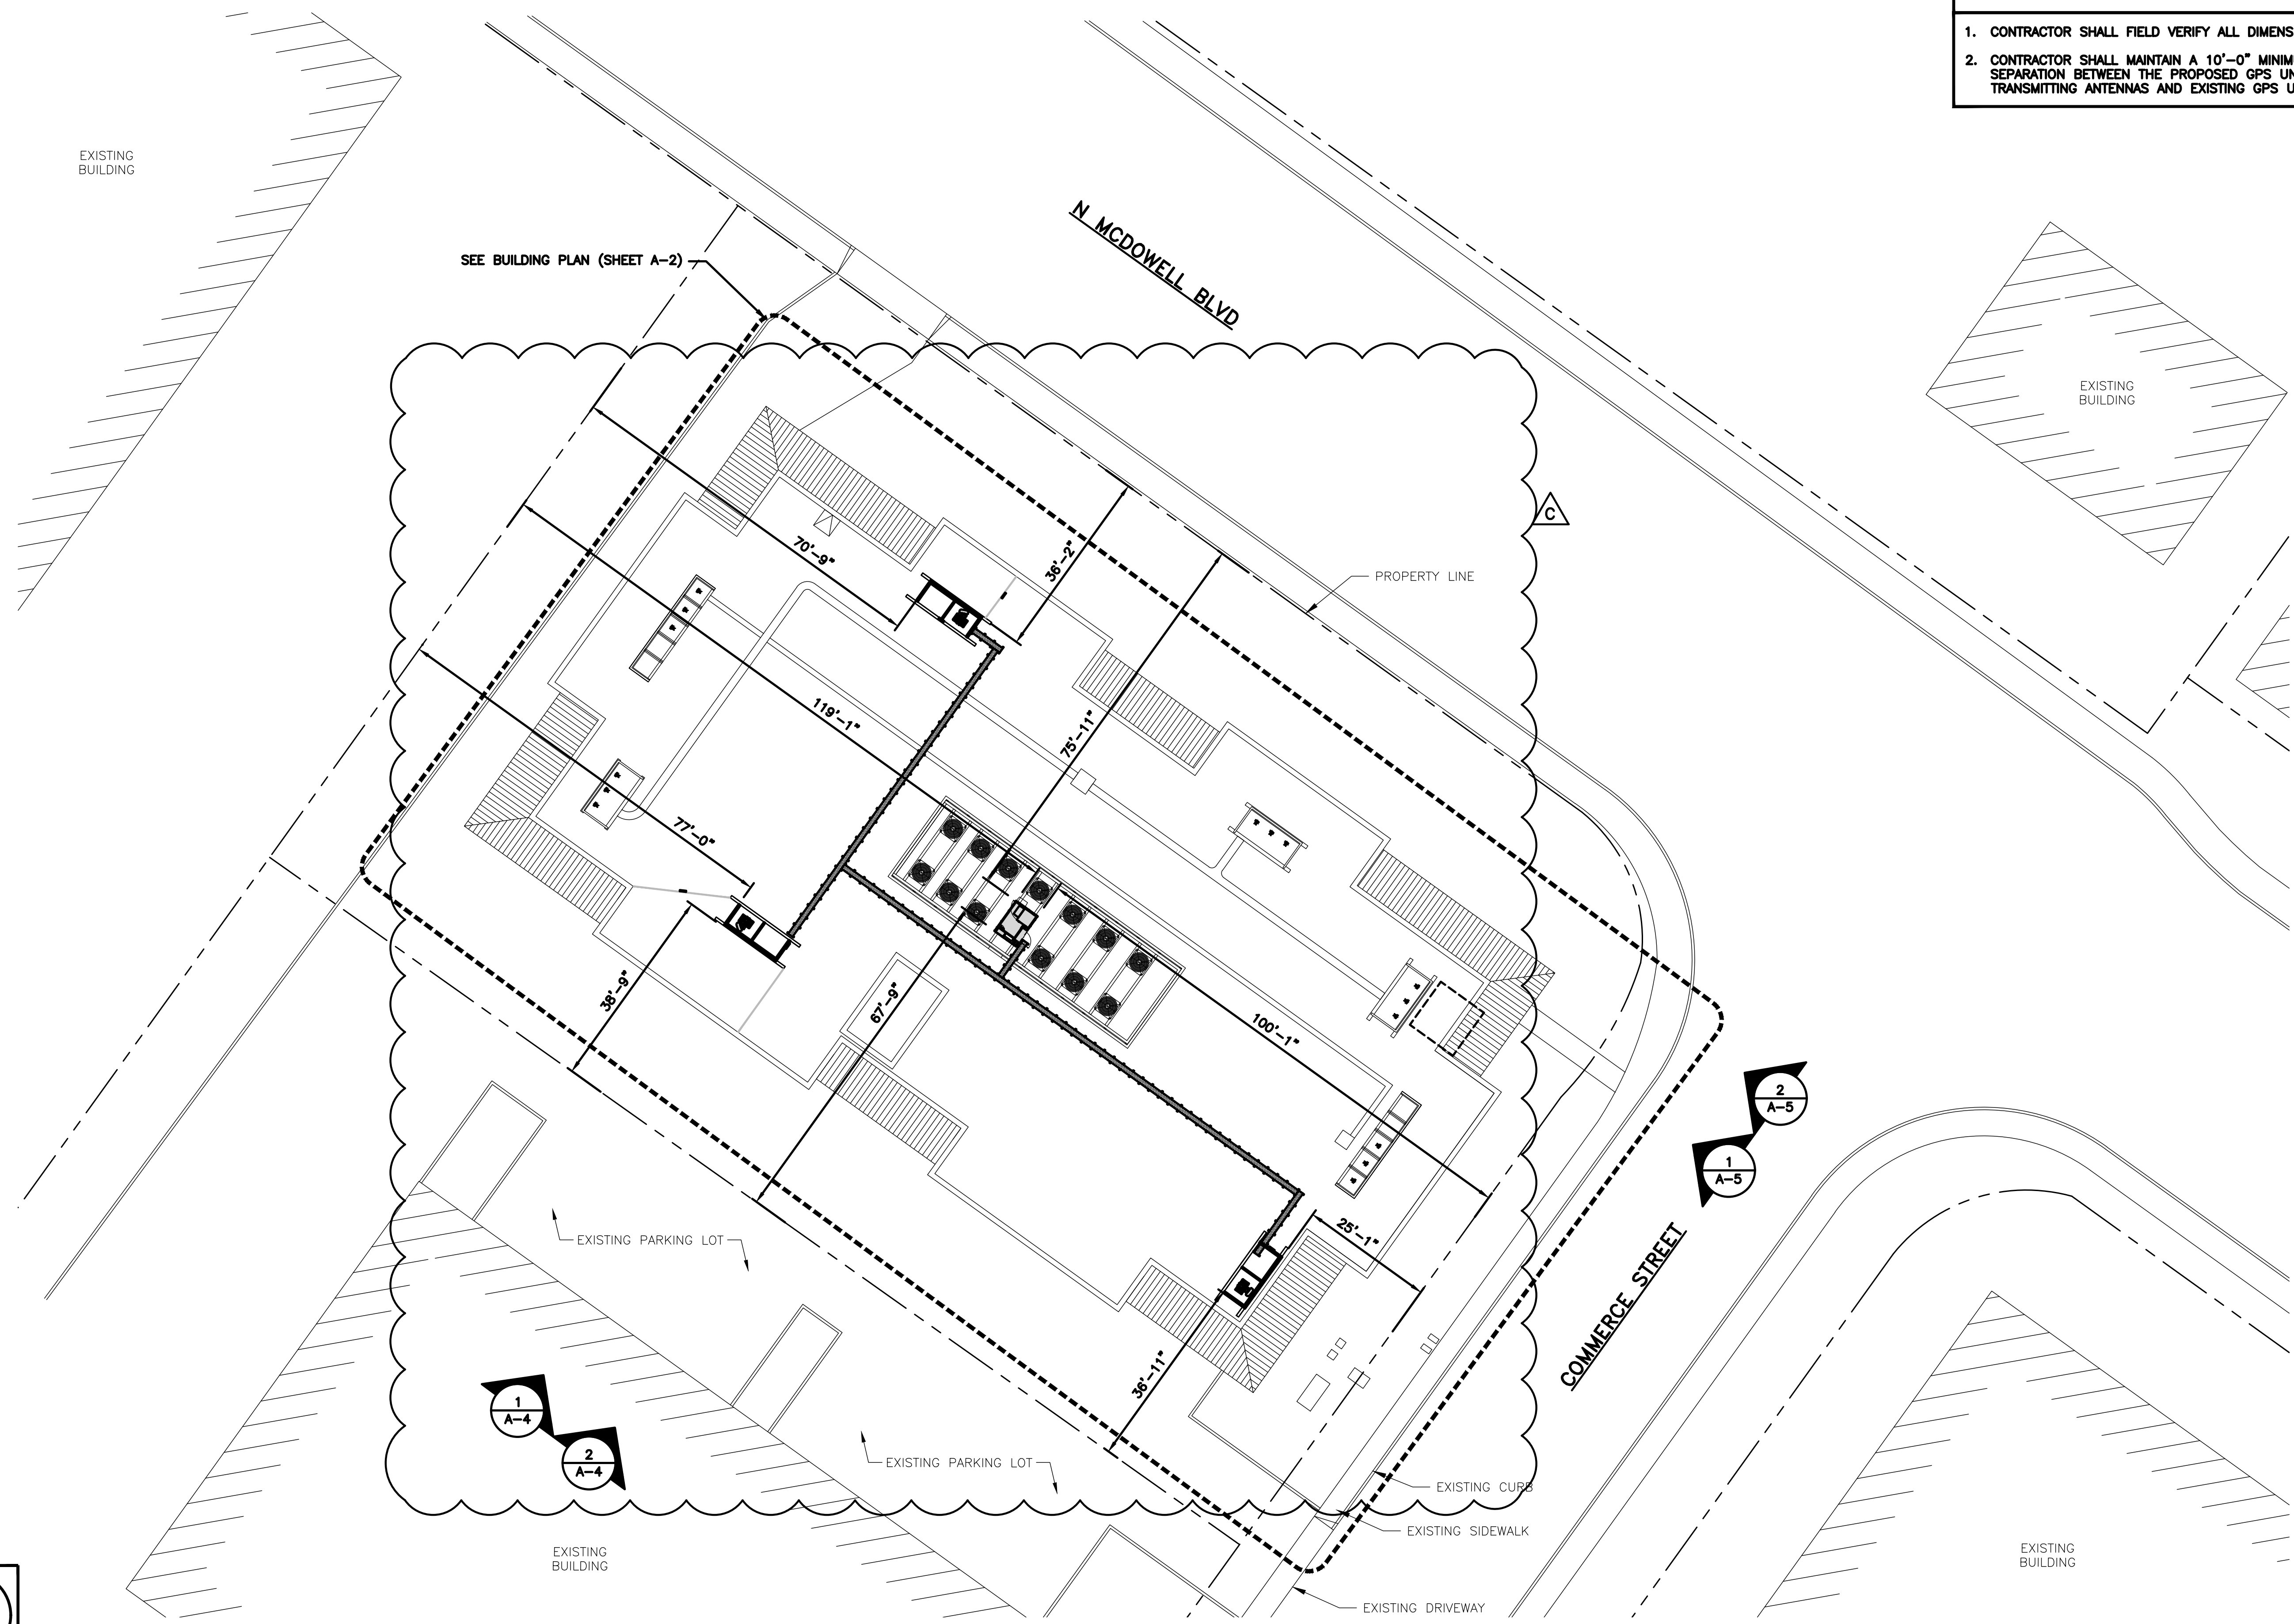

OVERALL SITE PLAN

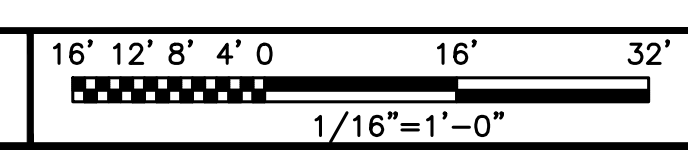

NOTES


1. CONTRACTOR SHALL FIELD VERIFY ALL DIMENSIONS.
2. CONTRACTOR SHALL MAINTAIN A 10'-0" MINIMUM SEPARATION BETWEEN THE PROPOSED GPS UNIT, TRANSMITTING ANTENNAS AND EXISTING GPS UNITS.
3. CONTRACTOR TO VERIFY WITH DISH Wireless L.L.C. C.M. THE LOCATION OF THE POWER AND FIBER SOURCE PRIOR TO CONSTRUCTION.
4. UTILITY RUBBER MAT TO BE IN STALLED UNDER ALL DISH Wireless L.L.C. EQUIPMENT THAT IS RESTING ON OR AFFIXED TO ROOF MEMBRANE



5701 SOUTH SANTA FE DRIVE
LITTLETON, CO 80120



2840 HOWE ROAD, SUITE E
MARTINEZ, CA 94553
www.TheCBRGroup.com

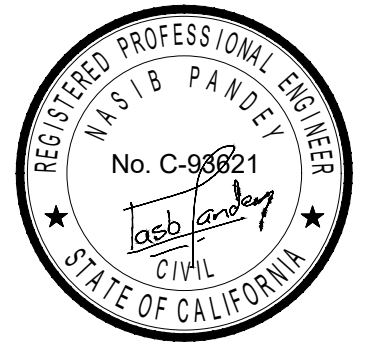

IT IS A VIOLATION OF LAW FOR ANY PERSON, UNLESS THEY ARE ACTING UNDER THE DIRECTION OF A LICENSED PROFESSIONAL ENGINEER, TO ALTER THIS DOCUMENT.

DRAWN BY: CHECKED BY: APPROVED BY:

JG/WM --- ---

RFDS REV #: 02/02/2022 REV 4

CONSTRUCTION DOCUMENTS

SUBMITTALS		
REV	DATE	DESCRIPTION
A	02/10/2022	90% CD'S ISSUED FOR REVIEW
B	04/19/2022	100% CONSTRUCTION DRAWINGS
C	06/11/2022	PLAN CHECK COMMENTS


A&E PROJECT NUMBER
SFSF001158A

DISH Wireless L.L.C.
PROJECT INFORMATION
SFSF001158A
1300 COMMERCE ST
PETALUMA, CA 94954


SHEET TITLE
ENLARGED BUILDING
PLAN

SHEET NUMBER

A-2

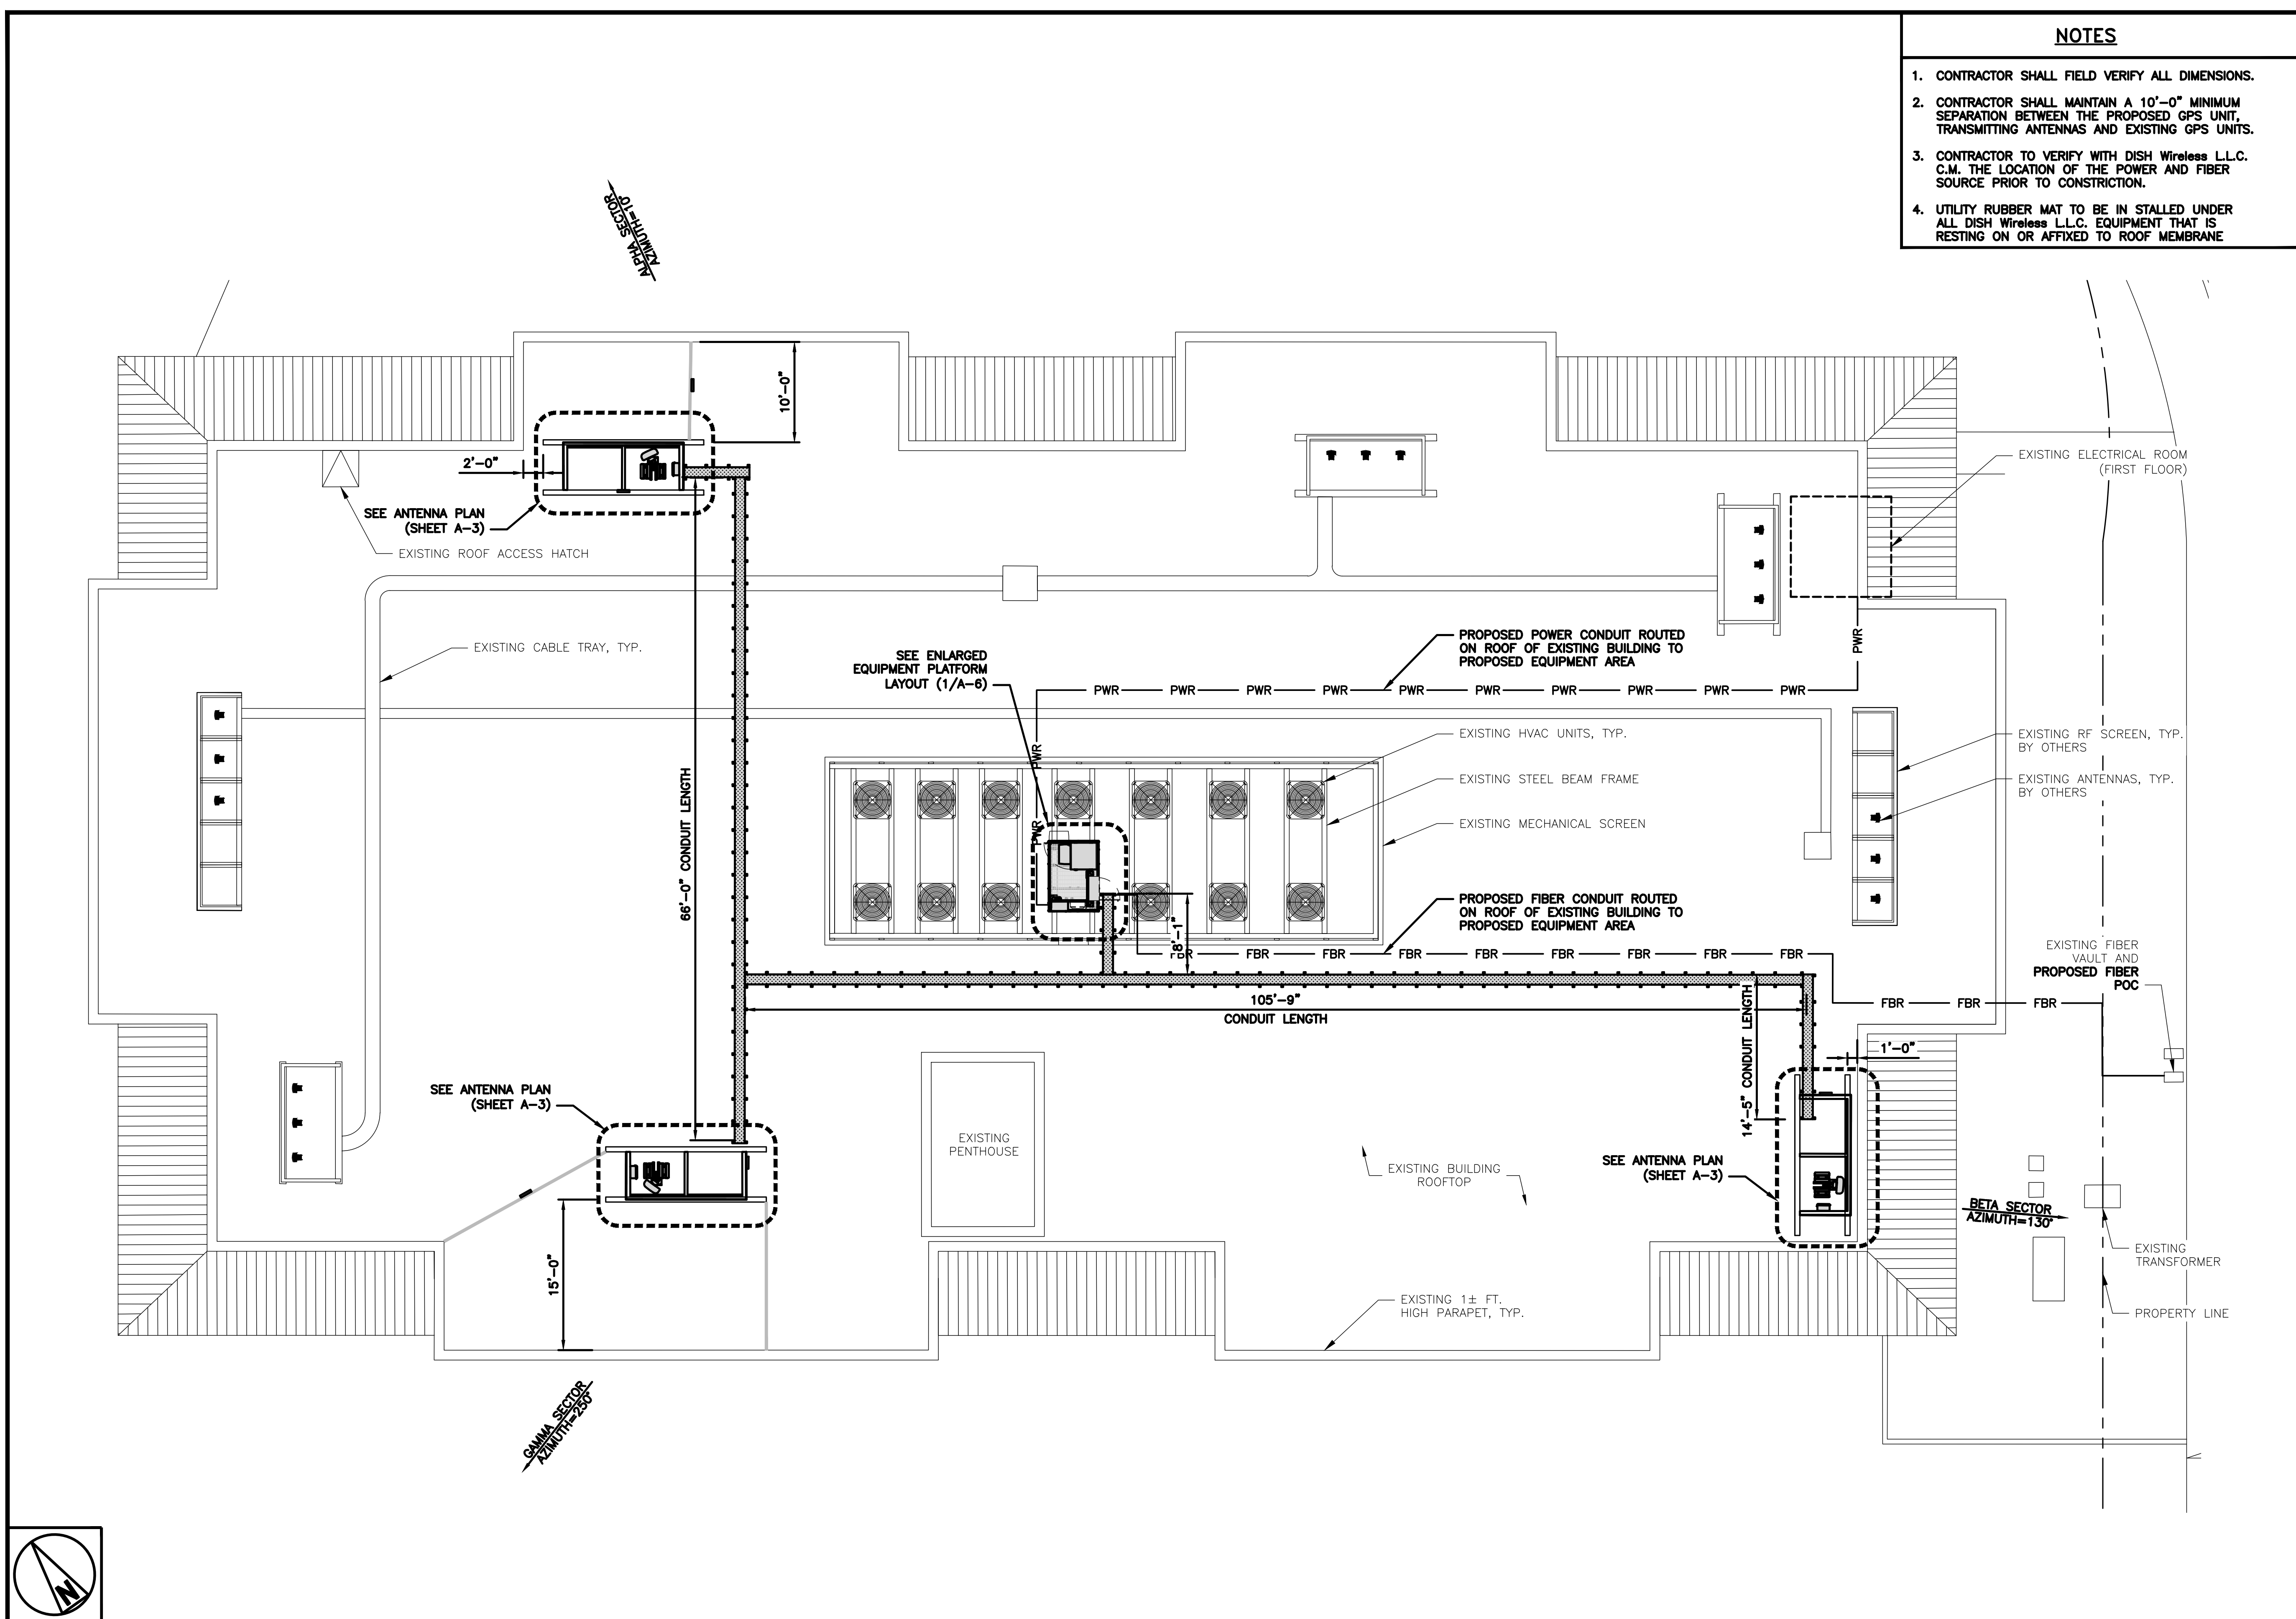


ENLARGED BUILDING PLAN

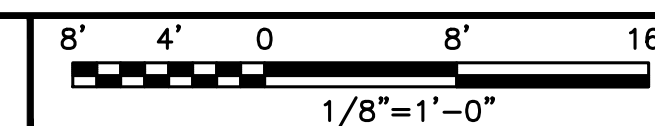


NOTES

1. CONTRACTOR SHALL FIELD VERIFY ALL DIMENSIONS.
2. ANTENNA SPECIFICATIONS REFER TO ANTENNA SCHEDULE AND TO FINAL CONSTRUCTION RFDS FOR ALL RF DETAILS
3. RF SCREEN TO BE PAINTED SHERWIN WILLIAMS SW2060 CASA BLANCA OR APPROVED EQUIVALENT

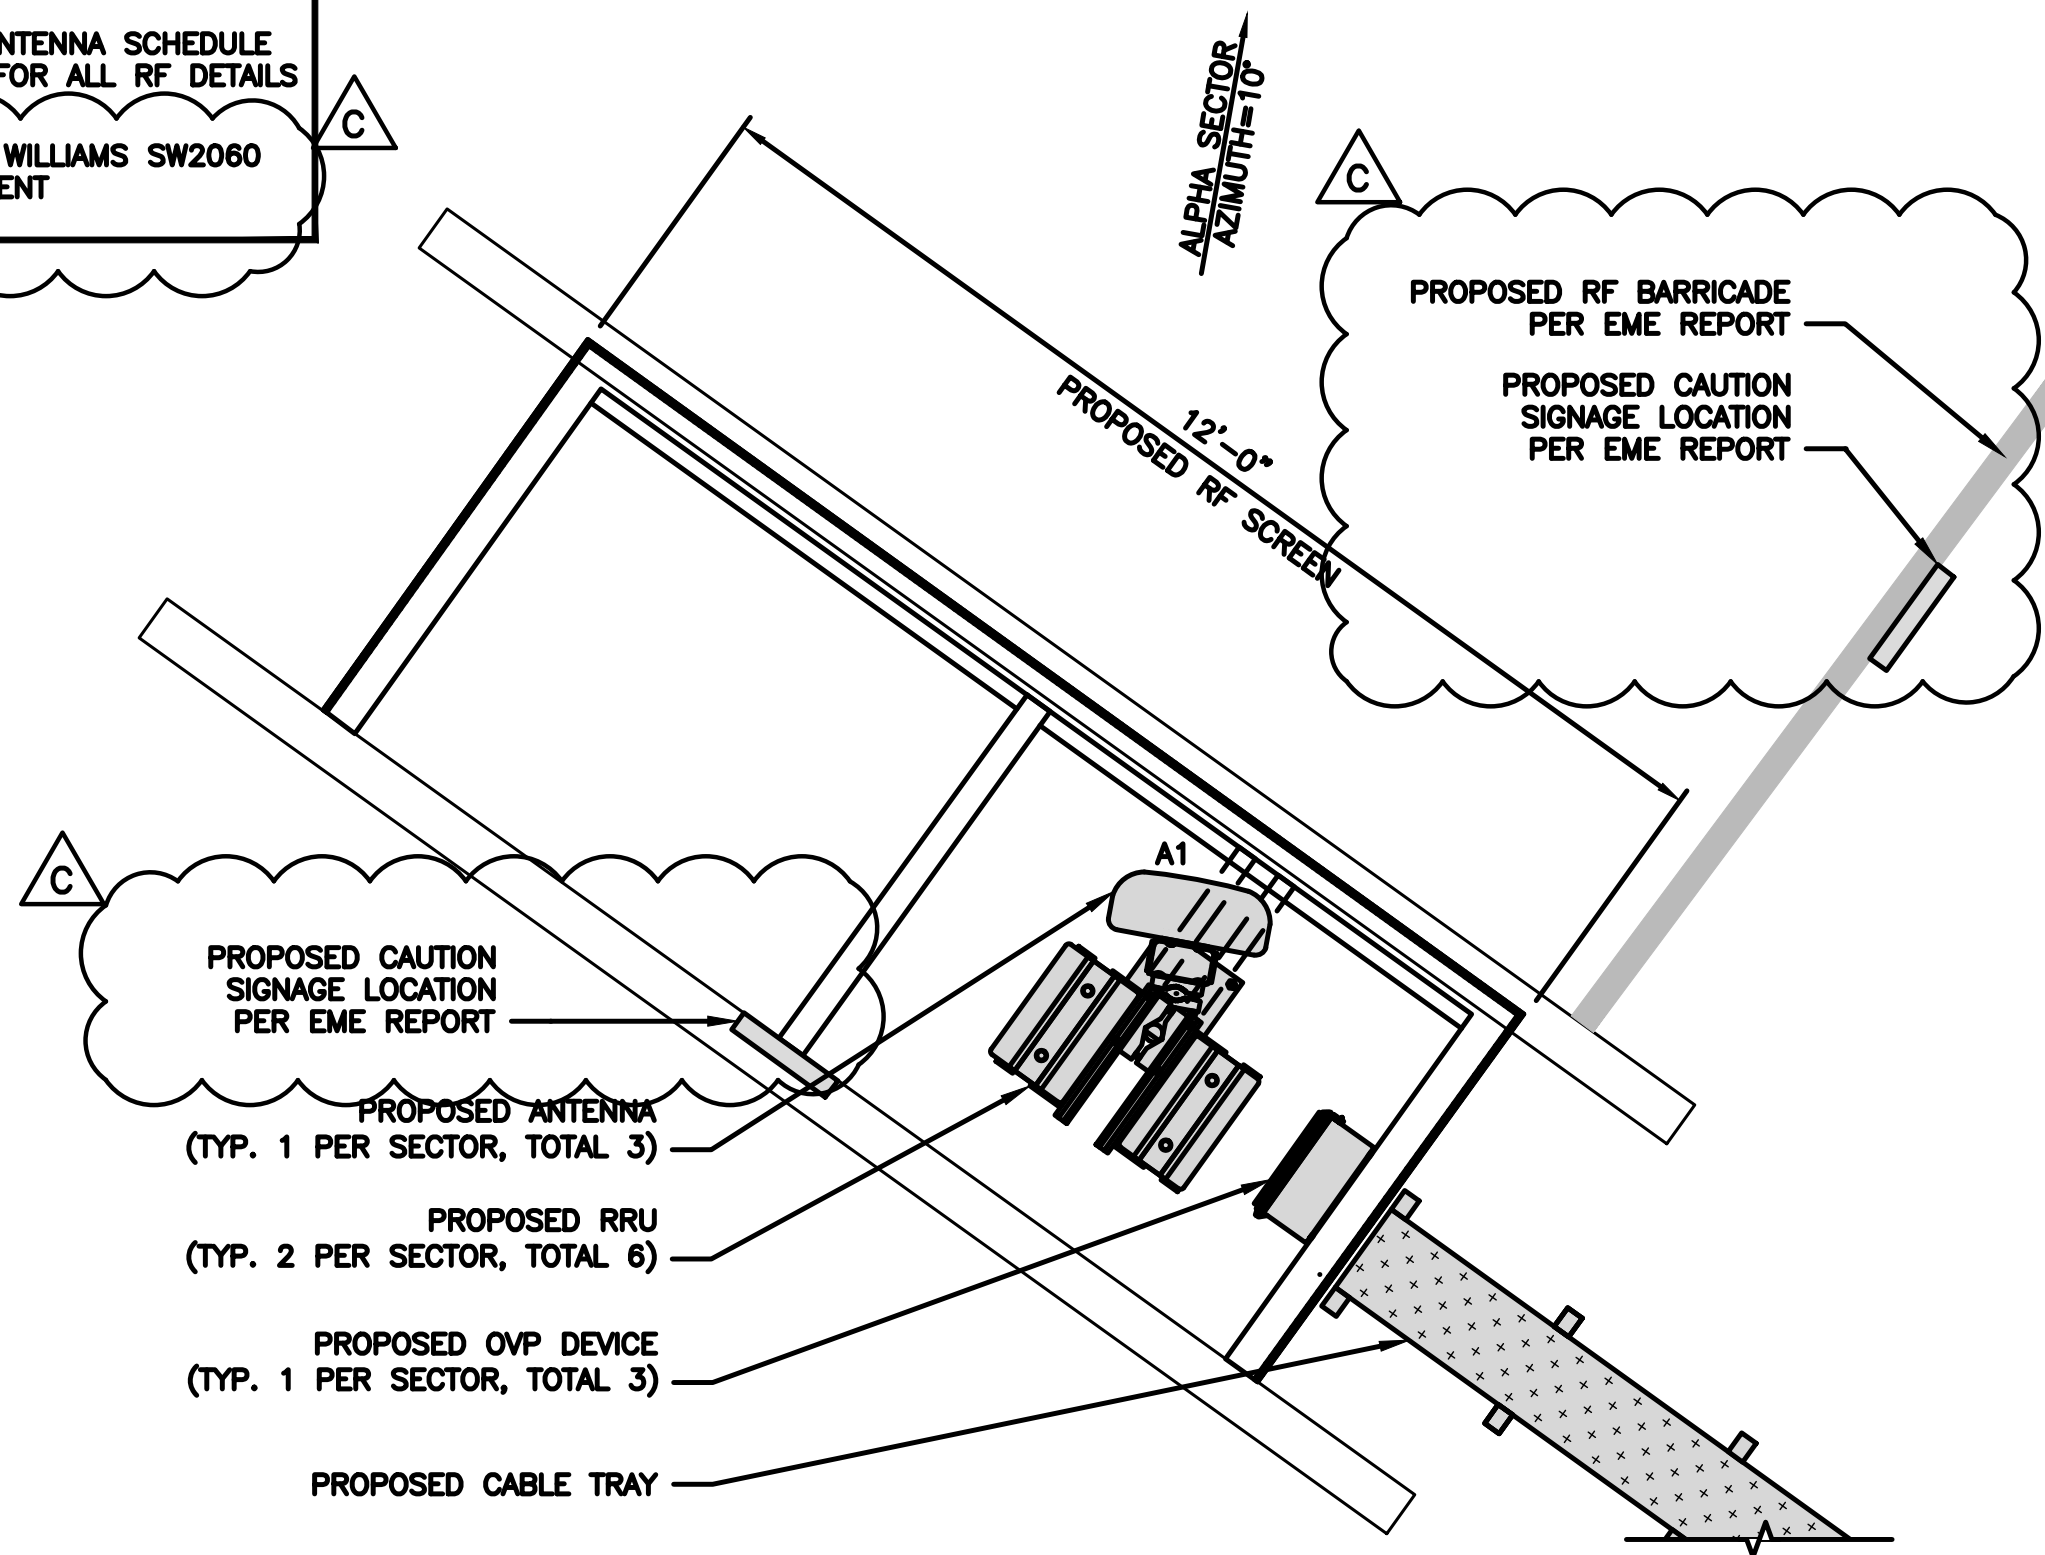


ANTENNA PLAN – ALPHA SECTOR

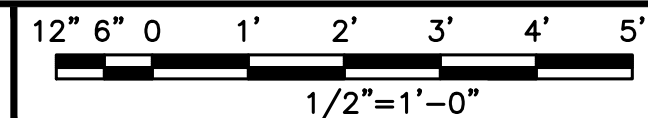


1


- PROPOSED ANTENNA (TYP. 1 PER SECTOR, TOTAL 3)
- PROPOSED RRU (TYP. 2 PER SECTOR, TOTAL 6)
- PROPOSED OVP DEVICE (TYP. 1 PER SECTOR, TOTAL 3)
- PROPOSED RF SCREEN (TYP. 1 PER SECTOR, TOTAL 3)

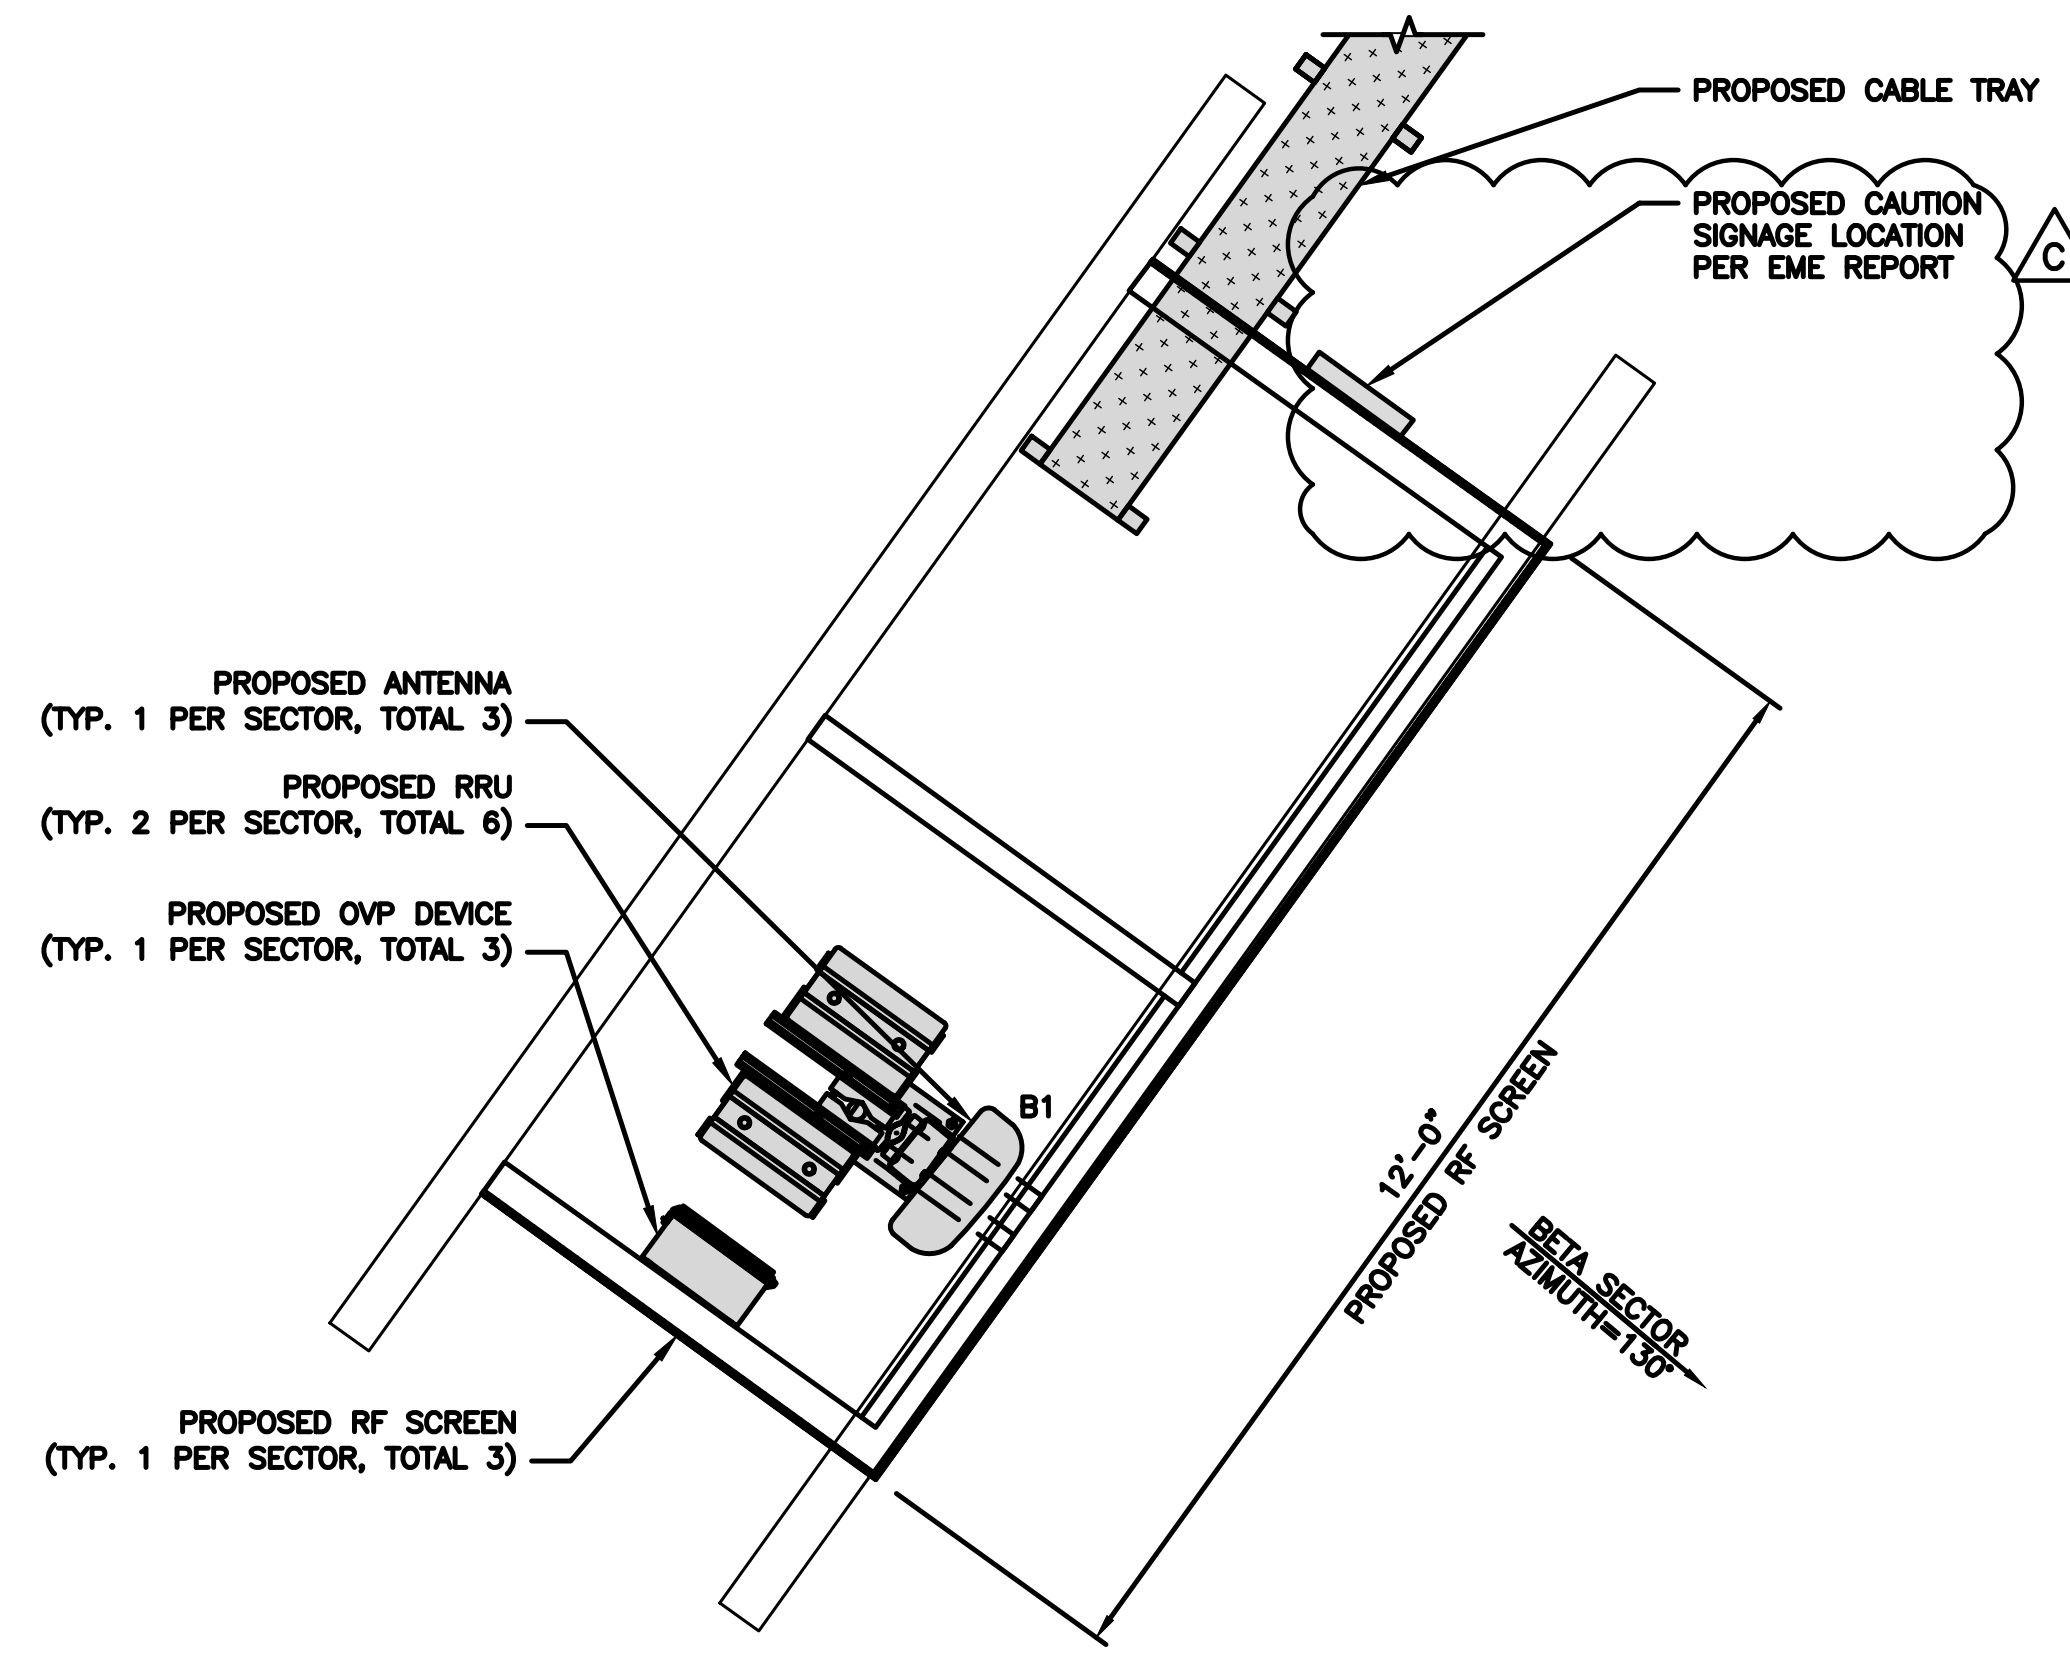


ANTENNA PLAN – BETA SECTOR

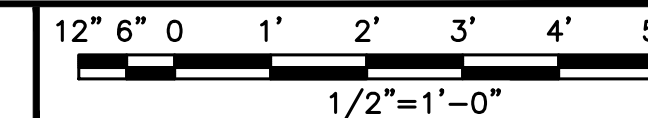

2

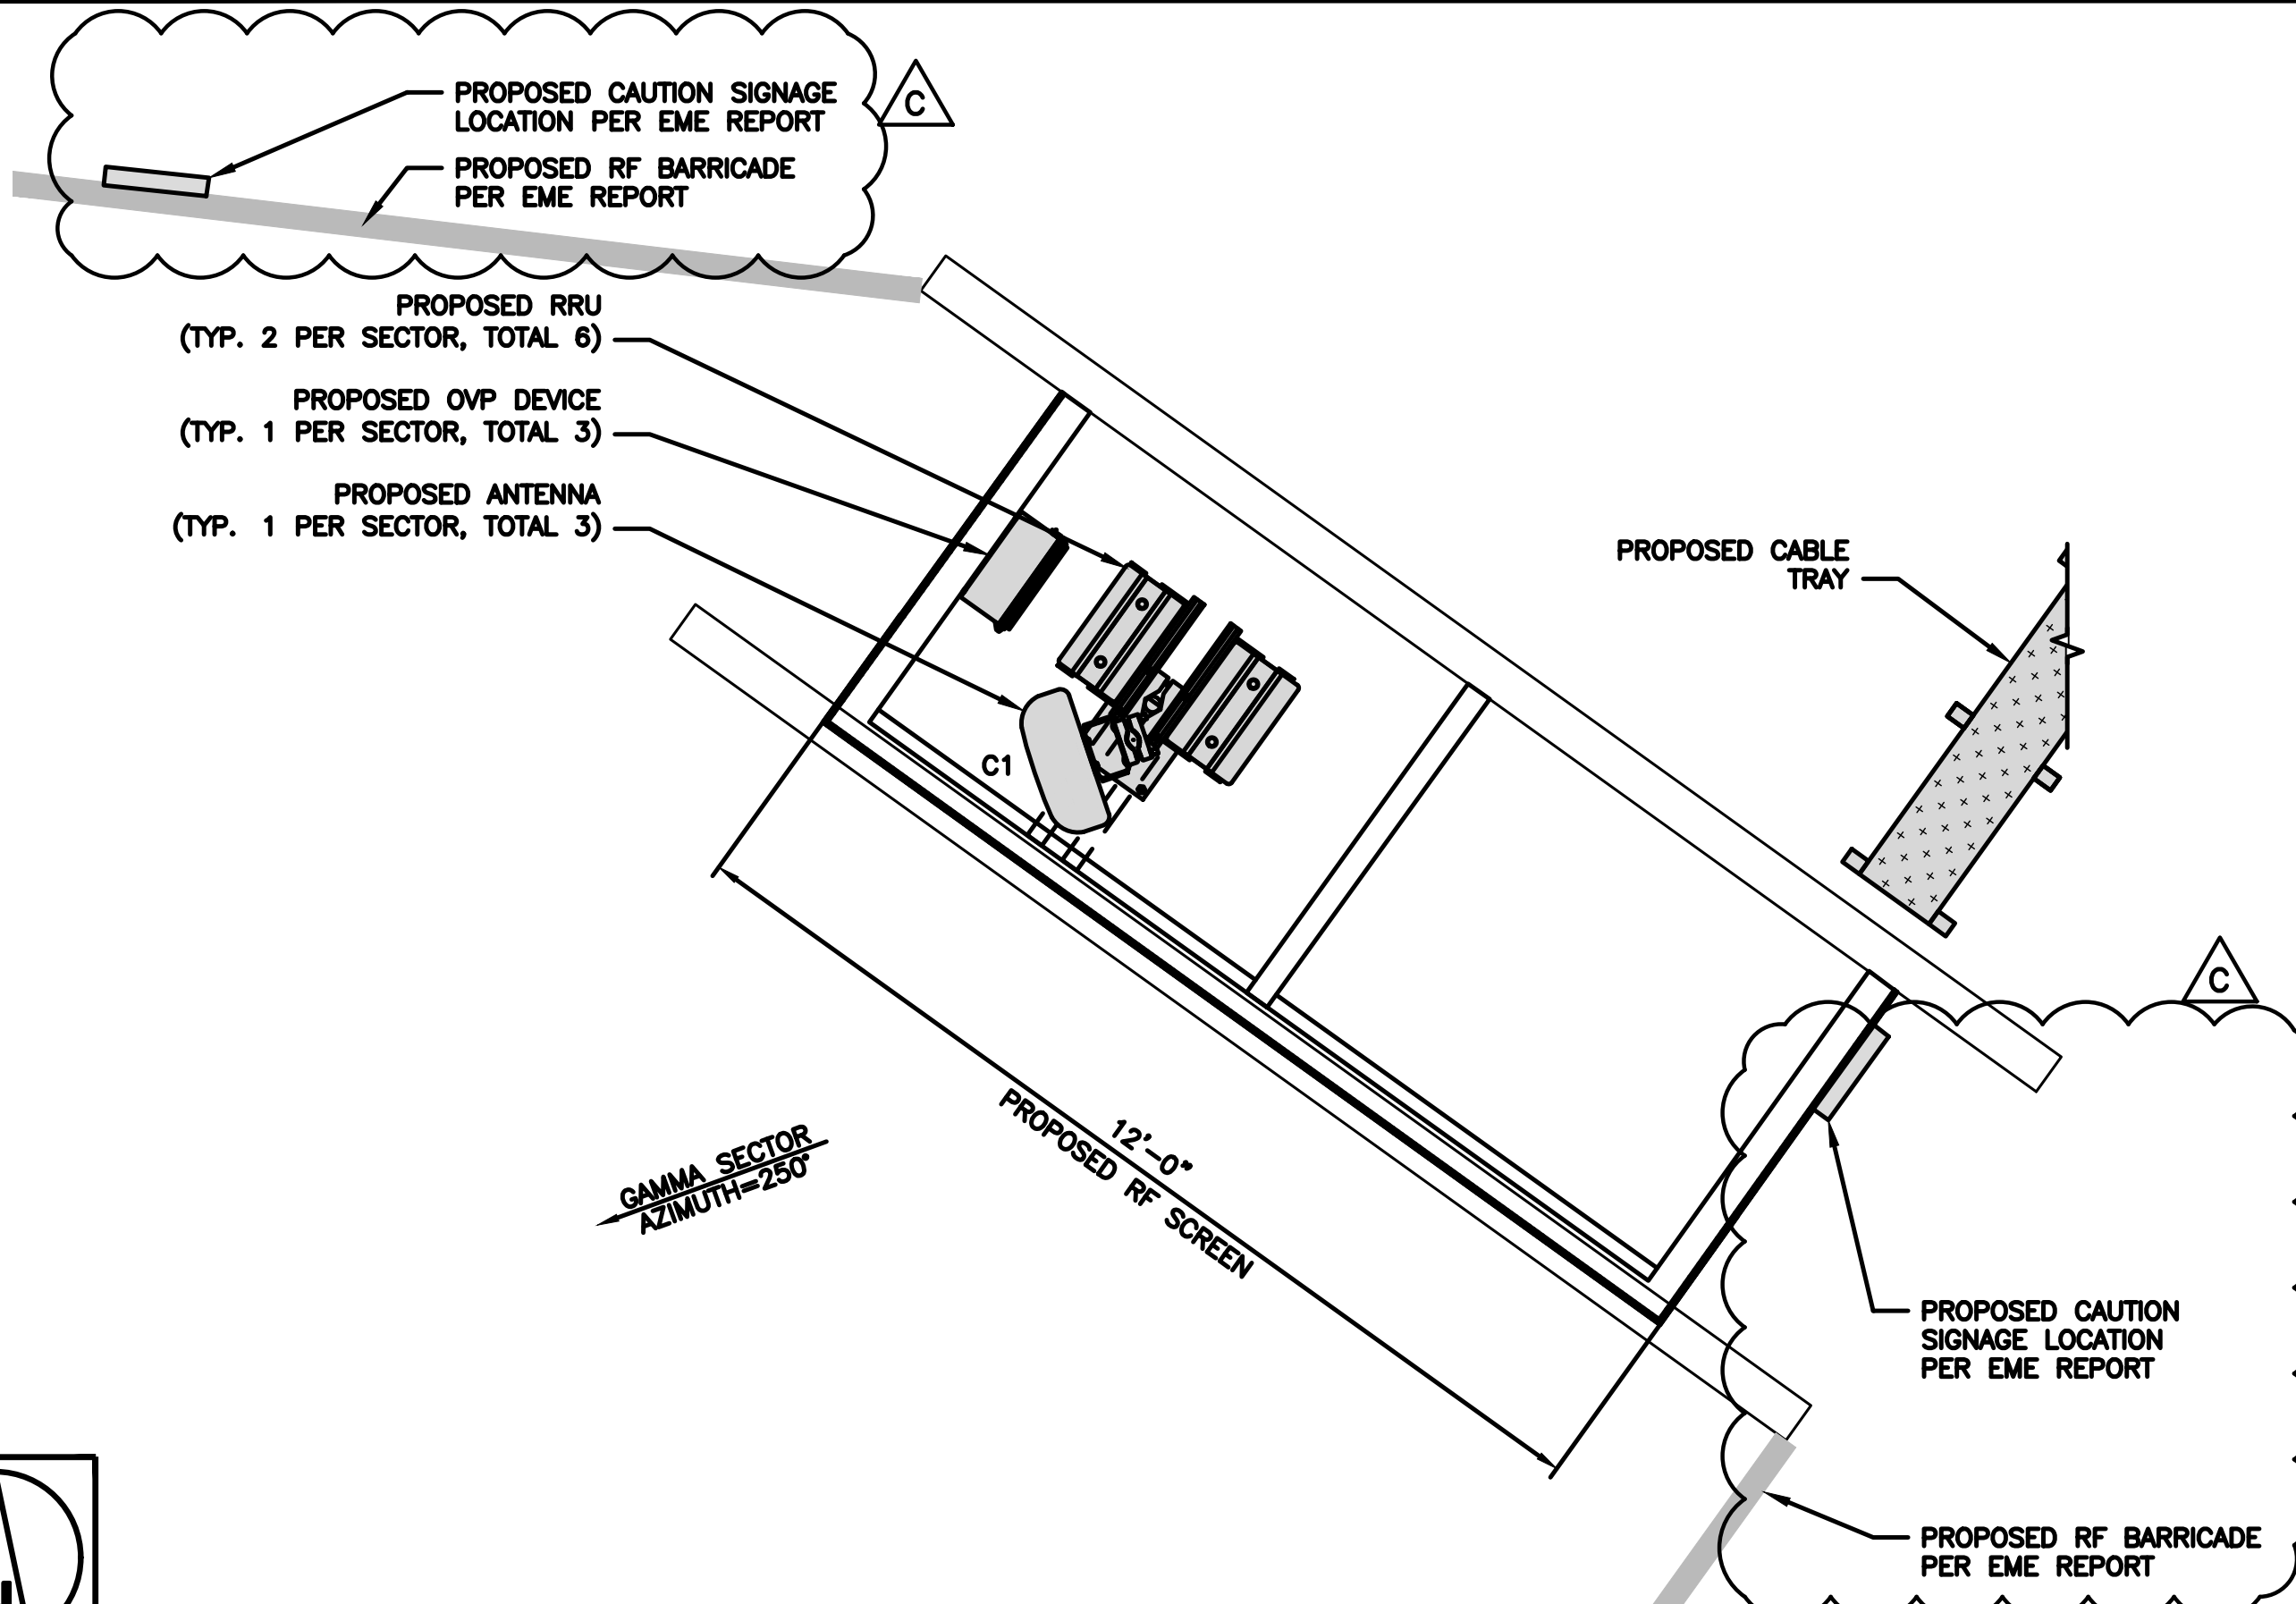

ANTENNA PLAN – GAMMA SECTOR

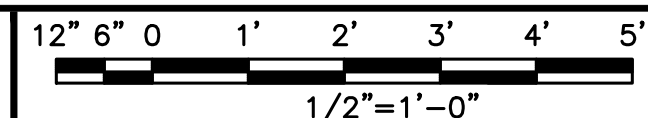

3

SECTOR	POSITION	ANTENNA						TRANSMISSION CABLE
		EXISTING OR PROPOSED	MANUFACTURER – MODEL NUMBER	TECHNOLOGY	SIZE (HxWxD)	AZIMUTH	RAD CENTER	FEED LINE TYPE AND LENGTH
ALPHA	A1	PROPOSED	CELLMAX – CX12044x	5G	72.4"x26.7"x7.7"	10°	42°-0"	(1) POWER AND FIBER TRUNK (105'± LONG)
BETA	B1	PROPOSED	CELLMAX – CX12044x	5G	72.4"x26.7"x7.7"	130°	42°-0"	(1) POWER AND FIBER TRUNK (100'± LONG)
GAMMA	C1	PROPOSED	CELLMAX – CX12044x	5G	72.4"x26.7"x7.7"	250°	42°-0"	(1) POWER AND FIBER TRUNK (75'± LONG)

SECTOR	POSITION	RRH			NOTES
		MANUFACTURER – MODEL NUMBER	TECHNOLOGY	SIZE (HxWxD)	
ALPHA	A1	MTI – G060708-50-02	n71	16.93"x13.89"x11.1"	1. CONTRACTOR TO REFER TO FINAL CONSTRUCTION RFDS FOR ALL RF DETAILS. 2. ANTENNA AND RRH MODELS MAY CHANGE DUE TO EQUIPMENT AVAILABILITY. ALL EQUIPMENT CHANGES MUST BE APPROVED AND REMAIN IN COMPLIANCE WITH THE PROPOSED DESIGN AND STRUCTURAL ANALYSES.
		MTI – G2021-49-02B	n70 n66	16.93"x13.89"x9.84"	
BETA	B1	MTI – G060708-50-02	n71	16.93"x13.89"x11.1"	
		MTI – G2021-49-02B	n70 n66	16.93"x13.89"x9.84"	
GAMMA	C1	MTI – G060708-50-02	n71	16.93"x13.89"x11.1"	
		MTI – G2021-49-02B	n70 n66	16.93"x13.89"x9.84"	

ANTENNA SCHEDULE

NO SCALE


4



5701 SOUTH SANTA FE DRIVE
LITTLETON, CO 80120



2840 HOWE ROAD, SUITE E
MARTINEZ, CA 94553
www.TheCBRGroup.com

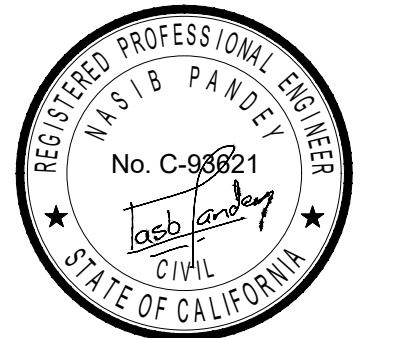

IT IS A VIOLATION OF LAW FOR ANY PERSON, UNLESS THEY ARE ACTING UNDER THE DIRECTION OF A LICENSED PROFESSIONAL ENGINEER, TO ALTER THIS DOCUMENT.

DRAWN BY: CHECKED BY: APPROVED BY:
JG/WM --- ---

RFDS REV #: 02/02/2022 REV 4

CONSTRUCTION DOCUMENTS

SUBMITTALS		
REV	DATE	DESCRIPTION
A	02/10/2022	90% CD'S ISSUED FOR REVIEW
B	04/19/2022	100% CONSTRUCTION DRAWINGS
C	06/11/2022	PLAN CHECK COMMENTS

A&E PROJECT NUMBER
SFSF001158A

DISH Wireless L.L.C.
PROJECT INFORMATION

SFSF001158A
1300 COMMERCE ST
PETALUMA, CA 94954

SHEET TITLE
ANTENNA PLAN,
RRU PLAN AND SCHEDULE

SHEET NUMBER

A-3

NOTES


1. CONTRACTOR SHALL FIELD VERIFY ALL DIMENSIONS.
2. CONTRACTOR SHALL MAINTAIN A 10'-0" MINIMUM SEPARATION BETWEEN THE PROPOSED GPS UNIT, TRANSMITTING ANTENNAS AND EXISTING GPS UNITS.



5701 SOUTH SANTA FE DRIVE
LITTLETON, CO 80120



2840 HOWE ROAD, SUITE E
MARTINEZ, CA 94553
www.TheCBRGroup.com

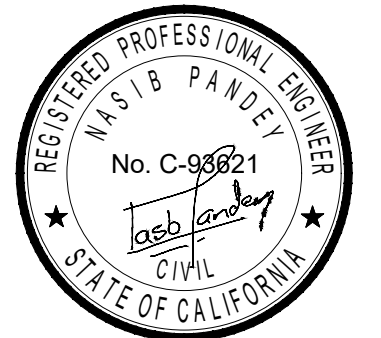

IT IS A VIOLATION OF LAW FOR ANY PERSON, UNLESS THEY ARE ACTING UNDER THE DIRECTION OF A LICENSED PROFESSIONAL ENGINEER, TO ALTER THIS DOCUMENT.

DRAWN BY: JG/WM CHECKED BY: --- APPROVED BY: ---

RFDS REV #: 02/02/2022 REV 4

CONSTRUCTION DOCUMENTS

SUBMITTALS

REV	DATE	DESCRIPTION
A	02/10/2022	90% CD'S ISSUED FOR REVIEW
B	04/19/2022	100% CONSTRUCTION DRAWINGS
C	06/11/2022	PLAN CHECK COMMENTS

A&E PROJECT NUMBER
SFSF001158A

DISH Wireless L.L.C.
PROJECT INFORMATION



SFSF001158A
1300 COMMERCE ST
PETALUMA, CA 94954

SHEET TITLE
EXISTING AND PROPOSED
SOUTHWEST ELEVATIONS

SHEET NUMBER



A-4

EXISTING SOUTHWEST ELEVATION

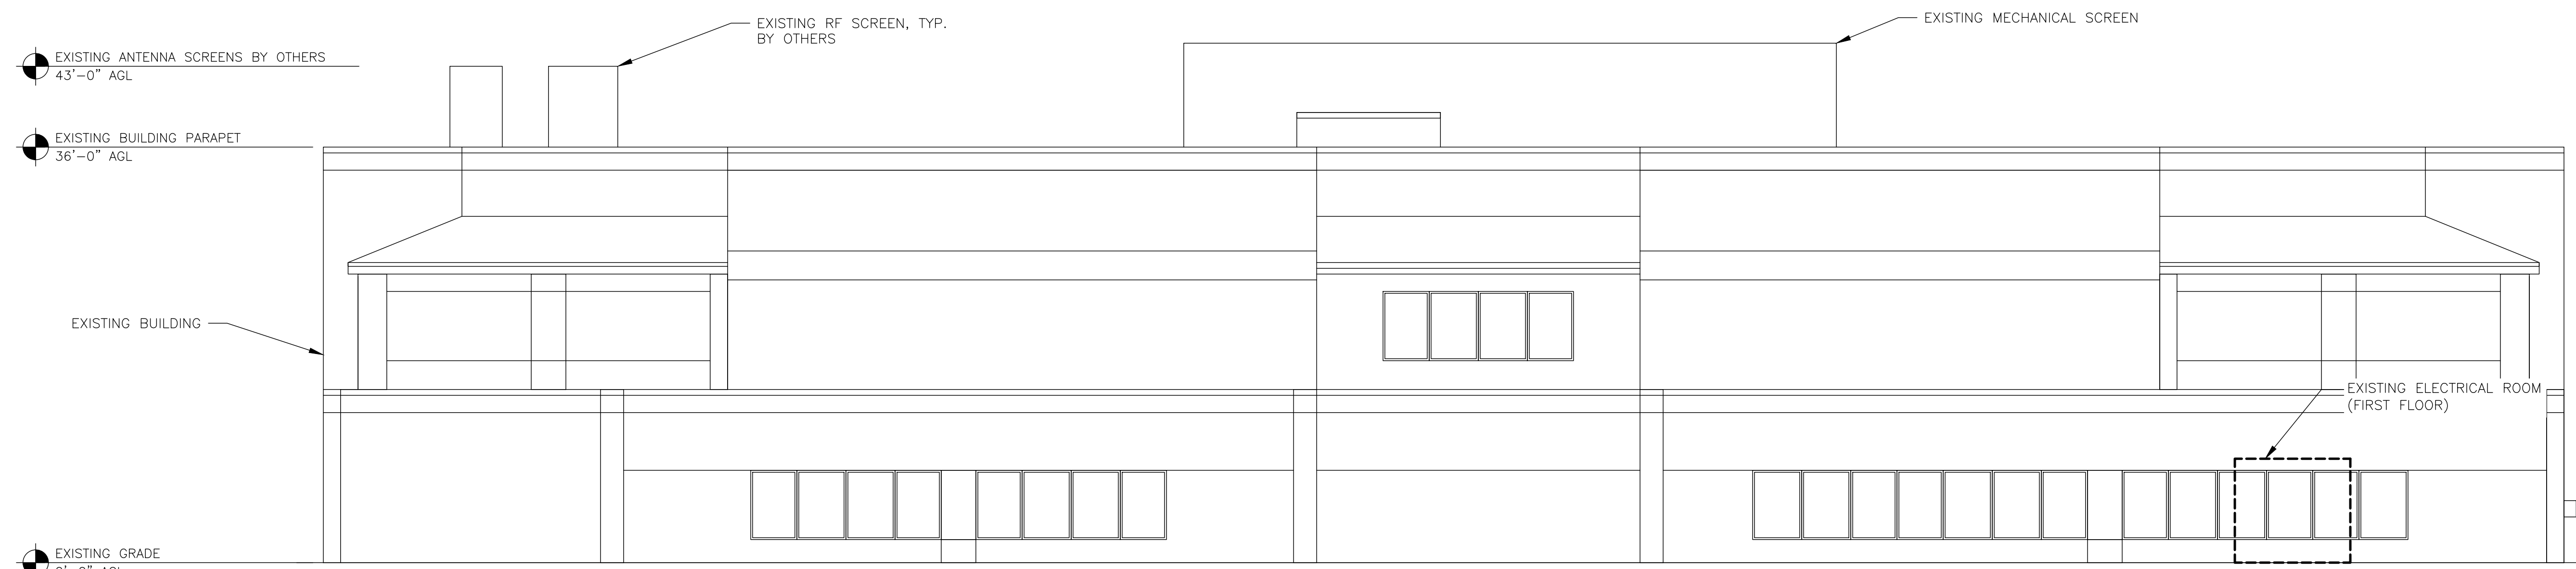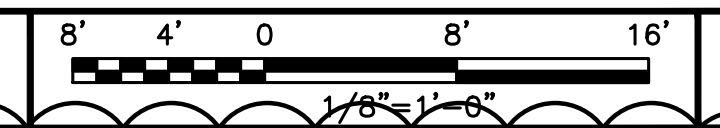

NOTES

1. CONTRACTOR SHALL FIELD VERIFY ALL DIMENSIONS.
2. CONTRACTOR SHALL MAINTAIN A 10'-0" MINIMUM SEPARATION BETWEEN THE PROPOSED GPS UNIT, TRANSMITTING ANTENNAS AND EXISTING GPS UNITS.
3. RF SCREEN TO BE PAINTED SHERWIN WILLIAMS SW2060 CASA BLANCA OR APPROVED EQUIVALENT

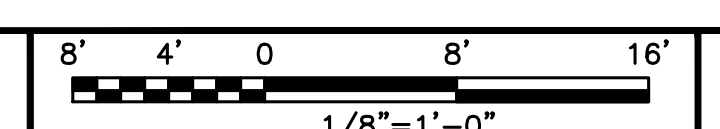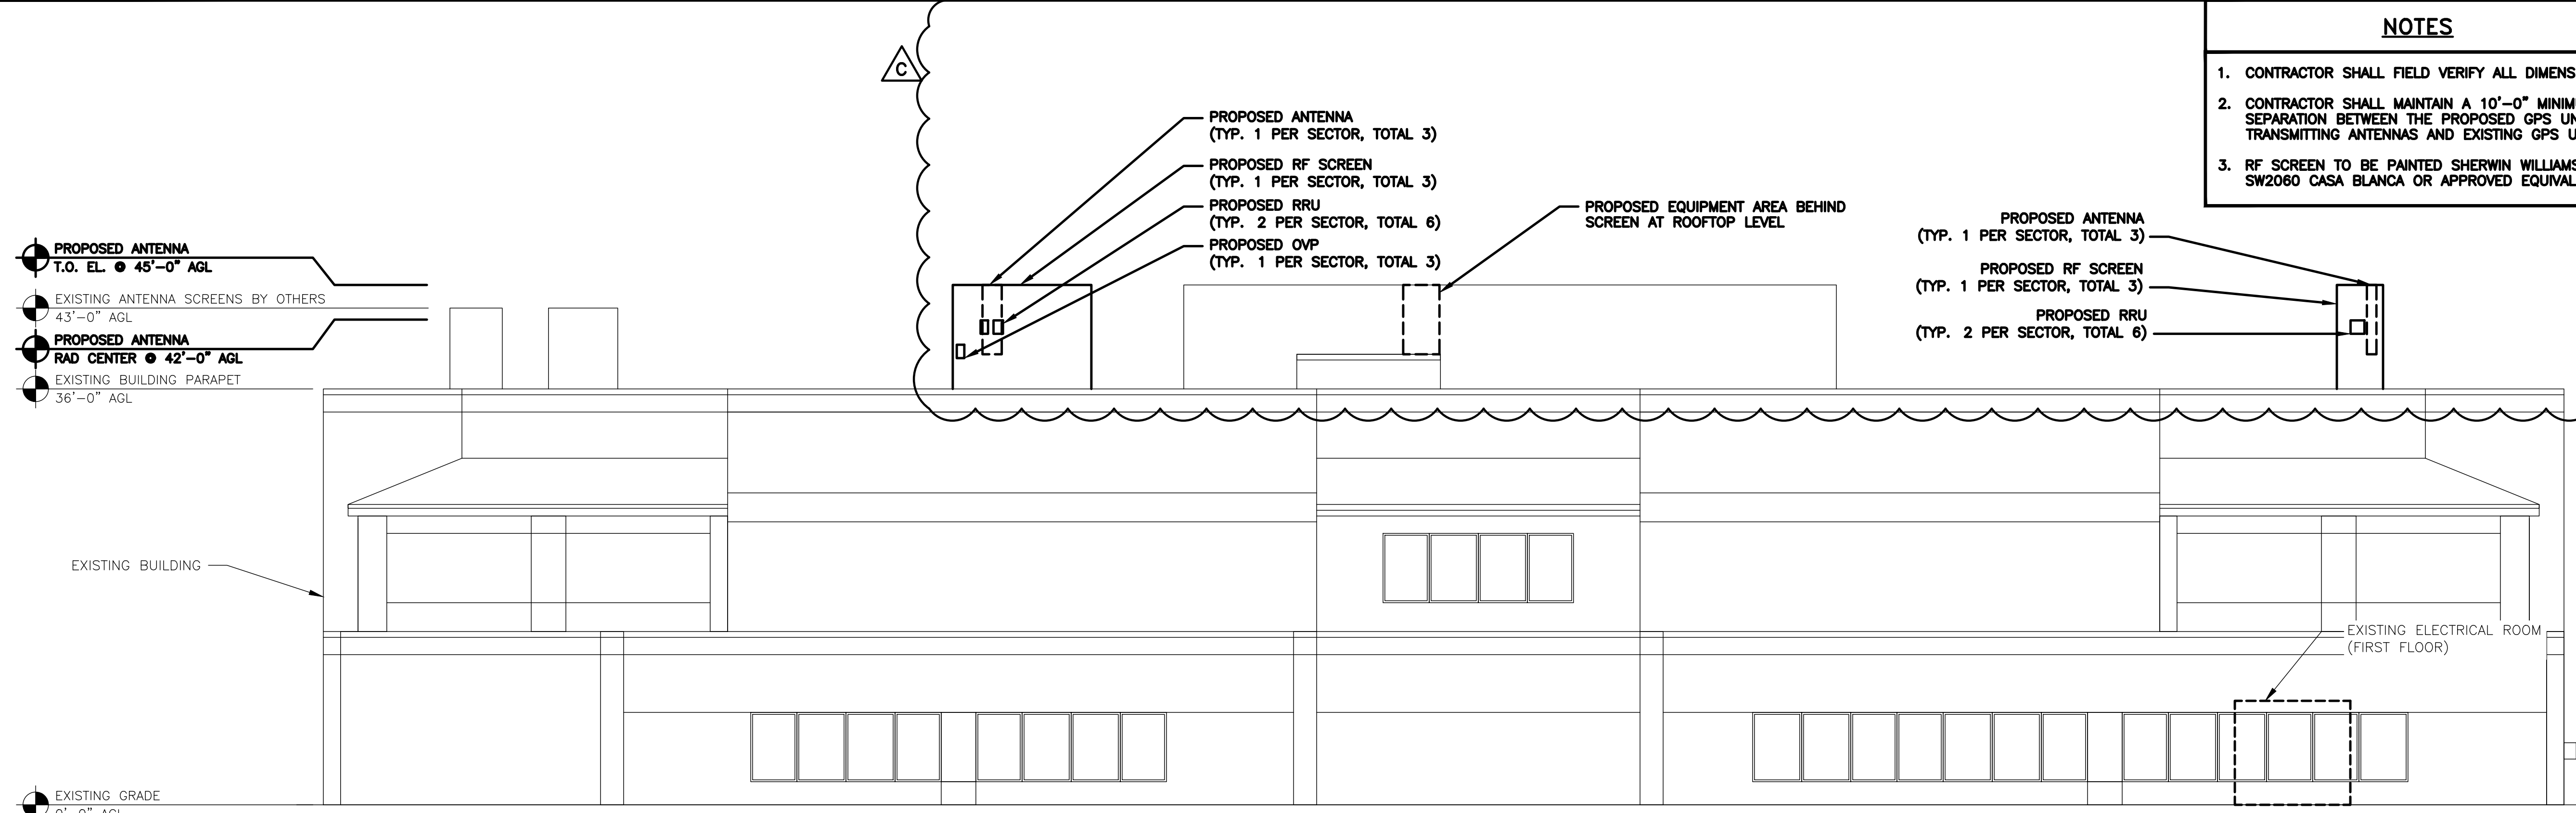

PROPOSED SOUTHWEST ELEVATION

NOTES


1. CONTRACTOR SHALL FIELD VERIFY ALL DIMENSIONS.
2. CONTRACTOR SHALL MAINTAIN A 10'-0" MINIMUM SEPARATION BETWEEN THE PROPOSED GPS UNIT, TRANSMITTING ANTENNAS AND EXISTING GPS UNITS.



5701 SOUTH SANTA FE DRIVE
LITTLETON, CO 80120



2840 HOWE ROAD, SUITE E
MARTINEZ, CA 94553
www.TheCBRGroup.com

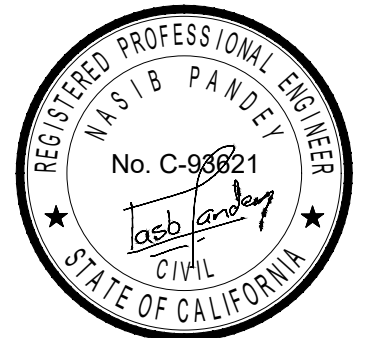


EXISTING ANTENNA SCREENS BY OTHERS
43'-0" AGL


EXISTING BUILDING PARAPET
36'-0" AGL

EXISTING GRADE
0'-0" AGL

EXISTING BUILDING

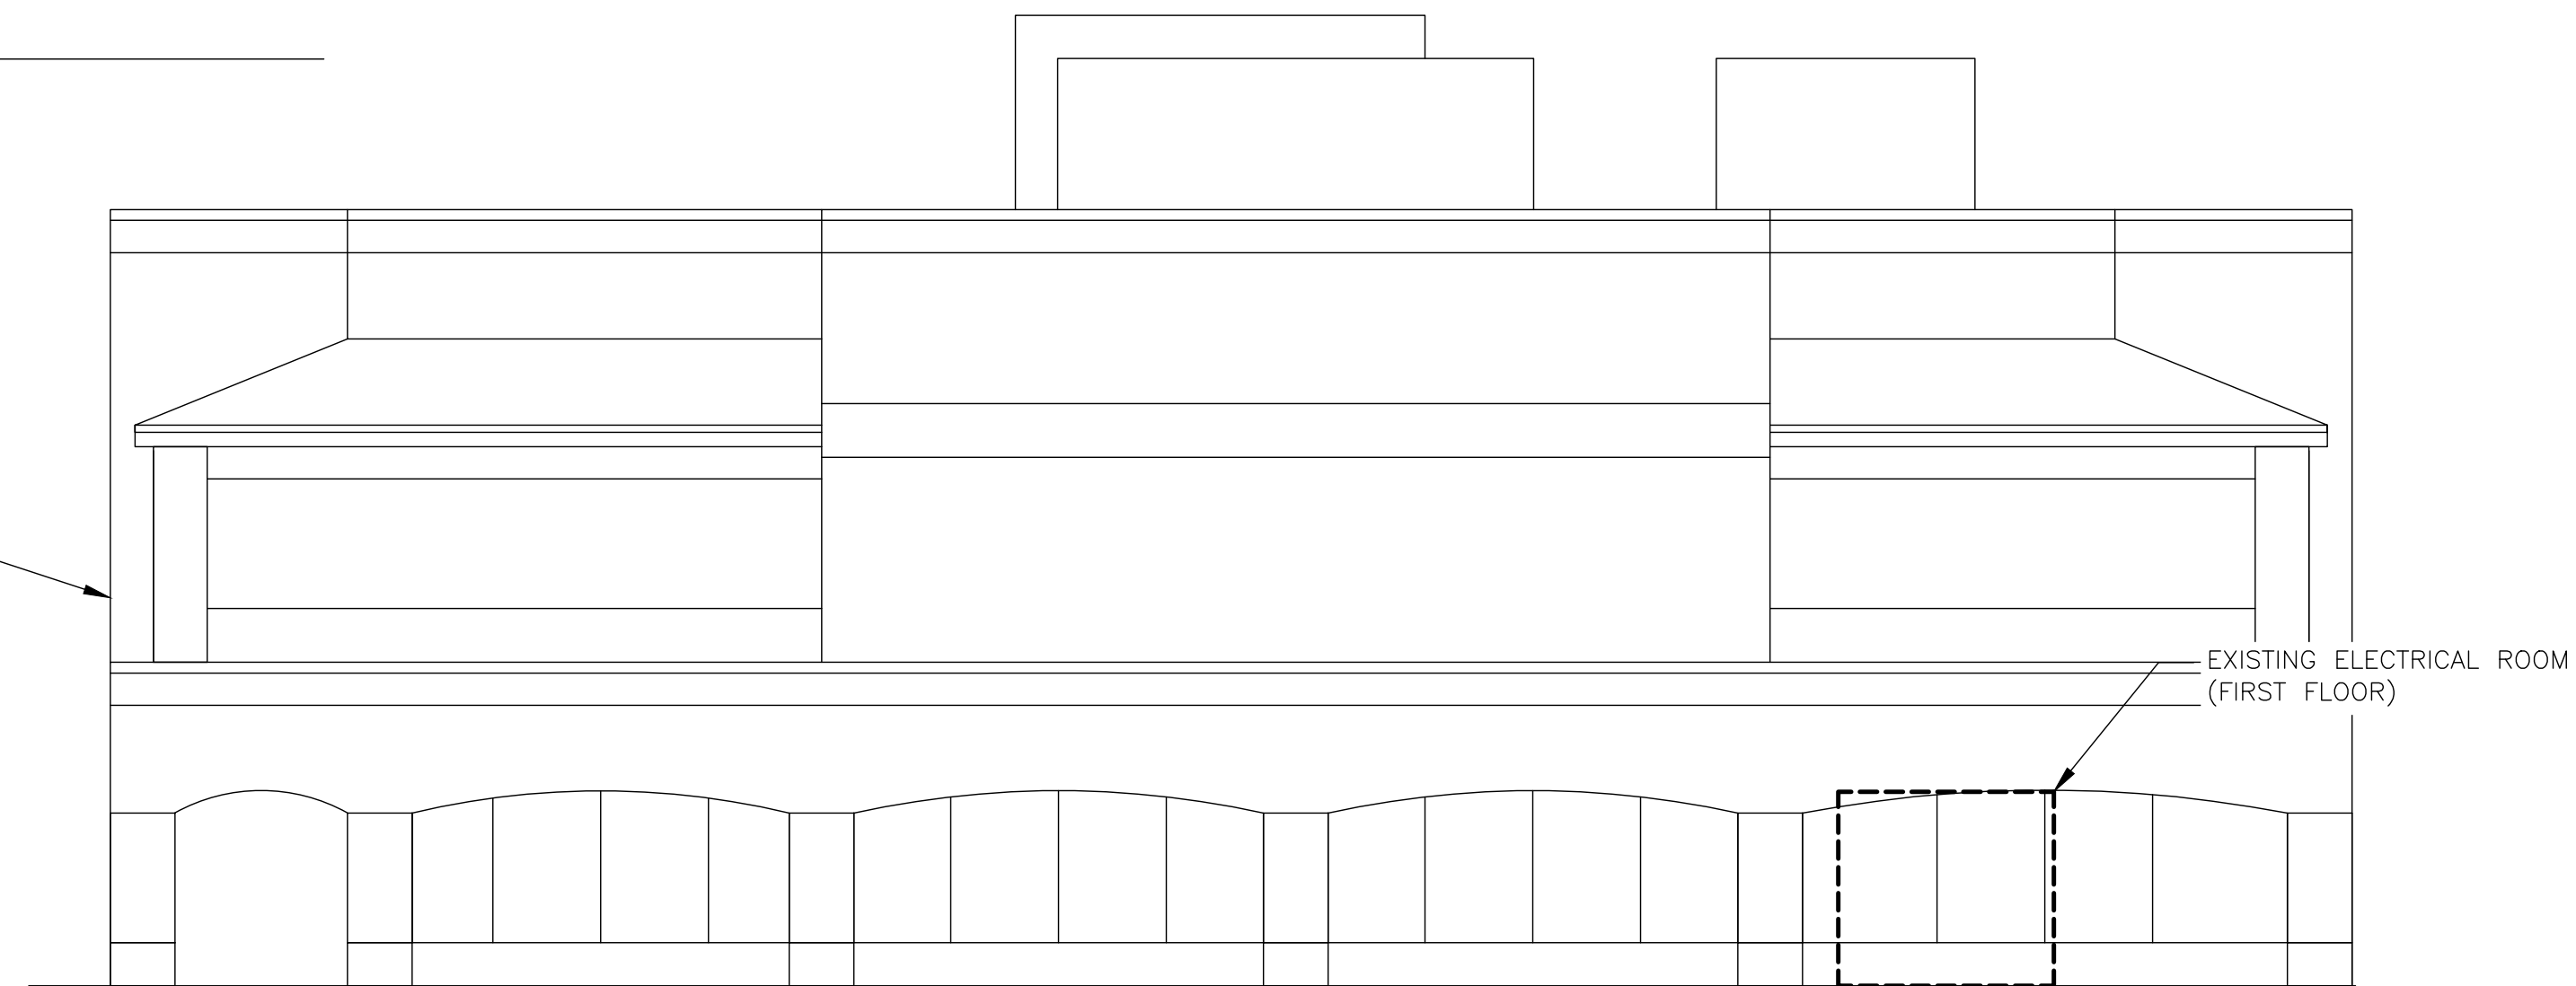

EXISTING SOUTHEAST ELEVATION

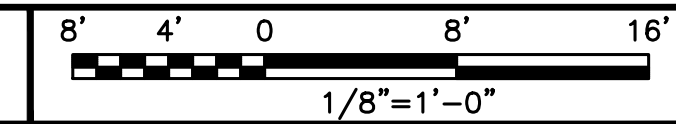

1

NOTES

1. CONTRACTOR SHALL FIELD VERIFY ALL DIMENSIONS.
2. CONTRACTOR SHALL MAINTAIN A 10'-0" MINIMUM SEPARATION BETWEEN THE PROPOSED GPS UNIT, TRANSMITTING ANTENNAS AND EXISTING GPS UNITS.
3. RF SCREEN TO BE PAINTED SHERWIN WILLIAMS SW2060 CASA BLANCA OR APPROVED EQUIVALENT

IT IS A VIOLATION OF LAW FOR ANY PERSON, UNLESS THEY ARE ACTING UNDER THE DIRECTION OF A LICENSED PROFESSIONAL ENGINEER, TO ALTER THIS DOCUMENT.

DRAWN BY: CHECKED BY: APPROVED BY:

JG/WM --- ---

RFDS REV #: 02/02/2022 REV 4

CONSTRUCTION DOCUMENTS

SUBMITTALS

REV	DATE	DESCRIPTION
A	02/10/2022	90% CD'S ISSUED FOR REVIEW
B	04/19/2022	100% CONSTRUCTION DRAWINGS
C	06/11/2022	PLAN CHECK COMMENTS

A&E PROJECT NUMBER
SFSF001158A

DISH Wireless L.L.C.
PROJECT INFORMATION

SFSF001158A
1300 COMMERCE ST
PETALUMA, CA 94954

SHEET TITLE
EXISTING AND PROPOSED
SOUTHEAST ELEVATIONS

SHEET NUMBER

A-5

PROPOSED ANTENNA
T.O. EL. @ 45'-0" AGL


EXISTING ANTENNA SCREENS BY OTHERS
43'-0" AGL

PROPOSED ANTENNA
RAD CENTER @ 42'-0" AGL


EXISTING BUILDING PARAPET
36'-0" AGL

EXISTING GRADE
0'-0" AGL


EXISTING BUILDING

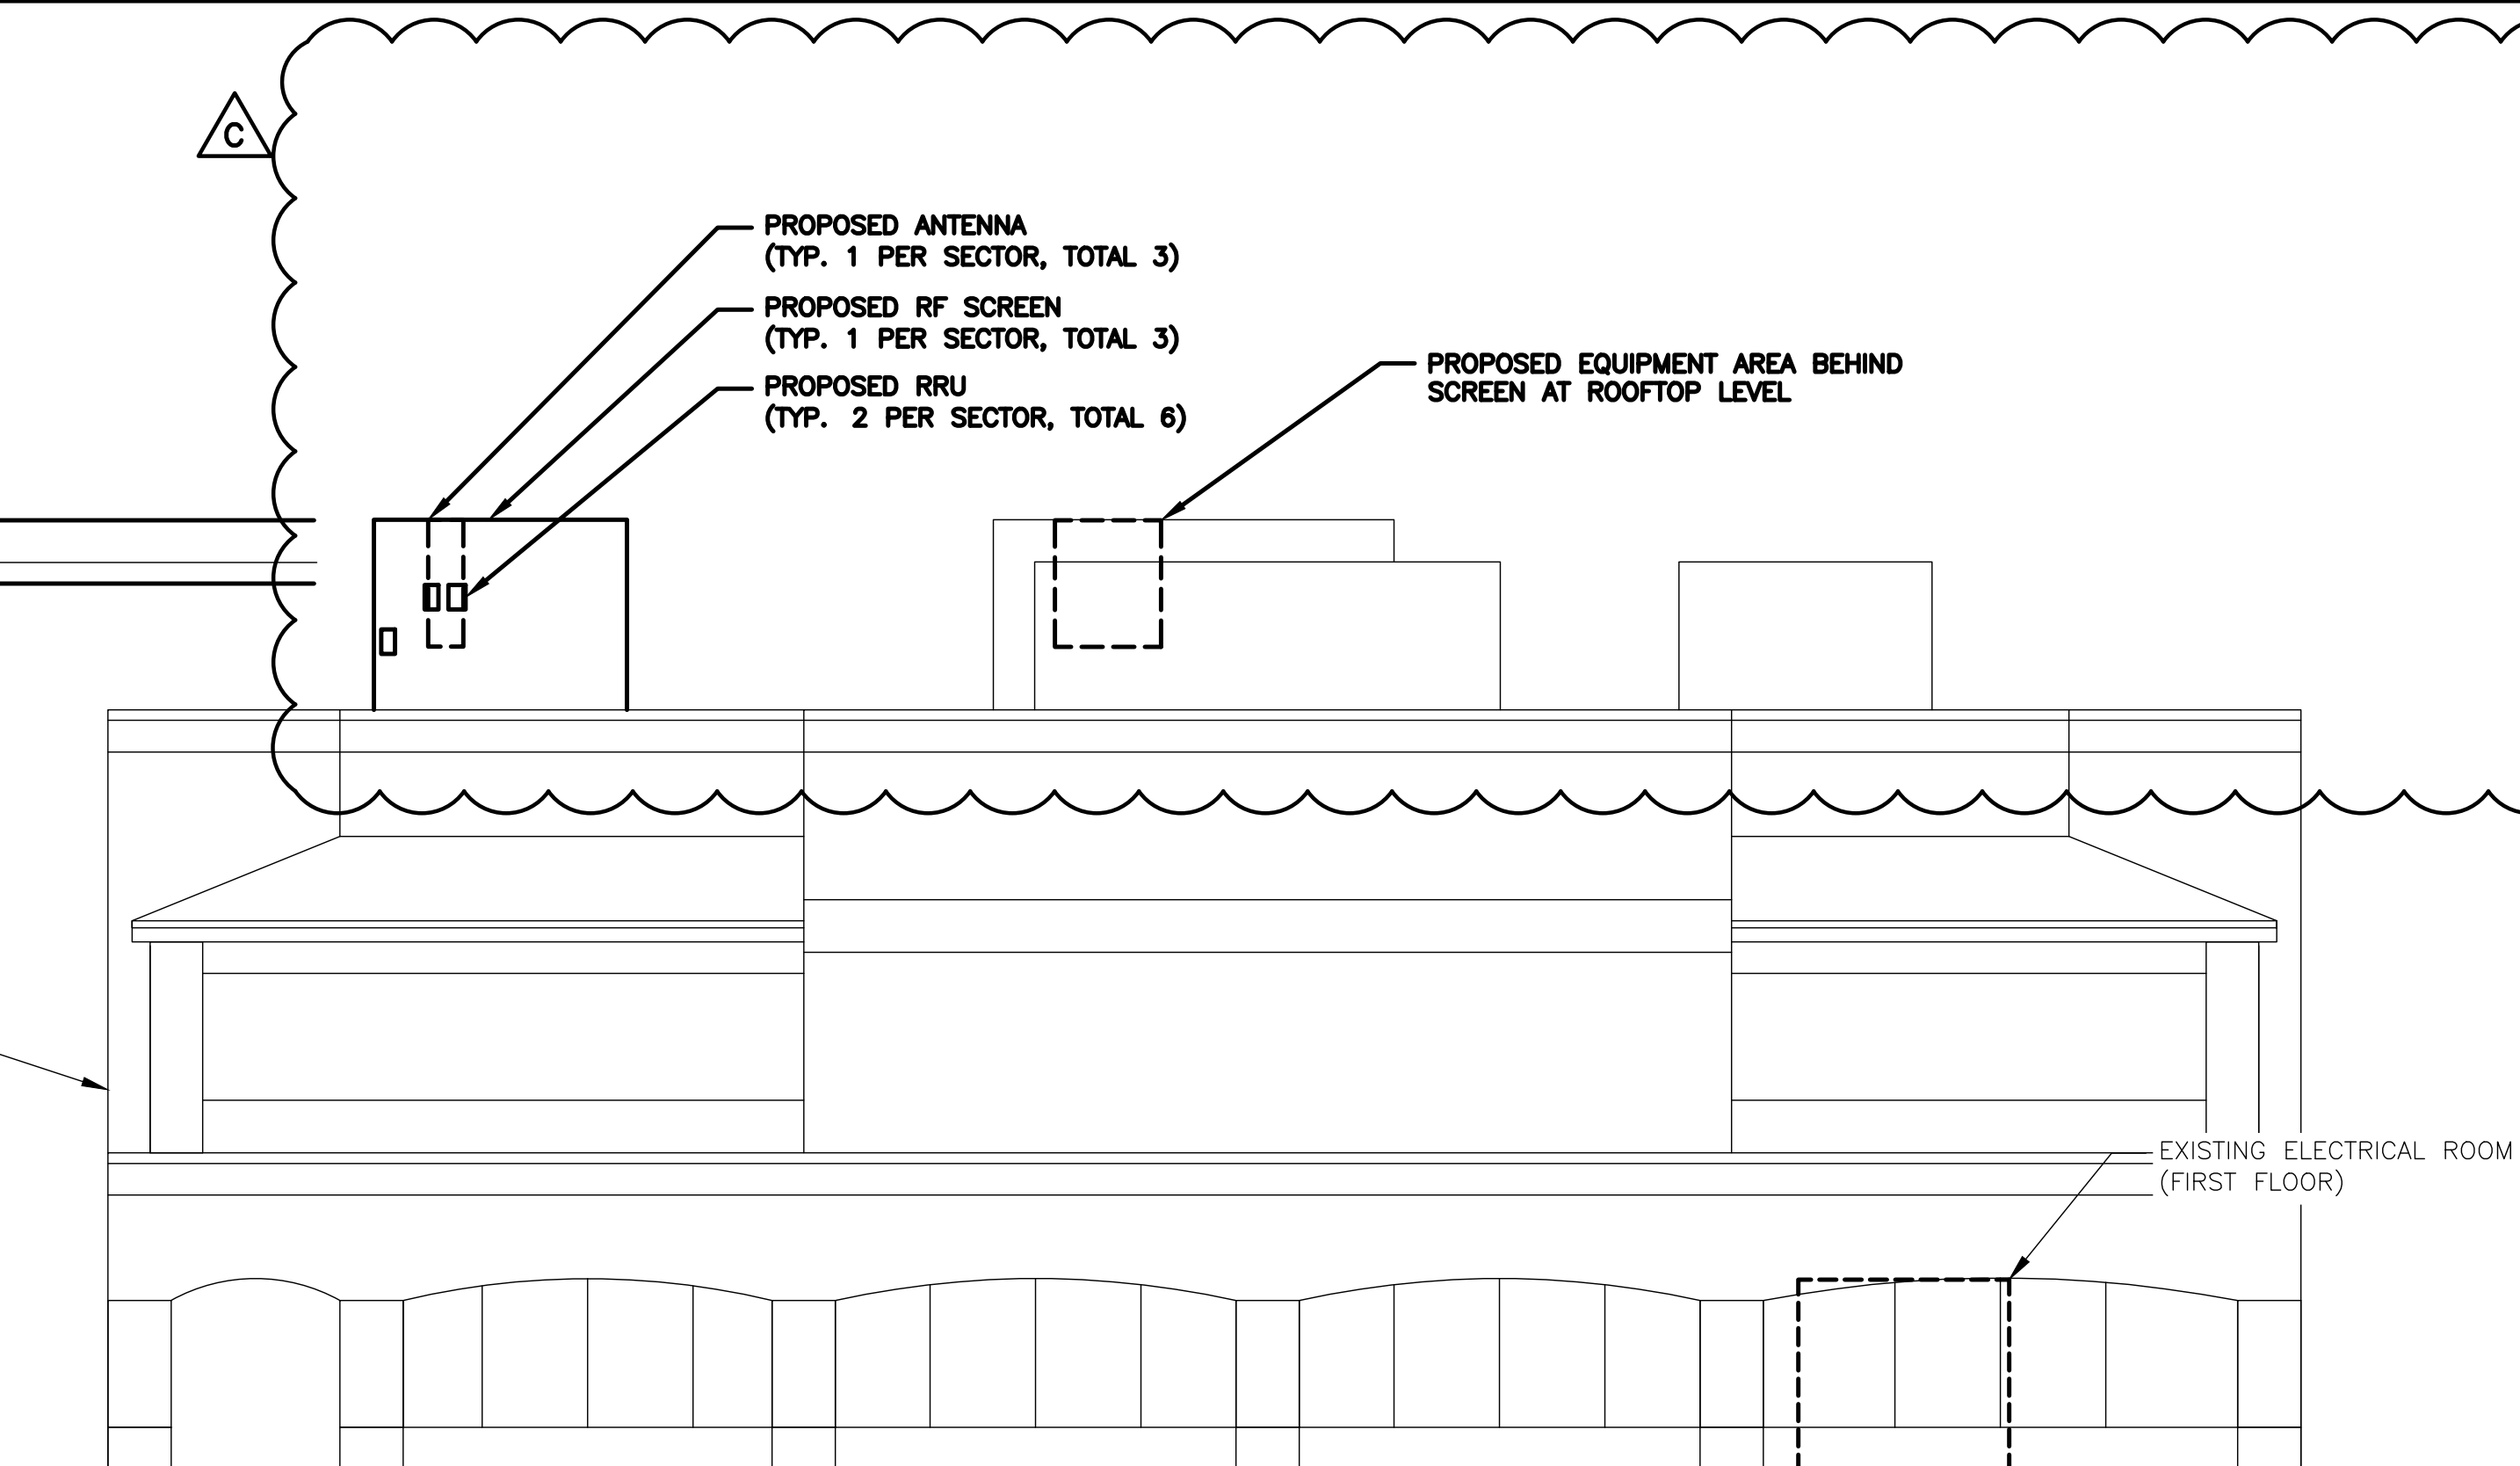


PROPOSED SOUTHEAST ELEVATION

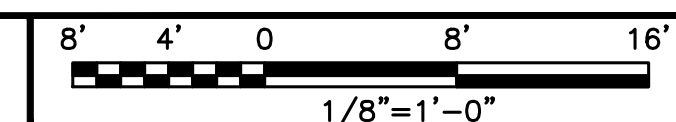


2

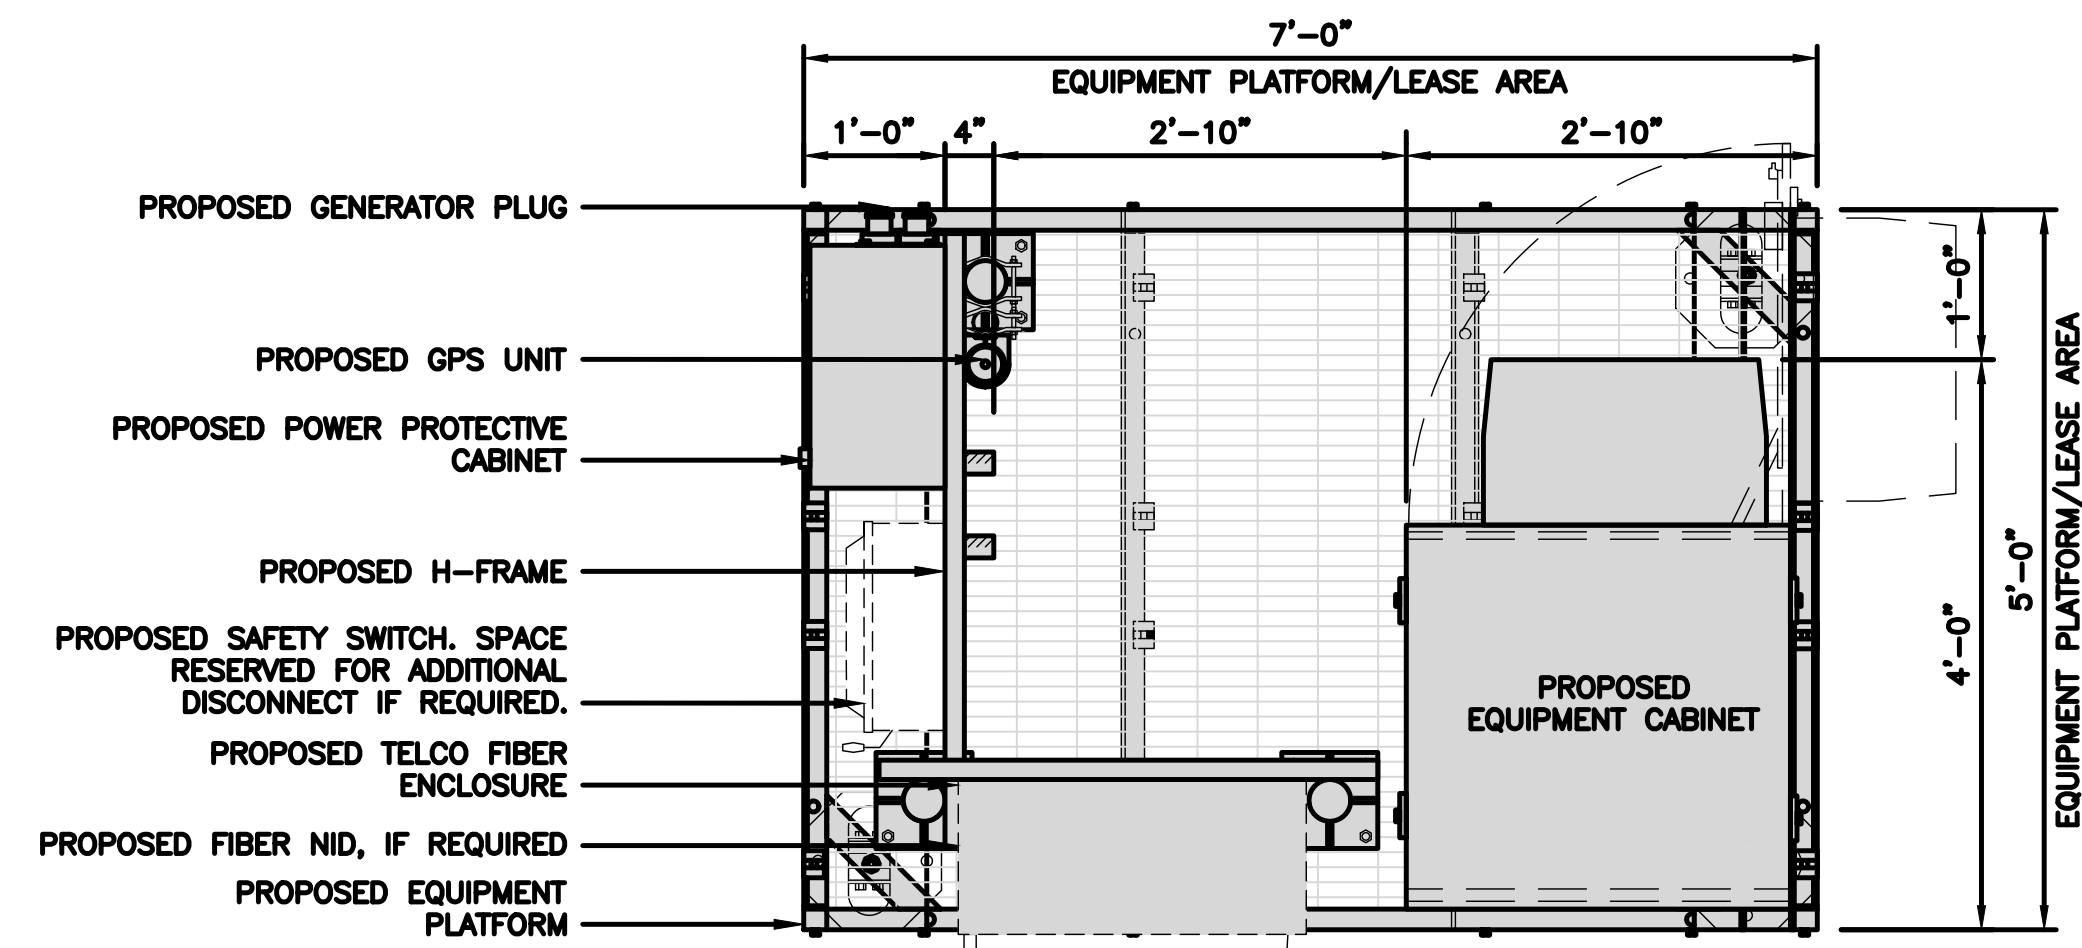

PLATFORM EQUIPMENT PLAN

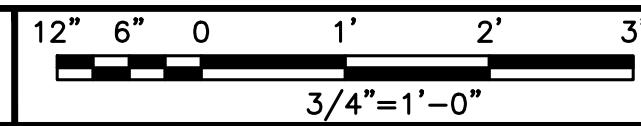

1

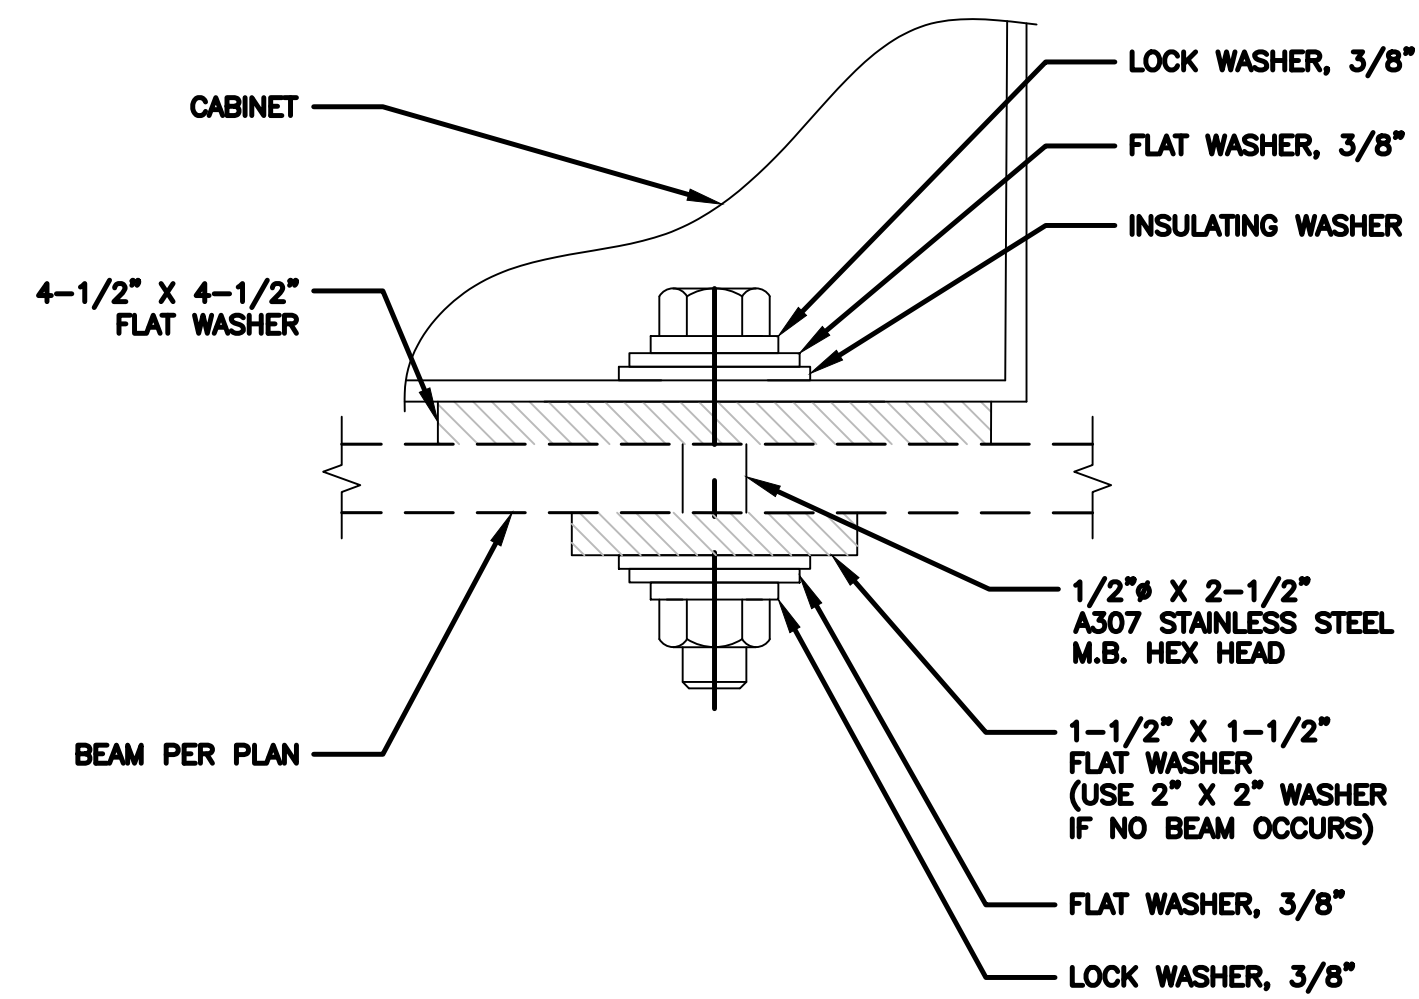


CABINET ANCHORAGE DETAIL

NO SCALE

2

COMMSCOPE MTC4045HFLD H-FRAME	
UNISTRUT/SUPPORT RAILS QTY	5
WEIGHT	59.74 lbs

NOTE:
OR DISH Wireless L.L.C.
APPROVED EQUIVALENT

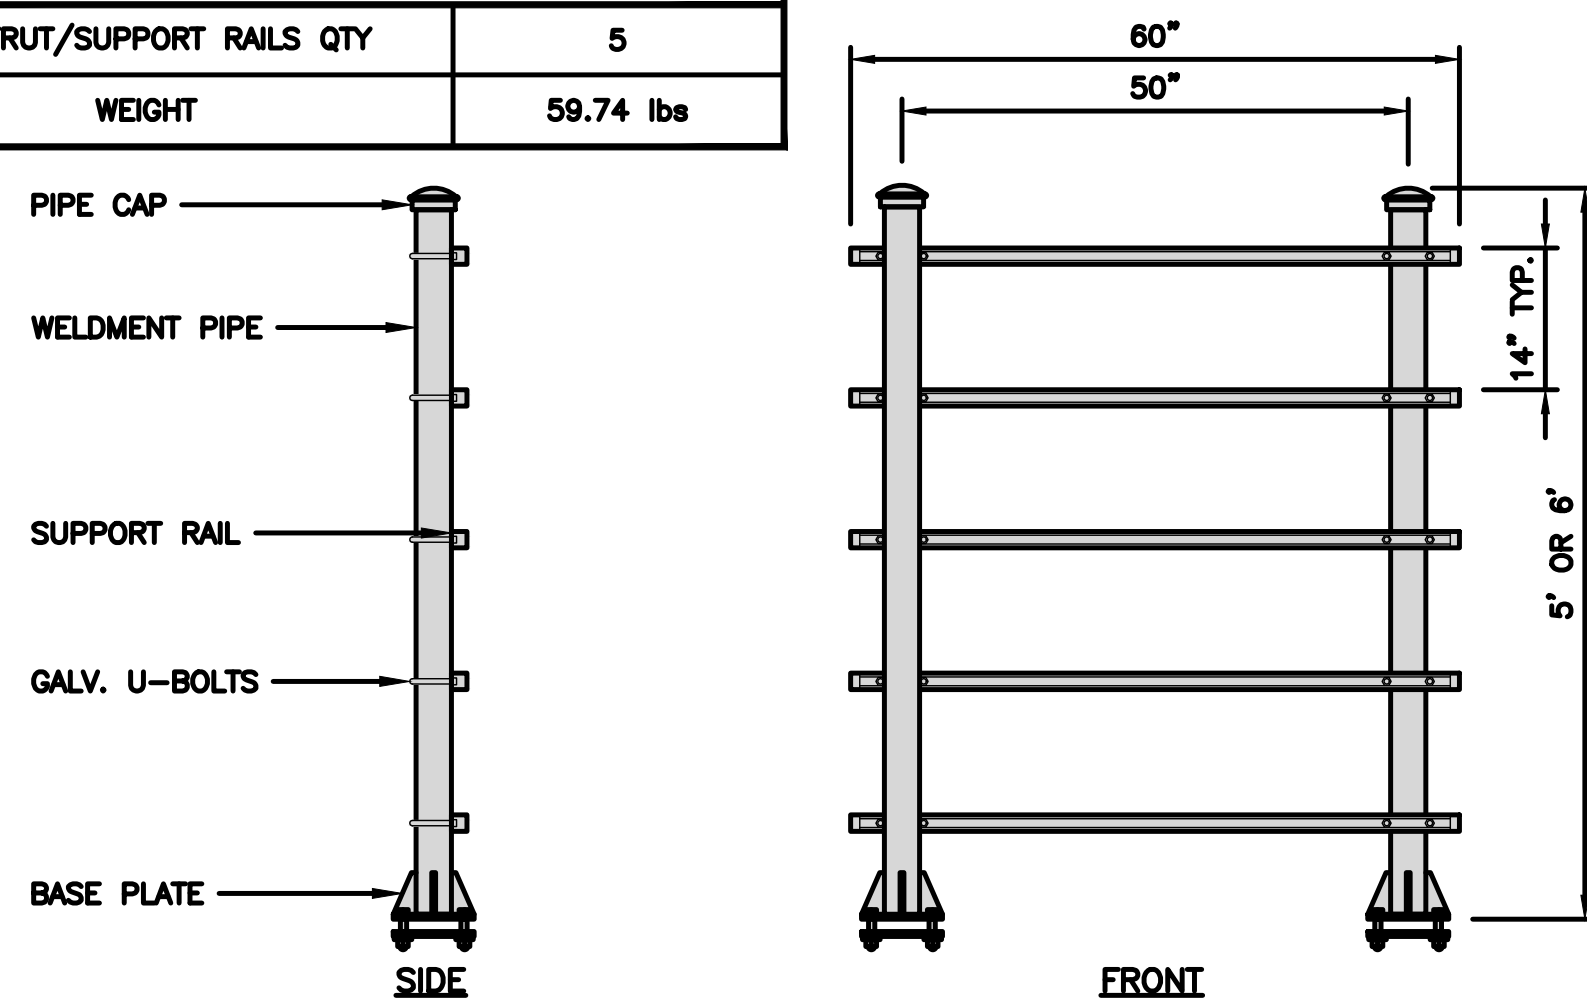

H-FRAME DETAIL

NO SCALE


3

NOT USED

NO SCALE

4

NOT USED

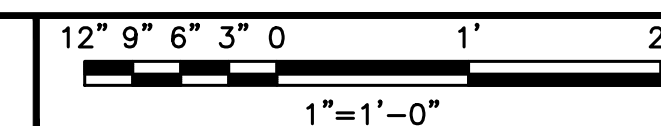


5

dish
wireless.

5701 SOUTH SANTA FE DRIVE
LITTLETON, CO 80120



2840 HOWE ROAD, SUITE E
MARTINEZ, CA 94553
www.TheCBRGroup.com

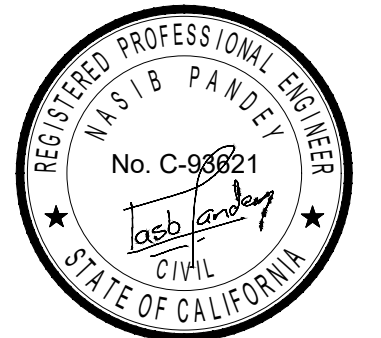

IT IS A VIOLATION OF LAW FOR ANY PERSON, UNLESS THEY ARE ACTING UNDER THE DIRECTION OF A LICENSED PROFESSIONAL ENGINEER, TO ALTER THIS DOCUMENT.

DRAWN BY: CHECKED BY: APPROVED BY:

JG/WM --- ---

RFDS REV #: 02/02/2022 REV 4

CONSTRUCTION DOCUMENTS

SUBMITTALS		
REV	DATE	DESCRIPTION
A	02/10/2022	90% CD'S ISSUED FOR REVIEW
B	04/19/2022	100% CONSTRUCTION DRAWINGS
C	06/11/2022	PLAN CHECK COMMENTS

A&E PROJECT NUMBER
SFSF001158A

DISH Wireless L.L.C.
PROJECT INFORMATION





SFSF001158A
1300 COMMERCE ST
PETALUMA, CA 94954

SHEET TITLE
EQUIPMENT PLATFORM AND
H-FRAME DETAILS

SHEET NUMBER

A-6

CHARLES INDUSTRY HEX CUBE-PM639155N4	
DIMENSIONS (HxWxD)	74"x32"x32"
POWER PLANT	-48VDC ABB/600W
TOTAL WEIGHT (EMPTY)	408 lbs


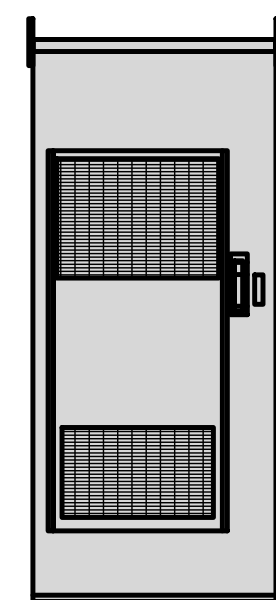
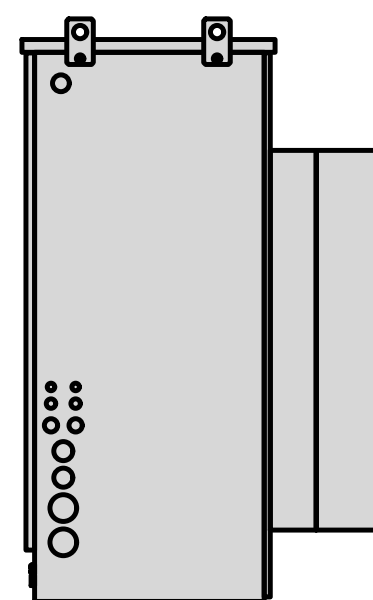
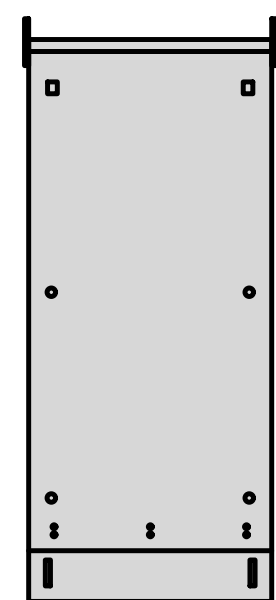
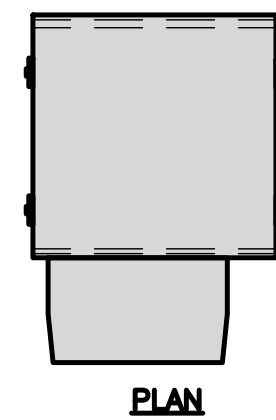


CABINET DETAIL

NO SCALE

1

RAYCAP PPC RDIAC-2465-P-240-MTS	
ENCLOSURE DIMENSIONS (HxWxD):	39"x22.855"x12.593
WEIGHT:	80 lbs
OPERATING AC VOLTAGE	240/120 1 PHASE 3W+G

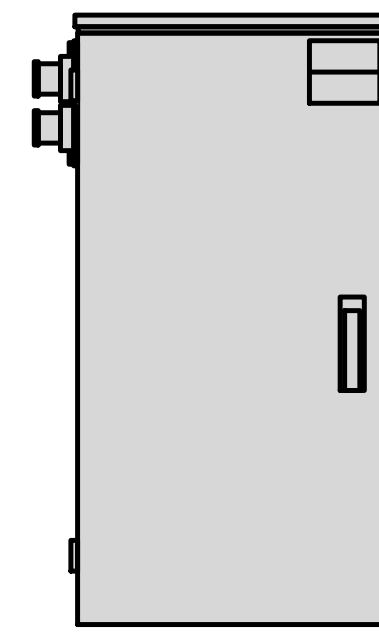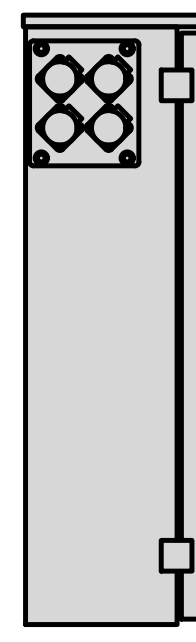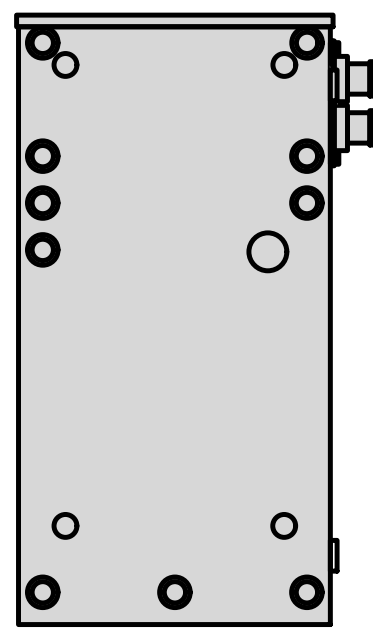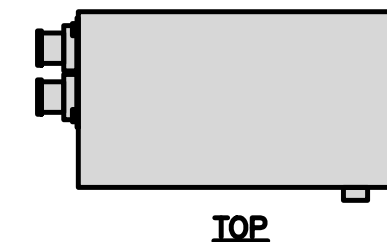 


CABINET DETAIL

NO SCALE

2


SQUARE D H363 HEAVY DUTY SAFETY SWITCH	
DIMENSIONS (HxWxD)	21.25"x10.25"x6.38"
WEIGHT	19.84 lbs
PRODUCT	SINGLE THROW
DEVICE APPLICATION	HEAVY APPLICATION
DISCONNECT TYPE	FUSIBLE DISCONNECT
FACTORY INSTALLED NEUTRAL	NONE
PHASE	3 PHASE
NUMBER OF POLES	3
CURRENT RATING	100A
VOLTAGE RATING	600 V AC/DC
ENCLOSURE RATING	NEMA 1 STEEL

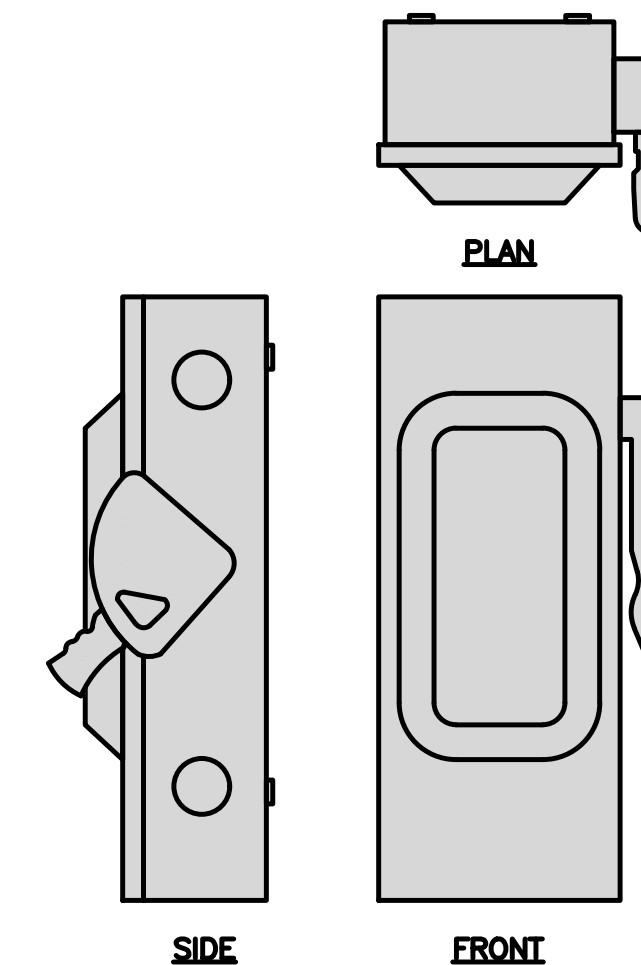

SAFETY SWITCH DETAIL

NO SCALE

3




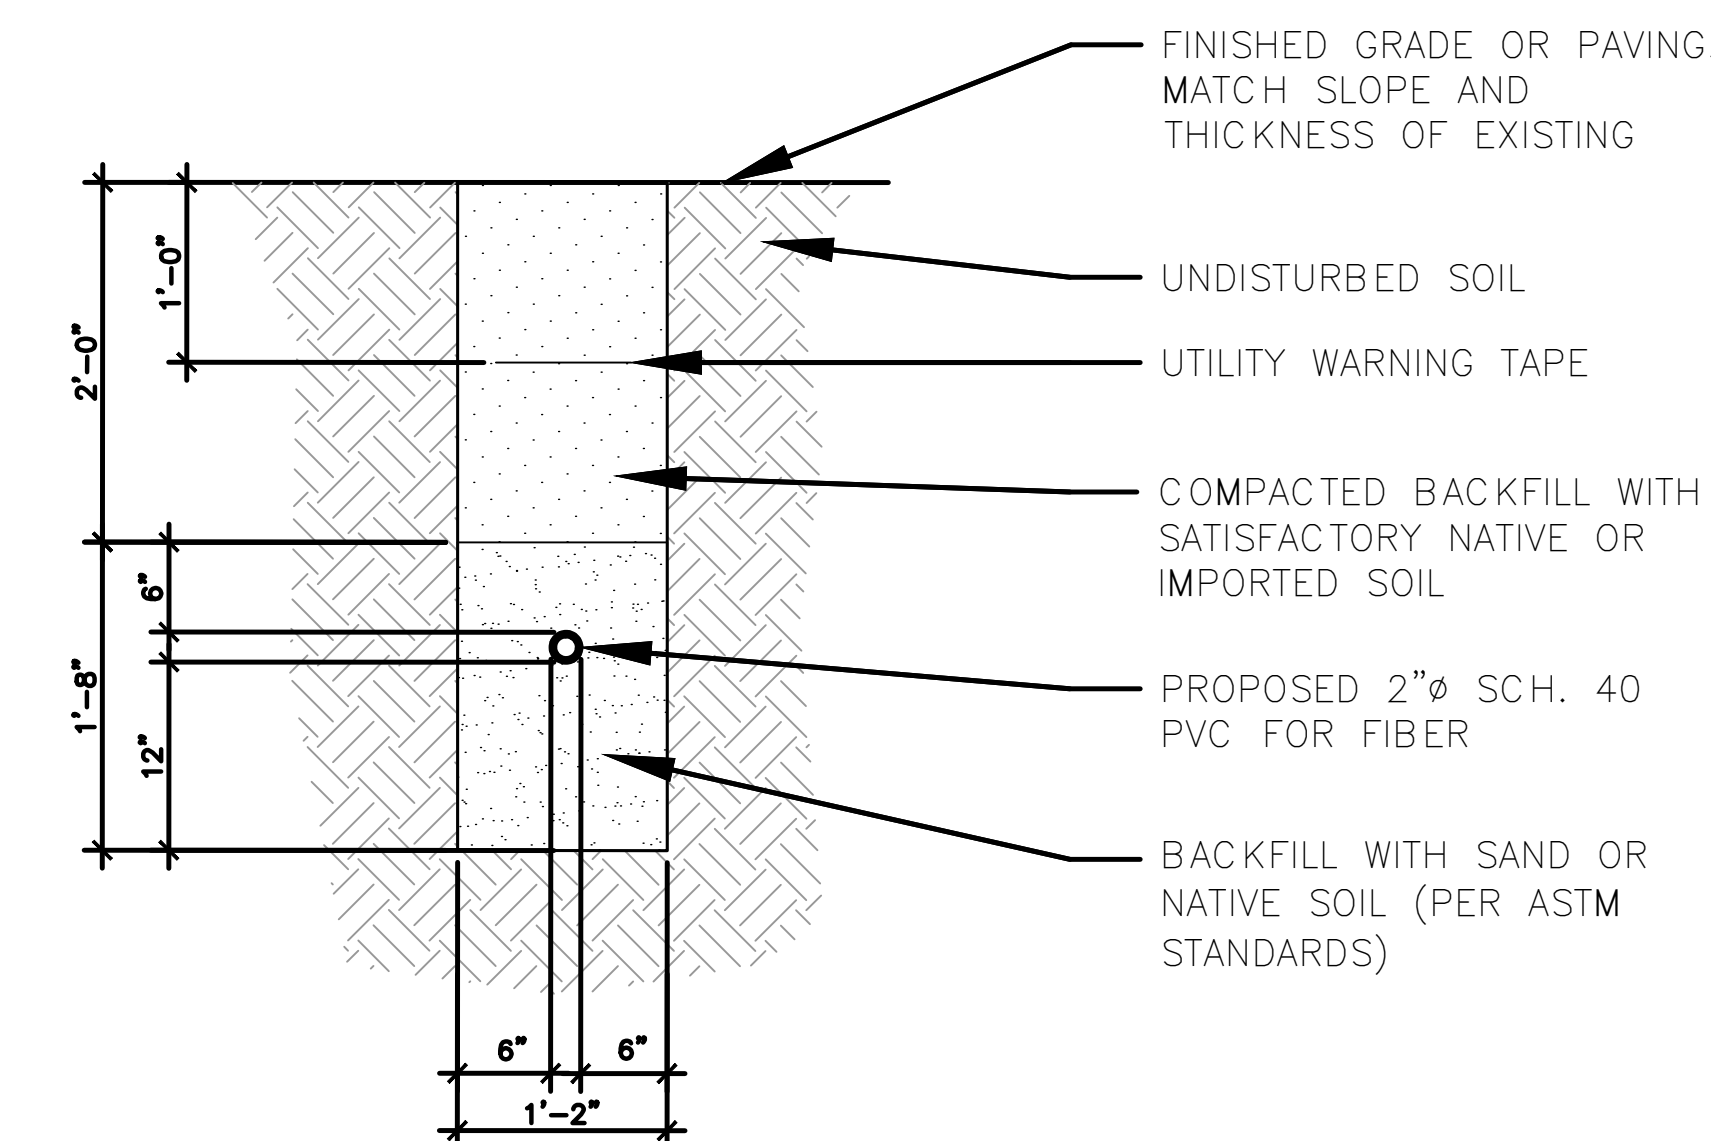


TRENCHING DETAIL

NO SCALE

4

LEVITON 1N240-2D SUBMETER	
WIRE	3
AMPS	200
VOLTS AC	120, 208, 240
PHASE	1

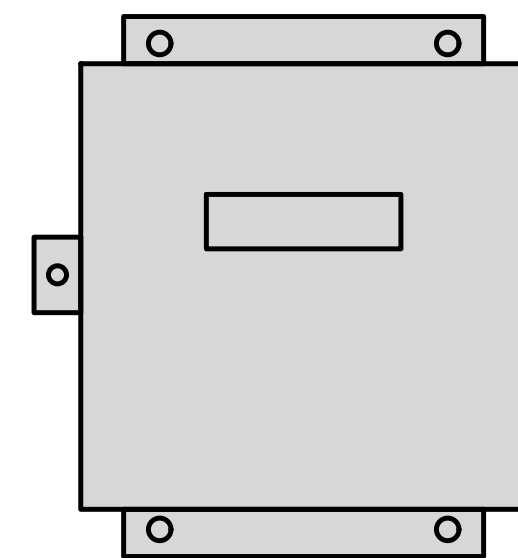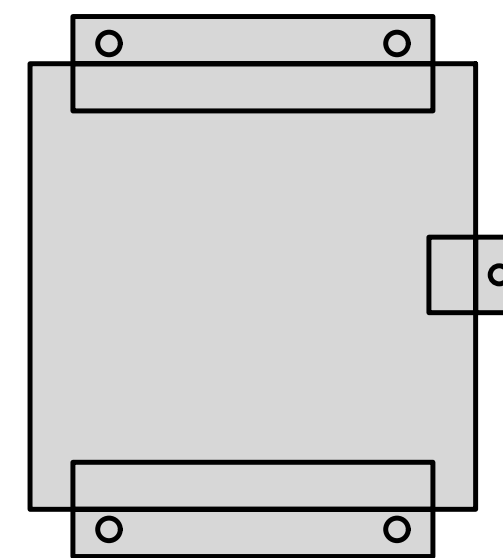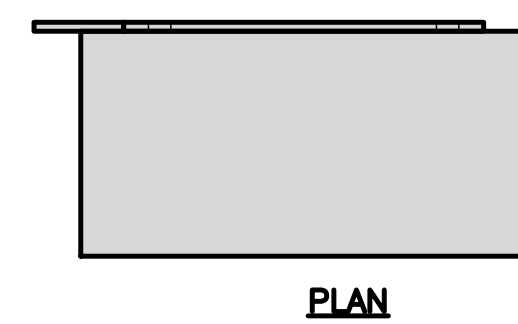 


SUBMETER DETAIL

NO SCALE

5

CHARLES CFIT-PF2020DSH1 FIBER TELCO ENCLOSURE	
ENCLOSURE DIMS (HxWxD)	20"x20"x9"
ENCLOSURE WEIGHT	20 lbs
MOUNTING	WALL
COMPLIANCE	TYPE 4



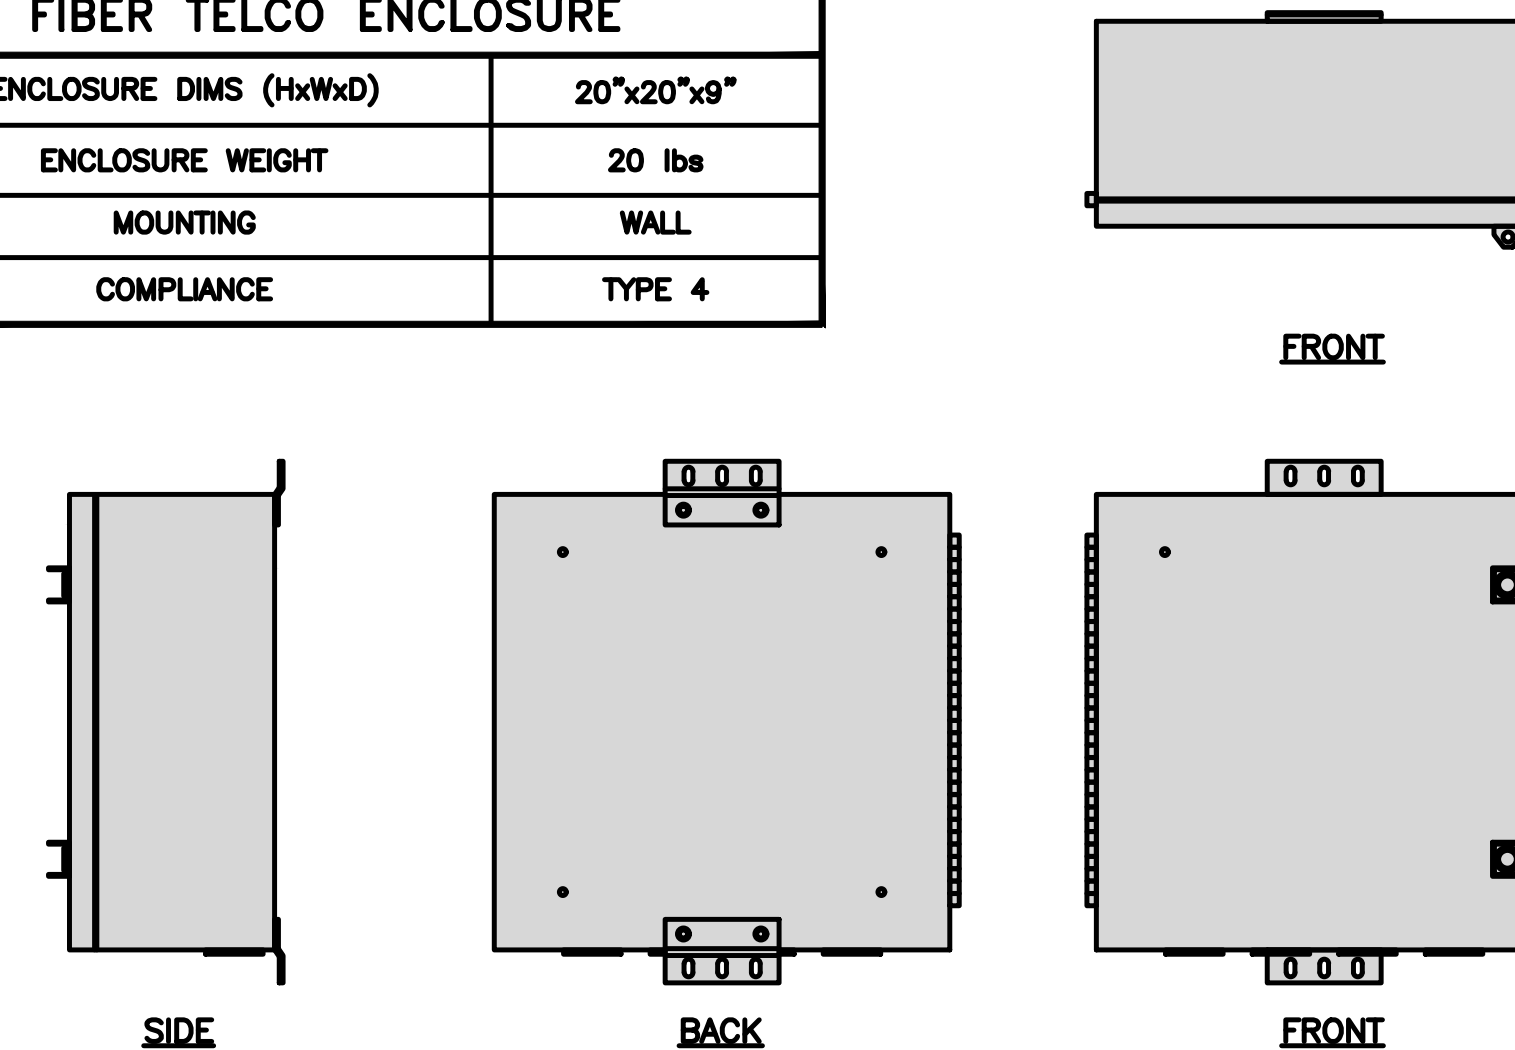


FIBER TELCO ENCLOSURE DETAIL

NO SCALE

6


PCTEL GPSGL-TMG-SPI-40NCB	
DIMENSIONS (DIAxH) MM/INCH	81x184mm 3.2"x7.25"
WEIGHT W/ACCESSORIES	075 lbs
CONNECTOR	N-FEMALE
FREQUENCY RANGE	1590 ± 30MHz

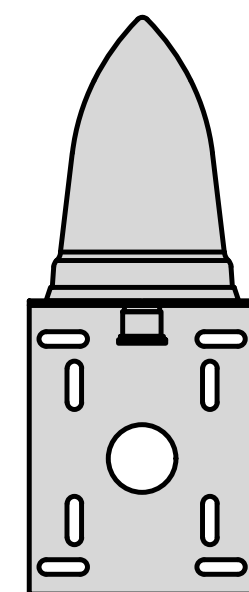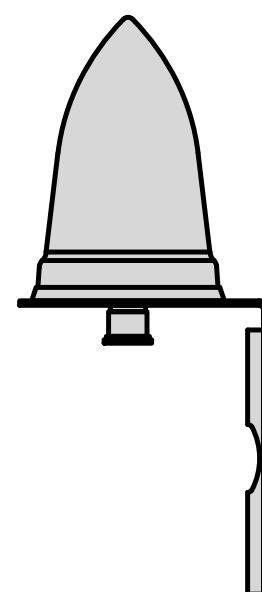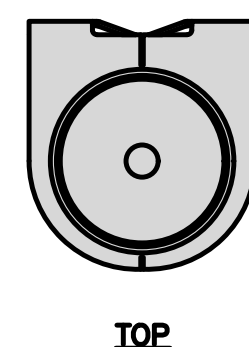

GPS DETAIL

NO SCALE


7

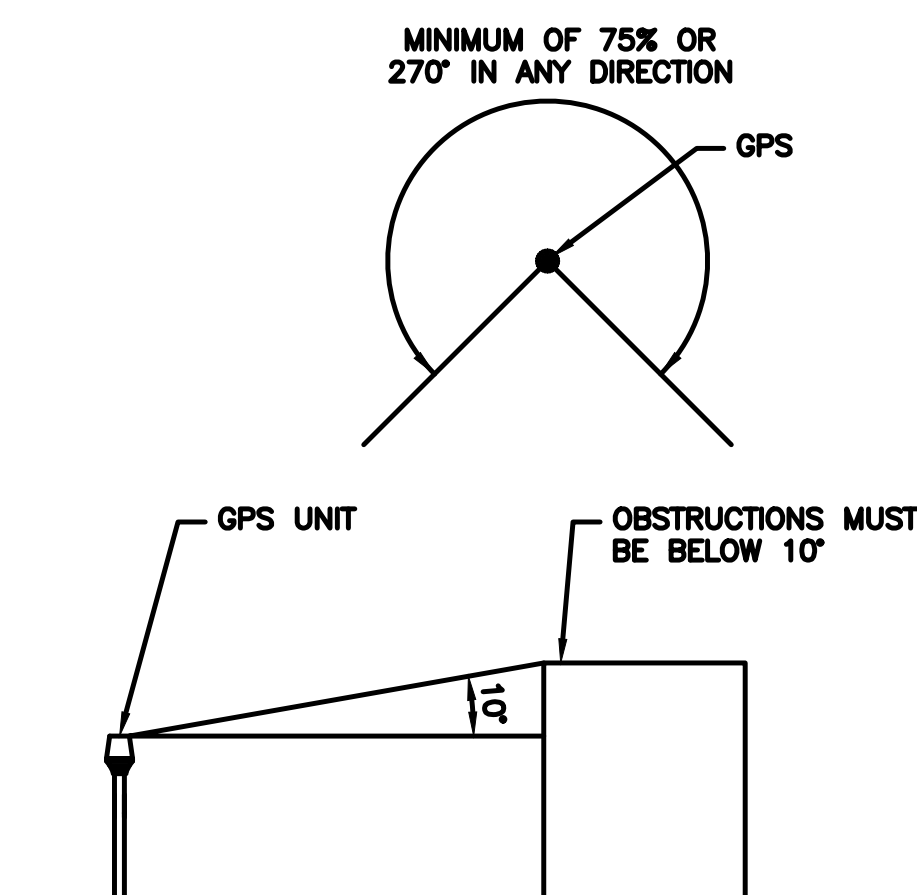

GPS MINIMUM SKY VIEW REQUIREMENTS

NO SCALE

8

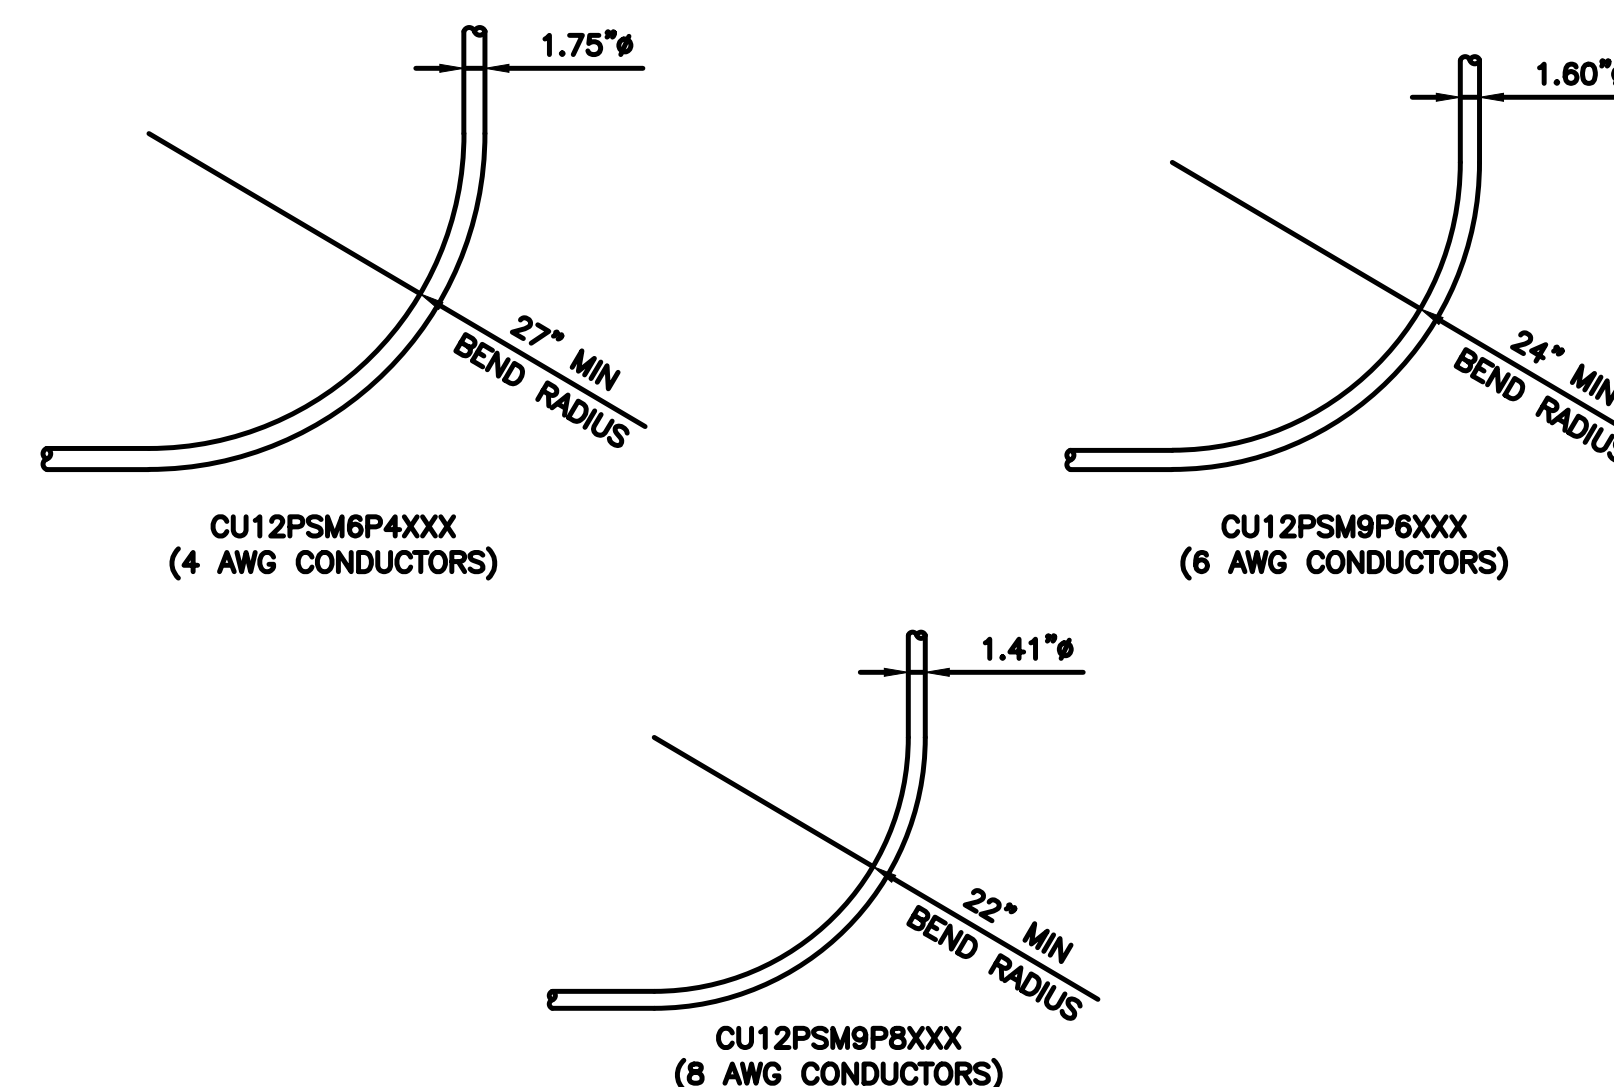

CABLES UNLIMITED HYBRID CABLE MINIMUM BEND RADIUSES

NO SCALE

9

dish wireless.

5701 SOUTH SANTA FE DRIVE
LITTLETON, CO 80120

THE CBR GROUP

2840 HOWE ROAD, SUITE E
MARTINEZ, CA 94553
www.TheCBRGroup.com



IT IS A VIOLATION OF LAW FOR ANY PERSON, UNLESS THEY ARE ACTING UNDER THE DIRECTION OF A LICENSED PROFESSIONAL ENGINEER, TO ALTER THIS DOCUMENT.

DRAWN BY: CHECKED BY: APPROVED BY:
JG/WM --- ---

RFDS REV #: 02/02/2022 REV 4

CONSTRUCTION DOCUMENTS

SUBMITTALS		
REV	DATE	DESCRIPTION
A	02/10/2022	90% CD'S ISSUED FOR REVIEW
B	04/19/2022	100% CONSTRUCTION DRAWINGS
C	06/11/2022	PLAN CHECK COMMENTS

A&E PROJECT NUMBER
SFSF001158A

DISH Wireless L.L.C.
PROJECT INFORMATION


SFSF001158A
1300 COMMERCE ST
PETALUMA, CA 94954

SHEET TITLE
EQUIPMENT DETAILS


SHEET NUMBER

A-7


MTI DB GEN-1.5 G2021-49-02B	
DIMENSIONS (HxWxD)	13.9"x16.9"x9.8"
WEIGHT	86 lbs
DC POWER IN	-40.5V to -57V
POWER SUPPLY VOLTAGE	-48Vdc (NOMINAL)

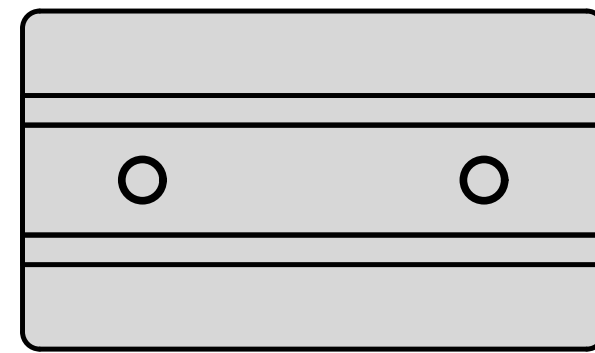

PLAN

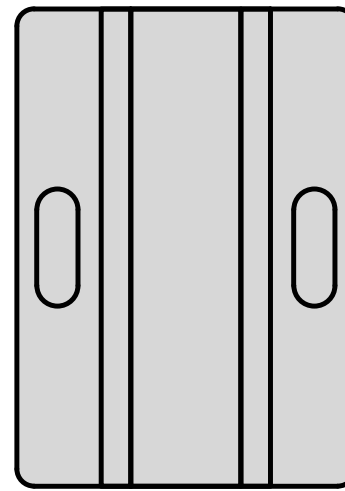


SIDE

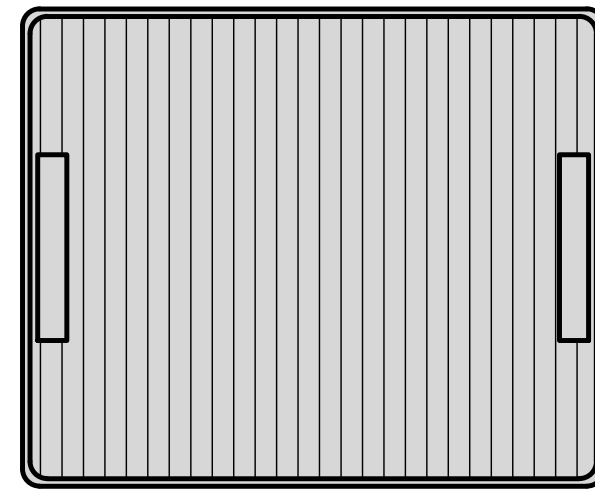


FRONT


MTI TB GEN-1.5 G060708-50-02B	
DIMENSIONS (HxWxD)	13.9"x16.9"x11"
WEIGHT	97 lbs
DC POWER IN	-40.5V to -57V
POWER SUPPLY VOLTAGE	-48Vdc (NOMINAL)

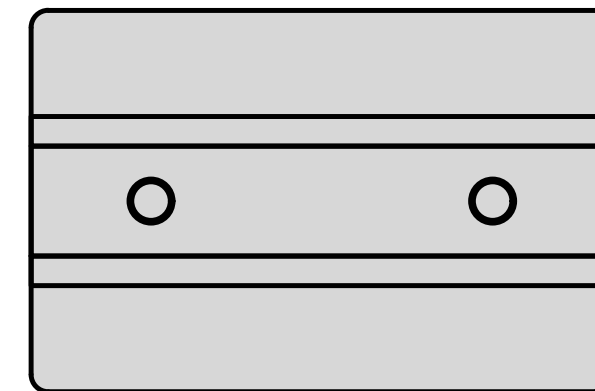

PLAN

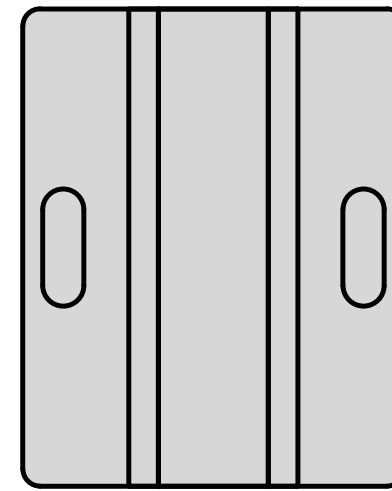



SIDE

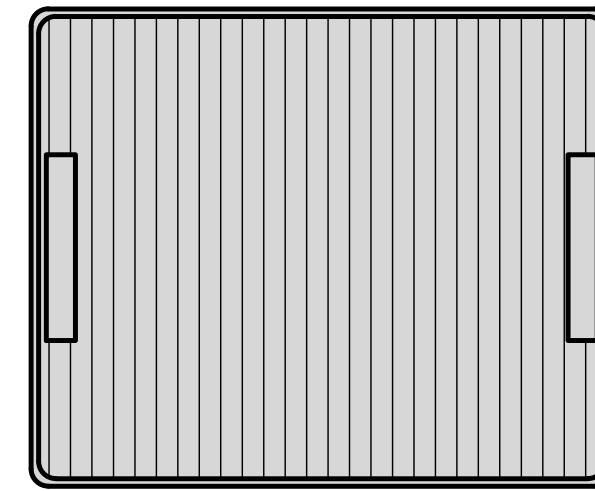

FRONT

SABRE DOUBLE Z-BRACKET C10123155	
DIMENSIONS (HxWxD) (1 BRACKET)	5"x20"x1-13/16"
WEIGHT (FULL ASSEMBLY)	35.79 lbs
PACKAGE QUANTITY	4

#	DESCRIPTION
1	PLATE, CHANNEL BRACKET
2	RRH Z BRACKET, 3/16"
3	THREADED ROD ASSEMBLY 1/2"x12"

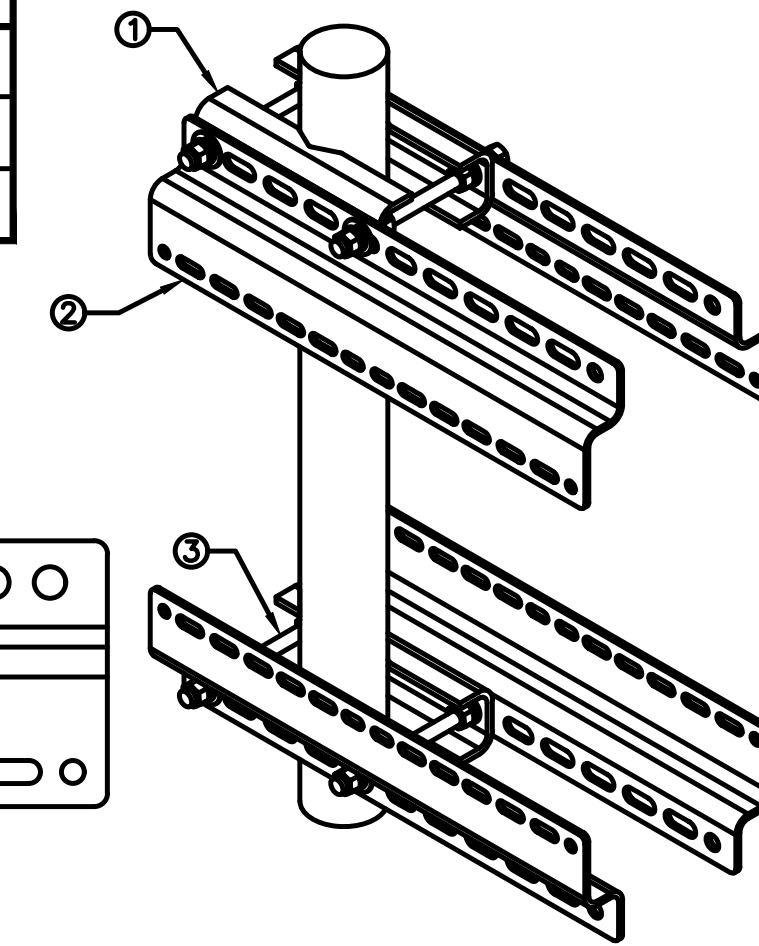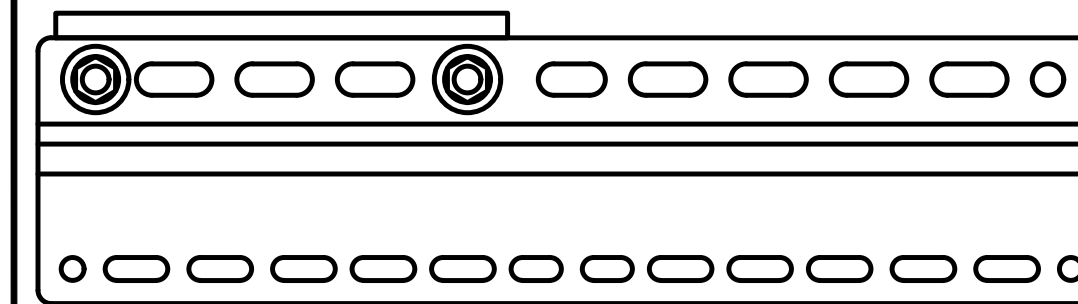

NOTE:
OR DISH Wireless L.L.C.
APPROVED EQUIVALENT

RRH DETAIL

NO SCALE

1

RRH DETAIL

NO SCALE

2

RRH MOUNT DETAIL


NO SCALE

3

CELLMAX 12044x CMA-UBTULBULBHH/6516/16/21/21	
DIMENSIONS (HxWxD)(MM/IN)	1840x680x196 72.4"x26.7"x7.7"
CONNECTORS	8 x 4.3-10 FEMALE
WEIGHT (kg/lb)	48/105
WEIGHT WITH BRACKETS (kg/lb)	53/116



PLAN

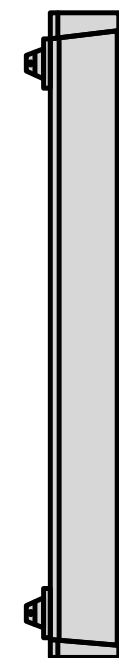

SIDE




FRONT

ANTENNA DETAIL

NO SCALE

4

COMMSCOPE RT-CB4D ROOFTOP COVER KIT		MOUNTING	NON-PENETRATING
DIMENSIONS (HxWxL)	7"x 11.25"x 96"	INCLUDED PRODUCTS:	RTCB4D.01 CHANNEL (1) MT-F1598 SLEEPERS (3) RTCUH HARDWARE RTHC.01 HOLD-DOWN CLAMPS (6)
WEIGHT/ VOLUME	85.98 LBS		
CABLE RUN (QTY)	4		

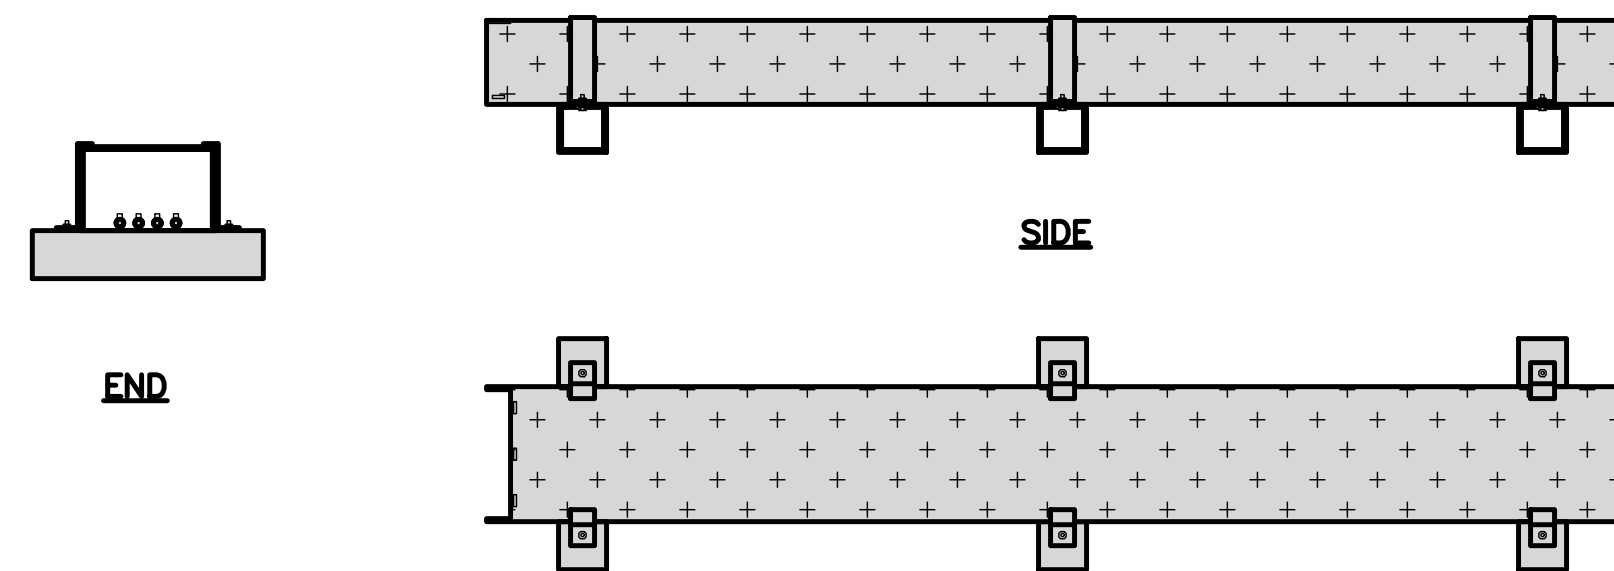

SIDE

END

PLAN


ROOFTOP CABLE TRAY DETAIL

NO SCALE

5

CELLMAX ANTENNA MOUNT BRACKET CX12044x	
TOTAL WEIGHT (WITH BRACKETS)	18 lbs (8.18 Kg)
POLE DIAMETER RANGE	2.5" TO 4.5"

NOTE:
KIT #91900318: TOP AND BOTTOM BRACKETS
FOR 4-, 6-, AND 8-FOOT ANTENNAS
ANTENNA BRACKET NOT PART OF KIT

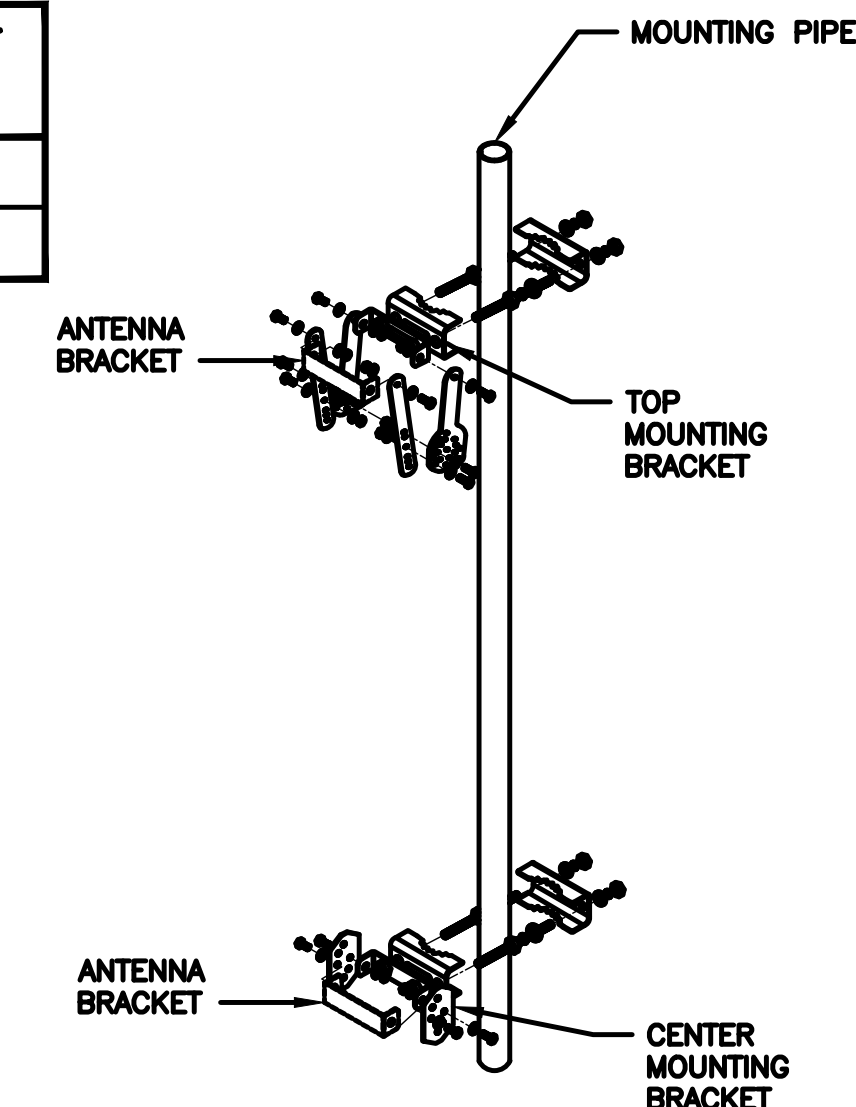


NOTE:
OR DISH Wireless L.L.C.
APPROVED EQUIVALENT

ANTENNA BRACKET DETAIL


NO SCALE

6


RAYCAP RDIDC-3045-PF-48 SURGE PROTECTION DEVICE (OVP)	
DIMENSIONS (HxWxD)	19"x16.21"x9.64"
WEIGHT	21 lbs

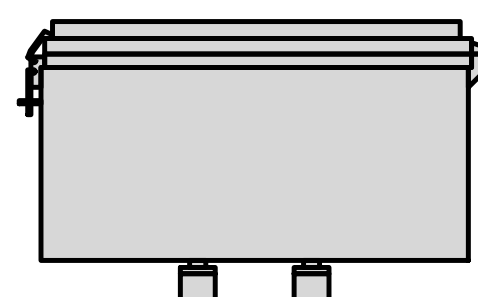


PLAN

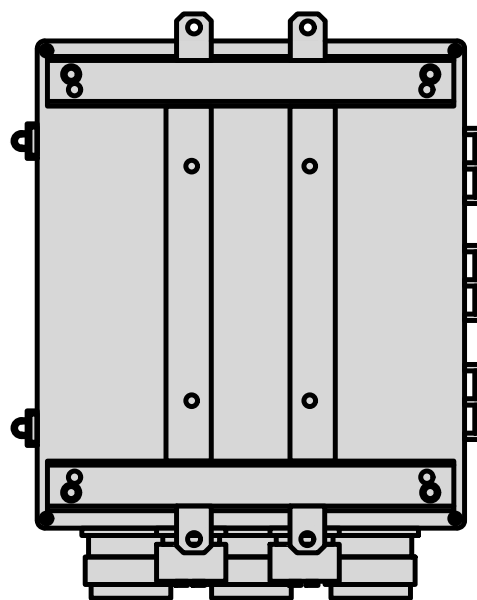

BACK

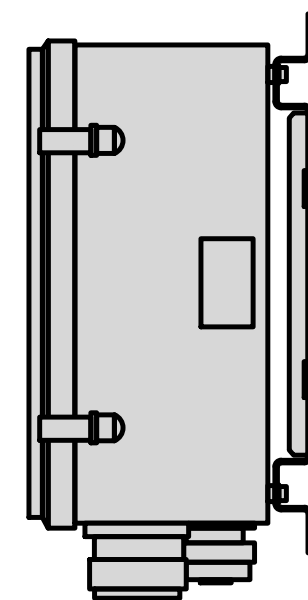

SIDE

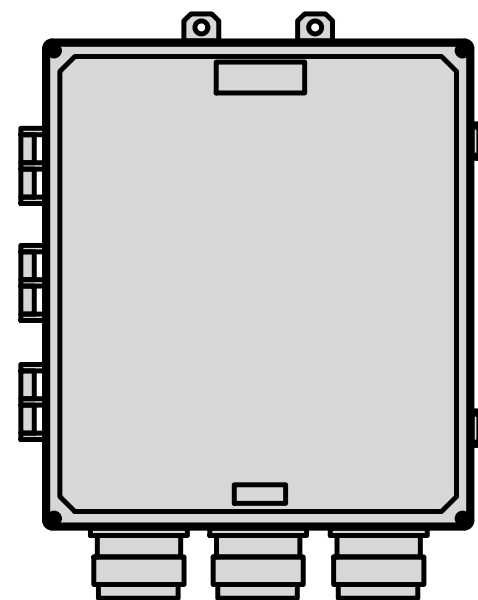


FRONT

SURGE PROTECTION DEVICE (OVP) DETAIL

NO SCALE

7

UTILITY RUBBER MAT, BLACK	
DIMENSIONS	4'x 3'x 1/2"
WEIGHT/ VOLUME	36.5 LB AVERAGE
MATERIAL	100% RECYCLE RUBBER

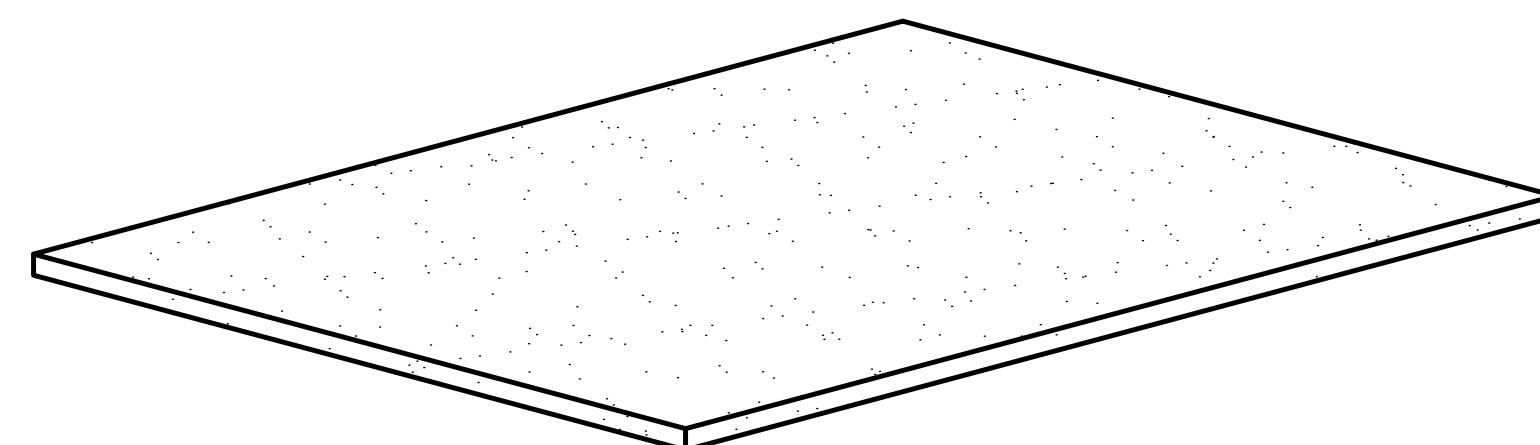

UTILITY RUBBER MAT DETAIL

NO SCALE

8


CONSTRUCTION DOCUMENTS		
SUBMITTALS		
REV	DATE	DESCRIPTION
A	02/10/2022	90% CD'S ISSUED FOR REVIEW
B	04/19/2022	100% CONSTRUCTION DRAWINGS
C	06/11/2022	PLAN CHECK COMMENTS
A&E PROJECT NUMBER SFSF001158A		
DISH Wireless L.L.C. PROJECT INFORMATION SFSF001158A 1300 COMMERCE ST PETALUMA, CA 94954		
SHEET TITLE EQUIPMENT DETAILS		
SHEET NUMBER A-8		



5701 SOUTH SANTA FE DRIVE
LITTLETON, CO 80120



2840 HOWE ROAD, SUITE E
MARTINEZ, CA 94553
www.TheCBRGroup.com




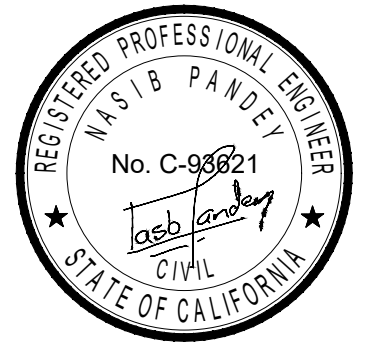


IT IS A VIOLATION OF LAW FOR ANY PERSON,
UNLESS THEY ARE ACTING UNDER THE DIRECTION
OF A LICENSED PROFESSIONAL ENGINEER,
TO ALTER THIS DOCUMENT.

DRAWN BY: CHECKED BY: APPROVED BY:

JG/WM --- ---


RFDS REV #: 02/02/2022 REV 4

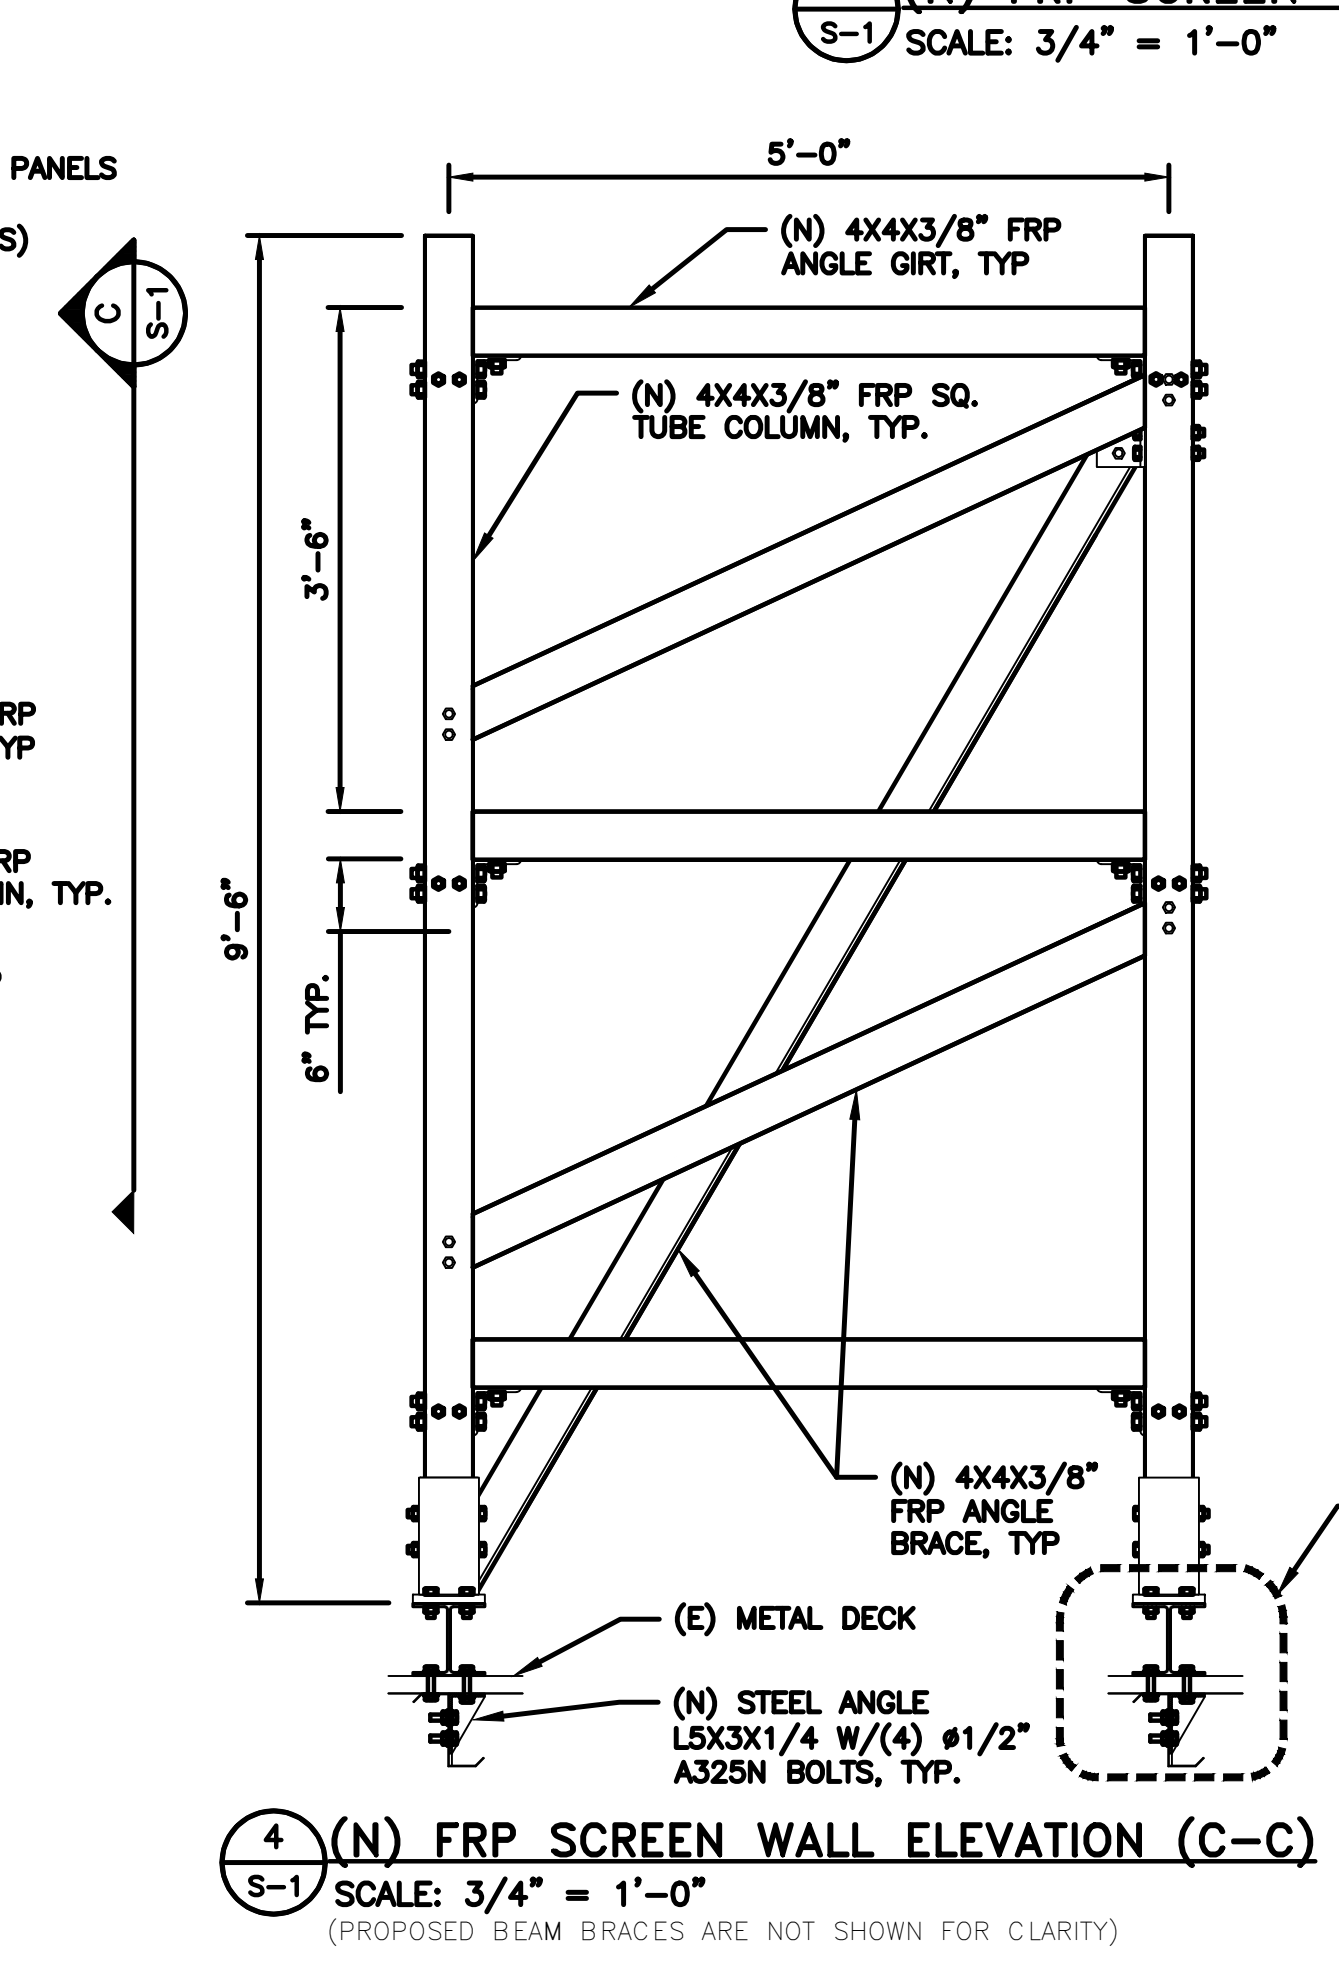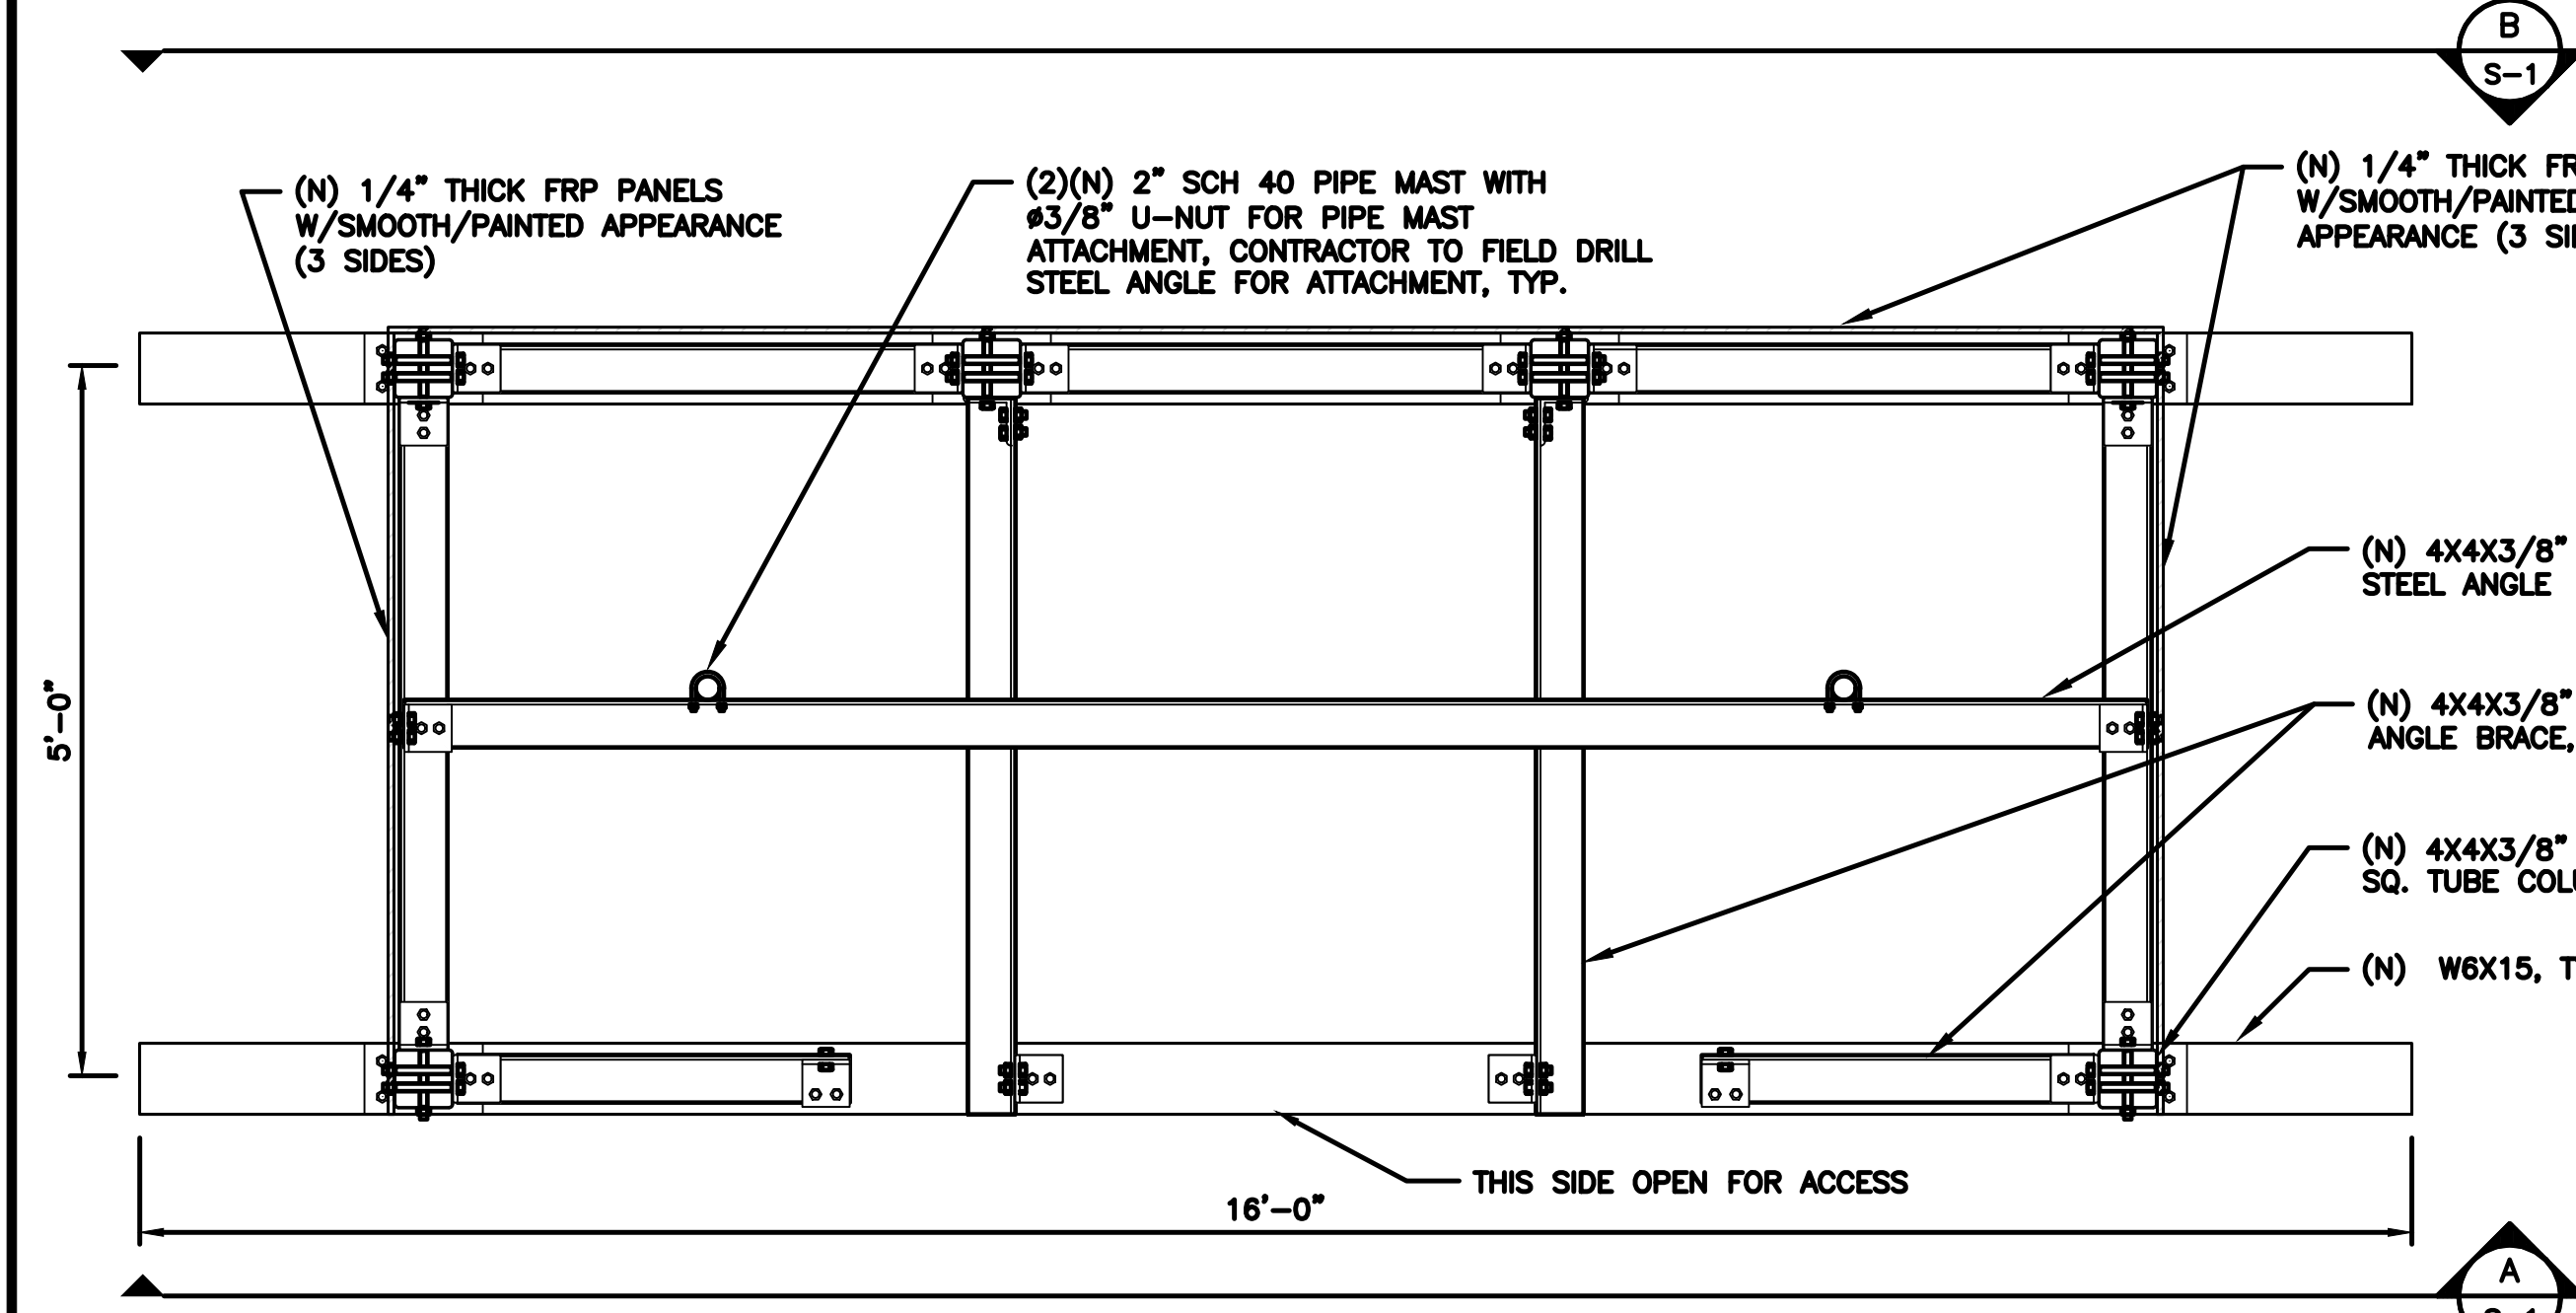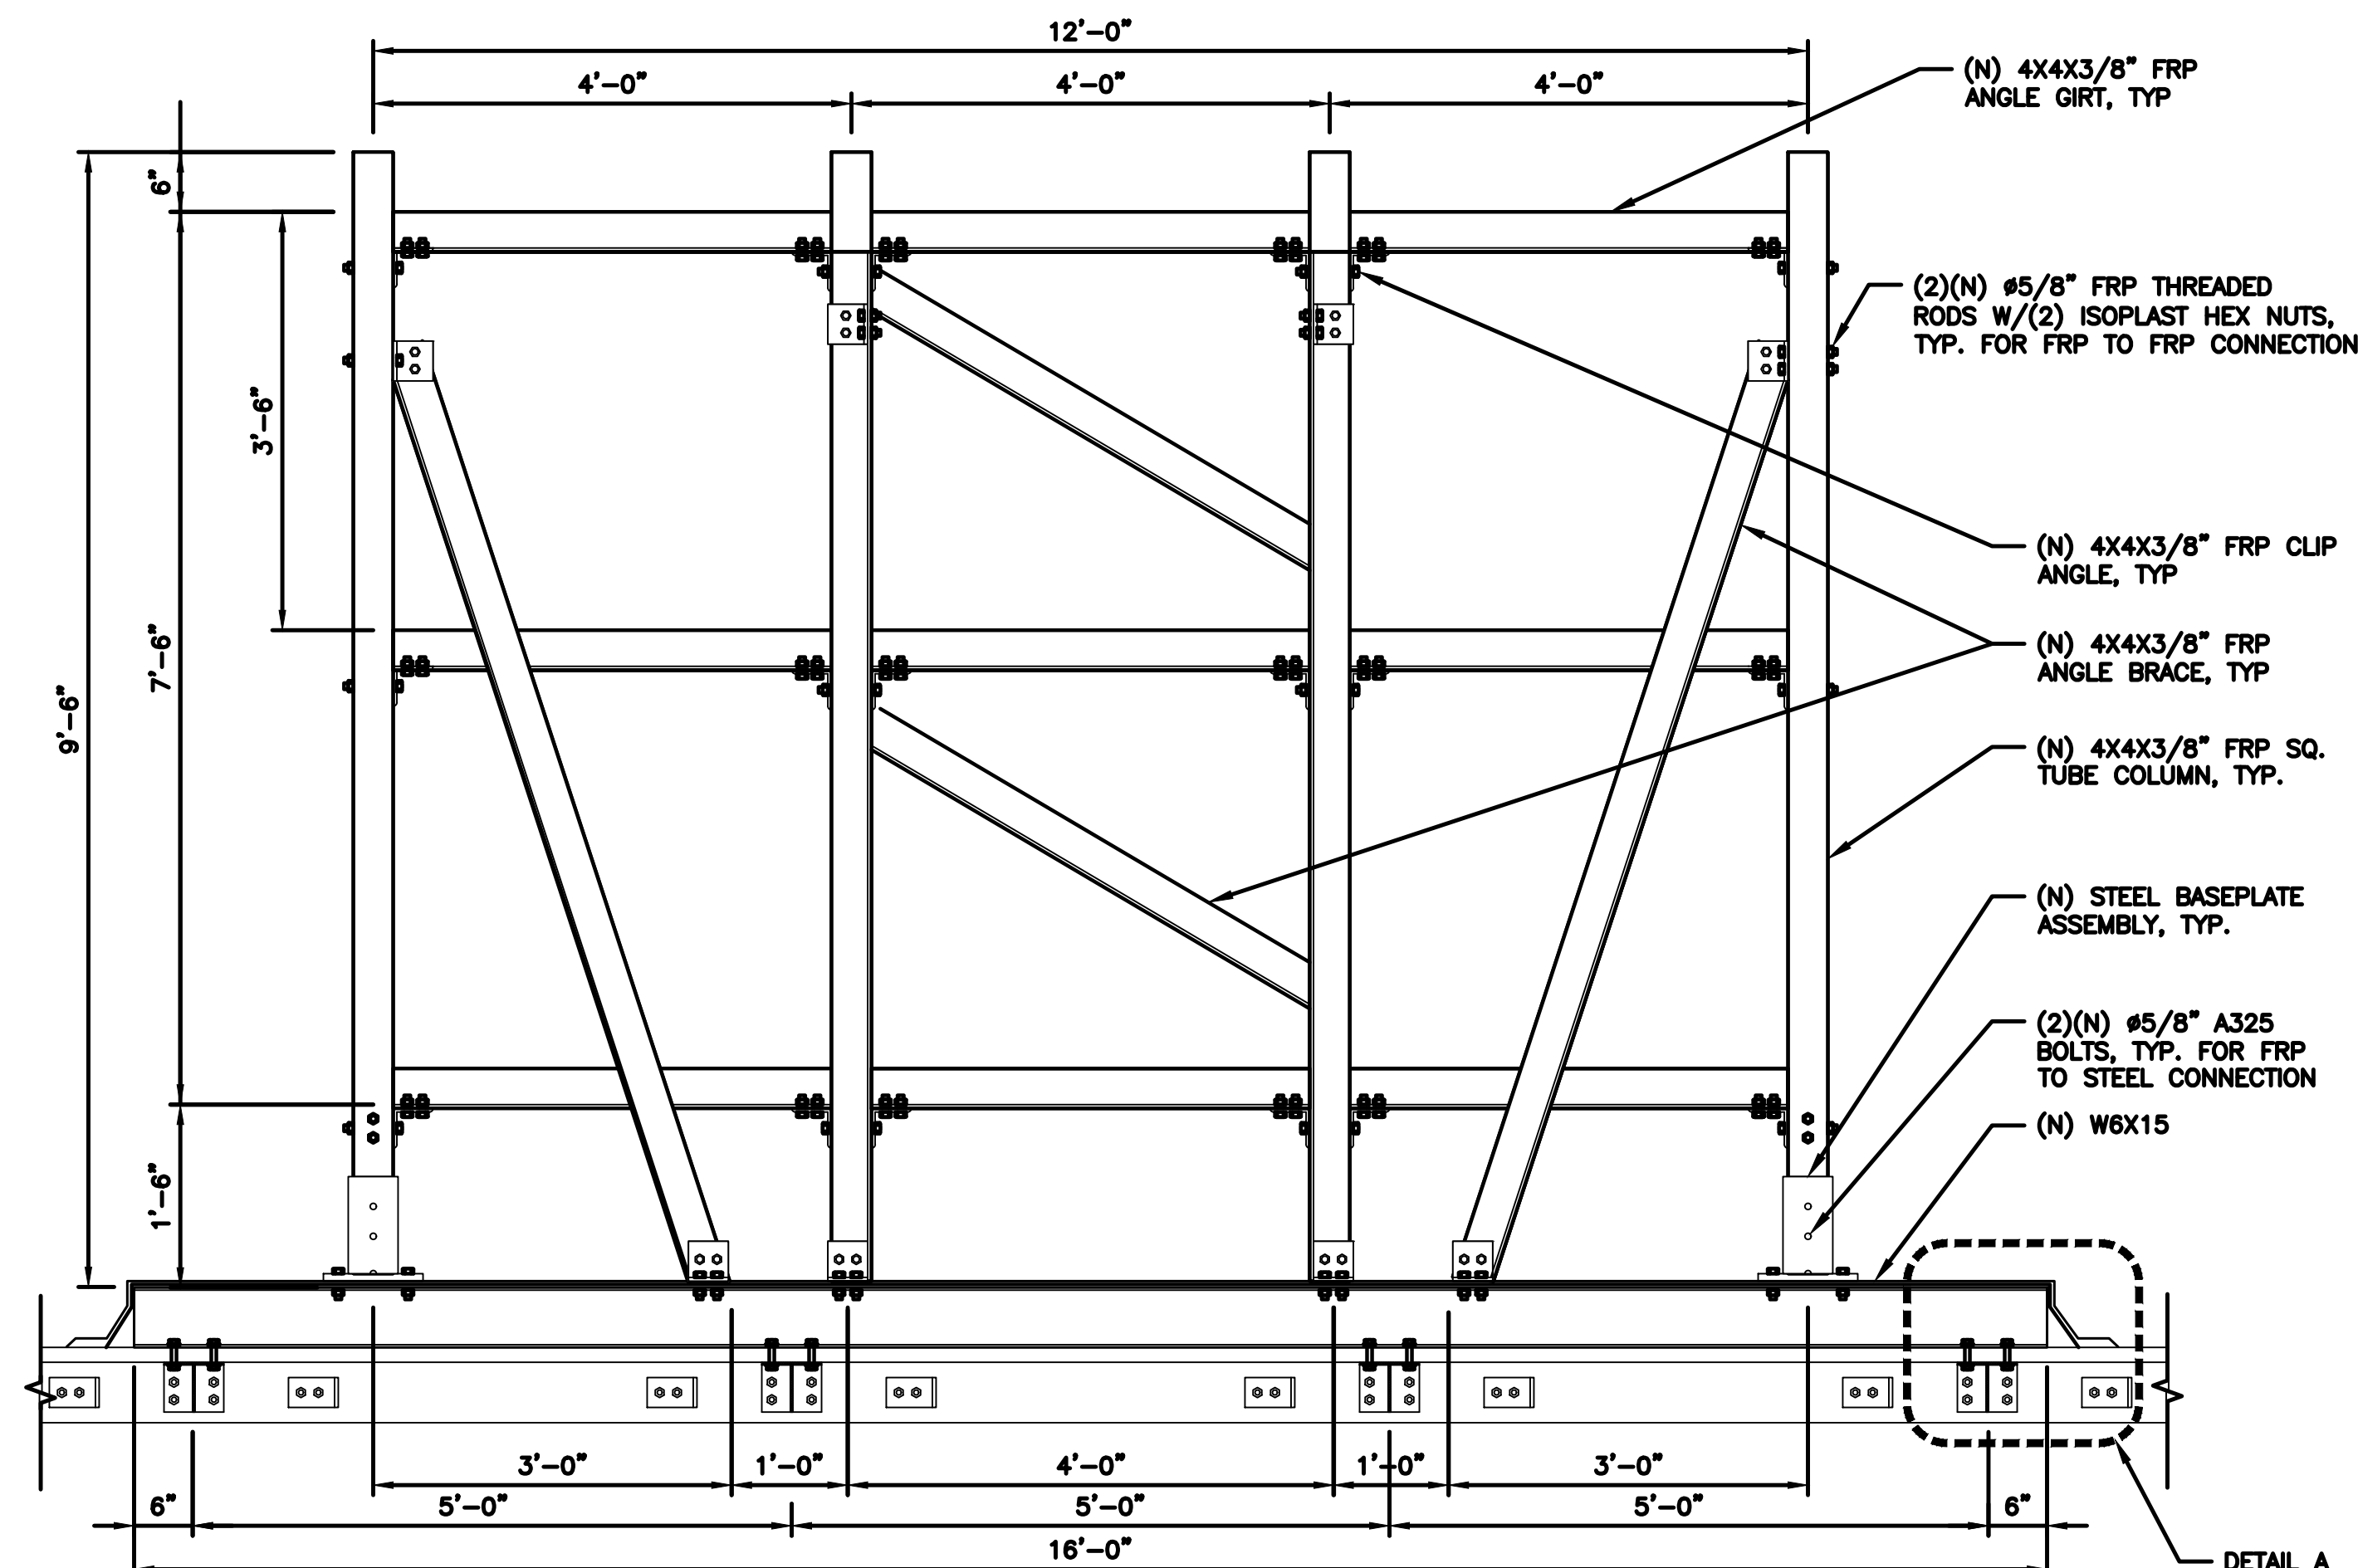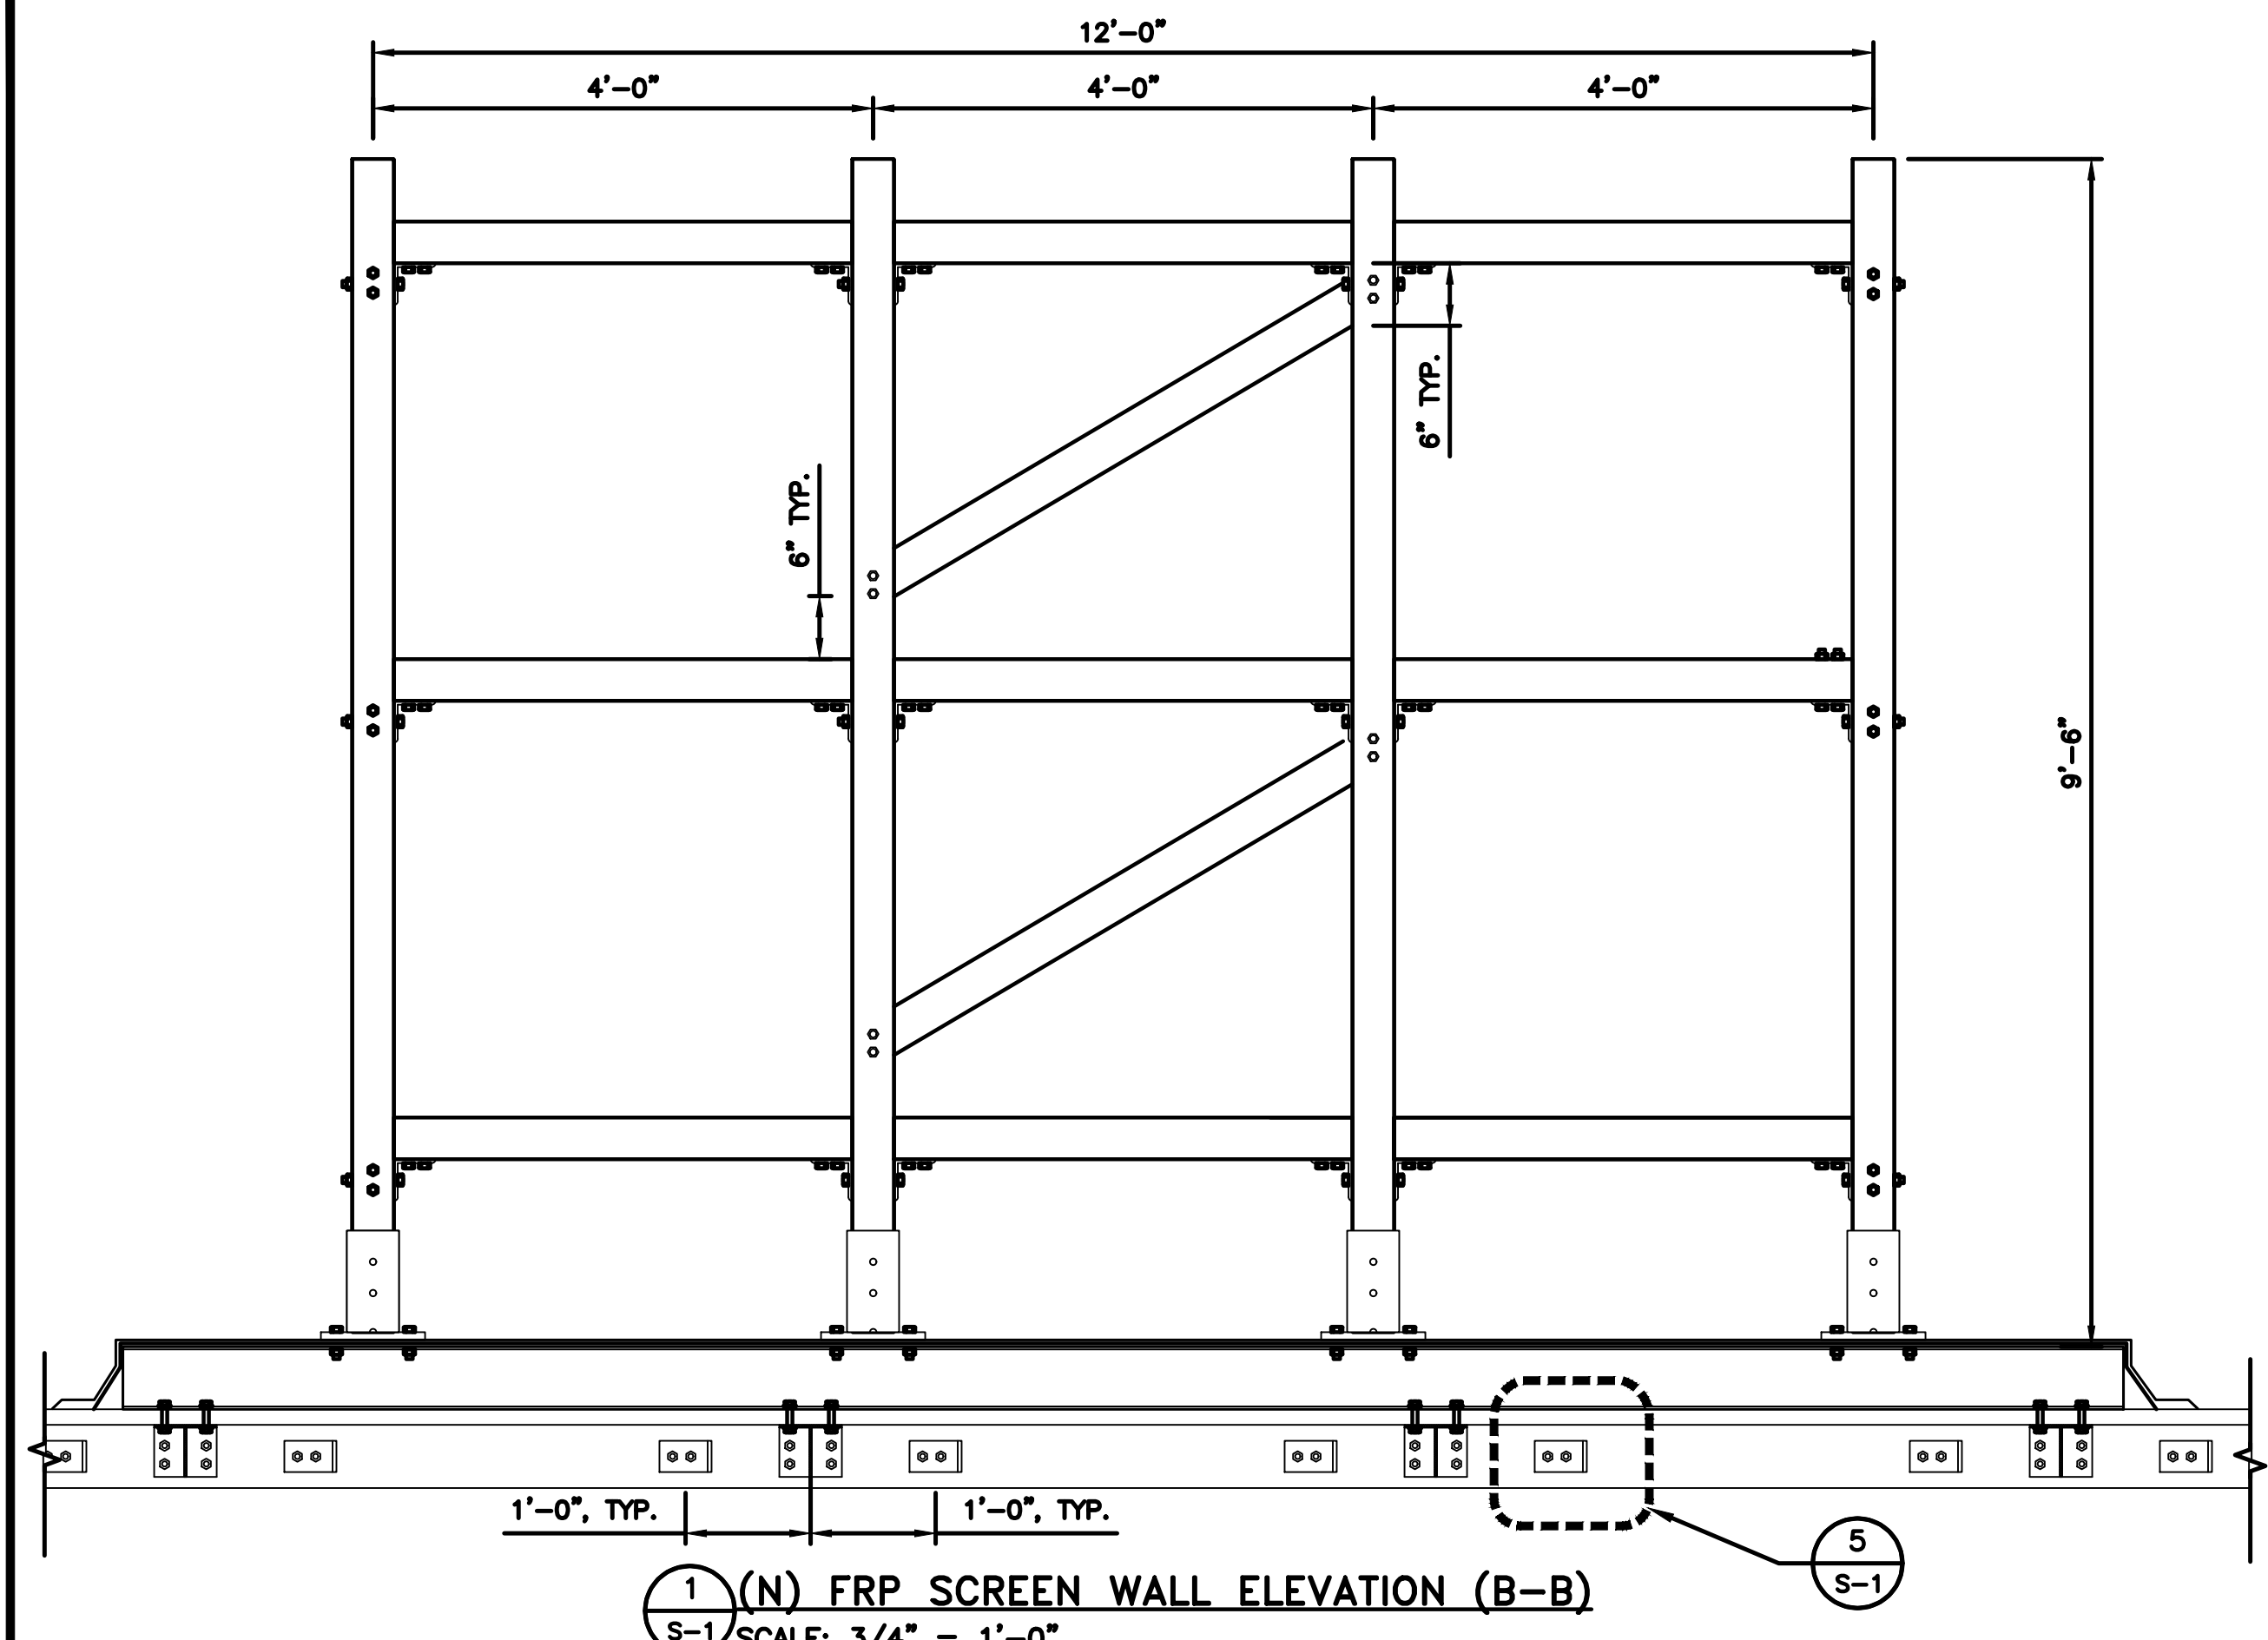

NOTE:
WEATHER PROOF ALL WALL & ROOF PENETRATIONS AS REQUIRED, USING SILICON SEALANT, SO AS TO PREVENT WATER PENETRATION INTO BUILDING WALLS. ALL WEATHERPROOFING SHALL BE APPROVED BY OWNER ROOFING CONTRACTOR.

PROVIDED DIMENSIONS ARE FOR REFERENCE ONLY. BEFORE ANY FABRICATION CONTRACTOR SHALL FIELD VERIFY ALL NEW MEMBER DIMENSIONS FOR FIT & POSSIBLE INTERFERENCE

NOTE:
EXISTING BUILDING COLUMNS, BEAMS AND WALL TO BE FIELD LOCATED AND SIZE VERIFIED BY GC PRIOR TO ANY CONSTRUCTION & FABRICATION. PLEASE NOTIFY THE CBR GROUP, FOR ANY DISCREPANCY FOR A REDESIGN.

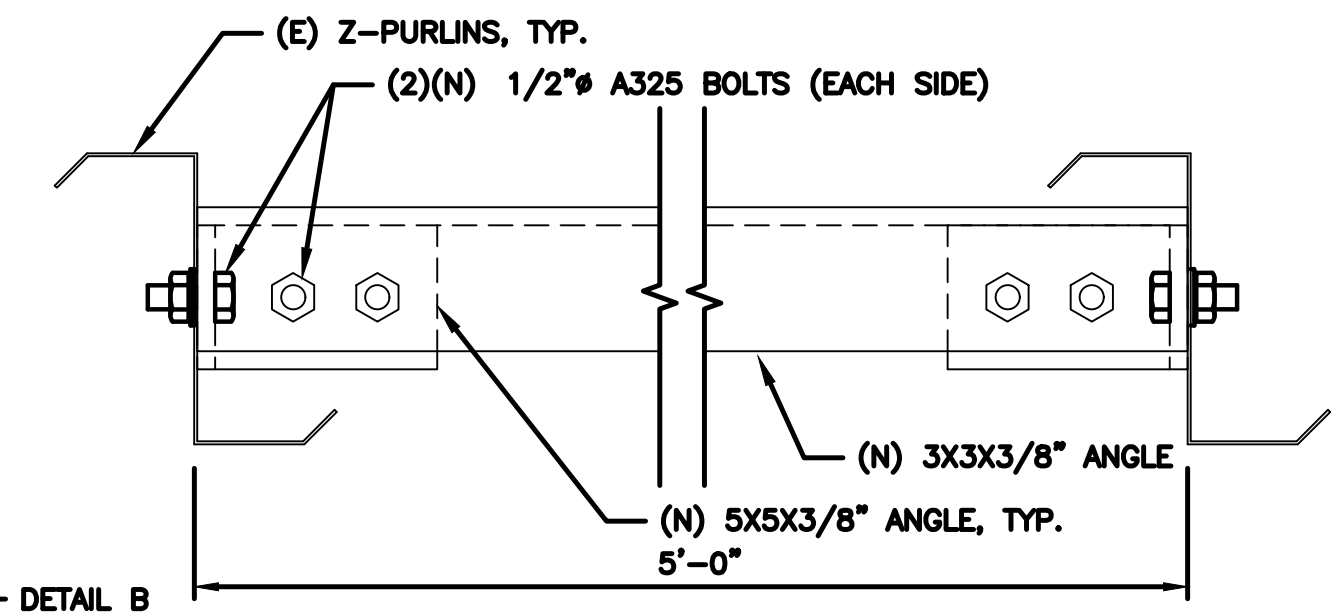

(ADD NEW ANGLE BRACES TO Z-PURLINS AT 1 FT EACH SIDE OF THE POINT OF THE FRAME CONNECTION, TYP.)



5701 SOUTH SANTA FE DRIVE
LITTLETON, CO 80120



2840 HOWE ROAD, SUITE E
MARTINEZ, CA 94553
www.TheCBRGroup.com



IT IS A VIOLATION OF LAW FOR ANY PERSON, UNLESS THEY ARE ACTING UNDER THE DIRECTION OF A LICENSED PROFESSIONAL ENGINEER, TO ALTER THIS DOCUMENT.

DRAWN BY: CHECKED BY: APPROVED BY:
JG/WM --- ---

RFDS REV #: 02/02/2022 REV 4

CONSTRUCTION DOCUMENTS

SUBMITTALS		
REV	DATE	DESCRIPTION
A	02/10/2022	90% CD'S ISSUED FOR REVIEW
B	04/19/2022	100% CONSTRUCTION DRAWINGS
C	06/11/2022	PLAN CHECK COMMENTS

A&E PROJECT NUMBER
SFSF001158A

DISH Wireless L.L.C.
PROJECT INFORMATION
SFSF001158A
1300 COMMERCE ST
PETALUMA, CA 94954





SHEET TITLE
STRUCTURAL DETAILS

SHEET NUMBER
S-1

NOTE:
WEATHER PROOF ALL WALL & ROOF PENETRATIONS AS REQUIRED, USING SILICON SEALANT, SO AS TO PREVENT WATER PENETRATION INTO BUILDING WALLS. ALL WEATHERPROOFING SHALL BE APPROVED BY OWNER ROOFING CONTRACTOR.

PROVIDED DIMENSIONS ARE FOR REFERENCE ONLY. BEFORE ANY FABRICATION CONTRACTOR SHALL FIELD VERIFY ALL NEW MEMBER DIMENSIONS FOR FIT & POSSIBLE INTERFERENCE

NOTE:
EXISTING BUILDING COLUMNS, BEAMS AND WALL TO BE FIELD LOCATED AND SIZE VERIFIED BY GC PRIOR TO ANY CONSTRUCTION & FABRICATION. PLEASE NOTIFY THE CBR GROUP, FOR ANY DISCREPANCY FOR A REDESIGN.

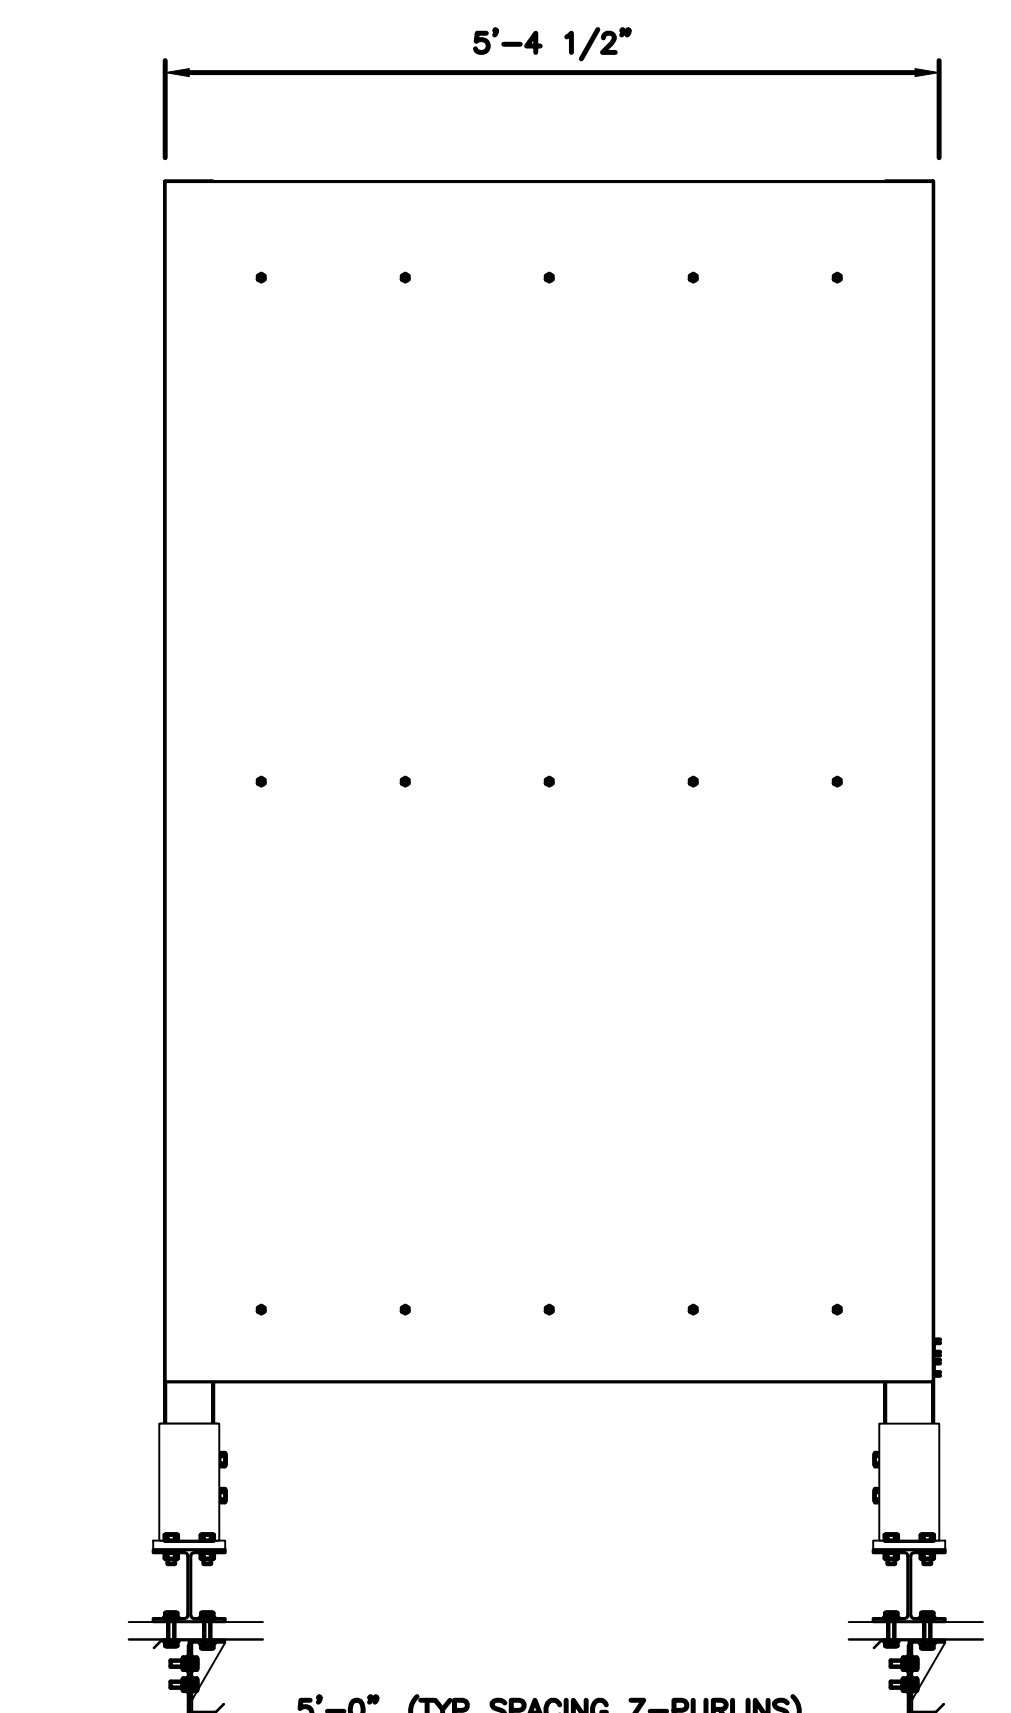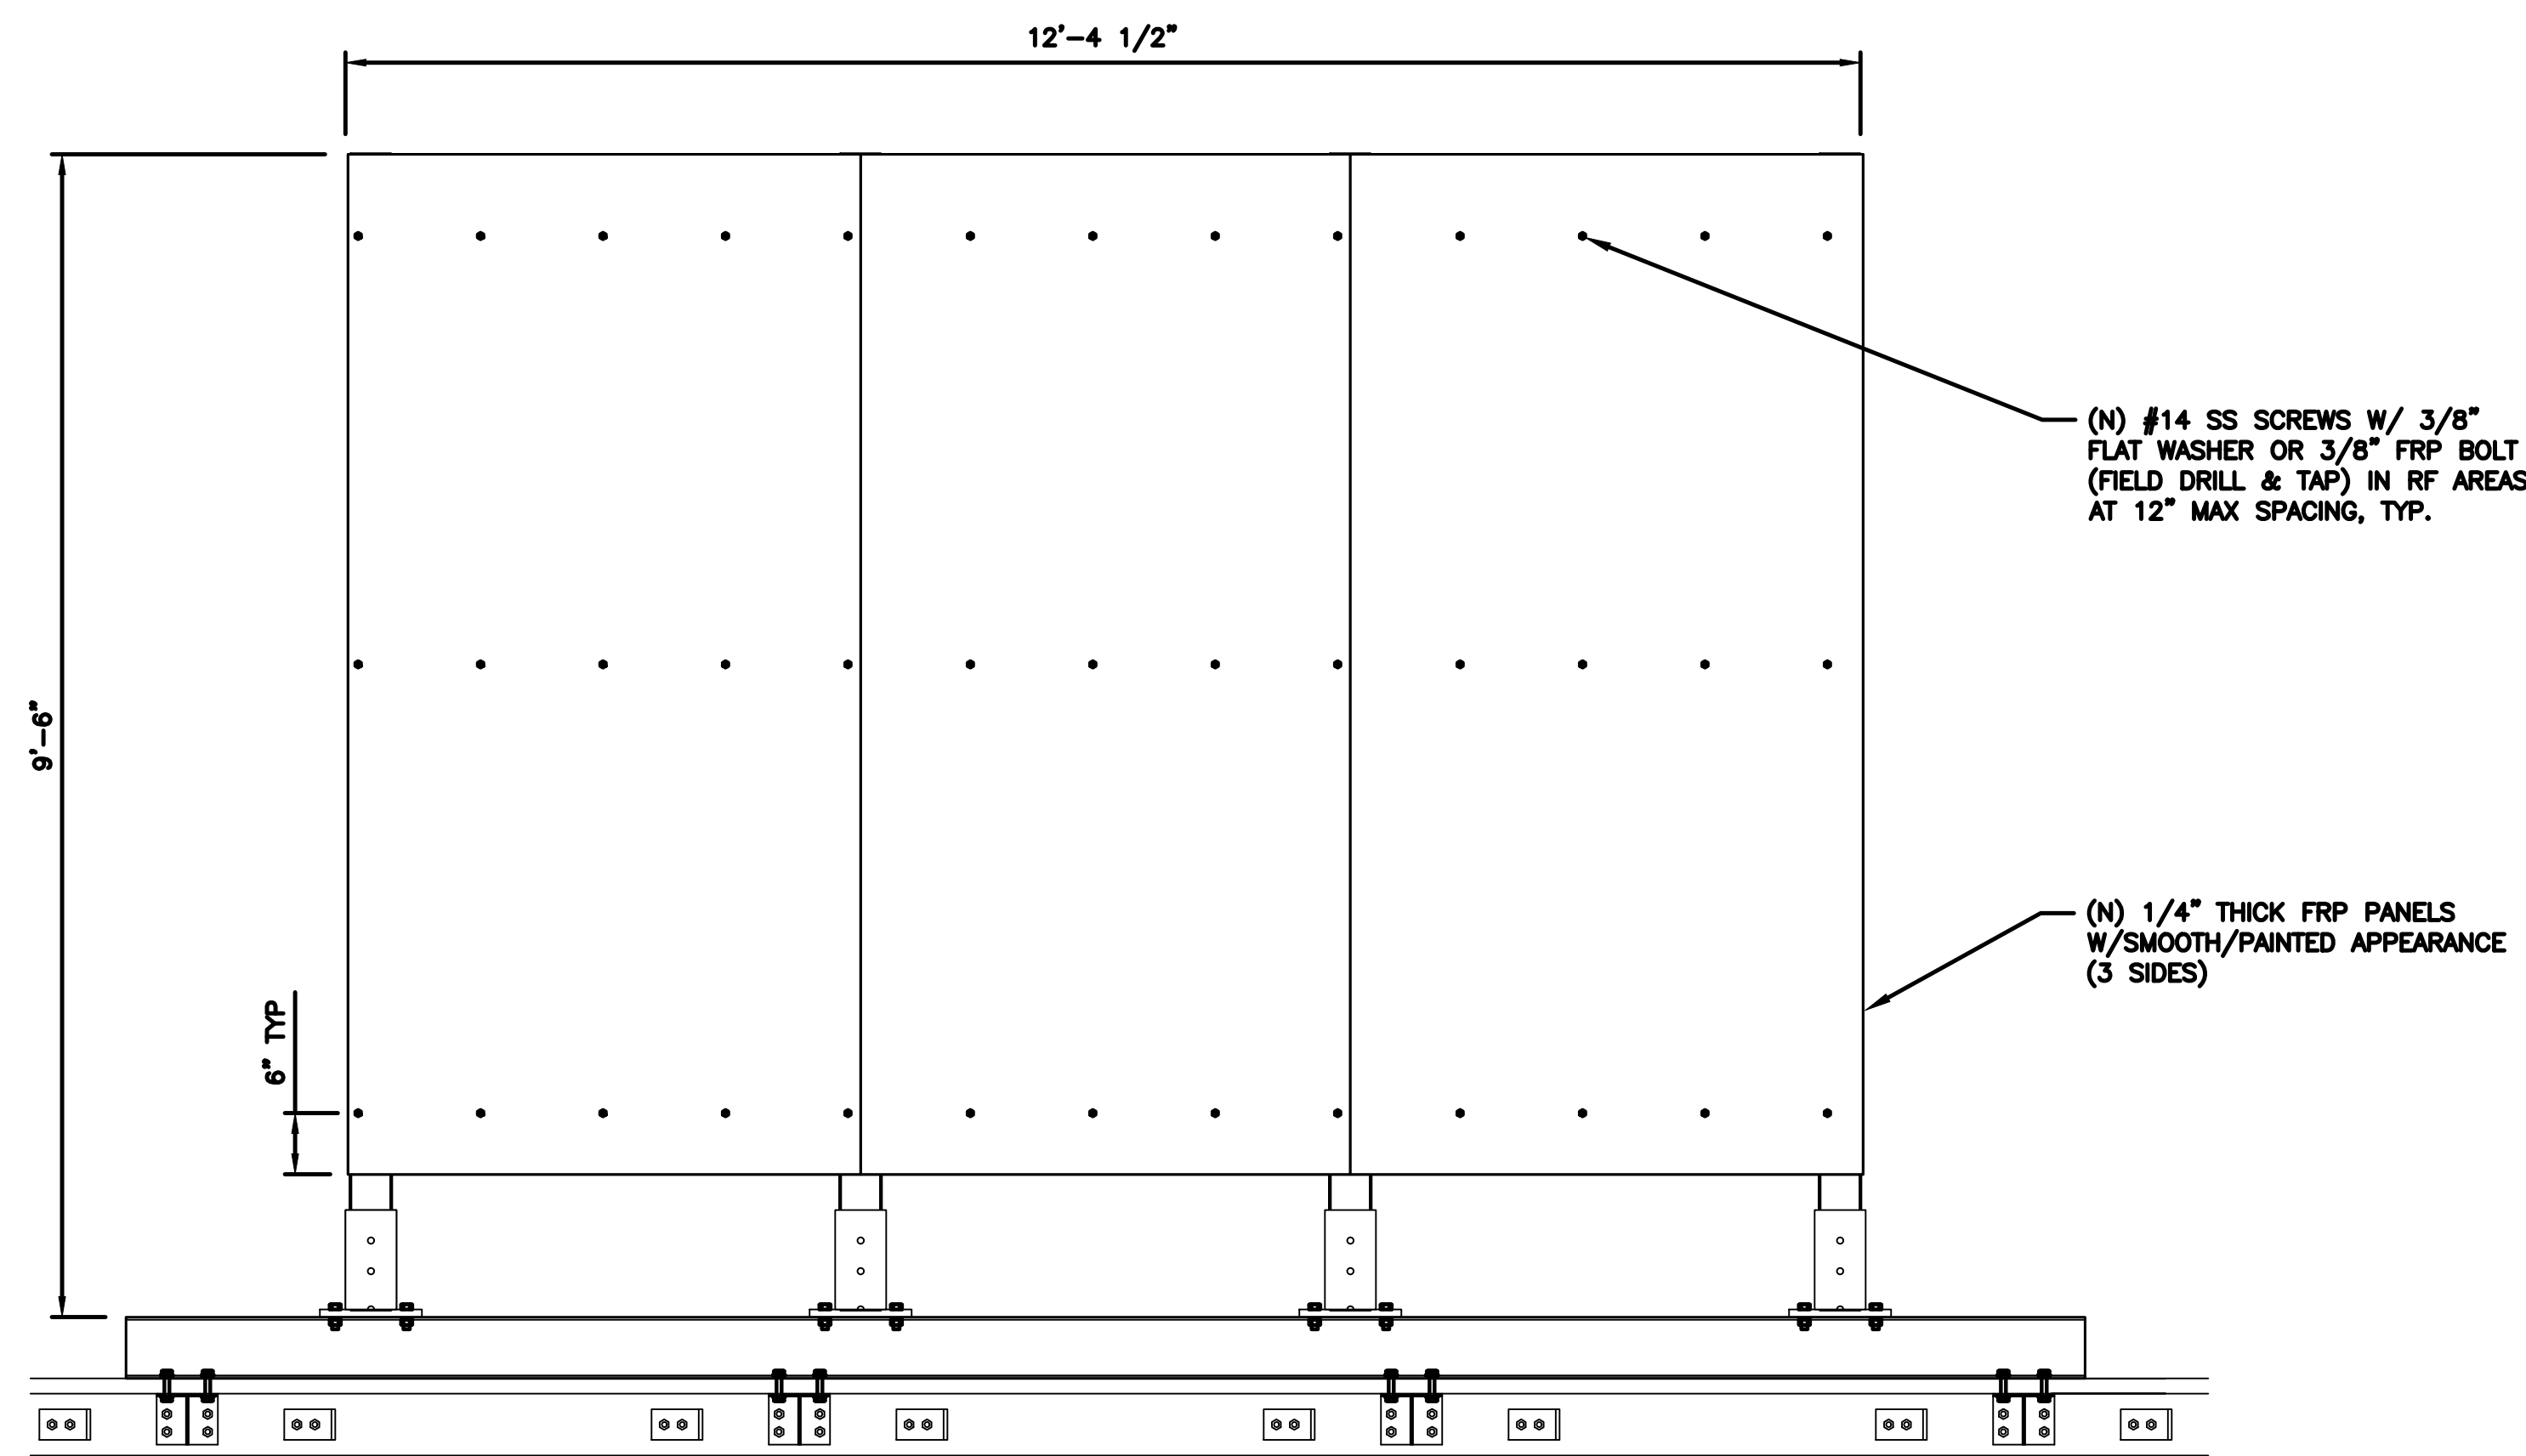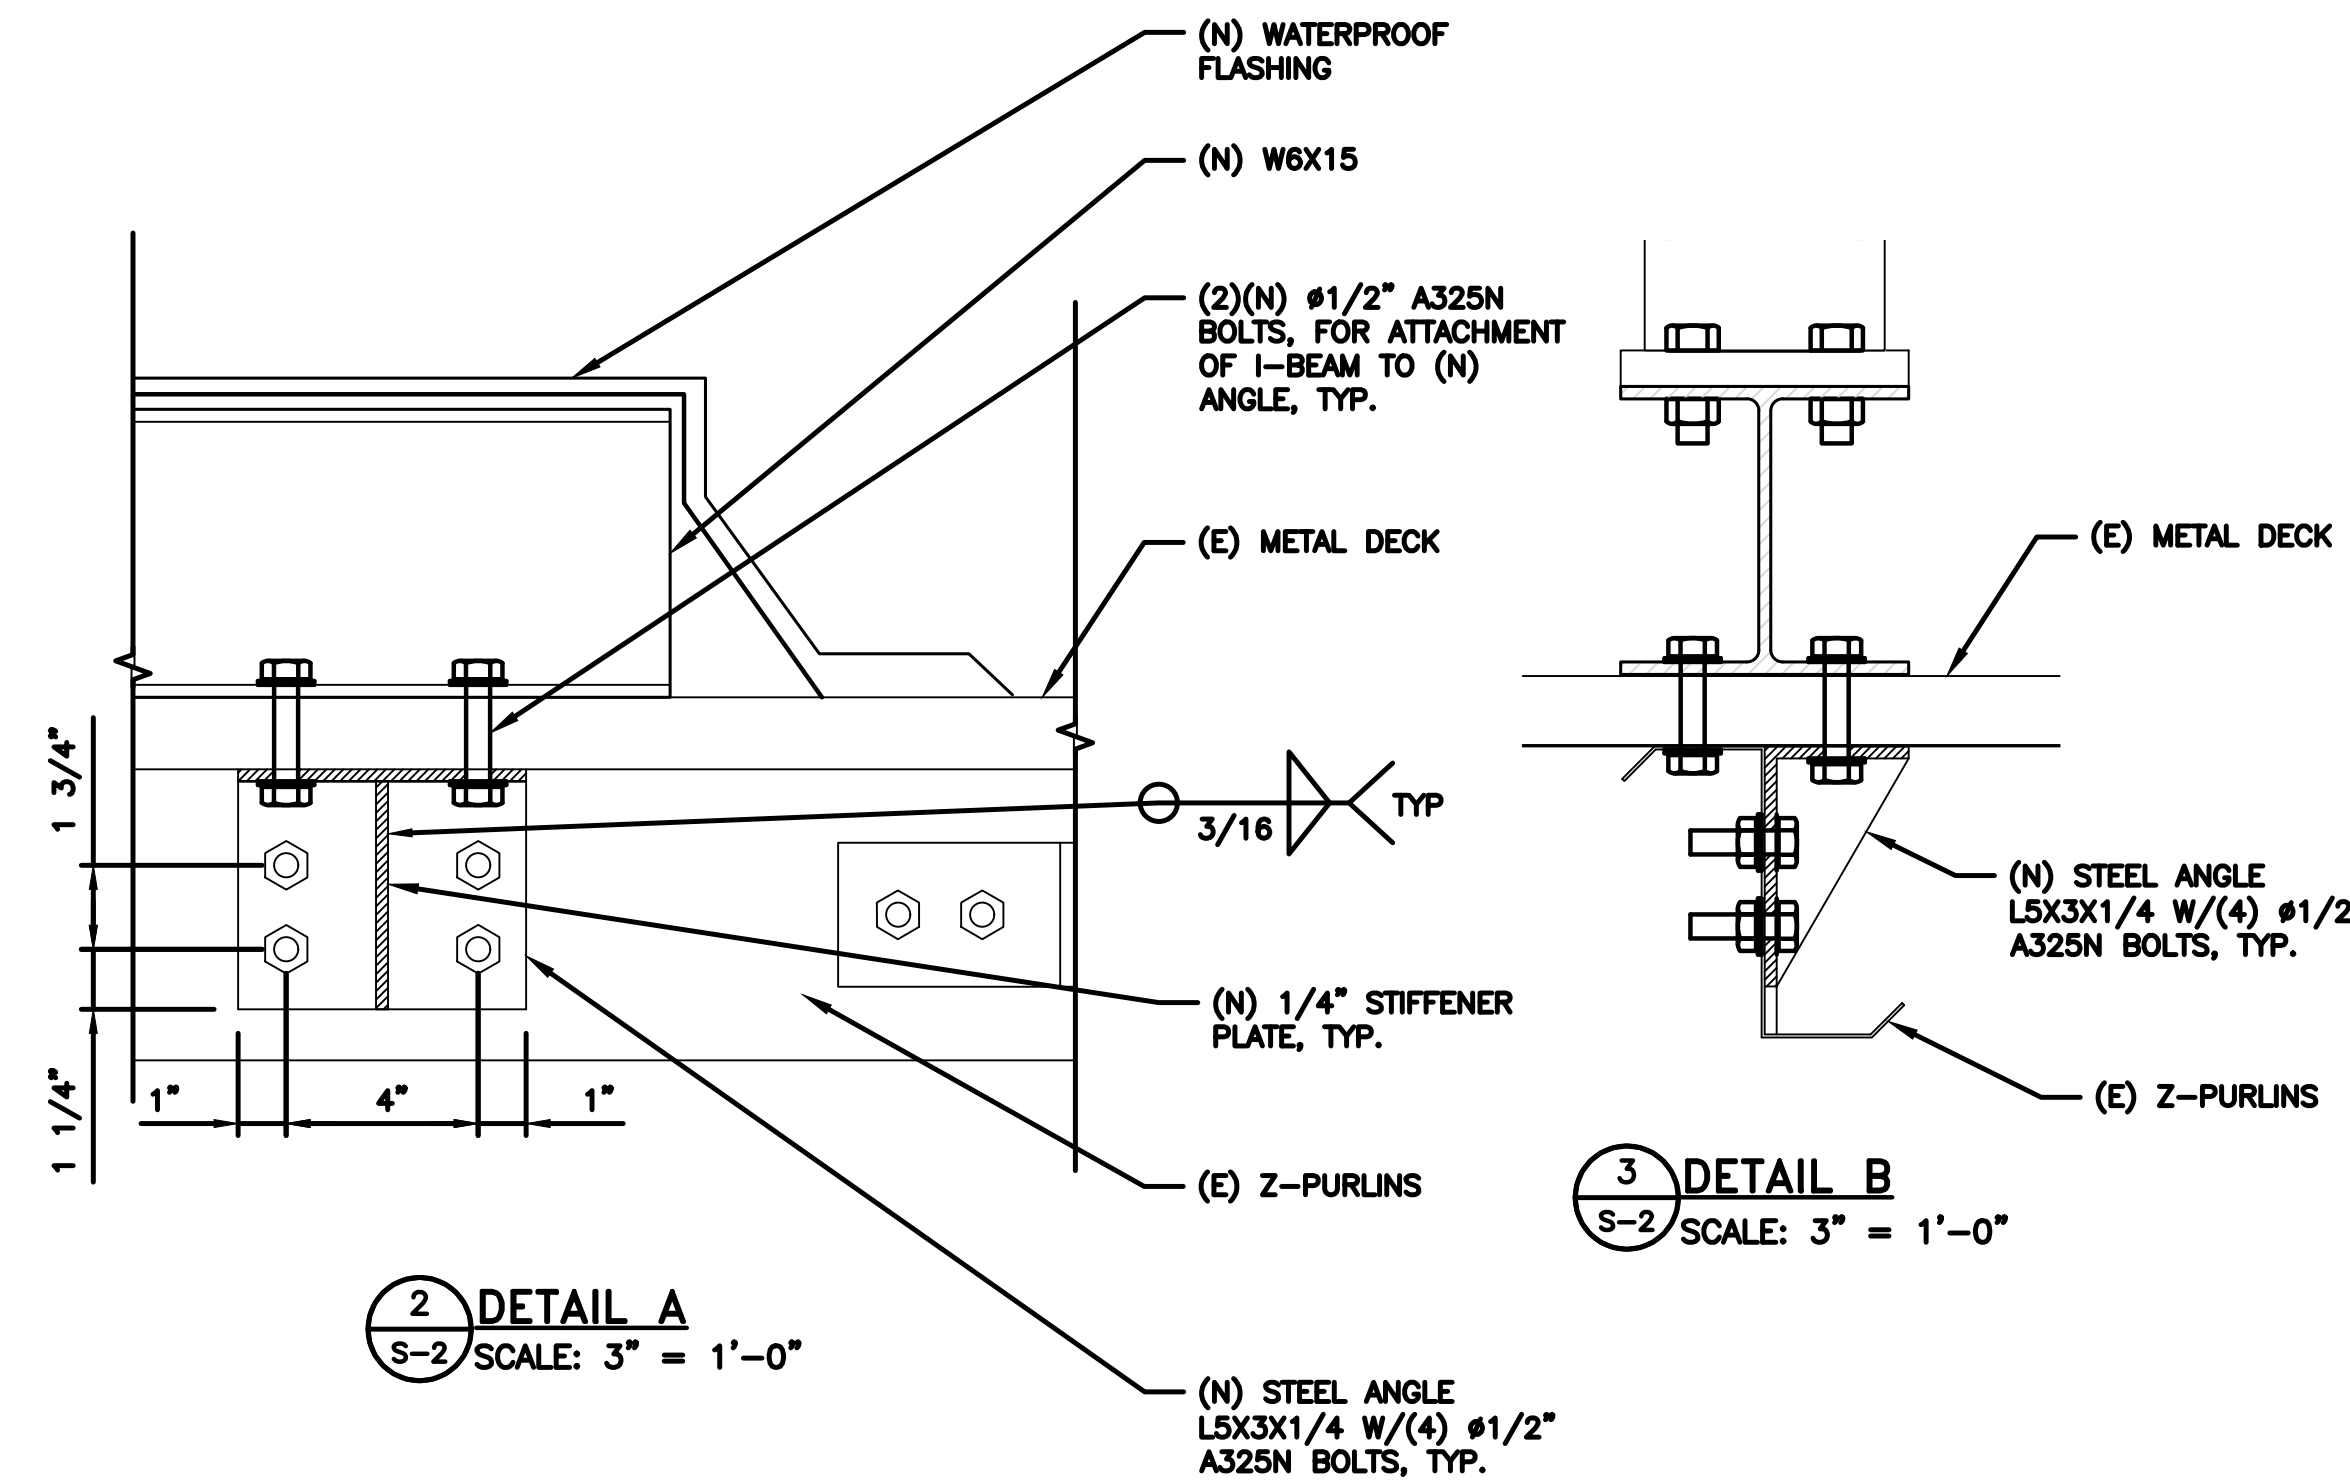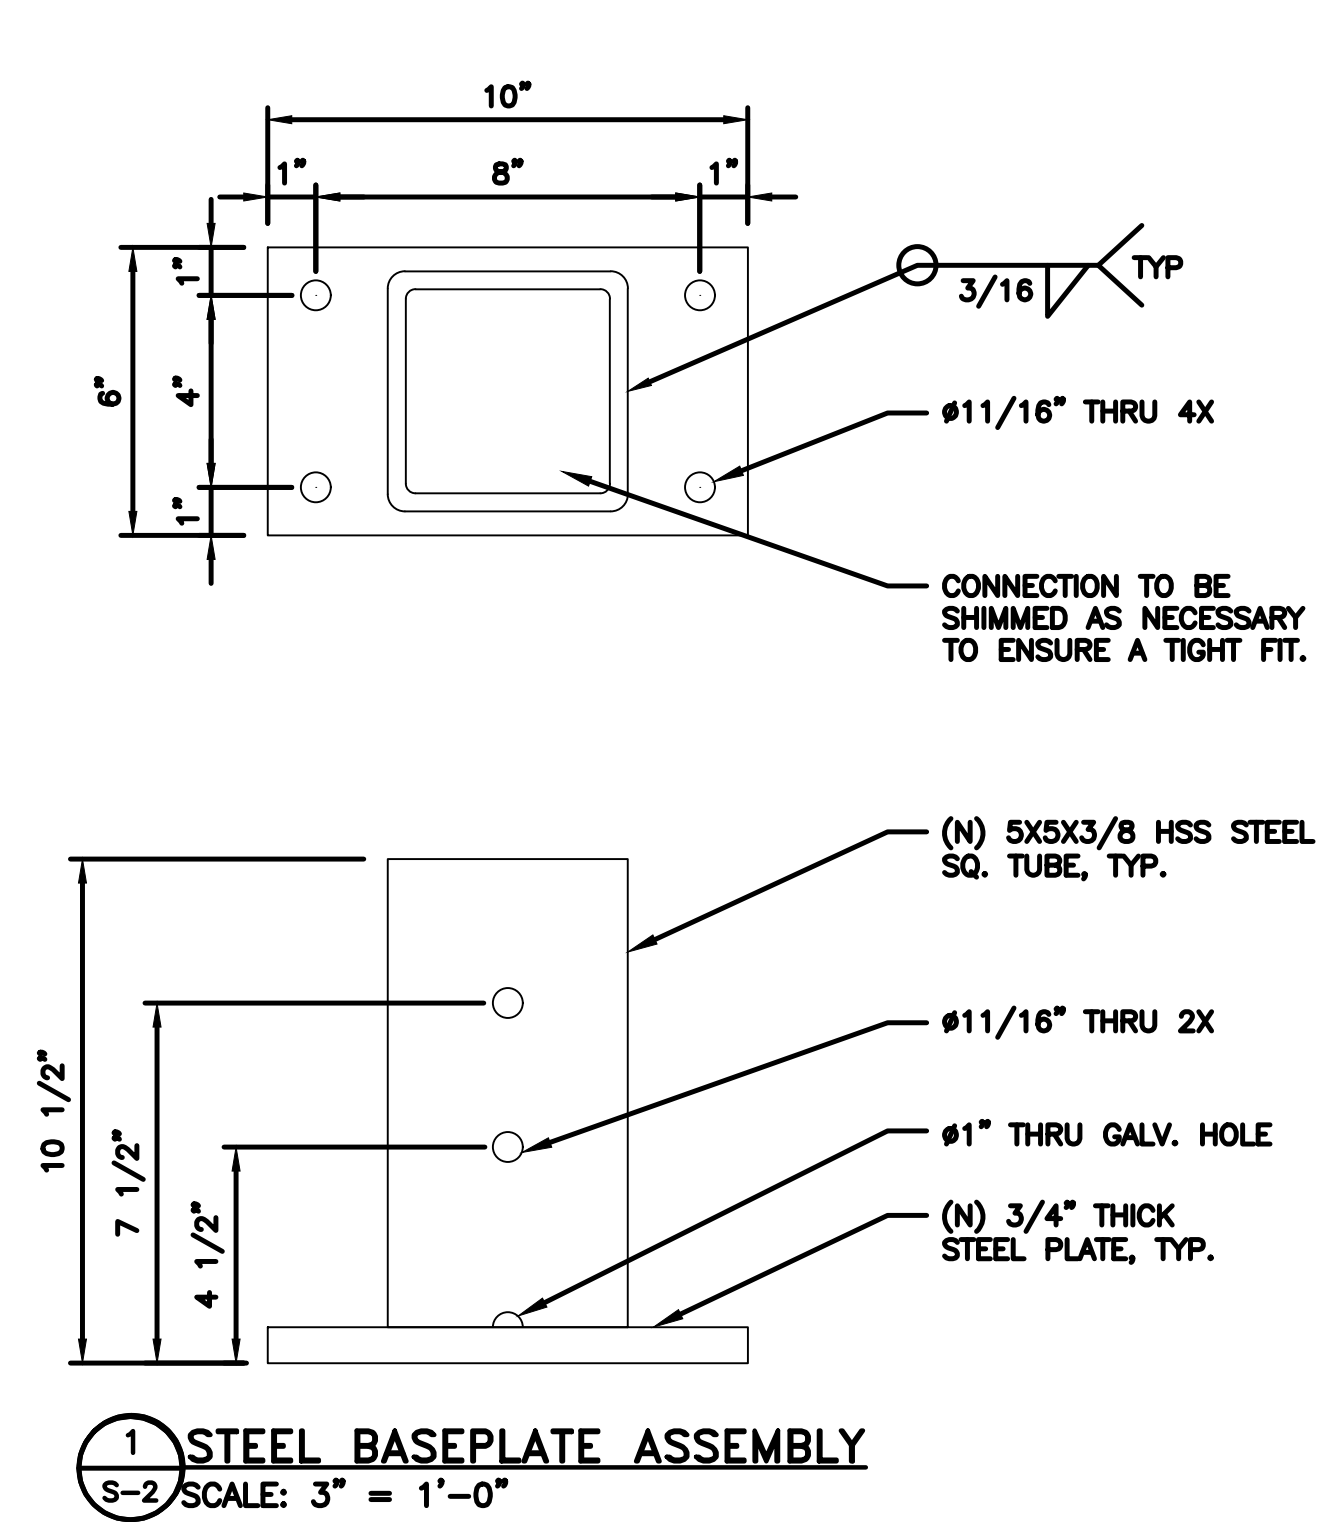


dish
wireless.

5701 SOUTH SANTA FE DRIVE
LITTLETON, CO 80120

THE CBR GROUP

2840 HOWE ROAD, SUITE E
MARTINEZ, CA 94553
www.TheCBRGroup.com

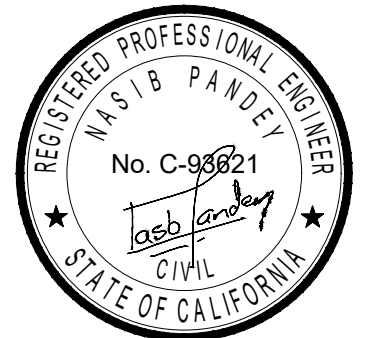

IT IS A VIOLATION OF LAW FOR ANY PERSON, UNLESS THEY ARE ACTING UNDER THE DIRECTION OF A LICENSED PROFESSIONAL ENGINEER, TO ALTER THIS DOCUMENT.

DRAWN BY: CHECKED BY: APPROVED BY:

JG/WM --- ---

RFDS REV #: 02/02/2022 REV 4

CONSTRUCTION DOCUMENTS

SUBMITTALS		
REV	DATE	DESCRIPTION
A	02/10/2022	90% CD'S ISSUED FOR REVIEW
B	04/19/2022	100% CONSTRUCTION DRAWINGS
C	06/11/2022	PLAN CHECK COMMENTS

A&E PROJECT NUMBER
SFSF001158A

DISH Wireless L.L.C.
PROJECT INFORMATION
SFSF001158A
1300 COMMERCE ST
PETALUMA, CA 94954


SHEET TITLE
STRUCTURAL DETAILS

SHEET NUMBER
S-2


NOTE:
WEATHER PROOF ALL WALL & ROOF PENETRATIONS AS REQUIRED, USING SILICON SEALANT, SO AS TO PREVENT WATER PENETRATION INTO BUILDING WALLS. ALL WEATHERPROOFING SHALL BE APPROVED BY OWNER ROOFING CONTRACTOR.

PROVIDED DIMENSIONS ARE FOR REFERENCE ONLY. BEFORE ANY FABRICATION CONTRACTOR SHALL FIELD VERIFY ALL NEW MEMBER DIMENSIONS FOR FIT & POSSIBLE INTERFERENCE


NOTE:
EXISTING BUILDING COLUMNS, BEAMS AND WALL TO BE FIELD LOCATED AND SIZE VERIFIED BY GC PRIOR TO ANY CONSTRUCTION & FABRICATION. PLEASE NOTIFY THE CBR GROUP, FOR ANY DISCREPANCY FOR A REDESIGN.

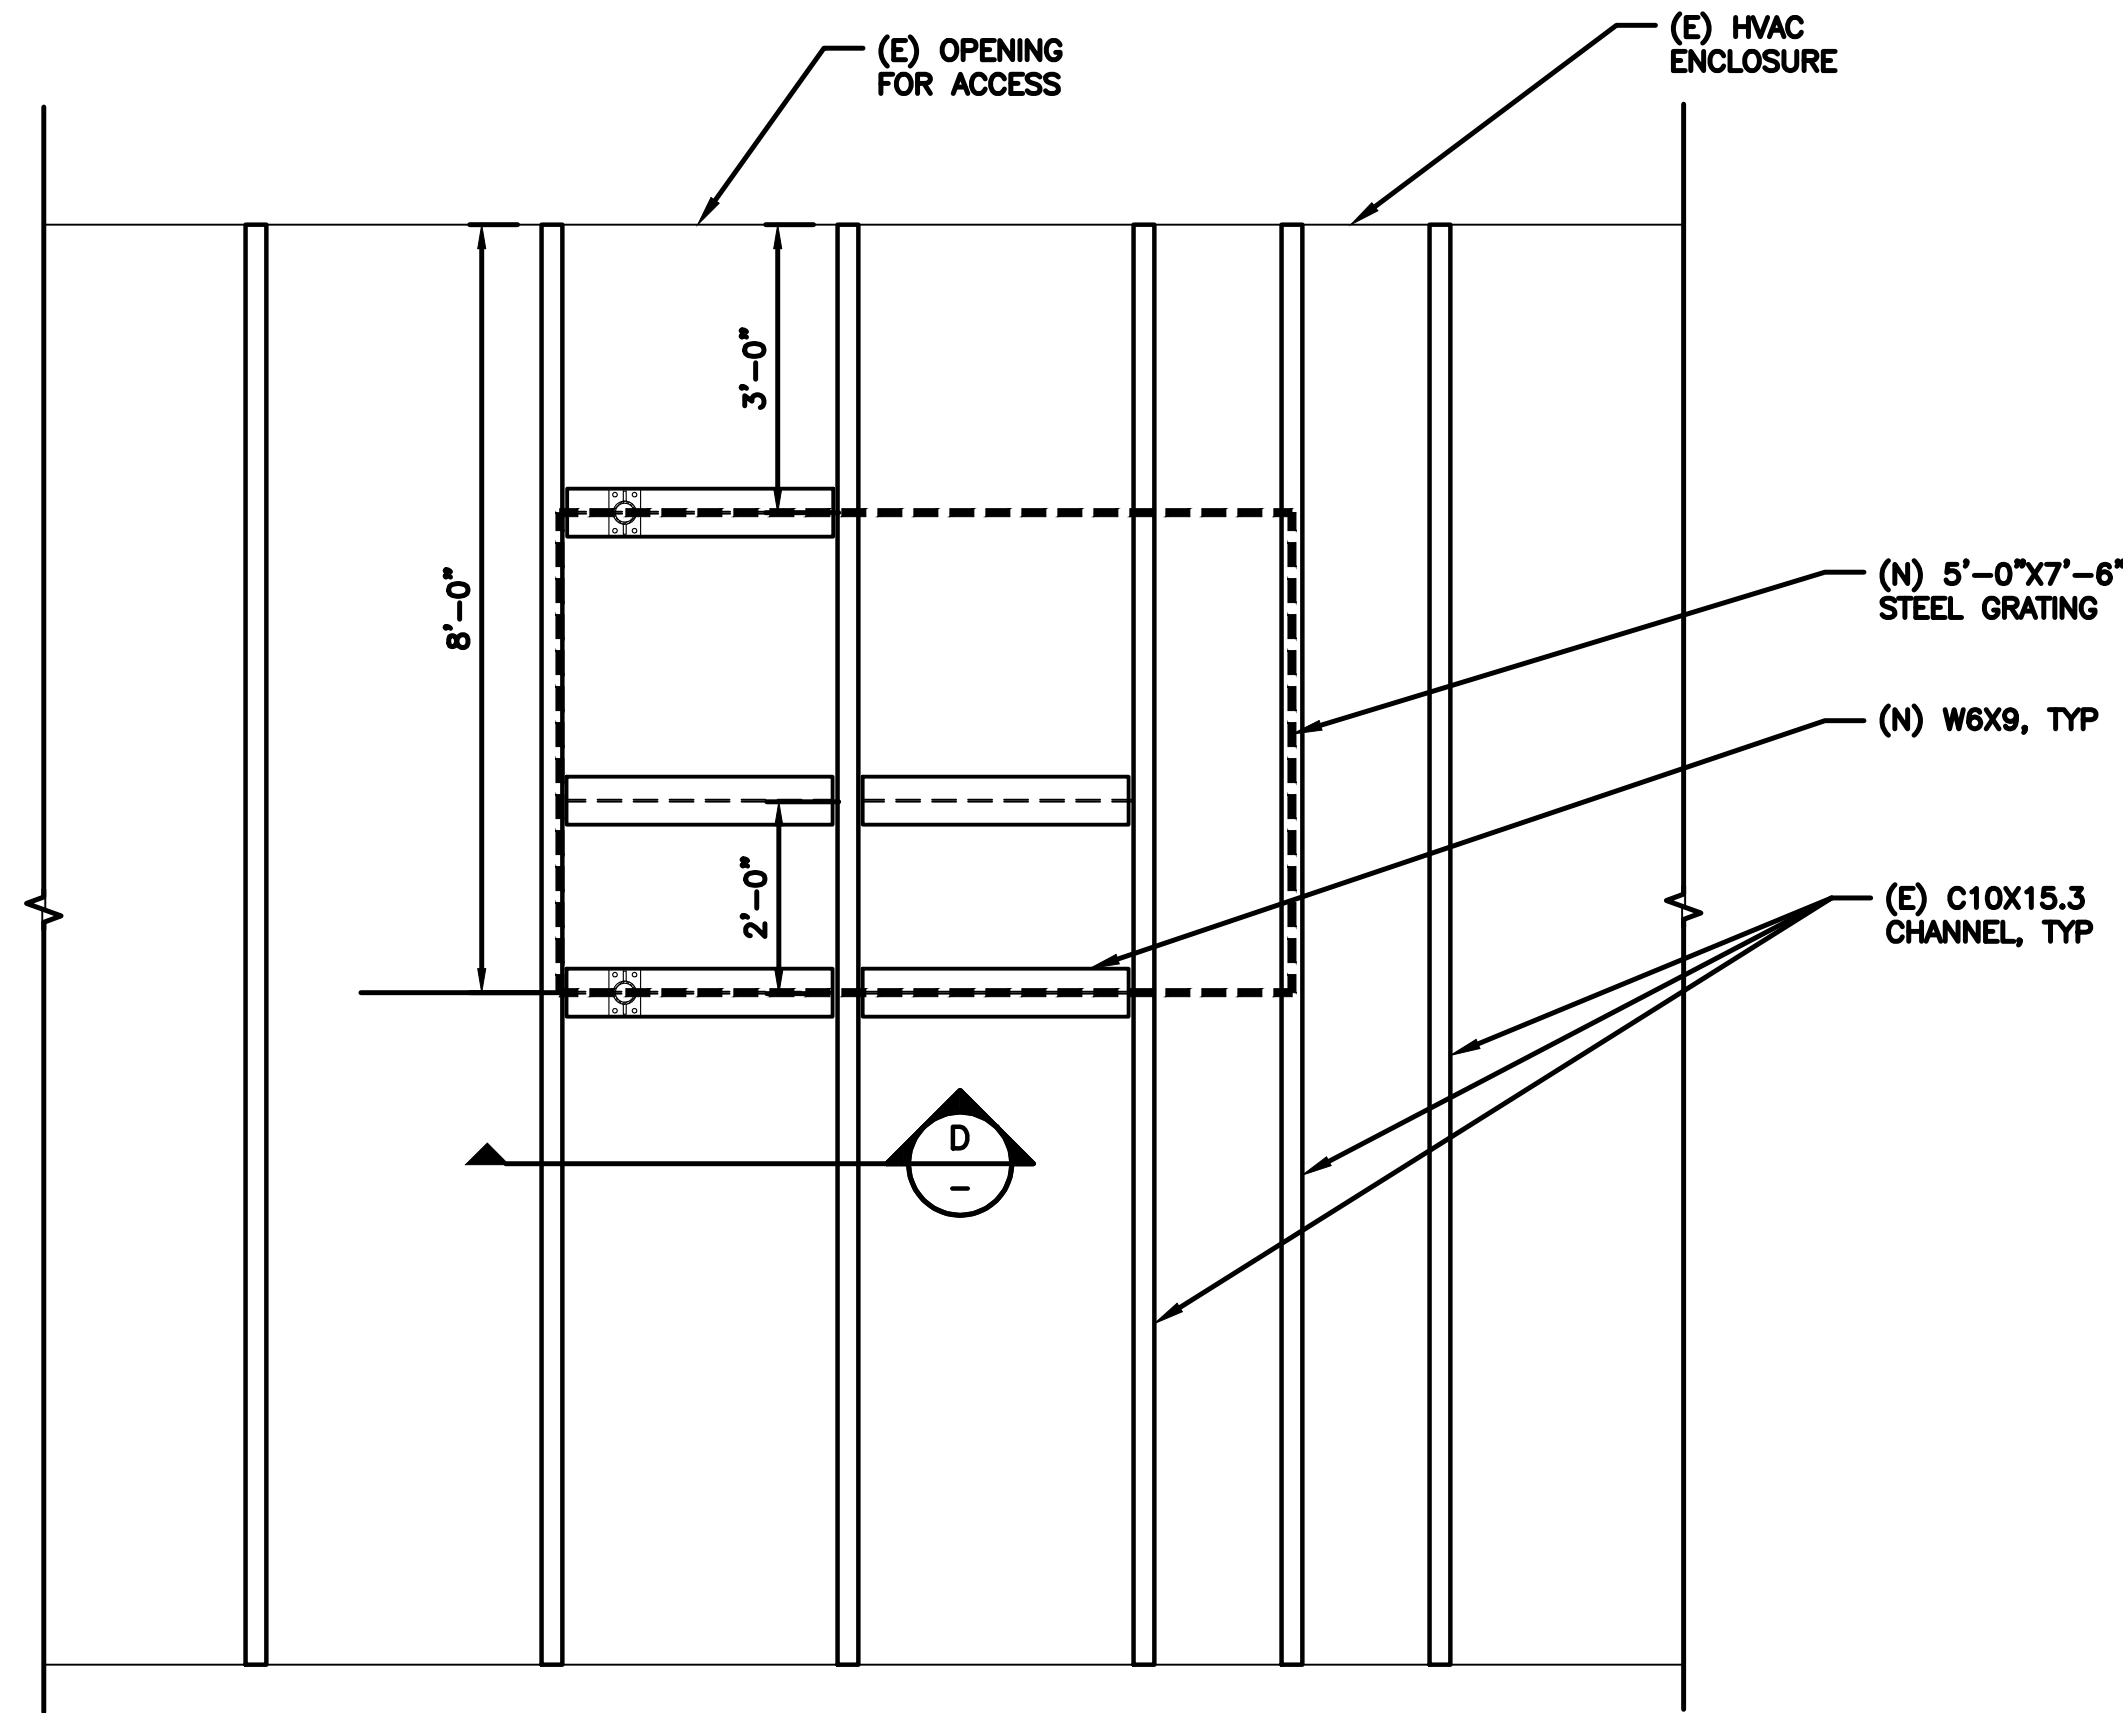




1 EQUIPMENT PLATFORM PLAN
S-3 SCALE: 1/2" = 1'-0"

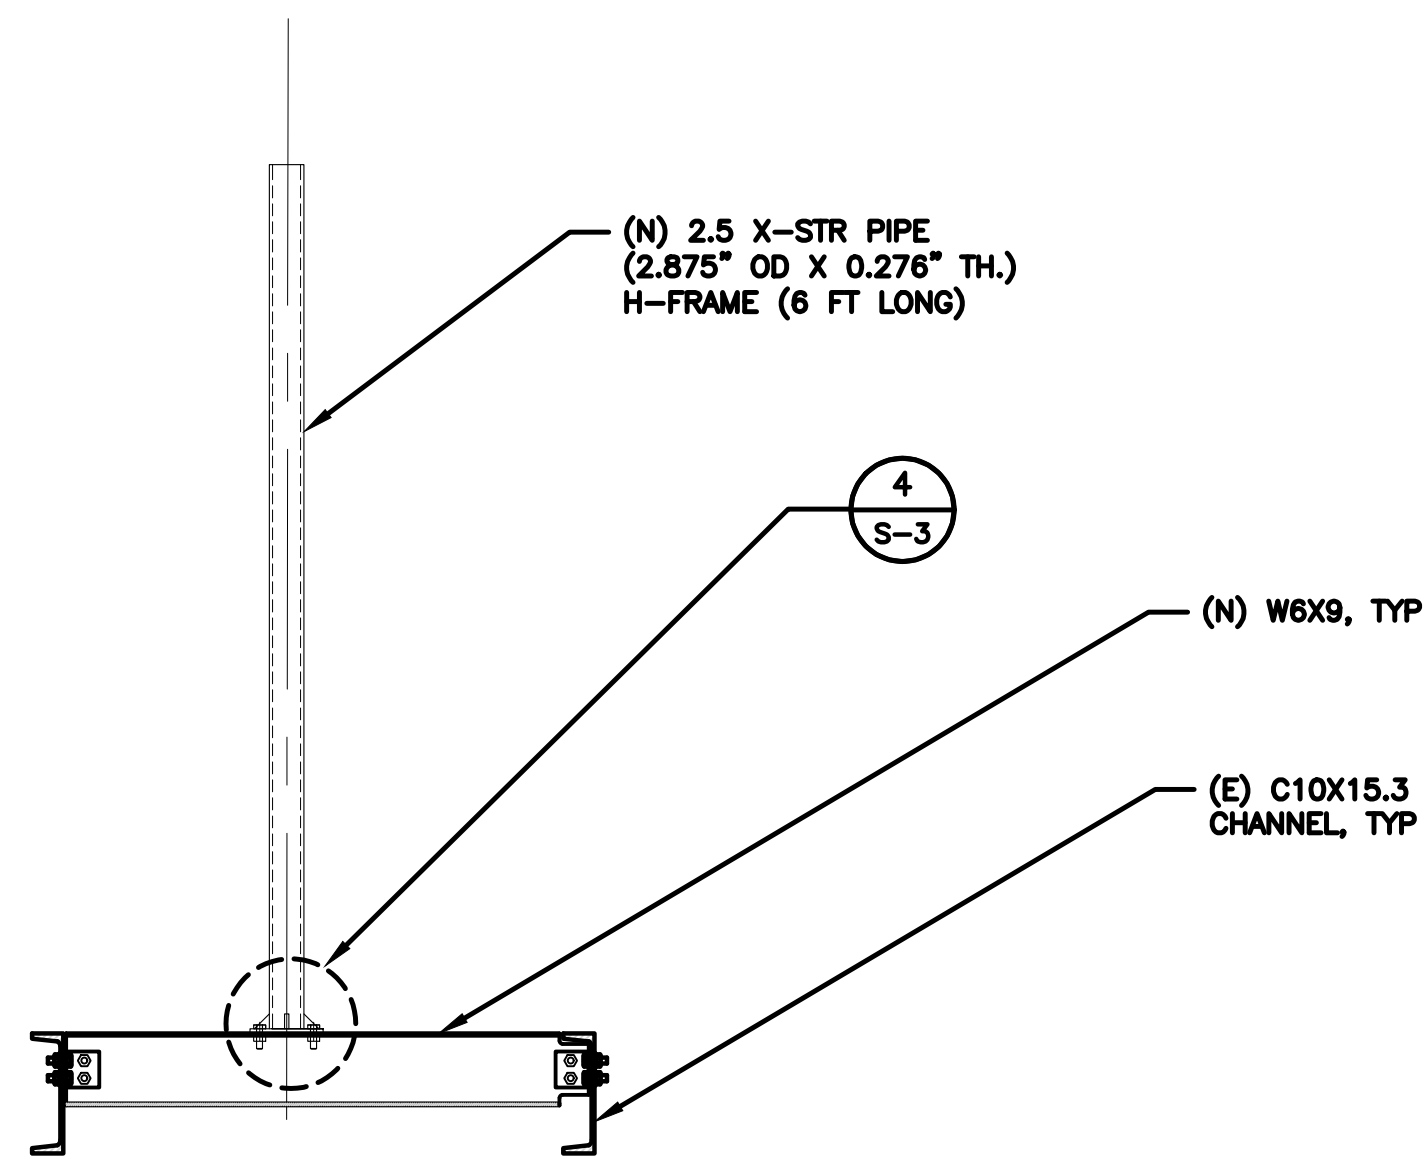

3 EQUIPMENT PLATFORM ELEVATION VIEW
S-3 SCALE: 3/4" = 1'-0"

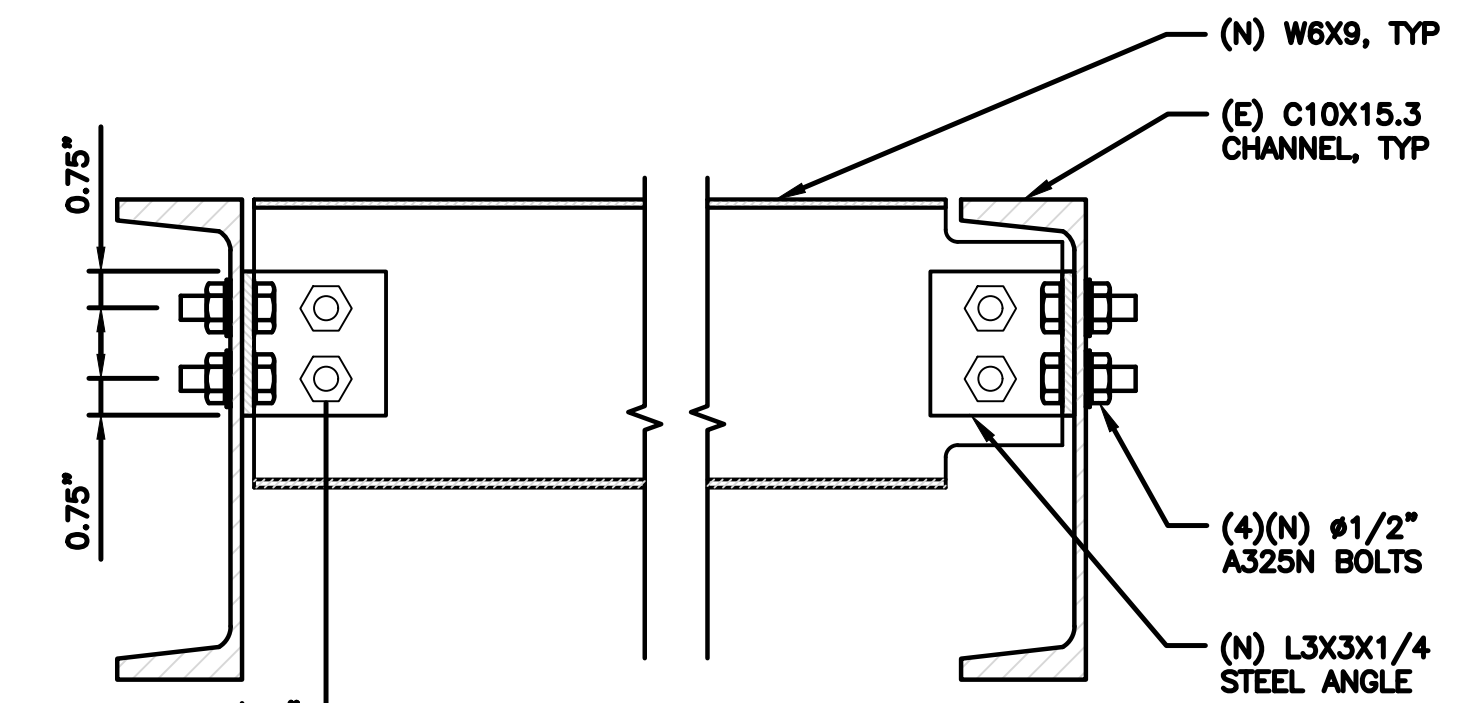

2 SECTION D-D
S-3 SCALE: 3" = 1'-0"

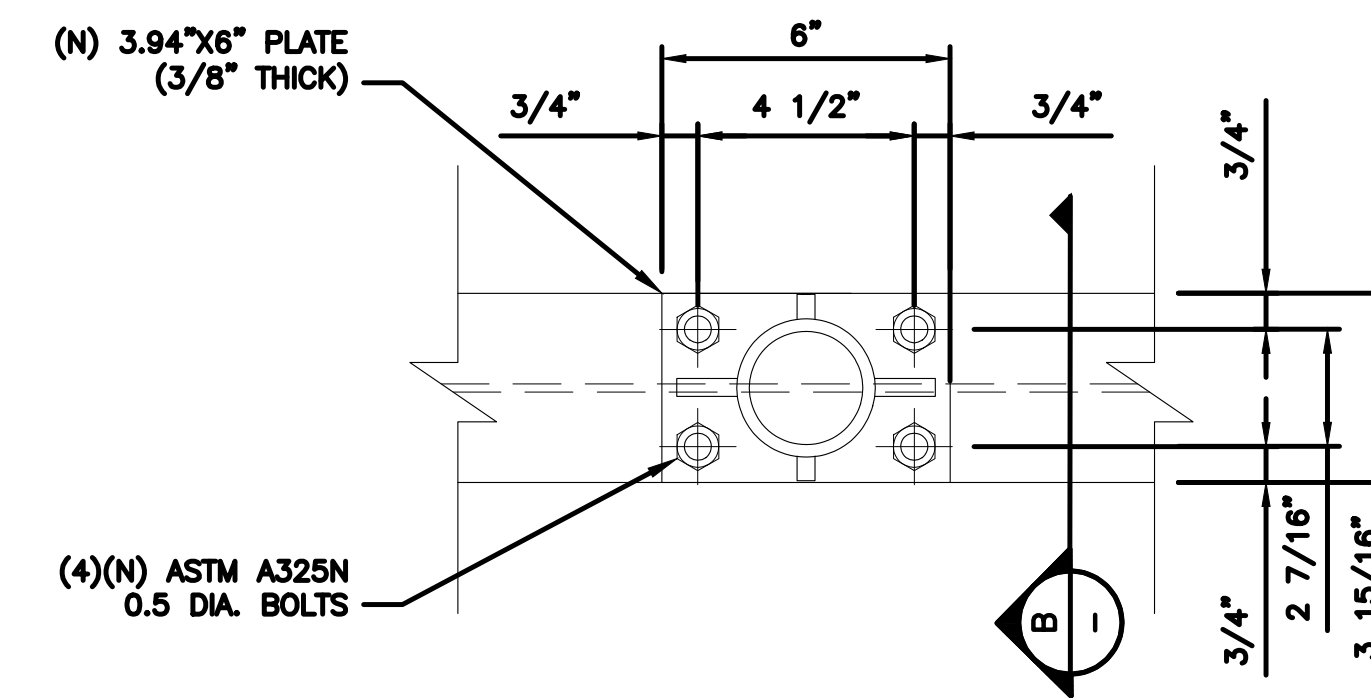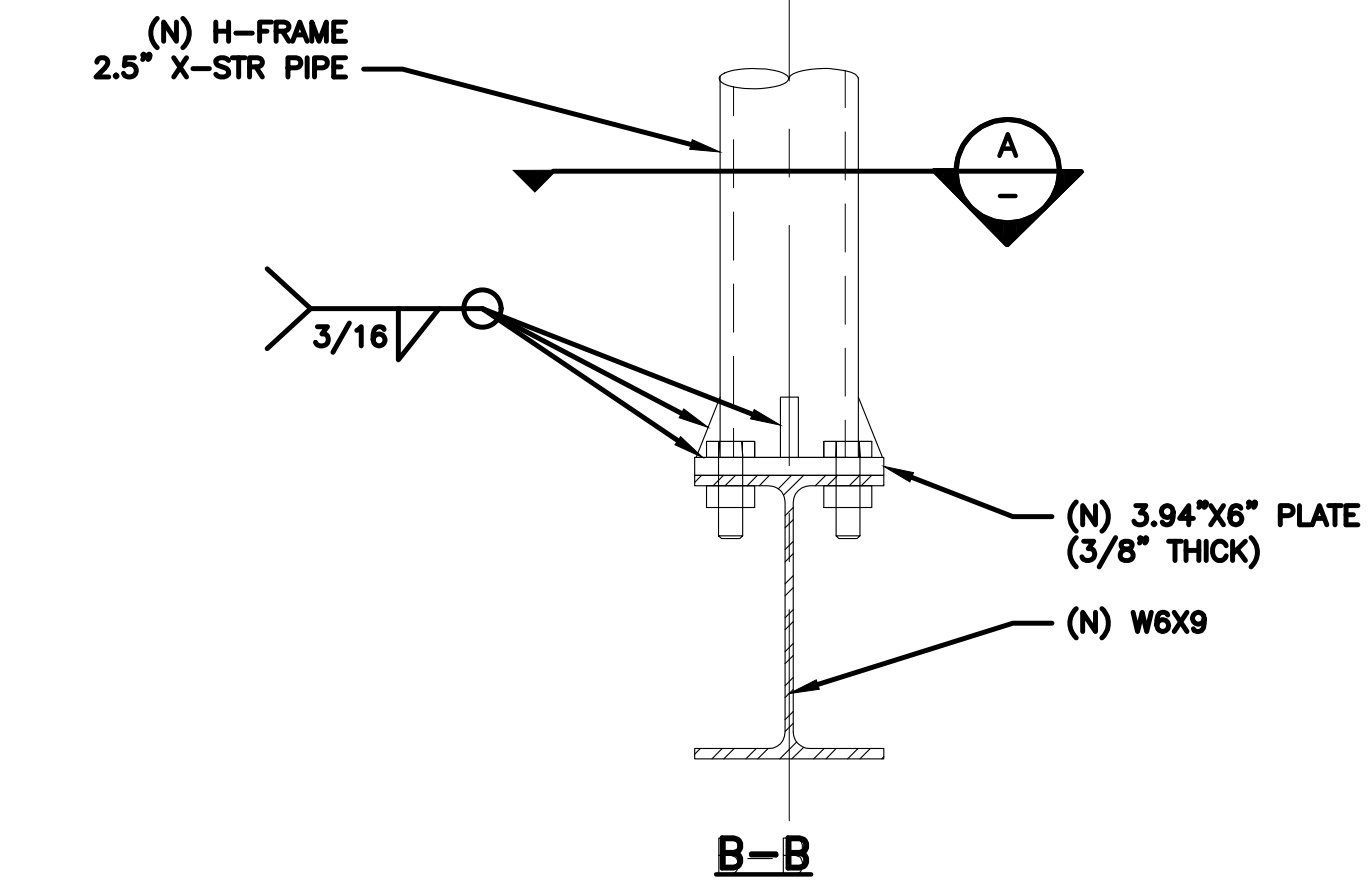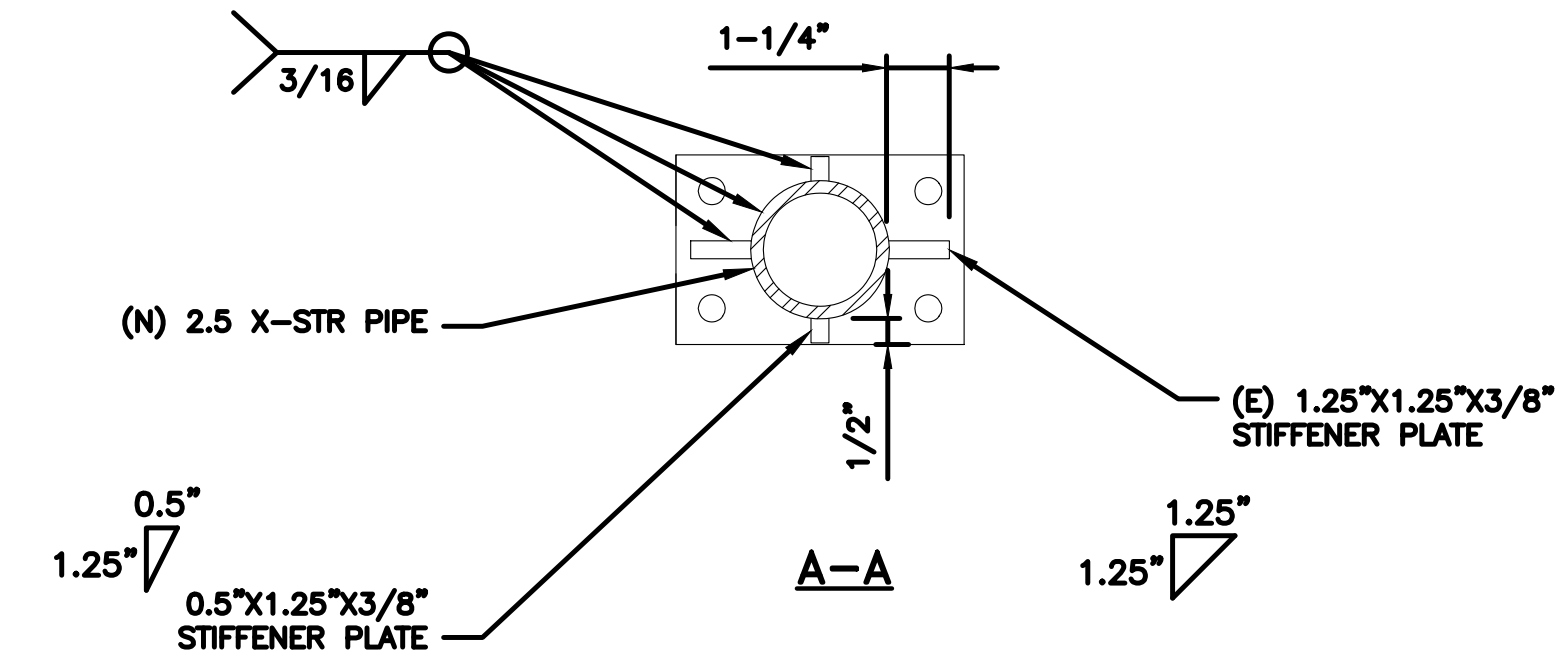


4 H-FRAME PIPE CONNECTION DETAILS
S-3 SCALE: 3" = 1'-0"

dish wireless.

5701 SOUTH SANTA FE DRIVE
LITTLETON, CO 80120

THE CBR GROUP

2840 HOWE ROAD, SUITE E
MARTINEZ, CA 94553
www.TheCBRGroup.com

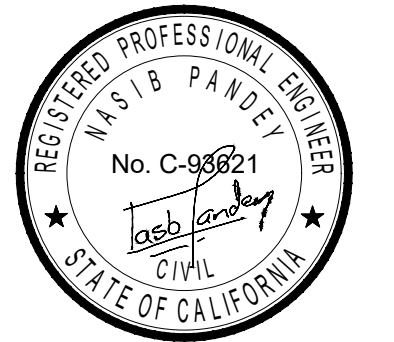

IT IS A VIOLATION OF LAW FOR ANY PERSON, UNLESS THEY ARE ACTING UNDER THE DIRECTION OF A LICENSED PROFESSIONAL ENGINEER, TO ALTER THIS DOCUMENT.

DRAWN BY: CHECKED BY: APPROVED BY:
JG/WM --- ---

RFDS REV #: 02/02/2022 REV 4

CONSTRUCTION DOCUMENTS

SUBMITTALS		
REV	DATE	DESCRIPTION
A	02/10/2022	90% CD'S ISSUED FOR REVIEW
B	04/19/2022	100% CONSTRUCTION DRAWINGS
C	06/11/2022	PLAN CHECK COMMENTS

A&E PROJECT NUMBER
SFSF001158A

DISH Wireless L.L.C.
PROJECT INFORMATION

SFSF001158A
1300 COMMERCE ST
PETALUMA, CA 94954

SHEET TITLE
STRUCTURAL DETAILS

SHEET NUMBER

S-3

DESIGN NOTES

- SS: 1,559
- S1: 0.6
- SDS: 1,247
- RISK CATEGORY: II
- IMPORTANCE FACTOR: I
- ULTIMATE WIND SPEED (ASCE 7-16): 91 MPH
- ROOF DEAD LOAD: 5PSF
- ROOFTOP DATA AS PER ORIGINAL BUILDING DRAWINGS BY JAMES GOODMAN ARCHITECTURE, PROJECT# 9917, DATED 10/13/2000

STRUCTURAL STEEL

1. ALL STEEL WORK SHALL BE ACCORDANCE WITH STEEL CONSTRUCTION MANUAL, 15th EDITION AND ALL EXTERIOR EXPOSED STEEL AND HARDWARE SHALL BE HOT DIP GALVANIZED. FILL MODIFICATIONS ARE TO BE COATED WITH ZINC ENRICHED PAINTED.
2. NON-STRUCTURAL CONNECTIONS FOR STEEL GRATING MAY USE 5/8" DIA. ASTM A307 BOLTS UNLESS NOTED OTHERWISE. BOLTED CONNECTIONS SHALL BE ASTM A325 BEARING TYP 3/4" DIA. CONNECTIONS AND SHALL BE HAVE MINIMUM OF TWO BOLTS UNLESS NOTED OTHERWISE.
3. ALL STEEL CONSTRUCTION INCLUDING FABRICATION, ERECTION AND MATERIALS SHALL COMPLY WITH ALL REQUIREMENTS OF THE AISC SPECIFICATION FOR THE DESIGN, FABRICATION, AND ERECTION OF STRUCTURAL STEEL FOR BUILDINGS AND THE 2019 CBC.
4. STRUCTURAL STEEL MEMBERS SHALL CONFORM TO THE FOLLOWING SPECIFICATIONS UNLESS OTHERWISE NOTED (U.O.N.):
 - A. WIDE FLANGE & TEE SHAPES, ASTM A992 (Fy=50,000 PSI)
 - B. STRUCTURAL TUBING (TS OR HSS), ASTM A500 GRADE B (Fy=46,000 PSI)
 - C. STEEL PIPE, ASTM A53 (TYPE E OR S, GRADE B (Fy=35,000 PSI)) SCHEDULE 40 WITH OUTSIDE DIAMETERS GIVEN.
 - D. ALL STRUCTURAL STEEL, ASTM A36.
5. ALL WELDING SHALL BE PERFORMED USING E70XX ELECTRODES AND SHALL CONFORM TO AISC & AWS D1.1. WHERE FILLET WELD SIZES ARE NOT SHOWN PROVIDE THE MINIMUM SIZE PER TABLE J2.4 IN THE AISC SPECIFICATION. PAINTED SURFACES SHALL BE TOUCHED UP. WELDING SHALL CONFORM TO AISC AND THE LATEST EDITION OF AWS D1.1. WHERE FILLET WELD SIZES ARE NOT SHOWN, PROVIDE THE MINIMUM SIZE PER TABLE J2.4 IN THE AISC "MANUAL OF STEEL CONSTRUCTION" PAINTED SURFACES SHALL BE TOUCHED UP.
6. ALL WELDING SHALL BE PERFORMED BY QUALIFIED, CERTIFIED WELDERS.
7. BOLTS SHALL BE ASTM A307 GRADE A MINIMUM AND HOT DIP GALVANIZED PER ASTM A153. BOLTED CONNECTIONS SHALL BE BEARING TYPE. SEE PLANS FOR LOCATION, NUMBER, AND SIZE OF BOLTS. SPECIAL INSPECTION NOT REQUIRED U.O.N.
8. THREADED RODS SHALL BE ASTM F593 CW 304 /316 STAINLESS STEEL. BOLTED CONNECTIONS SHALL BE BEARING TYPE. SEE PLANS FOR LOCATION, NUMBER, & SIZE OF BOLTS.
9. ALL HOLES FOR BOLTED CONNECTIONS SHALL BE 1/16" LARGER THAN THE NOMINAL BOLT DIAMETER. USE STANDARD AISC GAGE AND PITCH FOR BOLTS EXCEPT AS NOTED OTHERWISE. HOLES FOR ANCHOR BOLTS IN BASE PLATES MAY BE AISC "OVERSIZE" HOLES WHERE ACCOMPANIED BY OVERSIZED HARDENED HOT DIP GALVANIZED WASHERS.
10. ALL SHOP FABRICATED STEEL STRUCTURAL MEMBERS FOR EXTERIOR USE SHALL BE HOT DIP GALVANIZED PER ASTM A123 AFTER FABRICATION & PAINTED PER CUSTOMER SPECIFICATIONS AS REQUIRED. STEEL FOR INTERIOR USE SHALL BE SHOP COAT OR GALVANIZED & PAINTED PER PLAN.
11. ALL FIELD FABRICATED GALVANIZED STEEL THAT IS CUT, GROUND, DRILLED, WELDED OR DAMAGED SHALL BE TREATED WITH "ZINC RICH" COLD GALVANIZING SPRAY OR COATING. NO RAW STEEL SHALL BE EXPOSED.

CONCRETE AND REINFORCEMENT STEEL

1. ALL CONCRETE WORK SHALL BE IN ACCORDANCE WITH ACI 318-14, ACI 301-16 AND THE CAST-IN-PLACE CONCRETE SPECIFICATIONS.
2. ALL CONCRETE SHALL HAVE A MINIMUM COMPRESSIVE STRENGTH OF 2,500 PSI AT 28 DAYS UNLESS NOTED OTHERWISE.
3. WELDED WIRE FABRIC SHALL CONFORM TO ASTM A185 WELDED STEEL WIRE FABRIC UNLESS NOTED OTHER.
4. REINFORCING STEEL SHALL CONFORM TO ASTM A615, GRADE 60, UNLESS NOTED OTHERWISE.
5. SPLICES CLASS "B" AND ALL HOOKS SHALL BE STANDARD UNLESS NOTED OTHERWISE.
6. A 3/4" CHAMFER SHALL BE PROVIDED AT ALL EXPOSED EDGES OF CONCRETE U.O.N. IN ACCORDANCE WITH ACI 301 SECTION 4.2.4.
7. CONCRETE COVER FOR REINFORCEMENT STEEL SHALL BE ACCORDING TO ACI 318-14, TABLE 20.6.1.3.1:

CONCRETE EXPOSURE	MEMBER	REINFORCEMENT	SPECIFIED COVER, IN.
CAST AGAINST AND PERMANENTLY IN CONTACT WITH GROUND	ALL	ALL	3
EXPOSED TO WETHER OR IN CONTACT WITH GROUND	ALL	NO.6 THROUGH NO.18 BARS	2
		NO. 5 BAR, W31 OR D31 WIRE, AND SMALLER	1-1/2
NOT EXPOSED TO WEATHER OR IN CONTACT WITH GROUND	SLABS, JOISTS, AND WALLS	NO. 14 AND NO.18 BARS	1-1/2
		NO.11 BAR AND SMALLER	3/4
	BEAMS, COLUMNS PEDESTALS, AND TENSION TIES	PRIMARY REINFORCEMENT, STIRRUPS, TIES, SPIRALS, AND HOOPS	1-1/2

EXPANSION AND EPOXY ANCHOR NOTES

1. ALL ANCHORS PROVIDED SHALL BE INCLUDED IN EVALUATION REPORTS OF THE INTERNATIONAL CODE COUNCIL (ICC), AND SHALL BE EVALUATED FOR 2018 IBC MINIMUM REQUIREMENTS IN THE ICC REPORT.
2. CONCRETE EXPANSION ANCHORS SHALL BE KWIK BOLT TZ BY HILTI, INC., TULSA, OKLAHOMA AS PER ICC REPORT NO. ESR-1917 OR APPROVED EQUIVALENT.
3. CMU EXPANSION ANCHORS SHALL BE KWIK BOLT 3 BY HILTI, INC., TULSA, OKLAHOMA AS PER ICC REPORT NO. ESR-1385 OR APPROVED EQUIVALENT. ANCHORS SHALL BE INSTALLED A MINIMUM OF 1 1/2" FROM ANY VERTICAL MORTAR JOINT TYPICAL.
4. CONCRETE & GROUT FILLED CMU ADHESIVE EPOXY ANCHORS SHALL BE HIT RE-500SD BY HILTI, INC., TULSA, OKLAHOMA AS PER ICC REPORT NO. ESR-2322 OR APPROVED EQUIVALENT.
5. INSTALL EXPANSION AND EPOXY ANCHORS WITH SPECIAL INSPECTION AND PER ALL REQUIREMENTS OF THE MANUFACTURER, THE MANUFACTURER'S ICC APPROVAL AND THESE DRAWINGS.
6. EXPANSION ANCHORS SHALL BE 304/316 STAINLESS STEEL U.O.N. EPOXY ANCHOR THREADED ROD SHALL BE ASTM F593 CW 304/316 STAINLESS STEEL U.O.N.
7. LOCATE AND AVOID REINFORCEMENT AND OTHER EMBEDDED ITEMS WHEN INSTALLING ANCHORS. TYPICAL. SEE CONCRETE CORE DRILLING NOTES FOR ADDITIONAL INFORMATION.

CONCRETE MASONRY

1. MORTAR SHALL BE HAVE TYPE "S" WITH A MINIMUM 1,800 PSI AT 28 DAYS. GROUT SHALL BE A MINIMUM COMPRESSIVE STRENGTH OF 2,000 PSI AT 28 DAYS AND ALL GROUT SHALL BE CONSOLIDATED WITH A MECHANICAL VIBRATOR.
2. CONCRETE MASONRY UNITS SHALL BE MEDIUM WEIGHT (115 PCF) UNITS CONFORMS TO ASTM C90, GRADE N-1, f'm OF 1,500 PSI.
3. ALL CELLS IN CONCRETE BLOCKS SHALL BE FILLED SOLID WITH GROUT, EXCEPT AS NOTED IN THE DRAWINGS OR SPECIFICATIONS. CELL SHALL BE IN VERTICAL ALIGNMENT, DOWELS IN FOOTINGS SHALL BE SET TO ALIGN WITH CORES CONTAINING STEEL. ALL BOND BEAM BLOCK SHALL BE "DEEP CUT" UNITS.
4. ALL CELLS CONTAINING REINFORCING STEEL OR EMBEDDED ITEMS AND ALL CELLS IN RETAINING WALLS AND WALLS BELOW GRADE SHALL BE SOLID GROUTED. ALL HORIZONTAL REINFORCING STEEL SHALL BE PLACED IN BOND OR LINTEL BEAM UNITS.
5. WHEN GROUTING IS STOPPED FOR ONE LONGER, HORIZONTAL CONSTRUCTION JOINTS SHALL BE FORMED BY STOPPING THE GROUT POUR 1-1/2" BELOW TOP OF THE UPPERMOST UNIT. LOW LIFT CONSTRUCTION, MAXIMUM GROUT POUR HEIGHT IS 4 FEET.
6. PROVIDE INSPECTION AND CLEAN OUT HOLES AT BASE OF VERTICAL CELLS HAVING GROUT LIFTS IN EXCESS OF 4'-0" OF HEIGHT.
7. PROVIDE ONE BAR DIAMETER (A MINIMUM OF 1/2") GROUT BETWEEN MAIN REINFORCING AND MASONRY UNITS.
8. SAND SHALL BE CLEAN, SHARP AND WELL GRADED, FREE FROM INJURIOUS AMOUNTS OF DUST, LUMPS, SHALE, ALKAU OR ORGANIC MATERIAL.
9. BRICK SHALL CONFORM TO ASTM C-62 AND SHALL BE GRADE MW OR BETTER.

FIBERGLASS REINFORCED PLASTIC (FRP):

1. ALL STRUCTURAL SHAPES SHALL BE BEDFORD FRP SERIES 1525, PRODUCED USING THE PULTRUSION PROCESS.
2. ALL CUT EDGES AND HOLES SHALL BE SEALED WITH A RESIN COMPATIBLE WITH THE RESIN MATRIX USED IN THE STRUCTURAL SHAPE.
3. THE FABRICATOR AND CONTRACTOR SHALL EXERCISE PRECAUTIONS NECESSARY TO PROTECT THE FIBERGLASS PULTRUDED STRUCTURAL SHAPES FROM ABUSE TO PREVENT BREAKAGE, NICKS, GOUGES, ETC. DURING FABRICATION, HANDLING, AND INSTALLATION.
4. STRUCTURAL SHAPES SHALL BE FABRICATED AND ASSEMBLED AS INDICATED ON THE DESIGN DRAWINGS.
5. FRP BOLTS AND NUTS SHALL BE TIGHTENED TO SNUG TIGHT AND TURNED AN ADDITIONAL 1/2 TURN AND LOCKED WITH EPOXY.
6. FRP OR STEEL BOLTS THROUGH FRP MEMBERS SHALL MEET THE FOLLOWING SPACING AND EDGE DISTANCE REQUIREMENTS, MEASURE FROM BOLT CENTERS:
 - MIN. BOLT SPACING = 4 X BOLT DIAMETER
 - MIN. EDGE DISTANCE = 3 X BOLT DIAMETER IN DIRECTION OF PULTRUSION
 - MIN. EDGE DISTANCE = 2 X BOLT DIAMETER PERPENDICULAR TO DIRECTION OF PULTRUSION

FLASHING

1. ALL FLASHING SHALL BE 26 GA. GALV. IRON UNLESS OTHERWISE NOTED. PRIME AND PAINT TO MATCH ADJACENT CONSTRUCTION
2. FLASH AND COUNTER-FLASH AT ALL ROOF/WALL CONNECTIONS

WOOD

3. NOTCHES ON THE ENDS OF JOISTS SHALL NOT EXCEED ONE-FOURTH OF THE JOIST DEPTH
4. HOLES BORED IN JOISTS SHALL NOT BE WITHIN 2" OF THE TOP OR BOTTOM OF THE JOIST, AND THE DIAMETER OF ANY HOLE SHALL NOT EXCEED ONE-THIRD THE DEPTH OF THE JOIST. NOTCHES IN THE TOP OR BOTTOM OF JOISTS SHALL NOT EXCEED ONE-SIXTH THE DEPTH AND SHALL NOT BE LOCATED IN THE MIDDLE THIRD OF THE JOIST SPAN.
5. NOTCHING IN EXTERIOR WALLS AND BEARING PARTITIONS SHALL NOT EXCEED 25% OF THE STUD WIDTH. CUTTING OR NOTCHING OF STUDS IN NON-BEARING PARTITIONS SHALL NOT EXCEED 40% OF THE STUD WIDTH.
6. ALL NUTS SHALL BE TIGHTENED WHEN PLACED AND RE-TIGHTENED PRIOR TO APPLICATION OF FINISH OR AT COMPLETION OF JOB.
7. CONNECTIONS FOR WOOD MEMBERS SHALL BE DESIGNED IN ACCORDANCE WITH THE APPROPRIATE METHODOLOGY IN SECTION 2302.1. THE NUMBER AND SIZE OF FASTENERS CONNECTING WOOD MEMBERS SHALL BE NOT LESS THAN THAT SET FORTH IN TABLE 2304.10.1

TABLE 2304.10.1 FASTENING SCHEDULE

DESCRIPTION OF BUILDING ELEMENTS	NUMBER AND TYPE OF FASTENER	SPACING AND LOCATION
ROOF		
BLOCKING BETWEEN CEILING JOISTS, RAFTERS OR TRUSSES TO TOP PLATE OR OTHER FRAMING BELOW	3-8D COMMON (2 1/2"x0.131") OR 3-10D BOX (3"x0.128") OR 3-3"x0.131" NAILS OR 3-3" 14 GAUGE STAPLES, 1/8" CROWN	EACH END, TOENAIL
BLOCKING BETWEEN RAFTERS OR TRUSS NOT AT THE WALL TOP PLATE, TO RAFTER OR TRUSS	2-8D COMMON (2 1/2"x0.131") 2-3" X 0.131" NAILS 2-3" GAUGE STAPLES	EACH END, TOENAIL
	2-16D COMMON (3 1/2"x0.162") 3-3"x0.131" NAILS 3-3" 14 GAUGE STAPLES	END NAIL
FLAT BLOCKING TO TRUSS AND WEB FILLER	16D COMMON (3 1/2"x0.162") @ 6" O.C. 3"x0.131" NAILS @ 6" O.C. 3"x14 GAUGE STAPLES @ 6" O.C.	END NAIL
CEILING JOISTS TO TOP PLATE	3-8D COMMON (2 1/2"x0.131") OR 3-10D BOX (3"x0.128") OR 3-3"x0.131" NAILS OR 3-3" 14 GAUGE STAPLES, 1/8" CROWN	EACH END, TOENAIL
CEILING JOIST NOT ATTACHED TO PARALLEL RAFTER, LAPS OVER PARTITIONS (NO THRUST) (SEE SECTION 2308.7.3.1, TABLE 2308.7.3.1)	3-16D COMMON (3 1/2"x0.162") OR 4-10D BOX (3"x0.128") OR 4-3"x0.131" NAILS OR 4-3" 14 GAUGE STAPLES, 1/8" CROWN	FACE NAIL
CEILING JOIST ATTACHED TO PARALLEL RAFTER (HEEL JOIST) (SEE SECTION 2308.7.3.1, TABLE 2308.7.3.1)	PER TABLE 2308.7.3.1	FACE NAIL
COLLAR TIE TO RAFTER	3-10D COMMON (3"x0.148") OR 4-10D BOX (3"x0.128") OR 4-3"x0.131" NAILS OR 4-3" 14 GAUGE STAPLES, 1/8" CROWN	FACE NAIL
RAFTER OR ROOF TRUSS TO TOP PLATE (SEE SECTION 2308.7.5, TABLE 2308.7.3.5)	3-10 COMMON (3"x0.148") OR 3-16D BOX (3 1/2"x0.135") OR 4-10D BOX (3"x0.128") OR 4-3"x0.131" NAILS OR 4-3" GAUGE STAPLES, 1/8" CROWN	TOENAIL
ROOF RAFTERS TO RIDGE VALLEY OR HIP RAFTERS; OR ROOF RAFTER TO 2" RIDGE BEAM	2-16D COMMON (3 1/2"x0.162") OR 3-10D BOX (3"x0.128") OR 3-3"x0.131" NAILS OR 3-3" 14 GAUGE STAPLES, 1/8" CROWN	END NAIL
	3-10 COMMON (3"x0.148") OR 4-16D BOX (3 1/2"x0.135") OR 4-10D BOX (3"x0.128") OR 4-3"x0.131" NAILS OR 4-3" GAUGE STAPLES, 1/8" CROWN	TOENAIL

PAINTING

1. PERFORM ALL WORK NECESSARY AND REQUIRED FOR COMPLETION OF THE PROJECT AS REQUIRED TO COMPLETE THE FINISHING OF THE BUILDING. PAINTING OF ELECTRICAL WORK IN FINISHED AREAS OF THE BUILDING AND ACCESS DOORS ARE INCLUDED.
2. NO PAINTING OR FINISHING SHALL BE STARTED UNTIL THE SURFACES TO BE PAINTED OR FINISHED ARE IN THE PROPER CONDITION IN EVERY RESPECT. APPLICATION OF THE FIRST COAT SHALL CONSTITUTE ACCEPTANCE.
3. WOOD SURFACES SHALL BE SANDED AND DUSTED CLEAN. PUTTY ALL NAIL HOLES, CRACKS, ETC. AFTER FIRST PRIME COAT.
4. LEAVE ALL GLASS AREA, STUCCO SURFACES, FLOOR WALKS, HARDWARE, AND ANY OTHER SURFACES CLEAN AND FREE OF PAINT, STAIN, SPATTERINGS, SMEARS, SMUDGES WHICH ARE THE RESULT OF THESE OPERATIONS. REPLACE ANY GLASS DAMAGED IN ANY WAY.

SPECIAL INSPECTION


1. SPECIAL INSPECTION IS REQUIRED FOR THE INSTALLATION OF HILTI STAINLESS STEEL ANCHOR BOLTS ACCORDING TO ICC-ES# 1917. THE INSTALLATION OF ANCHOR BOLTS BY OTHER MANUFACTURERS ARE NOT ALLOWED.
2. HILTI ANCHORS SHALL BE INSTALLED IN NORMAL WEIGHT CONCRETE WITH A MINIMUM CONCRETE STRENGTH OF 2,500 PSI AT 28 DAYS. UNDER NO CIRCUMSTANCES SHALL THE ANCHORS BE INSTALLED IN MASONRY CONCRETE.
3. HOLES TO RECEIVE EXPANSION/WEDGE ANCHORS SHALL BE 1/8" LARGER IN DIAMETER THAN THE ANCHOR BOLTS, DOWEL OR ROD.
4. THE CONTRACTOR IS RESPONSIBLE TO ENSURE THAT THE INSTALLATION OF HILTI ANCHORS DOES NOT CUT THE EXISTING REBARS IN CONCRETE. ANY ISSUES SHALL BE BROUGHT TO THE ATTENTION OF THE ENGINEER OF RECORD IMMEDIATELY.



5701 SOUTH SANTA FE DRIVE
LITTLETON, CO 80120



2840 HOWE ROAD, SUITE E
MARTINEZ, CA 94553
www.TheCBRGroup.com

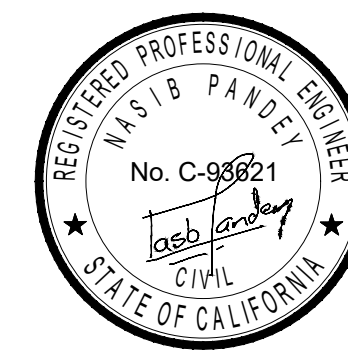

IT IS A VIOLATION OF LAW FOR ANY PERSON, UNLESS THEY ARE ACTING UNDER THE DIRECTION OF A LICENSED PROFESSIONAL ENGINEER, TO ALTER THIS DOCUMENT.

DRAWN BY:	CHECKED BY:	APPROVED BY:
JG/WM	---	---

RFDS REV #: 02/02/2022 REV 4

CONSTRUCTION DOCUMENTS


SUBMITTALS		
REV	DATE	DESCRIPTION
A	02/10/2022	90% CD'S ISSUED FOR REVIEW
B	04/19/2022	100% CONSTRUCTION DRAWINGS
C	06/11/2022	PLAN CHECK COMMENTS

A&E PROJECT NUMBER
SFSF001158A

DISH Wireless L.L.C.
PROJECT INFORMATION
SFSF001158A
1300 COMMERCE ST
PETALUMA, CA 94954

SHEET TITLE
STRUCTURAL NOTES

SHEET NUMBER
S-4

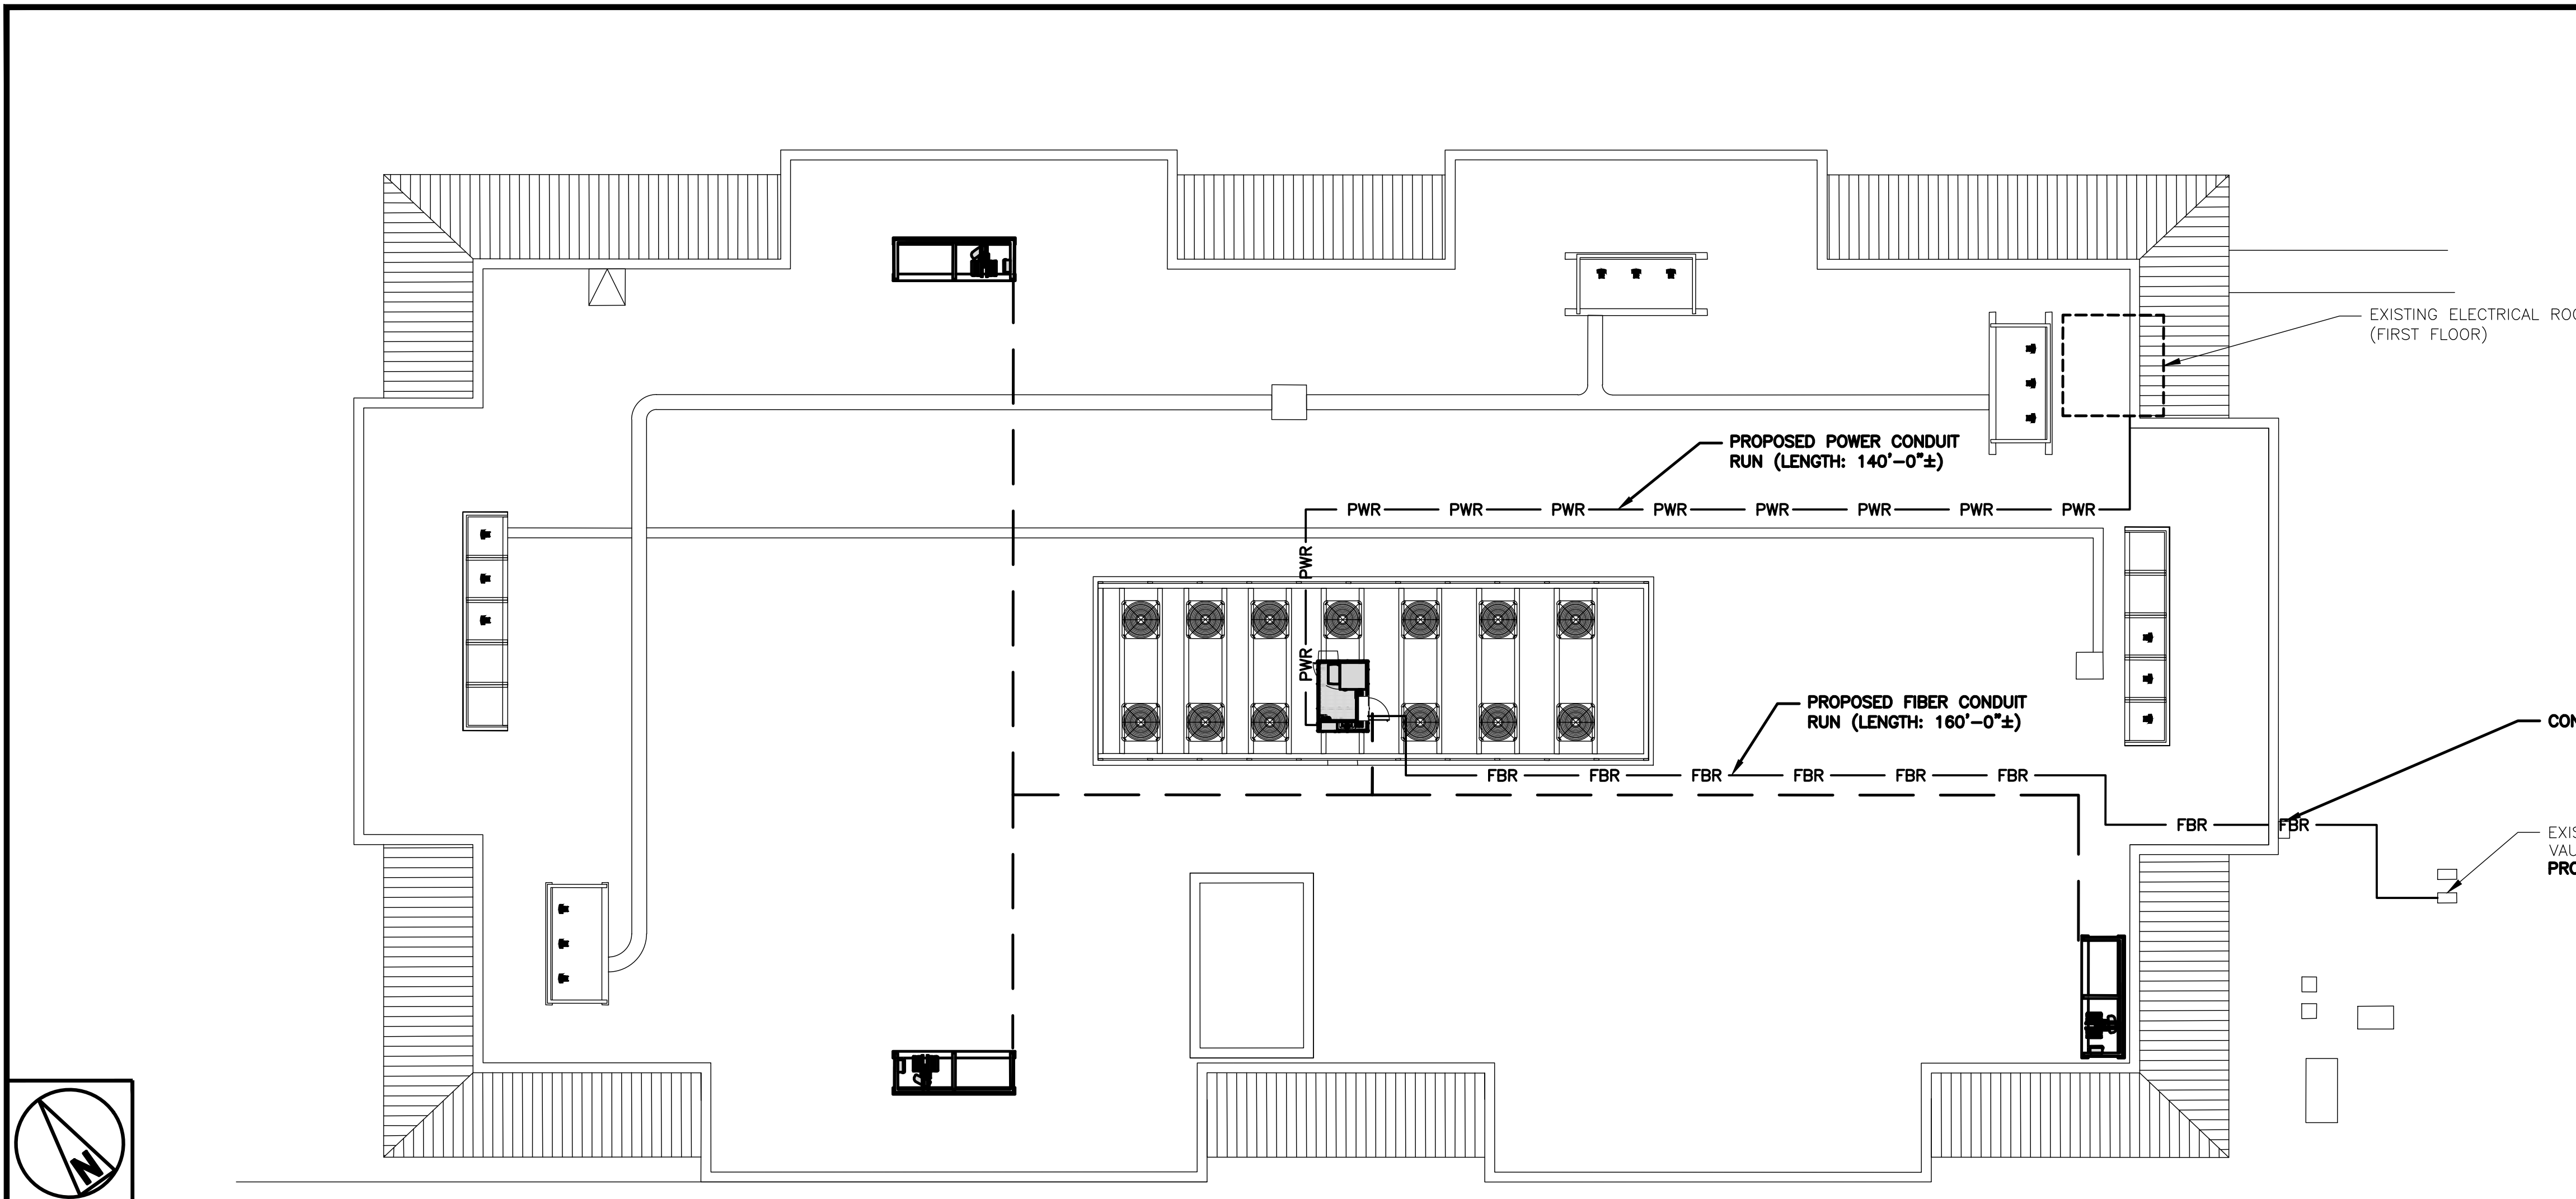

NOTE
 CONTRACTOR SHALL FIELD VERIFY ALL DIMENSIONS.


CONSTRUCTION NOTE
 1. CONTRACTOR TO FIND ACCESSIBLE AND APPROPRIATE LOCATION TO INSTALL (N) CAMLOCK GENERATOR CONNECTOR INTERSECT ICL AND RUN 3" CONDUIT FROM CAMLOCK TO THE (N) PPC CABINET

dish wireless.

5701 SOUTH SANTA FE DRIVE
 LITTLETON, CO 80120



THE CBR GROUP

2840 HOWE ROAD, SUITE E
 MARTINEZ, CA 94553
 www.TheCBRGroup.com

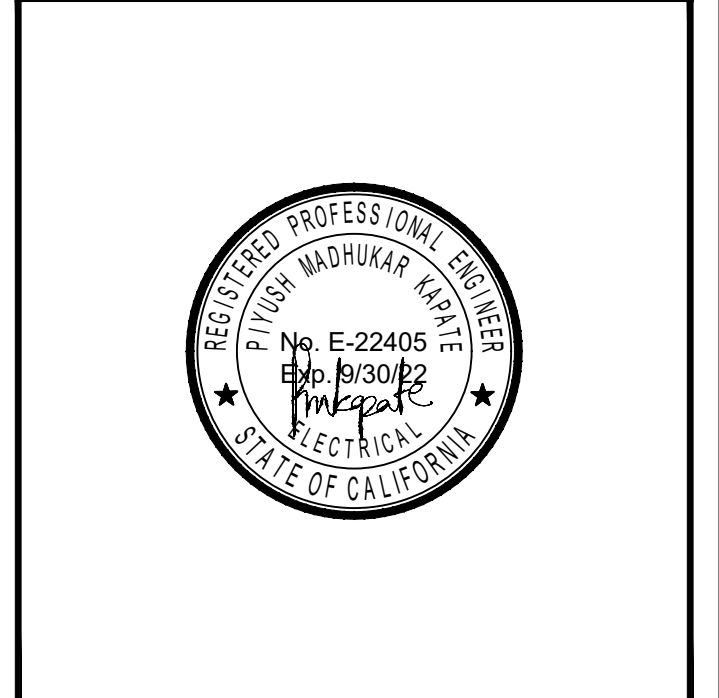

IT IS A VIOLATION OF LAW FOR ANY PERSON, UNLESS THEY ARE ACTING UNDER THE DIRECTION OF A LICENSED PROFESSIONAL ENGINEER, TO ALTER THIS DOCUMENT.

UTILITY ROUTE PLAN

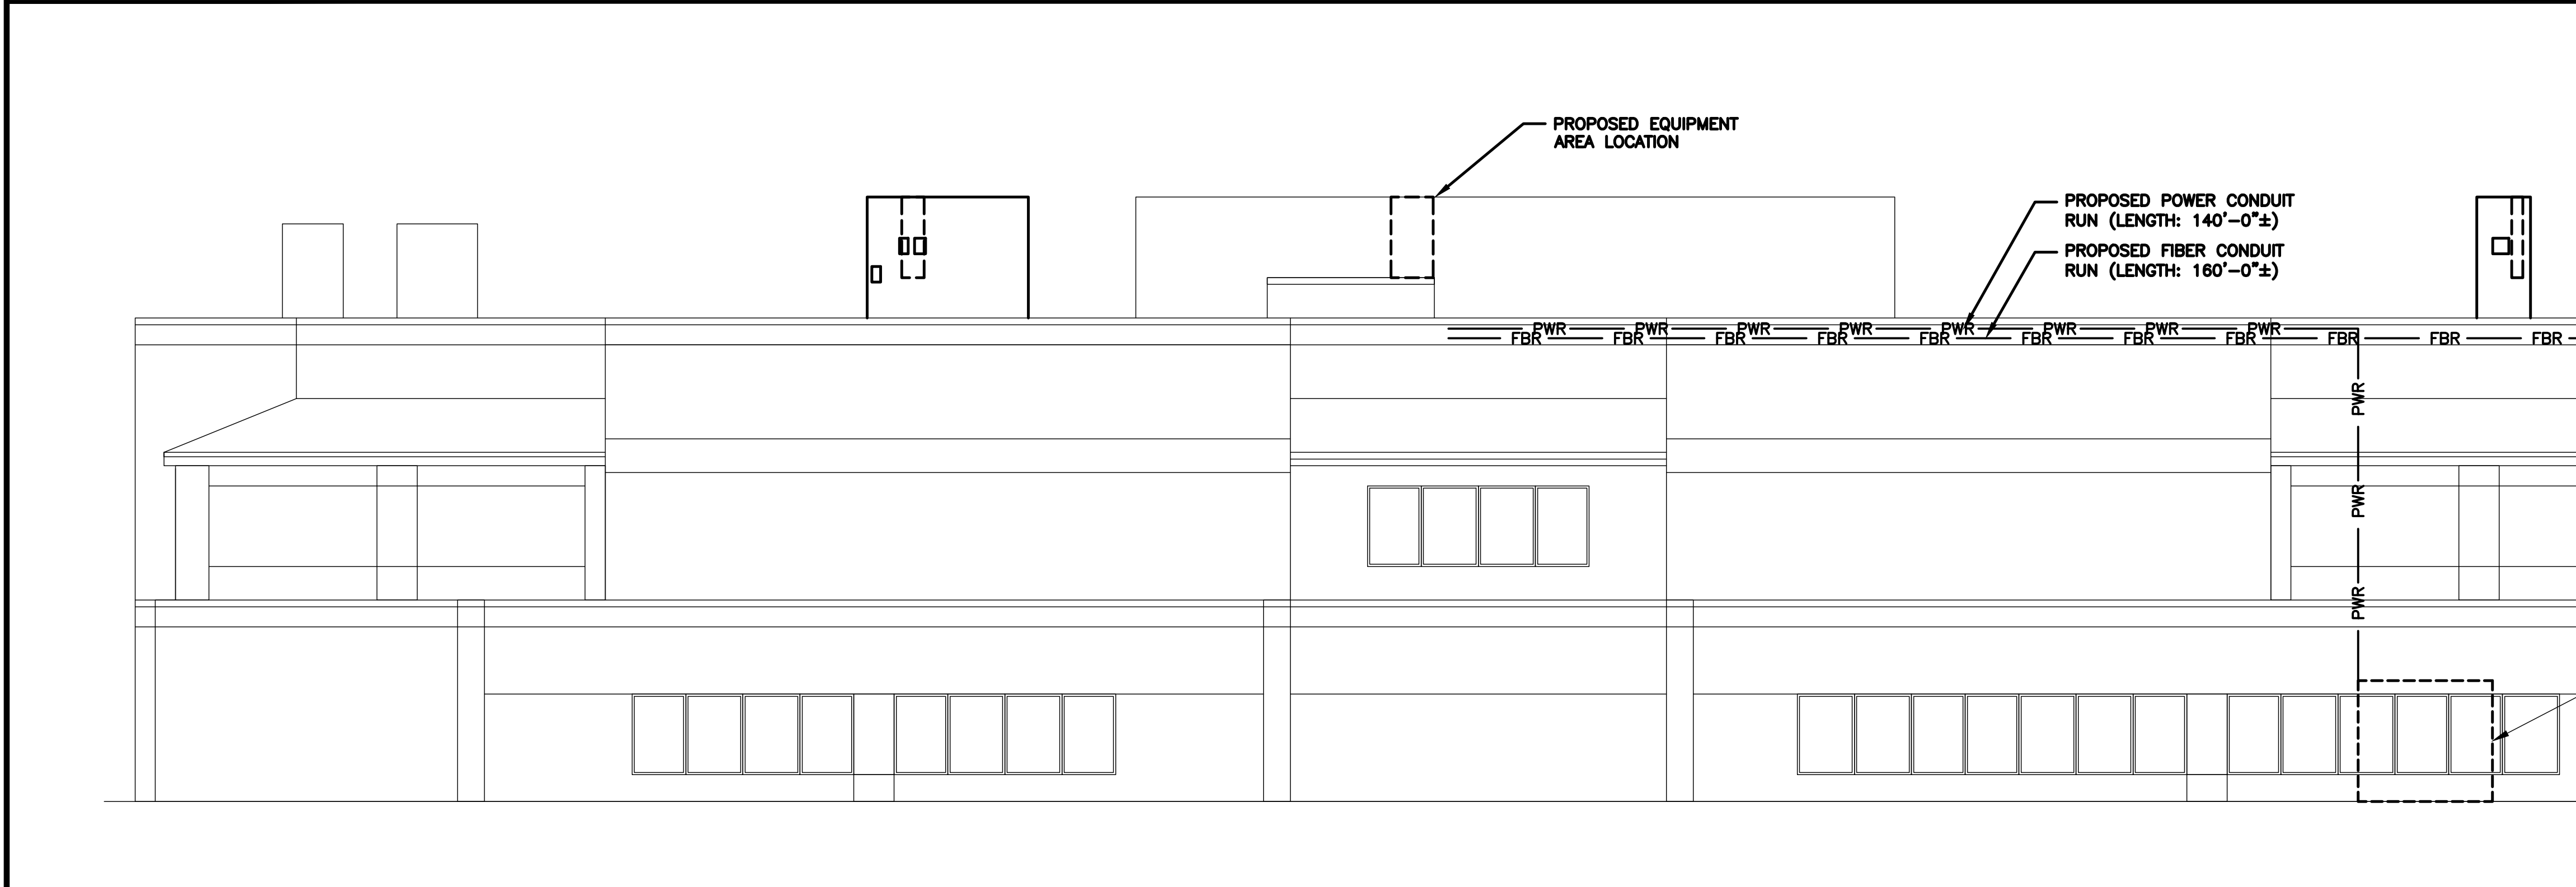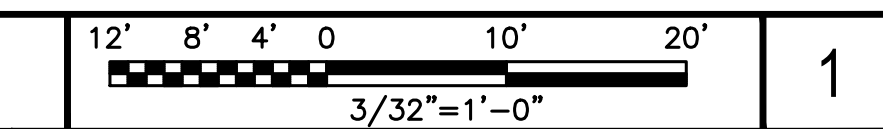

NOTES

1. CONTRACTOR SHALL FIELD VERIFY ALL DIMENSIONS.
 2. E-MON D-MON MOUNTED IN THE UTILITY ROOM LOCATED IN THE (FLOOR). WILL NEED BUILDING MAINTENANCE FOR ROOM ACCESS

DRAWN BY: JG/WM
 CHECKED BY: ---
 APPROVED BY: ---

RFDS REV #: 02/02/2022 REV 4

CONSTRUCTION DOCUMENTS

SUBMITTALS

REV	DATE	DESCRIPTION
A	02/10/2022	90% CD'S ISSUED FOR REVIEW
B	04/19/2022	100% CONSTRUCTION DRAWINGS
C	06/11/2022	PLAN CHECK COMMENTS

A&E PROJECT NUMBER
 SFSF001158A


DISH Wireless L.L.C.
 PROJECT INFORMATION

SFSF001158A
 1300 COMMERCE ST
 PETALUMA, CA 94954

SHEET TITLE
 ELECTRICAL/FIBER ROUTE PLAN AND NOTES


SHEET NUMBER
E-1

UTILITY ROUTE ELEVATION

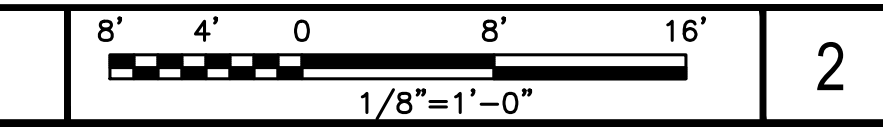

DC POWER WIRING SHALL BE COLOR CODED AT EACH END FOR IDENTIFYING +24V AND -48V CONDUCTORS. RED MARKINGS SHALL IDENTIFY +24V AND BLUE MARKINGS SHALL IDENTIFY -48V.


- CONTRACTOR SHALL INSPECT THE EXISTING CONDITIONS PRIOR TO SUBMITTING A BID. ANY QUESTIONS ARISING DURING THE BID PERIOD IN REGARDS TO THE CONTRACTOR'S FUNCTIONS, THE SCOPE OF WORK, OR ANY OTHER ISSUE RELATED TO THIS PROJECT SHALL BE BROUGHT UP DURING THE BID PERIOD WITH THE PROJECT MANAGER FOR CLARIFICATION, NOT AFTER THE CONTRACT HAS BEEN AWARDED.
- ALL ELECTRICAL WORK SHALL BE DONE IN ACCORDANCE WITH CURRENT NATIONAL ELECTRICAL CODES AND ALL STATE AND LOCAL CODES, LAWS, AND ORDINANCES. PROVIDE ALL COMPONENTS AND WIRING SIZES AS REQUIRED TO MEET NEC STANDARDS.
- LOCATION OF EQUIPMENT, CONDUIT AND DEVICES SHOWN ON THE DRAWINGS ARE APPROXIMATE AND SHALL BE COORDINATED WITH FIELD CONDITIONS PRIOR TO CONSTRUCTION.
- CONDUIT ROUGH-IN SHALL BE COORDINATED WITH THE MECHANICAL EQUIPMENT TO AVOID LOCATION CONFLICTS. VERIFY WITH THE MECHANICAL EQUIPMENT CONTRACTOR AND COMPLY AS REQUIRED.
- CONTRACTOR SHALL PROVIDE ALL BREAKERS, CONDUITS AND CIRCUITS AS REQUIRED FOR A COMPLETE SYSTEM.
- CONTRACTOR SHALL PROVIDE PULL BOXES AND JUNCTION BOXES AS REQUIRED BY THE NEC ARTICLE 314.
- CONTRACTOR SHALL PROVIDE ALL STRAIN RELIEF AND CABLE SUPPORTS FOR ALL CABLE ASSEMBLIES. INSTALLATION SHALL BE IN ACCORDANCE WITH MANUFACTURER'S SPECIFICATIONS AND RECOMMENDATIONS.
- ALL DISCONNECTS AND CONTROLLING DEVICES SHALL BE PROVIDED WITH ENGRAVED PHENOLIC NAMEPLATES INDICATING EQUIPMENT CONTROLLED, BRANCH CIRCUITS INSTALLED ON, AND PANEL FIELD LOCATIONS FED FROM.
- INSTALL AN EQUIPMENT GROUNDING CONDUCTOR IN ALL CONDUITS PER THE SPECIFICATIONS AND NEC 250. THE EQUIPMENT GROUNDING CONDUCTORS SHALL BE BONDED AT ALL JUNCTION BOXES, PULL BOXES, AND ALL DISCONNECT SWITCHES, AND EQUIPMENT CABINETS.
- ALL NEW MATERIAL SHALL HAVE A U.L. LABEL.
- PANEL SCHEDULE LOADING AND CIRCUIT ARRANGEMENTS REFLECT POST-CONSTRUCTION EQUIPMENT.
- CONTRACTOR SHALL BE RESPONSIBLE FOR AS-BUILT PANEL SCHEDULE AND SITE DRAWINGS.

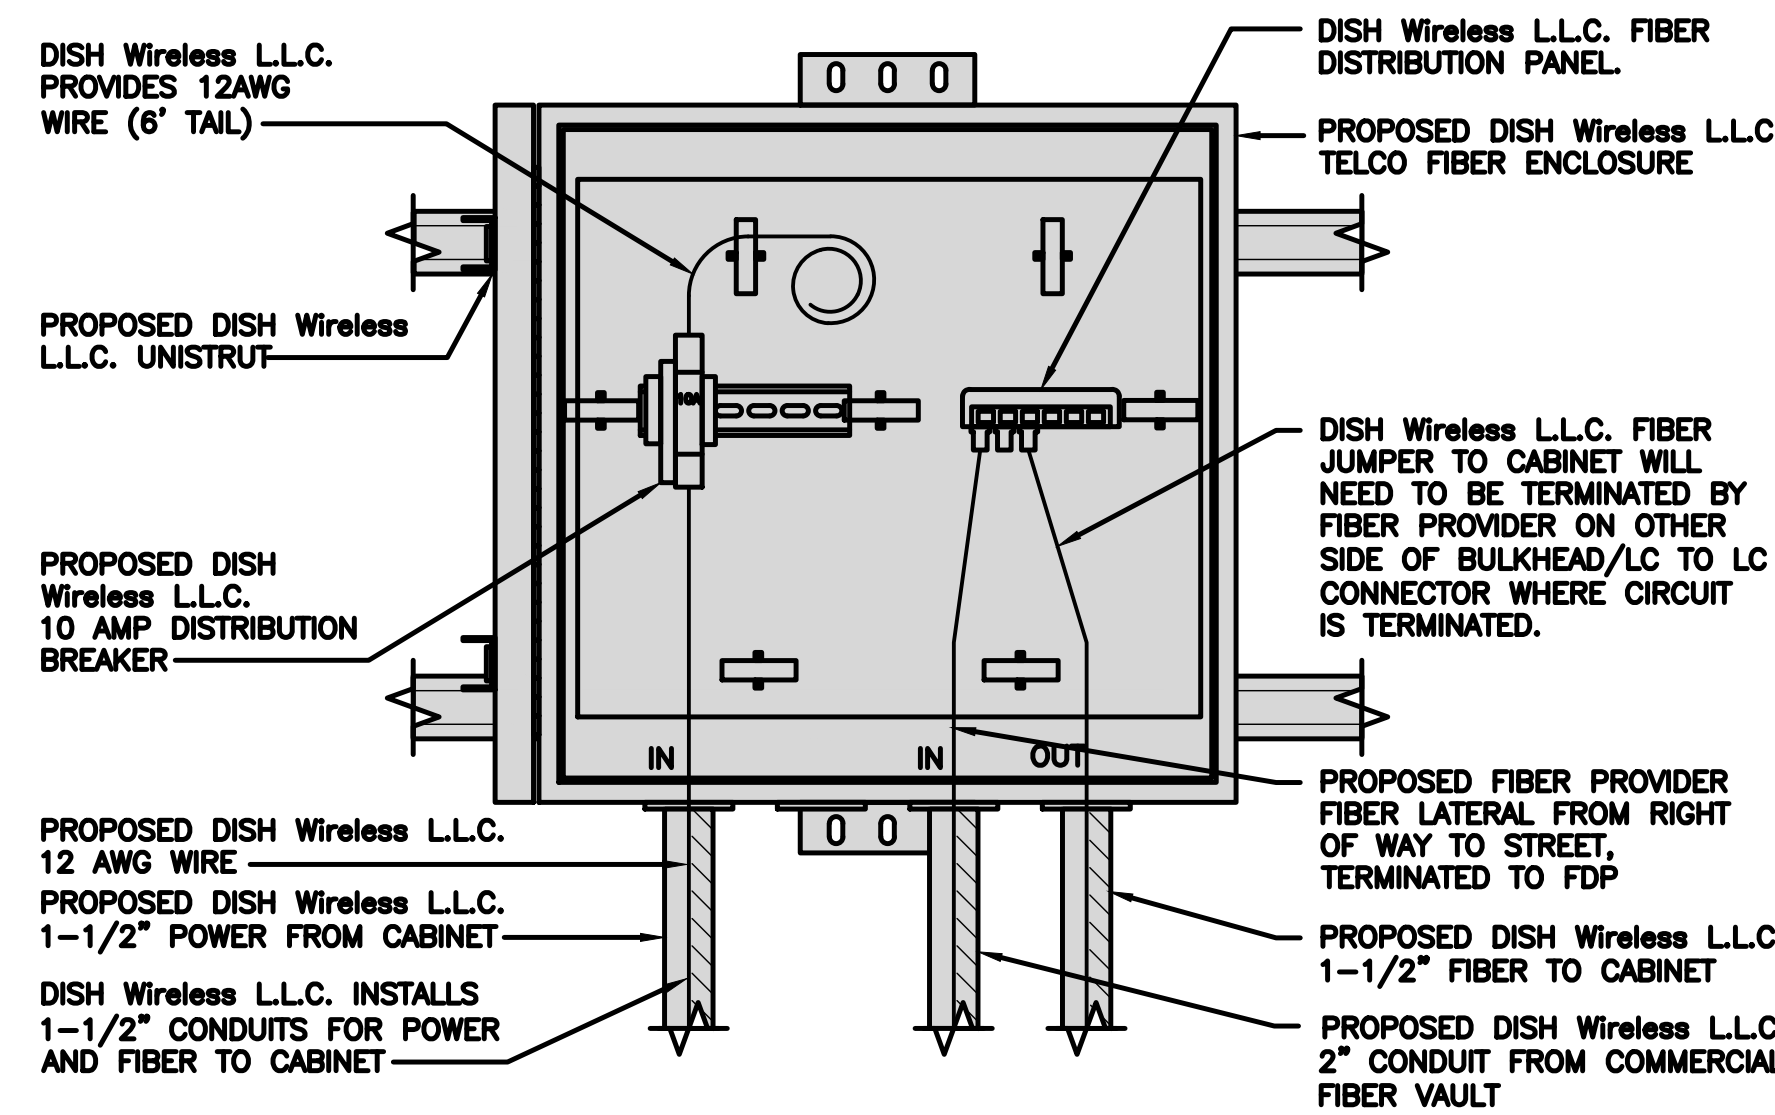


DARK TELCO BOX – INTERIOR WIRING LAYOUT

NO SCALE 2


INTERSECT CAM-LOCK GENERATOR CONNECTOR ICGC-1P	
ENCLOSURE DIMENSIONS (HxWxD):	23"x10"x9.5"
WEIGHT:	14 lbs
OPERATING AC VOLTAGE	400A, 208/120V

 

TOP

 


SIDE

 

FRONT

GEN PLUG DETAIL

NO SCALE 4

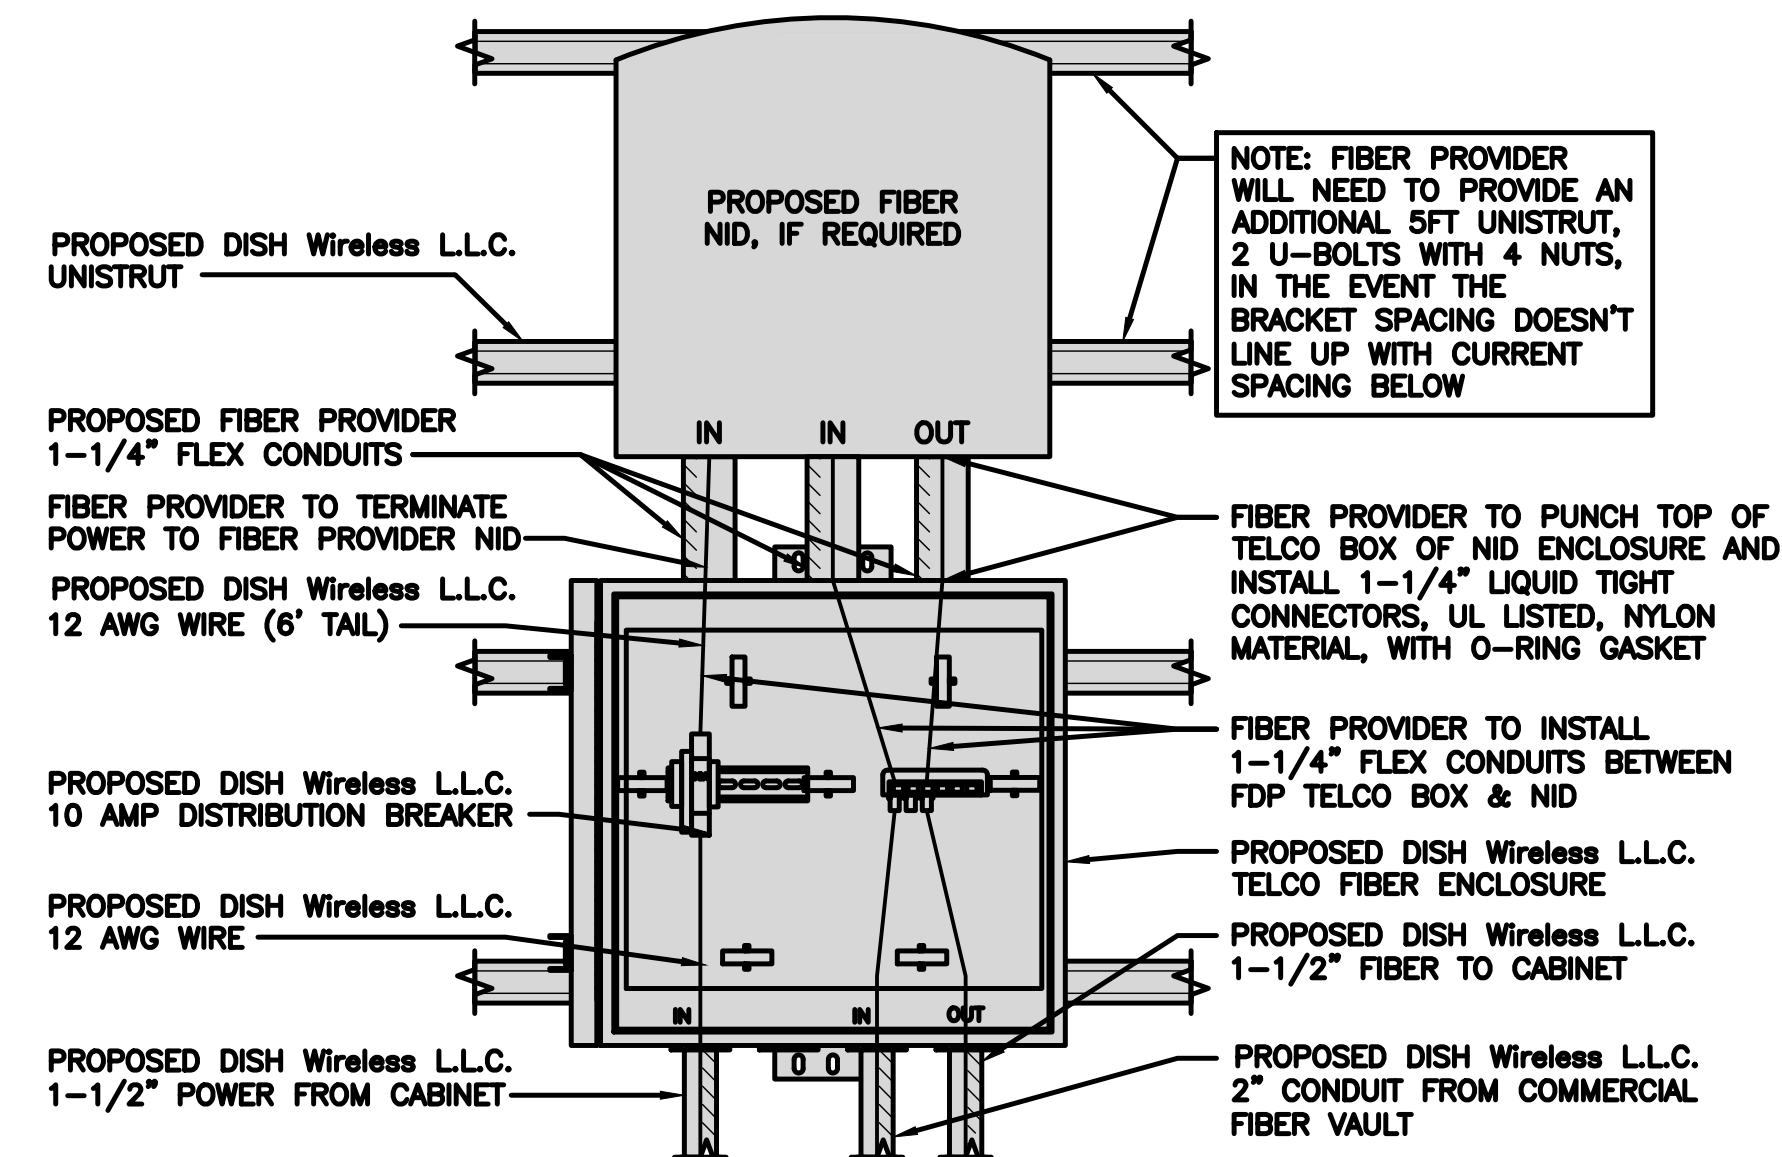

LIT TELCO BOX – INTERIOR WIRING LAYOUT (OPTIONAL)

NO SCALE 3

ELECTRICAL NOTES

NO SCALE 1

NOT USED

NO SCALE 5

NOT USED

NO SCALE 6

NOT USED

NO SCALE 7

NOT USED


NO SCALE 8



5701 SOUTH SANTA FE DRIVE
LITTLETON, CO 80120



2840 HOWE ROAD, SUITE E
MARTINEZ, CA 94553
www.TheCBRGroup.com

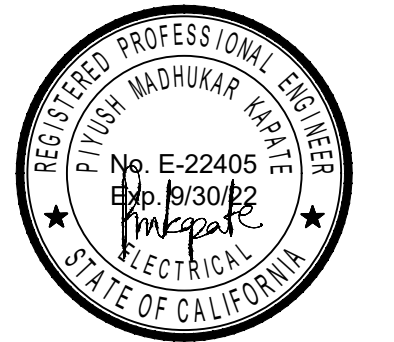

IT IS A VIOLATION OF LAW FOR ANY PERSON, UNLESS THEY ARE ACTING UNDER THE DIRECTION OF A LICENSED PROFESSIONAL ENGINEER, TO ALTER THIS DOCUMENT.

DRAWN BY: JG/WM
CHECKED BY: ---
APPROVED BY: ---

RFDS REV #: 02/02/2022 REV 4

CONSTRUCTION DOCUMENTS

SUBMITTALS		
REV	DATE	DESCRIPTION
A	02/10/2022	90% CD'S ISSUED FOR REVIEW
B	04/19/2022	100% CONSTRUCTION DRAWINGS
C	06/11/2022	PLAN CHECK COMMENTS

A&E PROJECT NUMBER
SFSF001158A



DISH Wireless L.L.C.
PROJECT INFORMATION
SFSF001158A
1300 COMMERCE ST
PETALUMA, CA 94954

SHEET TITLE
ELECTRICAL
DETAILS

SHEET NUMBER
E-2

CONSTRUCTION NOTE

1. CONTRACTOR TO USE SPARE 225A BREAKER IN THE (E) 600A SWITCHGEAR AND INSTALL (N) SUBMETER TO FEED POWER TO THE DISH EQUIPMENT AREA.
2. CONTRACTOR TO FIND APPROPRIATE PLACE TO INSTALL (N) SUBMETER AND DISCONNECT.
3. CONTRACTOR TO FIND ACCESSIBLE AND APPROPRIATE LOCATION TO INSTALL (N) CAMLOCK GENERATOR CONNECTOR INTERSECT ICL AND RUN 3" CONDUIT FROM CAMLOCK TO THE (N) PPC CABINET

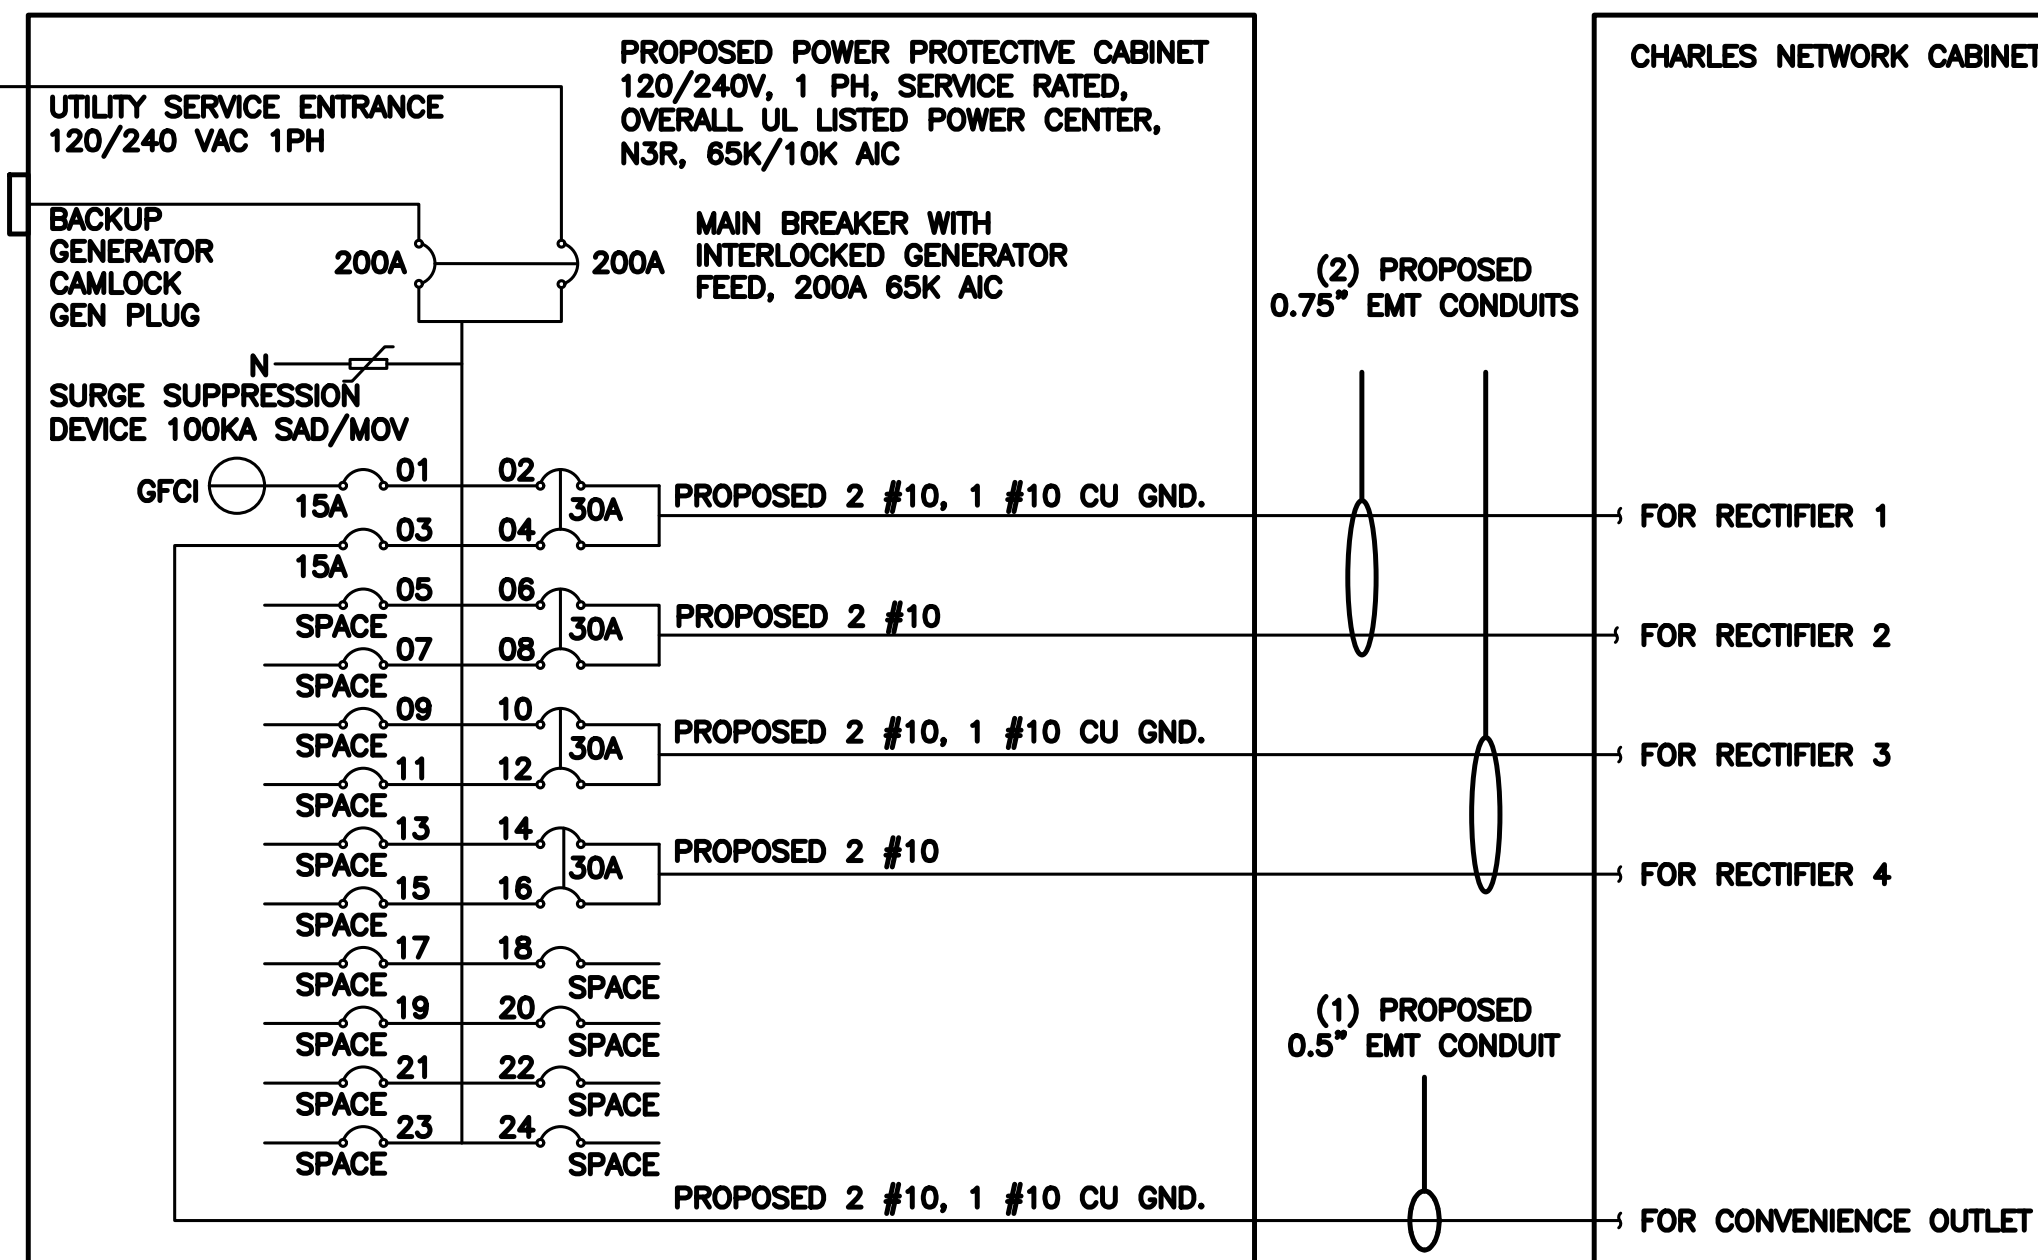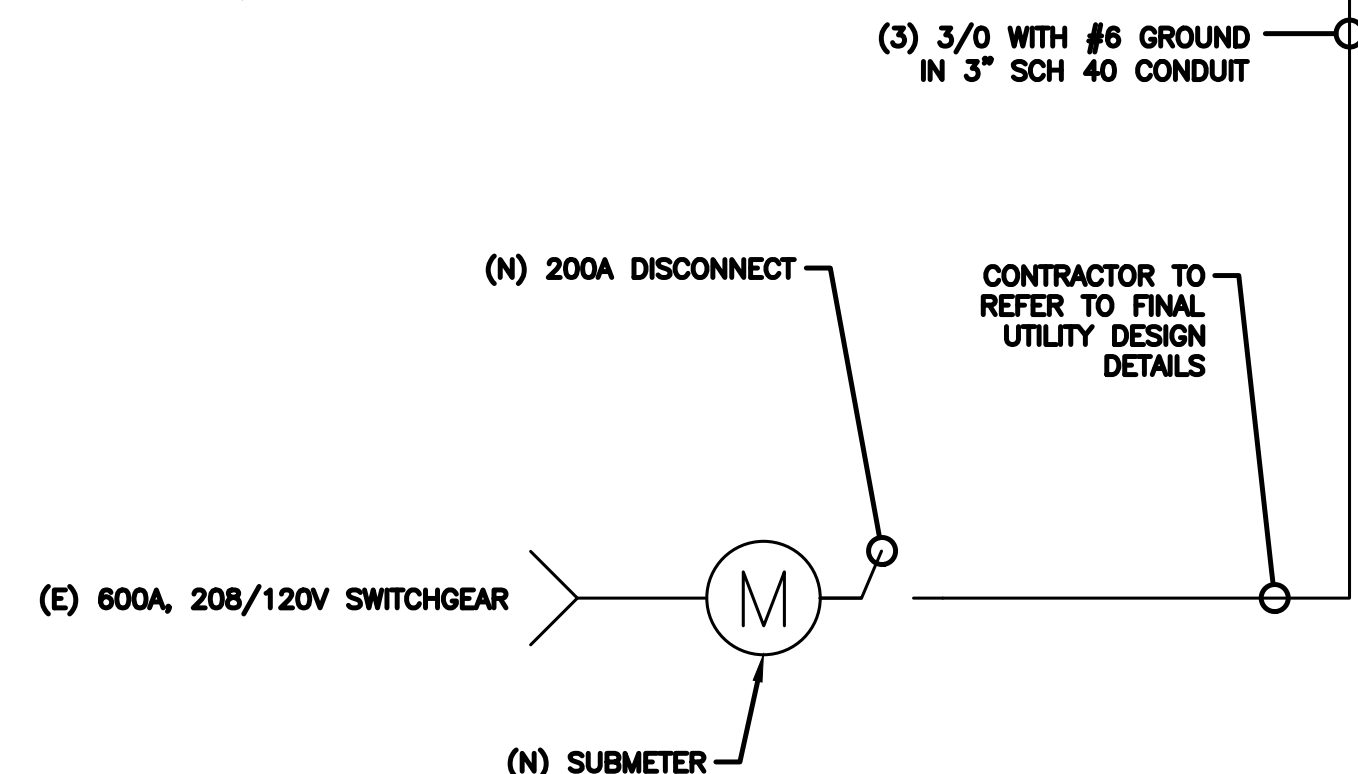

NOTE:
BRANCH CIRCUIT WIRING SUPPLYING RECTIFIERS ARE TO BE RATED UL1015, 105°C, 600V, AND PVC INSULATED, IN THE SIZES SHOWN IN THE ONE-LINE DIAGRAM. CONTRACTOR MAY SUBSTITUTE UL1015 WIRE FOR THWN-2 FOR CONVENIENCE OUTLET BRANCH CIRCUIT.

BREAKERS REQUIRED:
(4) 30A, 2P BREAKER - SQUARE D P/N:Q0230
(1) 15A, 1P BREAKER - SQUARE D P/N:Q0115

NOTES

THE ENGINEER OF RECORD HAS PERFORMED ALL REQUIRED SHORT CIRCUIT CALCULATIONS AND THE AIC RATINGS FOR EACH DEVICE IS ADEQUATE TO PROTECT THE EQUIPMENT AND THE ELECTRICAL SYSTEM.

THE ENGINEER OF RECORD HAS PERFORMED ALL REQUIRED VOLTAGE DROP CALCULATIONS AND ALL BRANCH CIRCUIT AND FEEDERS COMPLY WITH THE NEC (LISTED ON T-1) ARTICLE 210.19(A)(1) FPN NO. 4.

CONDUIT SIZING: AT 40% FILL PER NEC CHAPTER 9, TABLE 4, ARTICLE 358.
 0.5" CONDUIT - 0.122 SQ. IN AREA
 0.75" CONDUIT - 0.213 SQ. IN AREA
 2.0" CONDUIT - 1.316 SQ. IN AREA
 3.0" CONDUIT - 2.907 SQ. IN AREA

CABINET CONVENIENCE OUTLET CONDUCTORS (1 CONDUIT): USING THWN-2, CU.
 #10 - 0.0211 SQ. IN X 2 = 0.0422 SQ. IN
 #10 - 0.0211 SQ. IN X 1 = 0.0211 SQ. IN <GROUND
TOTAL = 0.0633 SQ. IN

0.5" EMT CONDUIT IS ADEQUATE TO HANDLE THE TOTAL OF (3) WIRES, INCLUDING GROUND WIRE, AS INDICATED ABOVE.

RECTIFIER CONDUCTORS (3 CONDUITS): USING UL1015, CU.
 #8 - 0.0552 SQ. IN X 2 = 0.1103 SQ. IN
 #8 - 0.0131 SQ. IN X 1 = 0.0131 SQ. IN <BARE GROUND
TOTAL = 0.1234 SQ. IN

0.75" EMT CONDUIT IS ADEQUATE TO HANDLE THE TOTAL OF (3) WIRES, INCLUDING GROUND WIRE, AS INDICATED ABOVE.

PPC FEED CONDUCTORS (1 CONDUIT): USING THWN, CU.
 3/0 - 0.2679 SQ. IN X 3 = 0.8037 SQ. IN
 #6 - 0.0507 SQ. IN X 1 = 0.0507 SQ. IN <GROUND
TOTAL = 0.8544 SQ. IN

3.0" SCH 40 PVC CONDUIT IS ADEQUATE TO HANDLE THE TOTAL OF (4) WIRES, INCLUDING GROUND WIRE, AS INDICATED ABOVE.



5701 SOUTH SANTA FE DRIVE
LITTLETON, CO 80120



2840 HOWE ROAD, SUITE E
MARTINEZ, CA 94553
www.TheCBRGroup.com



IT IS A VIOLATION OF LAW FOR ANY PERSON, UNLESS THEY ARE ACTING UNDER THE DIRECTION OF A LICENSED PROFESSIONAL ENGINEER, TO ALTER THIS DOCUMENT.

DRAWN BY: JG/WM
 CHECKED BY: ---
 APPROVED BY: ---
 RFDS REV #: 02/02/2022 REV 4

CONSTRUCTION DOCUMENTS

SUBMITTALS		
REV	DATE	DESCRIPTION
A	02/10/2022	90% CD'S ISSUED FOR REVIEW
B	04/19/2022	100% CONSTRUCTION DRAWINGS
C	06/11/2022	PLAN CHECK COMMENTS

A&E PROJECT NUMBER
SFSF001158A

DISH Wireless L.L.C.
PROJECT INFORMATION
SFSF001158A
1300 COMMERCE ST
PETALUMA, CA 94954

SHEET TITLE
ELECTRICAL ONE-LINE, FAULT
CALCS & PANEL SCHEDULE

SHEET NUMBER
E-3

PPC ONE-LINE DIAGRAM

NO SCALE 1

PROPOSED CHARLES PANEL SCHEDULE


LOAD SERVED	VOLT AMPS (WATTS)		TRIP	CKT #	PHASE	CKT #	TRIP	VOLT AMPS (WATTS)		LOAD SERVED
	L1	L2						L1	L2	
PPC GFCI OUTLET	180	180	15A	1	A	2	30A	2880	2880	ABB/GE INFINITY RECTIFIER 1
CHARLES GFCI OUTLET			15A	3	B	4	30A	2880	2880	ABB/GE INFINITY RECTIFIER 1
-SPACE-				5	A	6	30A	2880	2880	ABB/GE INFINITY RECTIFIER 2
-SPACE-				7	B	8	30A	2880	2880	ABB/GE INFINITY RECTIFIER 2
-SPACE-				9	A	10	30A	2880	2880	ABB/GE INFINITY RECTIFIER 3
-SPACE-				11	B	12	30A	2880	2880	ABB/GE INFINITY RECTIFIER 3
-SPACE-				13	A	14	30A	2880	2880	ABB/GE INFINITY RECTIFIER 4
-SPACE-				15	B	16	30A	2880	2880	ABB/GE INFINITY RECTIFIER 4
-SPACE-				17	A	18				-SPACE-
-SPACE-				19	B	20				-SPACE-
-SPACE-				21	A	22				-SPACE-
-SPACE-				23	B	24				-SPACE-
VOLTAGE AMPS		180	180					11520	11520	
200A MCB, 1φ, 24 SPACE, 120/208V				L1	L2			VOLTAGE AMPS		
MB RATING: 65,000 AIC				11700	11700			AMPS		
				56.25	56.25			MAX AMPS		
				112.5				MAX 125%		
				140.63						

PANEL SCHEDULE


NO SCALE 2

NOT USED


NO SCALE 3

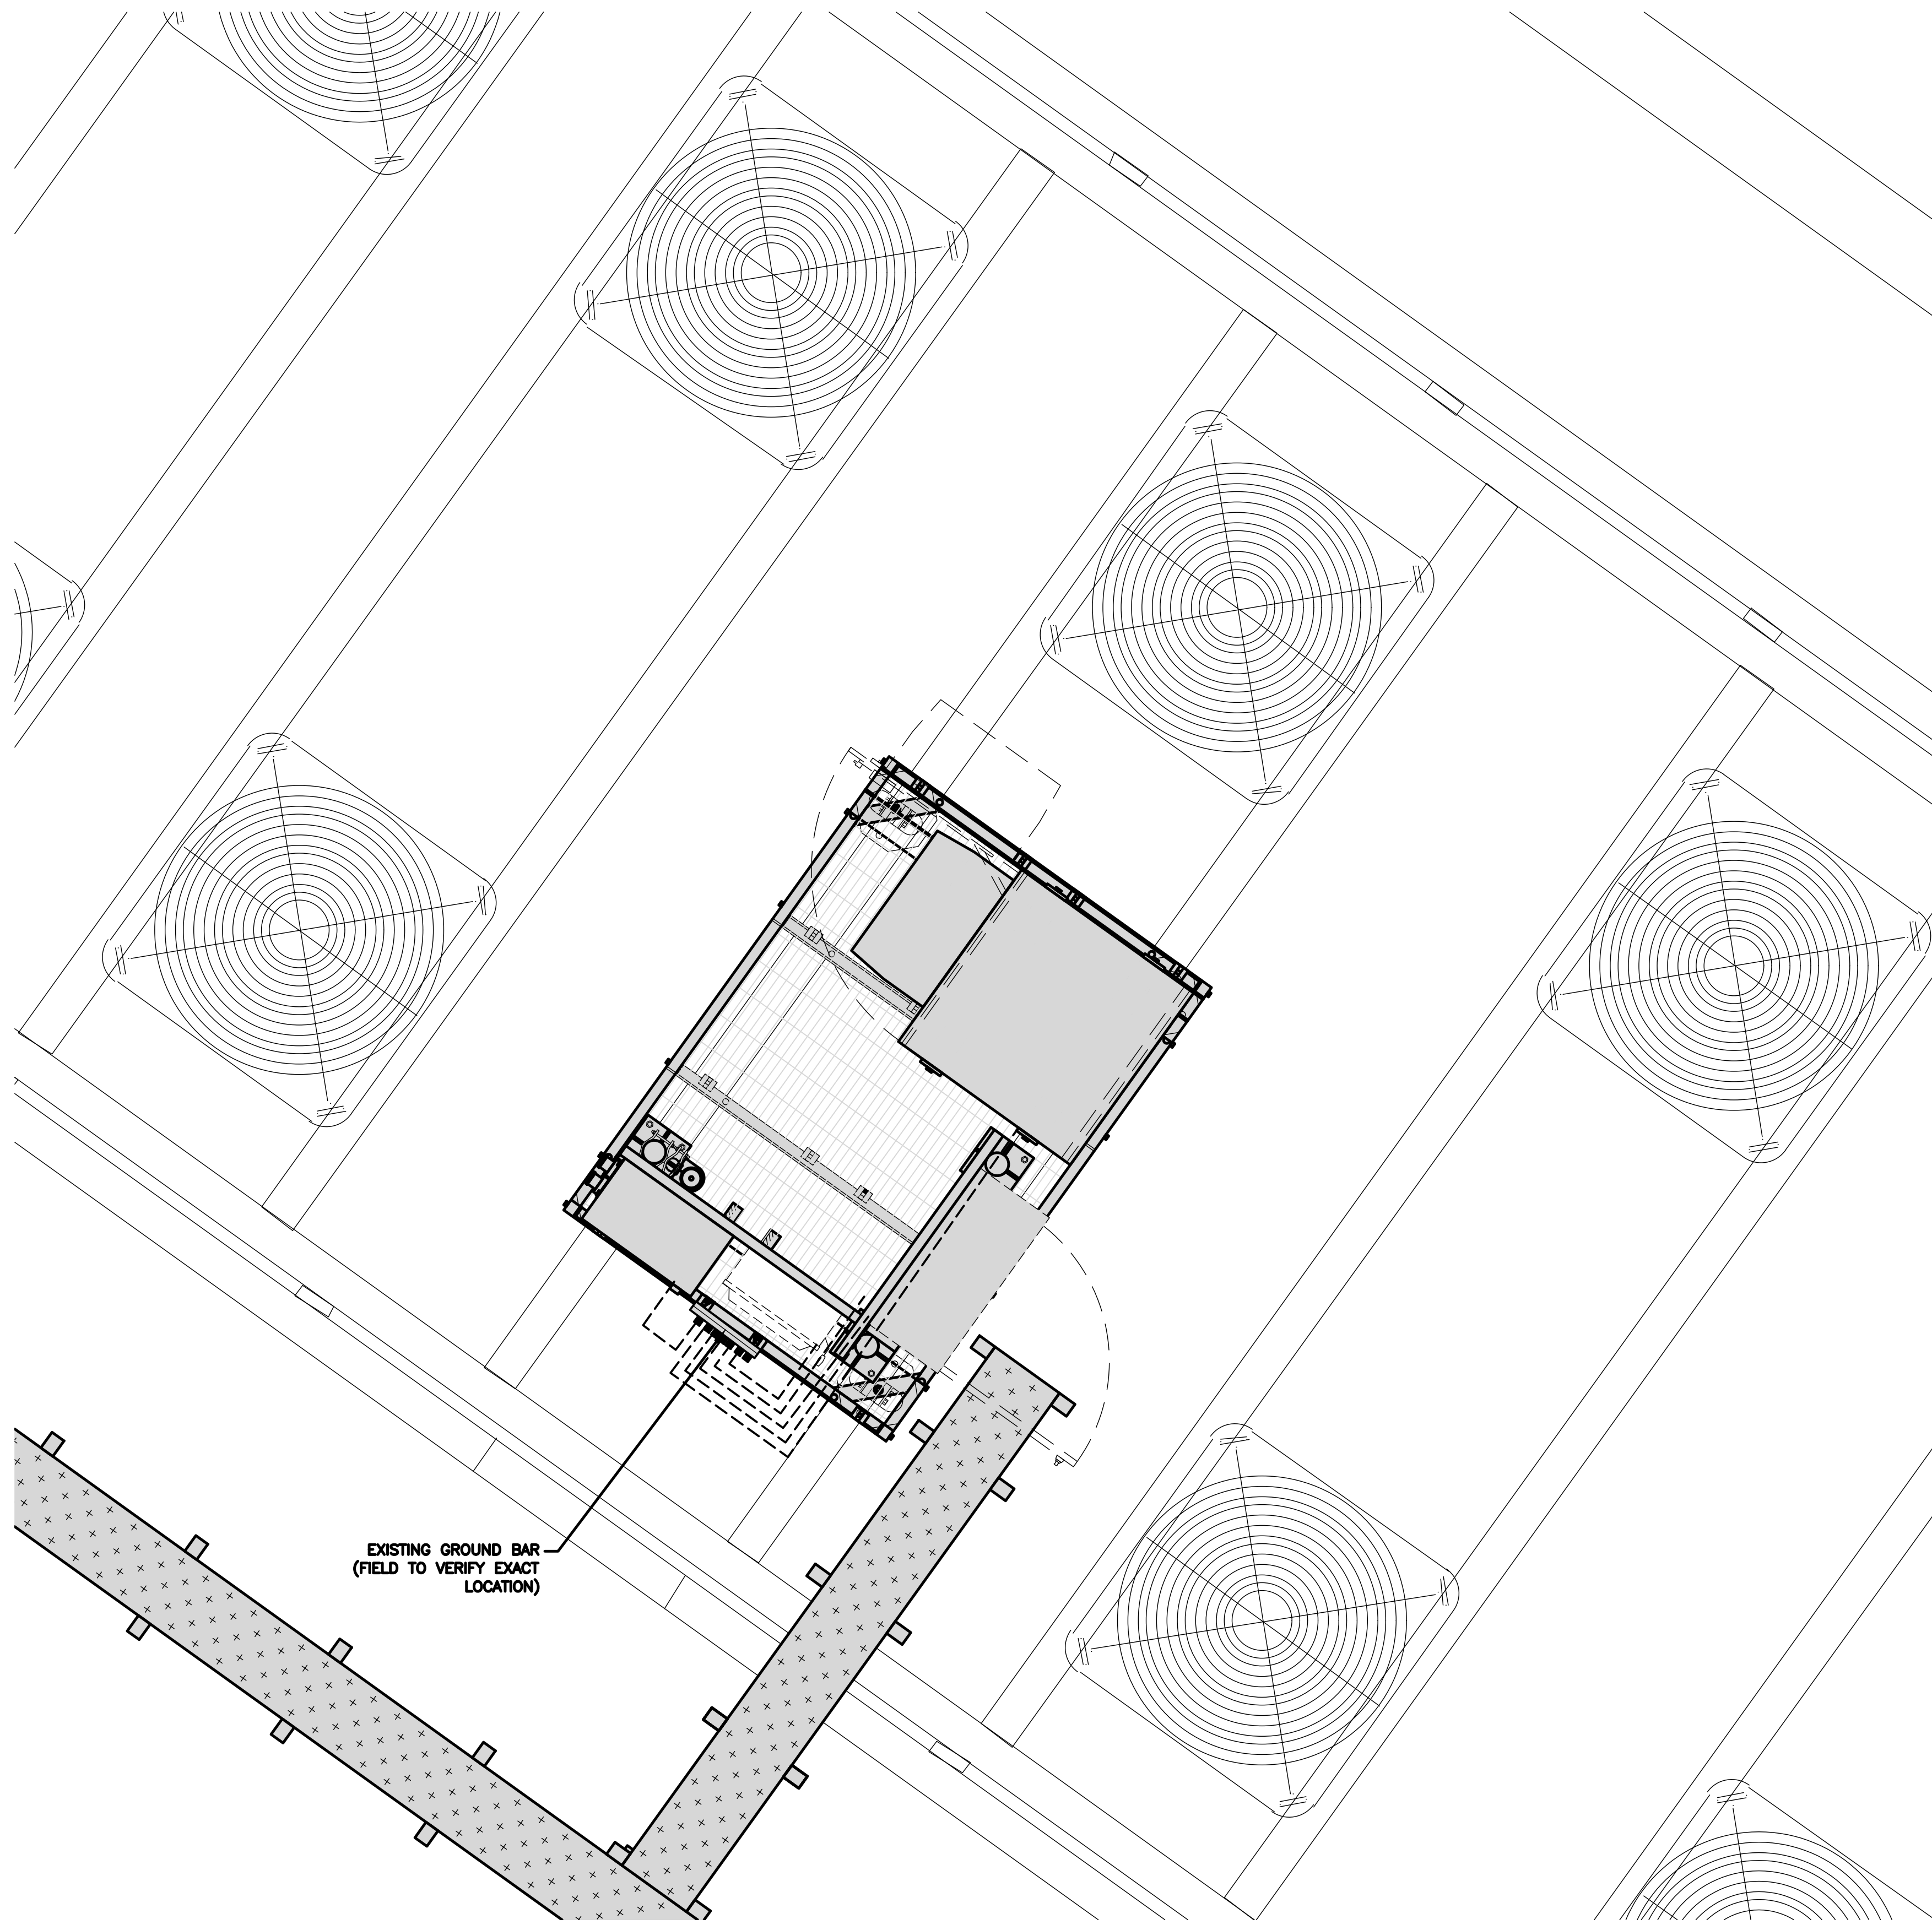

EXISTING GROUND BAR
(FIELD TO VERIFY EXACT LOCATION)

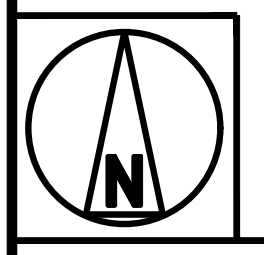

GROUNDING PLAN

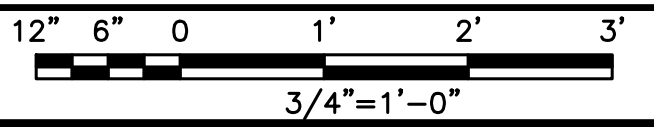

1

- EXOTHERMIC CONNECTION
- MECHANICAL CONNECTION
- ▬ GROUND BUS BAR
- GROUND ROD
- ⊙ TEST GROUND ROD WITH INSPECTION SLEEVE
- #6 AWG STRANDED & INSULATED
- - - - #2 AWG SOLID COPPER TINNED
- ▲ BUSS BAR INSULATOR

GROUNDING LEGEND

1. GROUNDING IS SHOWN DIAGRAMMATICALLY ONLY.
2. CONTRACTOR SHALL GROUND ALL EQUIPMENT AS A COMPLETE SYSTEM. GROUNDING SHALL BE IN COMPLIANCE WITH NEC SECTION 250 AND DISH Wireless L.L.C. GROUNDING AND BONDING REQUIREMENTS AND MANUFACTURER'S SPECIFICATIONS.
3. ALL GROUND CONDUCTORS SHALL BE COPPER; NO ALUMINUM CONDUCTORS SHALL BE USED.
4. NO EXOTHERMIC WELDING ON ROOFTOP

GROUNDING ROOFTOP KEY NOTES

- (A) **EXTERIOR GROUND RING:** #2 AWG SOLID COPPER, BURIED AT A DEPTH OF AT LEAST 30 INCHES BELOW GRADE, OR 6 INCHES BELOW THE FROST LINE AND APPROXIMATELY 24 INCHES FROM THE EXTERIOR WALL OR FOOTING.
- (B) **ROOFTOP GROUND SYSTEM:** THE GROUND SYSTEM USING MINIMUM #2 AWG SOLID COPPER CONDUCTORS.
- (C) **INTERIOR GROUND RING:** #2 AWG STRANDED GREEN INSULATED COPPER CONDUCTOR EXTENDED AROUND THE PERIMETER OF THE EQUIPMENT AREA. ALL NON-TELECOMMUNICATIONS RELATED METALLIC OBJECTS FOUND WITHIN A SITE SHALL BE GROUNDED TO THE INTERIOR GROUND RING WITH #6 AWG STRANDED GREEN INSULATED CONDUCTOR.
- (D) **BOND TO INTERIOR GROUND RING:** #2 AWG SOLID TINNED COPPER WIRE PRIMARY BONDS SHALL BE PROVIDED AT LEAST AT FOUR POINTS ON THE INTERIOR GROUND RING, LOCATED AT THE CORNERS OF THE BUILDING OR ROOM.
- (E) **GROUND ROD:** UL LISTED COPPER CLAD STEEL. MINIMUM 1/2" DIAMETER BY EIGHT FEET LONG. GROUND RODS SHALL BE INSTALLED WITH INSPECTION SLEEVES. GROUND RODS SHALL BE DRIVEN TO THE DEPTH OF GROUND RING CONDUCTOR.
- (F) **CELL REFERENCE GROUND BAR (CRGB):** POINT OF GROUND REFERENCE FOR ALL COMMUNICATIONS EQUIPMENT FRAMES. ALL BONDS ARE MADE WITH #2 AWG UNLESS NOTED OTHERWISE STRANDED GREEN INSULATED COPPER CONDUCTORS. BOND TO COMMON BUILDING GROUND SYSTEM WITH (2) #2 SOLID TINNED COPPER CONDUCTORS.
- (G) **HATCH PLATE GROUND BAR:** BOND TO THE COMMON BUILDING GROUND SYSTEM WITH TWO #2 AWG STRANDED GREEN INSULATED COPPER CONDUCTORS. WHEN A HATCH-PLATE AND A CELL REFERENCE GROUND BAR ARE BOTH PRESENT, THE CRGB MUST BE CONNECTED TO THE HATCH-PLATE AND TO THE INTERIOR GROUND RING USING (2) TWO #2 AWG STRANDED GREEN INSULATED COPPER CONDUCTORS EACH.
- (H) **EXTERIOR CABLE ENTRY PORT GROUND BARS:** LOCATED AT THE ENTRANCE TO THE CELL SITE ROOM. BOND TO GROUND RING WITH A #2 AWG SOLID TINNED COPPER CONDUCTORS WITH MECHANICAL CONNECTIONS.
- (I) **TELCO GROUND BAR:** BOND TO BOTH CELL REFERENCE GROUND BAR OR EXTERIOR GROUND RING.
- (J) **FRAME BONDING:** THE BONDING POINT FOR TELECOM EQUIPMENT FRAMES SHALL BE THE GROUND BUS THAT IS NOT ISOLATED FROM THE EQUIPMENTS METAL FRAMEWORK.
- (K) **INTERIOR UNIT BONDS:** METAL FRAMES, CABINETS AND INDIVIDUAL METALLIC UNITS LOCATED WITH THE AREA OF THE INTERIOR GROUND RING REQUIRE A #6 AWG STRANDED GREEN INSULATED COPPER BOND TO THE INTERIOR GROUND RING.
- (L) **FENCE AND GATE GROUNDING:** METAL FENCES SHALL BE BONDED TO THE COMMON BUILDING GROUND SYSTEM WITH A #2 AWG SOLID TINNED COPPER CONDUCTOR AT AN INTERVAL NOT EXCEEDING 25 FEET. BONDS SHALL BE MADE AT EACH GATE POST AND ACROSS GATE OPENINGS.
- (M) **EXTERIOR UNIT BONDS:** METALLIC OBJECTS, EXTERNAL TO OR MOUNTED TO THE BUILDING, SHALL BE BONDED TO THE COMMON BUILDING GROUND SYSTEM. USING #2 TINNED SOLID COPPER WIRE
- (N) **ICE BRIDGE SUPPORTS:** EACH ICE BRIDGE LEG SHALL BE BONDED TO THE GROUND RING WITH #2 AWG BARE TINNED COPPER CONDUCTOR. PROVIDE EXOTHERMIC WELDS AT BOTH THE ICE BRIDGE LEG AND BURIED GROUND RING.
- (O) **DURING ALL DC POWER SYSTEM CHANGES INCLUDING DC SYSTEM CHANGE OUTS, RECTIFIER REPLACEMENTS OR ADDITIONS, BREAKER DISTRIBUTION CHANGES, BATTERY REPLACEMENTS AND INSTALLATIONS OR CHANGES TO DC CONVERTER SYSTEMS IT SHALL BE REQUIRED THAT SERVICE CONTRACTORS VERIFY ALL DC POWER SYSTEMS ARE EQUIPPED WITH A MASTER DC SYSTEM RETURN GROUND CONDUCTOR FROM THE DC POWER SYSTEM COMMON RETURN BUS DIRECTLY CONNECTED TO THE CELL SITE REFERENCE GROUND BAR**
- (P) **ROOFTOP COLLECTOR BUSS BAR IS TO BE MECHANICALLY BONDED TO COMMON BUILDING GROUND SYSTEM. REFER TO DISH Wireless L.L.C. GROUNDING NOTES.**

GROUNDING KEY NOTES


NO SCALE 2



5701 SOUTH SANTA FE DRIVE
LITTLETON, CO 80120



2840 HOWE ROAD, SUITE E
MARTINEZ, CA 94553
www.TheCBRGroup.com

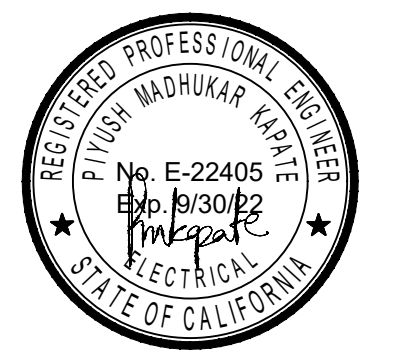

IT IS A VIOLATION OF LAW FOR ANY PERSON, UNLESS THEY ARE ACTING UNDER THE DIRECTION OF A LICENSED PROFESSIONAL ENGINEER, TO ALTER THIS DOCUMENT.

DRAWN BY: JG/WM CHECKED BY: --- APPROVED BY: ---

RFDS REV #: 02/02/2022 REV 4

CONSTRUCTION DOCUMENTS

SUBMITTALS		
REV	DATE	DESCRIPTION
A	02/10/2022	90% CD'S ISSUED FOR REVIEW
B	04/19/2022	100% CONSTRUCTION DRAWINGS
C	06/11/2022	PLAN CHECK COMMENTS


A&E PROJECT NUMBER
SFSF001158A

DISH Wireless L.L.C.
PROJECT INFORMATION
SFSF001158A
1300 COMMERCE ST
PETALUMA, CA 94954

SHEET TITLE
GROUNDING PLANS
AND NOTES


SHEET NUMBER

G-1

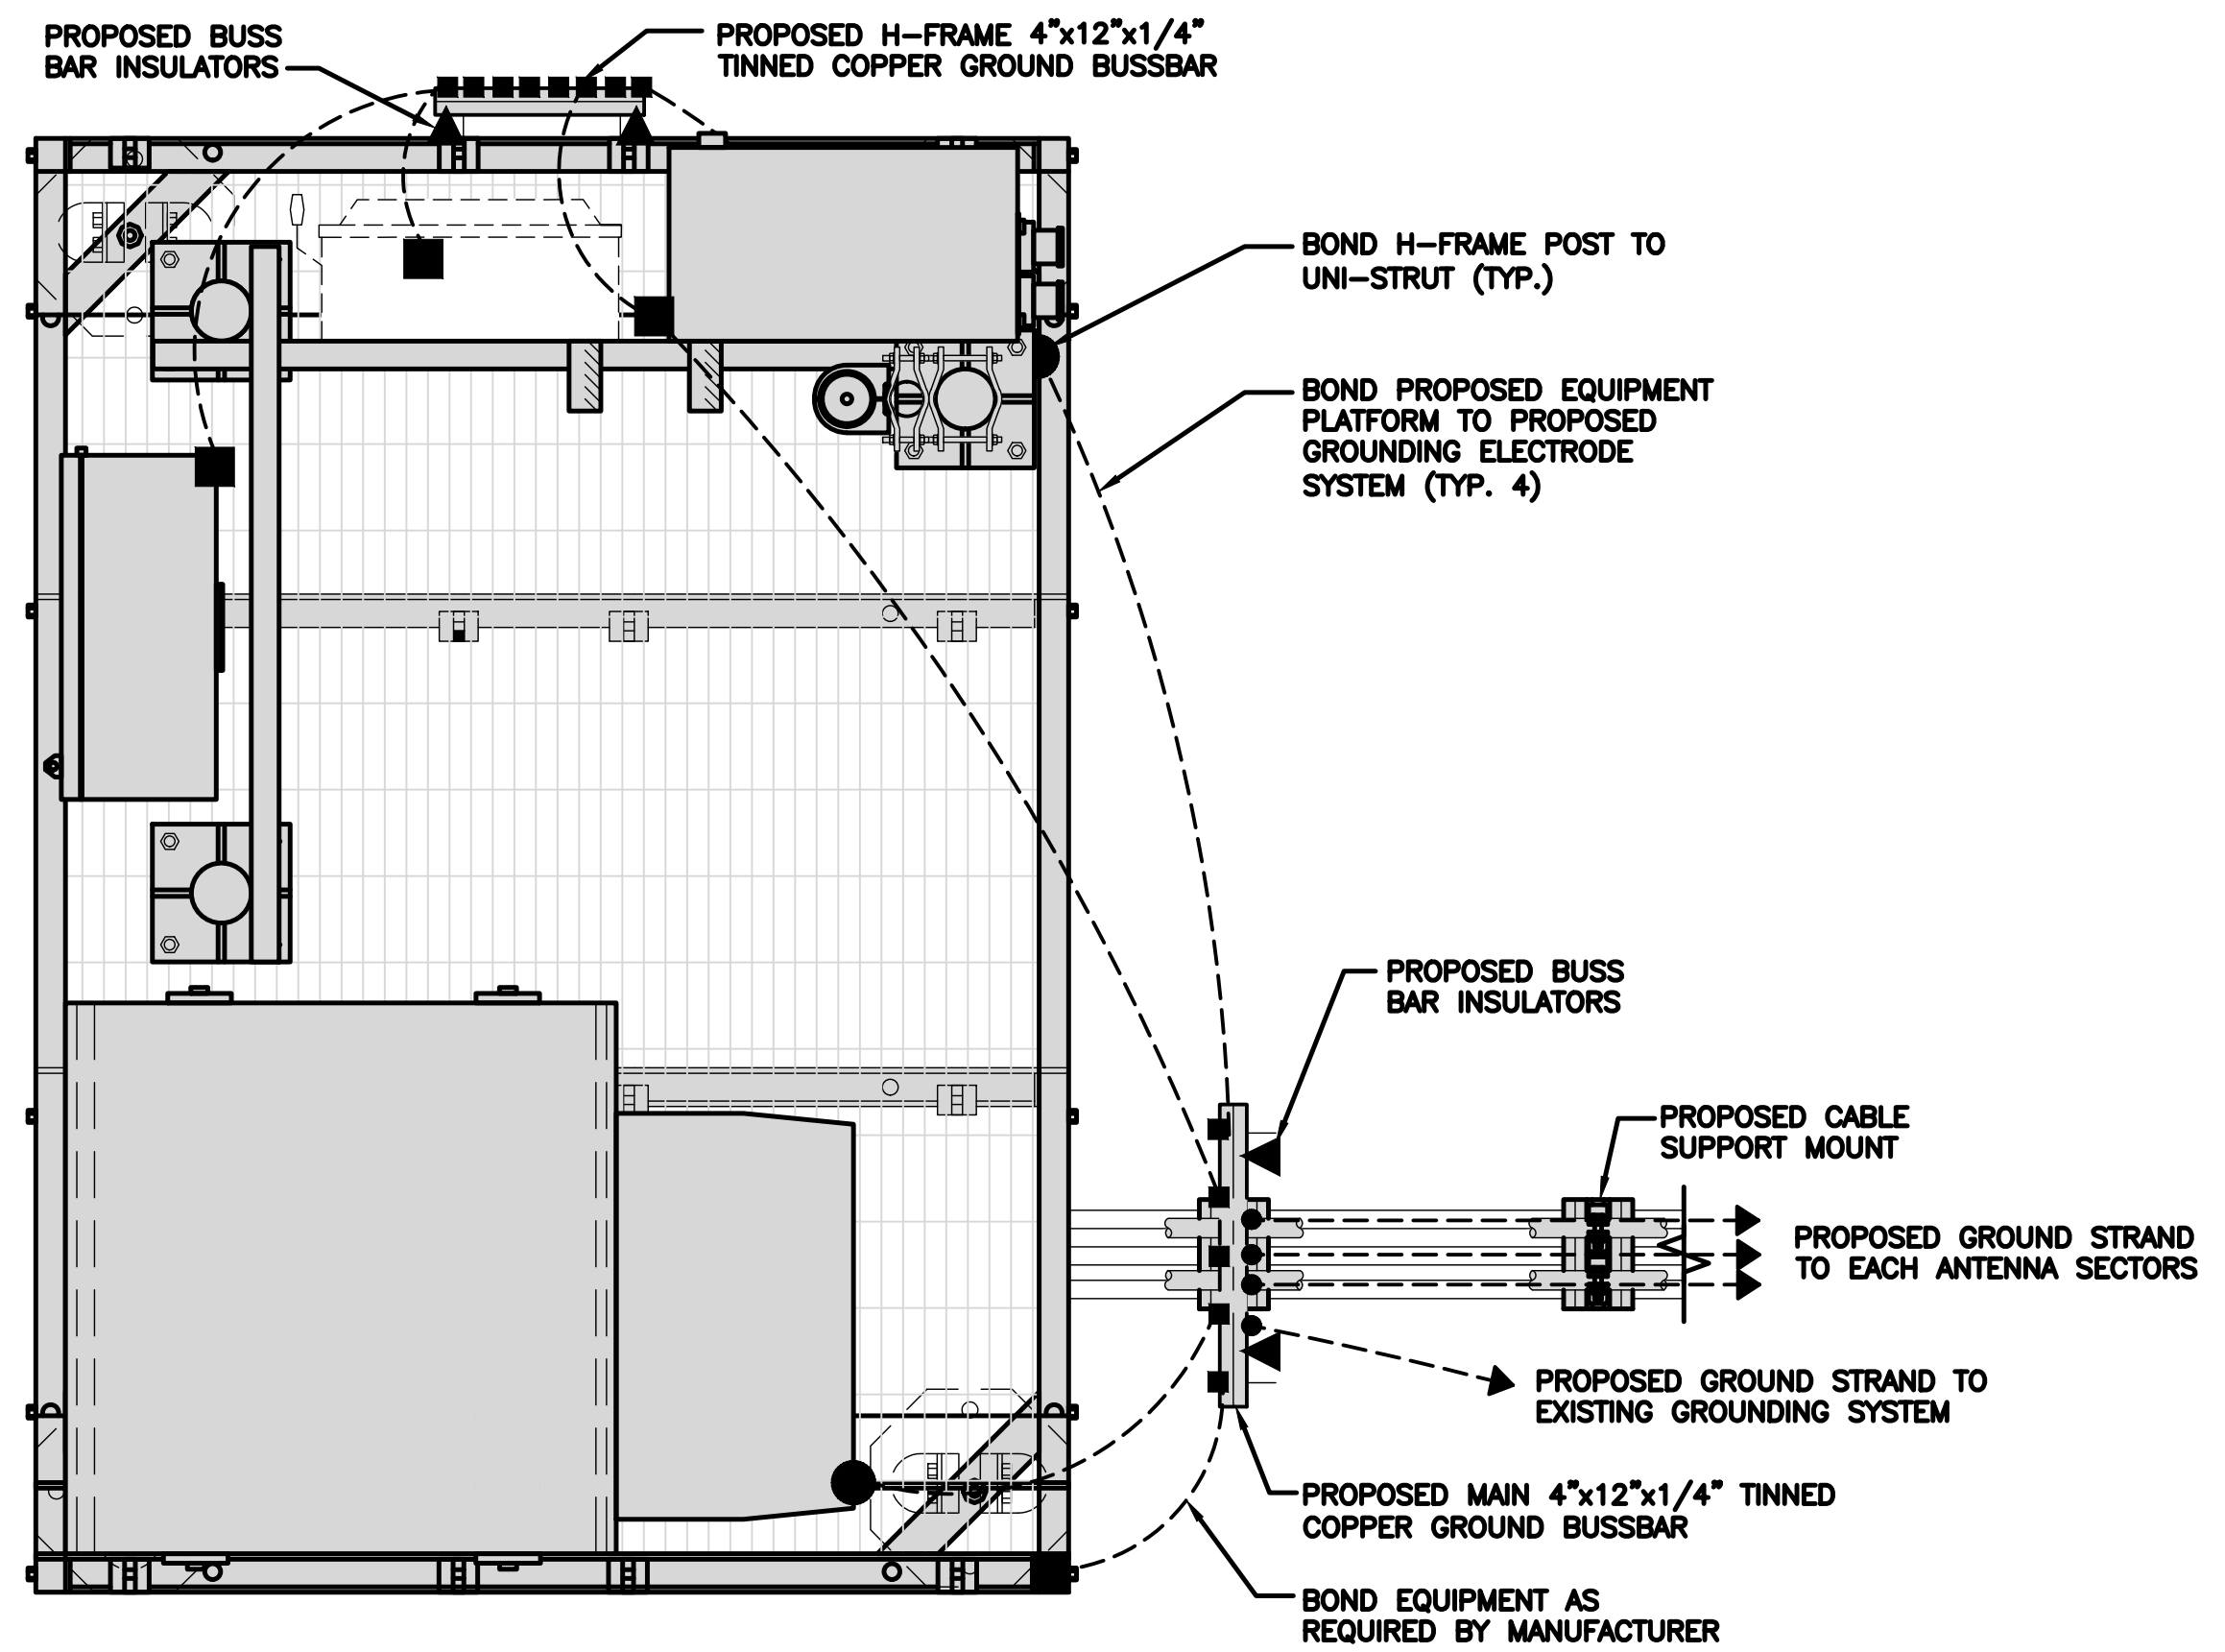

TYPICAL ROOFTOP EQUIPMENT GROUNDING PLAN

NO SCALE 1

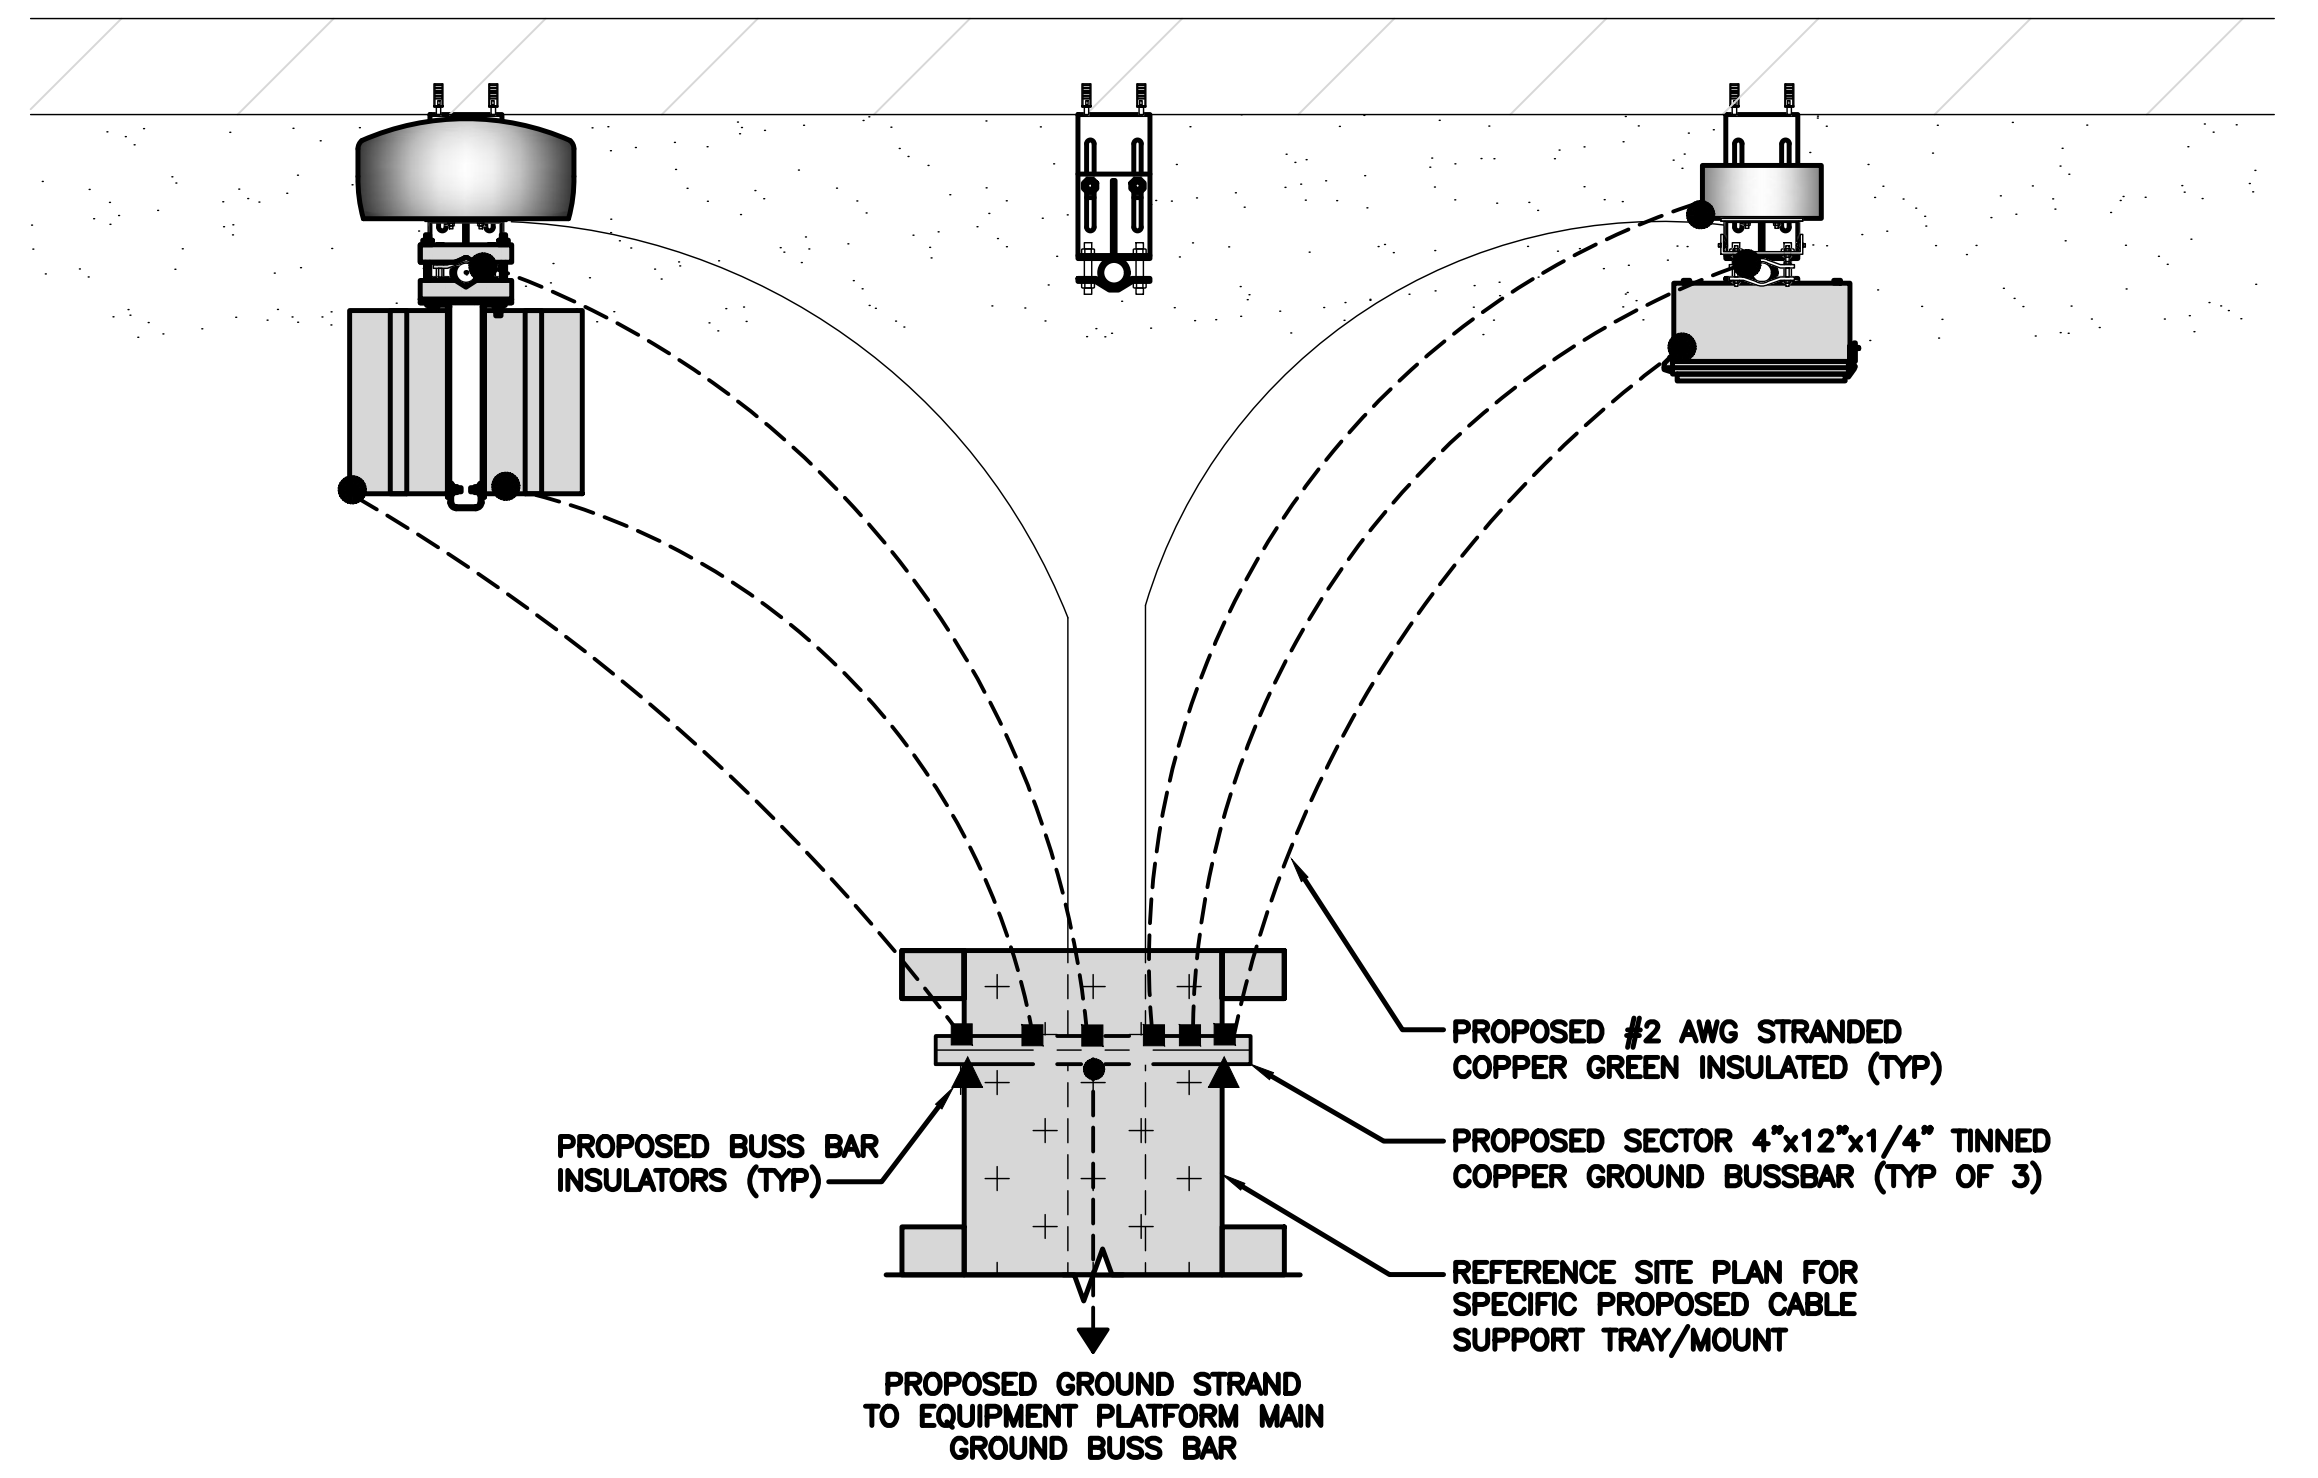


TYPICAL ROOFTOP ANTENNA GROUNDING PLAN

NO SCALE 2

NOTE

EQUIPMENT CABINET OMITTED FOR CLARITY

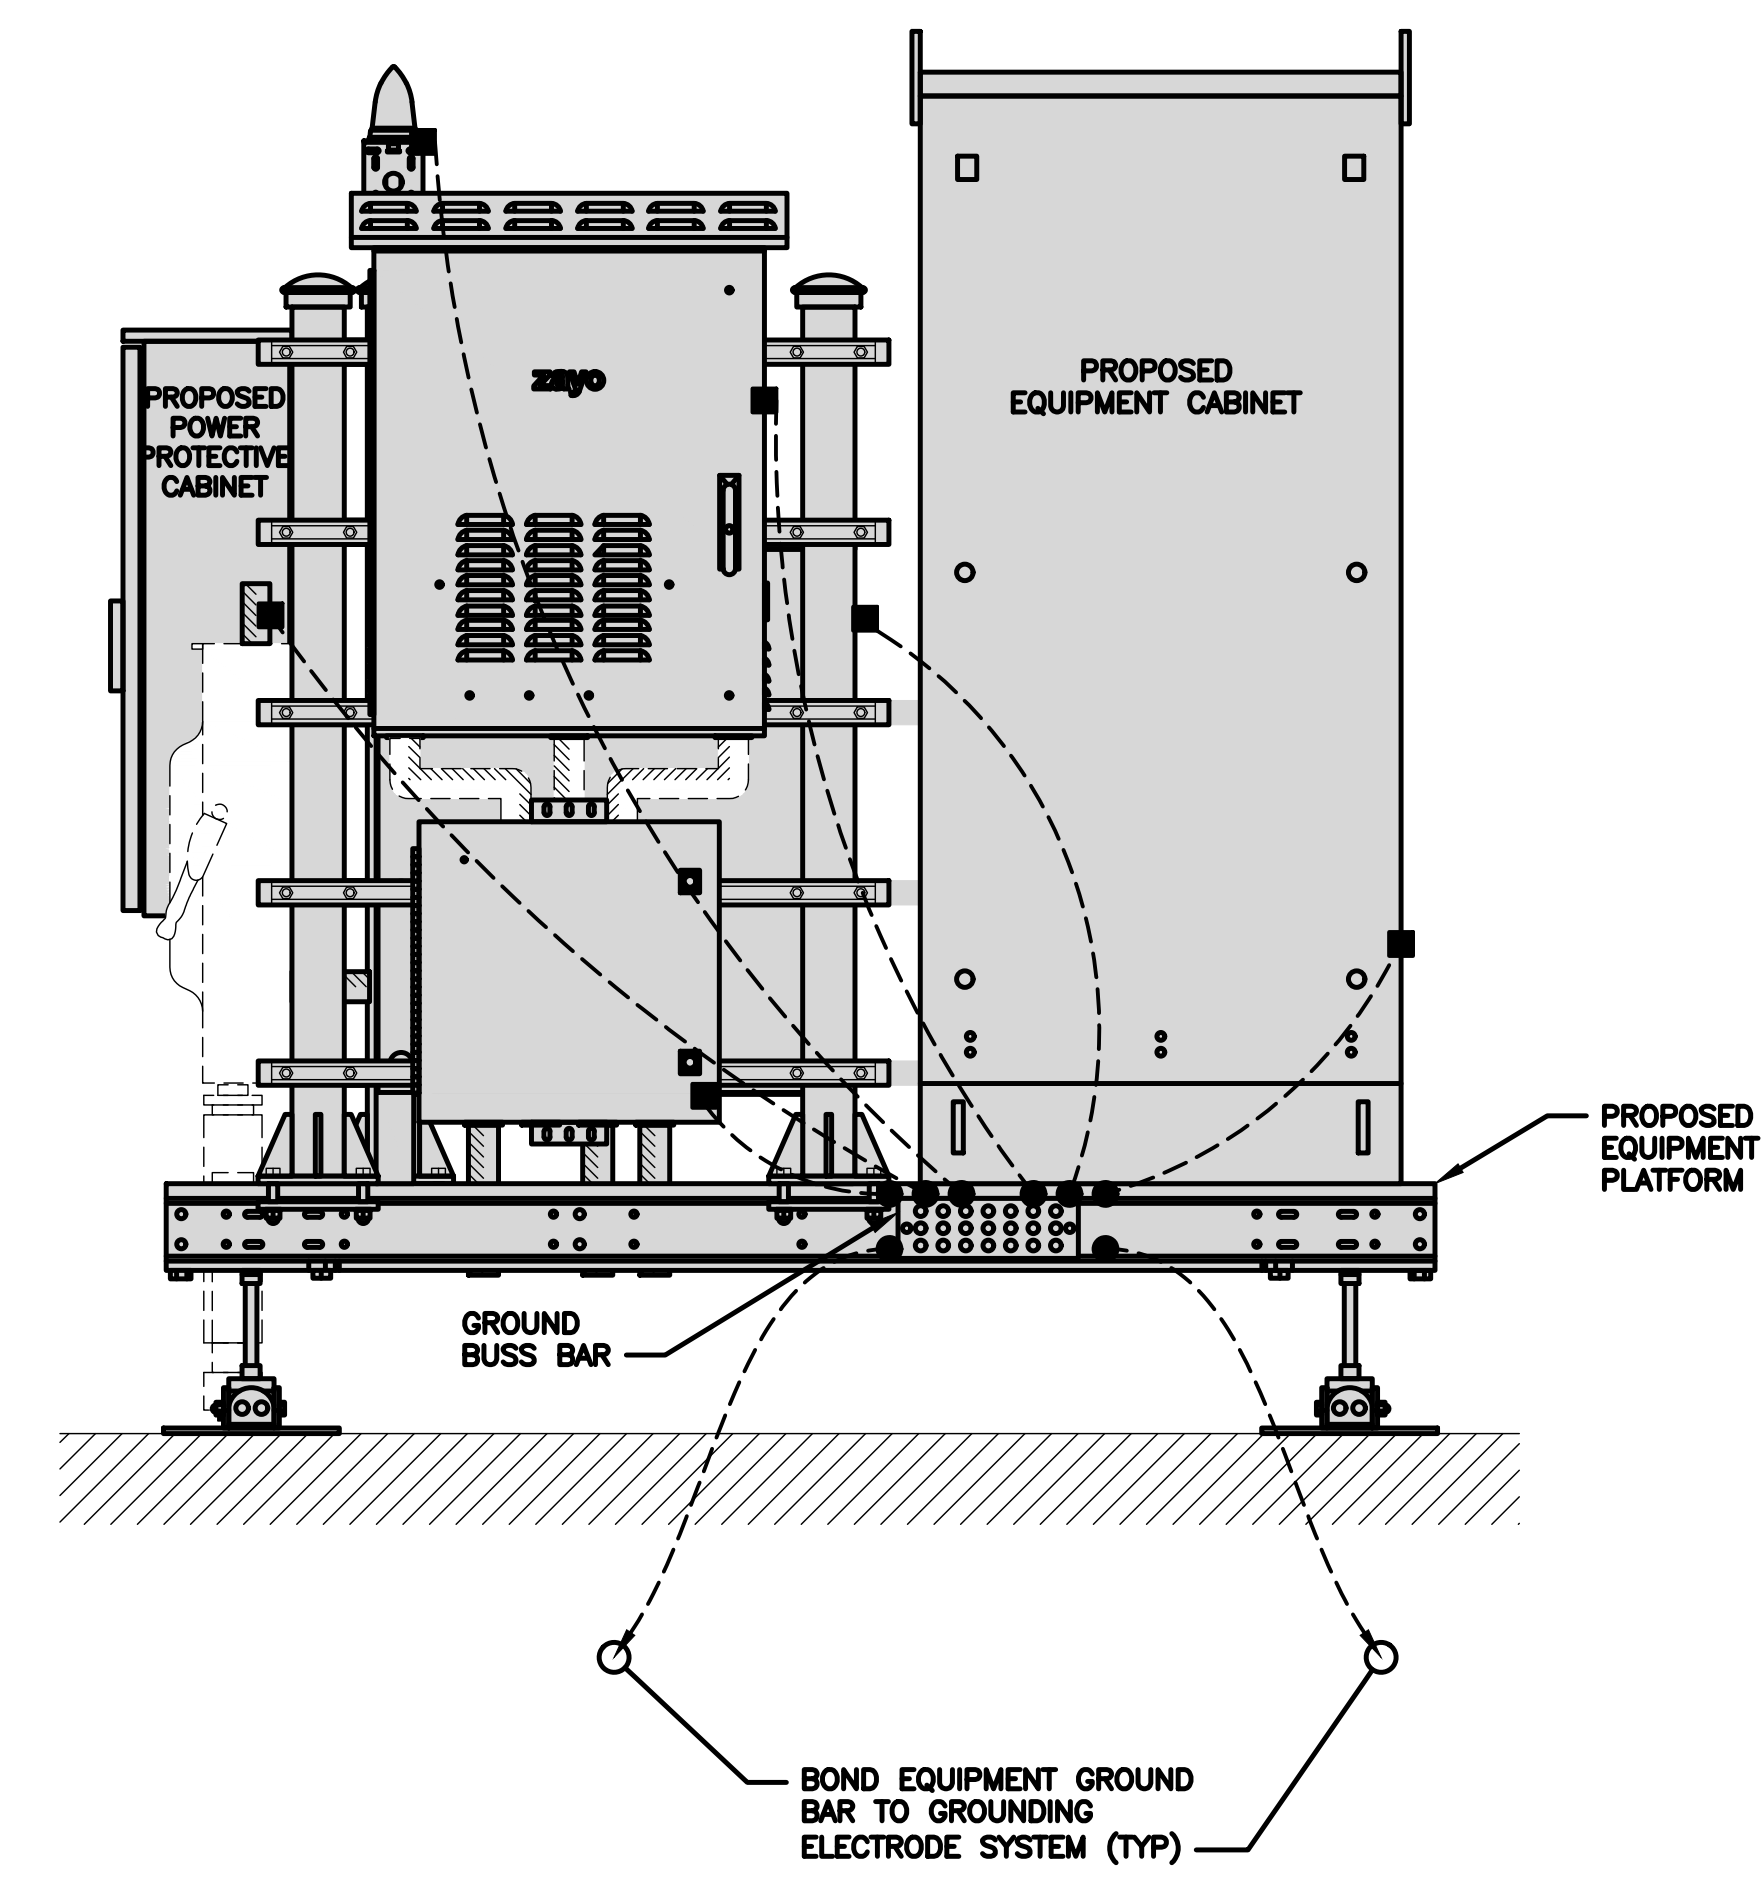

H-FRAME GROUNDING DETAIL

NO SCALE 3



5701 SOUTH SANTA FE DRIVE
LITTLETON, CO 80120



2840 HOWE ROAD, SUITE E
MARTINEZ, CA 94553
www.TheCBRGroup.com



IT IS A VIOLATION OF LAW FOR ANY PERSON, UNLESS THEY ARE ACTING UNDER THE DIRECTION OF A LICENSED PROFESSIONAL ENGINEER, TO ALTER THIS DOCUMENT.

DRAWN BY: CHECKED BY: APPROVED BY:
JG/WM --- ---

RFDS REV #: 02/02/2022 REV 4

CONSTRUCTION DOCUMENTS

SUBMITTALS		
REV	DATE	DESCRIPTION
A	02/10/2022	90% CD'S ISSUED FOR REVIEW
B	04/19/2022	100% CONSTRUCTION DRAWINGS
C	06/11/2022	PLAN CHECK COMMENTS



A&E PROJECT NUMBER
SFSF001158A

DISH Wireless L.L.C.
PROJECT INFORMATION
SFSF001158A
1300 COMMERCE ST
PETALUMA, CA 94954

SHEET TITLE
GROUNDING DETAILS

SHEET NUMBER
G-2

1. EXOTHERMIC WELD (2) TWO, #2 AWG BARE TINNED SOLID COPPER CONDUCTORS TO GROUND BAR. ROUTE CONDUCTORS TO BURIED GROUND RING AND PROVIDE PARALLEL EXOTHERMIC WELD.
2. ALL EXTERIOR GROUNDING HARDWARE SHALL BE STAINLESS STEEL 3/8" DIAMETER OR LARGER. ALL HARDWARE 18-8 STAINLESS STEEL INCLUDING LOCK WASHERS, COAT ALL SURFACES WITH AN ANTI-OXIDANT COMPOUND BEFORE MATING.
3. FOR GROUND BOND TO STEEL ONLY: COAT ALL SURFACES WITH AN ANTI-OXIDANT COMPOUND BEFORE MATING.
4. DO NOT INSTALL CABLE GROUNDING KIT AT A BEND AND ALWAYS DIRECT GROUND CONDUCTOR DOWN TO GROUNDING BUS.
5. NUT & WASHER SHALL BE PLACED ON THE FRONT SIDE OF THE GROUND BAR AND BOLTED ON THE BACK SIDE.
6. ALL GROUNDING PARTS AND EQUIPMENT TO BE SUPPLIED AND INSTALLED BY CONTRACTOR.
7. THE CONTRACTOR SHALL BE RESPONSIBLE FOR INSTALLING ADDITIONAL GROUND BAR AS REQUIRED.
8. ENSURE THE WIRE INSULATION TERMINATION IS WITHIN 1/8" OF THE BARREL (NO SHINERS).

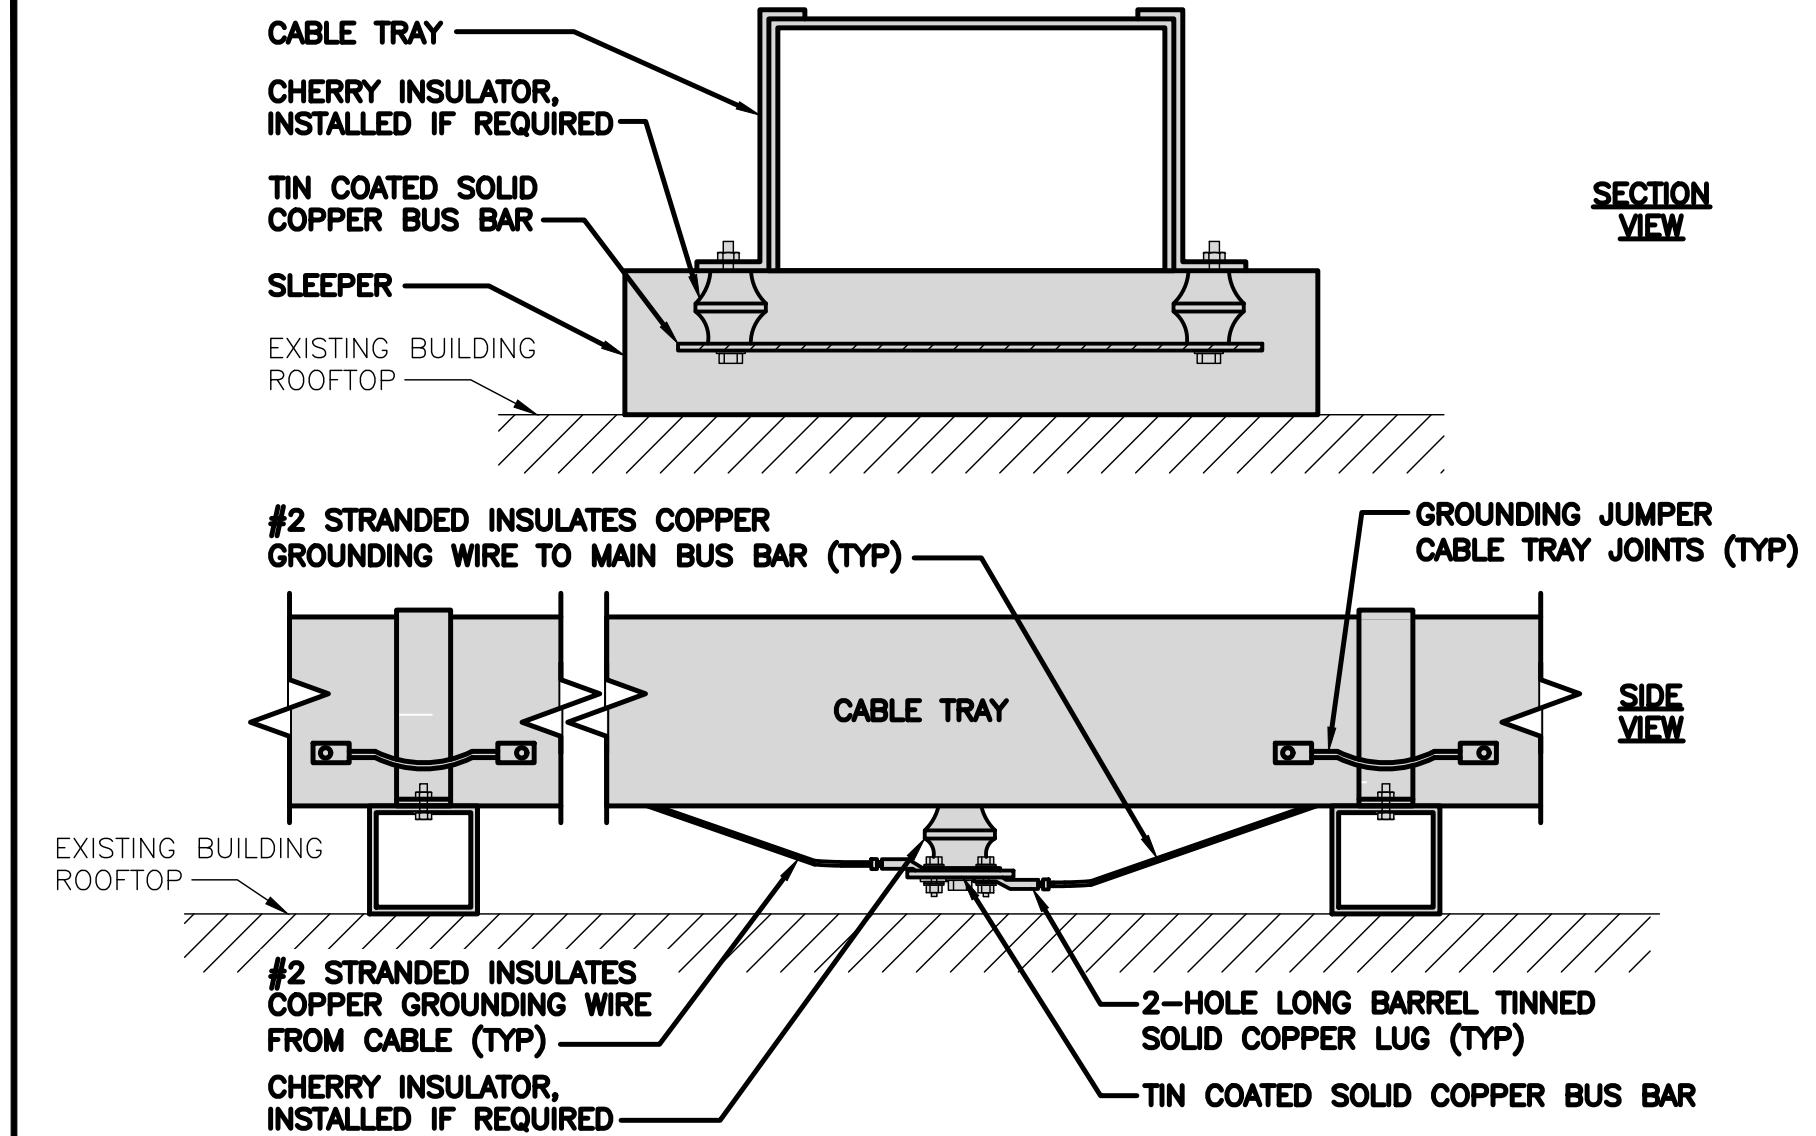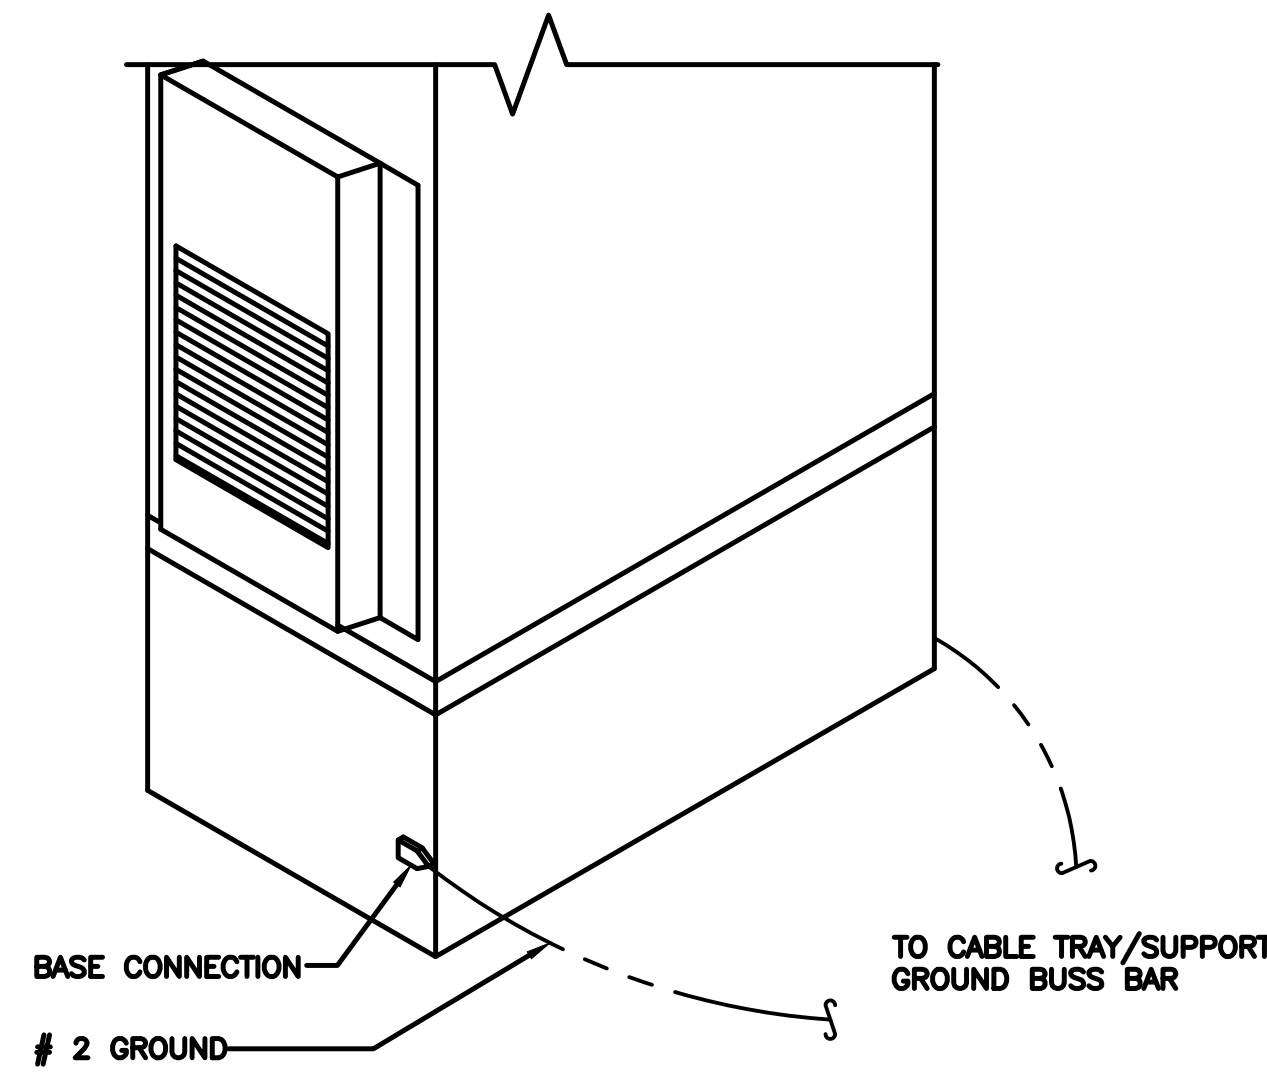

TYPICAL GROUNDING NOTES


NO SCALE 1

OUTDOOR CABINET GROUNDING

NO SCALE 2


TYPICAL CABLE TRAY GROUND BUSS BAR

NO SCALE 3

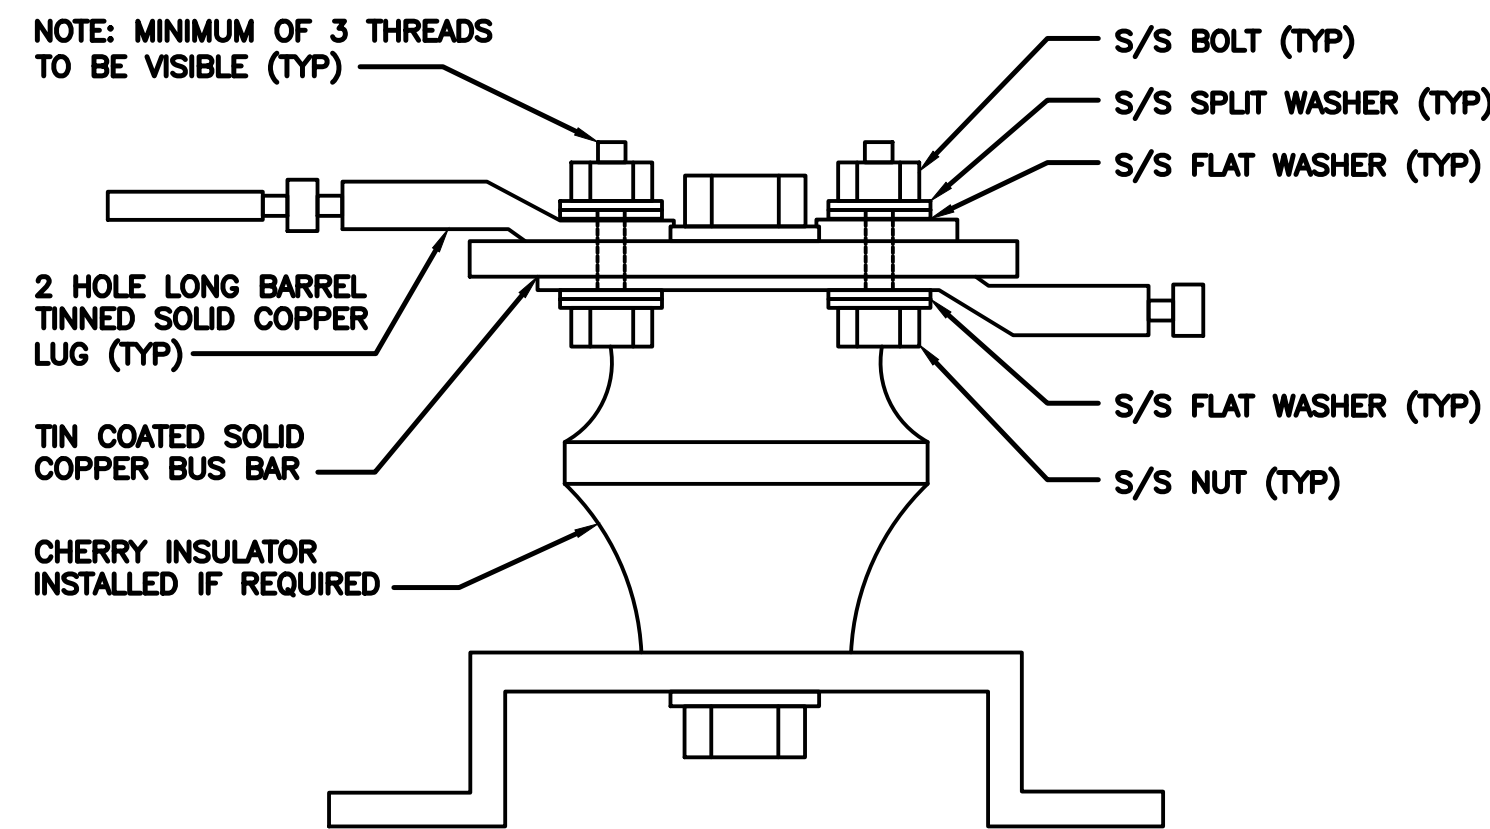


LUG DETAIL

NO SCALE 4

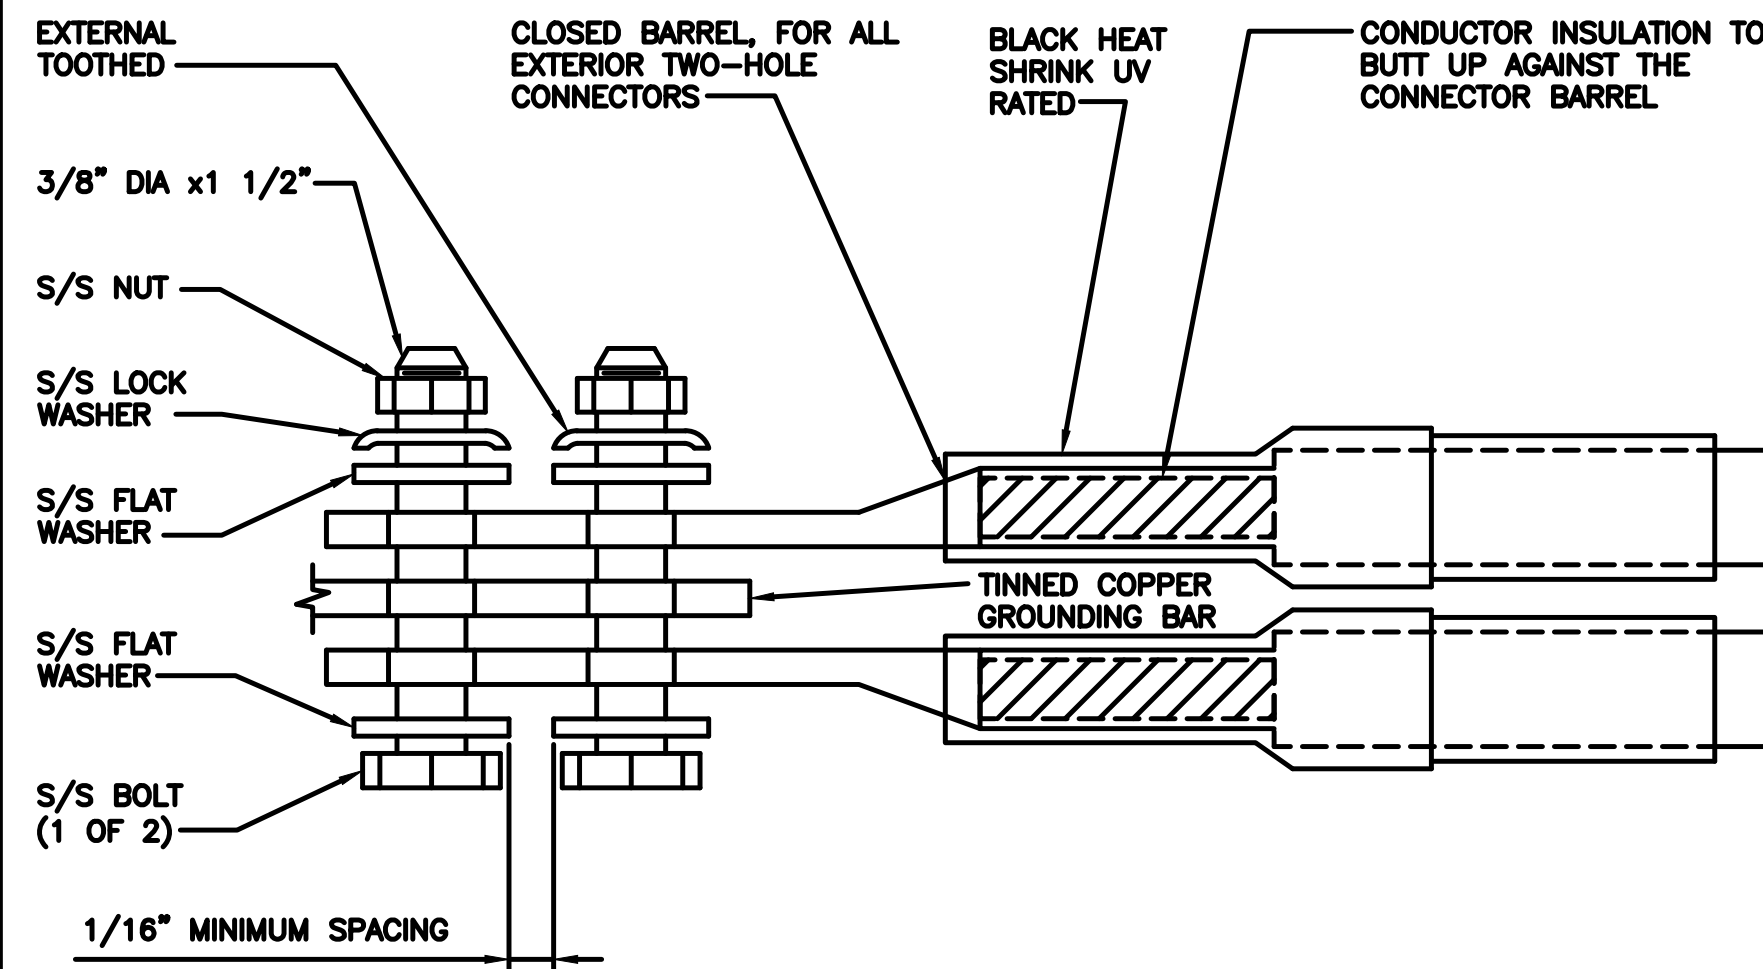

TYPICAL EXTERIOR TWO HOLE LUG

NO SCALE 5

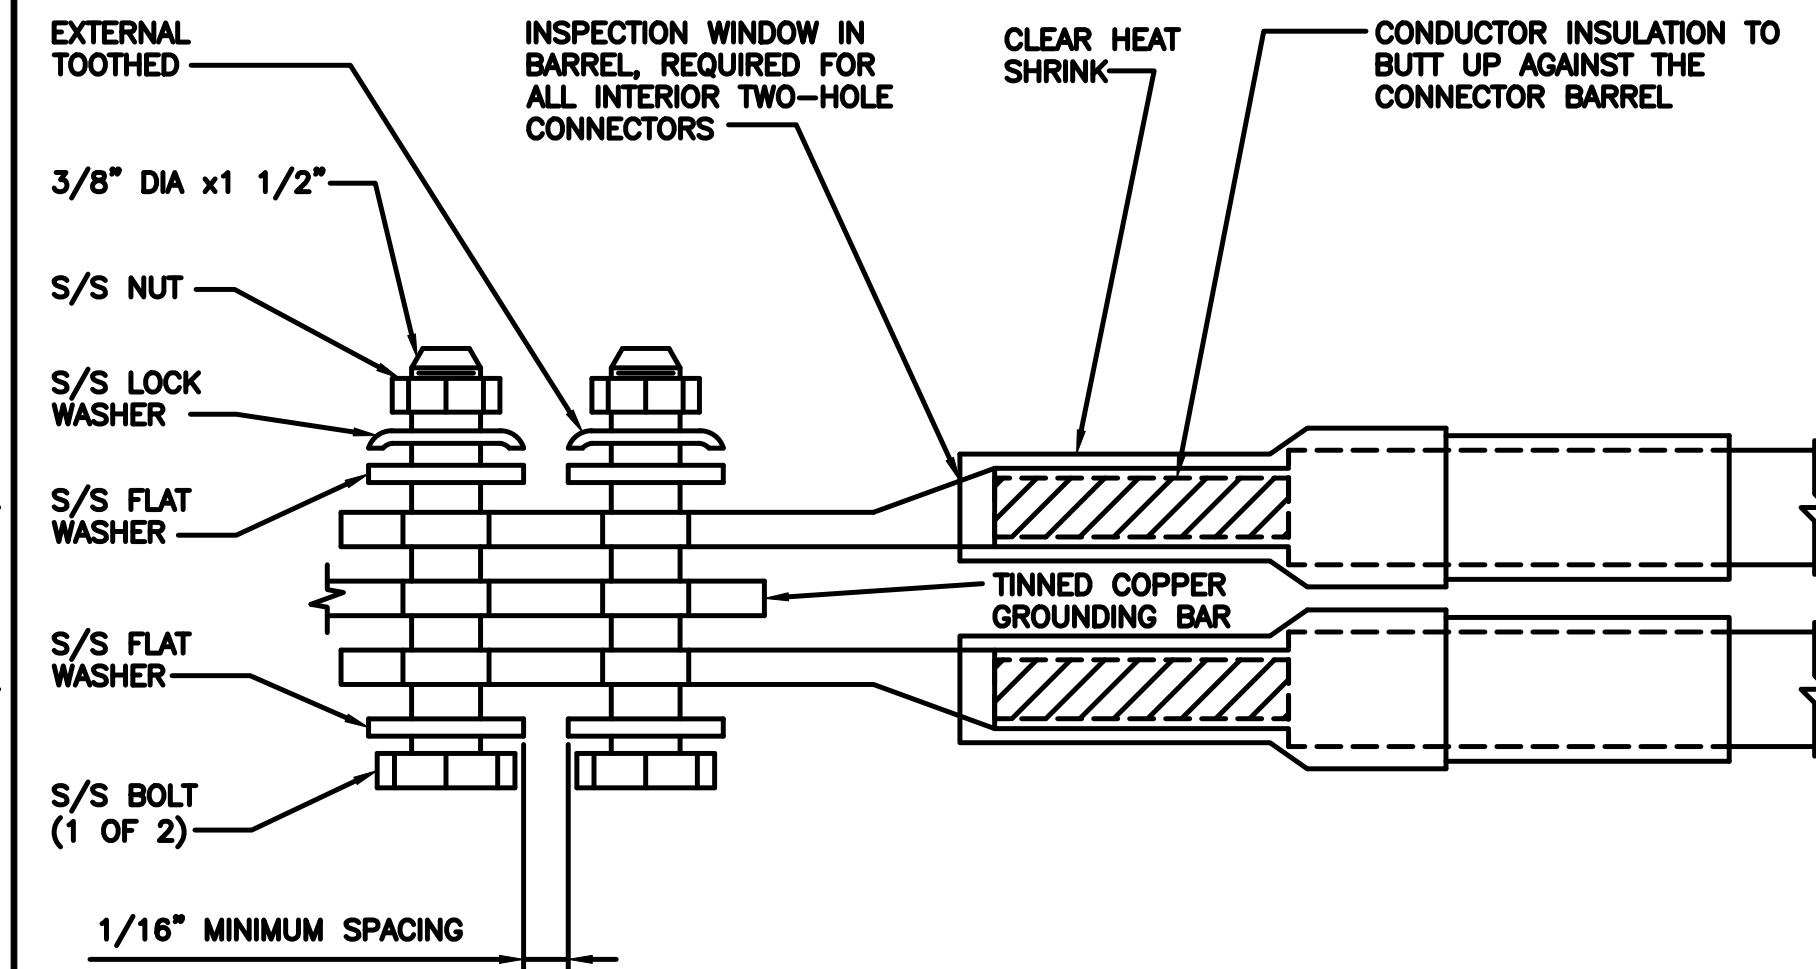

TYPICAL INTERIOR TWO HOLE LUG

NO SCALE 6

NOT USED

NO SCALE 7

NOT USED

NO SCALE 8

NOT USED


NO SCALE 9



5701 SOUTH SANTA FE DRIVE
LITTLETON, CO 80120



2840 HOWE ROAD, SUITE E
MARTINEZ, CA 94553
www.TheCBRGroup.com

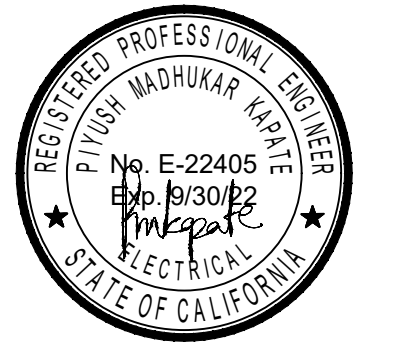

IT IS A VIOLATION OF LAW FOR ANY PERSON, UNLESS THEY ARE ACTING UNDER THE DIRECTION OF A LICENSED PROFESSIONAL ENGINEER, TO ALTER THIS DOCUMENT.

DRAWN BY: CHECKED BY: APPROVED BY:

JG/WM --- ---

RFDS REV #: 02/02/2022 REV 4

CONSTRUCTION DOCUMENTS

SUBMITTALS		
REV	DATE	DESCRIPTION
A	02/10/2022	90% CD'S ISSUED FOR REVIEW
B	04/19/2022	100% CONSTRUCTION DRAWINGS
C	06/11/2022	PLAN CHECK COMMENTS

A&E PROJECT NUMBER
SFSF001158A

DISH Wireless L.L.C.
PROJECT INFORMATION

SFSF001158A
1300 COMMERCE ST
PETALUMA, CA 94954

SHEET TITLE
GROUNDING DETAILS


SHEET NUMBER

G-3


HYBRID/DISCREET CABLES

3/4" TAPE WIDTHS WITH 3/4" SPACING

LOW-BAND RRH
(600 MHz N71 BASEBAND) +
(850 MHz N26 BAND) +
(700 MHz N29 BAND) - OPTIONAL PER MARKET
ADD FREQUENCY COLOR TO SECTOR BAND
(CBRS WILL USE YELLOW BAND)

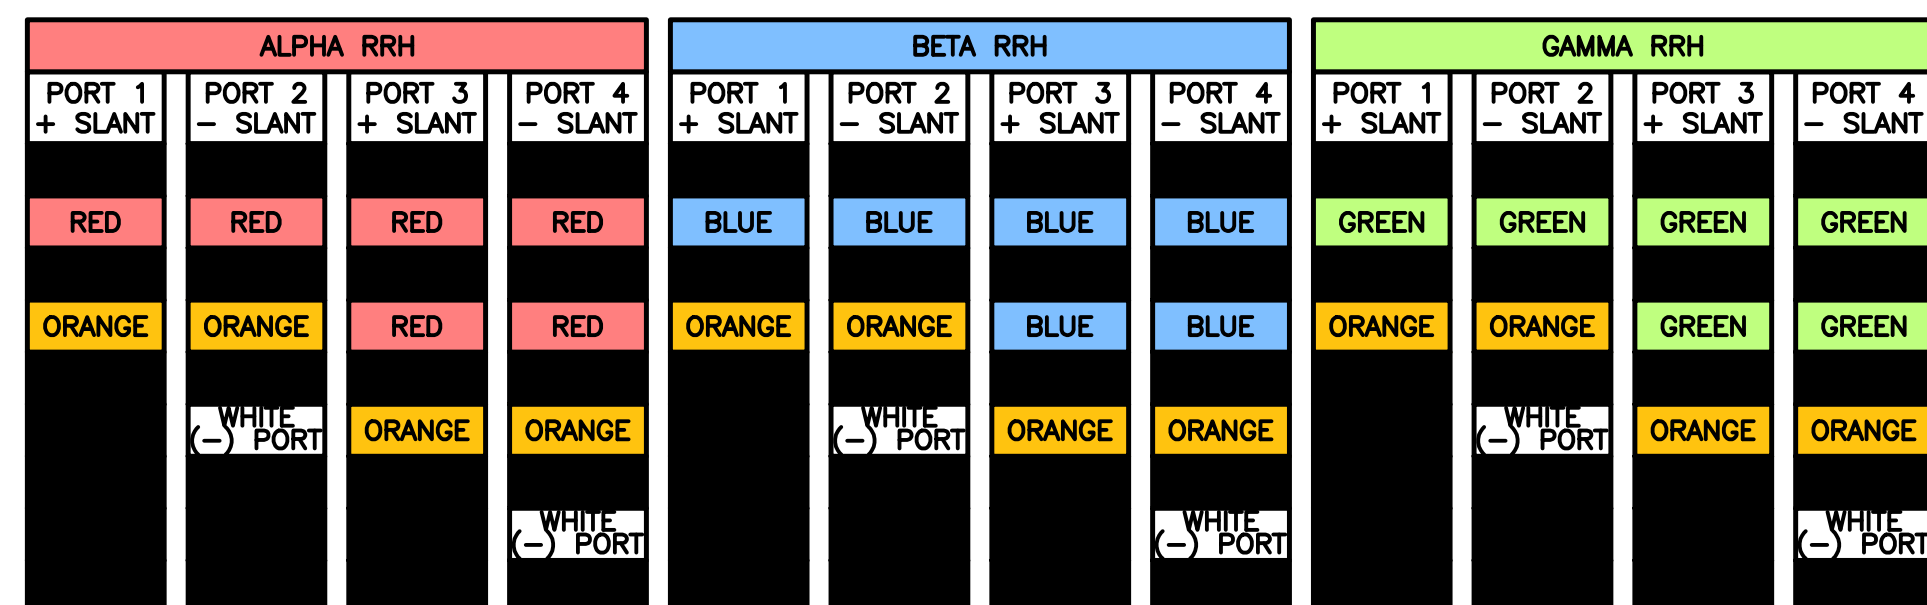

MID-BAND RRH
(AWS BANDS N66+N70)
ADD FREQUENCY COLOR TO SECTOR BAND
(CBRS WILL USE YELLOW BANDS)

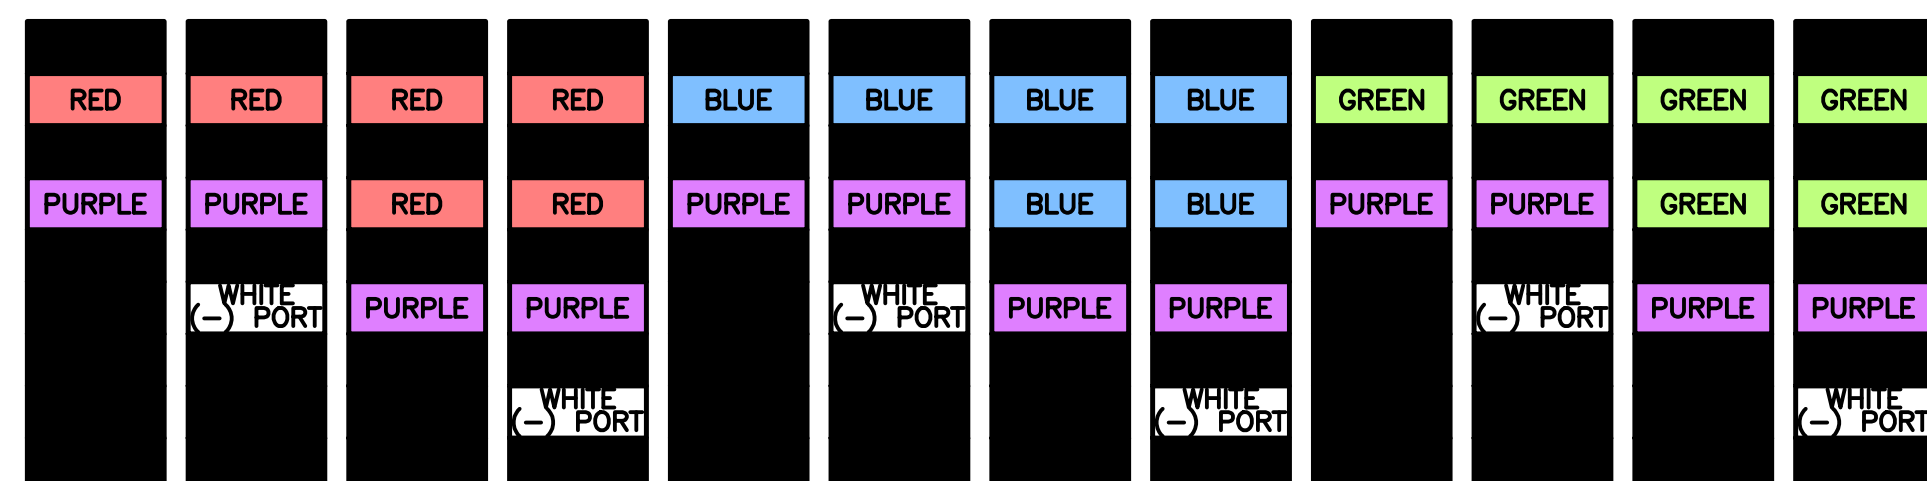


HYBRID/DISCREET CABLES

INCLUDE SECTOR BANDS BEING SUPPORTED
ALONG WITH FREQUENCY BANDS.

EXAMPLE 1 - HYBRID, OR DISCREET, SUPPORTS
ALL SECTORS, BOTH LOW-BANDS AND
MID-BANDS.


EXAMPLE 2 - HYBRID, OR DISCREET, SUPPORTS
CBRS ONLY, ALL SECTORS.

EXAMPLE 3 - MAIN COAX WITH GROUND
MOUNTED RRHS.

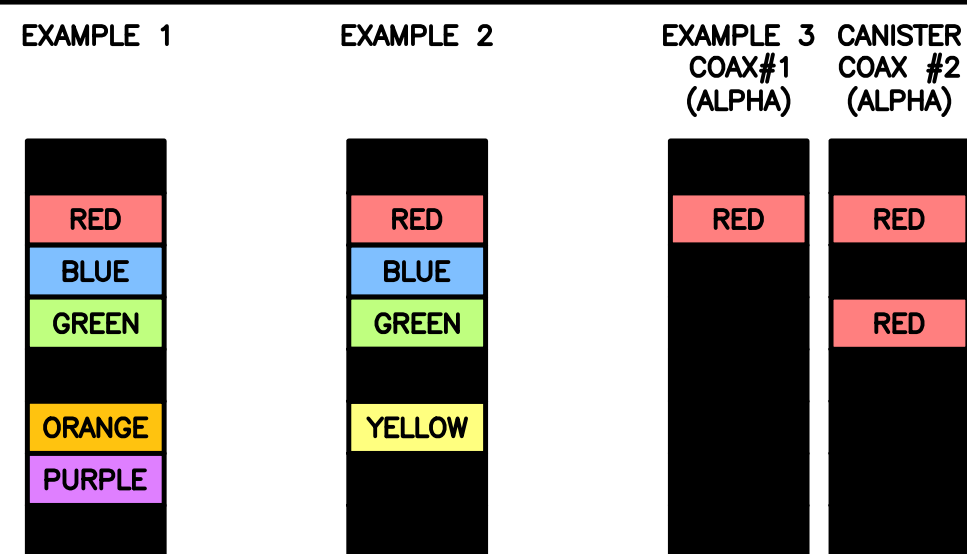


FIBER JUMPERS TO RRHS

LOW-BAND HHR FIBER CABLES HAVE SECTOR
STRIPE ONLY.

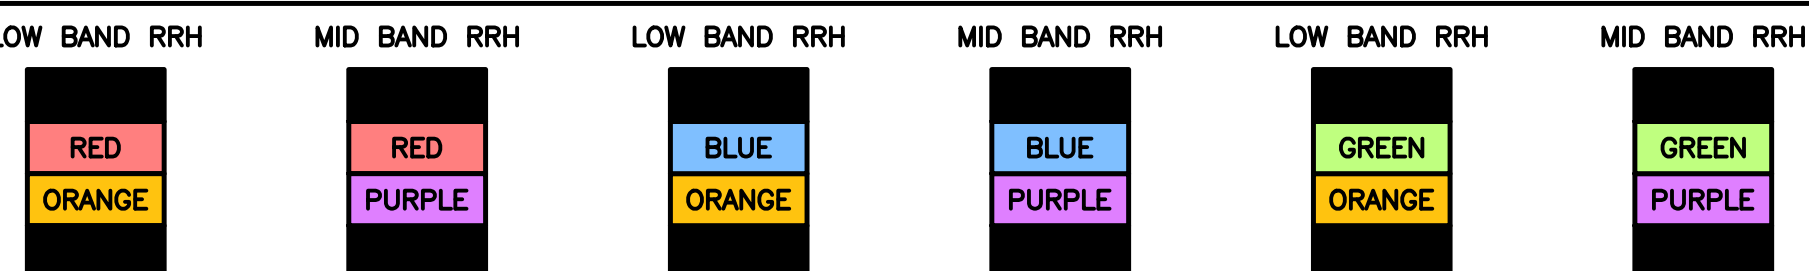

POWER CABLES TO RRHS


LOW-BAND RRH POWER CABLES HAVE SECTOR
STRIPE ONLY

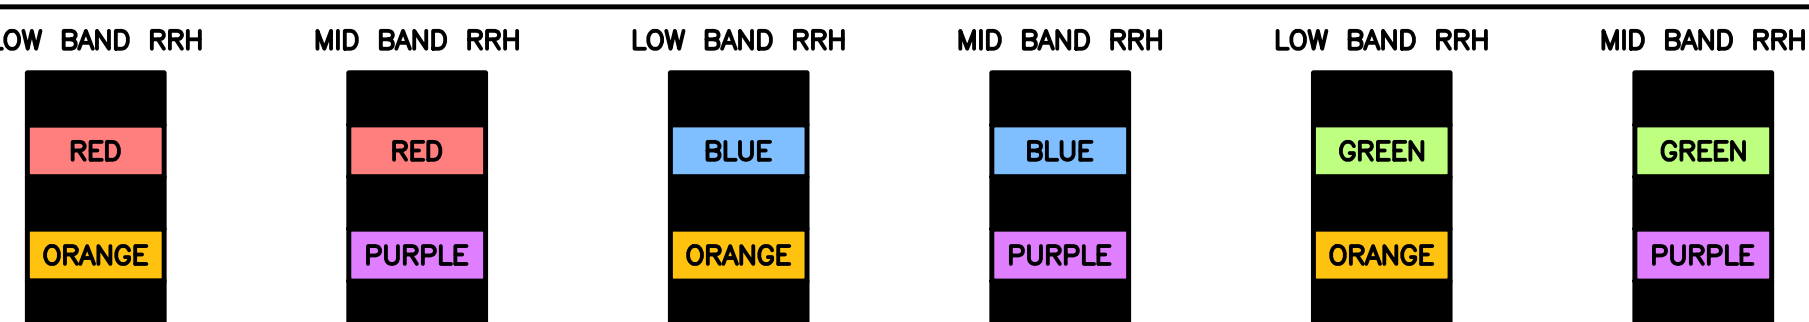

RET MOTORS AT ANTENNAS

RET CONTROL IS HANDLED BY THE MID-BAND
RRH WHEN ONE SET OF RET PORTS EXIST ON
ANTENNA.


SEPARATE RET CABLES ARE USED WHEN
ANTENNA PORTS PROVIDE INPUTS FOR BOTH
LOW AND MID BANDS.

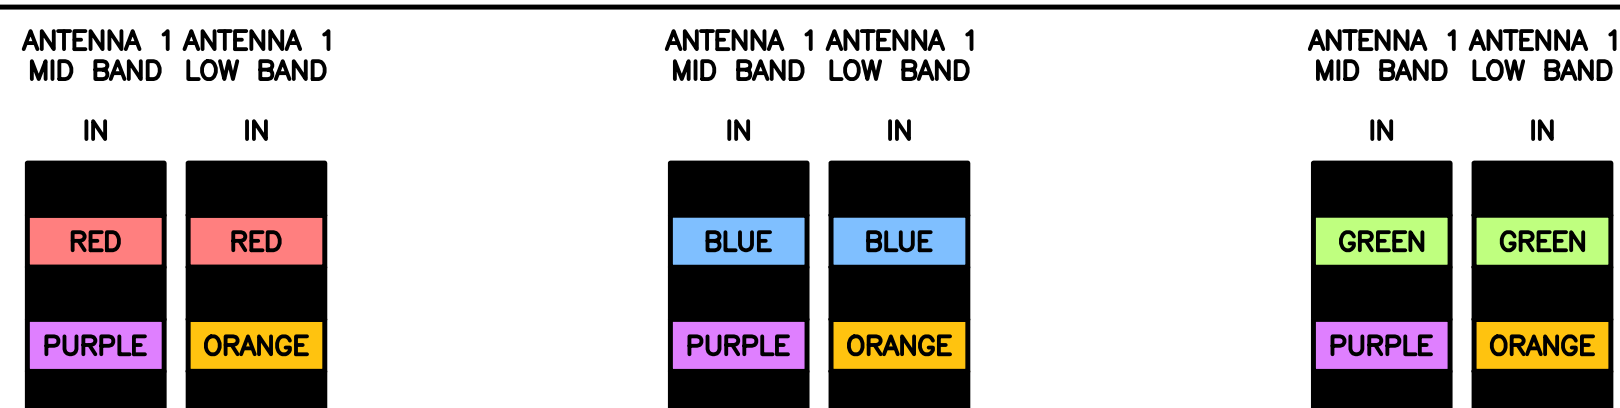

MICROWAVE RADIO LINKS

LINKS WILL HAVE A 1.5-2 INCH WHITE WRAP
WITH THE AZIMUTH COLOR OVERLAPPING IN THE
MIDDLE.
ADD ADDITIONAL SECTOR COLOR BANDS FOR
EACH ADDITIONAL MW RADIO.

MICROWAVE CABLES WILL REQUIRE P-TOUCH
LABELS INSIDE THE CABINET TO IDENTIFY THE
LOCAL AND REMOTE SITE ID'S.

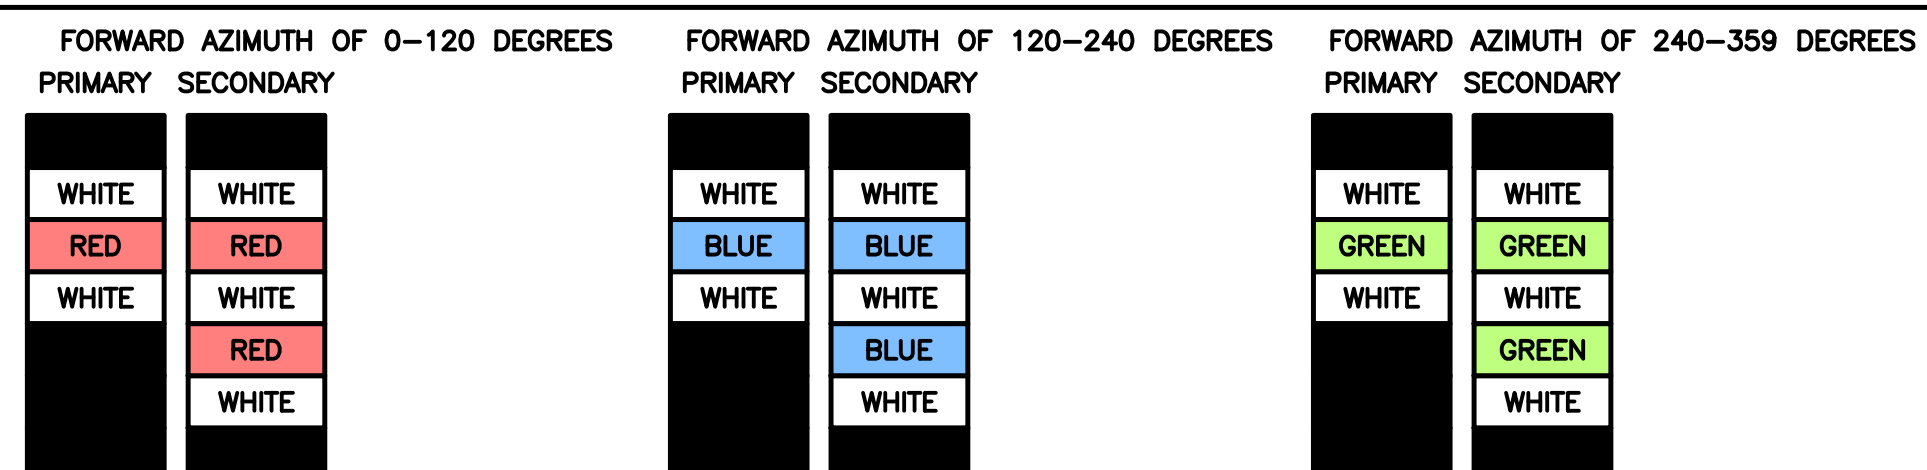

RF CABLE COLOR CODES

NO SCALE

1


LOW BANDS (N71+N26)
OPTIONAL - (N29)




AWS
(N66+N70+H-BLOCK)



CBRS TECH
(3 GHz)

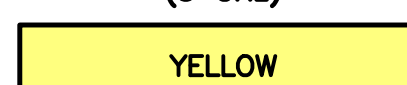

NEGATIVE SLANT PORT
ON ANT/RRH

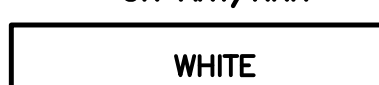

ALPHA SECTOR



BETA SECTOR



GAMMA SECTOR



COLOR IDENTIFIER

NO SCALE

2

NOT USED

NO SCALE

3

NOT USED

NO SCALE

4



5701 SOUTH SANTA FE DRIVE
LITTLETON, CO 80120



2840 HOWE ROAD, SUITE E
MARTINEZ, CA 94553
www.TheCBRGroup.com



IT IS A VIOLATION OF LAW FOR ANY PERSON,
UNLESS THEY ARE ACTING UNDER THE DIRECTION
OF A LICENSED PROFESSIONAL ENGINEER,
TO ALTER THIS DOCUMENT.

DRAWN BY: CHECKED BY: APPROVED BY:
JG/WM --- ---

RFDS REV #: 02/02/2022 REV 4

CONSTRUCTION DOCUMENTS

SUBMITTALS		
REV	DATE	DESCRIPTION
A	02/10/2022	90% CD'S ISSUED FOR REVIEW
B	04/19/2022	100% CONSTRUCTION DRAWINGS
C	06/11/2022	PLAN CHECK COMMENTS




A&E PROJECT NUMBER
SFSF001158A

DISH Wireless L.L.C.
PROJECT INFORMATION
SFSF001158A
1300 COMMERCE ST
PETALUMA, CA 94954

SHEET TITLE
RF
CABLE COLOR CODE

SHEET NUMBER
RF-1

EXOTHERMIC CONNECTION
 MECHANICAL CONNECTION
 BUSS BAR INSULATOR
 CHEMICAL ELECTROLYTIC GROUNDING SYSTEM
 TEST CHEMICAL ELECTROLYTIC GROUNDING SYSTEM
 EXOTHERMIC WITH INSPECTION SLEEVE
 GROUNDING BAR
 GROUND ROD
 TEST GROUND ROD WITH INSPECTION SLEEVE
 SINGLE POLE SWITCH
 DUPLEX RECEPTACLE
 DUPLEX GFCI RECEPTACLE
 FLUORESCENT LIGHTING FIXTURE (2) TWO LAMPS 48-T8
 SMOKE DETECTION (DC)
 EMERGENCY LIGHTING (DC)
 SECURITY LIGHT W/PHOTOCELL LITHONIA ALXW
 LED-1-25A400/51K-SR4-120-PE-DOBTD
 CHAIN LINK FENCE
 WOOD/WROUGHT IRON FENCE
 WALL STRUCTURE
 LEASE AREA
 PROPERTY LINE (PL)
 SETBACKS
 ICE BRIDGE
 CABLE TRAY
 WATER LINE
 UNDERGROUND POWER
 UNDERGROUND TELCO
 OVERHEAD POWER
 OVERHEAD TELCO
 UNDERGROUND TELCO/POWER
 ABOVE GROUND POWER
 ABOVE GROUND TELCO
 ABOVE GROUND TELCO/POWER
 WORKPOINT

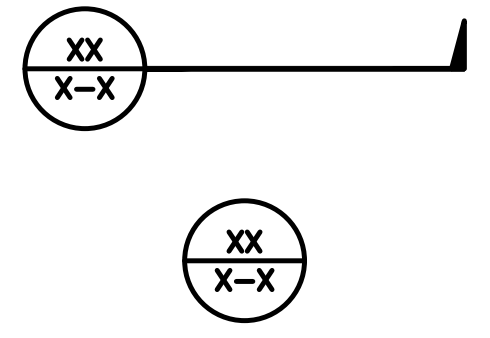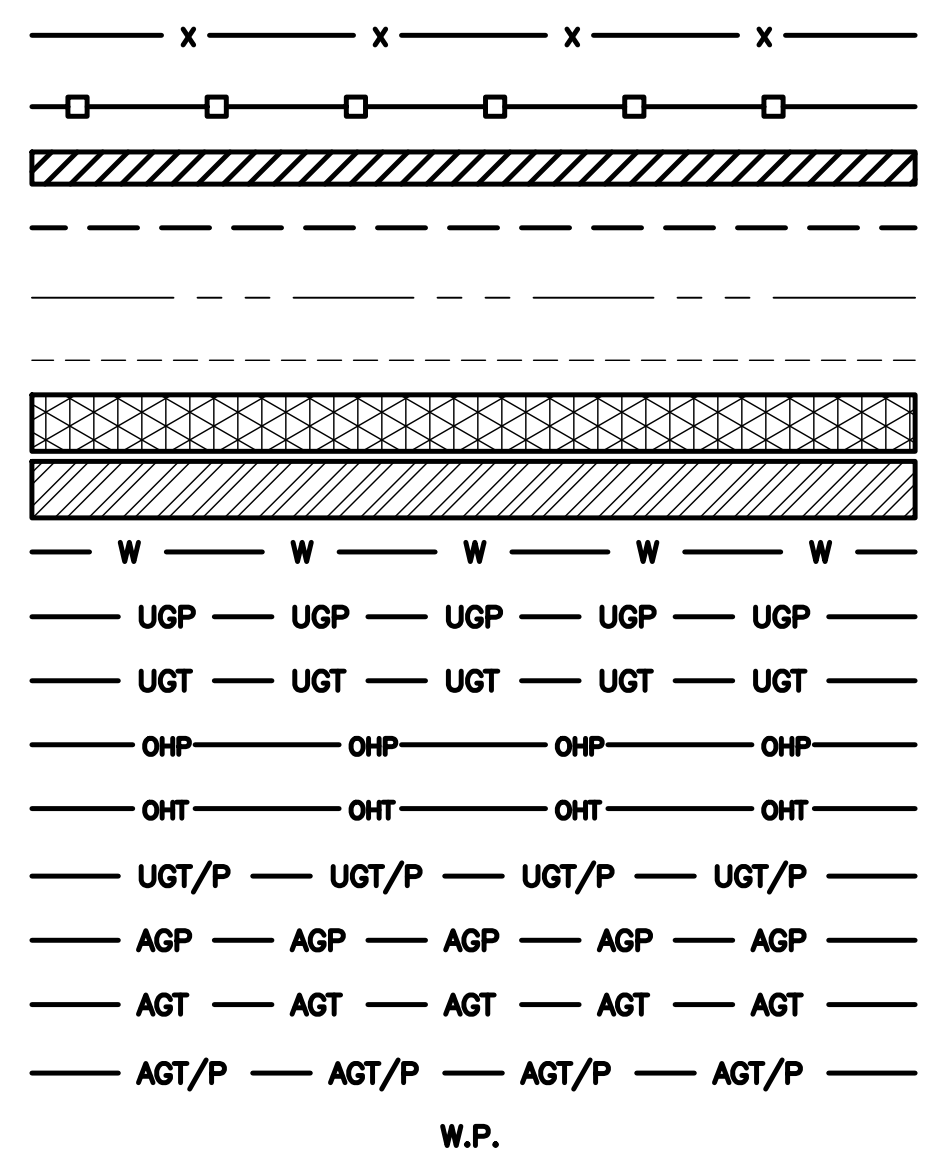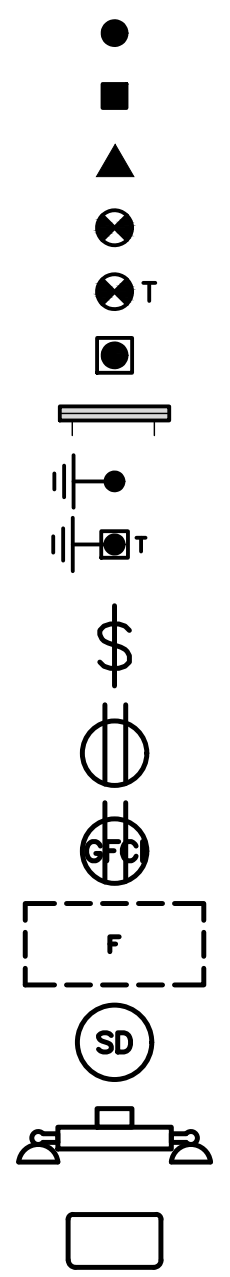

SECTION REFERENCE

DETAIL REFERENCE

LEGEND

AB ANCHOR BOLT	IN INCH
ABV ABOVE	INT INTERIOR
AC ALTERNATING CURRENT	LB(S) POUND(S)
ADDL ADDITIONAL	LF LINEAR FEET
AFF ABOVE FINISHED FLOOR	LTE LONG TERM EVOLUTION
AFG ABOVE FINISHED GRADE	MAS MASONRY
AGL ABOVE GROUND LEVEL	MAX MAXIMUM
AIC AMPERAGE INTERRUPTION CAPACITY	MB MACHINE BOLT
ALUM ALUMINUM	MECH MECHANICAL
ALT ALTERNATE	MFR MANUFACTURER
ANT ANTENNA	MGB MASTER GROUND BAR
APPROX APPROXIMATE	MIN MINIMUM
ARCH ARCHITECTURAL	MISC MISCELLANEOUS
ATS AUTOMATIC TRANSFER SWITCH	MTL METAL
AWG AMERICAN WIRE GAUGE	MTS MANUAL TRANSFER SWITCH
BATT BATTERY	MW MICROWAVE
BLDG BUILDING	NEC NATIONAL ELECTRIC CODE
BLK BLOCK	NM NEWTON METERS
BLKG BLOCKING	NO. NUMBER
BM BEAM	# NUMBER
BTC BARE TINNED COPPER CONDUCTOR	NTS NOT TO SCALE
BOF BOTTOM OF FOOTING	OC ON-CENTER
CAB CABINET	OSHA OCCUPATIONAL SAFETY AND HEALTH ADMINISTRATION
CANT CANTILEVERED	OPNG OPENING
CHG CHARGING	P/C PRECAST CONCRETE
CLG CEILING	PCS PERSONAL COMMUNICATION SERVICES
CLR CLEAR	PCU PRIMARY CONTROL UNIT
COL COLUMN	PRC PRIMARY RADIO CABINET
COMM COMMON	PP POLARIZING PRESERVING
CONC CONCRETE	PSF POUNDS PER SQUARE FOOT
CONSTR CONSTRUCTION	PSI POUNDS PER SQUARE INCH
DBL DOUBLE	PT PRESSURE TREATED
DC DIRECT CURRENT	PWR POWER CABINET
DEPT DEPARTMENT	QTY QUANTITY
DF DOUGLAS FIR	RAD RADIUS
DIA DIAMETER	RECT RECTIFIER
DIAG DIAGONAL	REF REFERENCE
DIM DIMENSION	REINF REINFORCEMENT
DWG DRAWING	REQ'D REQUIRED
DWL DOWEL	RET REMOTE ELECTRIC TILT
EA EACH	RF RADIO FREQUENCY
EC ELECTRICAL CONDUCTOR	RMC RIGID METALLIC CONDUIT
EL ELEVATION	RRH REMOTE RADIO HEAD
ELEC ELECTRICAL	RRU REMOTE RADIO UNIT
EMT ELECTRICAL METALLIC TUBING	RWY RACEWAY
ENG ENGINEER	SCH SCHEDULE
EQ EQUAL	SHT SHEET
EXP EXPANSION	SIAD SMART INTEGRATED ACCESS DEVICE
EXT EXTERIOR	SIM SIMILAR
EW EACH WAY	SPEC SPECIFICATION
FAB FABRICATION	SQ SQUARE
FF FINISH FLOOR	SS STAINLESS STEEL
FG FINISH GRADE	STD STANDARD
FIF FACILITY INTERFACE FRAME	STL STEEL
FIN FINISH(ED)	TEMP TEMPORARY
FLR FLOOR	THK THICKNESS
FDN FOUNDATION	TMA TOWER MOUNTED AMPLIFIER
FOC FACE OF CONCRETE	TN TOE NAIL
FOM FACE OF MASONRY	TOA TOP OF ANTENNA
FOS FACE OF STUD	TOC TOP OF CURB
FOW FACE OF WALL	TOF TOP OF FOUNDATION
FS FINISH SURFACE	TOP TOP OF PLATE (PARAPET)
FT FOOT	TOS TOP OF STEEL
FTG FOOTING	TOW TOP OF WALL
GA GAUGE	TVSS TRANSIENT VOLTAGE SURGE SUPPRESSION
GEN GENERATOR	TYP TYPICAL
GFCI GROUND FAULT CIRCUIT INTERRUPTER	UG UNDERGROUND
GLB GLUE LAMINATED BEAM	UL UNDERWRITERS LABORATORY
GLV GALVANIZED	UNO UNLESS NOTED OTHERWISE
GPS GLOBAL POSITIONING SYSTEM	UMTS UNIVERSAL MOBILE TELECOMMUNICATIONS SYSTEM
GND GROUND	UPS UNINTERRUPTIBLE POWER SYSTEM (DC POWER PLANT)
GSM GLOBAL SYSTEM FOR MOBILE	VIF VERIFIED IN FIELD
HDG HOT DIPPED GALVANIZED	W WIDE
HDR HEADER	W/ WITH
HGR HANGER	WD WOOD
HVAC HEAT/VENTILATION/AIR CONDITIONING	WP WEATHERPROOF
HT HEIGHT	WT WEIGHT
IGR INTERIOR GROUND RING	

ABBREVIATIONS



5701 SOUTH SANTA FE DRIVE
 LITTLETON, CO 80120



2840 HOWE ROAD, SUITE E
 MARTINEZ, CA 94553
 www.TheCBRGroup.com



IT IS A VIOLATION OF LAW FOR ANY PERSON, UNLESS THEY ARE ACTING UNDER THE DIRECTION OF A LICENSED PROFESSIONAL ENGINEER, TO ALTER THIS DOCUMENT.

DRAWN BY:	CHECKED BY:	APPROVED BY:
JG/WM	---	---

RFDS REV #: 02/02/2022 REV 4

CONSTRUCTION DOCUMENTS

SUBMITTALS		
REV	DATE	DESCRIPTION
A	02/10/2022	90% CD'S ISSUED FOR REVIEW
B	04/19/2022	100% CONSTRUCTION DRAWINGS
C	06/11/2022	PLAN CHECK COMMENTS

A&E PROJECT NUMBER
 SFSF001158A

DISH Wireless L.L.C.
 PROJECT INFORMATION
 SFSF001158A
 1300 COMMERCE ST
 PETALUMA, CA 94954

SHEET TITLE
 LEGEND AND ABBREVIATIONS

SHEET NUMBER
GN-1

SITE ACTIVITY REQUIREMENTS:

1. NOTICE TO PROCEED – NO WORK SHALL COMMENCE PRIOR TO CONTRACTOR RECEIVING A WRITTEN NOTICE TO PROCEED (NTP) AND THE ISSUANCE OF A PURCHASE ORDER. PRIOR TO ACCESSING/ENTERING THE SITE YOU MUST CONTACT THE DISH Wireless L.L.C. AND TOWER OWNER NOC & THE DISH Wireless L.L.C. AND TOWER OWNER CONSTRUCTION MANAGER.
2. "LOOK UP" – DISH Wireless L.L.C. AND TOWER OWNER SAFETY CLIMB REQUIREMENT:
THE INTEGRITY OF THE SAFETY CLIMB AND ALL COMPONENTS OF THE CLIMBING FACILITY SHALL BE CONSIDERED DURING ALL STAGES OF DESIGN, INSTALLATION, AND INSPECTION. TOWER MODIFICATION, MOUNT REINFORCEMENTS, AND/OR EQUIPMENT INSTALLATIONS SHALL NOT COMPROMISE THE INTEGRITY OR FUNCTIONAL USE OF THE SAFETY CLIMB OR ANY COMPONENTS OF THE CLIMBING FACILITY ON THE STRUCTURE. THIS SHALL INCLUDE, BUT NOT BE LIMITED TO: PINCHING OF THE WIRE ROPE, BENDING OF THE WIRE ROPE FROM ITS SUPPORTS, DIRECT CONTACT OR CLOSE PROXIMITY TO THE WIRE ROPE WHICH MAY CAUSE FRICTIONAL WEAR, IMPACT TO THE ANCHORAGE POINTS IN ANY WAY, OR TO IMPEDE/BLOCK ITS INTENDED USE. ANY COMPROMISED SAFETY CLIMB, INCLUDING EXISTING CONDITIONS MUST BE TAGGED OUT AND REPORTED TO YOUR DISH Wireless L.L.C. AND DISH Wireless L.L.C. AND TOWER OWNER POC OR CALL THE NOC TO GENERATE A SAFETY CLIMB MAINTENANCE AND CONTRACTOR NOTICE TICKET.
3. PRIOR TO THE START OF CONSTRUCTION, ALL REQUIRED JURISDICTIONAL PERMITS SHALL BE OBTAINED. THIS INCLUDES, BUT IS NOT LIMITED TO, BUILDING, ELECTRICAL, MECHANICAL, FIRE, FLOOD ZONE, ENVIRONMENTAL, AND ZONING. AFTER ONSITE ACTIVITIES AND CONSTRUCTION ARE COMPLETED, ALL REQUIRED PERMITS SHALL BE SATISFIED AND CLOSED OUT ACCORDING TO LOCAL JURISDICTIONAL REQUIREMENTS.
4. ALL CONSTRUCTION MEANS AND METHODS; INCLUDING BUT NOT LIMITED TO, ERECTION PLANS, RIGGING PLANS, CLIMBING PLANS, AND RESCUE PLANS SHALL BE THE RESPONSIBILITY OF THE GENERAL CONTRACTOR RESPONSIBLE FOR THE EXECUTION OF THE WORK CONTAINED HEREIN, AND SHALL MEET ANSI/ASSE A10.48 (LATEST EDITION); FEDERAL, STATE, AND LOCAL REGULATIONS; AND ANY APPLICABLE INDUSTRY CONSENSUS STANDARDS RELATED TO THE CONSTRUCTION ACTIVITIES BEING PERFORMED. ALL RIGGING PLANS SHALL ADHERE TO ANSI/ASSE A10.48 (LATEST EDITION) AND DISH Wireless L.L.C. AND TOWER OWNER STANDARDS, INCLUDING THE REQUIRED INVOLVEMENT OF A QUALIFIED ENGINEER FOR CLASS IV CONSTRUCTION, TO CERTIFY THE SUPPORTING STRUCTURE(S) IN ACCORDANCE WITH ANSI/TIA-322 (LATEST EDITION).
5. ALL SITE WORK TO COMPLY WITH DISH Wireless L.L.C. AND TOWER OWNER INSTALLATION STANDARDS FOR CONSTRUCTION ACTIVITIES ON DISH Wireless L.L.C. AND TOWER OWNER TOWER SITE AND LATEST VERSION OF ANSI/TIA-1019-A-2012 "STANDARD FOR INSTALLATION, ALTERATION, AND MAINTENANCE OF ANTENNA SUPPORTING STRUCTURES AND ANTENNAS."
6. IF THE SPECIFIED EQUIPMENT CAN NOT BE INSTALLED AS SHOWN ON THESE DRAWINGS, THE CONTRACTOR SHALL PROPOSE AN ALTERNATIVE INSTALLATION FOR APPROVAL BY DISH Wireless L.L.C. AND TOWER OWNER PRIOR TO PROCEEDING WITH ANY SUCH CHANGE OF INSTALLATION.
7. ALL MATERIALS FURNISHED AND INSTALLED SHALL BE IN STRICT ACCORDANCE WITH ALL APPLICABLE CODES, REGULATIONS AND ORDINANCES. CONTRACTOR SHALL ISSUE ALL APPROPRIATE NOTICES AND COMPLY WITH ALL LAWS, ORDINANCES, RULES, REGULATIONS AND LAWFUL ORDERS OF ANY PUBLIC AUTHORITY REGARDING THE PERFORMANCE OF THE WORK. ALL WORK CARRIED OUT SHALL COMPLY WITH ALL APPLICABLE MUNICIPAL AND UTILITY COMPANY SPECIFICATIONS AND LOCAL JURISDICTIONAL CODES, ORDINANCES AND APPLICABLE REGULATIONS.
8. THE CONTRACTOR SHALL INSTALL ALL EQUIPMENT AND MATERIALS IN ACCORDANCE WITH MANUFACTURER'S RECOMMENDATIONS UNLESS SPECIFICALLY STATED OTHERWISE.
9. THE CONTRACTOR SHALL CONTACT UTILITY LOCATING SERVICES INCLUDING PRIVATE LOCATES SERVICES PRIOR TO THE START OF CONSTRUCTION.
10. ALL EXISTING ACTIVE SEWER, WATER, GAS, ELECTRIC AND OTHER UTILITIES WHERE ENCOUNTERED IN THE WORK, SHALL BE PROTECTED AT ALL TIMES AND WHERE REQUIRED FOR THE PROPER EXECUTION OF THE WORK, SHALL BE RELOCATED AS DIRECTED BY CONTRACTOR. EXTREME CAUTION SHOULD BE USED BY THE CONTRACTOR WHEN EXCAVATING OR DRILLING PIERS AROUND OR NEAR UTILITIES. CONTRACTOR SHALL PROVIDE SAFETY TRAINING FOR THE WORKING CREW. THIS WILL INCLUDE BUT NOT BE LIMITED TO A) FALL PROTECTION B) CONFINED SPACE C) ELECTRICAL SAFETY D) TRENCHING AND EXCAVATION E) CONSTRUCTION SAFETY PROCEDURES.
11. ALL SITE WORK SHALL BE AS INDICATED ON THE STAMPED CONSTRUCTION DRAWINGS AND DISH PROJECT SPECIFICATIONS, LATEST APPROVED REVISION.
12. CONTRACTOR SHALL KEEP THE SITE FREE FROM ACCUMULATING WASTE MATERIAL, DEBRIS, AND TRASH AT THE COMPLETION OF THE WORK. IF NECESSARY, RUBBISH, STUMPS, DEBRIS, STICKS, STONES AND OTHER REFUSE SHALL BE REMOVED FROM THE SITE AND DISPOSED OF LEGALLY.
13. ALL EXISTING INACTIVE SEWER, WATER, GAS, ELECTRIC AND OTHER UTILITIES, WHICH INTERFERE WITH THE EXECUTION OF THE WORK, SHALL BE REMOVED AND/OR CAPPED, PLUGGED OR OTHERWISE DISCONTINUED AT POINTS WHICH WILL NOT INTERFERE WITH THE EXECUTION OF THE WORK, SUBJECT TO THE APPROVAL OF DISH Wireless L.L.C. AND TOWER OWNER, AND/OR LOCAL UTILITIES.
14. THE CONTRACTOR SHALL PROVIDE SITE SIGNAGE IN ACCORDANCE WITH THE TECHNICAL SPECIFICATION FOR SITE SIGNAGE REQUIRED BY LOCAL JURISDICTION AND SIGNAGE REQUIRED ON INDIVIDUAL PIECES OF EQUIPMENT, ROOMS, AND SHELTERS.
15. THE SITE SHALL BE GRADED TO CAUSE SURFACE WATER TO FLOW AWAY FROM THE CARRIER'S EQUIPMENT AND TOWER AREAS.
16. THE SUB GRADE SHALL BE COMPACTED AND BROUGHT TO A SMOOTH UNIFORM GRADE PRIOR TO FINISHED SURFACE APPLICATION.
17. THE AREAS OF THE OWNERS PROPERTY DISTURBED BY THE WORK AND NOT COVERED BY THE TOWER, EQUIPMENT OR DRIVEWAY, SHALL BE GRADED TO A UNIFORM SLOPE, AND STABILIZED TO PREVENT EROSION AS SPECIFIED ON THE CONSTRUCTION DRAWINGS AND/OR PROJECT SPECIFICATIONS.
18. CONTRACTOR SHALL MINIMIZE DISTURBANCE TO EXISTING SITE DURING CONSTRUCTION. EROSION CONTROL MEASURES, IF REQUIRED DURING CONSTRUCTION, SHALL BE IN CONFORMANCE WITH THE LOCAL GUIDELINES FOR EROSION AND SEDIMENT CONTROL.
19. THE CONTRACTOR SHALL PROTECT EXISTING IMPROVEMENTS, PAVEMENTS, CURBS, LANDSCAPING AND STRUCTURES. ANY DAMAGED PART SHALL BE REPAIRED AT CONTRACTOR'S EXPENSE TO THE SATISFACTION OF OWNER.
20. CONTRACTOR SHALL LEGALLY AND PROPERLY DISPOSE OF ALL SCRAP MATERIALS SUCH AS COAXIAL CABLES AND OTHER ITEMS REMOVED FROM THE EXISTING FACILITY. ANTENNAS AND RADIOS REMOVED SHALL BE RETURNED TO THE OWNER'S DESIGNATED LOCATION.
21. CONTRACTOR SHALL LEAVE PREMISES IN CLEAN CONDITION. TRASH AND DEBRIS SHOULD BE REMOVED FROM SITE ON A DAILY BASIS.
22. NO FILL OR EMBANKMENT MATERIAL SHALL BE PLACED ON FROZEN GROUND. FROZEN MATERIALS, SNOW OR ICE SHALL NOT BE PLACED IN ANY FILL OR EMBANKMENT.

GENERAL NOTES:

1. FOR THE PURPOSE OF CONSTRUCTION DRAWING, THE FOLLOWING DEFINITIONS SHALL APPLY:
CONTRACTOR: GENERAL CONTRACTOR RESPONSIBLE FOR CONSTRUCTION
CARRIER: DISH Wireless L.L.C.
TOWER OWNER: TOWER OWNER
2. THESE DRAWINGS HAVE BEEN PREPARED USING STANDARDS OF PROFESSIONAL CARE AND COMPLETENESS NORMALLY EXERCISED UNDER SIMILAR CIRCUMSTANCES BY REPUTABLE ENGINEERS IN THIS OR SIMILAR LOCALITIES. IT IS ASSUMED THAT THE WORK DEPICTED WILL BE PERFORMED BY AN EXPERIENCED CONTRACTOR AND/OR WORKPEOPLE WHO HAVE A WORKING KNOWLEDGE OF THE APPLICABLE CODE STANDARDS AND REQUIREMENTS AND OF INDUSTRY ACCEPTED STANDARD GOOD PRACTICE. AS NOT EVERY CONDITION OR ELEMENT IS (OR CAN BE) EXPLICITLY SHOWN ON THESE DRAWINGS, THE CONTRACTOR SHALL USE INDUSTRY ACCEPTED STANDARD GOOD PRACTICE FOR MISCELLANEOUS WORK NOT EXPLICITLY SHOWN.
3. THESE DRAWINGS REPRESENT THE FINISHED STRUCTURE. THEY DO NOT INDICATE THE MEANS OR METHODS OF CONSTRUCTION. THE CONTRACTOR SHALL BE SOLELY RESPONSIBLE FOR THE CONSTRUCTION MEANS, METHODS, TECHNIQUES, SEQUENCES, AND PROCEDURES. THE CONTRACTOR SHALL PROVIDE ALL MEASURES NECESSARY FOR PROTECTION OF LIFE AND PROPERTY DURING CONSTRUCTION. SUCH MEASURES SHALL INCLUDE, BUT NOT BE LIMITED TO, BRACING, FORMWORK, SHORING, ETC. SITE VISITS BY THE ENGINEER OR HIS REPRESENTATIVE WILL NOT INCLUDE INSPECTION OF THESE ITEMS AND IS FOR STRUCTURAL OBSERVATION OF THE FINISHED STRUCTURE ONLY.
4. NOTES AND DETAILS IN THE CONSTRUCTION DRAWINGS SHALL TAKE PRECEDENCE OVER GENERAL NOTES AND TYPICAL DETAILS. WHERE NO DETAILS ARE SHOWN, CONSTRUCTION SHALL CONFORM TO SIMILAR WORK ON THE PROJECT, AND/OR AS PROVIDED FOR IN THE CONTRACT DOCUMENTS. WHERE DISCREPANCIES OCCUR BETWEEN PLANS, DETAILS, GENERAL NOTES, AND SPECIFICATIONS, THE GREATER, MORE STRICT REQUIREMENTS, SHALL GOVERN. IF FURTHER CLARIFICATION IS REQUIRED CONTACT THE ENGINEER OF RECORD.
5. SUBSTANTIAL EFFORT HAS BEEN MADE TO PROVIDE ACCURATE DIMENSIONS AND MEASUREMENTS ON THE DRAWINGS TO ASSIST IN THE FABRICATION AND/OR PLACEMENT OF CONSTRUCTION ELEMENTS BUT IT IS THE SOLE RESPONSIBILITY OF THE CONTRACTOR TO FIELD VERIFY THE DIMENSIONS, MEASUREMENTS, AND/OR CLEARANCES SHOWN IN THE CONSTRUCTION DRAWINGS PRIOR TO FABRICATION OR CUTTING OF ANY NEW OR EXISTING CONSTRUCTION ELEMENTS. IF IT IS DETERMINED THAT THERE ARE DISCREPANCIES AND/OR CONFLICTS WITH THE CONSTRUCTION DRAWINGS THE ENGINEER OF RECORD IS TO BE NOTIFIED AS SOON AS POSSIBLE.
6. PRIOR TO THE SUBMISSION OF BIDS, THE BIDDING CONTRACTOR SHALL VISIT THE CELL SITE TO FAMILIARIZE WITH THE EXISTING CONDITIONS AND TO CONFIRM THAT THE WORK CAN BE ACCOMPLISHED AS SHOWN ON THE CONSTRUCTION DRAWINGS. ANY DISCREPANCY FOUND SHALL BE BROUGHT TO THE ATTENTION OF CARRIER POC AND TOWER OWNER.
7. ALL MATERIALS FURNISHED AND INSTALLED SHALL BE IN STRICT ACCORDANCE WITH ALL APPLICABLE CODES, REGULATIONS AND ORDINANCES. CONTRACTOR SHALL ISSUE ALL APPROPRIATE NOTICES AND COMPLY WITH ALL LAWS, ORDINANCES, RULES, REGULATIONS AND LAWFUL ORDERS OF ANY PUBLIC AUTHORITY REGARDING THE PERFORMANCE OF THE WORK. ALL WORK CARRIED OUT SHALL COMPLY WITH ALL APPLICABLE MUNICIPAL AND UTILITY COMPANY SPECIFICATIONS AND LOCAL JURISDICTIONAL CODES, ORDINANCES AND APPLICABLE REGULATIONS.
8. UNLESS NOTED OTHERWISE, THE WORK SHALL INCLUDE FURNISHING MATERIALS, EQUIPMENT, APPURTENANCES AND LABOR NECESSARY TO COMPLETE ALL INSTALLATIONS AS INDICATED ON THE DRAWINGS.
9. THE CONTRACTOR SHALL INSTALL ALL EQUIPMENT AND MATERIALS IN ACCORDANCE WITH MANUFACTURER'S RECOMMENDATIONS UNLESS SPECIFICALLY STATED OTHERWISE.
10. IF THE SPECIFIED EQUIPMENT CAN NOT BE INSTALLED AS SHOWN ON THESE DRAWINGS, THE CONTRACTOR SHALL PROPOSE AN ALTERNATIVE INSTALLATION FOR APPROVAL BY THE CARRIER AND TOWER OWNER PRIOR TO PROCEEDING WITH ANY SUCH CHANGE OF INSTALLATION.
11. CONTRACTOR IS TO PERFORM A SITE INVESTIGATION, BEFORE SUBMITTING BIDS, TO DETERMINE THE BEST ROUTING OF ALL CONDUITS FOR POWER, AND TELCO AND FOR GROUNDING CABLES AS SHOWN IN THE POWER, TELCO, AND GROUNDING PLAN DRAWINGS.
12. THE CONTRACTOR SHALL PROTECT EXISTING IMPROVEMENTS, PAVEMENTS, CURBS, LANDSCAPING AND STRUCTURES. ANY DAMAGED PART SHALL BE REPAIRED AT CONTRACTOR'S EXPENSE TO THE SATISFACTION OF DISH Wireless L.L.C. AND TOWER OWNER
13. CONTRACTOR SHALL LEGALLY AND PROPERLY DISPOSE OF ALL SCRAP MATERIALS SUCH AS COAXIAL CABLES AND OTHER ITEMS REMOVED FROM THE EXISTING FACILITY. ANTENNAS REMOVED SHALL BE RETURNED TO THE OWNER'S DESIGNATED LOCATION.
14. CONTRACTOR SHALL LEAVE PREMISES IN CLEAN CONDITION. TRASH AND DEBRIS SHOULD BE REMOVED FROM SITE ON A DAILY BASIS.



5701 SOUTH SANTA FE DRIVE
LITTLETON, CO 80120



2840 HOWE ROAD, SUITE E
MARTINEZ, CA 94553
www.TheCBRGroup.com



IT IS A VIOLATION OF LAW FOR ANY PERSON, UNLESS THEY ARE ACTING UNDER THE DIRECTION OF A LICENSED PROFESSIONAL ENGINEER, TO ALTER THIS DOCUMENT.

DRAWN BY:	CHECKED BY:	APPROVED BY:
JG/WM	---	---

RFDS REV #: 02/02/2022 REV 4

CONSTRUCTION DOCUMENTS

SUBMITTALS		
REV	DATE	DESCRIPTION
A	02/10/2022	90% CD'S ISSUED FOR REVIEW
B	04/19/2022	100% CONSTRUCTION DRAWINGS
C	06/11/2022	PLAN CHECK COMMENTS

A&E PROJECT NUMBER
SFSF001158A

DISH Wireless L.L.C.
PROJECT INFORMATION
SFSF001158A
1300 COMMERCE ST
PETALUMA, CA 94954

SHEET TITLE
GENERAL NOTES

SHEET NUMBER
GN-2

CONCRETE, FOUNDATIONS, AND REINFORCING STEEL:

1. ALL CONCRETE WORK SHALL BE IN ACCORDANCE WITH THE ACI 301, ACI 318, ACI 336, ASTM A184, ASTM A185 AND THE DESIGN AND CONSTRUCTION SPECIFICATION FOR CAST-IN-PLACE CONCRETE.
2. UNLESS NOTED OTHERWISE, SOIL BEARING PRESSURE USED FOR DESIGN OF SLABS AND FOUNDATIONS IS ASSUMED TO BE 1000 psf.
3. ALL CONCRETE SHALL HAVE A MINIMUM COMPRESSIVE STRENGTH (f'c) OF 3000 psi AT 28 DAYS, UNLESS NOTED OTHERWISE. NO MORE THAN 90 MINUTES SHALL ELAPSE FROM BATCH TIME TO TIME OF PLACEMENT UNLESS APPROVED BY THE ENGINEER OF RECORD. TEMPERATURE OF CONCRETE SHALL NOT EXCEED 90°F AT TIME OF PLACEMENT.
4. CONCRETE EXPOSED TO FREEZE-THAW CYCLES SHALL CONTAIN AIR ENTRAINING ADMIXTURES. AMOUNT OF AIR ENTRAINMENT TO BE BASED ON SIZE OF AGGREGATE AND F3 CLASS EXPOSURE (VERY SEVERE). CEMENT USED TO BE TYPE II PORTLAND CEMENT WITH A MAXIMUM WATER-TO-CEMENT RATIO (W/C) OF 0.45.
5. ALL STEEL REINFORCING SHALL CONFORM TO ASTM A615. ALL WELDED WIRE FABRIC (WWF) SHALL CONFORM TO ASTM A185. ALL SPLICES SHALL BE CLASS "B" TENSION SPLICES, UNLESS NOTED OTHERWISE. ALL HOOKS SHALL BE STANDARD 90 DEGREE HOOKS, UNLESS NOTED OTHERWISE. YIELD STRENGTH (Fy) OF STANDARD DEFORMED BARS ARE AS FOLLOWS:
 - #4 BARS AND SMALLER 40 ksi
 - #5 BARS AND LARGER 60 ksi
6. THE FOLLOWING MINIMUM CONCRETE COVER SHALL BE PROVIDED FOR REINFORCING STEEL UNLESS SHOWN OTHERWISE ON DRAWINGS:
 - CONCRETE CAST AGAINST AND PERMANENTLY EXPOSED TO EARTH 3"
 - CONCRETE EXPOSED TO EARTH OR WEATHER:
 - #6 BARS AND LARGER 2"
 - #5 BARS AND SMALLER 1-1/2"
 - CONCRETE NOT EXPOSED TO EARTH OR WEATHER:
 - SLAB AND WALLS 3/4"
 - BEAMS AND COLUMNS 1-1/2"
7. A TOOLED EDGE OR A 3/4" CHAMFER SHALL BE PROVIDED AT ALL EXPOSED EDGES OF CONCRETE, UNLESS NOTED OTHERWISE, IN ACCORDANCE WITH ACI 301 SECTION 4.2.4.

ELECTRICAL INSTALLATION NOTES:

1. ALL ELECTRICAL WORK SHALL BE PERFORMED IN ACCORDANCE WITH THE PROJECT SPECIFICATIONS, NEC AND ALL APPLICABLE FEDERAL, STATE, AND LOCAL CODES/ORDINANCES.
2. CONDUIT ROUTINGS ARE SCHEMATIC. CONTRACTOR SHALL INSTALL CONDUITS SO THAT ACCESS TO EQUIPMENT IS NOT BLOCKED AND TRIP HAZARDS ARE ELIMINATED.
3. WIRING, RACEWAY AND SUPPORT METHODS AND MATERIALS SHALL COMPLY WITH THE REQUIREMENTS OF THE NEC.
4. ALL CIRCUITS SHALL BE SEGREGATED AND MAINTAIN MINIMUM CABLE SEPARATION AS REQUIRED BY THE NEC.
- 4.1. ALL EQUIPMENT SHALL BEAR THE UNDERWRITERS LABORATORIES LABEL OF APPROVAL, AND SHALL CONFORM TO REQUIREMENT OF THE NATIONAL ELECTRICAL CODE.
- 4.2. ALL OVERCURRENT DEVICES SHALL HAVE AN INTERRUPTING CURRENT RATING THAT SHALL BE GREATER THAN THE SHORT CIRCUIT CURRENT TO WHICH THEY ARE SUBJECTED, 22,000 AIC MINIMUM. VERIFY AVAILABLE SHORT CIRCUIT CURRENT DOES NOT EXCEED THE RATING OF ELECTRICAL EQUIPMENT IN ACCORDANCE WITH ARTICLE 110.24 NEC OR THE MOST CURRENT ADOPTED CODE PRE THE GOVERNING JURISDICTION.
5. EACH END OF EVERY POWER PHASE CONDUCTOR, GROUNDING CONDUCTOR, AND TELCO CONDUCTOR OR CABLE SHALL BE LABELED WITH COLOR-CODED INSULATION OR ELECTRICAL TAPE (3M BRAND, 1/2" PLASTIC ELECTRICAL TAPE WITH UV PROTECTION, OR EQUAL). THE IDENTIFICATION METHOD SHALL CONFORM WITH NEC AND OSHA.
6. ALL ELECTRICAL COMPONENTS SHALL BE CLEARLY LABELED WITH LAMICOID TAGS SHOWING THEIR RATED VOLTAGE, PHASE CONFIGURATION, WIRE CONFIGURATION, POWER OR AMPACITY RATING AND BRANCH CIRCUIT ID NUMBERS (i.e. PANEL BOARD AND CIRCUIT ID'S).
7. PANEL BOARDS (ID NUMBERS) SHALL BE CLEARLY LABELED WITH PLASTIC LABELS.
8. TIE WRAPS ARE NOT ALLOWED.
9. ALL POWER AND EQUIPMENT GROUND WIRING IN TUBING OR CONDUIT SHALL BE SINGLE COPPER CONDUCTOR (#14 OR LARGER) WITH TYPE THHW, THWN, THWN-2, XHHW, XHHW-2, THW, THW-2, RHW, OR RHW-2 INSULATION UNLESS OTHERWISE SPECIFIED.
10. SUPPLEMENTAL EQUIPMENT GROUND WIRING LOCATED INDOORS SHALL BE SINGLE COPPER CONDUCTOR (#6 OR LARGER) WITH TYPE THHW, THWN, THWN-2, XHHW, XHHW-2, THW, THW-2, RHW, OR RHW-2 INSULATION UNLESS OTHERWISE SPECIFIED.
11. POWER AND CONTROL WIRING IN FLEXIBLE CORD SHALL BE MULTI-CONDUCTOR, TYPE SOOW CORD (#14 OR LARGER) UNLESS OTHERWISE SPECIFIED.
12. POWER AND CONTROL WIRING FOR USE IN CABLE TRAY SHALL BE MULTI-CONDUCTOR, TYPE TC CABLE (#14 OR LARGER), WITH TYPE THHW, THWN, THWN-2, XHHW, XHHW-2, THW, THW-2, RHW, OR RHW-2 INSULATION UNLESS OTHERWISE SPECIFIED.
13. ALL POWER AND GROUNDING CONNECTIONS SHALL BE CRIMP-STYLE, COMPRESSION WIRE LUGS AND WIRE NUTS BY THOMAS AND BETTS (OR EQUAL). LUGS AND WIRE NUTS SHALL BE RATED FOR OPERATION NOT LESS THAN 75° C (90° C IF AVAILABLE).
14. RACEWAY AND CABLE TRAY SHALL BE LISTED OR LABELED FOR ELECTRICAL USE IN ACCORDANCE WITH NEMA, UL, ANSI/IEEE AND NEC.
15. ELECTRICAL METALLIC TUBING (EMT), INTERMEDIATE METAL CONDUIT (IMC), OR RIGID METAL CONDUIT (RMC) SHALL BE USED FOR EXPOSED INDOOR LOCATIONS.


16. ELECTRICAL METALLIC TUBING (EMT) OR METAL-CLAD CABLE (MC) SHALL BE USED FOR CONCEALED INDOOR LOCATIONS.
17. SCHEDULE 40 PVC UNDERGROUND ON STRAIGHTS AND SCHEDULE 80 PVC FOR ALL ELBOWS/90s AND ALL APPROVED ABOVE GRADE PVC CONDUIT.
18. LIQUID-TIGHT FLEXIBLE METALLIC CONDUIT (LIQUID-TITE FLEX) SHALL BE USED INDOORS AND OUTDOORS, WHERE VIBRATION OCCURS OR FLEXIBILITY IS NEEDED.
19. CONDUIT AND TUBING FITTINGS SHALL BE THREADED OR COMPRESSION-TYPE AND APPROVED FOR THE LOCATION USED. SET SCREW FITTINGS ARE NOT ACCEPTABLE.
20. CABINETS, BOXES AND WIRE WAYS SHALL BE LABELED FOR ELECTRICAL USE IN ACCORDANCE WITH NEMA, UL, ANSI/IEEE AND THE NEC.
21. WIREWAYS SHALL BE METAL WITH AN ENAMEL FINISH AND INCLUDE A HINGED COVER, DESIGNED TO SWING OPEN DOWNWARDS (WIREMOLD SPECMATE WIREWAY).
22. SLOTTED WIRING DUCT SHALL BE PVC AND INCLUDE COVER (PANDUIT TYPE E OR EQUAL).
23. CONDUITS SHALL BE FASTENED SECURELY IN PLACE WITH APPROVED NON-PERFORATED STRAPS AND HANGERS. EXPLOSIVE DEVICES (i.e. POWDER-ACTUATED) FOR ATTACHING HANGERS TO STRUCTURE WILL NOT BE PERMITTED. CLOSELY FOLLOW THE LINES OF THE STRUCTURE, MAINTAIN CLOSE PROXIMITY TO THE STRUCTURE AND KEEP CONDUITS IN TIGHT ENVELOPES. CHANGES IN DIRECTION TO ROUTE AROUND OBSTACLES SHALL BE MADE WITH CONDUIT OUTLET BODIES. CONDUIT SHALL BE INSTALLED IN A NEAT AND WORKMANLIKE MANNER. PARALLEL AND PERPENDICULAR TO STRUCTURE WALL AND CEILING LINES. ALL CONDUIT SHALL BE FISHED TO CLEAR OBSTRUCTIONS. ENDS OF CONDUITS SHALL BE TEMPORARILY CAPPED FLUSH TO FINISH GRADE TO PREVENT CONCRETE, PLASTER OR DIRT FROM ENTERING. CONDUITS SHALL BE RIGIDLY CLAMPED TO BOXES BY GALVANIZED MALLEABLE IRON BUSHING ON INSIDE AND GALVANIZED MALLEABLE IRON LOCKNUT ON OUTSIDE AND INSIDE.
24. EQUIPMENT CABINETS, TERMINAL BOXES, JUNCTION BOXES AND PULL BOXES SHALL BE GALVANIZED OR EPOXY-COATED SHEET STEEL. SHALL MEET OR EXCEED UL 50 AND BE RATED NEMA 1 (OR BETTER) FOR INTERIOR LOCATIONS AND NEMA 3 (OR BETTER) FOR EXTERIOR LOCATIONS.
25. METAL RECEPTACLE, SWITCH AND DEVICE BOXES SHALL BE GALVANIZED, EPOXY-COATED OR NON-CORRODING; SHALL MEET OR EXCEED UL 514A AND NEMA OS 1 AND BE RATED NEMA 1 (OR BETTER) FOR INTERIOR LOCATIONS AND WEATHER PROTECTED (WP OR BETTER) FOR EXTERIOR LOCATIONS.
26. NONMETALLIC RECEPTACLE, SWITCH AND DEVICE BOXES SHALL MEET OR EXCEED NEMA OS 2 (NENORTH REVISION) AND BE RATED NEMA 1 (OR BETTER) FOR INTERIOR LOCATIONS AND WEATHER PROTECTED (WP OR BETTER) FOR EXTERIOR LOCATIONS.
27. THE CONTRACTOR SHALL NOTIFY AND OBTAIN NECESSARY AUTHORIZATION FROM THE CARRIER AND/OR DISH Wireless L.L.C. AND TOWER OWNER BEFORE COMMENCING WORK ON THE AC POWER DISTRIBUTION PANELS.
28. THE CONTRACTOR SHALL PROVIDE NECESSARY TAGGING ON THE BREAKERS, CABLES AND DISTRIBUTION PANELS IN ACCORDANCE WITH THE APPLICABLE CODES AND STANDARDS TO SAFEGUARD LIFE AND PROPERTY.
29. INSTALL LAMICOID LABEL ON THE METER CENTER TO SHOW "DISH Wireless L.L.C.".
30. ALL EMPTY/SPARE CONDUITS THAT ARE INSTALLED ARE TO HAVE A METERED MULE TAPE PULL CORD INSTALLED.



5701 SOUTH SANTA FE DRIVE
LITTLETON, CO 80120



2840 HOWE ROAD, SUITE E
MARTINEZ, CA 94553
www.TheCBRGroup.com

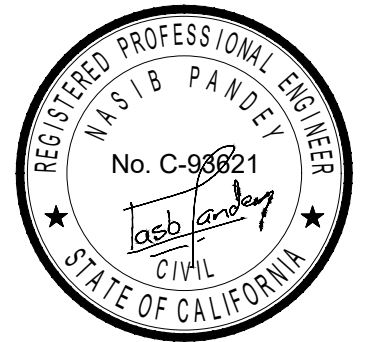

IT IS A VIOLATION OF LAW FOR ANY PERSON, UNLESS THEY ARE ACTING UNDER THE DIRECTION OF A LICENSED PROFESSIONAL ENGINEER, TO ALTER THIS DOCUMENT.

DRAWN BY:	CHECKED BY:	APPROVED BY:
JG/WM	---	---

RFDS REV #: 02/02/2022 REV 4

CONSTRUCTION DOCUMENTS

SUBMITTALS		
REV	DATE	DESCRIPTION
A	02/10/2022	90% CD'S ISSUED FOR REVIEW
B	04/19/2022	100% CONSTRUCTION DRAWINGS
C	06/11/2022	PLAN CHECK COMMENTS

A&E PROJECT NUMBER
SFSF001158A

DISH Wireless L.L.C.
PROJECT INFORMATION
SFSF001158A
1300 COMMERCE ST
PETALUMA, CA 94954

SHEET TITLE
GENERAL NOTES

SHEET NUMBER
GN-3

GROUNDING NOTES:

1. ALL GROUND ELECTRODE SYSTEMS (INCLUDING TELECOMMUNICATION, RADIO, LIGHTNING PROTECTION AND AC POWER GES'S) SHALL BE BONDED TOGETHER AT OR BELOW GRADE, BY TWO OR MORE COPPER BONDING CONDUCTORS IN ACCORDANCE WITH THE NEC.
2. THE CONTRACTOR SHALL PERFORM IEEE FALL-OF-POTENTIAL RESISTANCE TO EARTH TESTING (PER IEEE 1100 AND 81) FOR GROUND ELECTRODE SYSTEMS, THE CONTRACTOR SHALL FURNISH AND INSTALL SUPPLEMENTAL GROUND ELECTRODES AS NEEDED TO ACHIEVE A TEST RESULT OF 5 OHMS OR LESS.
3. THE CONTRACTOR IS RESPONSIBLE FOR PROPERLY SEQUENCING GROUNDING AND UNDERGROUND CONDUIT INSTALLATION AS TO PREVENT ANY LOSS OF CONTINUITY IN THE GROUNDING SYSTEM OR DAMAGE TO THE CONDUIT AND PROVIDE TESTING RESULTS.
4. METAL CONDUIT AND TRAY SHALL BE GROUNDED AND MADE ELECTRICALLY CONTINUOUS WITH LISTED BONDING FITTINGS OR BY BONDING ACROSS THE DISCONTINUITY WITH #6 COPPER WIRE UL APPROVED GROUNDING TYPE CONDUIT CLAMPS.
5. METAL RACEWAY SHALL NOT BE USED AS THE NEC REQUIRED EQUIPMENT GROUND CONDUCTOR. STRANDED COPPER CONDUCTORS WITH GREEN INSULATION, SIZED IN ACCORDANCE WITH THE NEC, SHALL BE FURNISHED AND INSTALLED WITH THE POWER CIRCUITS TO BTS EQUIPMENT.
6. EACH CABINET FRAME SHALL BE DIRECTLY CONNECTED TO THE MASTER GROUND BAR WITH GREEN INSULATED SUPPLEMENTAL EQUIPMENT GROUND WIRES, #6 STRANDED COPPER OR LARGER FOR INDOOR BTS; #2 BARE SOLID TINNED COPPER FOR OUTDOOR BTS.
7. CONNECTIONS TO THE GROUND BUS SHALL NOT BE DOUBLED UP OR STACKED BACK TO BACK CONNECTIONS ON OPPOSITE SIDE OF THE GROUND BUS ARE PERMITTED.
8. ALL EXTERIOR GROUND CONDUCTORS BETWEEN EQUIPMENT/GROUND BARS AND THE GROUND RING SHALL BE #2 SOLID TINNED COPPER UNLESS OTHERWISE INDICATED.
9. ALUMINUM CONDUCTOR OR COPPER CLAD STEEL CONDUCTOR SHALL NOT BE USED FOR GROUNDING CONNECTIONS.
10. USE OF 90° BENDS IN THE PROTECTION GROUNDING CONDUCTORS SHALL BE AVOIDED WHEN 45° BENDS CAN BE ADEQUATELY SUPPORTED.
11. EXOTHERMIC WELDS SHALL BE USED FOR ALL GROUNDING CONNECTIONS BELOW GRADE.
12. ALL GROUND CONNECTIONS ABOVE GRADE (INTERIOR AND EXTERIOR) SHALL BE FORMED USING HIGH PRESS CRIMPS.
13. COMPRESSION GROUND CONNECTIONS MAY BE REPLACED BY EXOTHERMIC WELD CONNECTIONS.
14. ICE BRIDGE BONDING CONDUCTORS SHALL BE EXOTHERMICALLY BONDED OR BOLTED TO THE BRIDGE AND THE TOWER GROUND BAR.
15. APPROVED ANTIOXIDANT COATINGS (i.e. CONDUCTIVE GEL OR PASTE) SHALL BE USED ON ALL COMPRESSION AND BOLTED GROUND CONNECTIONS.
16. ALL EXTERIOR GROUND CONNECTIONS SHALL BE COATED WITH A CORROSION RESISTANT MATERIAL.
17. MISCELLANEOUS ELECTRICAL AND NON-ELECTRICAL METAL BOXES, FRAMES AND SUPPORTS SHALL BE BONDED TO THE GROUND RING, IN ACCORDANCE WITH THE NEC.
18. BOND ALL METALLIC OBJECTS WITHIN 6 ft OF MAIN GROUND RING WITH (1) #2 BARE SOLID TINNED COPPER GROUND CONDUCTOR.
19. GROUND CONDUCTORS USED FOR THE FACILITY GROUNDING AND LIGHTNING PROTECTION SYSTEMS SHALL NOT BE ROUTED THROUGH METALLIC OBJECTS THAT FORM A RING AROUND THE CONDUCTOR, SUCH AS METALLIC CONDUITS, METAL SUPPORT CLIPS OR SLEEVES THROUGH WALLS OR FLOORS. WHEN IT IS REQUIRED TO BE HOUSED IN CONDUIT TO MEET CODE REQUIREMENTS OR LOCAL CONDITIONS, NON-METALLIC MATERIAL SUCH AS PVC CONDUIT SHALL BE USED. WHERE USE OF METAL CONDUIT IS UNAVOIDABLE (i.e., NONMETALLIC CONDUIT PROHIBITED BY LOCAL CODE) THE GROUND CONDUCTOR SHALL BE BONDED TO EACH END OF THE METAL CONDUIT.
20. ALL GROUNDS THAT TRANSITION FROM BELOW GRADE TO ABOVE GRADE MUST BE #2 BARE SOLID TINNED COPPER IN 3/4" NON-METALLIC, FLEXIBLE CONDUIT FROM 24" BELOW GRADE TO WITHIN 3" TO 6" OF CAD-WELD TERMINATION POINT. THE EXPOSED END OF THE CONDUIT MUST BE SEALED WITH SILICONE CAULK. (ADD TRANSITIONING GROUND STANDARD DETAIL AS WELL).
21. BUILDINGS WHERE THE MAIN GROUNDING CONDUCTORS ARE REQUIRED TO BE ROUTED TO GRADE, THE CONTRACTOR SHALL ROUTE TWO GROUNDING CONDUCTORS FROM THE ROOFTOP, TOWERS, AND WATER TOWERS GROUNDING RING, TO THE EXISTING GROUNDING SYSTEM, THE GROUNDING CONDUCTORS SHALL NOT BE SMALLER THAN 2/0 COPPER. ROOFTOP GROUNDING RING SHALL BE BONDED TO THE EXISTING GROUNDING SYSTEM, THE BUILDING STEEL COLUMNS, LIGHTNING PROTECTION SYSTEM, AND BUILDING MAIN WATER LINE (FERROUS OR NONFERROUS METAL PIPING ONLY). DO NOT ATTACH GROUNDING TO FIRE SPRINKLER SYSTEM PIPES.



5701 SOUTH SANTA FE DRIVE
LITTLETON, CO 80120



2840 HOWE ROAD, SUITE E
MARTINEZ, CA 94553
www.TheCBRGroup.com



IT IS A VIOLATION OF LAW FOR ANY PERSON, UNLESS THEY ARE ACTING UNDER THE DIRECTION OF A LICENSED PROFESSIONAL ENGINEER, TO ALTER THIS DOCUMENT.

DRAWN BY:	CHECKED BY:	APPROVED BY:
JG/WM	---	---

RFDS REV #: 02/02/2022 REV 4

CONSTRUCTION DOCUMENTS

SUBMITTALS		
REV	DATE	DESCRIPTION
A	02/10/2022	90% CD'S ISSUED FOR REVIEW
B	04/19/2022	100% CONSTRUCTION DRAWINGS
C	06/11/2022	PLAN CHECK COMMENTS

A&E PROJECT NUMBER
SFSF001158A

DISH Wireless L.L.C.
PROJECT INFORMATION
SFSF001158A
1300 COMMERCE ST
PETALUMA, CA 94954

SHEET TITLE
GENERAL NOTES

SHEET NUMBER
GN-4

SIGN TYPES		
TYPE	COLOR	COLOR CODE PURPOSE
INFORMATION	GREEN	"INFORMATIONAL SIGN" TO NOTIFY OTHERS OF SITE OWNERSHIP & CONTACT NUMBER AND POTENTIAL RF EXPOSURE.
NOTICE	BLUE	"NOTICE BEYOND THIS POINT" RF FIELDS BEYOND THIS POINT MAY EXCEED THE FCC GENERAL PUBLIC EXPOSURE LIMIT. OBEY ALL POSTED SIGNS AND SITE GUIDELINES FOR WORKING IN RF ENVIRONMENTS. IN ACCORDANCE WITH FEDERAL COMMUNICATIONS COMMISSION RULES ON RADIO FREQUENCY EMISSIONS 47 CFR-1.1307(b)
CAUTION	YELLOW	"CAUTION BEYOND THIS POINT" RF FIELDS BEYOND THIS POINT MAY EXCEED THE FCC GENERAL PUBLIC EXPOSURE LIMIT. OBEY ALL POSTED SIGNS AND SITE GUIDELINES FOR WORKING IN RF ENVIRONMENTS. IN ACCORDANCE WITH FEDERAL COMMUNICATIONS COMMISSION RULES ON RADIO FREQUENCY EMISSIONS 47 CFR-1.1307(b)
WARNING	ORANGE/RED	"WARNING BEYOND THIS POINT" RF FIELDS AT THIS SITE EXCEED FCC RULES FOR HUMAN EXPOSURE. FAILURE TO OBEY ALL POSTED SIGNS AND SITE GUIDELINES FOR WORKING IN RF ENVIRONMENTS COULD RESULT IN SERIOUS INJURY. IN ACCORDANCE WITH FEDERAL COMMUNICATIONS COMMISSION RULES ON RADIO FREQUENCY EMISSIONS 47 CFR-1.1307(b)

SIGN PLACEMENT:

- RF SIGNAGE PLACEMENT SHALL FOLLOW THE RECOMMENDATIONS OF AN EXISTING EME REPORT, CREATED BY A THIRD PARTY PREVIOUSLY AUTHORIZED BY DISH Wireless L.L.C.
- INFORMATION SIGN (GREEN) SHALL BE LOCATED ON EXISTING DISH Wireless L.L.C. EQUIPMENT.
 - A) IF THE INFORMATION SIGN IS A STICKER, IT SHALL BE PLACED ON EXISTING DISH Wireless L.L.C. EQUIPMENT CABINET.
 - B) IF THE INFORMATION SIGN IS A METAL SIGN IT SHALL BE PLACED ON EXISTING DISH Wireless L.L.C. H-FRAME WITH A SECURE ATTACH METHOD.
- IF EME REPORT IS NOT AVAILABLE AT THE TIME OF CREATION OF CONSTRUCTION DOCUMENTS; PLEASE CONTACT DISH Wireless L.L.C. CONSTRUCTION MANAGER FOR FURTHER INSTRUCTION ON HOW TO PROCEED.

NOTES:


1. FOR DISH Wireless L.L.C. LOGO, SEE DISH Wireless L.L.C. DESIGN SPECIFICATIONS (PROVIDED BY DISH Wireless L.L.C.)
2. SITE ID SHALL BE APPLIED TO SIGNS USING "LASER ENGRAVING" OR ANY OTHER WEATHER RESISTANT METHOD (DISH Wireless L.L.C. APPROVAL REQUIRED)
3. TEXT FOR SIGNAGE SHALL INDICATE CORRECT SITE NAME AND NUMBER AS PER DISH Wireless L.L.C. CONSTRUCTION MANAGER RECOMMENDATIONS.
4. CABINET/SHELTER MOUNTING APPLICATION REQUIRES ANOTHER PLATE APPLIED TO THE FACE OF THE CABINET WITH WATER PROOF POLYURETHANE ADHESIVE
5. ALL SIGNS WILL BE SECURED WITH EITHER STAINLESS STEEL ZIP TIES OR STAINLESS STEEL TECH SCREWS
6. ALL SIGNS TO BE 8.5"x11" AND MADE WITH 0.04" OF ALUMINUM MATERIAL

INFORMATION

This is an access point to an area with transmitting antennas.

Obey all signs and barriers beyond this point.
Call the DISH Wireless L.L.C. NOC at 1-866-624-6874

Site ID: _____

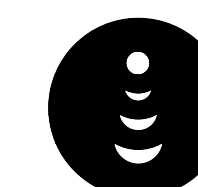

THIS SIGN IS FOR REFERENCE PURPOSES ONLY



5701 SOUTH SANTA FE DRIVE
LITTLETON, CO 80120



2840 HOWE ROAD, SUITE E
MARTINEZ, CA 94553
www.TheCBRGroup.com



IT IS A VIOLATION OF LAW FOR ANY PERSON, UNLESS THEY ARE ACTING UNDER THE DIRECTION OF A LICENSED PROFESSIONAL ENGINEER, TO ALTER THIS DOCUMENT.

DRAWN BY: CHECKED BY: APPROVED BY:
JG/WM --- ---

RFDS REV #: 02/02/2022 REV 4

CONSTRUCTION DOCUMENTS

SUBMITTALS		
REV	DATE	DESCRIPTION
A	02/10/2022	90% CD'S ISSUED FOR REVIEW
B	04/19/2022	100% CONSTRUCTION DRAWINGS
C	06/11/2022	PLAN CHECK COMMENTS

A&E PROJECT NUMBER
SFSF001158A

DISH Wireless L.L.C.
PROJECT INFORMATION
SFSF001158A
1300 COMMERCE ST
PETALUMA, CA 94954

SHEET TITLE
RF SIGNAGE

SHEET NUMBER
GN-5

NOTICE



Transmitting Antenna(s)

Radio frequency fields beyond this point **MAY EXCEED** the FCC Occupational exposure limit.

Obey all posted signs and site guidelines for working in radio frequency environments.

Call the DISH Wireless L.L.C. NOC at 1-866-624-6874 prior to working beyond this point.

Site ID: _____



THIS SIGN IS FOR REFERENCE PURPOSES ONLY

CAUTION



Transmitting Antenna(s)

Radio frequency fields beyond this point **MAY EXCEED** the FCC Occupational exposure limit.

Obey all posted signs and site guidelines for working in radio frequency environments.

Call the DISH Wireless L.L.C. NOC at 1-866-624-6874 prior to working beyond this point.

Site ID: _____



THIS SIGN IS FOR REFERENCE PURPOSES ONLY

WARNING



Transmitting Antenna(s)

Radio frequency fields beyond this point **EXCEED** the FCC Occupational exposure limit.

Obey all posted signs and site guidelines for working in radio frequency environments.

Call the DISH Wireless L.L.C. NOC at 1-866-624-6874 prior to working beyond this point.

Site ID: _____



THIS SIGN IS FOR REFERENCE PURPOSES ONLY

RF SIGNAGE