


VICINITY MAP
NTS

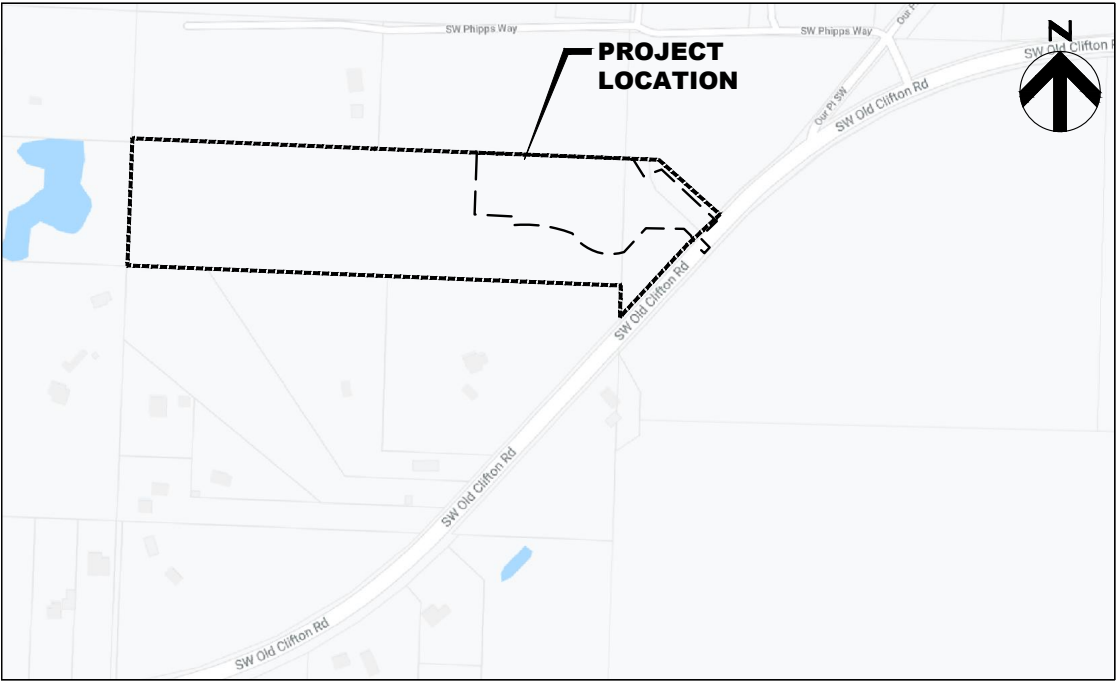

SITE LOCATION MAP
NTS

Contract Drawings For

McCORMICK COMMUNITIES, LLC.

PORT ORCHARD 660 RESERVOIR

4807 SW OLD CLIFTON ROAD
PORT ORCHARD, WASHINGTON
98367

PROJECT NO.
10172116
July 2022

SHEET INDEX - SCHEDULE A

GENERAL		
1	G0-00	TITLE SHEET & DRAWING INDEX
2	G0-01	CONSTRUCTION NOTES
3	G0-02	ABBREVIATIONS AND SYMBOLS
4	G0-03	PROCESS FLOW DIAGRAM
5	V1-01	SURVEY CONTROL PLAN
CIVIL		
6	C1-01	EXISTING SITE PLAN
7	C1-02	SITE PREPARATION AND TESC PLAN
8	C1-03	SITE PLAN
9	C1-04	GRADING AND PAVING PLAN
10	C1-05	SITE PIPING PLAN
11	C1-06	ENLARGED RESERVOIR PLAN
12	C1-07	CIVIL DETAILS
13	C1-08	CIVIL DETAILS
14	C1-09	CIVIL DETAILS
15	C1-10	CIVIL DETAILS
16	C1-11	SANITARY SEWER PROFILE
MECHANICAL		
17	D50-01	BOOSTER PUMP STATION PROCESS PLAN
18	D50-02	BOOSTER PUMP STATION SECTIONS
19	D50-03	DECHLORINATING OVERFLOW SECURITY ASSEMBLY
20	D50-04	RESERVOIR MIXING SYSTEM DETAILS
21	D50-05	CATHODIC PROTECTION TANK SCHEMATIC
22	D50-06	CATHODIC PROTECTION DETAILS 1
23	D50-07	CATHODIC PROTECTION DETAILS 2
24	D50-08	CATHODIC PROTECTION DETAILS 3
25	D50-09	FLOW METER VAULT AND CV-002 VALVE VAULT
26	M50-01	BOOSTER PUMP STATION MECHANICAL LEGEND
27	M50-02	BOOSTER PUMP STATION MECHANICAL PLAN
28	M50-03	HVAC SCHEDULES AND SPECIFICATIONS
ELECTRICAL		
29	E1-01	ELECTRICAL LEGEND 1
30	E1-02	ELECTRICAL LEGEND 2
31	E1-03	ONE-LINE DIAGRAM
32	E1-04	ELECTRICAL LIGHTING AND RECEPTACLE PLAN
33	E1-05	PUMP STATION GROUNDING AND LIGHTNING PROTECTION PLAN
34	E1-06	ELECTRICAL LOAD SCHEDULES
35	E1-07	MOTOR CONTROL CENTER MCC-01 ELEVATION
36	E1-08	VFD ELEMENTARY AND CONTROL DIAGRAM
37	E1-09	INSTRUMENTATION PLAN
INSTRUMENTATION		
38	I1-01	INSTRUMENTATION LEGEND AND ABBREVIATIONS
39	I1-02	P&ID BOOSTER PUMP STATION
40	I1-03	P&ID 660 TANK
41	I1-04	INSTRUMENTATION DETAILS
42	I1-05	CONTROL PANEL LAYOUT AND BILL OF MATERIALS

SHEET INDEX - SCHEDULE B

T BAILEY 660 RESERVOIR MANUFACTURER DRAWINGS		
1	S-1	GENERAL STRUCTURAL NOTES
2	GA-1	DESIGN SKETCH
3	GA-2	PLAN VIEW ORIENTATION
4	GA-3	FOUNDATION DESIGN
5	GA-4	SHAFT DESIGN
6	GA-5	ROOF ORIENTATION
7	GA-6	LADDER WITH PLATFORM DESIGNS
8	GA-7	PIPING PLAN
9	GA-8	ANCHOR CHAIR & DOORS ORIENTATION & DETAILS

[illegible]

VERTICAL DATUM:

BASE: COUNTY CORN STATION "PRDY"
ELEVATION= 345.462' (NAVD 88)

BASIS OF BEARING:

GRID NORTH, BASED UPON GLOBAL POSITIONING SYSTEM (GPS)
LAMBERT GRID WASHINGTON STATE NORTH ZONE COORDINATES.THE
NORTH AMERICAN DATUM OF 1983/2011 (NAD 83/2011 EPOCH 2010.00)
GRID COORDINATES WERE FOUND TO BE 189899.60 / 1177628.83
AT A BRASS DISK IN CONCRETE, INCASED AT THE NORTH QUARTER
CORNER OF SECTION 08, TOWNSHIP 21 NORTH, RANGE 1 EAST, W.M..
THE INVERSE OF BOTH THE SEA LEVEL CORRECTION FACTOR OF
0.999988534 AND THE GRID SCALE FACTOR OF 0.9999990407 WAS
APPLIED TO THE GRID COORDINATES FOR SHOWN GROUND DISTANCES.

SURVEYOR'S NOTES:

- 1) THE MONUMENT CONTROL SHOWN FOR THIS SITE WAS ACCOMPLISHED BY FIELD TRAVERSE UTILIZING A TWO (2) SECOND THEODOLITE WITH INTEGRAL ELECTRONIC DISTANCE MEASURING METER (TRIMBLE S-3) AND REAL TIME KINEMATIC (RTK) / STATIC GLOBAL POSITIONING SYSTEM (TRIMBLE R-8). LINEAR AND ANGULAR CLOSURE OF THE TRAVERSES MEET THE STANDARDS OF WAC 332-130-090.
- 2) UTILITIES OTHER THAN THOSE SHOWN MAY EXIST ON THIS SITE. ONLY THOSE WHICH ARE VISIBLE OR HAVING VISIBLE EVIDENCE OF THEIR INSTALLATION ARE SHOWN HEREON.
- 3) THIS SURVEY REPRESENTS PHYSICAL IMPROVEMENT CONDITIONS AS THEY EXISTED MAY 23, 2017, THE DATE OF THIS FIELD SURVEY.
- 4) LEGAL DESCRIPTION NOT PROVIDED. NO ADDITIONAL RESEARCH HAS BEEN ATTEMPTED.
- 5) OFFSET DIMENSIONS SHOWN HEREON ARE MEASURED PERPENDICULAR TO PROPERTY LINES.
- 6) IT IS NOT THE INTENT OF THIS SURVEY TO SHOW EASEMENTS OR RESERVATIONS WHICH MAY EFFECT THIS SITE.

DESCRIPTION:

RESULTANT PARCEL A AND PARCEL B OF BOUNDARY LINE ADJUSTMENT
RECORDED UNDER AUDITOR'S FILE NO. 3031737, RECORDS OF KITSAP
COUNTY, WASHINGTON.


NOTE:

SITE TOPOGRAPHIC BASE MAP UPDATED PER REVISED
SURVEY FROM CONTOUR ENGINEERING LLC, MARCH 10, 2022

LEGEND:

- = CALCULATED MONUMENT POSITION
• = FOUND MONUMENT AS NOTED.

PORTIONS OF THE NE 1/4, NE 1/4 OF SECTION 7 & THE NW 1/4, NW 1/4, SECTION 8, TOWNSHIP 20 NORTH, RANGE 2 EAST, W.M.

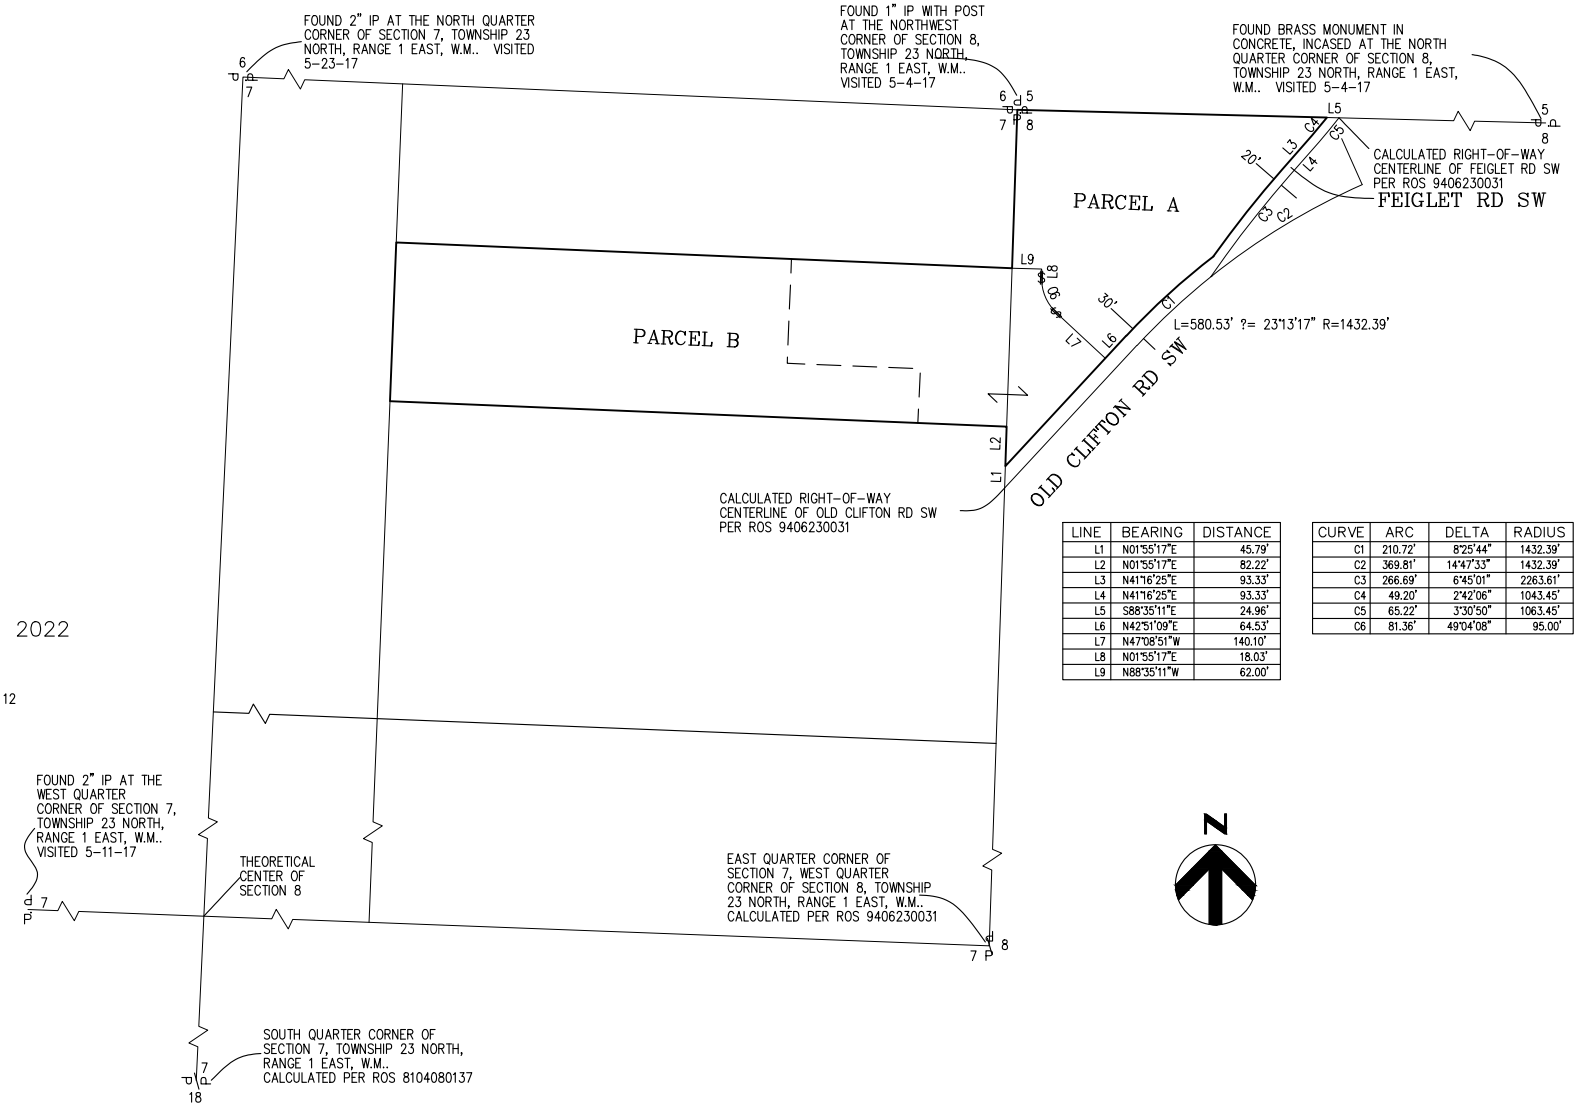

PLAN

CALL 48 HOURS
BEFORE YOU DIG
1-800-424-5555



PROJECT MANAGER			L. NOLAN
	CIVIL ENG	J. KNOLL	
	WATER ENG	L. CHENG	
	STRUCTURAL ENG	M. HIJAZI	
	ELECTRICAL ENG	I. RINCON	
	INSTR. ENG	M. HUTSON	
7/2022	BID SET		
ISSUE	DATE	DESCRIPTION	

PROJECT NUMBER		10172116
----------------	--	----------




SURVEY CONTROL PLAN

0 1" 2"


FILENAME | V1-01.dwg

SCALE | AS NOTED

SHEET | **V1-01**

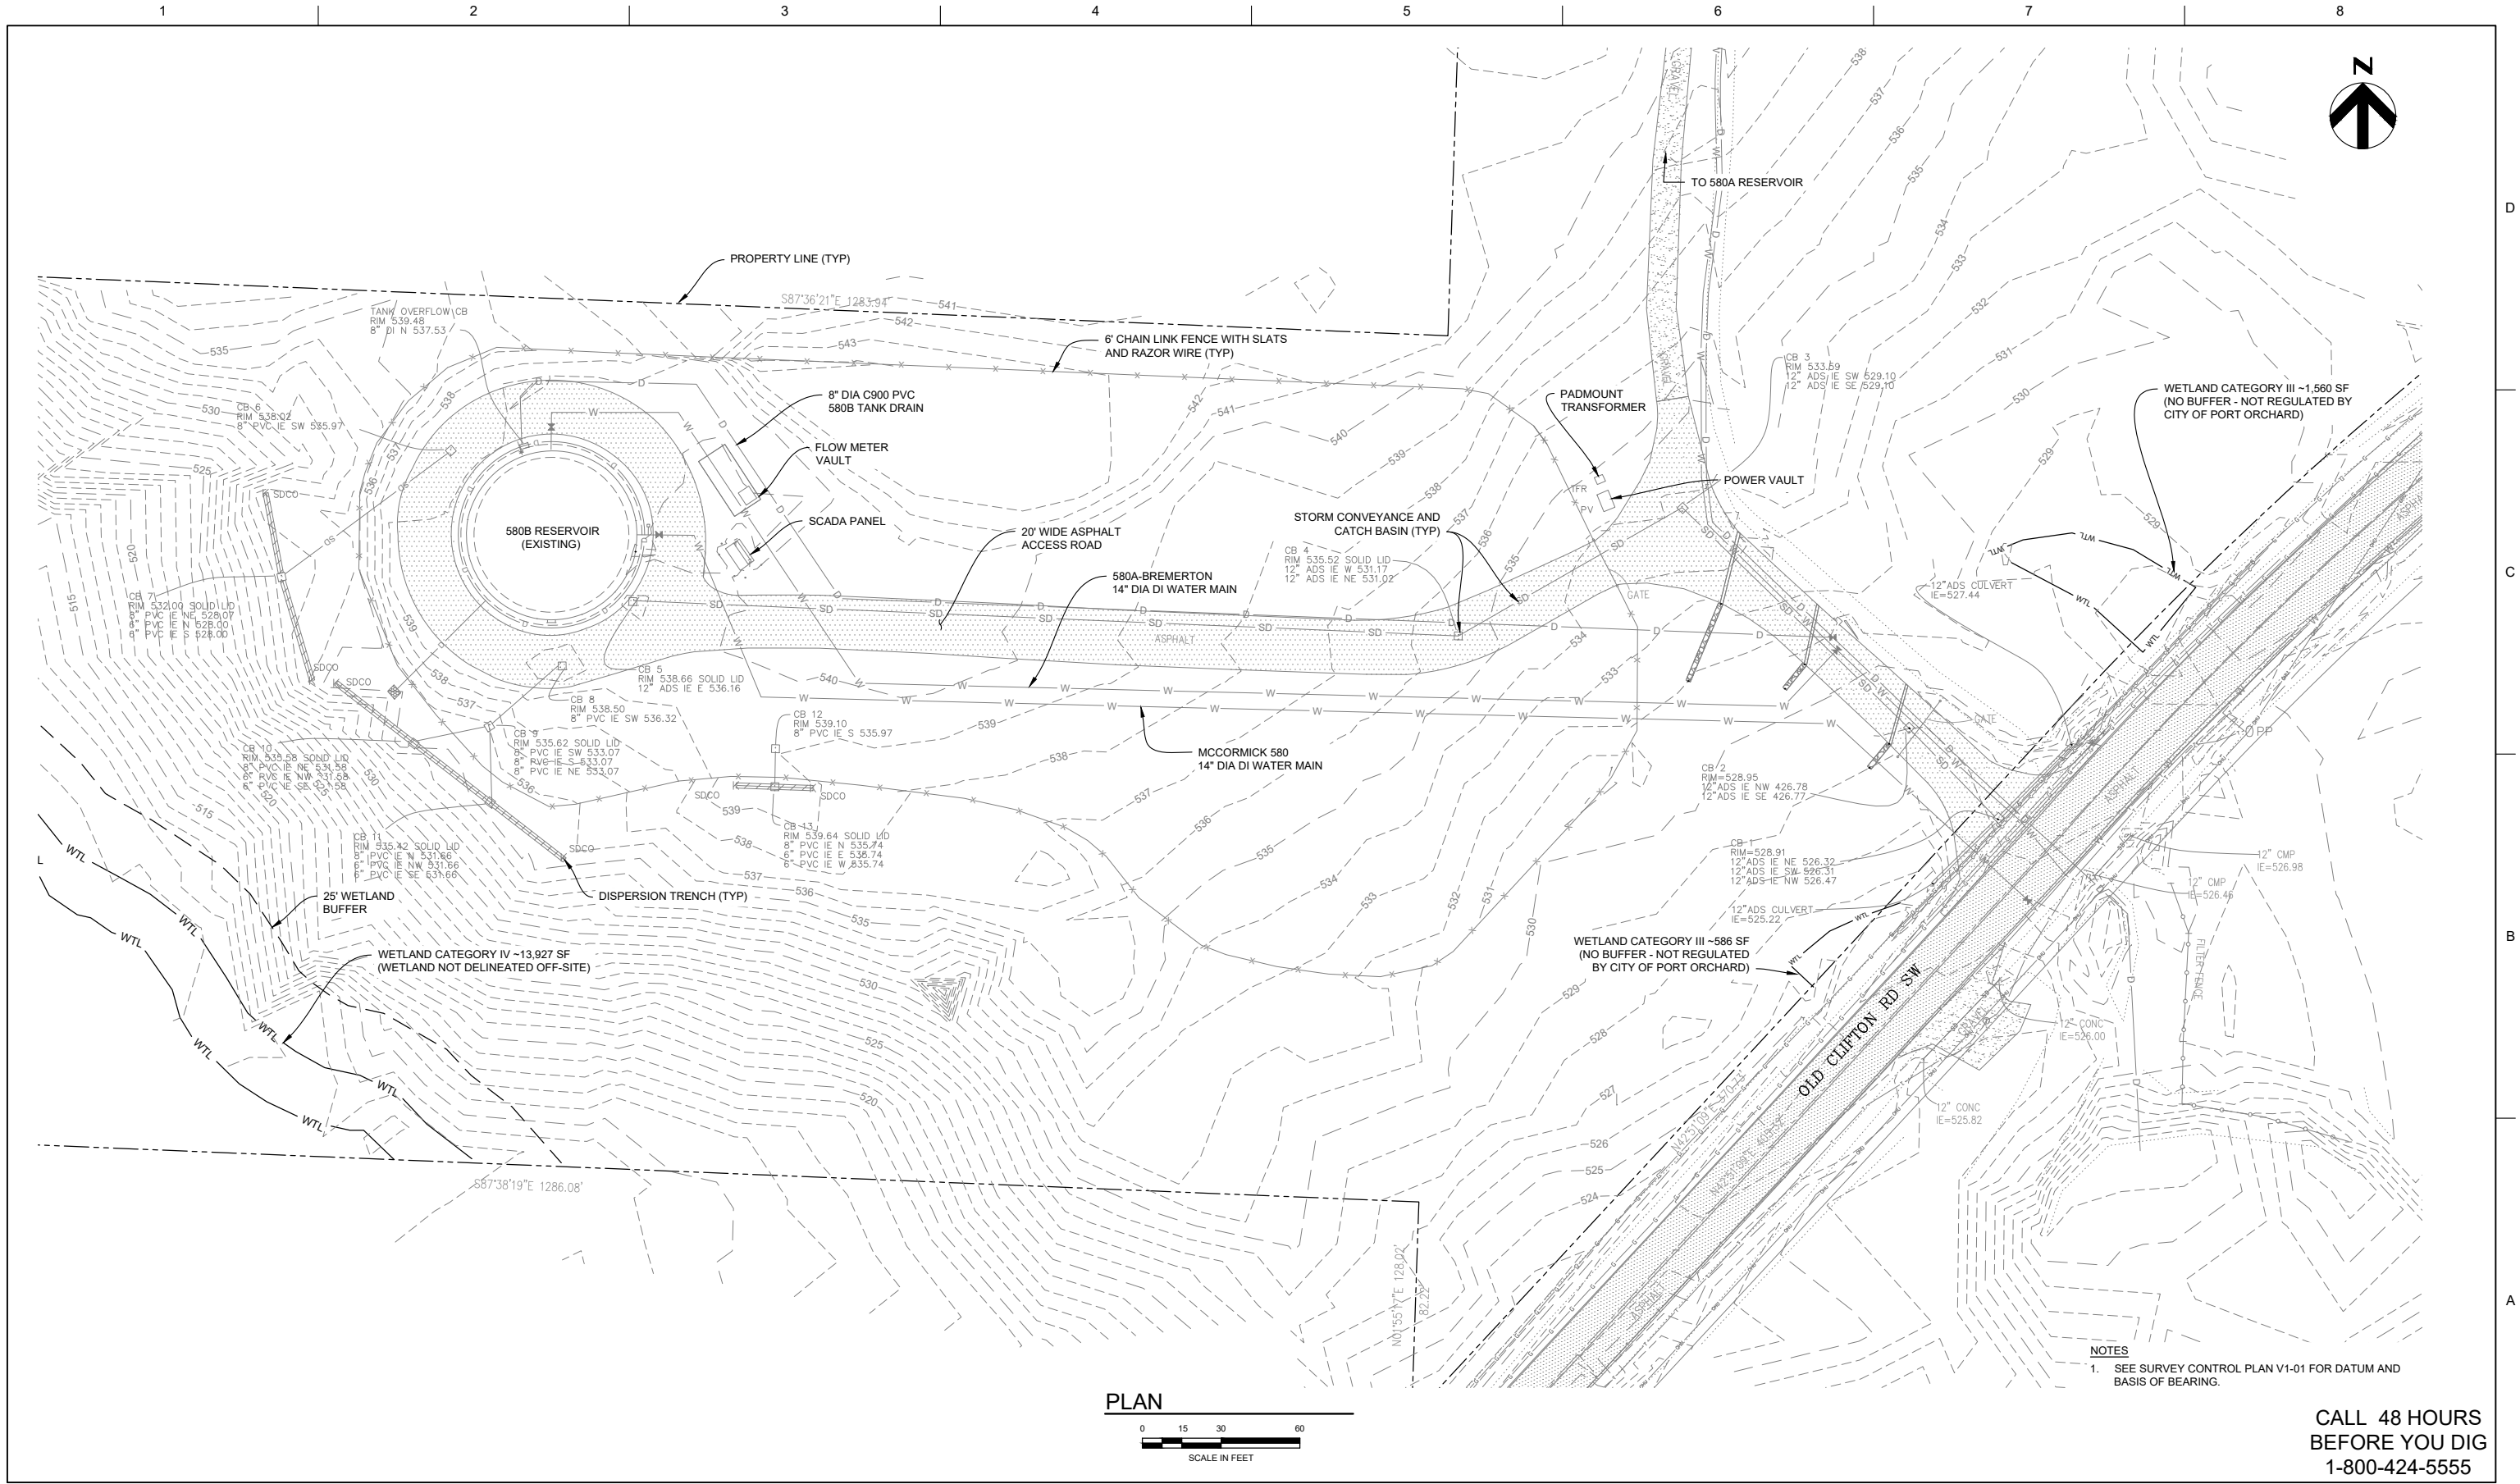

PLAN

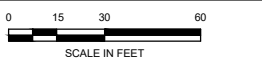

NOTES
1. SEE SURVEY CONTROL PLAN V1-01 FOR DATUM AND BASIS OF BEARING.

CALL 48 HOURS
BEFORE YOU DIG
1-800-424-5555



7/2022	BID SET	
ISSUE	DATE	DESCRIPTION

PROJECT MANAGER	L. NOLAN
CIVIL ENG	J. KNOLL
WATER ENG	L. CHENG
STRUCTURAL ENG	M. HIJAZI
ELECTRICAL ENG	I. RINCON
INSTR. ENG	M. HUTSON
PROJECT NUMBER	10172116





MCCORMICK
CLOSE TO WHAT COUNTS
PORT ORCHARD 660 RESERVOIR

EXISTING SITE PLAN



FILENAME C1-01.dwg
SCALE 1" = 30'

SHEET
C1-01

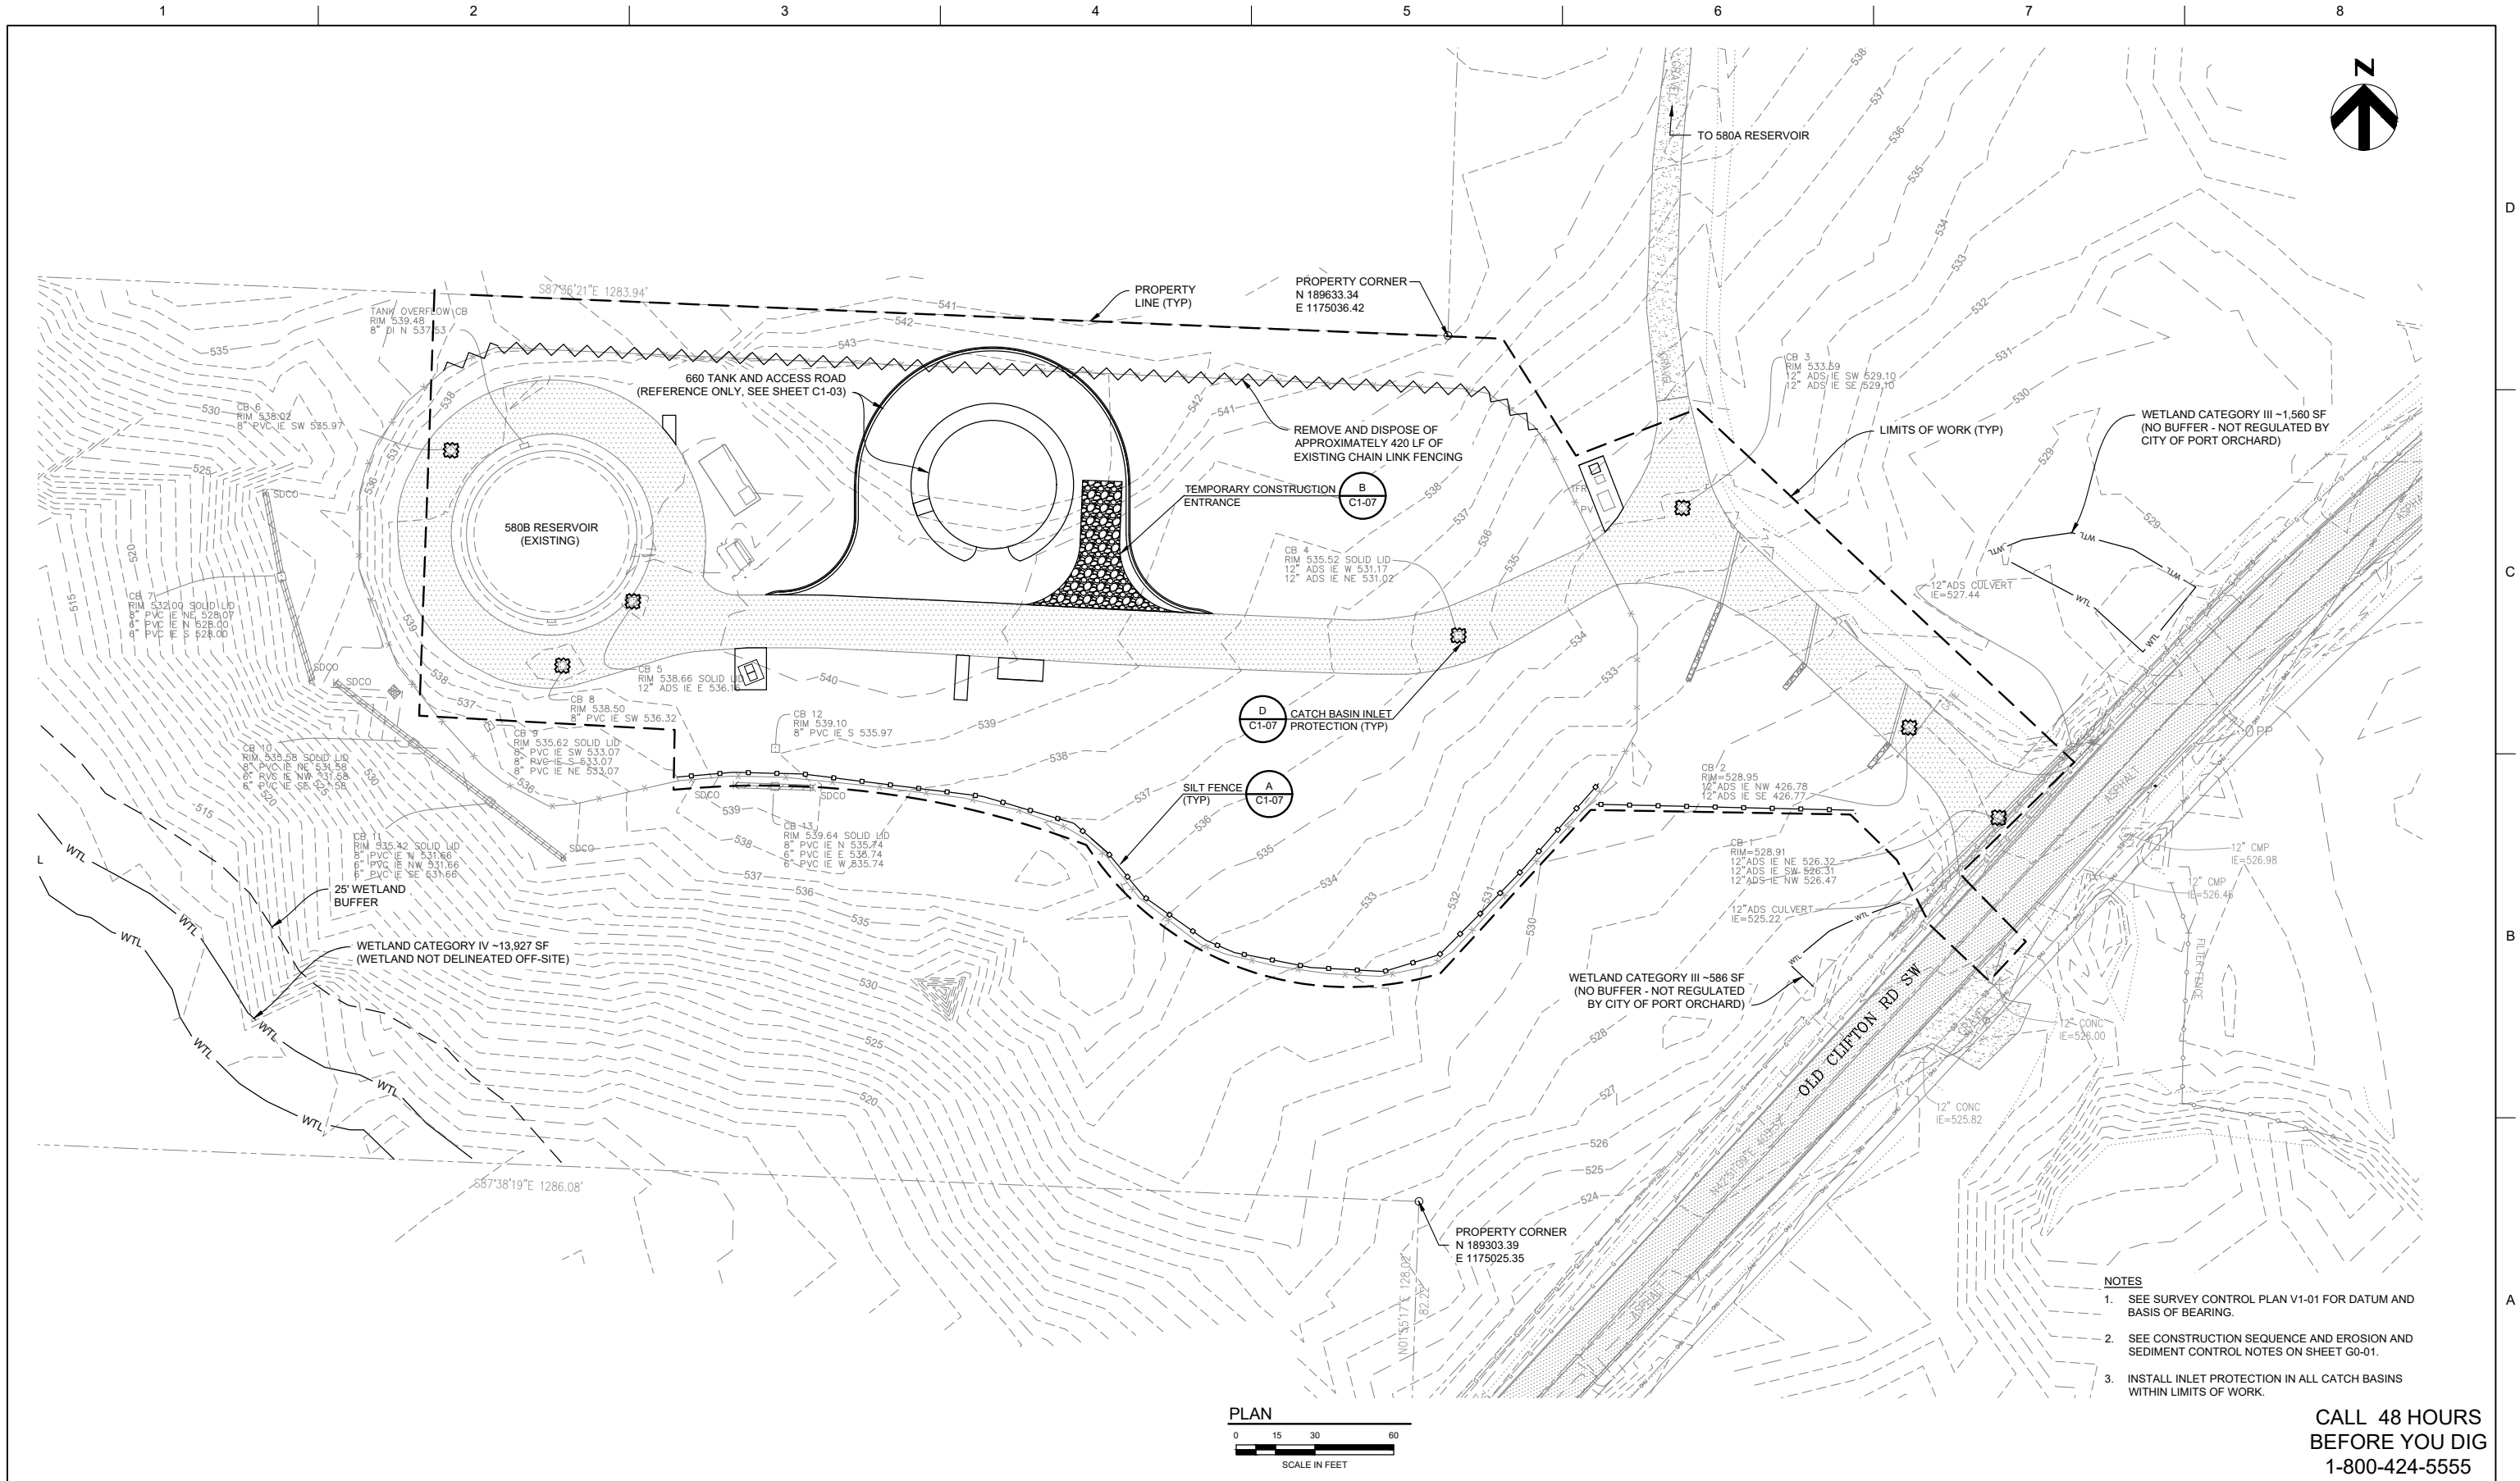


	7/2022	BID SET
ISSUE	DATE	DESCRIPTION

PROJECT MANAGER	L. NOLAN
CIVIL ENG.	J. KNOLL
WATER ENG.	L. CHENG
STRUCTURAL ENG.	M. HIJAZI
ELECTRICAL ENG.	I. RINCON
INSTR. ENG.	M. HUTSON
PROJECT NUMBER	10172116




SITE PREPARATION AND TESC PLAN

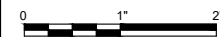

FILENAME C1-02.dwg
SCALE 1" = 30'

SHEET
C1-02

CALL 48 HOURS
BEFORE YOU DIG
1-800-424-5555

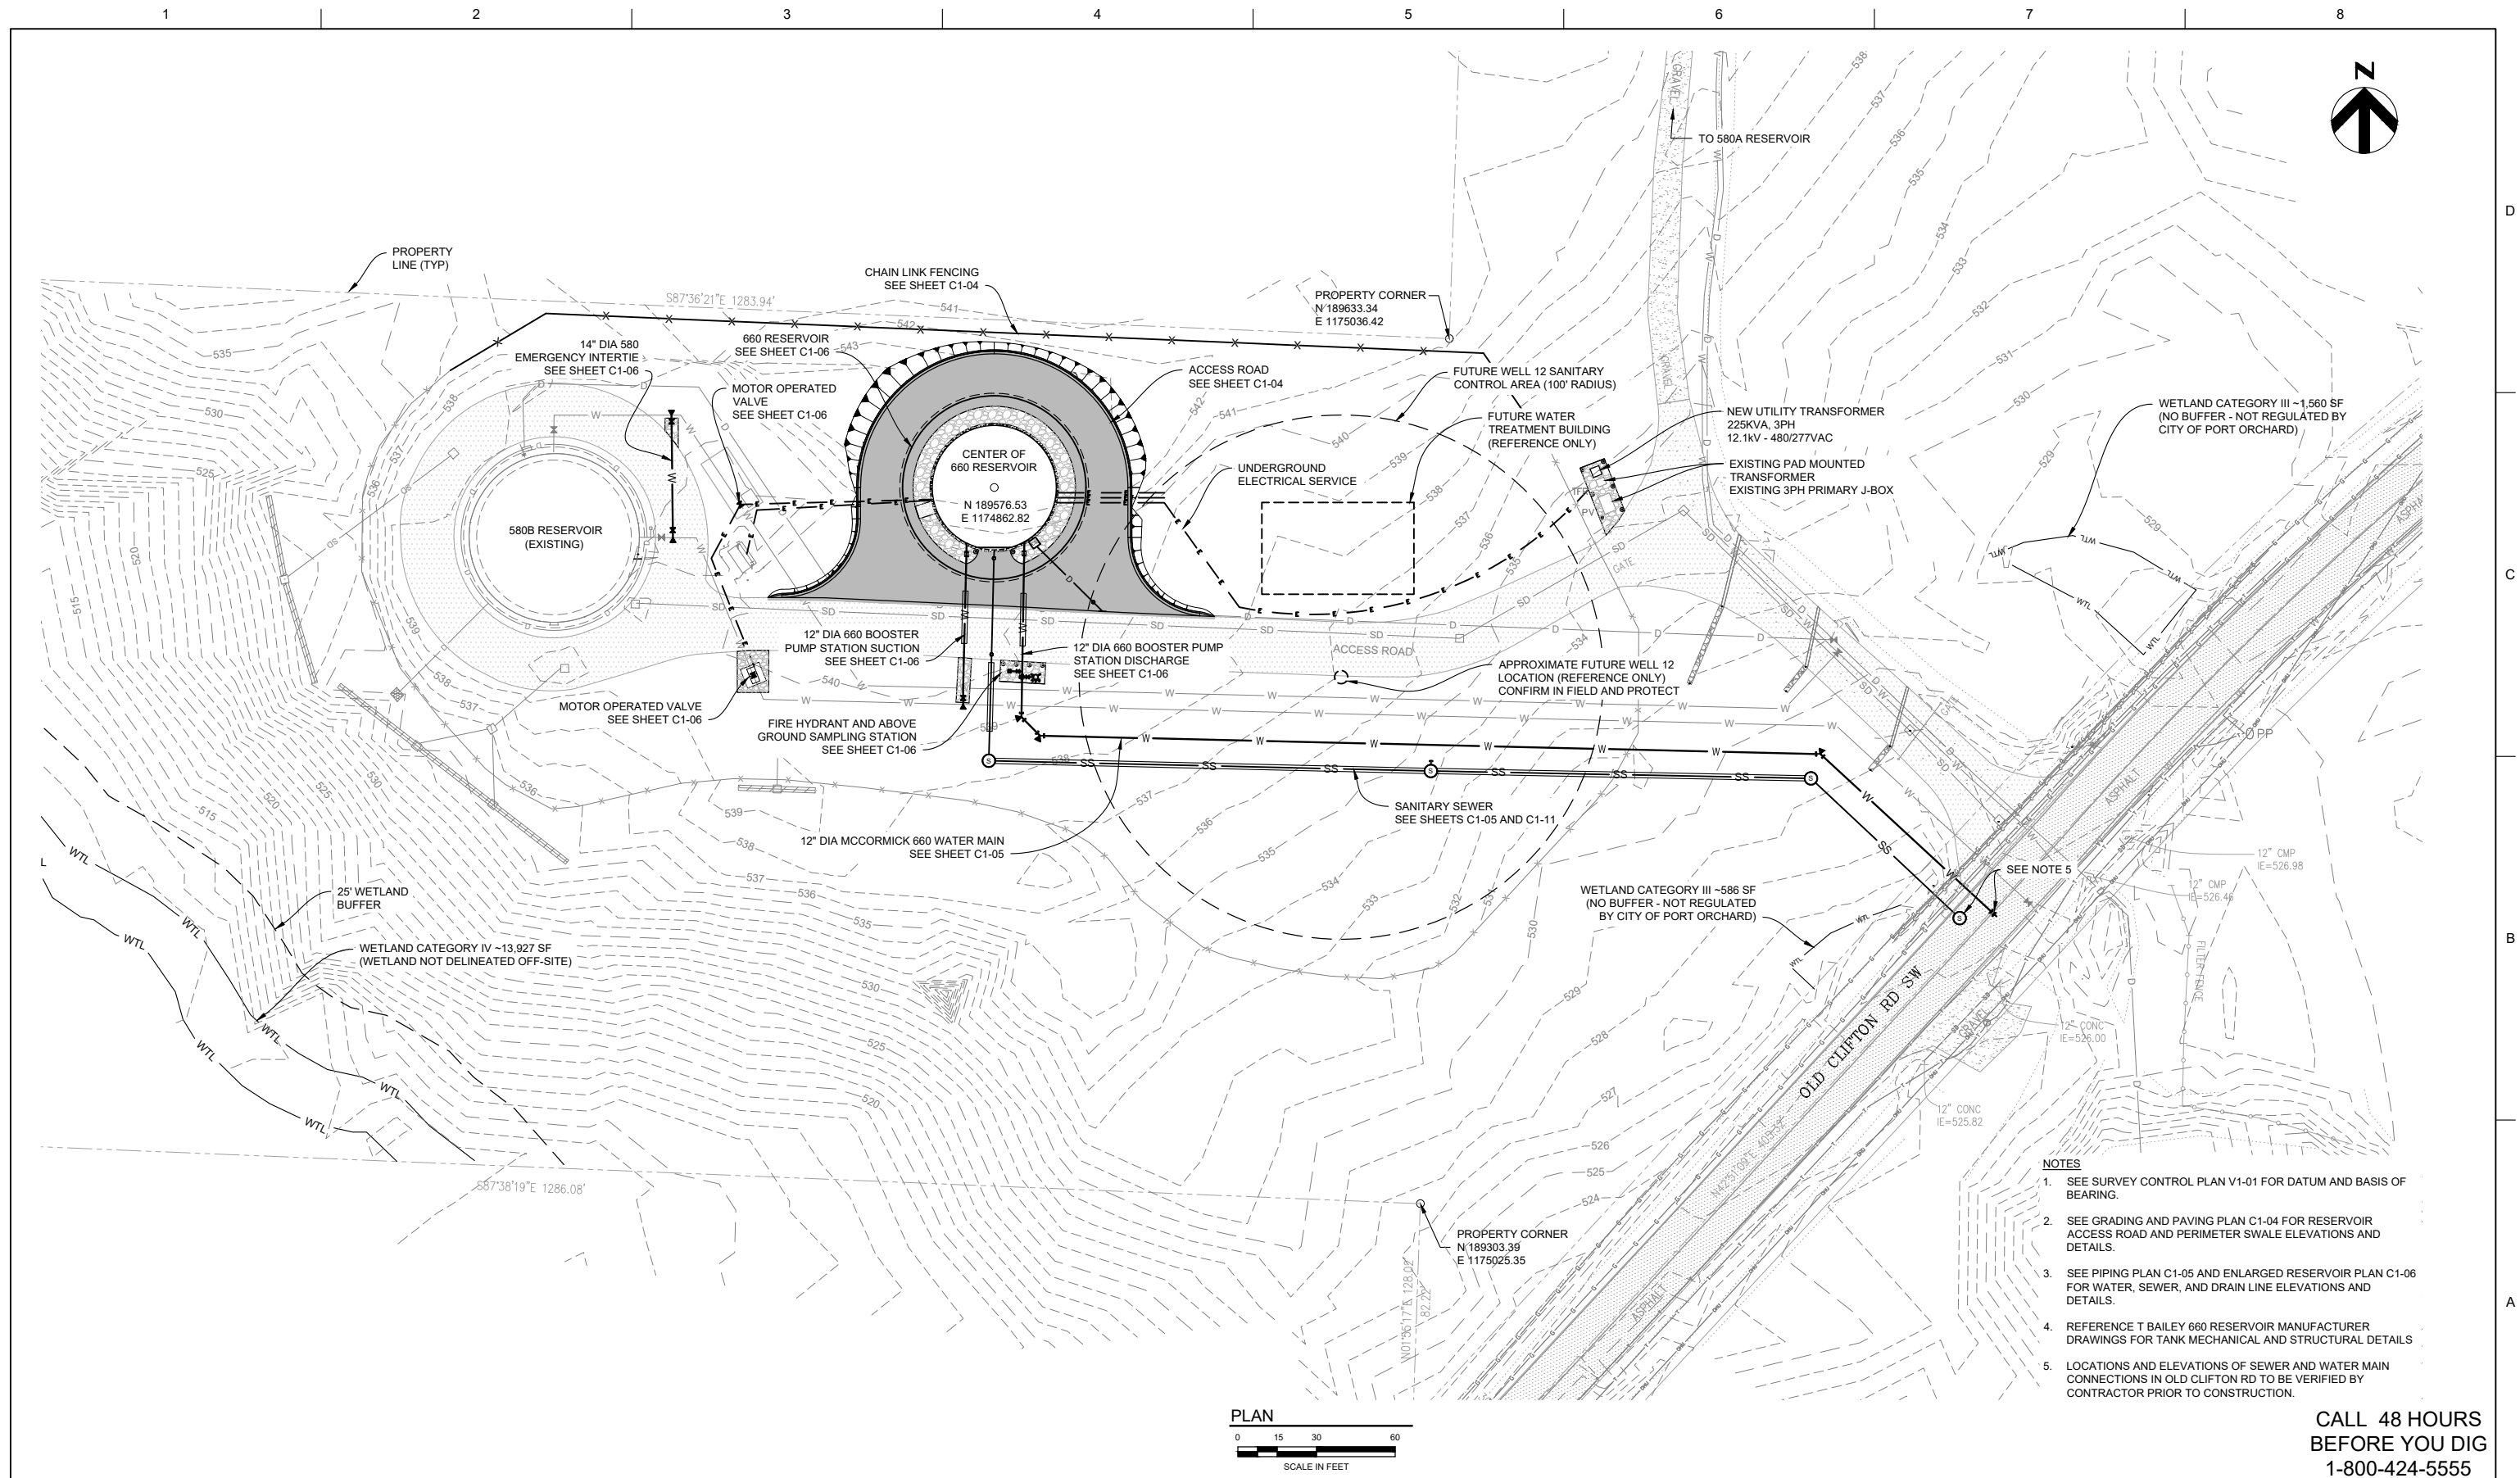


CALL 48 HOURS
BEFORE YOU DIG
1-800-424-5555



			CIVIL ENG	J. KNOLL
			WATER ENG	L. CHENG
			STRUCTURAL ENG	M. HIJAZI
			ELECTRICAL ENG	I. RINCON
			INSTR. ENG	M. HUTSON
7/2022			BID SET	
ISSUE	DATE	DESCRIPTION	PROJECT NUMBER	10172116




SITE PLAN

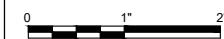

FILENAME	C1-03.dwg
SCALE	1" = 30'

C1-03

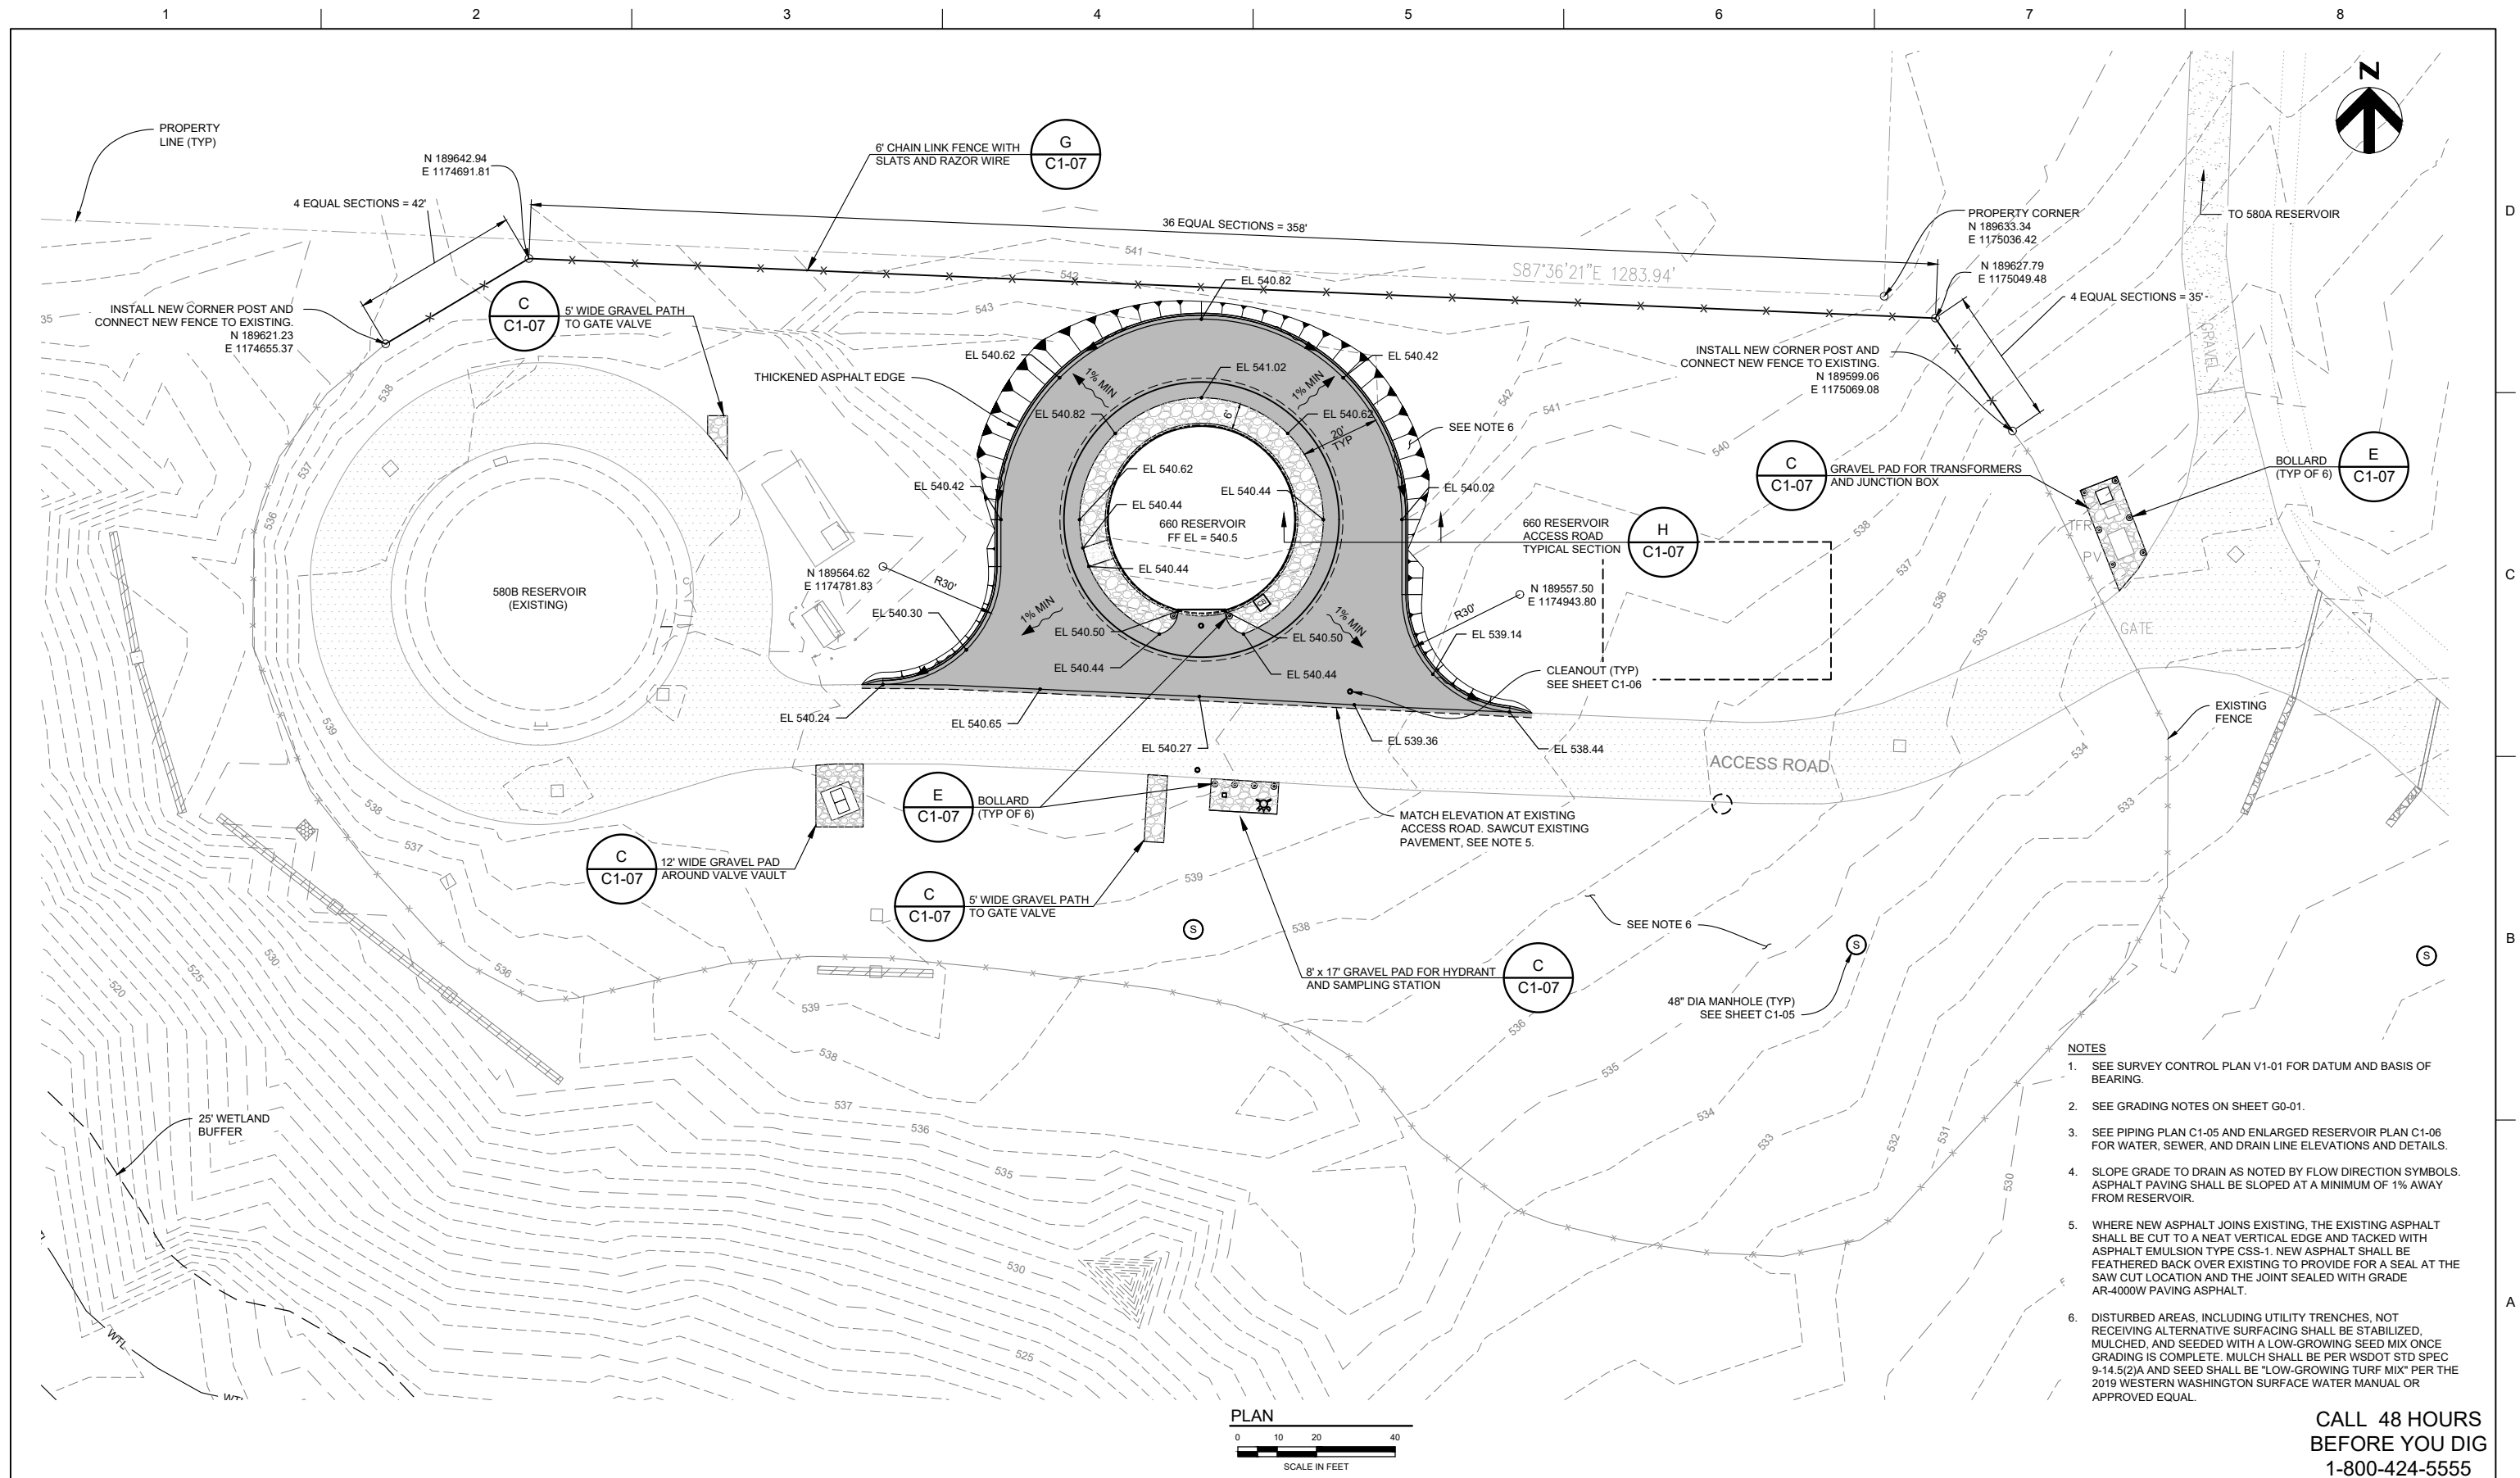

CALL 48 HOURS
BEFORE YOU DIG
1-800-424-5555


[illegible]

PROJECT MANAGER	L. NOLAN
CIVIL ENG	J. KNOLL
WATER ENG	L. CHENG
STRUCTURAL ENG	M. HIJAZI
ELECTRICAL ENG	I. RINCON
INSTR. ENG	M. HUTSON
PROJECT NUMBER	10172116




MCCORMICK
CLOSE TO WHAT COUNTS
PORT ORCHARD 660 RESERVOIR

GRADING AND PAVING PLAN

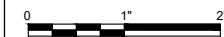

FILENAME	C1-04.dwg
SCALE	1" = 20'

C1-04

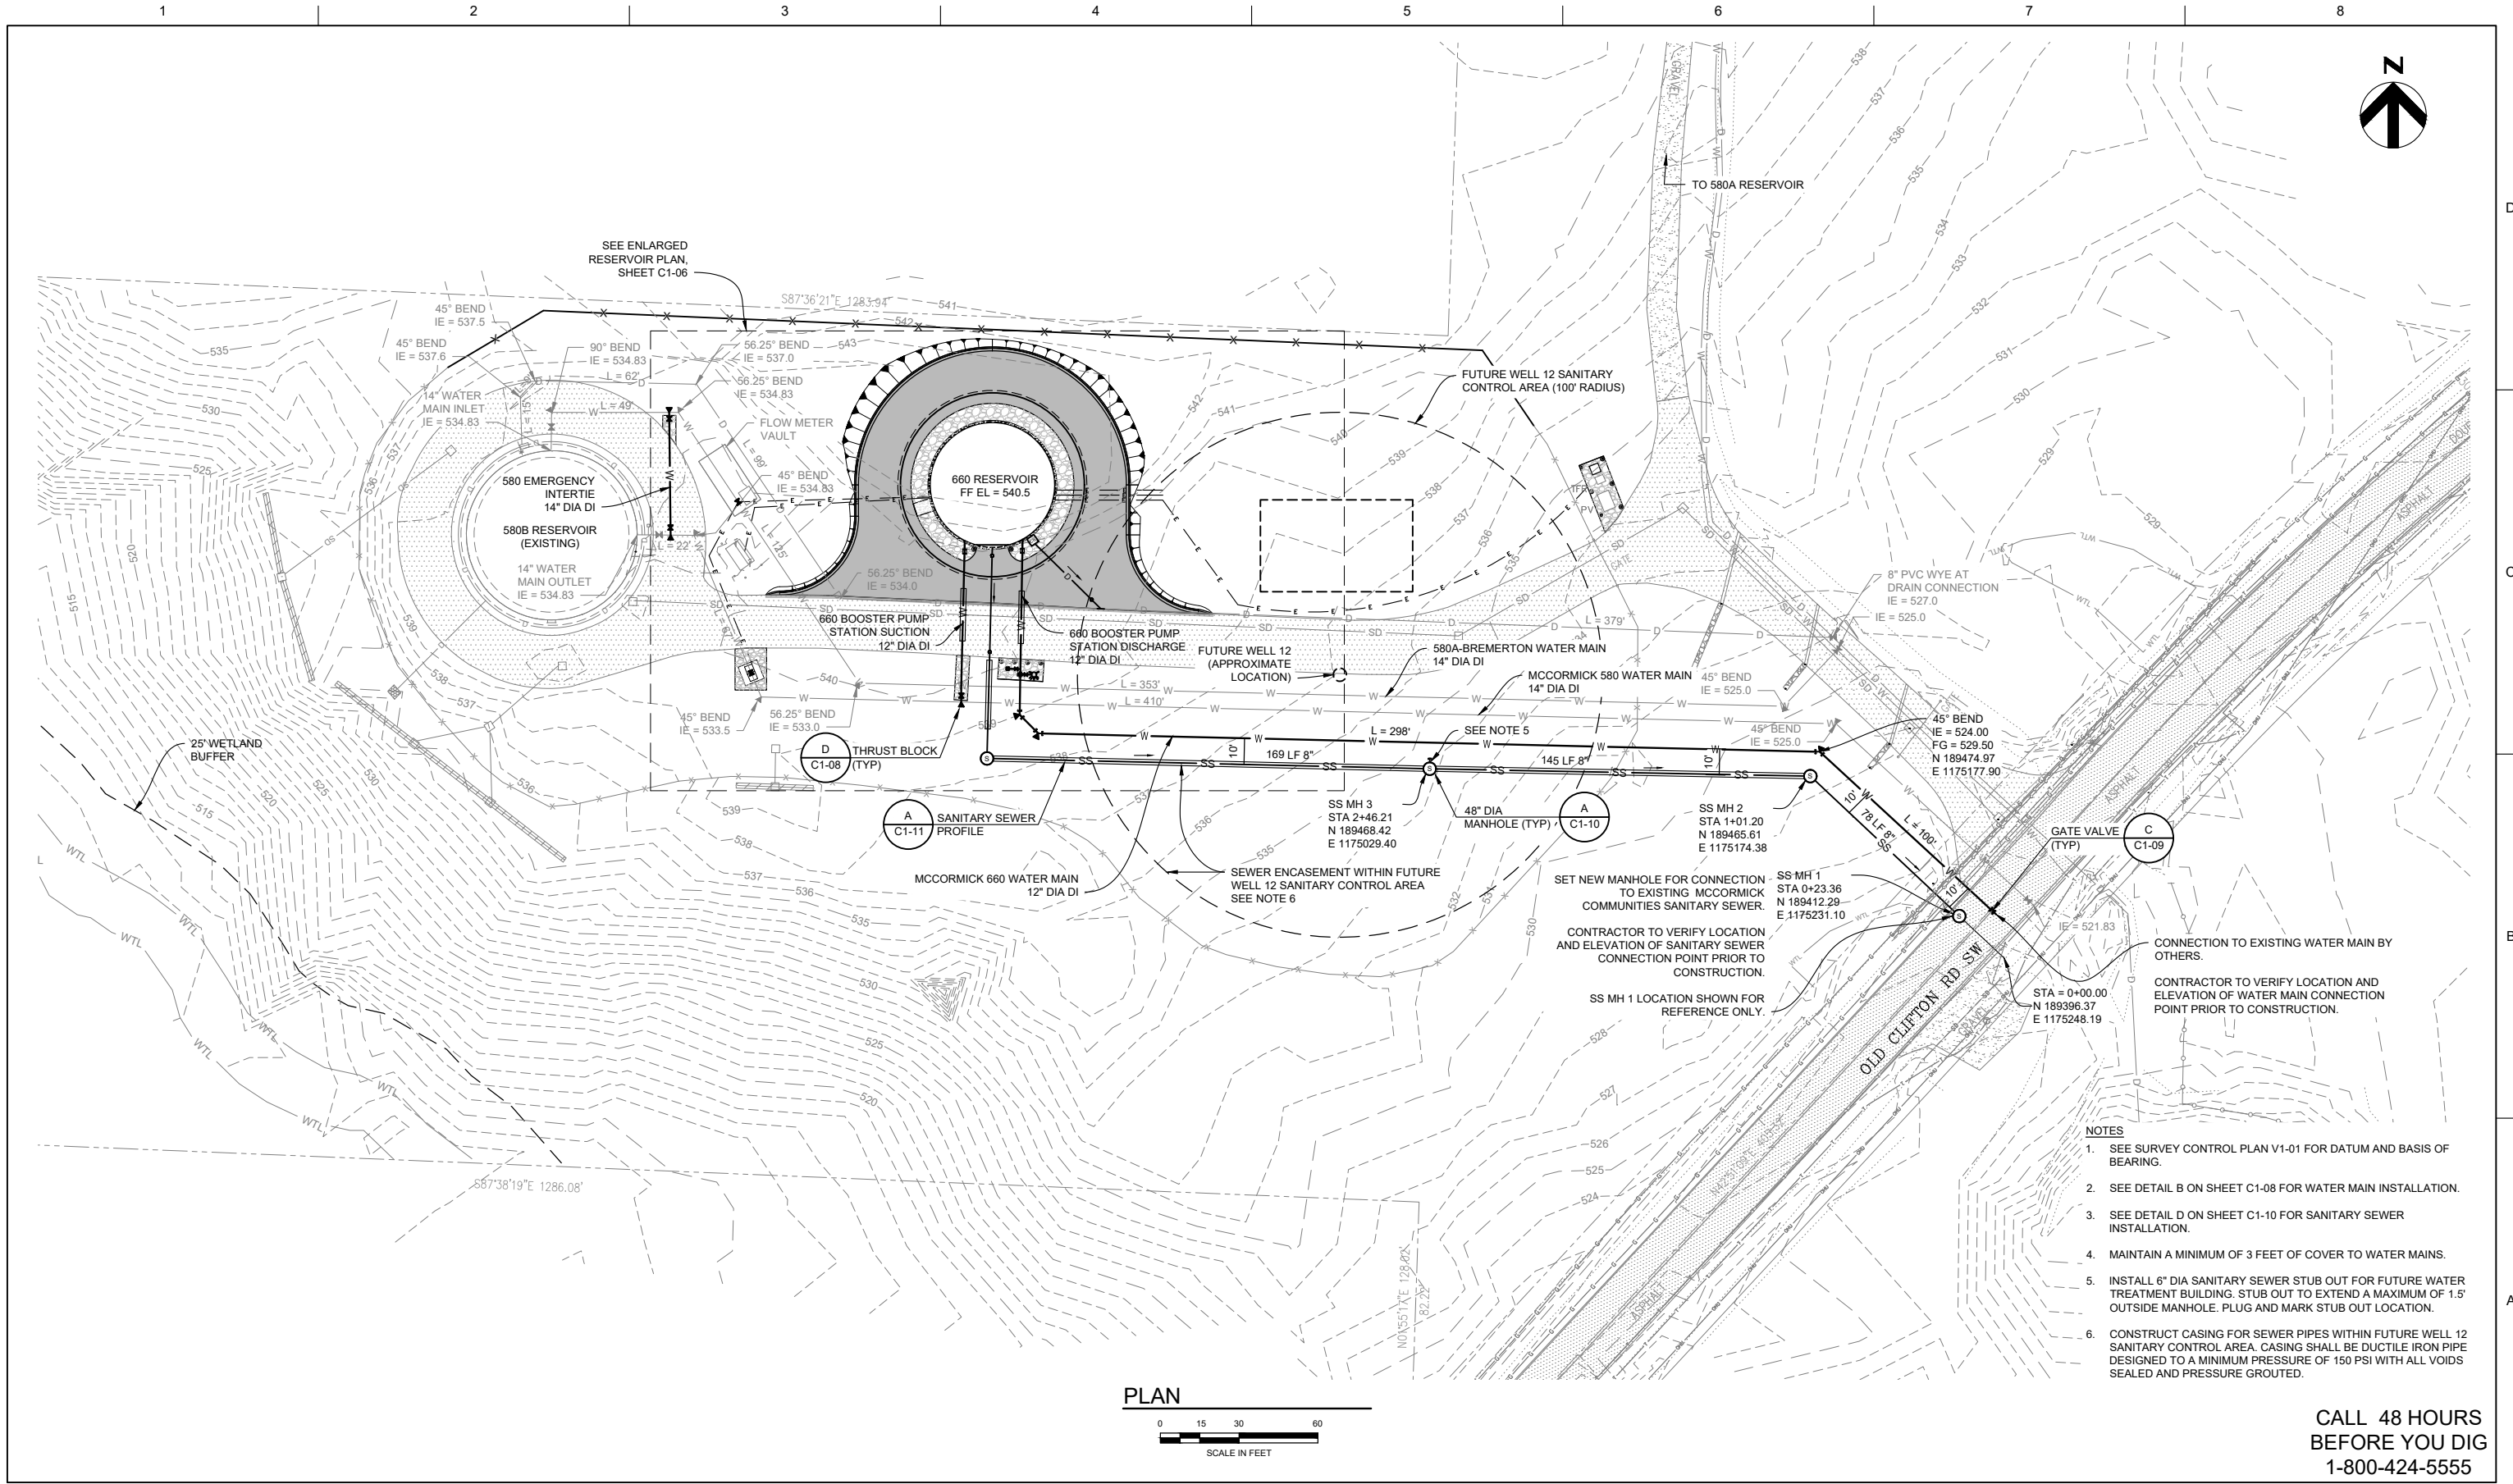

CALL 48 HOURS
BEFORE YOU DIG
1-800-424-5555




7/2022 BID SET		
ISSUE	DATE	DESCRIPTION

PROJECT MANAGER L. NOLAN	
CIVIL ENG	J. KNOLL
WATER ENG	L. CHENG
STRUCTURAL ENG	M. HIJAZI
ELECTRICAL ENG	I. RINCON
INSTR. ENG	M. HUTSON
PROJECT NUMBER 10172116	




SITE PIPING PLAN





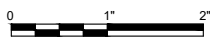


FILENAME C1-05.dwg
SCALE 1" = 30'

SHEET
C1-05

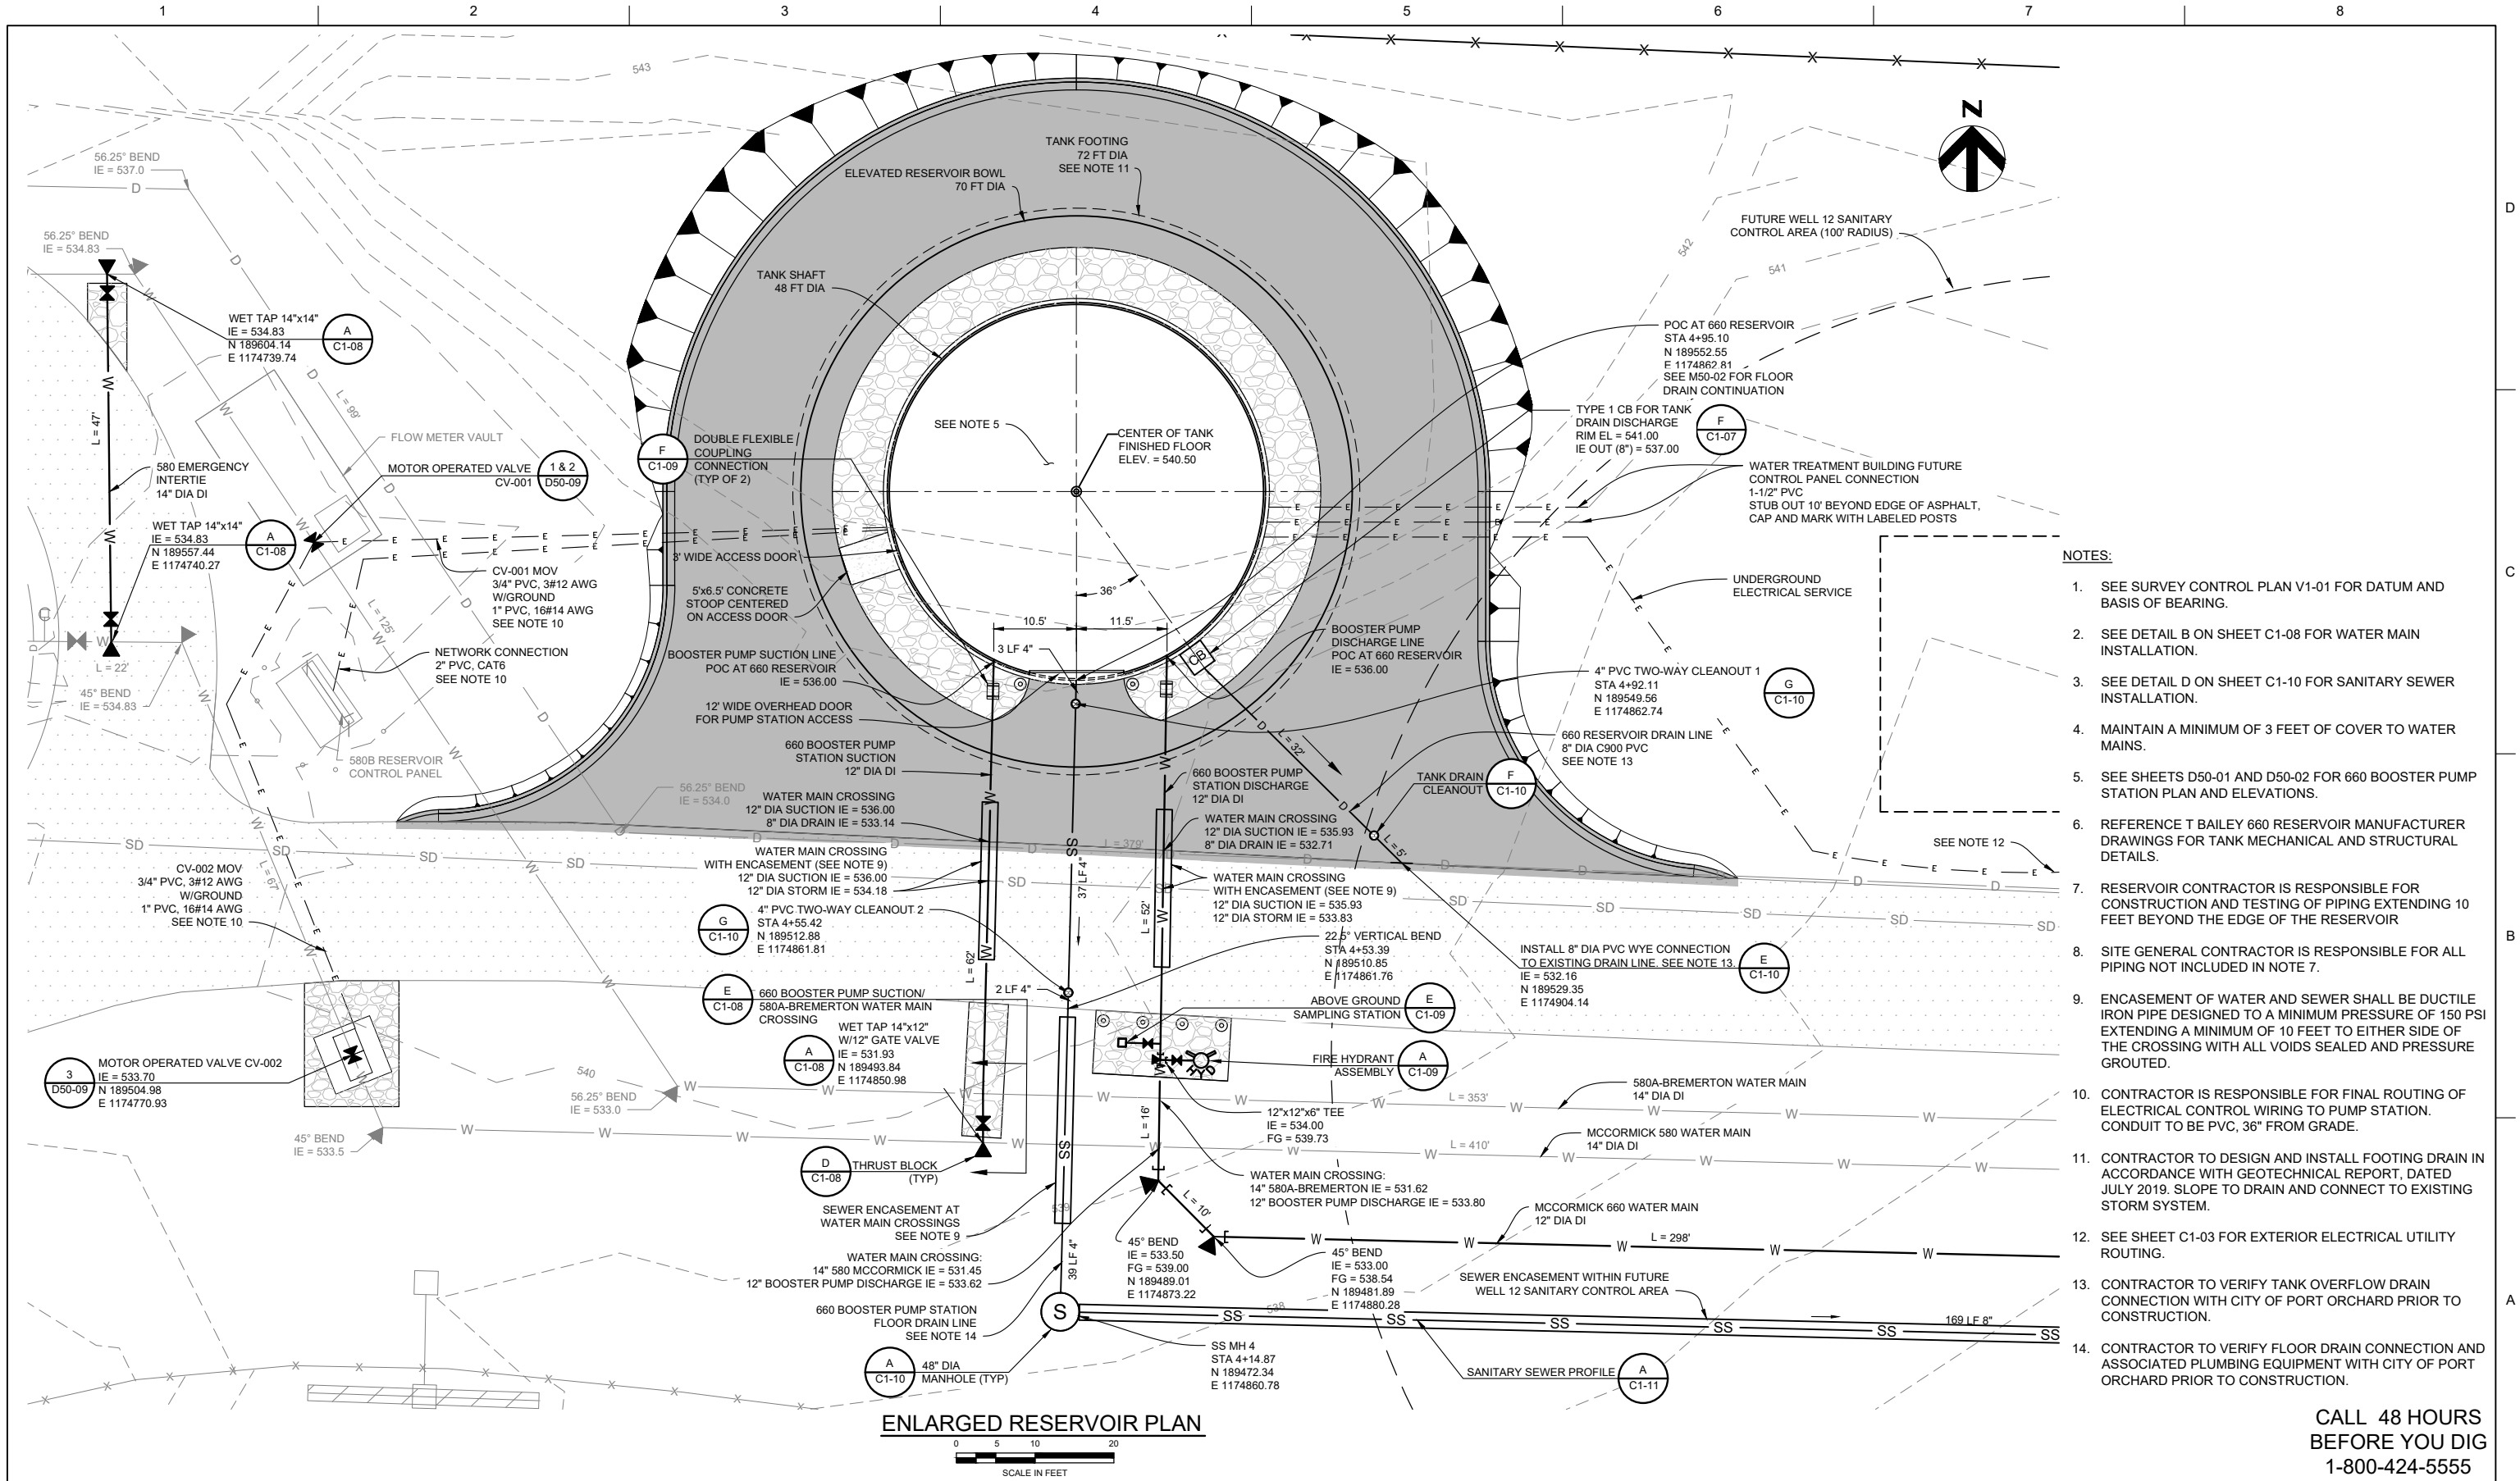


- NOTES:**
- SEE SURVEY CONTROL PLAN V1-01 FOR DATUM AND BASIS OF BEARING.
 - SEE DETAIL B ON SHEET C1-08 FOR WATER MAIN INSTALLATION.
 - SEE DETAIL D ON SHEET C1-10 FOR SANITARY SEWER INSTALLATION.
 - MAINTAIN A MINIMUM OF 3 FEET OF COVER TO WATER MAINS.
 - SEE SHEETS D50-01 AND D50-02 FOR 660 BOOSTER PUMP STATION PLAN AND ELEVATIONS.
 - REFERENCE T BAILEY 660 RESERVOIR MANUFACTURER DRAWINGS FOR TANK MECHANICAL AND STRUCTURAL DETAILS.
 - RESERVOIR CONTRACTOR IS RESPONSIBLE FOR CONSTRUCTION AND TESTING OF PIPING EXTENDING 10 FEET BEYOND THE EDGE OF THE RESERVOIR
 - SITE GENERAL CONTRACTOR IS RESPONSIBLE FOR ALL PIPING NOT INCLUDED IN NOTE 7.
 - ENCASEMENT OF WATER AND SEWER SHALL BE DUCTILE IRON PIPE DESIGNED TO A MINIMUM PRESSURE OF 150 PSI EXTENDING A MINIMUM OF 10 FEET TO EITHER SIDE OF THE CROSSING WITH ALL VOIDS SEALED AND PRESSURE GROUTED.
 - CONTRACTOR IS RESPONSIBLE FOR FINAL ROUTING OF ELECTRICAL CONTROL WIRING TO PUMP STATION. CONDUIT TO BE PVC, 36" FROM GRADE.
 - CONTRACTOR TO DESIGN AND INSTALL FOOTING DRAIN IN ACCORDANCE WITH GEOTECHNICAL REPORT, DATED JULY 2019. SLOPE TO DRAIN AND CONNECT TO EXISTING STORM SYSTEM.
 - SEE SHEET C1-03 FOR EXTERIOR ELECTRICAL UTILITY ROUTING.
 - CONTRACTOR TO VERIFY TANK OVERFLOW DRAIN CONNECTION WITH CITY OF PORT ORCHARD PRIOR TO CONSTRUCTION.
 - CONTRACTOR TO VERIFY FLOOR DRAIN CONNECTION AND ASSOCIATED PLUMBING EQUIPMENT WITH CITY OF PORT ORCHARD PRIOR TO CONSTRUCTION.

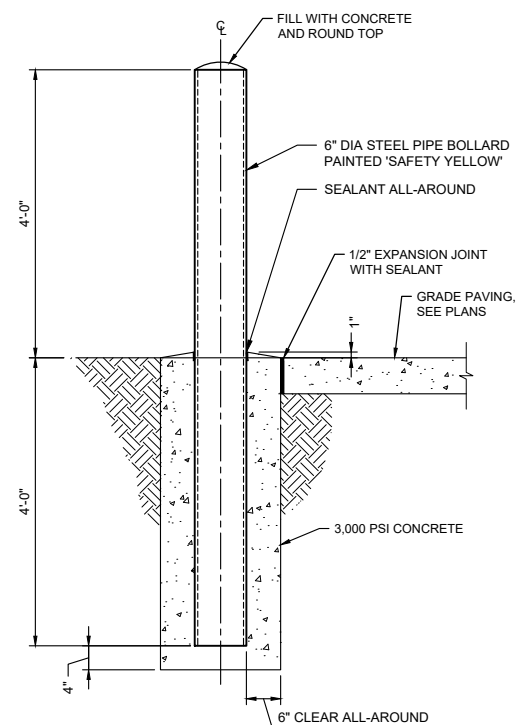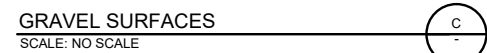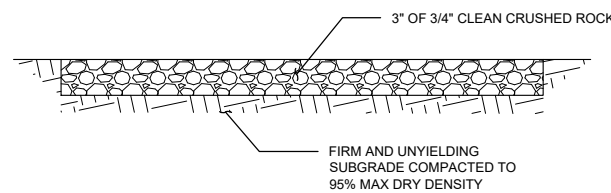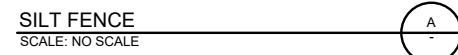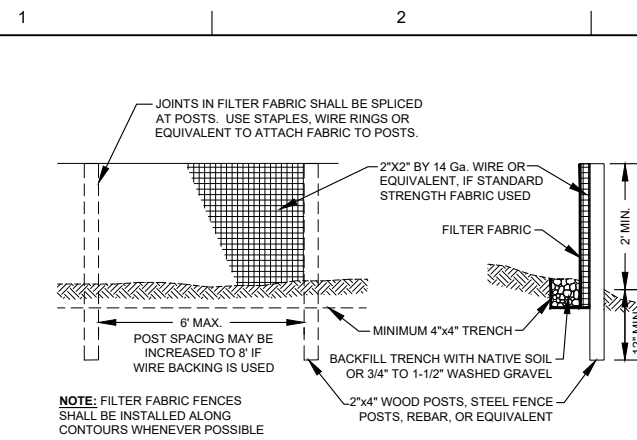


TYPICAL BOLLARD


SCALE: NO SCALE

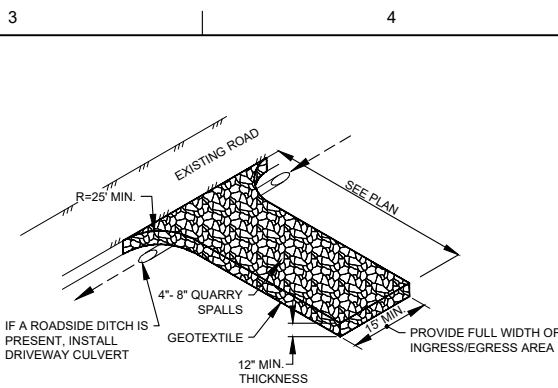






TEMPORARY CONSTRUCTION ENTRANCE
SCALE: NO SCALE

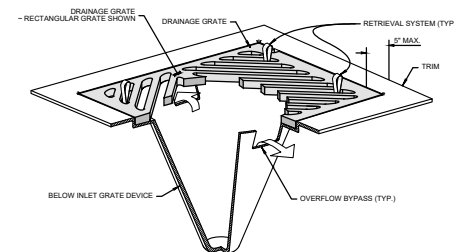


CATCH BASIN INLET PROTECTION
SCALE: NO SCALE

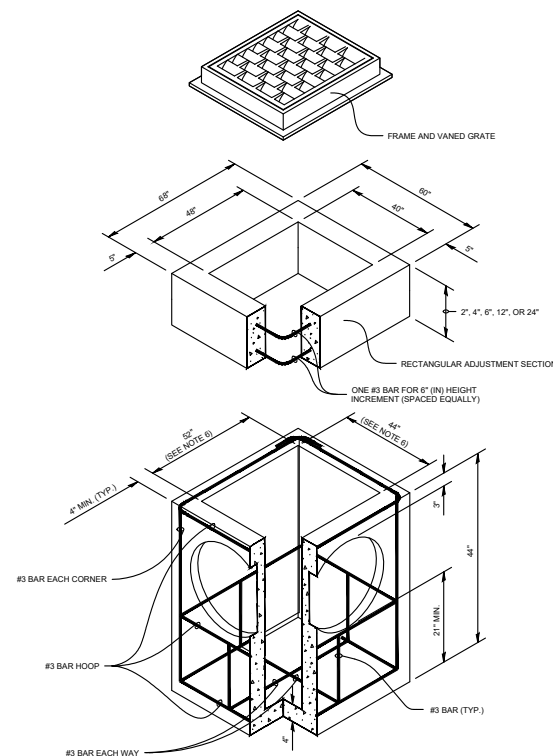

PRECAST TYPE 1 CATCH BASIN
SCALE: NO SCALE

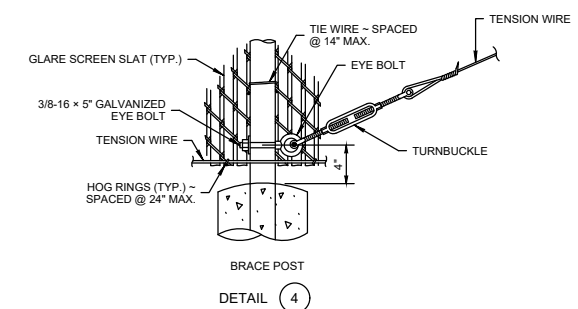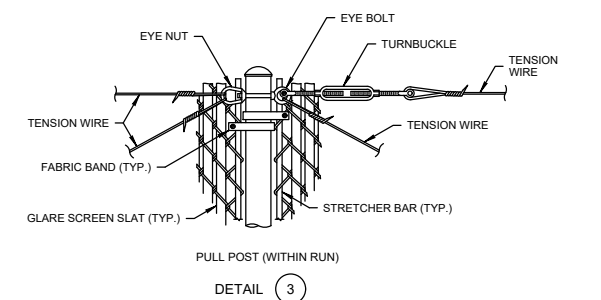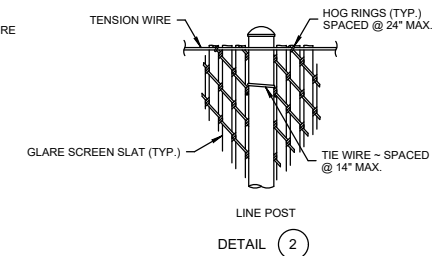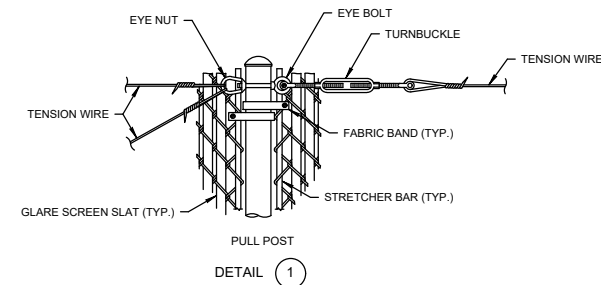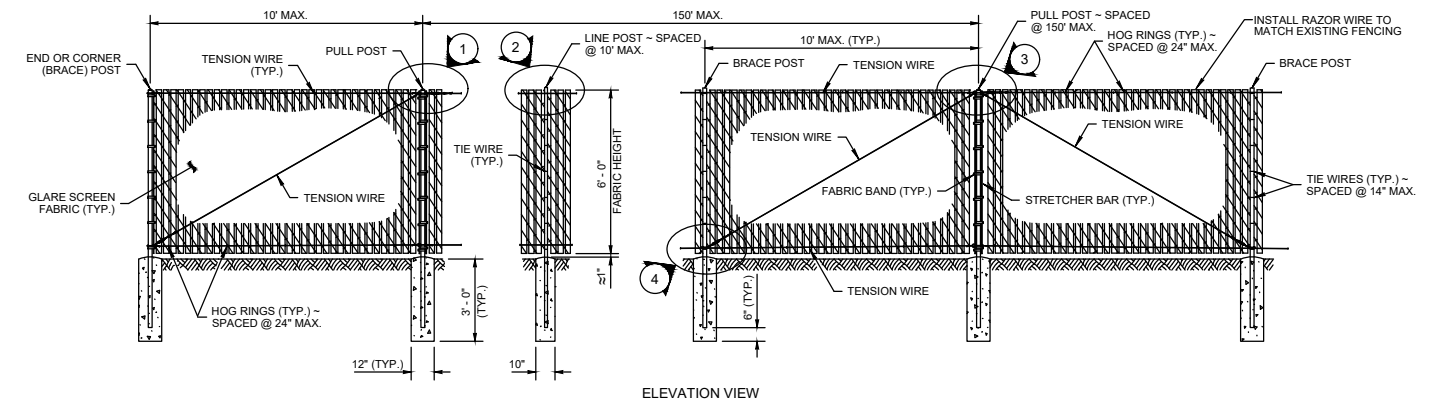

CHAIN LINK FENCE WITH SLATS AND RAZOR WIRE
SCALE: NO SCALE

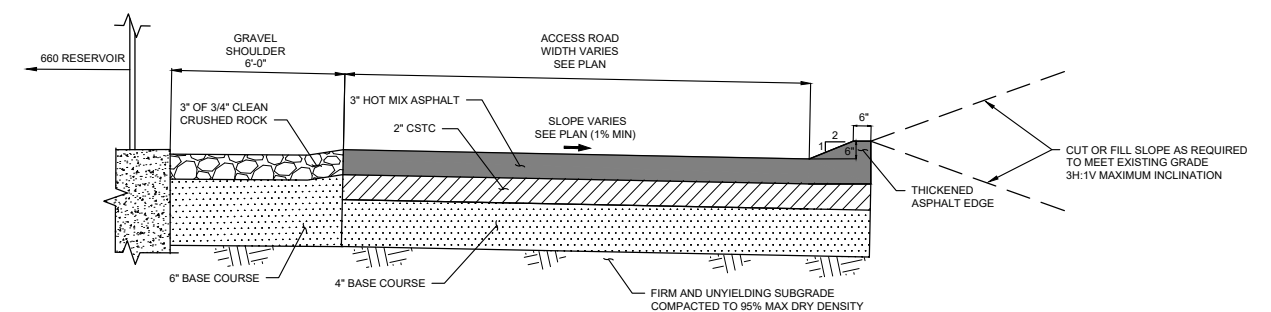

660 RESERVOIR ACCESS ROAD
SCALE: NO SCALE

**CALL 48 HOURS
BEFORE YOU DIG
1-800-424-5555**

[illegible]

PROJECT MANAGER	L. NOLAN
CIVIL ENG	J. KNOLL
WATER ENG	L. CHENG
STRUCTURAL ENG	M. HIJAZI
ELECTRICAL ENG	I. RINCON
INSTR. ENG	M. HUTSON
PROJECT NUMBER	10172116



MCCORMICK
CLOSE TO WHAT COUNTS

PORT ORCHARD 660 RESERVOIR



CIVIL DETAILS




FILENAME	C1-07.dwg
SCALE	AS NOTED

SHEET

C1-07

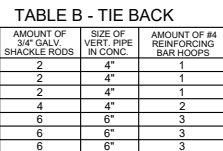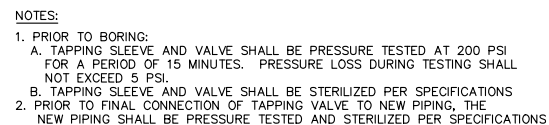



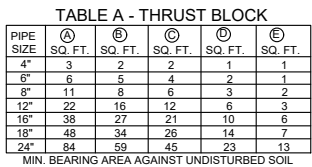


- NOTES:**
1. BEARING AREA OF CONCRETE THRUST BLOCK IS BASED ON 225 PSI PRESSURE AND SAFE SOIL BEARING LOAD OF 2000 PSF.
 2. THE SAFE SOIL BEARING LOAD SHALL BE ADJUSTED TO MEASURED SOIL BEARING LOADS IN THE FIELD.
 3. AREAS MUST BE ADJUSTED FOR OTHER PIPE SIZES, PRESSURES AND SOIL CONDITIONS.
 4. CONCRETE BLOCKING SHALL BE CAST IN PLACE AND HAVE A MINIMUM OF 1/4 SQUARE FOOT BEARING AGAINST THE FITTING.
 5. THE BLOCK SHALL BEAR AGAINST THE FITTINGS ONLY AND SHALL BE CLEAR OF JOINTS TO PERMIT TAKING UP AND DISMANTLING OF JOINT
 6. THE CONTRACTOR SHALL INSTALL BLOCKING ADEQUATE TO WITHSTAND FULL TEST PRESSURE AS WELL AS CONTINUOUSLY WITHSTAND OPERATING PRESSURE UNDER ALL CONDITIONS OF SERVICE.
 7. USE 2" THICK STYROFOAM TO FORM THE CONCRETE BLOCKING. PLASTIC SHALL BE INSTALLED BETWEEN ALL CONCRETE BLOCKING AND FITTINGS.



PIPE SIZE	(A)	(B)	(C)	(D)	(E)
	SQ. FT.	SQ. FT.	SQ. FT.	SQ. FT.	SQ. FT.
4"	3	2	1	1	
6"	6	4	2	1	
8"	11	8	6	3	2
12"	22	16	12	6	3
16"	38	27	21	10	6
18"	48	34	26	14	7
24"	84	59	45	23	13

MIN. BEARING AREA AGAINST UNDISTURBED SOIL

	Est. 1890	RESTORATION, TAPS, AND BLOCKING C	<table><tr><td>DRAWN BY</td><td>IDS</td></tr><tr><td>DATE</td><td>1/31/2019</td></tr><tr><td>SCALE</td><td>NTS</td></tr><tr><td>DRAWING NUMBER</td><td>802</td></tr></table>	DRAWN BY	IDS	DATE	1/31/2019	SCALE	NTS	DRAWING NUMBER	802		Est. 1890	RESTORATION, TAPS, AND BLOCKING B	<table><tr><td>DRAWN BY</td><td>IDS</td></tr><tr><td>DATE</td><td>1/31/2019</td></tr><tr><td>SCALE</td><td>NTS</td></tr><tr><td>DRAWING NUMBER</td><td>801</td></tr></table>	DRAWN BY	IDS	DATE	1/31/2019	SCALE	NTS	DRAWING NUMBER	801		Est. 1890	RESTORATION, TAPS, AND BLOCKING	<table><tr><td>DRAWN BY</td><td>IDS</td></tr><tr><td>DATE</td><td>1/15/2019</td></tr><tr><td>SCALE</td><td>NTS</td></tr><tr><td>DRAWING NUMBER</td><td>803-B</td></tr></table>	DRAWN BY	IDS	DATE	1/15/2019	SCALE	NTS	DRAWING NUMBER	803-B		Est. 1890	RESTORATION, TAPS, AND BLOCKING	<table><tr><td>DRAWN BY</td><td>IDS</td></tr><tr><td>DATE</td><td>1/15/2019</td></tr><tr><td>SCALE</td><td>NTS</td></tr><tr><td>DRAWING NUMBER</td><td>803-A</td></tr></table>	DRAWN BY	IDS	DATE	1/15/2019	SCALE	NTS	DRAWING NUMBER	803-A																																																																																																																																																																																																																																																																																																																																																																																																																																																																																																																																																																																																																																																																																																																																																																																																																																																																																																																																																																																																																																																																																																																																																																																																																																																								
	DRAWN BY	IDS																																																																																																																																																																																																																																																																																																																																																																																																																																																																																																																																																																																																																																																																																																																																																																																																																																																																																																																																																																																																																																																																																																																																																																																																																																																																																																					
	DATE	1/31/2019																																																																																																																																																																																																																																																																																																																																																																																																																																																																																																																																																																																																																																																																																																																																																																																																																																																																																																																																																																																																																																																																																																																																																																																																																																																																																																					
	SCALE	NTS																																																																																																																																																																																																																																																																																																																																																																																																																																																																																																																																																																																																																																																																																																																																																																																																																																																																																																																																																																																																																																																																																																																																																																																																																																																																																																					
DRAWING NUMBER	802																																																																																																																																																																																																																																																																																																																																																																																																																																																																																																																																																																																																																																																																																																																																																																																																																																																																																																																																																																																																																																																																																																																																																																																																																																																																																																						
DRAWN BY	IDS																																																																																																																																																																																																																																																																																																																																																																																																																																																																																																																																																																																																																																																																																																																																																																																																																																																																																																																																																																																																																																																																																																																																																																																																																																																																																																						
DATE	1/31/2019																																																																																																																																																																																																																																																																																																																																																																																																																																																																																																																																																																																																																																																																																																																																																																																																																																																																																																																																																																																																																																																																																																																																																																																																																																																																																																						
SCALE	NTS																																																																																																																																																																																																																																																																																																																																																																																																																																																																																																																																																																																																																																																																																																																																																																																																																																																																																																																																																																																																																																																																																																																																																																																																																																																																																																						
DRAWING NUMBER	801																																																																																																																																																																																																																																																																																																																																																																																																																																																																																																																																																																																																																																																																																																																																																																																																																																																																																																																																																																																																																																																																																																																																																																																																																																																																																																						
DRAWN BY	IDS																																																																																																																																																																																																																																																																																																																																																																																																																																																																																																																																																																																																																																																																																																																																																																																																																																																																																																																																																																																																																																																																																																																																																																																																																																																																																																						
DATE	1/15/2019																																																																																																																																																																																																																																																																																																																																																																																																																																																																																																																																																																																																																																																																																																																																																																																																																																																																																																																																																																																																																																																																																																																																																																																																																																																																																																						
SCALE	NTS																																																																																																																																																																																																																																																																																																																																																																																																																																																																																																																																																																																																																																																																																																																																																																																																																																																																																																																																																																																																																																																																																																																																																																																																																																																																																																						
DRAWING NUMBER	803-B																																																																																																																																																																																																																																																																																																																																																																																																																																																																																																																																																																																																																																																																																																																																																																																																																																																																																																																																																																																																																																																																																																																																																																																																																																																																																																						
DRAWN BY	IDS																																																																																																																																																																																																																																																																																																																																																																																																																																																																																																																																																																																																																																																																																																																																																																																																																																																																																																																																																																																																																																																																																																																																																																																																																																																																																																						
DATE	1/15/2019																																																																																																																																																																																																																																																																																																																																																																																																																																																																																																																																																																																																																																																																																																																																																																																																																																																																																																																																																																																																																																																																																																																																																																																																																																																																																																						
SCALE	NTS																																																																																																																																																																																																																																																																																																																																																																																																																																																																																																																																																																																																																																																																																																																																																																																																																																																																																																																																																																																																																																																																																																																																																																																																																																																																																																						
DRAWING NUMBER	803-A																																																																																																																																																																																																																																																																																																																																																																																																																																																																																																																																																																																																																																																																																																																																																																																																																																																																																																																																																																																																																																																																																																																																																																																																																																																																																																						
		WET TAP				WATER MAIN TRENCH									THRUST BLOCKING AND TIE BACKS																																																																																																																																																																																																																																																																																																																																																																																																																																																																																																																																																																																																																																																																																																																																																																																																																																																																																																																																																																																																																																																																																																																																																																																																																																																																																								

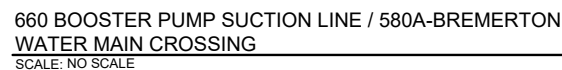

	TEST PRESSURE (PSI)		CONCRETE VOLUME (Ft ³)	CUBE SIZE (Ft)		
4"	250	11.25"	6	1.8	5/8"	17"
		22.5"	12	2.3		
		45"	22	2.8		
6"	250	11.25"	14	2.4	5/8"	17"
		22.5"	27	3.0		
		45"	50	3.7		
8"	250	11.25"	25	2.9	5/8"	17"
		22.5"	48	3.6		
		45"	89	4.5		
10"	250	11.25"	38	3.4	5/8"	17"
		22.5"	75	4.2		
		45"	139	5.2		
12"	250	11.25"	55	3.8	5/8"	17"
		22.5"	108	4.8		
		45"	200	5.8		
14"	250	11.25"	75	4.2	7/8"	24"
		22.5"	147	5.3	3/4"	20"
		45"	272	6.5	1"	27"
16"	250	11.25"	98	4.6	5/8"	17"
		22.5"	192	5.8	7/8"	24"
		45"	355	7.1	1 1/8"	30"


CALL 48 HOURS
BEFORE YOU DIG
1-800-424-5555



			PROJECT MANAGER	L. NOLAN
			CIVIL ENG	J. KNOLL
			WATER ENG	L. CHENG
			STRUCTURAL ENG	M. HIJAZI
			ELECTRICAL ENG	I. RINCON
			INSTR. ENG	M. HUTSON
7/2022			BID SET	
ISSUE	DATE	DESCRIPTION	PROJECT NUMBER	10172116







CIVIL DETAILS

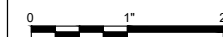

FILENAME	C1-08.dwg
SCALE	AS NOTED


SHEET

C1-08

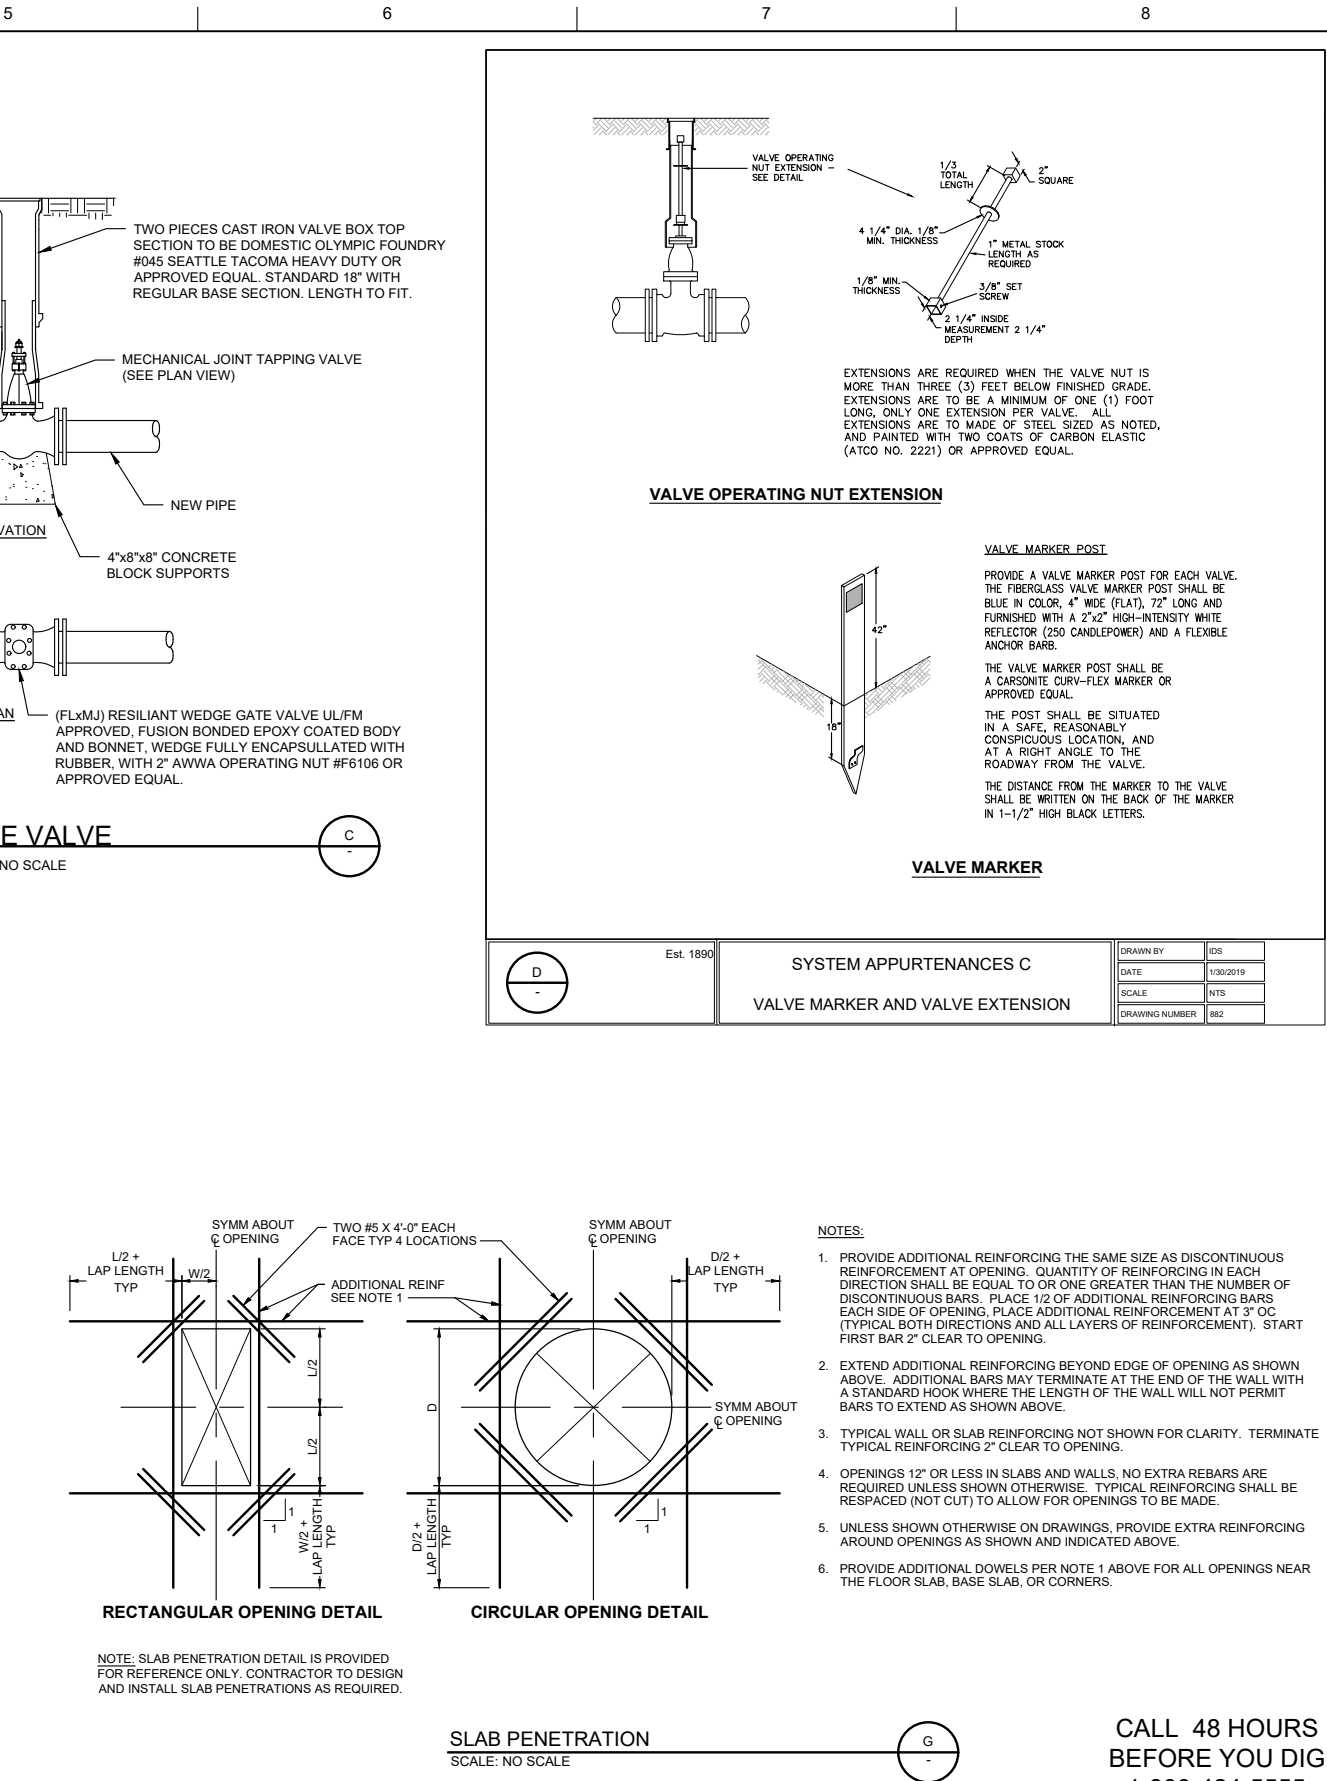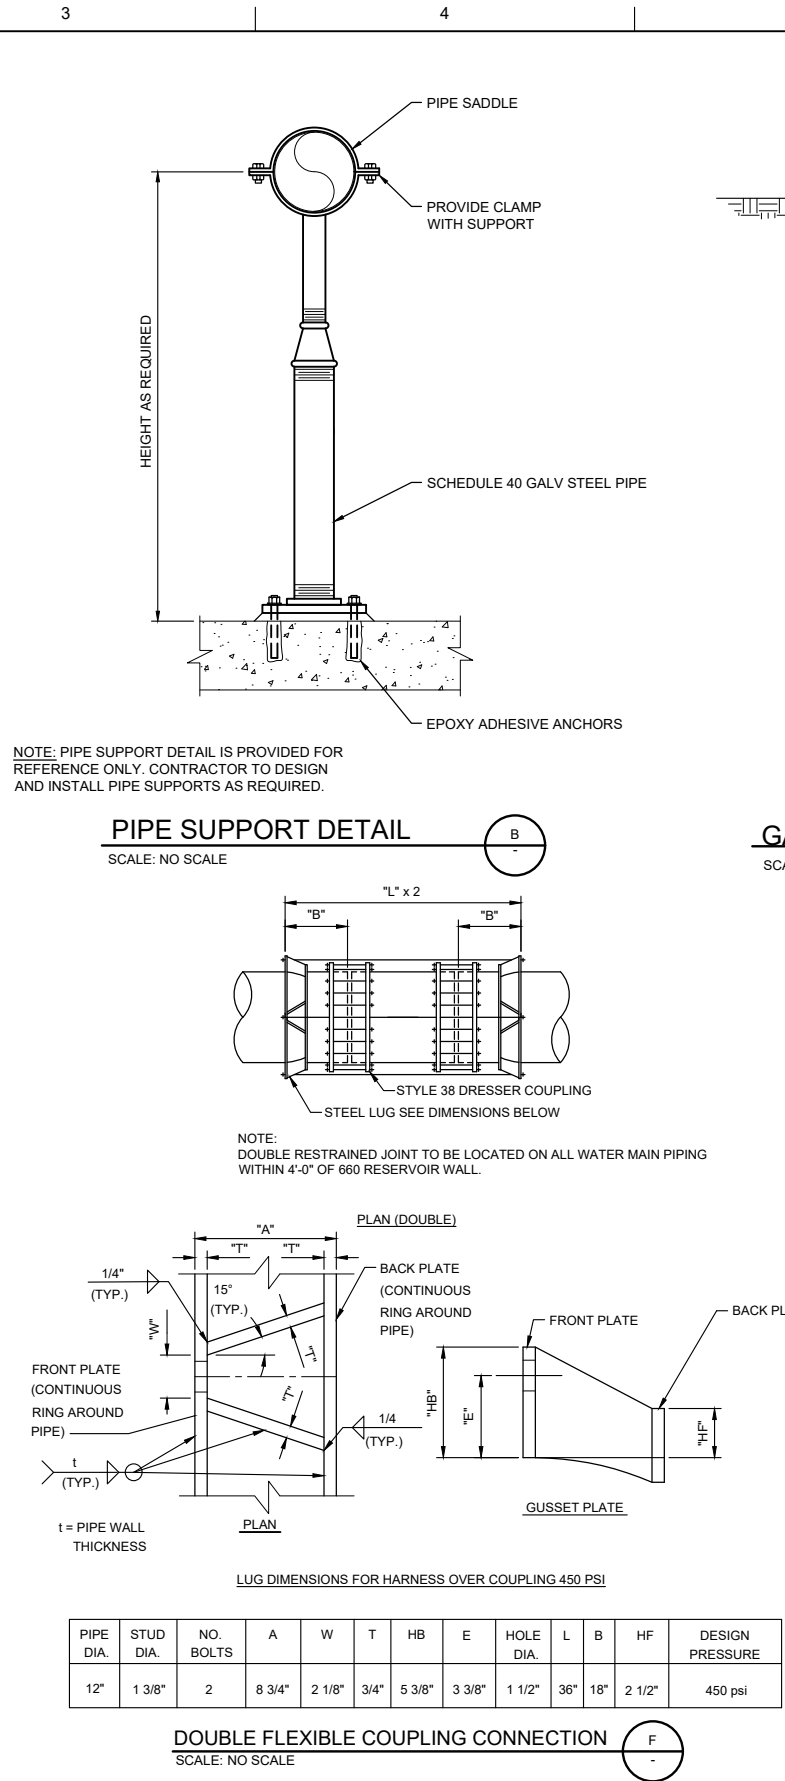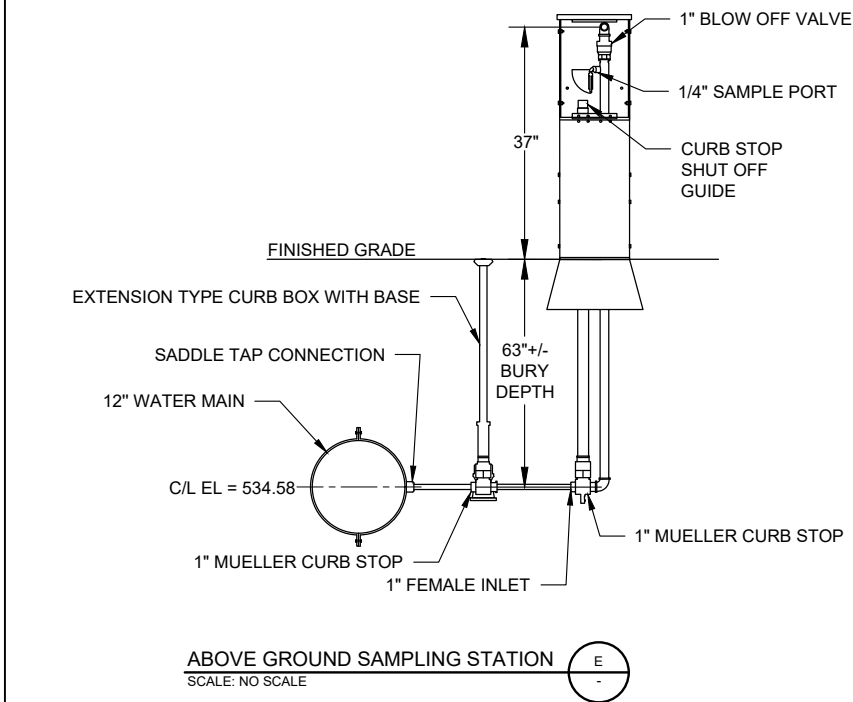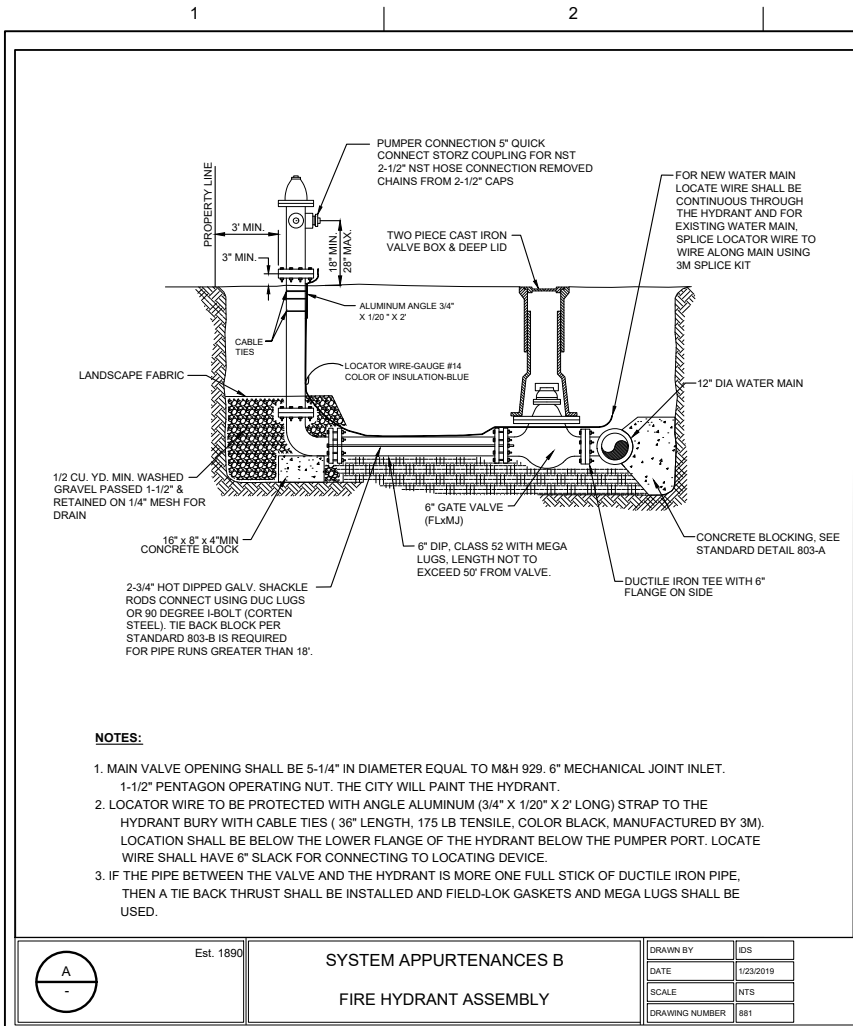



7/2022	BID SET
ISSUE	DATE
DESCRIPTION	

PROJECT MANAGER	L. NOLAN
CIVIL ENG.	J. KNOLL
WATER ENG.	L. CHENG
STRUCTURAL ENG.	M. HIJAZI
ELECTRICAL ENG.	I. RINCON
INSTR. ENG.	M. HUTSON
PROJECT NUMBER	10172116

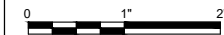

FILENAME	C1-09.dwg
SCALE	AS NOTED

SHEET	C1-09
-------	-------

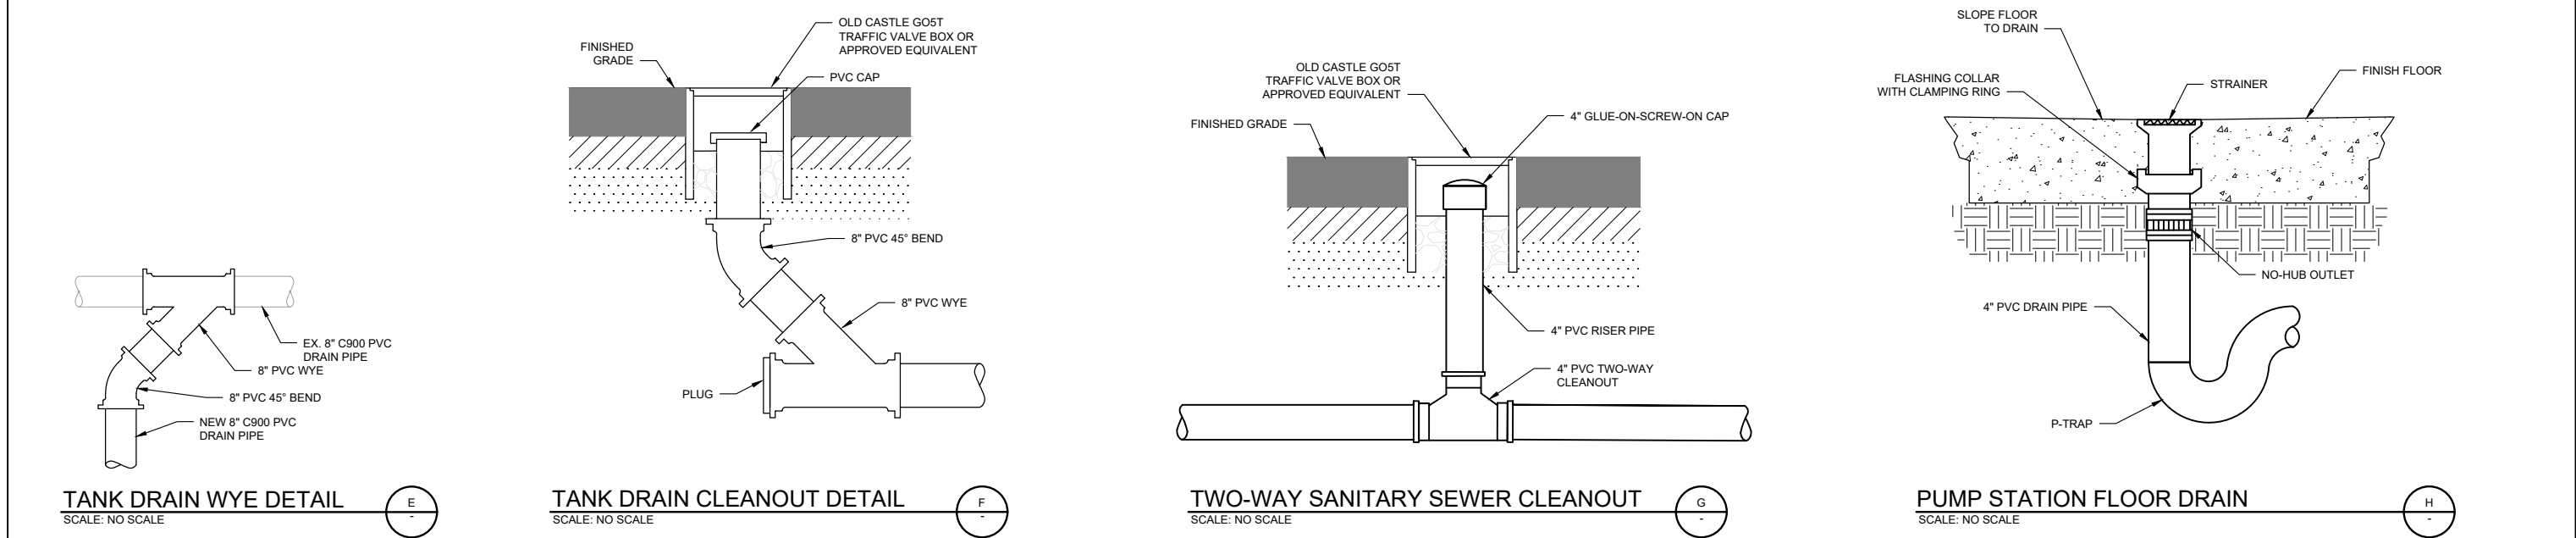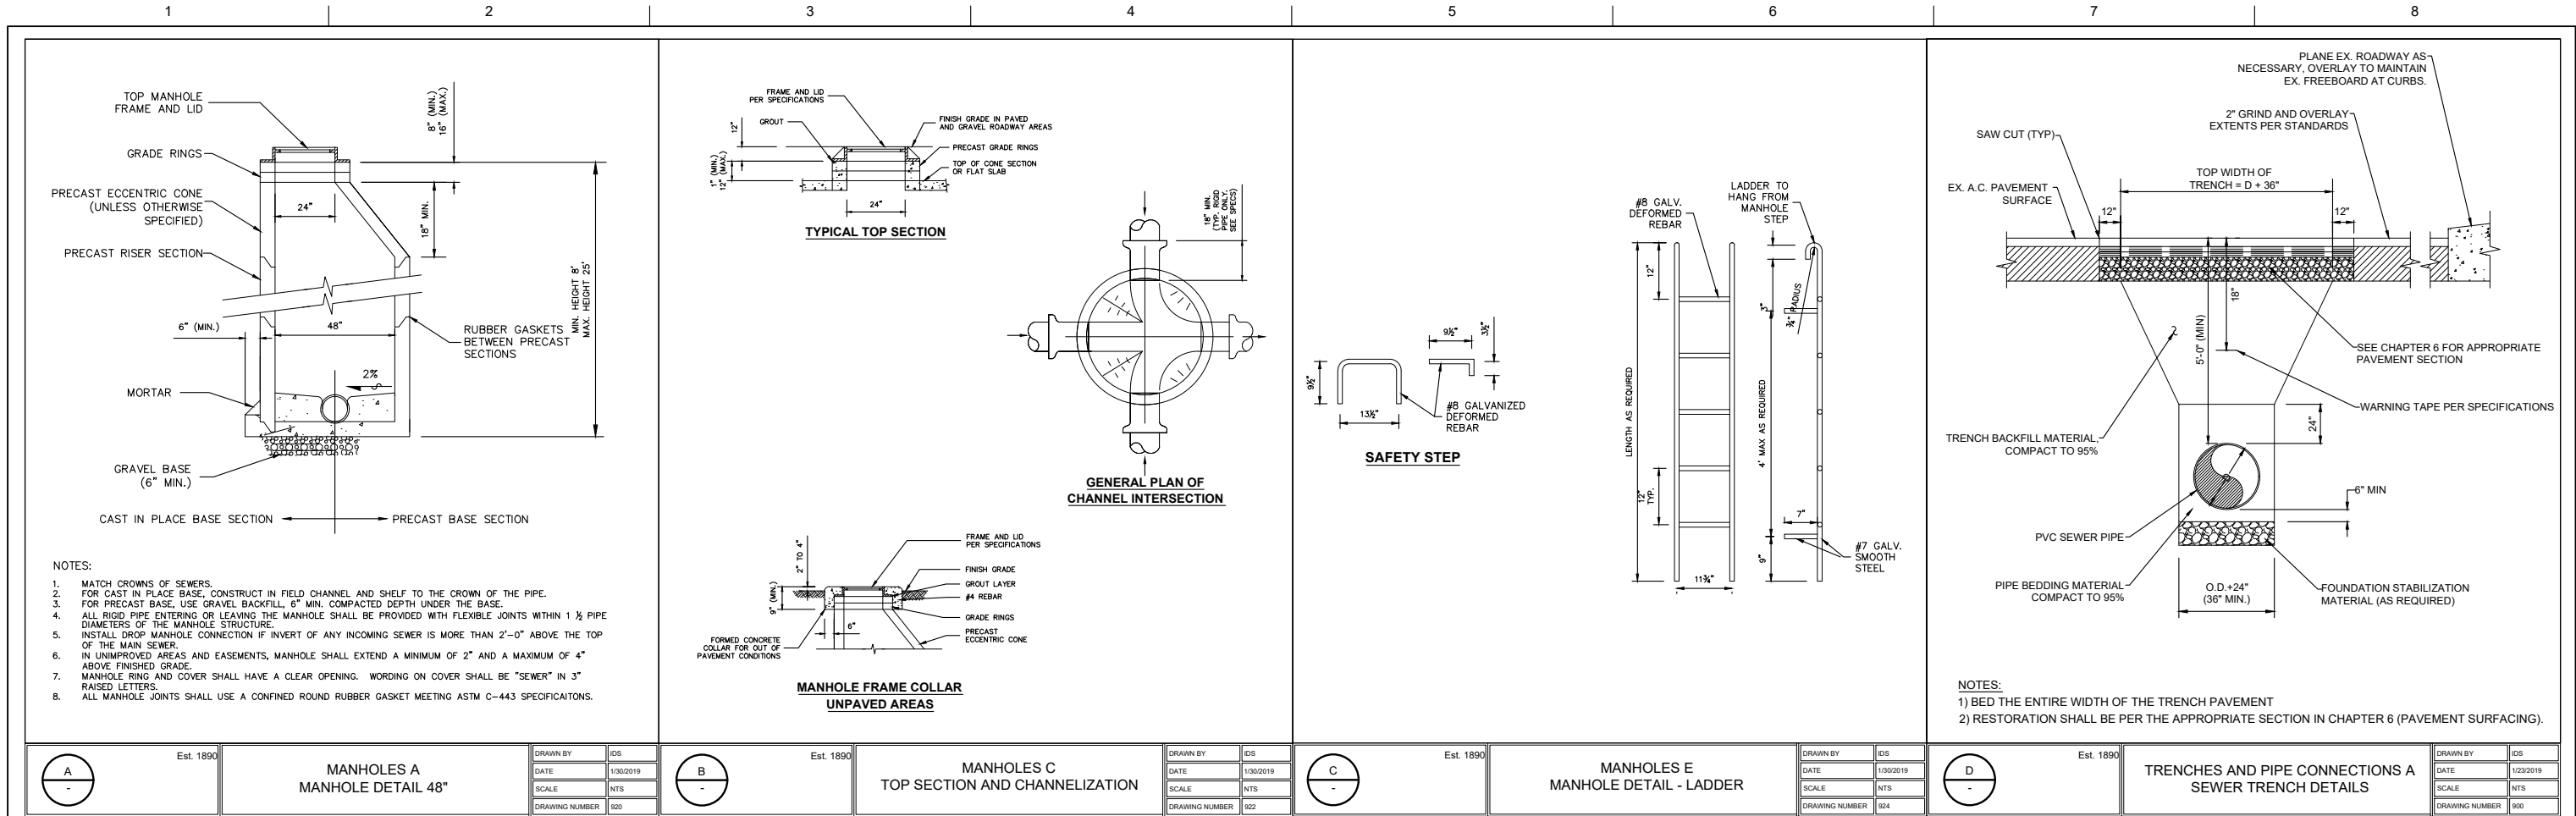


CALL 48 HOURS
BEFORE YOU DIG
1-800-424-5555



7/2022 BID SET		
ISSUE	DATE	DESCRIPTION

PROJECT MANAGER		L. NOLAN
CIVIL ENG.	J. KNOLL	
WATER ENG.	L. CHENG	
STRUCTURAL ENG.	M. HIJAZI	
ELECTRICAL ENG.	I. RINCON	
INSTR. ENG.	M. HUTSON	
PROJECT NUMBER		10172116

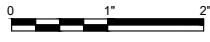

CIVIL DETAILS

FILENAME	C1-10.dwg
SCALE	AS NOTED


SHEET
C1-10

B:\M 360\10172116_McCormick_Booster_Pump_Station_2020\10172116-00-U.rvt
7/5/2022 10:52:15 AM




7/2022	BID SET	
ISSUE	DATE	DESCRIPTION

PROJECT MANAGER		LAURA NOLAN
CIVIL ENG	J. KNOLL	
WATER ENG	L. CHENG	
STRUCTURAL ENG	M. HIJAZI	
ELECTRICAL ENG	I. RINCON	
MECHANICAL ENG	K. SUTTON	
INSTR. ENG	M. HUTSON	
PROJECT NUMBER		10172116

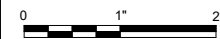

FILENAME 10172116-00-U.RVT
SCALE 3/8" = 1'-0"

SHEET
D50-01

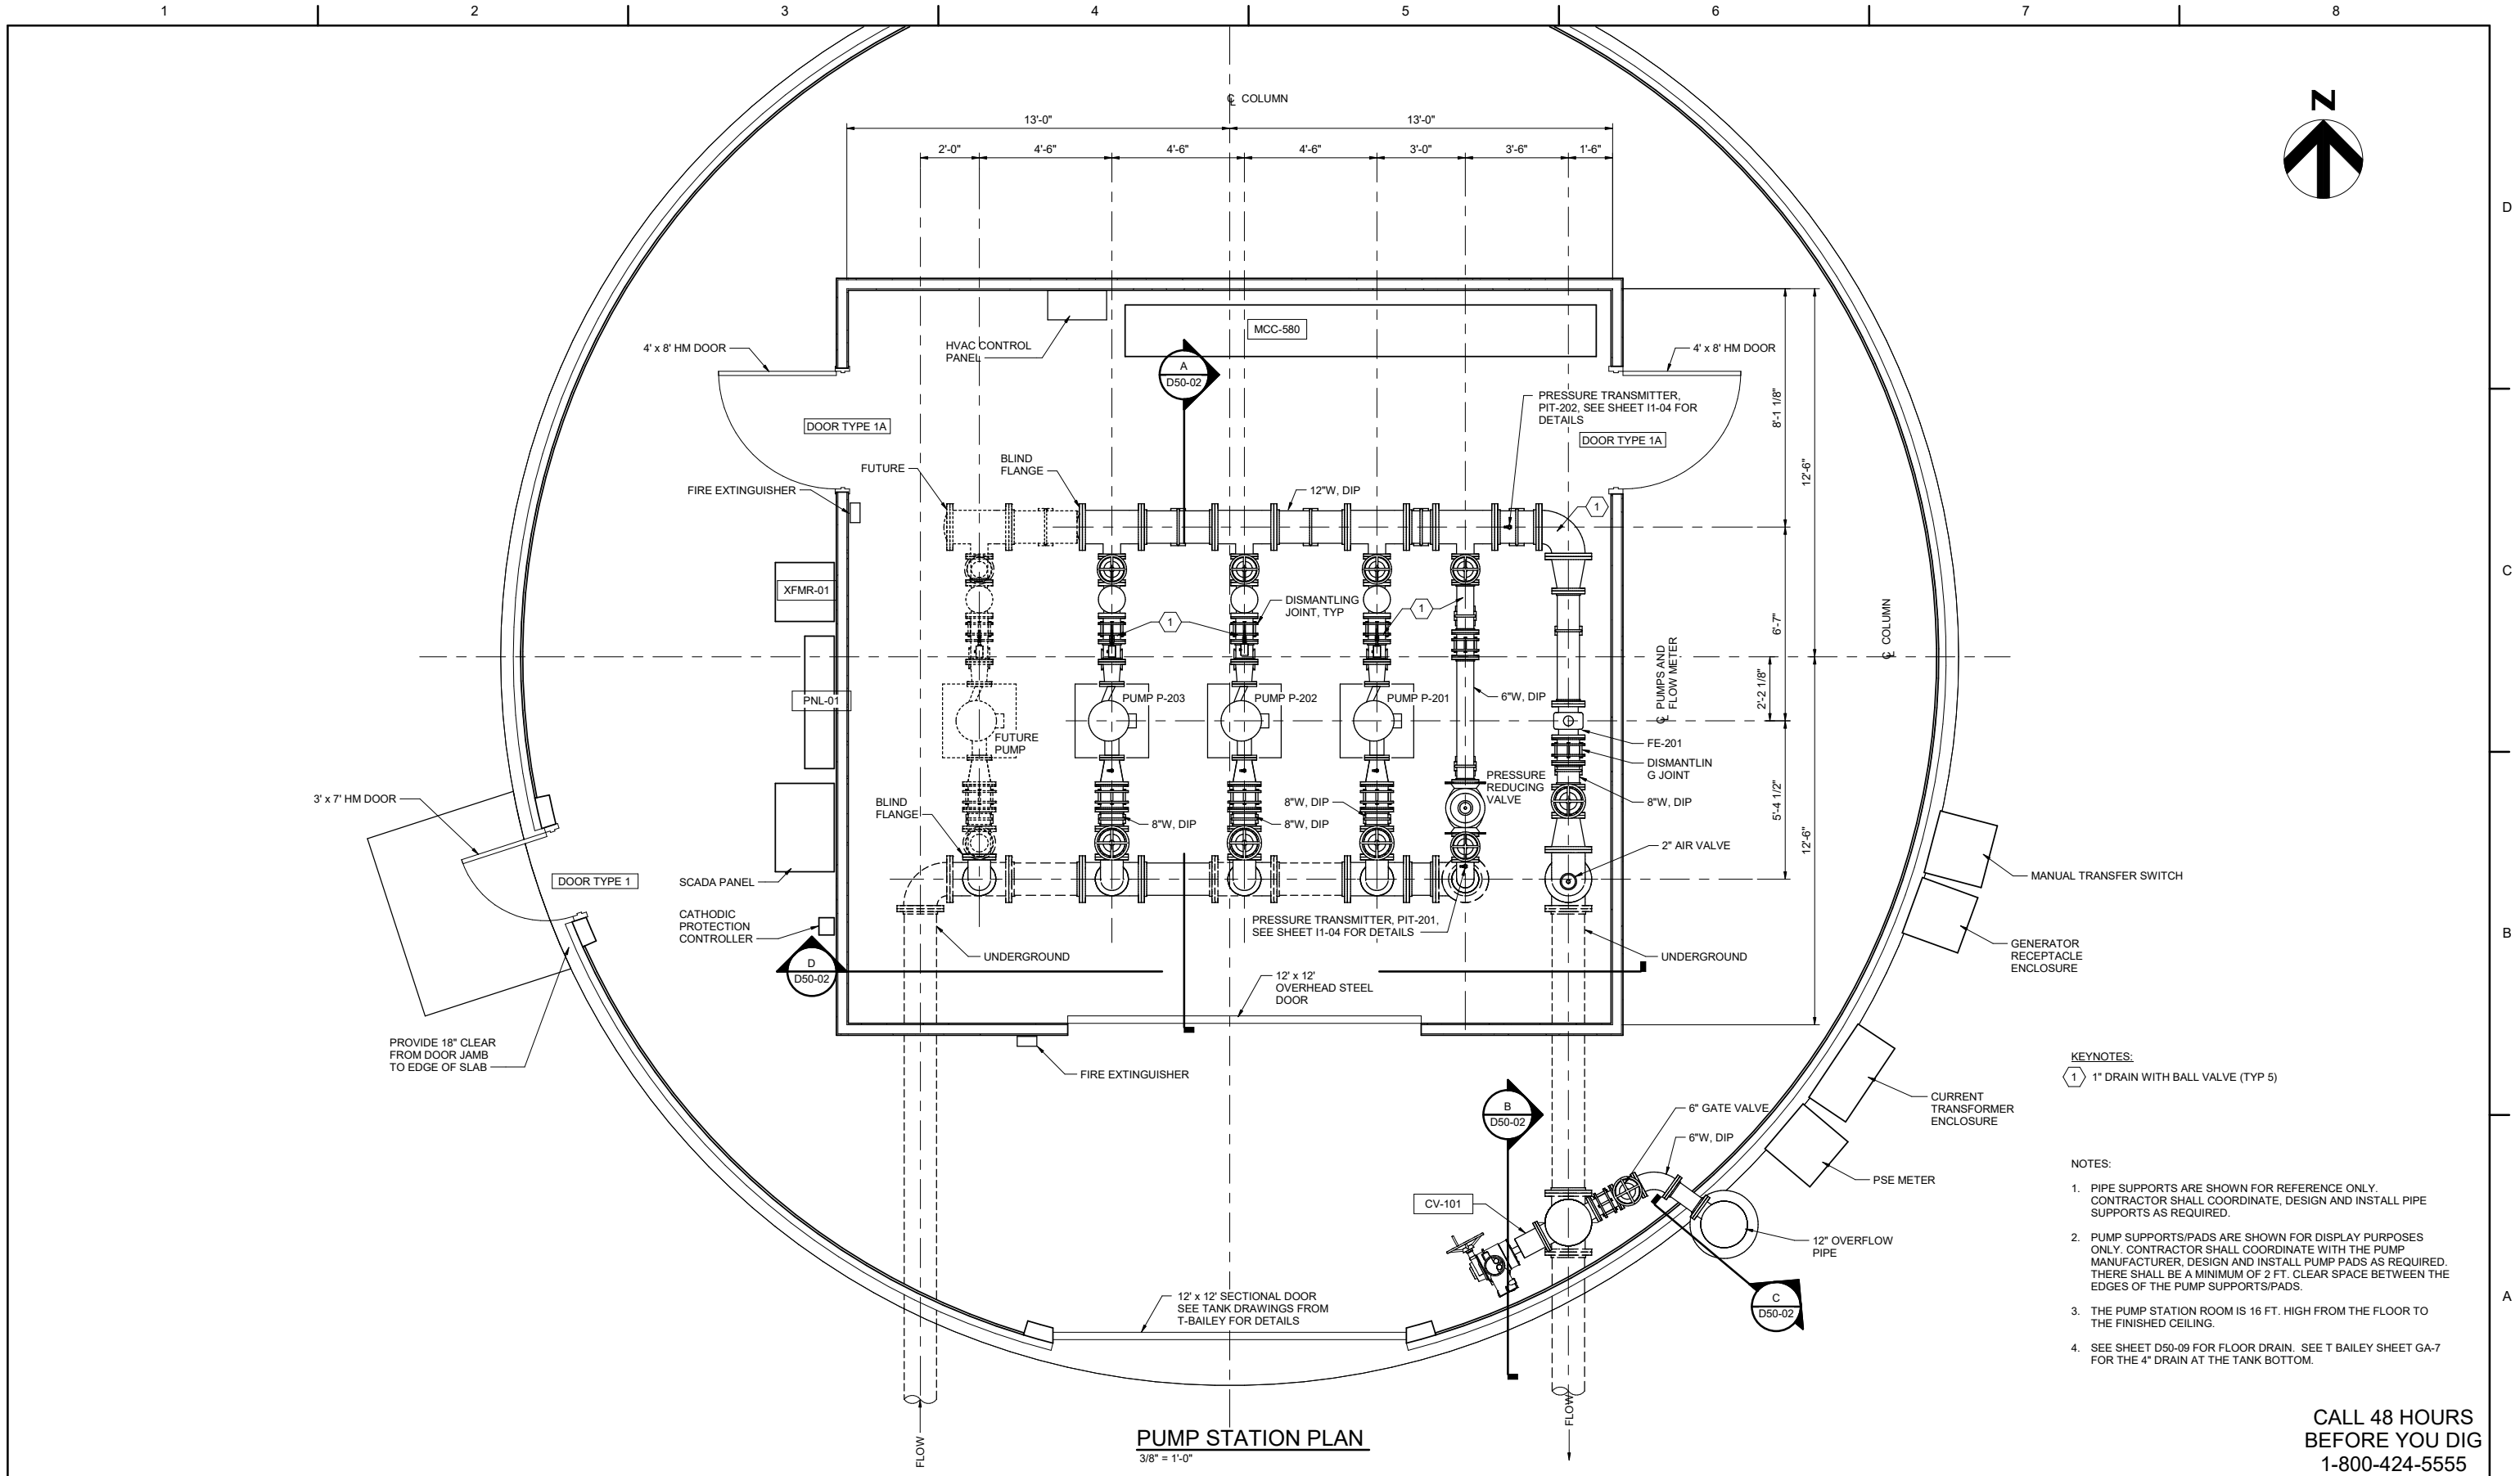

KEYNOTES:
1 1" DRAIN WITH BALL VALVE (TYP 5)



- NOTES:
- PIPE SUPPORTS ARE SHOWN FOR REFERENCE ONLY. CONTRACTOR SHALL COORDINATE, DESIGN AND INSTALL PIPE SUPPORTS AS REQUIRED.
 - PUMP SUPPORTS/PADS ARE SHOWN FOR DISPLAY PURPOSES ONLY. CONTRACTOR SHALL COORDINATE WITH THE PUMP MANUFACTURER, DESIGN AND INSTALL PUMP PADS AS REQUIRED. THERE SHALL BE A MINIMUM OF 2 FT. CLEAR SPACE BETWEEN THE EDGES OF THE PUMP SUPPORTS/PADS.
 - THE PUMP STATION ROOM IS 16 FT. HIGH FROM THE FLOOR TO THE FINISHED CEILING.
 - SEE SHEET D50-09 FOR FLOOR DRAIN. SEE T BAILEY SHEET GA-7 FOR THE 4" DRAIN AT THE TANK BOTTOM.

CALL 48 HOURS
BEFORE YOU DIG
1-800-424-5555


1. OWNER TO PROVIDE THE DECHLORINATION TABLETS.

2. DOSA TO BE ABRASIVE BLASTED, INTERIOR TO BE COATED WITH TWO COATS MACROPOXY 646, EXTERIOR TO BE PRIMED WITH ONE COAT MACROPOXY 646 (3-5 MILS DFT EACH COAT) BY TIDEFLEX. TOP COAT IS APPLIED IN FIELD.

2. DOSA TO BE ABRASIVE BLASTED, INTERIOR TO BE COATED WITH TWO COATS MACROPOXY 646, EXTERIOR TO BE PRIMED WITH ONE COAT MACROPOXY 646 (3-5 MILS DFT EACH COAT) BY TIDEFLEX. TOP COAT IS APPLIED IN FIELD.

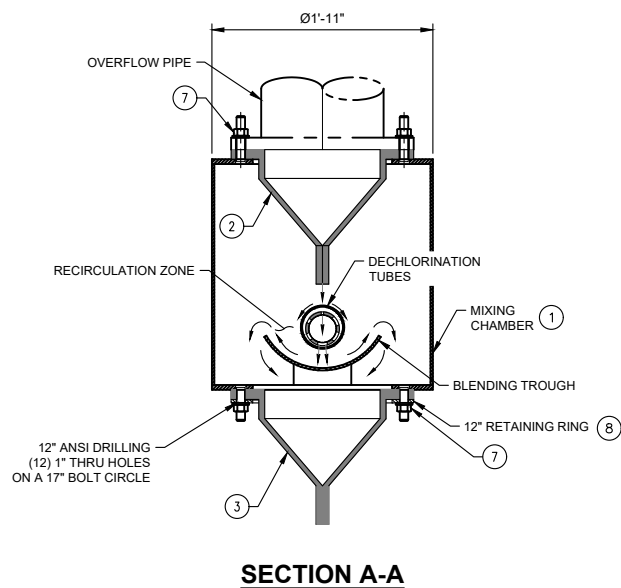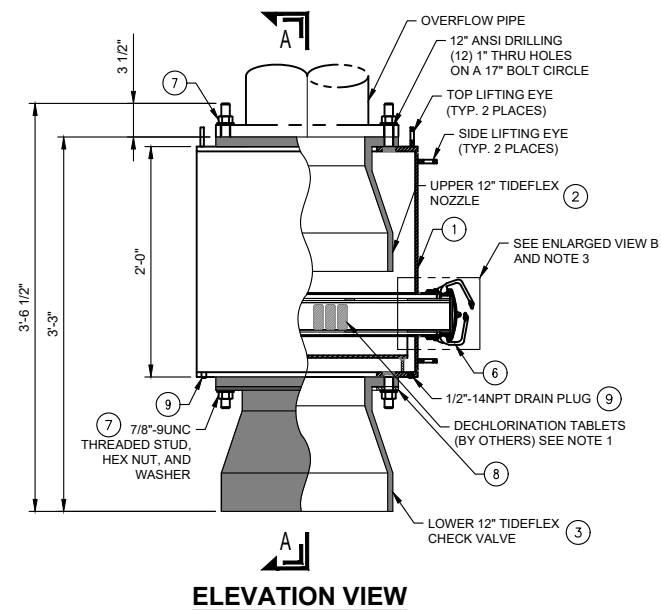

ITEM	QTY.	DESCRIPTION
1	1	MIXING CHAMBER
2	1	UPPER 12" TIDFLEX NOZZLE
3	1	LOWER 12" TIDFLEX CHECK VALVE
4	1	PVC ROTATABLE INNER TUBE
5	1	3/4" S/STEEL PERFORATED TABLET TUBE
6	1	ALUMINUM 4" CAMLOCK ADAPTER
7	24	7/8"-9UNC HEX NUT AND WASHER
8	1	RETAINING RING
9	2	1/2"-14NPT DRAIN PLUG

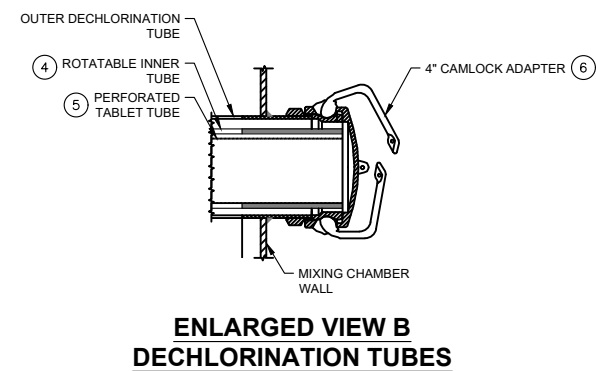

**CALL 48 HOURS
BEFORE YOU DIG
1-800-424-5555**



			PROJECT MANAGER		L. NOLAN
			CIVIL ENG		J. KNOLL
			WATER ENG		L. CHENG
			STRUCTURAL ENG		M. HUAZI
			ELECTRICAL ENG		I. RINCON
			INSTR. ENG		M. HUTSON
7/2022			BID SET		
ISSUE	DATE	DESCRIPTION	PROJECT NUMBER		10172116



DECHLORINATING OVERFLOW SECURITY ASSEMBLY







FILENAME	D50-03.dwg
SCALE	NTS

SCALE | NTS

SHEET

D50-03

UNITED STATES PATENT NUMBER: 7,104,279 | CANADIAN PATENT NUMBER: 2,409,009

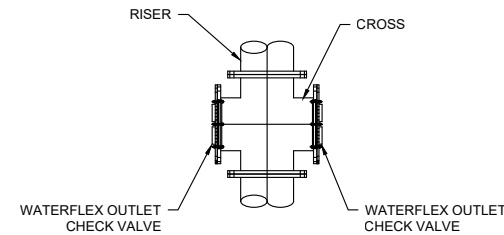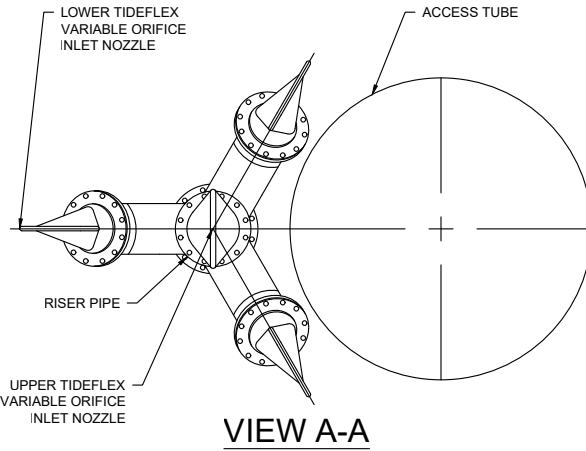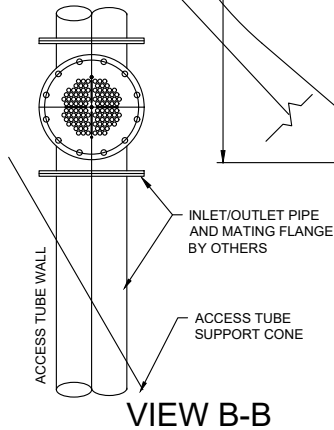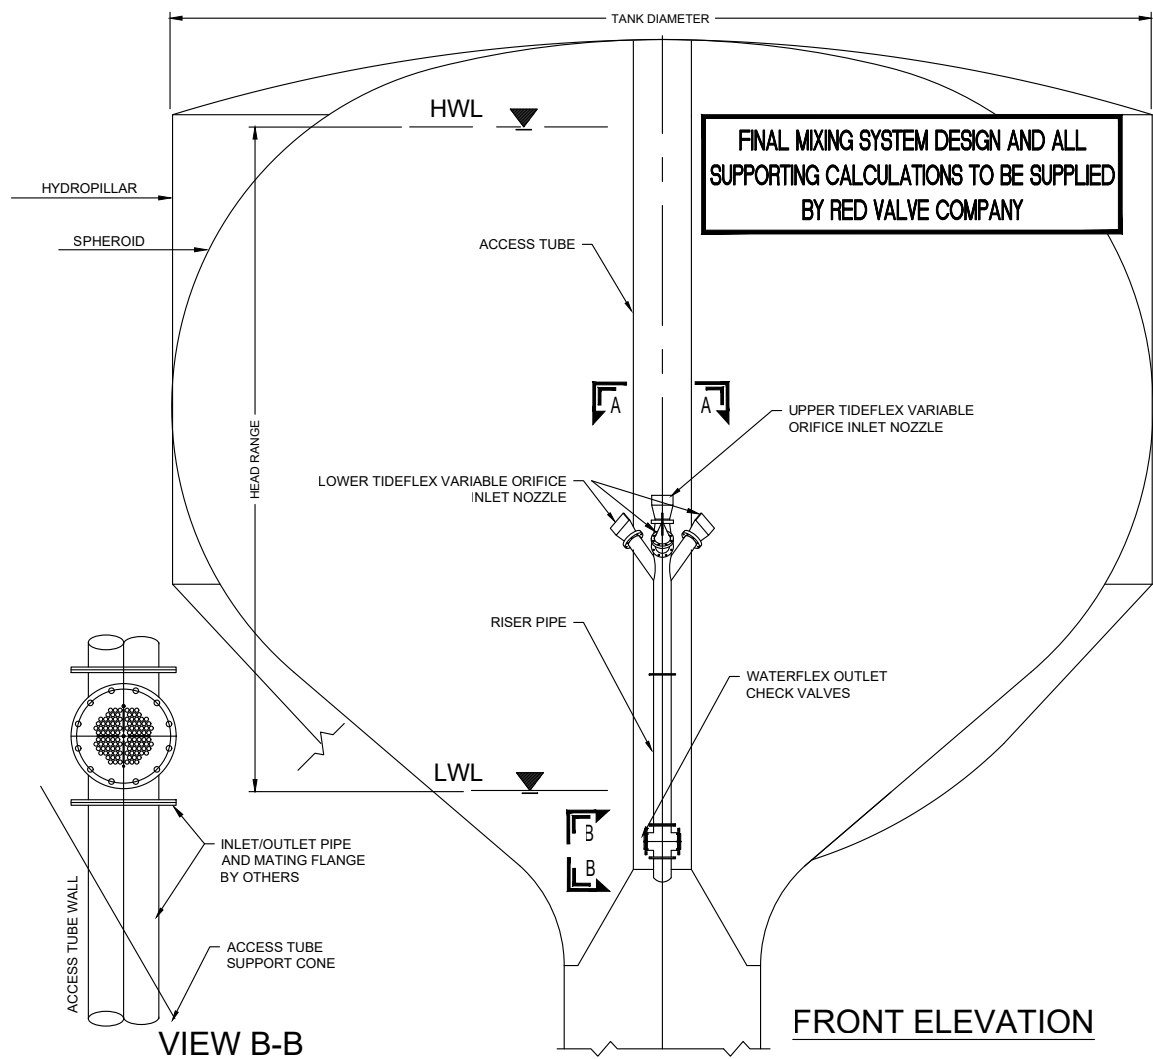

OUTLET CHECK VALVES

- NOTES:
- DO NOT USE THIS DRAWING FOR CONSTRUCTION. DRAWING INTENDED AS A GENERAL REPRESENTATION ONLY.
 - QUANTITY, SIZE, ELEVATIONS, LOCATIONS, AND DISCHARGE ANGLES OF TIDEFLEX INLET NOZZLES AND OUTLET CHECK VALVES ARE TANK-SPECIFIC BASED ON HYDRAULICS, MIXING AND TURNOVER CRITERIA.
 - CARBON AND STAINLESS PIPE SECTIONS MAY BE SUPPLIED WITH PLAIN ENDS TO BE BUTT WELDED IN THE FIELD.
 - THE MIXING SYSTEM MANUFACTURE SHALL COORDINATE WITH THE TANK MANUFACTURE SO THAT THE TIDEFLEX NOZZLES ARE NOT IN CONFLICT WITH THE OVERFLOW PIPE PHYSICALLY AND HYDRAULICALLY AND SHALL TAKE SOLE RESPONSIBILITY FOR THE HYDRAULIC PERFORMANCE OF THE MIXING SYSTEM.

TIDEFLEX MIXING SYSTEM GENERAL ARRANGEMENT

SCALE: 1" = 1'-0"



Tideflex
Technologies

A Division of Red Valve Company, Inc.

TIDEFLEX TECHNOLOGIES
TIDEFLEX MIXING SYSTEM

700 N. BELL AVENUE
CARNEGIE, PA 15106 USA
PHONE: 412-279-0044
FAX: 412-279-5410

WEBSITE: WWW.TIDEFLEX.COM
EMAIL: INFO@TIDEFLEX.COM

CALL 48 HOURS
BEFORE YOU DIG
1-800-424-5555




ISSUE	DATE	DESCRIPTION
7/2022	BID SET	

PROJECT MANAGER	
CIVIL ENG	J. KNOLL
WATER ENG	L. CHENG
STRUCTURAL ENG	M. HIJAZI
ELECTRICAL ENG	I. RINCON
INSTR. ENG	M. HUTSON
PROJECT NUMBER	
10172116	



M
MCCORMICK
CLOSE TO WHAT COUNTS
PORT ORCHARD 660 RESERVOIR

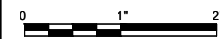


FILENAME | D50-04.dwg
SCALE | NTS

SHEET
D50-04

RESERVOIR MIXING SYSTEM DETAILS

C:\pwworking\west01\02192871\050-06.dwg, LAYOUT, 3/31/2022 1:53:18 PM, EPILAPIL

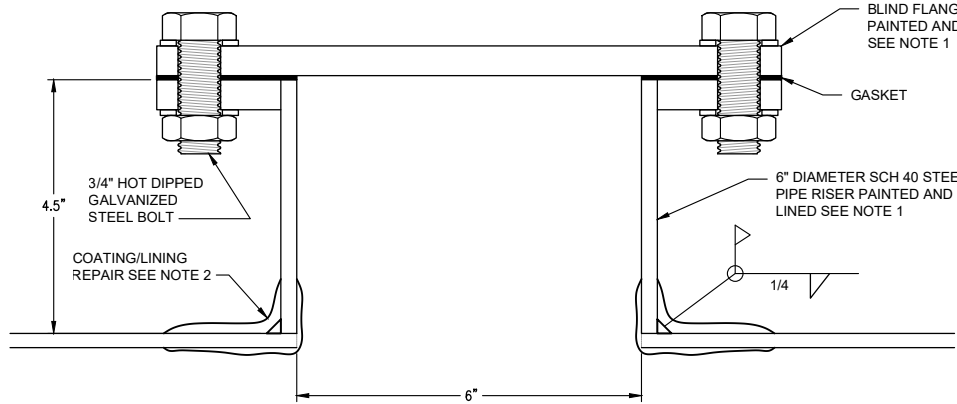


CP TEST POINT RAISED HAND HOLE

SCALE: NONE

NOTES:

1. BLIND FLANGE AND PIPE RISER SHALL BE SHOP COATED AND LINED WITH SAME COATING AS REST OF TANK.
2. REPAIR COATING AND LINING AFTER WELD TO A DISTANCE 4" BEYOND BURN ZONE.
A. COATING SHALL BE SAME COATING AS REST OF TANK.
3. DO NOT COAT BLIND FLANGE NUTS/BOLTS.

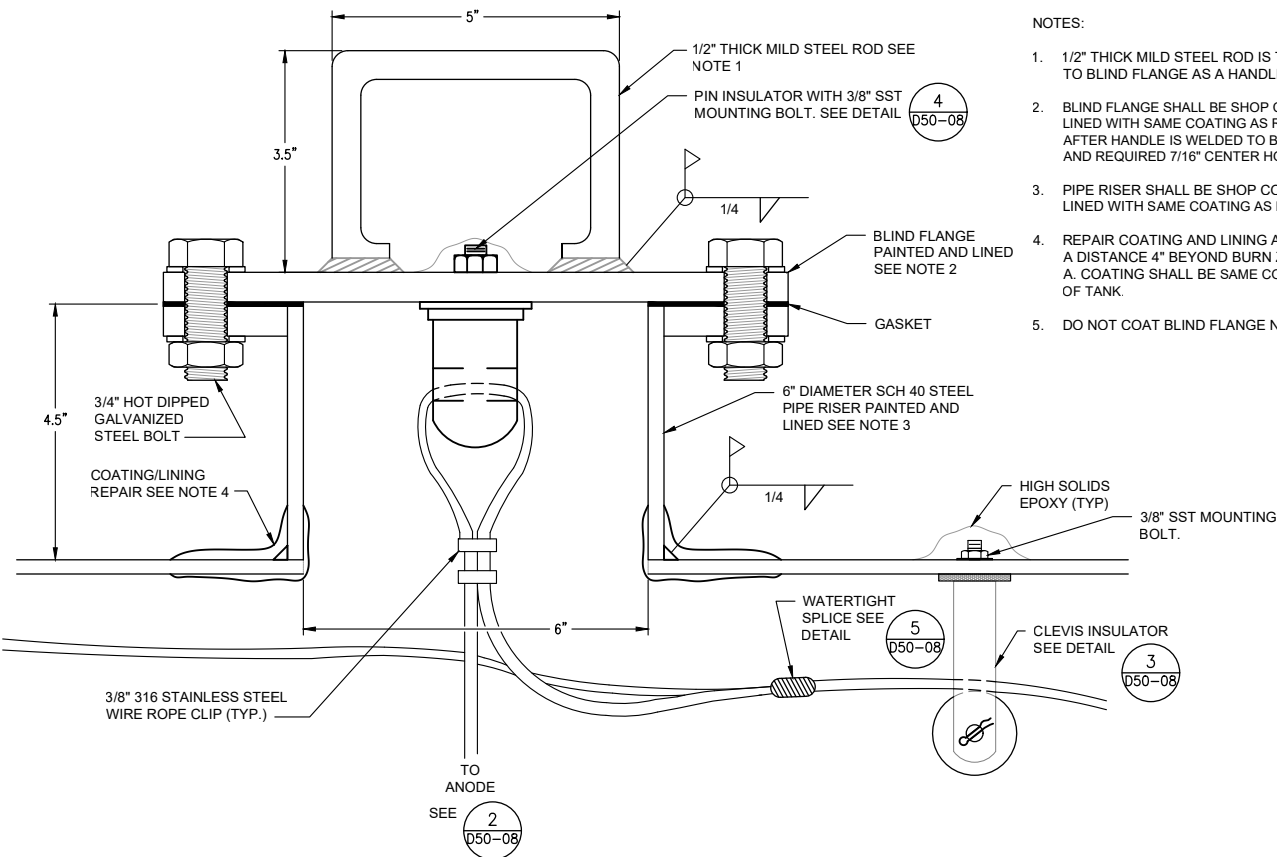


ANODE RAISED HAND HOLE WITH HANDLE

SCALE: NONE

NOTES:

1. 1/2" THICK MILD STEEL ROD IS TO BE WELDED TO BLIND FLANGE AS A HANDLE.
2. BLIND FLANGE SHALL BE SHOP COATED AND LINED WITH SAME COATING AS REST OF TANK, AFTER HANDLE IS WELDED TO BLIND FLANGE AND REQUIRED 7/16" CENTER HOLE IS DRILLED.
3. PIPE RISER SHALL BE SHOP COATED AND LINED WITH SAME COATING AS REST OF TANK.
4. REPAIR COATING AND LINING AFTER WELD TO A DISTANCE 4" BEYOND BURN ZONE.
A. COATING SHALL BE SAME COATING AS REST OF TANK.
5. DO NOT COAT BLIND FLANGE NUTS/BOLTS.

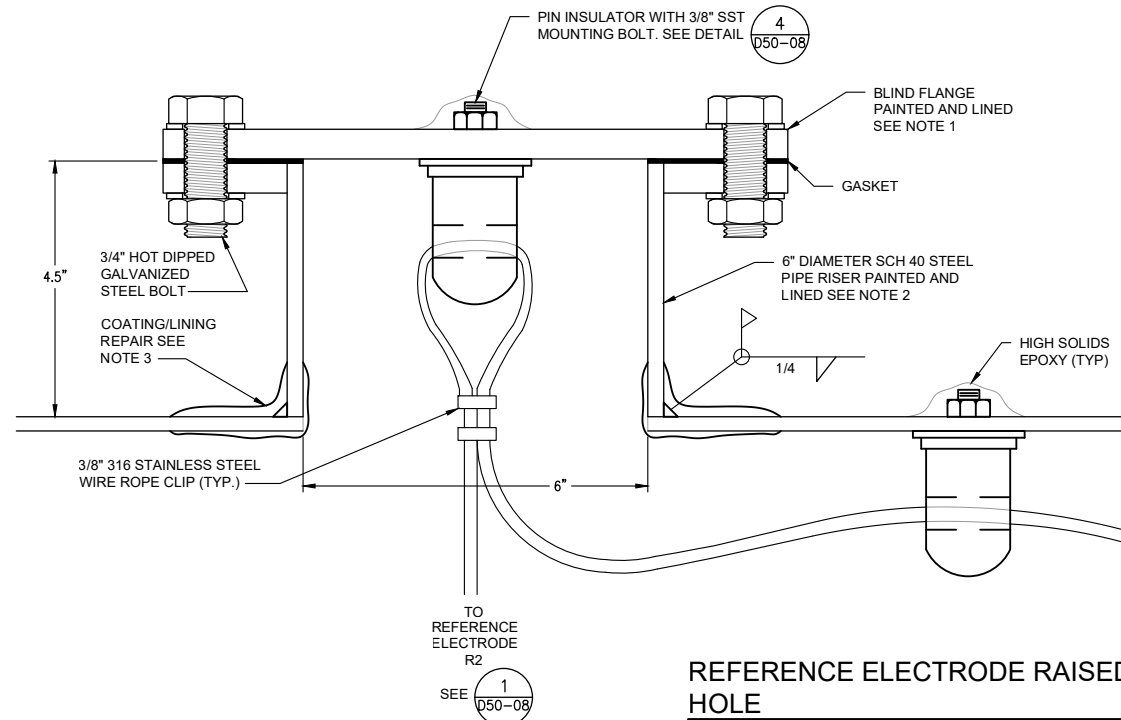


REFERENCE ELECTRODE RAISED HAND HOLE

SCALE: NONE

NOTES:

1. BLIND FLANGE SHALL BE 7/16" PRE-DRILLED ON CENTER, SHOP COATED AND LINED WITH SAME COATING AS REST OF TANK.
2. PIPE RISER SHALL BE SHOP COATED AND LINED WITH SAME COATING AS REST OF TANK.
3. REPAIR COATING AND LINING AFTER WELD TO A DISTANCE 4" BEYOND BURN ZONE.
A. COATING SHALL BE SAME COATING AS REST OF TANK.
4. DO NOT COAT BLIND FLANGE NUTS/BOLTS.

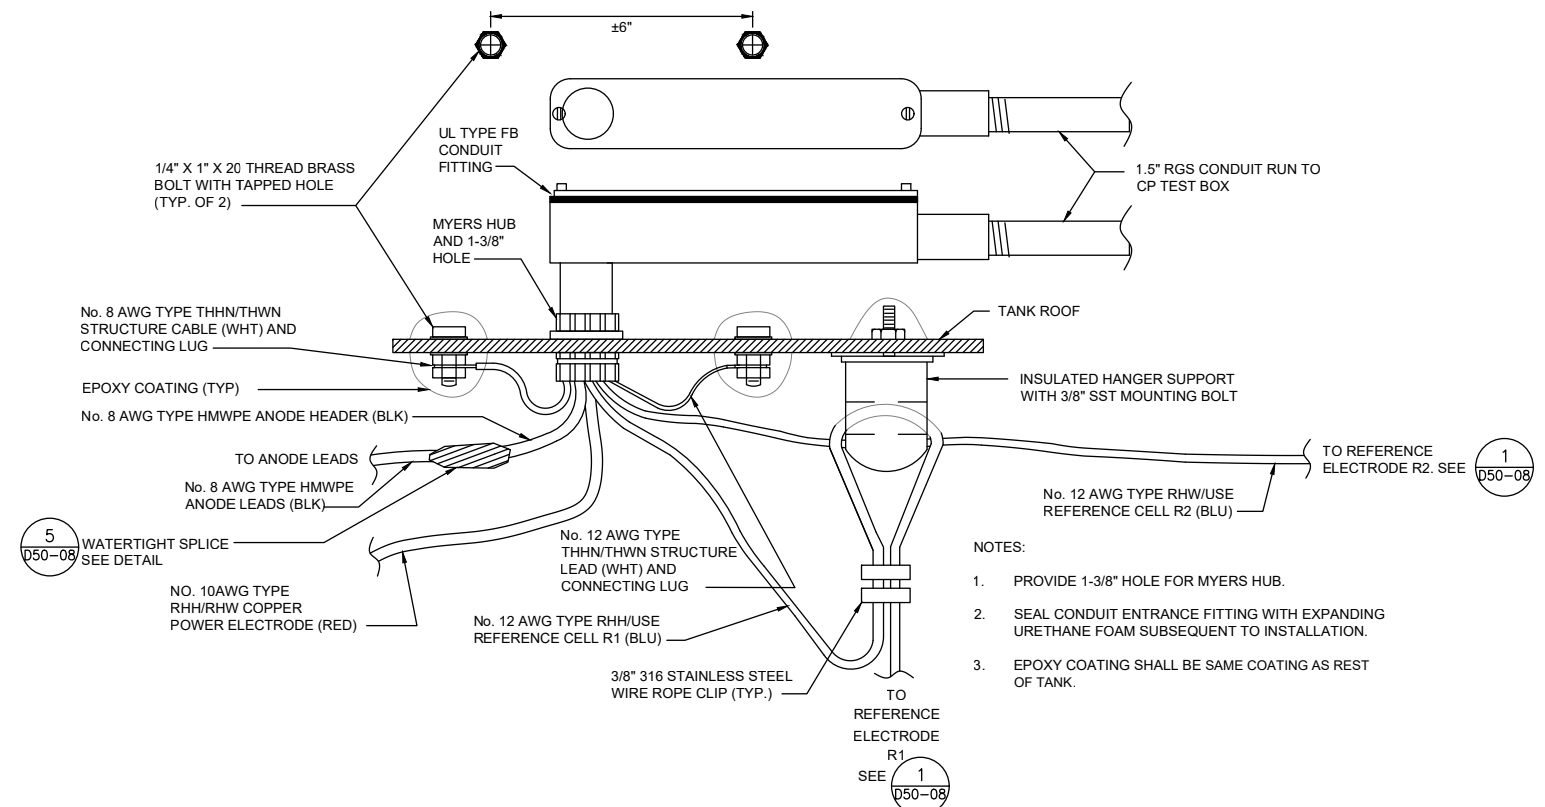

WIRE AND CONDUIT PENETRATION ASSEMBLY

SCALE: NONE

NOTES:

1. PROVIDE 1-3/8" HOLE FOR MYERS HUB.
2. SEAL CONDUIT ENTRANCE FITTING WITH EXPANDING URETHANE FOAM SUBSEQUENT TO INSTALLATION.
3. EPOXY COATING SHALL BE SAME COATING AS REST OF TANK.




ISSUE	DATE	DESCRIPTION
7/2022	BID SET	

PROJECT MANAGER	L. NOLAN
CIVIL ENG	J. KNOLL
WATER ENG	L. CHENG
STRUCTURAL ENG	M. HIJAZI
ELECTRICAL ENG	I. RINCON
DRAWN BY	E. PILAPIL
PROJECT NUMBER	10172116



CATHODIC PROTECTION DETAILS 1

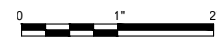


FILENAME | D50-06.dwg
SCALE | AS NOTED

SHEET
D50-06

CALL 48 HOURS
BEFORE YOU DIG
1-800-424-5555

C:\pwworking\west01\d2192871D50-07.dwg, LAYOUT, 3/31/2022 1:54:26 PM, EPIPIL

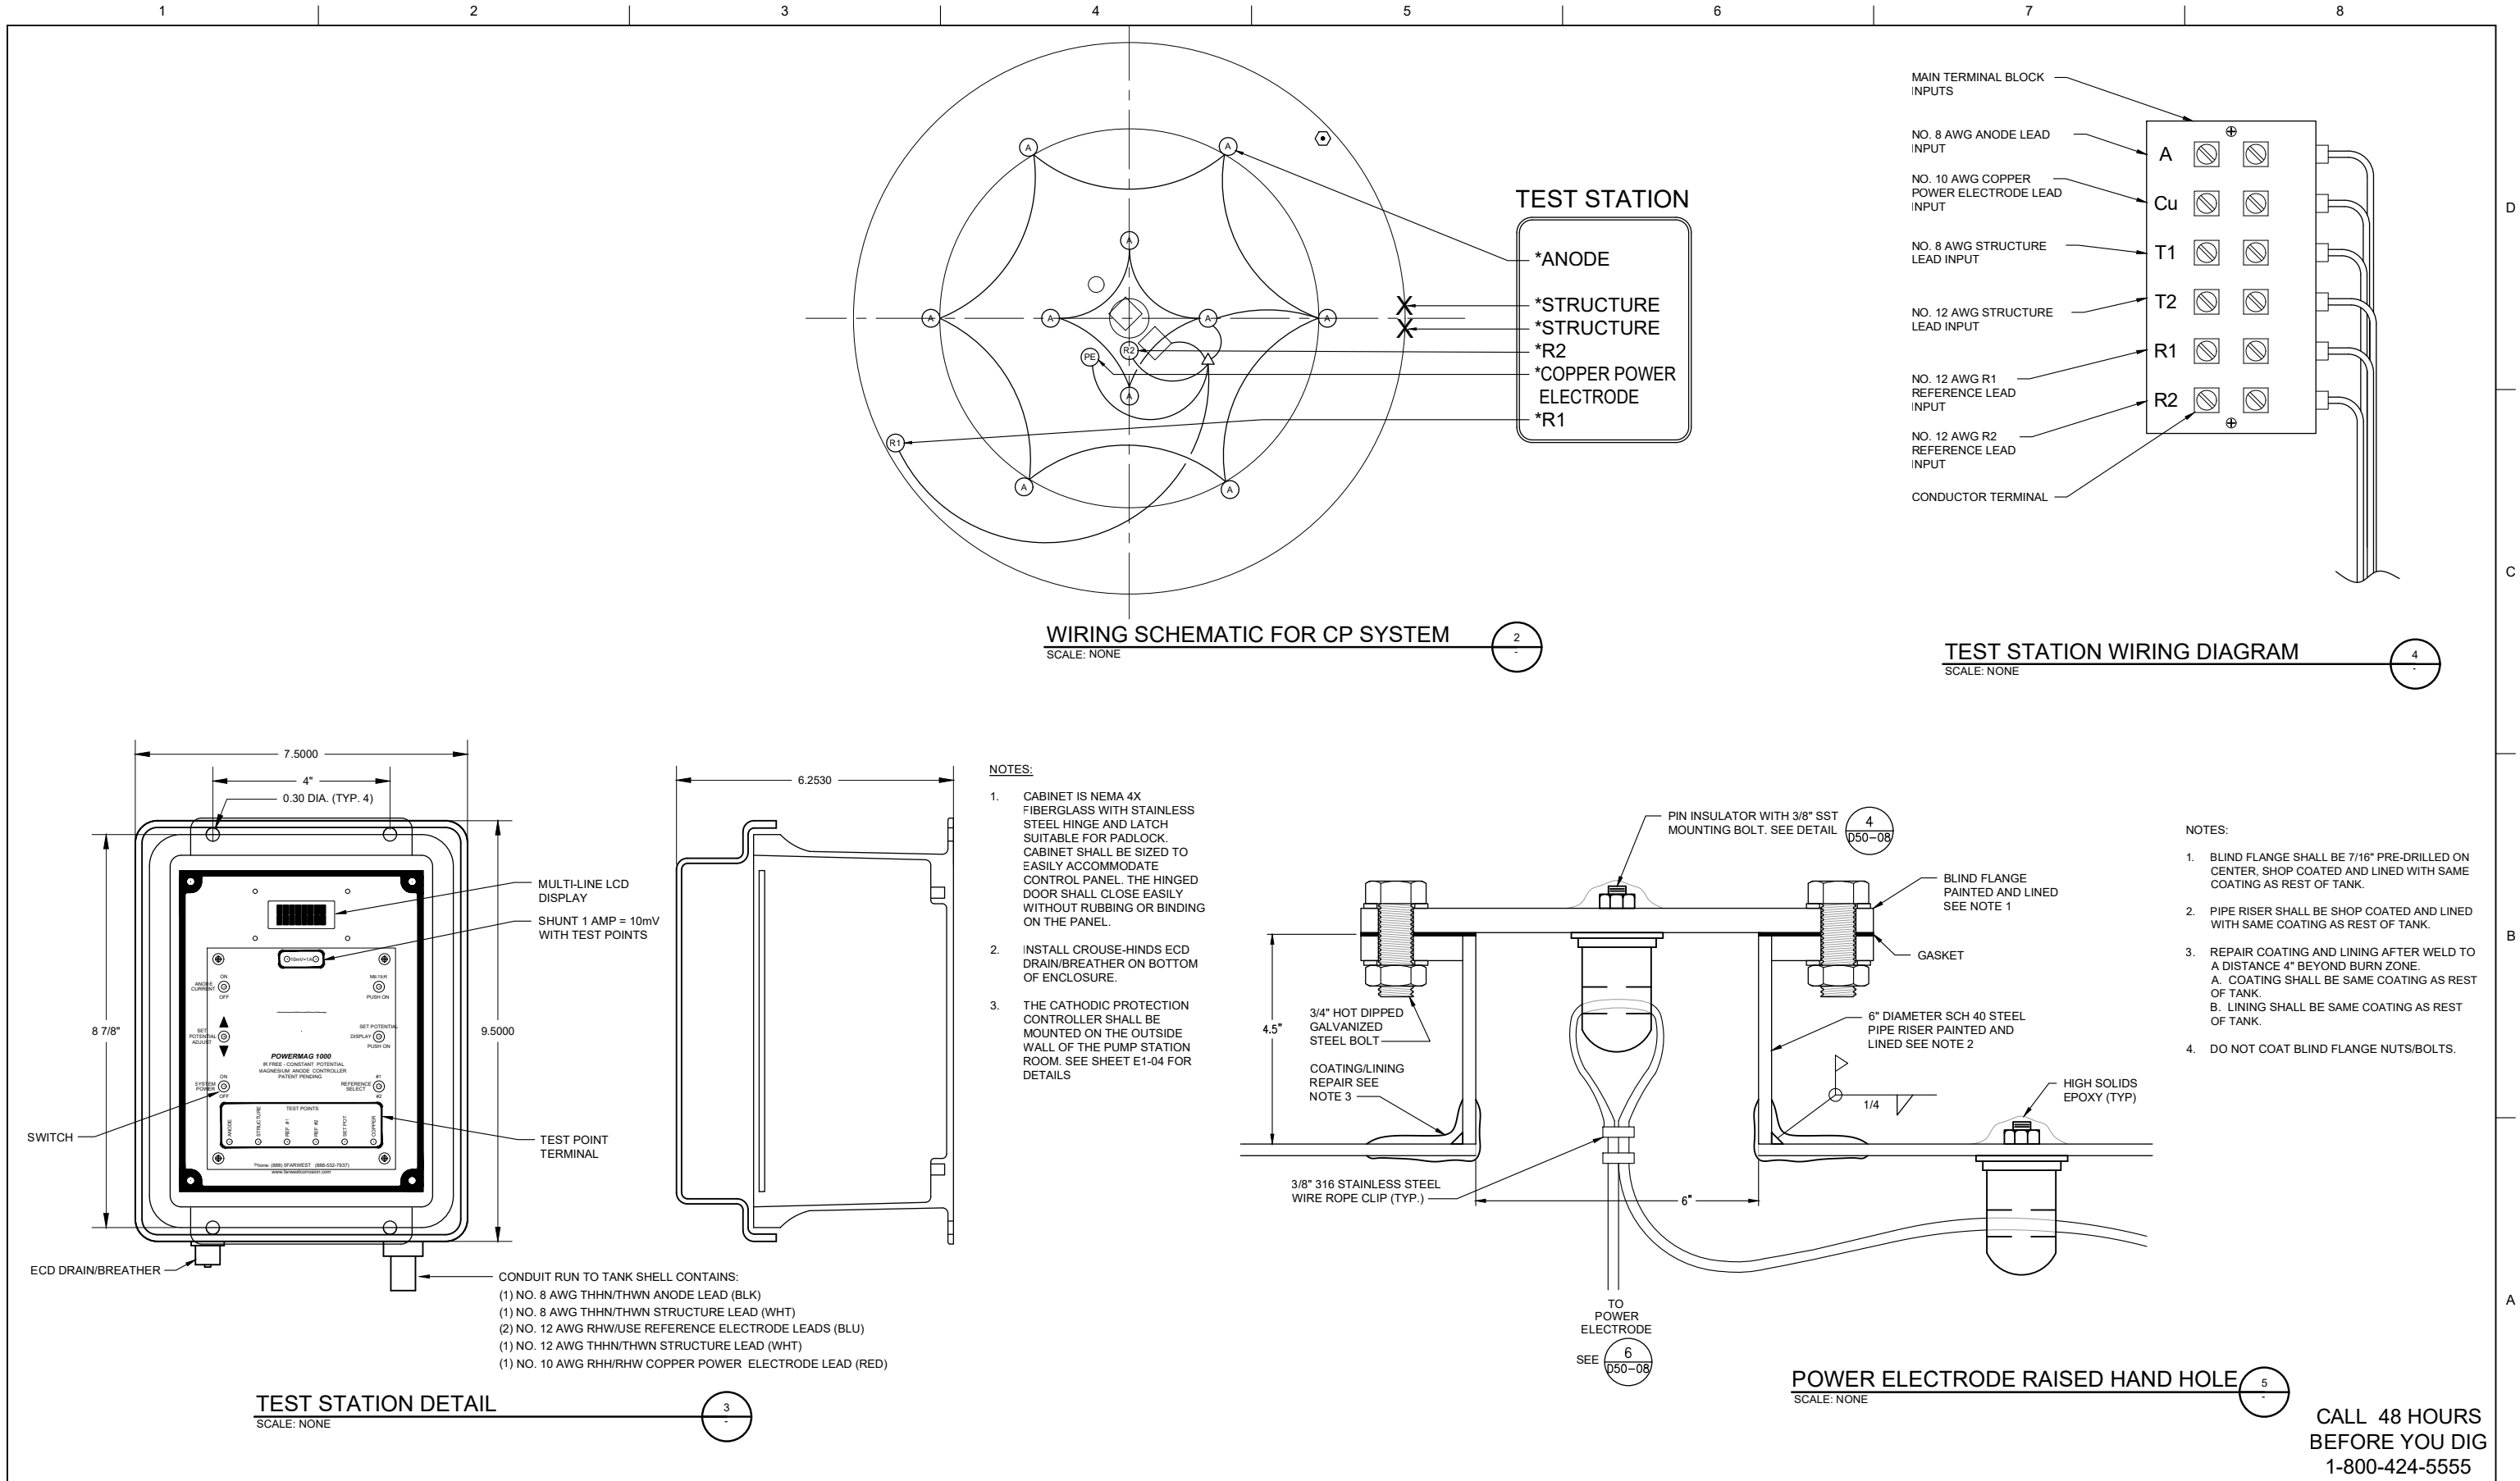


CALL 48 HOURS
BEFORE YOU DIG
1-800-424-5555



PROJECT MANAGER	L. NOLAN
CIVIL ENG	J. KNOLL
WATER ENG	L. CHENG
STRUCTURAL ENG	M. HIJAZI
ELECTRICAL ENG	I. RINCON
DRAWN BY	E. PILAPIL
PROJECT NUMBER	10172116




CATHODIC PROTECTION
DETAILS 2

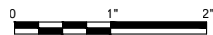

FILENAME | D50-07.dwg
SCALE | AS NOTED

SHEET
D50-07

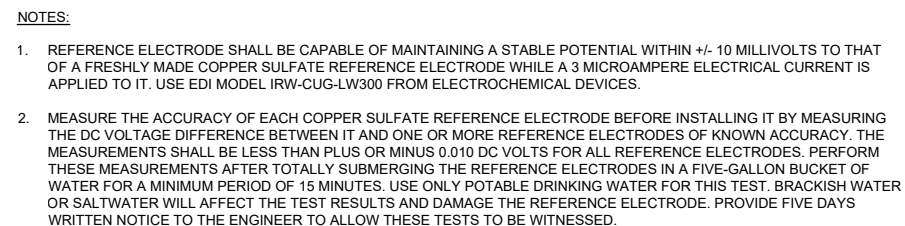

SCALE: NONE



ALLOY COMPOSITION	
ELEMENT	CONTENT %
AL	0.010% MAX.
Mn	0.5 - 1.3%
Si	0.5% MAX.
Cu	0.02% MAX.
Ni	0.001% MAX.
Fe	0.03 MAX.
Other	0.30 MAX.
Ma	REMAINDER



1. MAKE SPLICE WATERPROOF
 - A. SMOOTH ALL IRREGULAR SURFACES WITH 3M SCOTCHFIL ELECTRICAL INSULATION PUTTY OR APPROVED EQUAL.
 - B. APPLY 2 LAYERS OF HALF LAPPED RUBBER SPLICING TAPE, SCOTCH LINERLESS RUBBER SPLICING TAPE 130C OR APPROVED EQUAL..
 - C. APPLY 2 LAYERS OF HALF LAPPED VINYL ELECTRICAL TAPE, SCOTCH SUPER 33+ OR APPROVED EQUAL.
2. NUMBER OF WIRES MAY VARY PER SPLICE


SCALE: NONE



CALL 48 HOURS
BEFORE YOU DIG
1-800-424-5555

[illegible]

PROJECT MANAGER	L. NOLAN
CIVIL ENG	J. KNOLL
WATER ENG	L. CHENG
STRUCTURAL ENG	M. HIJAZI
ELECTRICAL ENG	I. RINCON
DRAWN BY	E. PILAPIL
PROJECT NUMBER	10172116

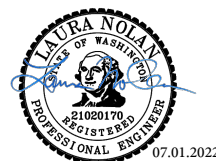

CATHODIC PROTECTION DETAILS 3



FILENAME	D50-08.dwg
SCALE	AS NOTED

SHEET

D50-08

B:\M 360\10172116_McCormick_Booster_Pump_Station_2020\10172116-00-U.rvt
7/7/2022 4:44:15 PM




7/8/2022 ISSUED FOR BID
ISSUE DATE DESCRIPTION

PROJECT MANAGER LAURA NOLAN


CIVIL ENG	J. KNOLL
WATER ENG	L. CHENG
STRUCTURAL ENG	M. HIJAZI
ELECTRICAL ENG	L. KIRMEYER
MECHANICAL ENG	K. SUTTON
INSTR. ENG	M. HUTSON

PROJECT NUMBER 10172116

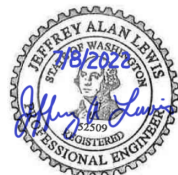

PORT ORCHARD 660 RESERVOIR

BOOSTER PUMP STATION
MECHANICAL LEGEND

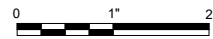

FILENAME 10172116-00-U.RVT
SCALE NONE

SHEET
M50-01

PIPING SYSTEMS		PIPING SYMBOLOGY		HVAC SYMBOLOGY		TEMPERATURE CONTROL DIAGRAM SYMBOLOGY		ABBREVIATIONS	
	COLD WATER, POTABLE (CW)		PIPE ANCHOR		SUPPLY AIR OR OUTSIDE AIR DUCT UP (SECTION CUT, FIRST DIMENSION DUCT WIDTH)		SUPPLY AIR REGISTER		MISCELLANEOUS DEVICE IDENTIFIER
	HOT WATER, POTABLE (HW)		PIPE GUIDE		SUPPLY AIR OR OUTSIDE AIR DUCT DOWN (NO SECTION CUT)		EXHAUST AIR OR RETURN AIR GRILLE		COIL IDENTIFIERS
	HOT WATER RECIRCULATING, POTABLE (HWC)		EXPANSION JOINT		RETURN AIR DUCT UP (SECTION CUT)		EXHAUST AIR OR RETURN AIR GRILLE		CONTROL DEVICE IDENTIFIER
	NON POTABLE COLD WATER		PRESSURE/TEMPERATURE PORT		RETURN AIR DUCT DOWN (NO SECTION CUT)		SUPPLY AIR ASSEMBLY SQUARE DIFFUSER		CONTROL ABBREVIATIONS
	HOT WATER - TEMPERATURE, POTABLE		THERMOMETER		EXHAUST AIR DUCT UP (NO SECTION CUT)		SUPPLY AIR ASSEMBLY ROUND DIFFUSER		
	TEPID WATER, POTABLE		THERMOWELL		EXHAUST AIR DUCT DOWN (NO SECTION CUT)				
	TEPID WATER RETURN, POTABLE		PRESSURE GAUGE		ROUND ELBOW UP				
	SANITARY SEWER BELOW GRADE		TEMPERATURE GAUGE		ROUND ELBOW DOWN				
	SANITARY SEWER ABOVE GRADE		FLEXIBLE PIPING CONNECTION		TRANSITION - RECTANGULAR TO ROUND DUCT				
	SANITARY VENT		WYE STRAINER		STANDARD BRANCH				
	ACID WASTE		MANUAL AIR VENT		ELBOW - W/TURNING VANE (RECTANGULAR)				
	ACID VENT		AUTOMATIC AIR VENT		ELBOW - (RECTANGULAR), SMOOTH RADIUS				
	COMBINATION WASTE AND VENT		METER (WATER, GAS, OTHER)		RECTANGULAR DUCT OR OPENING SIZE FIRST NUMBER INDICATES SIZE OF SIDE SHOWN				
	PRESSURE DRAINAGE		FLOOR CLEANOUT		ROUND DUCT SIZE				
	STORM DRAIN ABOVE GRADE		WALL CLEANOUT		RECTANGULAR DUCT INCLINE - RISE OR DROP IN RESPECT TO THE AIR FLOW				
	STORM DRAIN BELOW GRADE		DOUBLE GRADE CLEANOUT		ROUND DUCT INCLINE - RISE OR DROP IN RESPECT TO THE AIR FLOW				
	STORM DRAIN OVERFLOW		WATER HAMMER ARRESTOR		HIDDEN DUCT				
	NATURAL GAS		EARTHQUAKE VALVE		DUCT/PIPE ELEVATION TAG ABOVE FINISH FLOOR				
	LIQUEFIED PROPANE		CONCENTRIC REDUCER		VOLUME DAMPER				
	COMPRESSED AIR		ECCENTRIC REDUCER, FLAT ON BOTTOM						
	HEATING HOT WATER SUPPLY		ECCENTRIC REDUCER, FLAT ON TOP						
	HEATING HOT WATER RETURN		ELBOW, 90° TURN DOWN						
	GLYCOL HEATING HOT WATER SUPPLY		ELBOW, 90° TURN UP						
	GLYCOL HEATING HOT WATER RETURN		TEE, OUTLET UP						
	CHILLED WATER SUPPLY		TEE, OUTLET DOWN						
	CHILLED WATER RETURN		TEE, OUTLET UP W/ 90° TURN						
	GLYCOL CHILLED WATER SUPPLY		TEE, OUTLET DOWN W/ 90° TURN						
	GLYCOL CHILLED WATER RETURN		PIPE BREAK						
	CONDENSER WATER SUPPLY		PIPE CAP						
	CONDENSER WATER RETURN		BLIND FLANGE						
	REFRIGERANT LIQUID		UNION						
	REFRIGERANT SUCTION		FLOW ARROW						
	CONDENSATE DRAIN		SHUTOFF VALVE (NORMALLY OPEN)						
	CONDENSATE PUMP DISCHARGE		SHUTOFF VALVE (NORMALLY CLOSED)						
	STEAM SUPPLY - PSI		DRAIN VALVE						
	BOILER BLOW DOWN		CHECK VALVE						
	BOILER FEED		VACUUM BREAKER						
	STEAM VENT		AUTOMATIC FLOW CONTROL VALVE						
	MAKE-UP WATER		CALIBRATED MANUAL BALANCING VALVE						
			PRESSURE-RELIEF VALVE						
			PRESSURE-REDUCING VALVE (PRV)						
			AUTOMATIC CONTROL VALVE, 2-WAY						
			AUTOMATIC CONTROL VALVE, 3-WAY						
			BACKFLOW PREVENTER						
			PLUMBING FIXTURE						

GENERAL MECHANICAL NOTES

- THESE NOTES ARE NOT ALL INCLUSIVE. REFER TO DRAWINGS AND SPECIFICATION FOR ADDITIONAL REQUIREMENTS.
- THIS IS A STANDARD MECHANICAL (HVAC AND PLUMBING) SYMBOLOGY AND ABBREVIATIONS SHEET. LISTING OF SYMBOLS AND ABBREVIATIONS DOES NOT IMPLY ALL SYMBOLS AND ABBREVIATIONS HAVE BEEN USED ON THIS PROJECT.
- VALVE SYMBOLS SHOWN HERE ARE APPLICABLE ONLY TO MECHANICAL SHEETS.
- PROVIDE ALL MATERIALS, LABOR, AND EQUIPMENT FOR COMPLETE AND OPERABLE SYSTEMS AS INDICATED ON THE DRAWINGS AS SPECIFIED, OR AS REQUIRED BY CODE.
- MECHANICAL INSTALLATION SHALL COMPLY WITH THE ADA/ABA ACCESSIBILITY GUIDELINES.
- DETAILS APPLY TO THE ENTIRE PROJECT AND ARE ONLY REFERENCED TO PROVIDE CLARITY IF THERE ARE MULTIPLE DETAILS THAT COULD APPLY TO A PARTICULAR PROJECT CONDITION.
- COORDINATE LOCATION OF ALL MECHANICAL EQUIPMENT, DUCTWORK, AND PIPING WITH OTHER TRADES BEFORE PROCEEDING WITH WORK. DO NOT INSTALL MECHANICAL EQUIPMENT, DUCTWORK, OR PIPING ABOVE ELECTRICAL EQUIPMENT WHERE PROHIBITED BY ELECTRICAL CODES (SWITCHBOARDS, PANELS, ETC.).
- LIGHT LINE WEIGHT INDICATES EXISTING PIPING, DUCTWORK, AND/OR EQUIPMENT TO REMAIN. BOLD LINE WEIGHT INDICATES NEW WORK TO BE INSTALLED AS WORK OF THIS CONTRACT.
- COORDINATE INSTALLATION OF OUTSIDE AIR INTAKE WITH INSTALLATION OF PLUMBING VENTS, FLUES AND EXHAUST/RELIEF OUTLETS TO MAINTAIN 10' SEPARATION.
- ALL WORK IN FINISHED SPACES SHALL BE LOCATED ABOVE CEILINGS, IN CHASES OR OTHER CONCEALED ACCESSIBLE LOCATIONS UNLESS NOTED OTHERWISE. LOCATE AND ARRANGE VALVES, DRAIN FITTINGS, ETC. TO BE ACCESSIBLE THROUGH LAY-IN CEILINGS, ACCESS PANELS OR ACCESS DOORS. PROVIDE AN ACCESS PANEL OR DOOR FOR ALL NON-ACCESSIBLE INSTALLATIONS. COORDINATE LOCATION OF ACCESS PANELS OR DOORS WITH THE ARCHITECT/ENGINEER AND OTHER TRADES.
- ALL MATERIALS LOCATED IN PLENUM SHALL BE RATED FOR PLENUM INSTALLATION.
- ALL DUCTWORK, PIPING, AND EQUIPMENT SUPPORTED FROM STRUCTURAL STEEL SHALL BE COORDINATED WITH ALL TRADES. ALL ATTACHMENTS TO STEEL BAR JOISTS, TRUSSES, OR JOIST GIRDERS SHALL BE AT PANEL POINTS OR AS SHOWN ON THE MECHANICAL OR STRUCTURAL DRAWINGS. WELDING TO STRUCTURAL MEMBERS SHALL NOT BE PERMITTED.
- ALL MISCELLANEOUS METALS AND MATERIALS REQUIRED TO ENSURE PROPER INSTALLATION AND AS SHOWN IN DETAILS FOR PIPING, DUCTWORK, AND EQUIPMENT (UNLESS OTHERWISE NOTED) SHALL BE PROVIDED BY THE INSTALLING CONTRACTOR.
- PROVIDE DIELECTRIC UNIONS AT ALL CONNECTIONS OF DISSIMILAR METALS (SUCH AS COPPER TO GALVANIZED STEEL).
- PROVIDE ISOLATION VALVES AT EACH PIECE OF EQUIPMENT. ALSO PROVIDE ISOLATION VALVES ON EACH BRANCH AND/OR RISER SERVING MULTIPLE PIECES OF EQUIPMENT OR FIXTURES AND ELSEWHERE AS INDICATED. INSTALL VALVES AS CLOSE TO MAIN AS POSSIBLE.


GENERAL HVAC NOTES

- DUCTWORK DIMENSIONS: FIRST NUMBER INDICATES SIDE OF DUCTWORK SHOWN. ALL DIMENSIONS ARE IN INCHES AND ARE INSIDE CLEAR DIMENSIONS.
- VOLUME DAMPERS ABOVE PLASTER OR GYPBOARD CEILINGS SHALL HAVE EXTENSION RODS AND CHROME-PLATED ESCUTCHEON PLATES.
- COORDINATE ALL GRILLE, REGISTER AND DIFFUSER LOCATIONS WITH REFLECTED CEILING PLAN, LIGHTING, AND ALL OTHER CEILING MOUNTED DEVICES.
- PROVIDE FLEXIBLE CONNECTIONS IN ALL DUCTWORK AND PIPING SYSTEMS CONNECTED TO FANS, PUMPS AND OTHER EQUIPMENT WHICH REQUIRE VIBRATION ISOLATION.
- PROVIDE ACCESSIBLE VOLUME DAMPERS OR OTHER MEANS OF AIRFLOW ADJUSTMENT AT ALL DUCT RUN-OUTS TO DIFFUSERS AND GRILLES.
- PROVIDE DUCT ACCESS DOORS AT OUTSIDE AIR INTAKE PLENUMS.
- ALL DUCT RUN-OUTS TO DIFFUSERS AND GRILLES SHALL BE THE SAME AS THE DIFFUSER OR GRILLE NECK SIZE UNLESS NOTED OTHERWISE.
- ALL PIPING RUNOUTS SHALL BE 3/4" UNLESS NOTED OTHERWISE.

GENERAL PLUMBING NOTES

- PROVIDE ALL PIPING AND FIXTURES IN ACCORDANCE WITH THE LOCAL PLUMBING CODES.
- SANITARY SEWER PIPING SMALLER THAN 3" SHALL BE SLOPED AT 1/4" PER FOOT, 3" AND LARGER SHALL BE SLOPED AT 1/8" PER FOOT.

1 2 3 4 5 6 7 8

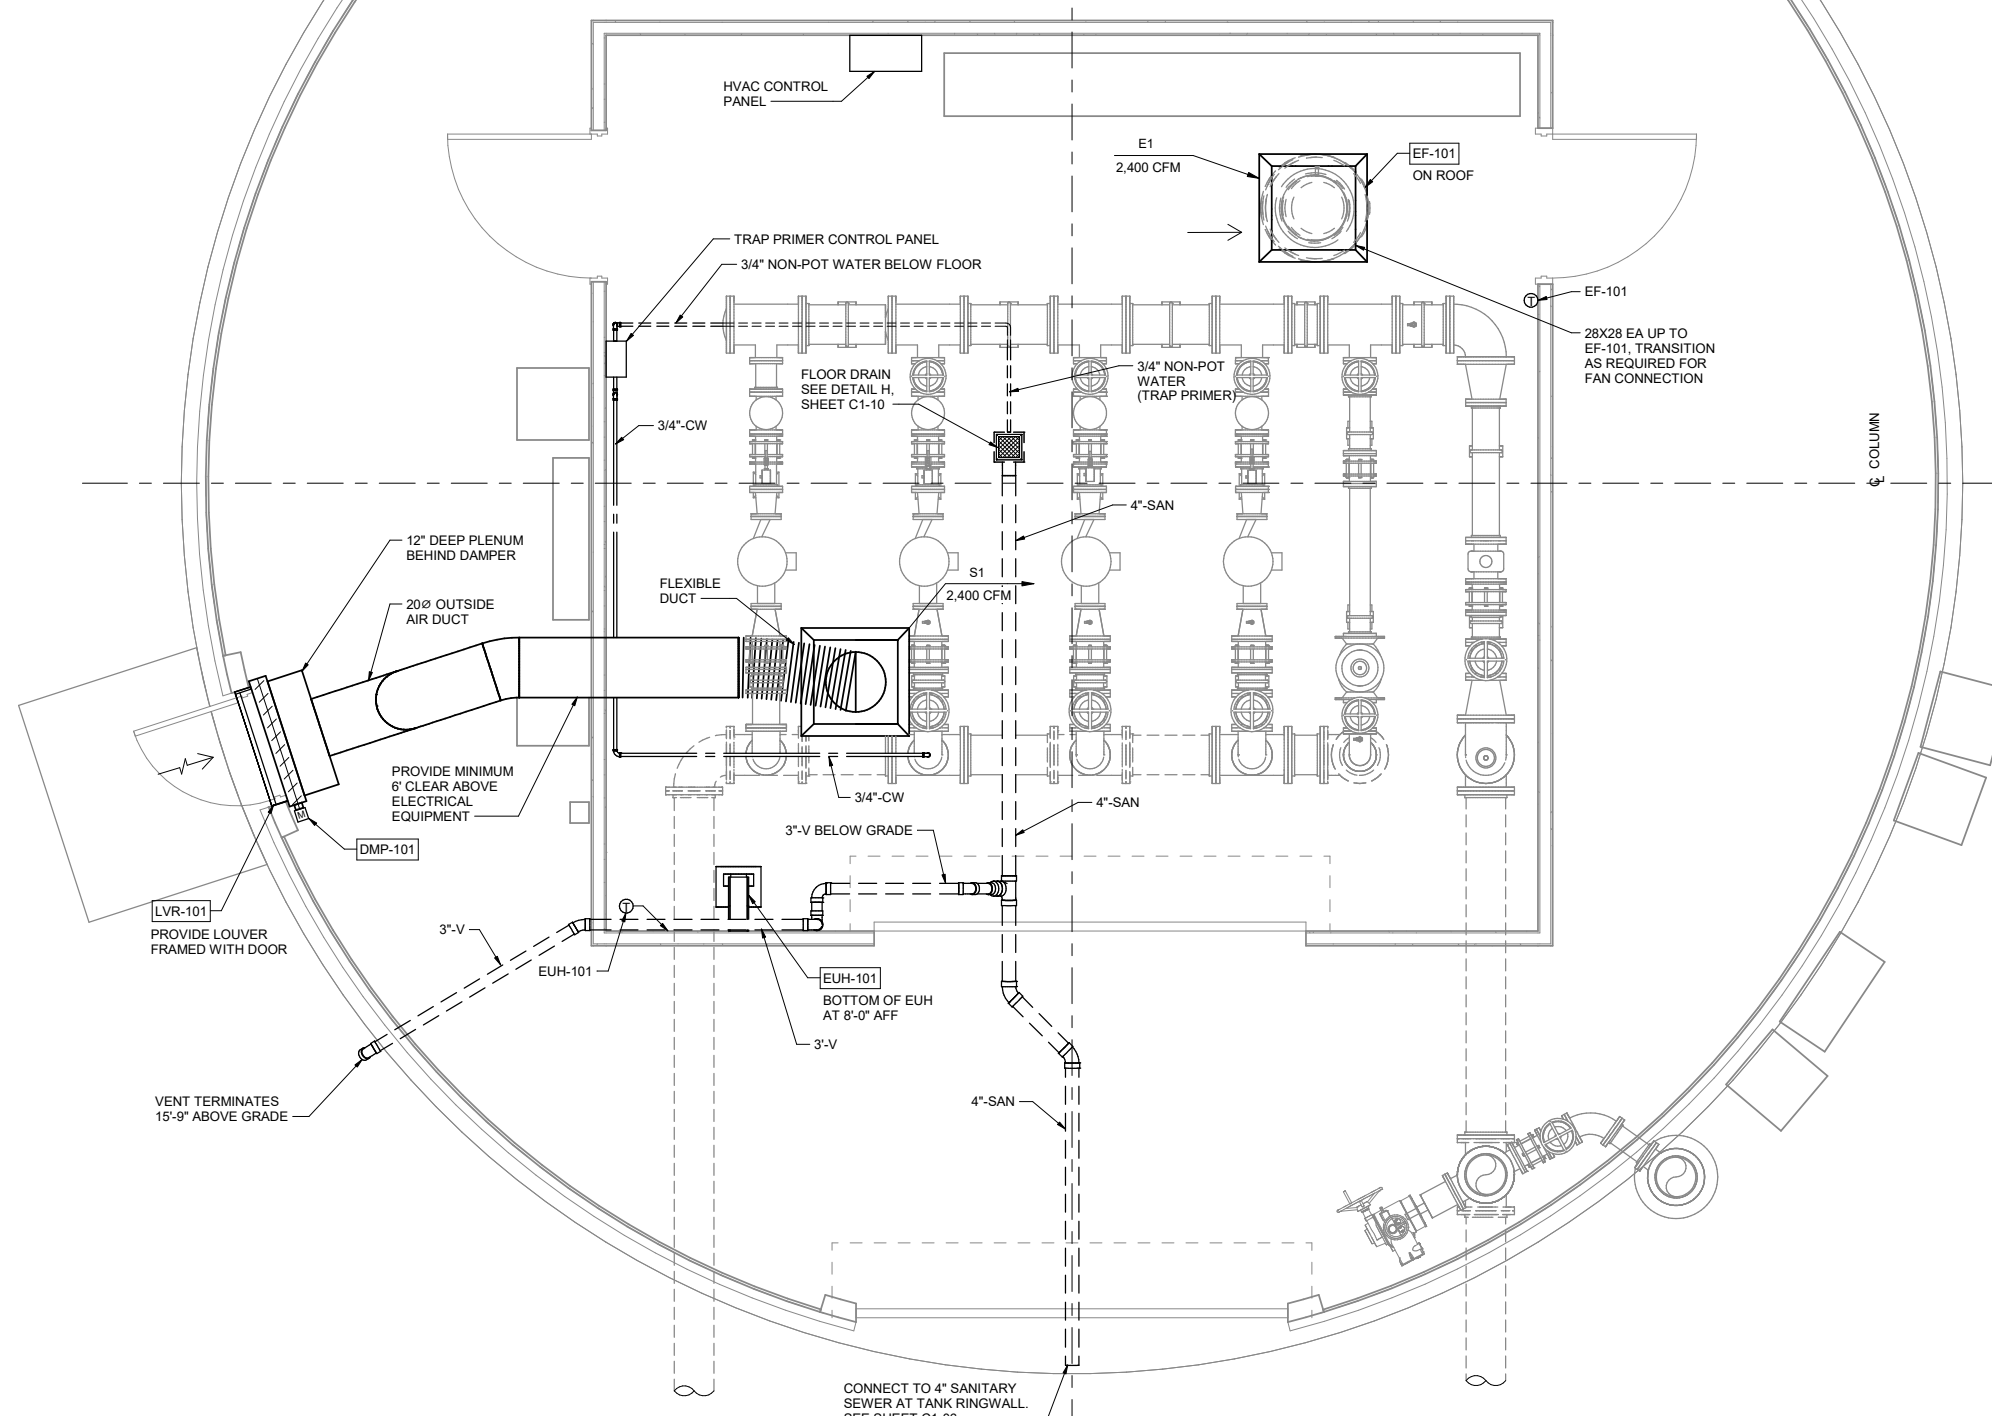

PUMP STATION MECHANICAL PLAN
3/8" = 1'-0"


CALL 48 HOURS
BEFORE YOU DIG
1-800-424-5555

B:\M 360\10172116_McCormick_Booster_Pump_Station_2020\10172116-00-U.rvt
7/7/2022 4:16:13 PM



7/8/2022	ISSUED FOR BID	
ISSUE	DATE	DESCRIPTION

PROJECT MANAGER		LAURA NOLAN
CIVIL ENG	J. KNOLL	
WATER ENG	L. CHENG	
STRUCTURAL ENG	M. HIJAZI	
ELECTRICAL ENG	L. KIRMEYER	
MECHANICAL ENG	K. SUTTON	
INSTR. ENG	M. HUTSON	
PROJECT NUMBER		10172116

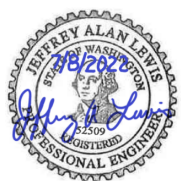


MCCORMICK
CLOSE TO WHAT COUNTS
PORT ORCHARD 660 RESERVOIR

PORT ORCHARD 660 RESERVOIR
BOOSTER PUMP STATION MECHANICAL PLAN
0 1" 2"
FILENAME 10172116-00-U.RVT
SCALE 3/8" = 1'-0"
SHEET
M50-02

BIM 360://10172116_McCormick_Booster_Pump_Station_202010172116-00-U-rt
7/7/2022 4:16:13 PM




7/8/2022
ISSUE DATE DESCRIPTION

ISSUED FOR BID


PROJECT MANAGER LAURA NOLAN

CIVIL ENG	J. KNOLL
WATER ENG	L. CHENG
STRUCTURAL ENG	M. HIJAZI
ELECTRICAL ENG	L. KIRMEYER
MECHANICAL ENG	K. SUTTON
INSTR. ENG	M. HUTSON
PROJECT NUMBER	10172116

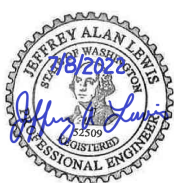

PORT ORCHARD 660 RESERVOIR

HVAC SCHEDULES
AND SPECIFICATIONS

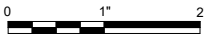

FILENAME 10172116-00-U.RVT
SCALE NONE

SHEET
M50-03

MECHANICAL SPECIFICATIONS

GENERAL PROVISIONS

THIS CONTRACTOR SHALL EXAMINE ALL SUCH DRAWINGS AND SPECIFICATIONS AND BECOME THOROUGHLY FAMILIAR WITH THE PROVISIONS CONTAINED THEREIN.

MECHANICAL DRAWINGS ARE DIAGRAMMATIC. THEY ARE INTENDED TO SHOW THE APPROXIMATE LOCATIONS OF EQUIPMENT AND DUCTWORK. DIMENSIONS GIVEN ON THE PLANS, IN FIGURES, SHALL TAKE PRECEDENCE OVER SCALED DIMENSIONS AND SHALL BE VERIFIED IN THE FIELD.

UNTIL TIME OF INSTALLATION. MAKE MINOR CHANGES IN THE LOCATION OF DUCTWORK AND EQUIPMENT AS NECESSARY WITHOUT ADDITIONAL COST TO THE CONTRACT.

THE MECHANICAL DRAWINGS AND SPECIFICATIONS ARE INTENDED TO SUPPLEMENT EACH OTHER. MATERIAL AND LABOR NECESSARY TO THE PROJECT SHALL BE FURNISHED AND INSTALLED EVEN THOUGH NOT SPECIFICALLY MENTIONED IN BOTH. LABOR AND/OR MATERIALS NEITHER SHOWN NOR SPECIFIED, BUT OBVIOUSLY NECESSARY FOR THE COMPLETION AND PROPER FUNCTIONING OF THE SYSTEM SHALL BE FURNISHED AND INSTALLED BY THE MECHANICAL CONTRACTOR.

IT IS THE INTENT OF THESE DRAWINGS THAT THIS BE A COMPLETE MECHANICAL JOB. ANY ERRORS OR OMISSIONS SHALL BE BROUGHT TO THE ATTENTION OF THE ENGINEER PRIOR TO SUBMITTAL AND INSTALLATION.

CODES

INSTALLATION SHALL BE IN FULL ACCORDANCE WITH ALL CODES, RULES AND REGULATIONS OF MUNICIPAL, CITY, COUNTY, STATE AND PUBLIC UTILITIES AND ALL OTHER AUTHORITIES HAVING JURISDICTION INCLUDING BUT NOT LIMITED TO:

- INTERNATIONAL BUILDING CODE 2018
- INTERNATIONAL MECHANICAL CODE 2018
- UNIFORM PLUMBING CODE 2018
- WASHINGTON STATE ENERGY CODE 2020 EDITION
- ASHRAE 90.1-2016
- ASHRAE 62.1-2016
- SMACNA HVAC DUCT CONSTRUCTION STANDARDS – METAL AND FLEXIBLE

COMPLY WITH ANY SPECIFICATION OR DRAWING REQUIREMENTS THAT ARE IN EXCESS, BUT NOT IN CONFLICT WITH CODE REQUIREMENTS.

STANDARDS AND SUBSTITUTIONS

SHOULD THE CONTRACTOR PROPOSE TO FURNISH MATERIALS OR EQUIPMENT OTHER THAN THOSE SPECIFIED, SUBMIT A WRITTEN REQUEST FOR SUBSTITUTION, ACCOMPANIED WITH COMPLETE DESCRIPTIVE (MANUFACTURER, CATALOG NUMBER, ETC.) AND TECHNICAL DATA FOR ALL ITEMS. FAILURE TO COMPLY WITH REQUIREMENT MAY CAUSE THE ITEM TO BE REJECTED.

QUALITY ASSURANCE

IT IS THE INTENT OF THE DRAWINGS AND SPECIFICATIONS TO ESTABLISH A STANDARD OF QUALITY OF MATERIALS AND EQUIPMENT INSTALLED. ALL PRODUCTS SHALL BE NEW AND OF THE TYPE AND QUALITY. WHERE MATERIAL, EQUIPMENT OR OTHER PRODUCTS ARE SPECIFIED BY MANUFACTURER, BRAND NAME, TYPE OR CATALOG NUMBER, SUCH DESIGNATION SHALL ESTABLISH THE STANDARD OF THE DESIRED QUALITY AND STYLE.

RECORD DRAWINGS

SUBMIT SET OF REPRODUCIBLE MECHANICAL DRAWINGS SHOWING THE RECORD CONDITIONS.

TESTING AND BALANCING REQUIREMENTS

TESTING AND BALANCING OF ALL AIR SYSTEMS SHALL BE DONE IN ACCORDANCE WITH THE ASSOCIATED AIR BALANCE COUNCIL (AABC), AMERICAN INDUSTRIAL HYGIENE ASSOCIATION (AIHA), ASHRAE HVAC SYSTEMS AND EQUIPMENT HANDBOOK – “TESTING, ADJUSTING, AND BALANCING” CHAPTER, AND NATIONAL ENVIRONMENTAL BALANCING BUREAU (NEBB).

THE TESTING AND BALANCING FIRM SHALL BE AN INDEPENDENT FIRM FROM THE HVAC EQUIPMENT INSTALLATION FIRM.

DO NOT BEGIN BALANCING AND TESTING UNTIL HVAC SYSTEMS ARE COMPLETE AND IN FULL WORKING ORDER.

OBTAIN DESIGN CFM AT FANS. DIFFUSERS, REGISTERS, AND GRILLES SHALL COMPLY WITH DESIGN REQUIREMENTS WITHIN 10 PCT. TEST AND RECORD ENTERING AND LEAVING AIR TEMPERATURES (DB-HEATING, DB/WB-COOLING). ADJUST AND ASSURE THAT THE OPERATION OF AUTOMATICALLY OPERATED DAMPERS ARE AS SPECIFIED.

COMMISSIONING

PROVIDE COMMISSIONING IN ACCORDANCE WITH WASHINGTON STATE ENERGY CODE.

CORROSION RESISTANT COATINGS/MATERIALS

ALL UNITS SHALL BE CONSTRUCTED WITH CORROSION-RESISTANT MATERIALS (ALUMINUM, STAINLESS STEEL, OR FRP) OR HAVE CORROSION-RESISTANT COATING MANUFACTURED BY HERESITE AND CHEMICAL CO., AERO-MARINE ENGINEERING, INC., OR APPROVED EQUAL.

DUCTWORK

DUCTWORK SHALL BE ALUMINUM WITH THICKNESS PER SMACNA FOR A 4 IN WC PRESSURE CLASS. DUCTWORK SHALL BE INSULATED WITH 2" THICK MINIMUM FIBERGLASS DUCT WRAP WITH FSK JACKET, AT A MINIMUM R-VALUE OF R-6.

SUPPORTS AND HANGERS: SUPPORTS ANGLES SHALL BE ALUMINUM OR STAINLESS STEEL, MINIMUM 1-1/2 BY 1-1/2 BY 1/4 ANGLE SUPPORT ANGLES. HANGER RODS SHALL BE ALUMINUM OR STAINLESS STEEL. ANCHORS SHALL BE STAINLESS STEEL WEDGE TYPE. FABRICATED UNITS SHALL BE TRAPEZE TYPE. STRAP HANGERS ARE PROHIBITED.

TURNING VANES: MATERIAL SHALL BE SAME AS DUCT. FABRICATED UNITS SHALL BE DOUBLE VANE TYPE. PRESSURE DROP THROUGH ELBOWS SHALL BE LIMITED TO A MAXIMUM 20 PERCENT OF VELOCITY PRESSURE.

FLEXIBLE CONNECTIONS: MATERIALS SHALL BE HYPALON, DOUBLE COATED WOVEN GLASS FABRIC. FABRICATED CONNECTIONS SHALL WITHSTAND 4.5 IN WC, POSITIVE AND NEGATIVE PRESSURE.

DAMPERS: MOTORIZED DAMPERS SHALL BE SAME MATERIAL AS DUCT.

LOUVERS

MATERIAL: ASTM B221 EXTRUDED ALUMINUM, ALLOY 6063T5, MINIMUM 0.081 IN THICK. 4 IN DEEP, DRAINABLE WITH BLADES AT 37-1/2 DEGREE ANGLE. CONTINUOUS BLADE APPEARANCE WITH MINIMUM FREE AREA: 8.58 SQFT FOR 4 X 4 FT LOUVER. MAXIMUM PRESSURE DROP: 0.10 IN OF WATER AT 700 FPM. WATER PENETRATION: 0.01 OZ/SQFT AT 873 FPM. SHALL BE AMCA CERTIFIED.

INSTALL IN STANDARD ALUMINUM FRAME. ANCHORS, FASTENERS, AND REINFORCING SHALL BE ALUMINUM OR STAINLESS STEEL. THE FINISH SHALL BE A AA-M12C22A41 CLEAR ANODIZED ARCHITECTURAL CLASS 1 COATING PER AA DAF 45. INSTALL PER MANUFACTURER'S INSTRUCTIONS AND RECOMMENDATIONS. INSTALL ANCHORING AND BRACING AS REQUIRED. INSTALL 0.040 IN ALUMINUM FLASHING AT SILL TO MATCH LOUVER.

HVAC EQUIPMENT

ROOF MOUNTED, CENTRIFUGAL EXHAUST FAN (EF-101)

MATERIALS OF THE FAN SHALL BE ALUMINUM WITH A SOLID STAINLESS-STEEL DRIVE SHAFT. PROPELLERS SHALL BE STATICALLY AND DYNAMICALLY BALANCED, OF AN AIRFOIL DESIGN, AND MUST HAVE A MINIMUM OF 4 BLADES. BEARINGS SHALL BE CAST-IRON PILLOW BLOCKS, REGREASABLE, AND HAVE AN AVERAGE 200,000 HOUR LIFE. PROVIDE WITH ELECTRICALLY COMMUTATED CONTROL. SEE SCHEDULE FOR SIZE, CAPACITY, MOTOR, AND ELECTRICAL INFORMATION.

PROVIDE WITH PREFABRICATED INSULATED ALUMINUM ROOF CURB, MOTORIZED DAMPER, BIRD SCREEN, AND EXTENDED GREASE LINES AND FITTINGS.

WASH-DOWN STYLE ELECTRIC UNIT HEATER (EUH-101)

UNIT SHALL BE UL LISTED, CORROSION RESISTANT WASHABLE CONSTRUCTION. THE MATERIALS OF THE HEATER SHALL BE NON-SPARKING ALUMINUM FOR THE FAN, STAINLESS STEEL FOR THE HEATER CASE WITH HEATING MONEL FIN TUBE. THE JUNCTION BOX SHALL BE NEMA 4X. SEE SCHEDULE FOR SIZE, CAPACITY, MOTOR, AND ELECTRICAL INFORMATION.

PROVIDE WITH STAINLESS STEEL MOUNTING BRACKET AND 40 TO 90 °F, 5 °F DIFFERENTIAL WALL-MOUNTED THERMOSTAT.

MOTORIZED DAMPERS (DMP-101)

MATERIAL: 6063 T5 ALUMINUM WITH EXTRUDED VINYL BLADE SEAL. 0.125 IN MINIMUM FRAME THICKNESS, PARALLEL AIRFOIL BLADES, MAXIMUM 6 IN WIDE, 1/2 IN PLATED STEEL HEX AXLES, MOLDED SYNTHETIC BEARINGS. ELECTRIC MOTOR OPERATOR SIZED WITH A MINIMUM 150% SAFETY FACTOR WITH END POSITION SWITCHES.

LABELING:

NAMEPLATES: SHALL BE LAMINATED TWO-LAYER PHENOLIC OR DR (HIGH IMPACT) ACRYLIC WITH ENGRAVED BLACK LETTERS ON LIGHT CONTRASTING BACKGROUND. NAMEPLATE THICKNESS SHALL BE A MINIMUM OF 1/16 IN.

SELF ADHESIVE PIPE AND DUCT MARKERS: COLOR AND LETTERING SHALL CONFORM TO ASME A13.1. THE MATERIAL SHALL BE FLEXIBLE, VINYL FILM TAPE WITH PRESSURE SENSITIVE ADHESIVE BACKING AND PRINTED MARKINGS. THE THICKNESS SHALL BE A MINIMUM OF 5 MILS. THE LETTER HEIGHT SHALL BE 1/2 IN HIGH LETTERS UP TO 2 IN OUTSIDE DIAMETER OF INSULATION OR PIPE, 1 IN HIGH LETTERS FOR 2-1/2 TO 6 IN OUTSIDE DIAMETER OF INSULATION OR PIPE, AND 1-3/4 IN HIGH LETTERS FOR GREATER THAN 6 IN OUTSIDE DIAMETER OF INSULATION OR PIPE AND ALL DUCTWORK AND EQUIPMENT. THEY SHALL BE INDOOR/OUTDOOR GRADE, HAVE WEATHER AND UV RESISTANT INKS, AND PERMANENT ADHESIVE.

LOCKOUT DEVICES: LOCKOUT HASPS SHALL BE ANODIZED ALUMINUM HASP WITH ERASABLE LABEL SURFACE AT A MINIMUM OF 7-1/4 X 3 IN. VALVE LOCKOUT DEVICES SHALL BE BY BRADY CORPORATION OR MASTER LOCK COMPANY, LLC. THEY SHALL BE NYLON DEVICES PREVENTING ACCESS TO VALVE OPERATOR, ACCEPTING LOCK SHACKLE.

CONTROLS

- CONTROLS AND SEQUENCE OF OPERATIONS INDICATED ILLUSTRATE BASIC OPERATING FUNCTIONS ONLY.
- REVIEW DRAWINGS AND SUBMIT COMPLETE INSTALLATION DATA, INCLUDING MINOR DETAILS, TO PROVIDE PROPER OPERATION.
- ALL TEMPERATURES AND SETPOINTS INDICATED SHALL BE CONSIDERED ADJUSTABLE WHETHER NOTED OR NOT.
- EF-101 AND DMP-101:
 - PROVIDE FAN CONTROL PANEL. EXHAUST FAN AND DAMPER SHALL BE INTERLOCKED. DAMPER SHALL BE PROVED OPEN PRIOR TO STARTING THE EXHAUST FAN.
 - EXHAUST FAN SHALL RUN AS REQUIRED TO MAINTAIN THE MAXIMUM TEMPERATURE IN THE PUMP STATION AT 85°F (ADJUSTABLE) AT THE AIR VOLUME SHOWN ON THE SCHEDULES. EXHAUST FAN SHALL RUN UNTIL THE TEMPERATURE IS 5°F BELOW SETPOINT.
 - A SELECTOR SWITCH WITH A 2-HOUR MAXIMUM TIMER SHALL BE PROVIDED TO ALLOW THE BUILDING OPERATOR TO MANUALLY SWITCH THE EXHAUST FAN ON.
- EUH-101:
 - ON A CALL FOR HEATING FROM THE UNIT'S SPACE THERMOSTAT, THE UNIT SHALL ENERGIZE TO MAINTAIN A SPACE TEMPERATURE OF 40°F.

PLUMBING FIXTURES, EQUIPMENT, AND MATERIALS

FLOOR DRAIN

CAST IRON FLOOR DRAIN BODY WITH ANCHOR FLANGE, INTEGRAL CLAMPING COLLAR, SEEPAGE OPENINGS, 1/2 IN PRIMER TAP WITH PLUG, GRATE SUPPORTED BUCKET, AND 12 IN ROUND DUCTILE IRON HEAVY DUTY GRATE. 6 IN DRAIN CONNECTION WITH TRAP.

TRAP PRIMER

ASSE 1044 ELECTRONIC TRAP PRIMER WITH 24 HOUR TIMER. 120V / 1 PH / 60 HZ. 6.3 WATTS. SURFACE MOUNTED CABINET. QUARTER TURN ISOLATION VALVE. ROUTE TUBING FROM TRAP PRIMER TO FLOOR DRAINS PER MANUFACTURER'S INSTRUCTIONS AND IN COMPLIANCE WITH THE PLUMBING CODE.

POTABLE AND NON-POTABLE WATER PIPING

ASTM B88 TYPE L COPPER PIPE WITH ASTM B16.22 WROUGHT COPPER SOLDER JOINT FITTINGS USING ASTM B32 SOLDER WITH TIN/ANTIMONY RATIO OF 95/5 AND NON-CORROSIVE FLUX. BURIED PIPING SHALL BE TYPE K COPPER PIPE WITH WROUGHT COPPER FITTINGS USING AWS A5.8 SILVER SOLDER. PROVIDE DIELECTRIC UNIONS WHEN CONNECTING TO DISSIMILAR MATERIALS. PROVIDE MSS SP 110, 600 PSI WOG, TWO PIECE BRONZE BODY, STAINLESS STEEL BALL, FULL PORT, TEFLON SEATS, BLOW-OUT PROOF STEM, SOLDER OR THREADED ENDS, WITH LEVER HANDLE BALL VALVES FOR ISOLATION / SHUT-OFF SERVICE.

SAN/VENT PIPING ABOVE GRADE

ASTM A74 SERVICE WEIGHT CAST IRON SOIL PIPE WITH CISPI 310 HUBLESS FITTINGS USING NEOPRENE GASKETS AND STANLESS STEEL CLAMP AND SHIELD ASSEMBLIES.

SAN/VENT PIPING BELOW GRADE

ASTM D2729 DWV TYPE PVC WITH ASTM D2855 SOLVENT WELD PVC DWV FITTINGS.

FAN SCHEDULE

MARK NUMBER	SERVES	OPERATING AIRFLOW (CFM)	STATIC PRESSURE IN WG	FAN TYPE	WHEEL DIA IN	FAN RPM	S P L 250 HZ MAX dB	MOTOR DATA				BASIS OF DESIGN	NOTE
								HP	V/PH	DRIVE TYPE	CONTROL TYPE		
EF-101	PUMP ROOM	2,400	0.2	ROOF	19.5	583	70	0.25	120/1	DIRECT	EC	LOREN COOK ACRU-D VF	1,2,3

NOTES:

- TYP. PROVIDE FANS AND MOTORS SIZED TO DELIVER NOMINAL AIRFLOW AND STATIC PRESSURE SHOWN.
- WITH EC MOTOR FOR FAN SPEED ADJUSTMENT.
 - PROVIDE WITH MOTORIZED ISOLATION DAMPER, INSULATED ROOF CURB, AND CONTROLLER.
 - PROVIDE THERMOSTAT, CONDUIT, WIRING, DISCONNECTS, CONTROLLER, AND ALL NECESSARY APPURTENANCES AS REQUIRED TO OPERATE FAN AND DAMPERS AS A COMPLETE SYSTEM.

DIFFUSER, REGISTER, AND GRILLE SCHEDULE

MARK NUMBER	MAX AIRFLOW CFM	FACE SIZE IN (WXH)	CONNECTION SIZE, IN (WXH OR DIA)	MAX STATIC PRESS DROP IN WG	MAX NC	MOUNTING LOCATION	FRAME TYPE	MATERIAL	FINISH		BASIS OF DESIGN	NOTES
S1	2,400	30x30	28x28	0.05	30	CEILING	SURFACE	ALUMINUM	CLEAR ANODIZE		TITUS 300F	1,2,4
E1	2,400	30x30	28x28	0.05	30	CEILING	SURFACE	ALUMINUM	CLEAR ANODIZE		TITUS 350ZFL	1,3

NOTES:

- COORDINATE WITH CEILING FRAMING TO PROVIDE BLOCKOUT FOR GRILLES AS REQUIRED TO NOT INTERRUPT FRAMING.
- ADJUSTABLE DOUBLE DEFLECTION GRILLE WITH 3/4 IN BLADE SPACING AND FRONT BLADES PARALLEL TO THE HEIGHT (H) DIMENSION.
- SINGLE DEFLECTION GRILLE WITH 3/4 IN BLADE SPACING AND FIXED BLADES SET AT 0 DEG AND PARALLEL TO THE WIDTH (W) DIMENSION.
- PROVIDE SQUARE TO ROUND ADAPTOR.

UNIT HEATER SCHEDULE

MARK NUMBER	UNIT CONFIGURATION	SENS CAP MBH	NOMINAL AIRFLOW CFM	COIL E A T DEG F	ELECTRIC COIL DATA			MOTOR DATA		BASIS OF DESIGN	NOTE
					KW	TEMP RISE	V/PH	HP	V/PH		
EUH-101	HORIZONTAL	6.8	405	40	2	21	208/3	1/15	208/3	CHROMALOX HD3D	1,2,3

NOTES:

- TYP. PROVIDE UNIT MOUNTED MOTOR STARTER AND DISCONNECT.
- PROVIDE WASH-DOWN STYLE, CORROSION RESISTANT ELECTRIC UNIT HEATER.
 - PROVIDE WALL MOUNTED THERMOSTAT, CONDUIT, AND WIRING.
 - PROVIDE WALL MOUNTING BRACKET.

MOTORIZED DAMPER SCHEDULE

MARK NUMBER	SYSTEM SERVED	SERVICE TYPE	DAMPER CONFIGURATION	BLADE TYPE	MAX AIR VELOCITY FPM	NOMINAL SIZE L x W IN	ACTUATOR TYPE	BASIS OF DESIGN	NOTE
DMP-101	INTAKE	INTAKE	PARALLEL	AIRFOIL	500	40 x 36	ELEC	RUSKIN CD-50	1

NOTES:

- PROVIDE WITH SPRING OPEN, POWER CLOSED DAMPER ACTUATOR AND END SWITCHES AS REQUIRED TO MEET CONTROL SEQUENCE.





LOUVER SCHEDULE

MARK NUMBER	ELEVATION N/S/E/W	SYSTEM SERVED	SERVICE TYPE	LOUVER TYPE	NOMINAL AIRFLOW CFM	MAX VEL @ FREE AREA FPM	MAX PRESS DROP IN WG	LOUVER MATERIAL	SCREEN TYPE	SIZE H x W x D IN	BASIS OF DESIGN	NOTE
LVR-101	SOUTH	PUMP ROOM	INTAKE	FIXED	2400	500	0.05	ALUMINUM	BIRD	36 x 40 x 4	RUSKIN 375DX	1

NOTES:

- TYP. COORDINATE FINAL FINISHED FACE SIZE, MOUNTING, COLOR AND WALL ELEVATIONS WITH ARCHITECT PRIOR TO FURNISHING MATERIALS.
- PROVIDE WITH FLATTENED ALUMINUM BIRD SCREEN.


ONE-LINE, POWER, AND LIGHTING SYMBOLOLOGY

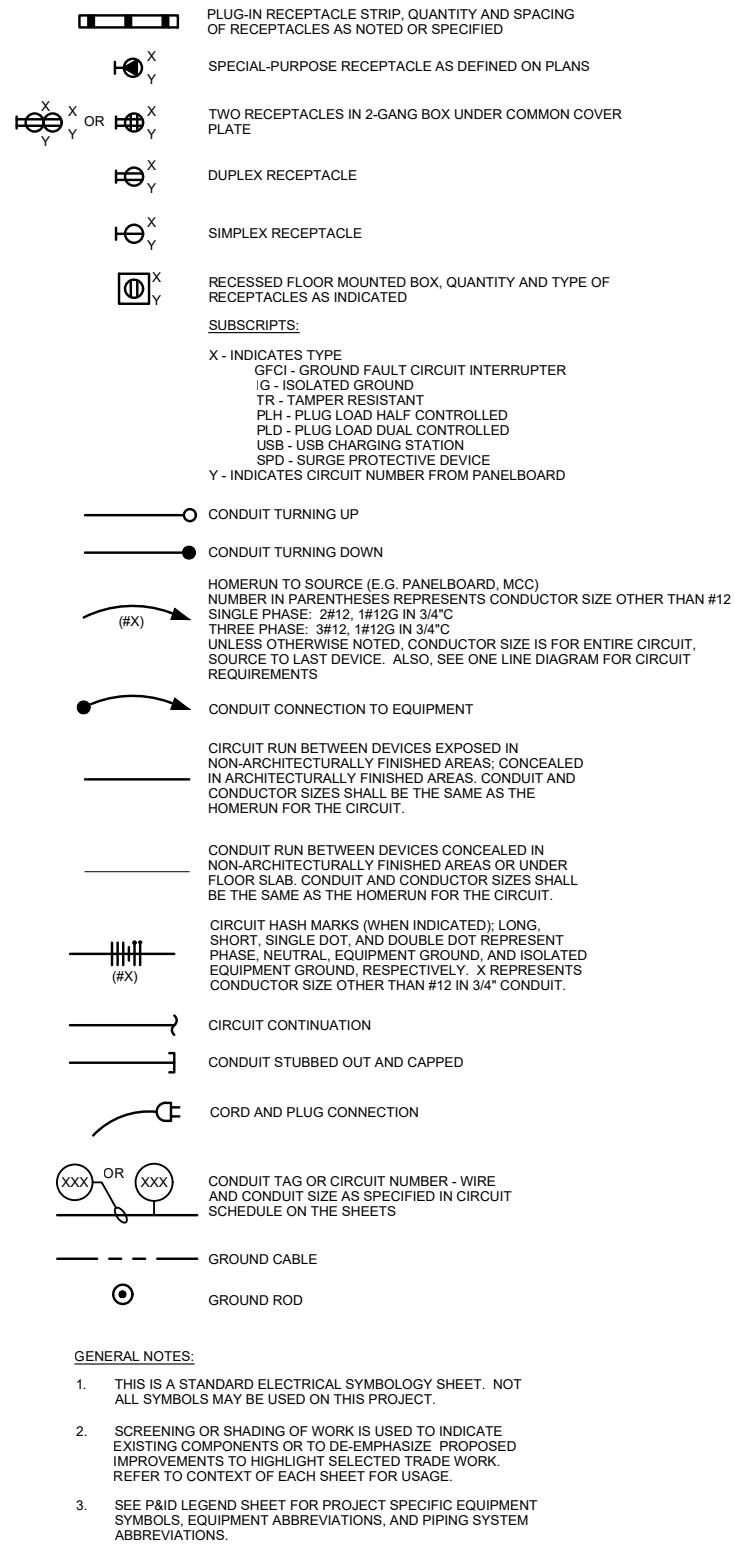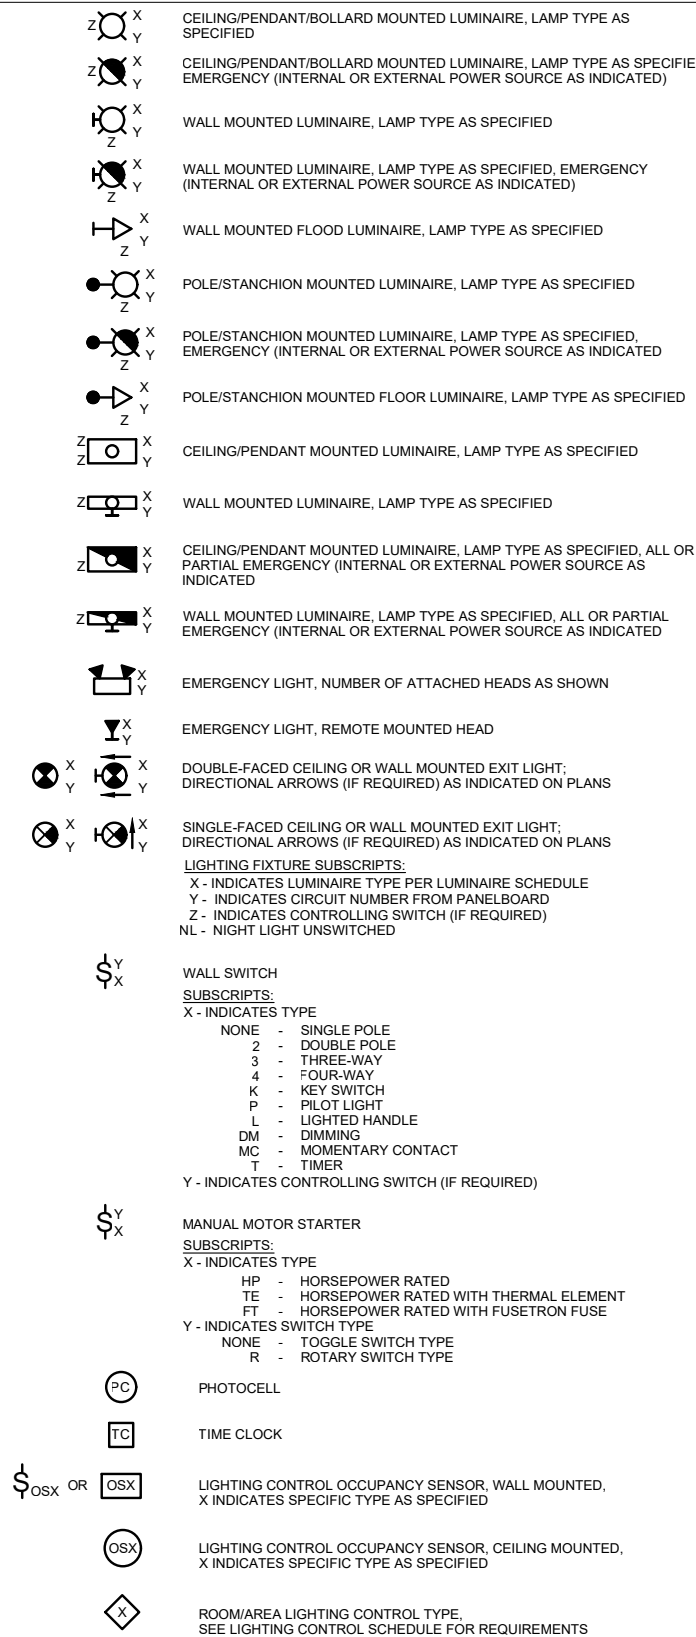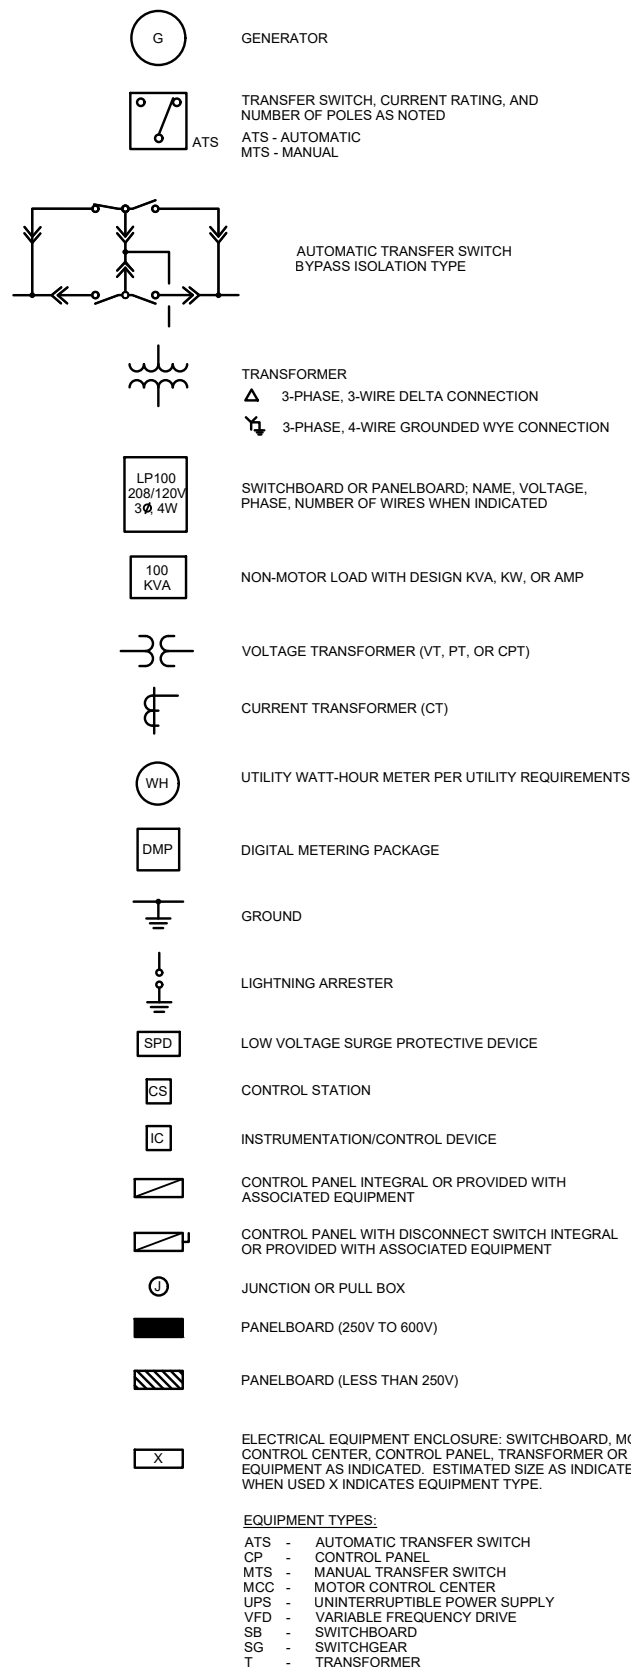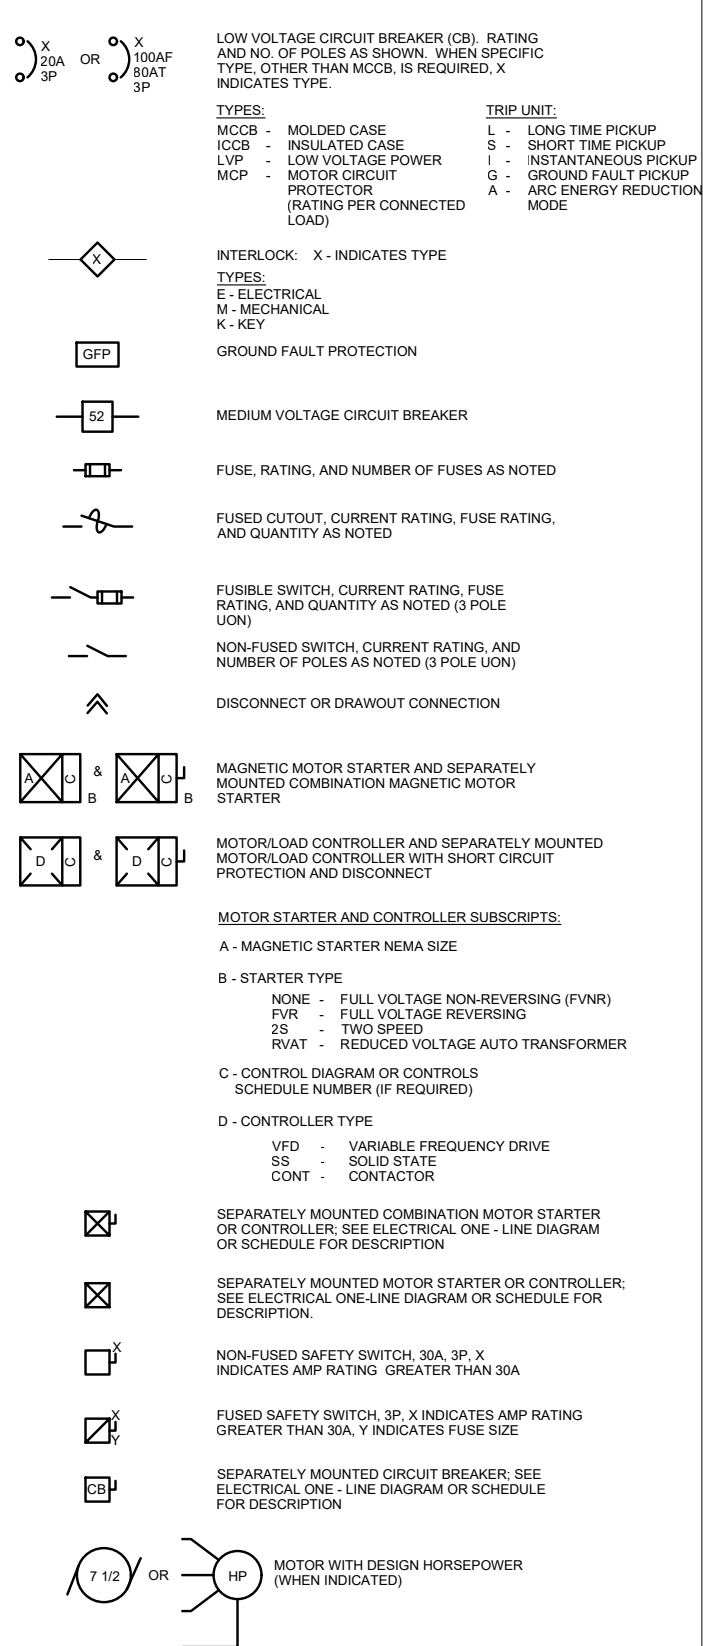[illegible]

PROJECT MANAGER	L. NOLAN
CIVIL ENG.	J. KNOLL
WATER ENG.	L. CHENG
STRUCTURAL ENG.	M. HIJAZI
ELECTRICAL ENG.	I. RINCON
INSTR. ENG.	M. HUTSON
PROJECT NUMBER	10172116





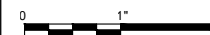













 
 








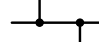 


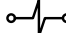
 



 



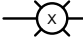
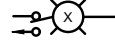

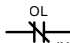





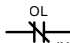




 


 


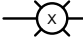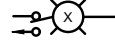


 



 
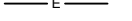
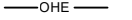







 

 

ELECTRICAL LEGEND 1



FILENAME	E1-01.dwg
SCALE	AS NOTED

| SHEET

E1-01


1	2	3	4	5	6	7	8
COMMUNICATION SYMBOLOGY		EMERGENCY ALARM SYMBOLOGY		CONTROL SYMBOLOGY		CONTROL SYMBOLOGY	
<div><div></div>WALL MOUNTED TELEPHONE OUTLET</div> <div><div></div>WALL MOUNTED DATA OUTLET</div> <div><div></div>WALL MOUNTED COMBINATION TELEPHONE AND DATA OUTLET</div> <div><div></div>RECESSED FLOOR MOUNTED TELEPHONE OUTLET</div> <div><div></div>RECESSED FLOOR MOUNTED DATA OUTLET</div> <div><div></div>RECESSED FLOOR MOUNTED COMBINATION TELEPHONE AND DATA OUTLET</div>		<div><div></div>ALARM BELL</div> <div><div></div>ALARM HORN</div> <div><div></div>ALARM FLASHING LIGHT</div> <div><div></div>ALARM BELL AND FLASHING LIGHT COMBINATION UNIT</div> <div><div></div>ALARM HORN AND FLASHING LIGHT COMBINATION UNIT</div> <div><div></div>PUSHBUTTON OR PULLSTATION</div>		<div><div></div>ELECTRICAL CONNECTION</div> <div><div></div>NO ELECTRICAL CONNECTION</div> <div><div><div>SV</div>OR<div></div></div>SOLENOID VALVE</div> <div><div><div><div>X</div><div>Y</div></div></div>CONTROL/RELAY COIL: X-INDICATES TYPE Y-INDICATES LOOP NUMBER, WHEN USED</div> <div>TYPES: CR-CONTROL RELAYTC-TIME CLOCK PC-PHOTOCELLLC-LIGHTING CONTACTOR DP-DEFINITE PURPOSETR-TIMING RELAY M-MOTOR STARTER</div> <div></div> NORMALLY OPEN CONTACT (N.O.) <div></div> NORMALLY CLOSED CONTACT (N.C.) <div></div> NORMALLY OPEN TIME DELAY RELAY CONTACT WITH TIME DELAY ON CLOSING AFTER COIL IS ENERGIZED <div></div> NORMALLY CLOSED TIME DELAY RELAY CONTACT WITH TIME DELAY ON OPENING AFTER COIL IS ENERGIZED <div></div> NORMALLY OPEN TIME DELAY RELAY CONTACT WITH TIME DELAY ON OPENING AFTER COIL IS DE-ENERGIZED <div></div> NORMALLY CLOSED TIME DELAY RELAY CONTACT WITH TIME DELAY ON CLOSING AFTER COIL IS DE-ENERGIZED <div></div> NORMALLY OPEN TEMPERATURE SWITCH; CLOSE ON RISING TEMPERATURE <div></div> NORMALLY CLOSED TEMPERATURE SWITCH; OPEN ON RISING TEMPERATURE <div></div> NORMALLY OPEN FLOW SWITCH; CLOSE ON INCREASING FLOW <div></div> NORMALLY CLOSED FLOW SWITCH; OPEN ON INCREASING FLOW <div></div> NORMALLY OPEN LEVEL SWITCH, CLOSE ON RISING LEVEL <div></div> NORMALLY CLOSED LEVEL SWITCH, OPEN ON RISING LEVEL <div></div> NORMALLY OPEN PRESSURE SWITCH, CLOSE ON INCREASING PRESSURE <div></div> NORMALLY CLOSED PRESSURE SWITCH, OPEN ON INCREASING PRESSURE <div></div> NORMALLY OPEN LIMIT SWITCH, CLOSE ON REACHING LIMIT <div></div> NORMALLY CLOSED LIMIT SWITCH, OPEN ON REACHING LIMIT <div></div> MICROPROCESSOR (PLC, RTU, ETC.) OUTPUT <div></div> MICROPROCESSOR (PLC, RTU, ETC.) INPUT <div></div> FIELD WIRING EXTERNAL TO CONTROL PANEL <div><div>HANDOFFAUTO</div><div></div><div>XOXXOOX</div></div> 3 POSITION SELECTOR SWITCH, MAINTAINED CONTACTS; UNLESS OTHERWISE NOTED, 2-POSITION SIMILAR <div></div> NORMALLY OPEN PUSHBUTTON, MOMENTARY CONTACT UNLESS OTHERWISE NOTED <div></div> NORMALLY CLOSED PUSHBUTTON, MOMENTARY CONTACT UNLESS OTHERWISE NOTED <td colspan="2"><div><div></div>INDICATING LIGHT: X INDICATES LENS COLOR</div><div><div><div></div><div><div>LENS COLORS:</div><div>R - REDY - YELLOW</div><div>G - GREENW - WHITE</div><div>B - BLUEA - AMBER</div></div></div></div><div></div>THERMAL OVERLOAD ELEMENT<div><div></div>OL(X)</div><div>THERMAL OVERLOAD RELAY CONTACT. WHEN SHOWN X INDICATES QUANTITY.</div><div>CPT</div><div>CONTROL POWER TRANSFORMER (CPT)</div><div>RTM</div><div>RUN TIME METER</div></td>		<div><div></div>INDICATING LIGHT: X INDICATES LENS COLOR</div> <div><div><div></div><div><div>LENS COLORS:</div><div>R - REDY - YELLOW</div><div>G - GREENW - WHITE</div><div>B - BLUEA - AMBER</div></div></div></div> <div></div> THERMAL OVERLOAD ELEMENT <div><div></div>OL(X)</div> <div>THERMAL OVERLOAD RELAY CONTACT. WHEN SHOWN X INDICATES QUANTITY.</div> <div>CPT</div> <div>CONTROL POWER TRANSFORMER (CPT)</div> <div>RTM</div> <div>RUN TIME METER</div>	
AUDIO/VISUAL SYMBOLOGY		SITE SYMBOLOGY					
<div><div></div>TELEVISION OUTLET</div> <div><div></div>CEILING MOUNT SPEAKER</div> <div><div><div>S</div>X</div><div><div>SPEAKER SUBSCRIPTS:</div><div>X - INDICATES HEIGHT</div></div></div> <div><div></div>HORN TYPE TRANSDUCER</div> <div><div></div>VOLUME CONTROL</div> <div><div></div>HEAD END EQUIPMENT</div> <div><div></div>FLOOR MOUNTED MICROPHONE JACK</div> <div><div></div>WALL MOUNTED MICROPHONE JACK</div>		<div><div></div>EXTERIOR PAD MOUNTED TRANSFORMER</div> <div><div></div>POLE - MOUNTED TRANSFORMER</div> <div><div><div>X</div><div>Y- MHX OR HHX</div><div>X - INDICATES SEQUENCE NUMBER</div></div></div> <div><div><div>X</div><div>Y</div><div>POLE/STANCHION MOUNTED FLOOD LUMINAIRE, LAMP TYPE AS SPECIFIED</div></div></div> <div><div><div>X</div><div>Y</div><div>POLE MOUNTED AREA OR ROADWAY LUMINAIRE, LAMP TYPE AS SPECIFIED</div></div></div> <div><div><div>X</div><div>Y</div><div>HIGH MAST LIGHTING, NUMBER OF LUMINAIRES AS SPECIFIED</div></div><div><div>LIGHTING FIXTURE SUBSCRIPTS:</div><div>X - INDICATES LUMINAIRE TYPE PER LUMINAIRE SCHEDULE</div><div>Y - INDICATES CIRCUIT NUMBER FROM PANELBOARD</div></div></div> <div><div></div>POWER POLE</div> <div><div></div>DOWNGUY</div> <div><div>E</div>UNDERGROUND (UNO) ELECTRICAL AND COMMUNICATION SYSTEMS PATHWAY</div> <div><div>OHE</div>OVERHEAD ELECTRICAL AND COMMUNICATION SYSTEMS PATHWAY</div>					
SECURITY SYMBOLOGY							
<div><div></div>DOOR POSITION SWITCH</div> <div><div></div>COMBINATION ELECTRIC DOOR STRIKE AND POSITION SWITCH</div> <div><div><div>R</div>P</div>PROXIMITY CARD READER</div> <div><div><div>R</div>K</div>PROXIMITY CARD READER WITH KEYPAD</div> <div><div></div>DUAL TECHNOLOGY MOTION DETECTOR</div> <div><div></div>REQUEST TO EXIT MOTION DETECTOR</div> <div><div></div>REQUEST TO EXIT PUSH BUTTON</div> <div><div></div>GGLASS BREAK DETECTOR</div> <div><div><div>PTZ</div>PAN/TILT/ZOOM WHEN INDICATED</div></div> <div><div></div>SECSECURITY EQUIPMENT CABINET</div> <div><div></div>RREMOTE KEYPAD/CONTROL STATION</div>							




PROJECT MANAGER L. NOLAN		
CIVIL ENG	J. KNOLL	
WATER ENG	L. CHENG	
STRUCTURAL ENG	M. HIJAZI	
ELECTRICAL ENG	I. RINCON	
INSTR. ENG	M.HUTSON	
PROJECT NUMBER 10172116		
7/2022	BID SET	
ISSUE	DATE	DESCRIPTION


PROJECT MANAGER L. NOLAN	
CIVIL ENG	J. KNOLL
WATER ENG	L. CHENG
STRUCTURAL ENG	M. HIJAZI
ELECTRICAL ENG	I. RINCON
INSTR. ENG	M.HUTSON
PROJECT NUMBER 10172116	



ELECTRICAL LEGEND 2		FILENAME	E1-02.dwg	SHEET	E1-02
		SCALE	AS NOTED		

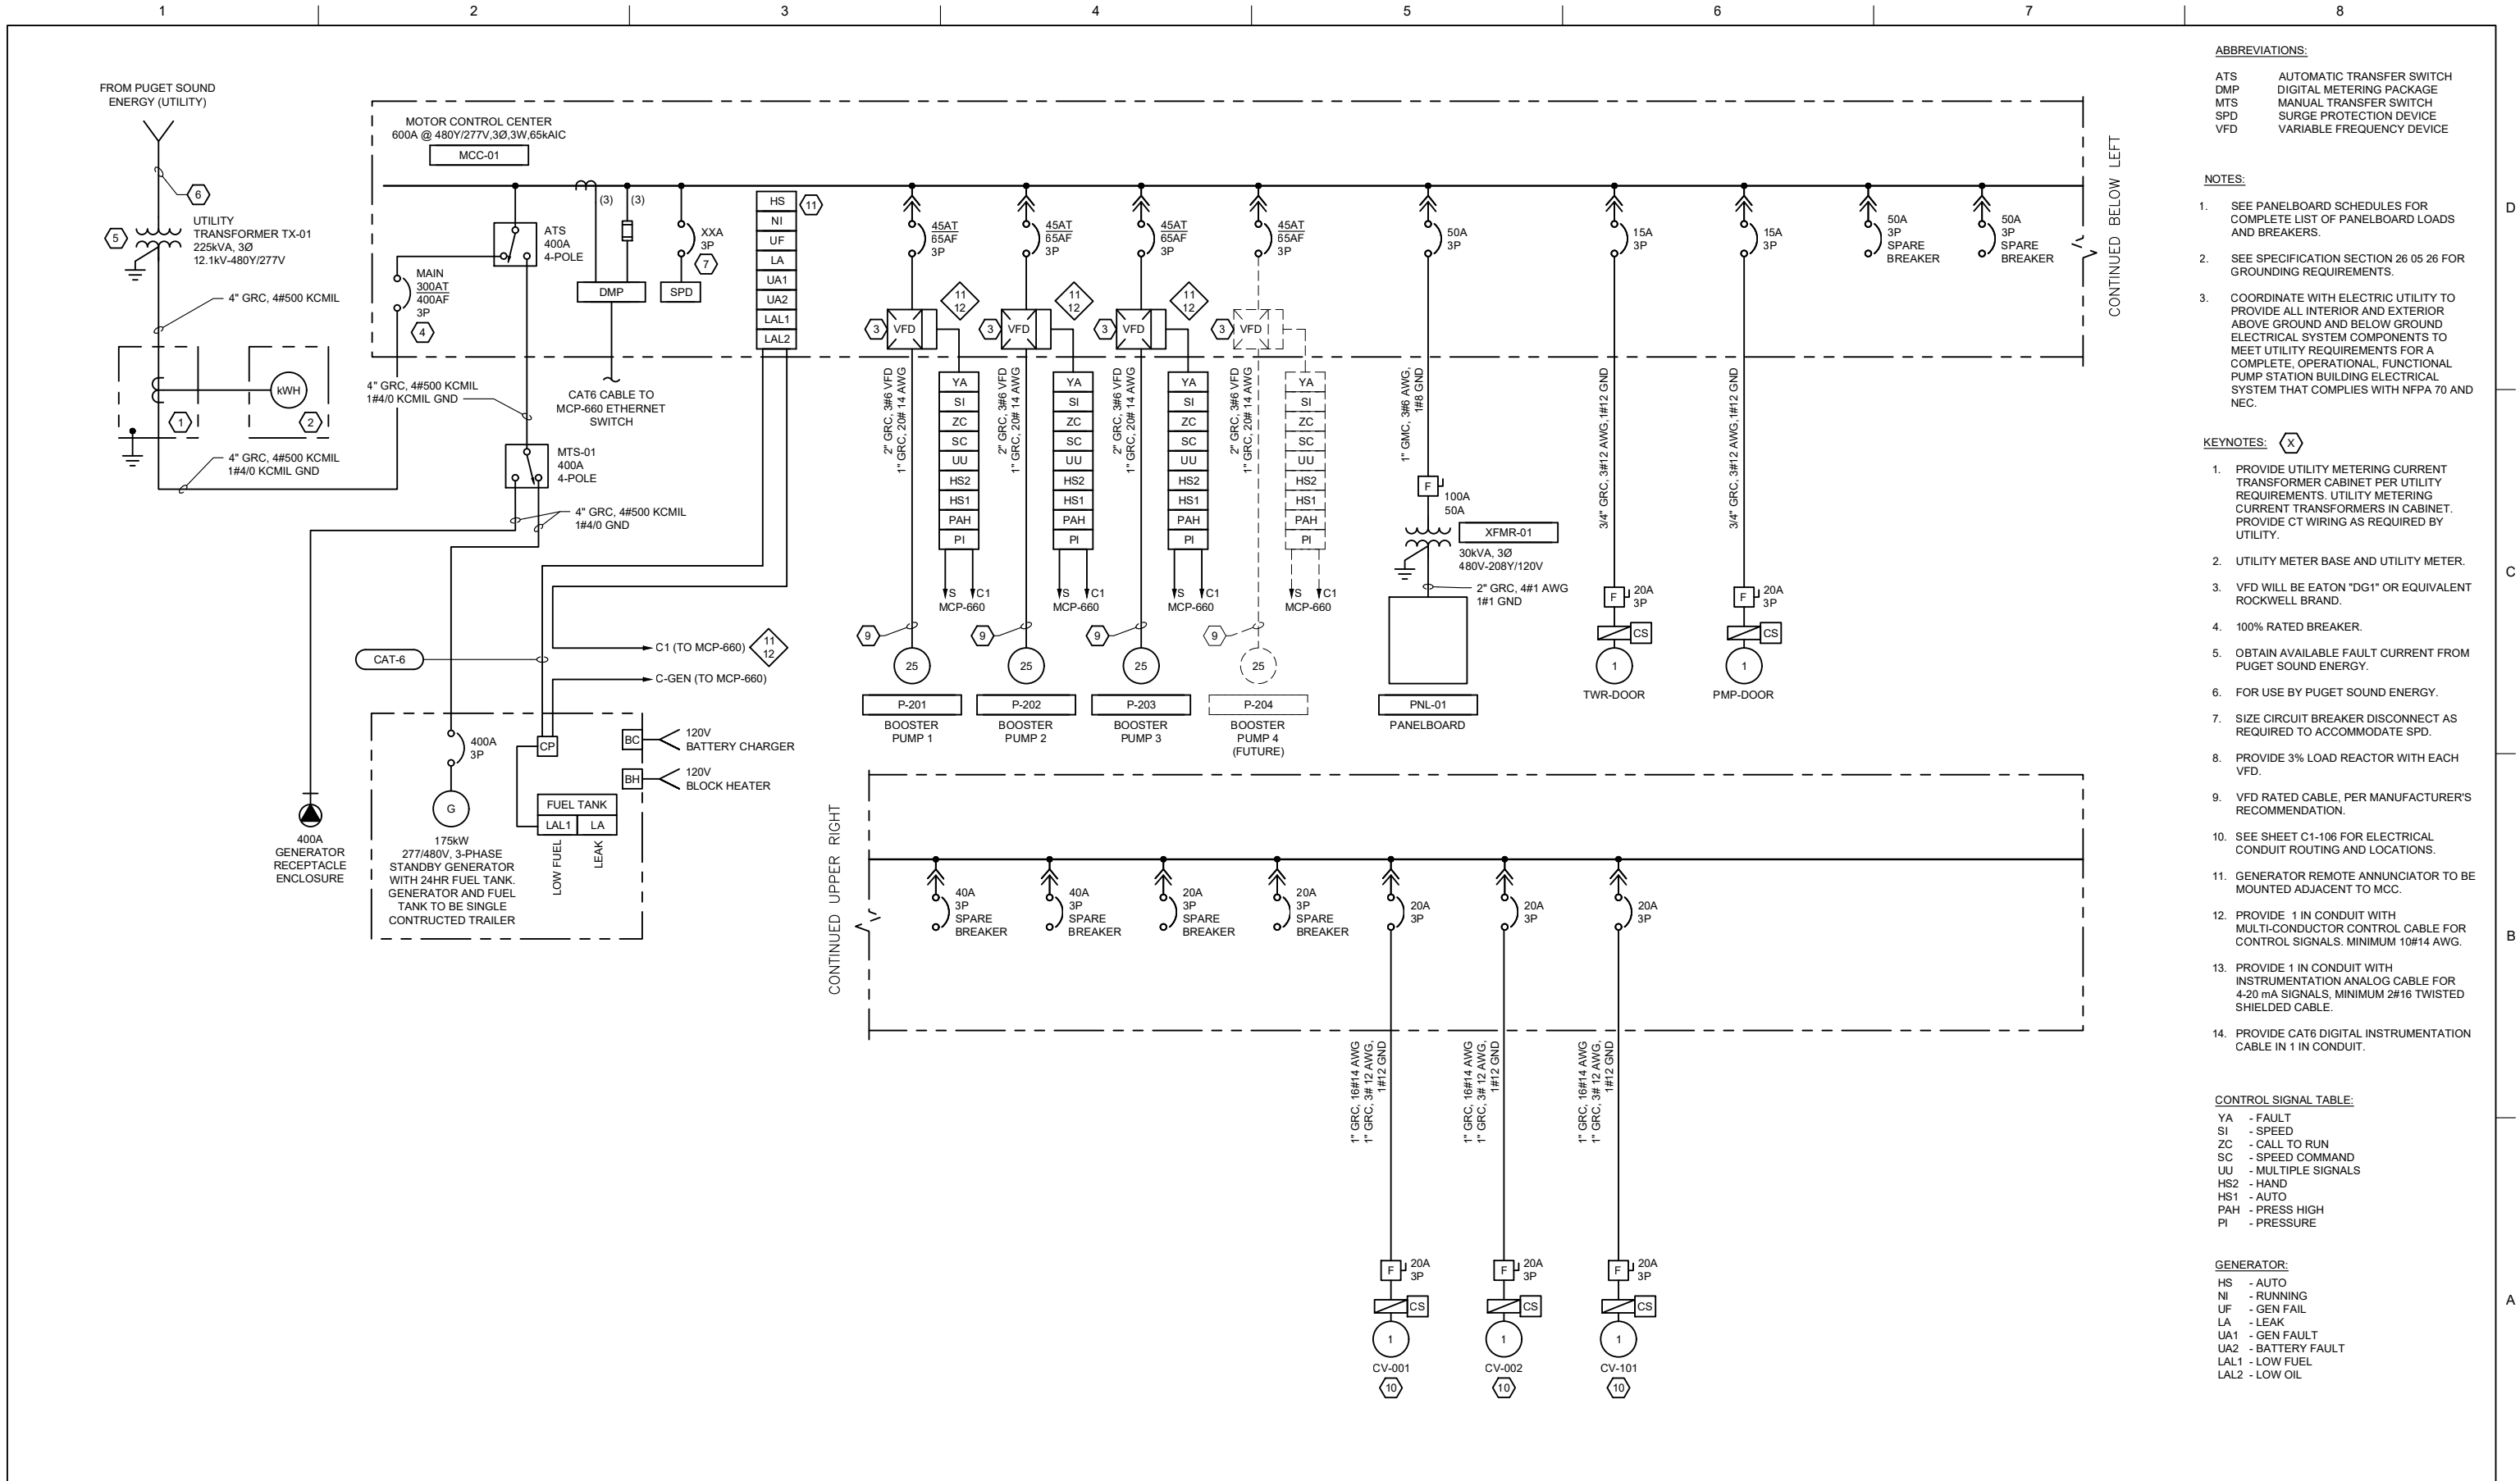


PROJECT MANAGER	L. NOLAN
CIVIL ENG	J. KNOLL
WATER ENG	L. CHENG
STRUCTURAL ENG	M. HIJAZI
ELECTRICAL ENG	I. RINCON
INSTR. ENG	M. HUTSON
PROJECT NUMBER	10172116

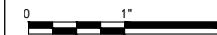

ONE-LINE DIAGRAM

FILENAME E1-03.dwg
SCALE AS NOTED


SHEET
E1-03

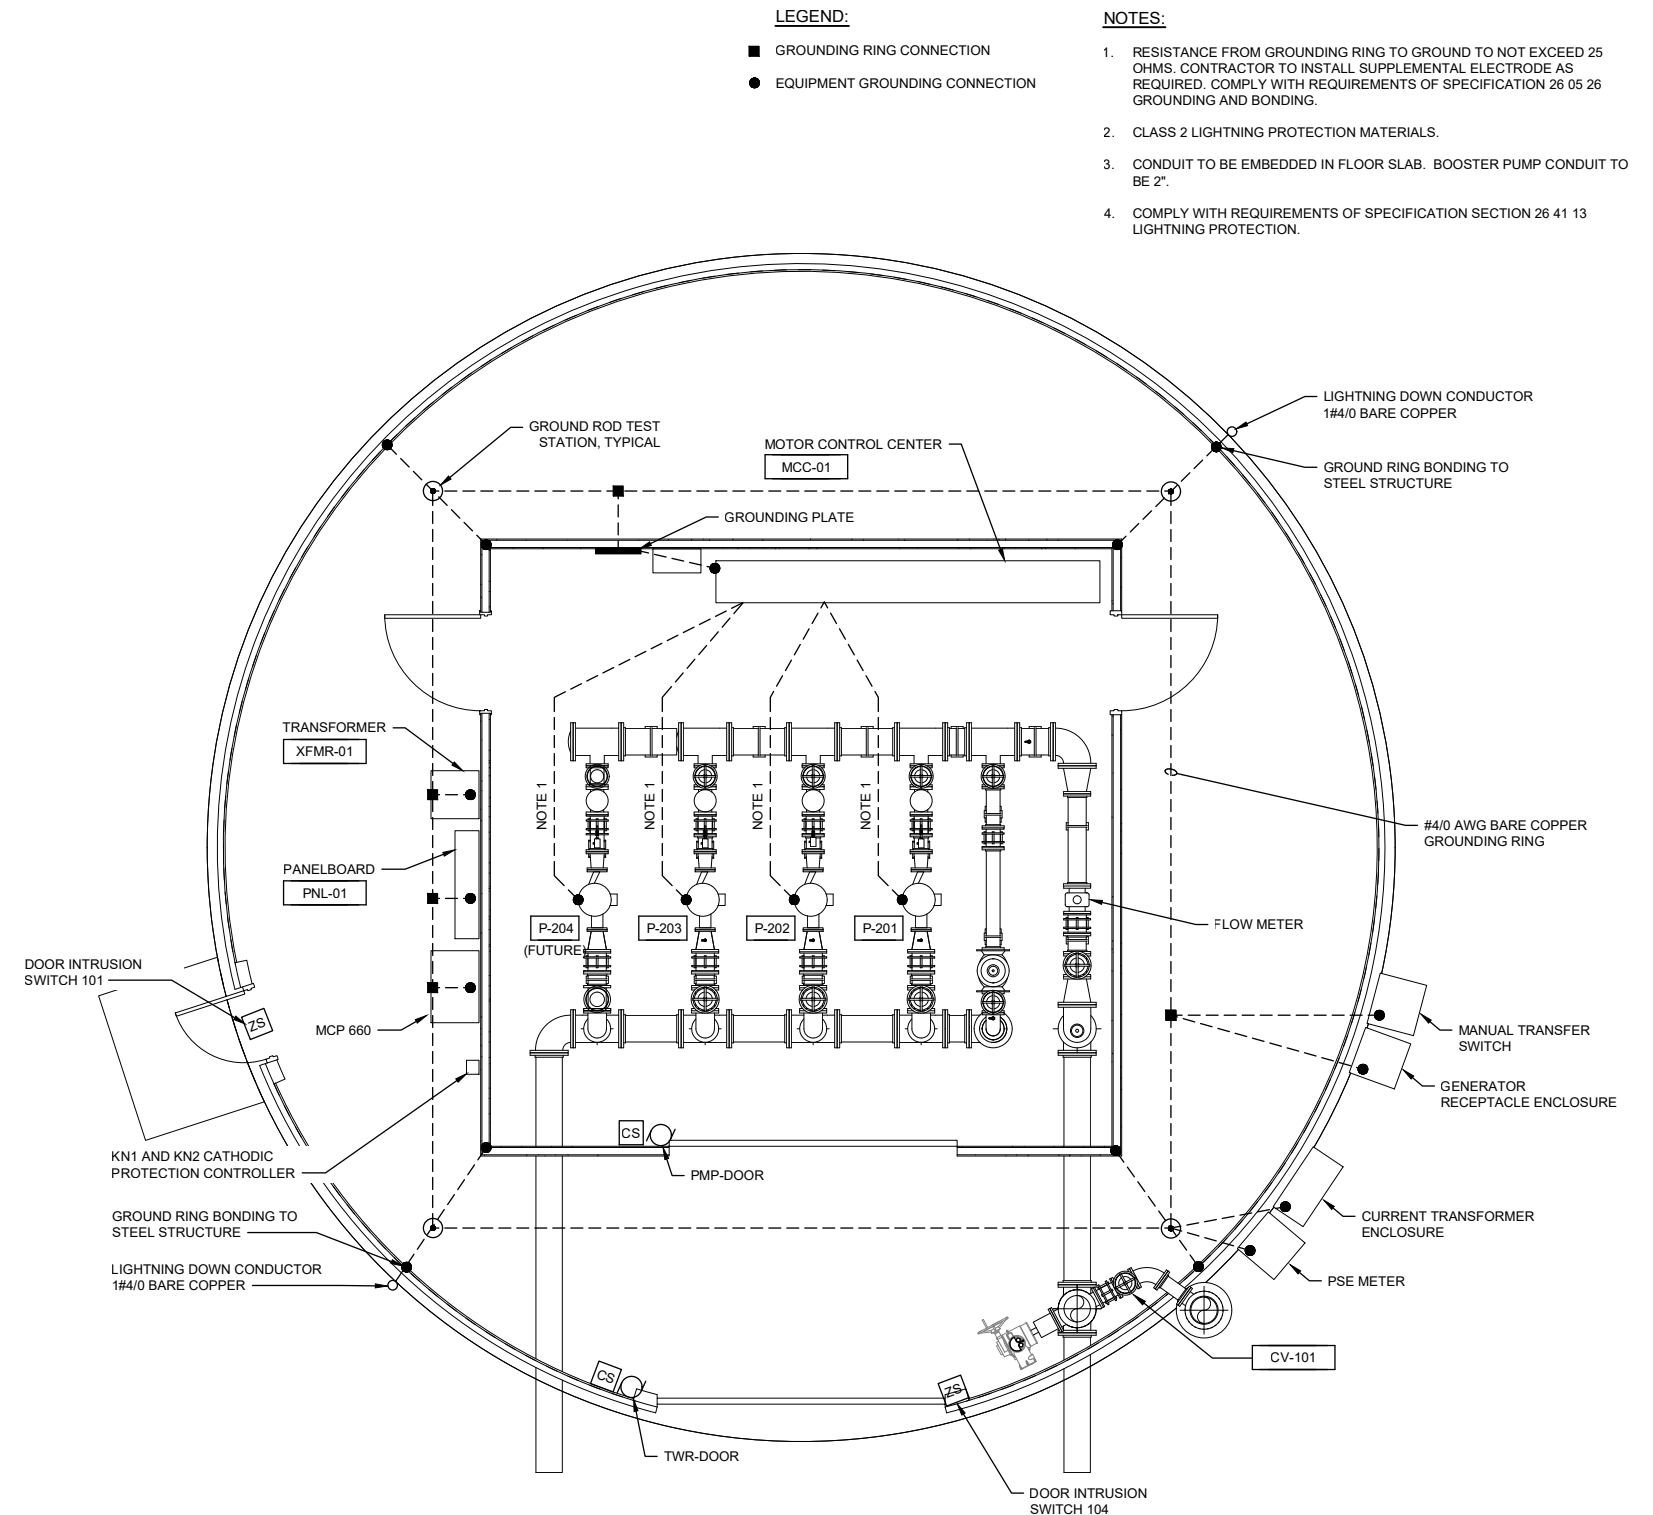

CALL 48 HOURS
BEFORE YOU DIG
1-800-424-5555



			PROJECT MANAGER		L. NOLAN
			CIVIL ENG	J. KNOLL	
			WATER ENG	L. CHENG	
			STRUCTURAL ENG	M. HIJAZI	
			ELECTRICAL ENG	I. RINCON	
			INSTR. ENG	M. HUTSON	
7/2022			BID SET		
ISSUE	DATE	DESCRIPTION	PROJECT NUMBER	10172116	

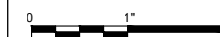

PUMP STATION GROUNDING AND LIGHTNING PROTECTION PLAN

FILENAME	E1-05.dwg
SCALE	AS NOTED

E1-05

NAME: MCC-01

VOLTAGE: 480

PHASE: 3

WIRE: 3

HERTZ: 60

NEUTRAL BUS: NO

GROUND BUS: NO

MAIN BREAKER SIZE: 300

MINIMUM BUS SIZE: 600 AMPS

65kA

FAULT CURRENT BRACING: IC

AMPS, RMS SYMMETRICAL

LOCATION: ELECTRICAL BLDG

FED FROM: Utility Transformer

FEED (OCPD SIZE): 600

ENCLOSURE TYPE: NEMA 1

ASSET NUMBER	EQUIPMENT NAME OR LOAD DESCRIPTION	CONNECTED LOAD											LOAD TYPE	LTG	RCPT	MOTOR	HVAC	MISC	LARGEST MOTOR
		LOAD SIZE	LOAD UNIT	VOLT	PH	HP	AMPS	Working=1 Standby=0	Demand Factor	Effic.	p.f.	KVA							
P-201	BOOSTER PUMP-1 (LARGEST MOTOR 1.25%)*	25	HP	480	3	25.0	34.0	1.0	0.9	0.9	0.9	20.7	LM	0.0	0.0	0.0	0.0	0.0	20.7
P-202	BOOSTER PUMP-2	25	HP	480	3	25.0	34.0	1.0	0.9	0.9	0.9	20.7	M	0.0	0.0	20.7	0.0	0.0	0.0
P-203	BOOSTER PUMP-3	25	HP	480	3	25.0	34.0	1.0	0.9	0.9	0.9	20.7	M	0.0	0.0	20.7	0.0	0.0	0.0
P-204	BOOSTER PUMP-4 (FUTURE)	25	HP	480	3	25.0	34.0	1.0	0.9	0.9	0.9	20.7	M	0.0	0.0	20.7	0.0	0.0	0.0
XFMR-01	XFMR-01 30KVA	30	KVA	480	3	0.0	36.1	1.0	0.8	0.9	0.9	26.7	L	26.7	0.0	0.0	0.0	0.0	0.0
CV-101	CV-101 MOV	1	HP	480	3	1.0	2.1	1.0	0.3	0.75	0.9	0.3	M	0.0	0.0	0.3	0.0	0.0	0.0
CV-001	CV-001 MOV	1	HP	480	3	1.0	2.1	1.0	0.3	0.75	0.9	0.3	M	0.0	0.0	0.3	0.0	0.0	0.0
CV-002	CV-002 MOV	1	HP	480	3	1.0	2.1	1.0	0.3	0.75	0.9	0.3	M	0.0	0.0	0.3	0.0	0.0	0.0
TWR-DOOR	TWR-DOOR	1	HP	480	3	1.0	2.1	1.0	0.3	0.75	0.9	0.3	M	0.0	0.0	0.3	0.0	0.0	0.0
PMP-DOOR	PMP-DOOR	1	HP	480	3	1.0	2.1	1.0	0.3	0.75	0.9	0.3	M	0.0	0.0	0.3	0.0	0.0	0.0
					3	0.0	0.0	1.0	0.3	0.75	0.9	0.0	M	0.0	0.0	0.0	0.0	0.0	0.0
Connected Totals:														26.67	0.00	63.82	0.00	0.00	20.72

MCC-01 LOAD CALCULATION:									
CONNECTED KVA					METHOD				
TOTAL EXISTING (E) LOAD FROM 30 DAY									
METER RECORDING, PER NEC (2017) 220.87:	E				ALL @		1.25		0
TOTAL LIGHTING (L) LOAD:	L		26.67		ALL @		100%		26.67
TOTAL RECEPTACLE (R) LOAD:	R		0.00		FIRST 10KVA @		100%		0.00
					REMAINDER OVER 10KVA		50%		0.00
TOTAL MOTOR (M) LOAD:	M		63.82		ALL @		100%		63.82
					125% OF LARGEST		125%		25.90
TOTAL HVAC (H) LOAD:	H		0.00		ALL @		100%		0.00
TOTAL MISCELLANEOUS (X) LOAD:	X		0.00		ALL @		100%		0.00
TOTAL KVA:			111.21	KVA				116.39	KVA
AVERAGE AMPS @	480 volts		133.77	AMP S					140.00 AMPS

PANELBOARD SCHEDULE: PNL-01												
VOLTAGE: 208/120		BUS AMPACITY: 125A					LOCATION: EXTERIOR PUMP HOUSE				MAIN BREAKER: YES	
PHASE: 3 ϕ		NEUTRAL AMPACITY: 100%					POWERED FROM: XFMR EQUIPMENT TAG				MAIN LUGS ONLY: NO	
WIRE: 4-WIRE		MAIN BREAKER AMPS: 100A					FED FROM: BOTTOM				FED-THRU LUGS: NO	
AIC RATING: 10KAIC							FEEDER ENTRY: BOTTOM				DOUBLE LUGS: NO	
CIRCUIT DESCRIPTION		LOAD TYPE	LOAD (KVA)	CB AMPS	CB POLE	PHASE	CB POLE	CB AMPS	LOAD (KVA)	LOAD TYPE	CIRCUIT DESCRIPTION	
1	LIGHTING - INDOOR	L	0.11	20	1	A	1	20	1.30	R	RECEPTACLE - INDOOR	2
3	LIGHTING - OUTDOOR	L	0.35	20	1	B	1	20	0.72	R	RECEPTACLE - OUTDOOR	4
5	LIGHTING - TANK ACCESS	L	0.14	20	1	C	1	20	0.72	R	RECEPTACLE - TANK ACCESS	6
7	MCP-660 PLC UPS	Z	0.24	20	1	A	1	20	0.05	Z	CATHODIC PROTECTION UNIT	8
9	MCP-660 PLC	Z	0.24	20	1	B	1	20	1.92	Z	GEN BATTERY CHARGER	10
11	EXIT LIGHT CHARGER	L	0.20	20	1	C	1	20	1.92	Z	GEN BLOCK HEATER	12
13	EXHAUST FAN	M	0.60	20	1	A	1	20	6.66	Z	EUH-101	14
15					1	B	1	20	6.66	Z		16
17					1	C	1	20	6.66	Z		18
19					1	A	1					20
21					1	B	1					22
23					1	C	1					24
25					1	A	1					26
27					1	B	1					28
29					1	C	1					30
31						A						32
33						B						34
35						C						36

LOAD TYPE CODE AND DESCRIPTION	CONNECTED LOAD (KVA)			NEC DEMAND FACTOR	CALCULATED LOAD (KVA)			
	A	B	C		A	B	C	TOTAL
H = HVAC	0.00	0.00	0.00	1.00	0.00	0.00	0.00	0.00
K = KITCHEN EQUIPMENT	0.00	0.00	0.00	1.00	0.00	0.00	0.00	0.00
L = LIGHTING	0.11	0.35	0.34	1.25	0.14	0.44	0.42	0.99
LM = LARGEST MOTOR LOAD	0.00	0.00	0.00	1.25	0.00	0.00	0.00	0.00
M = MOTORS AND COMPRESSORS	0.60	0.00	0.00	1.00	0.60	0.00	0.00	0.60
R = GENERAL-USE RECEPTACLES <= 10 KVA	1.30	0.72	0.72	1.00	1.30	0.72	0.72	2.74
R = GENERAL-USE RECEPTACLES > 10 KVA	0.00	0.00	0.00	0.50	0.00	0.00	0.00	0.00
S = SPECIFIC-USE RECEPTACLES	0.00	0.00	0.00	1.00	0.00	0.00	0.00	0.00
Z = MISCELLANEOUS AND APPLIANCES	6.95	8.82	8.58	1.00	6.95	8.82	8.58	24.35
CALCULATED LOAD TOTAL (KVA):					8.99	9.98	9.72	28.68
CALCULATED LOAD TOTAL (AMPS):					10.81	12.00	11.69	34.50

CALL 48 HOURS BEFORE YOU DIG
1-800-424-5555



7/2022	BID SET	
ISSUE	DATE	DESCRIPTION


PROJECT MANAGER		L. NOLAN
CIVIL ENG	J. KNOLL	
WATER ENG	L. CHENG	
STRUCTURAL ENG	M. HIJAZI	
ELECTRICAL ENG	I. RINCON	
INSTR. ENG	M. HUTSON	
PROJECT NUMBER		10172116





MCCORMICK
CLOSE TO WHAT COUNTS

PORT ORCHARD 660 RESERVOIR

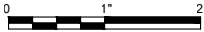


ELECTRICAL LOAD SCHEDULES

FILENAME	E1-06.dwg
SCALE	AS NOTED




HEET

E1-07

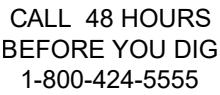



**CALL 48 HOURS
BEFORE YOU DIG
1-800-424-5555**

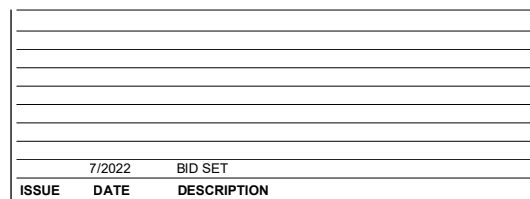


PROJECT MANAGER	L. NOLAN
CIVIL ENG	J. KNOLL
WATER ENG	L. CHENG
STRUCTURAL ENG	M. HIJAZI
ELECTRICAL ENG	I. RINCON
INSTR. ENG	M. HUTSON
PROJECT NUMBER	10172116



FILENAME	E1-09.dwg
SCALE	AS NOTED

E1-09

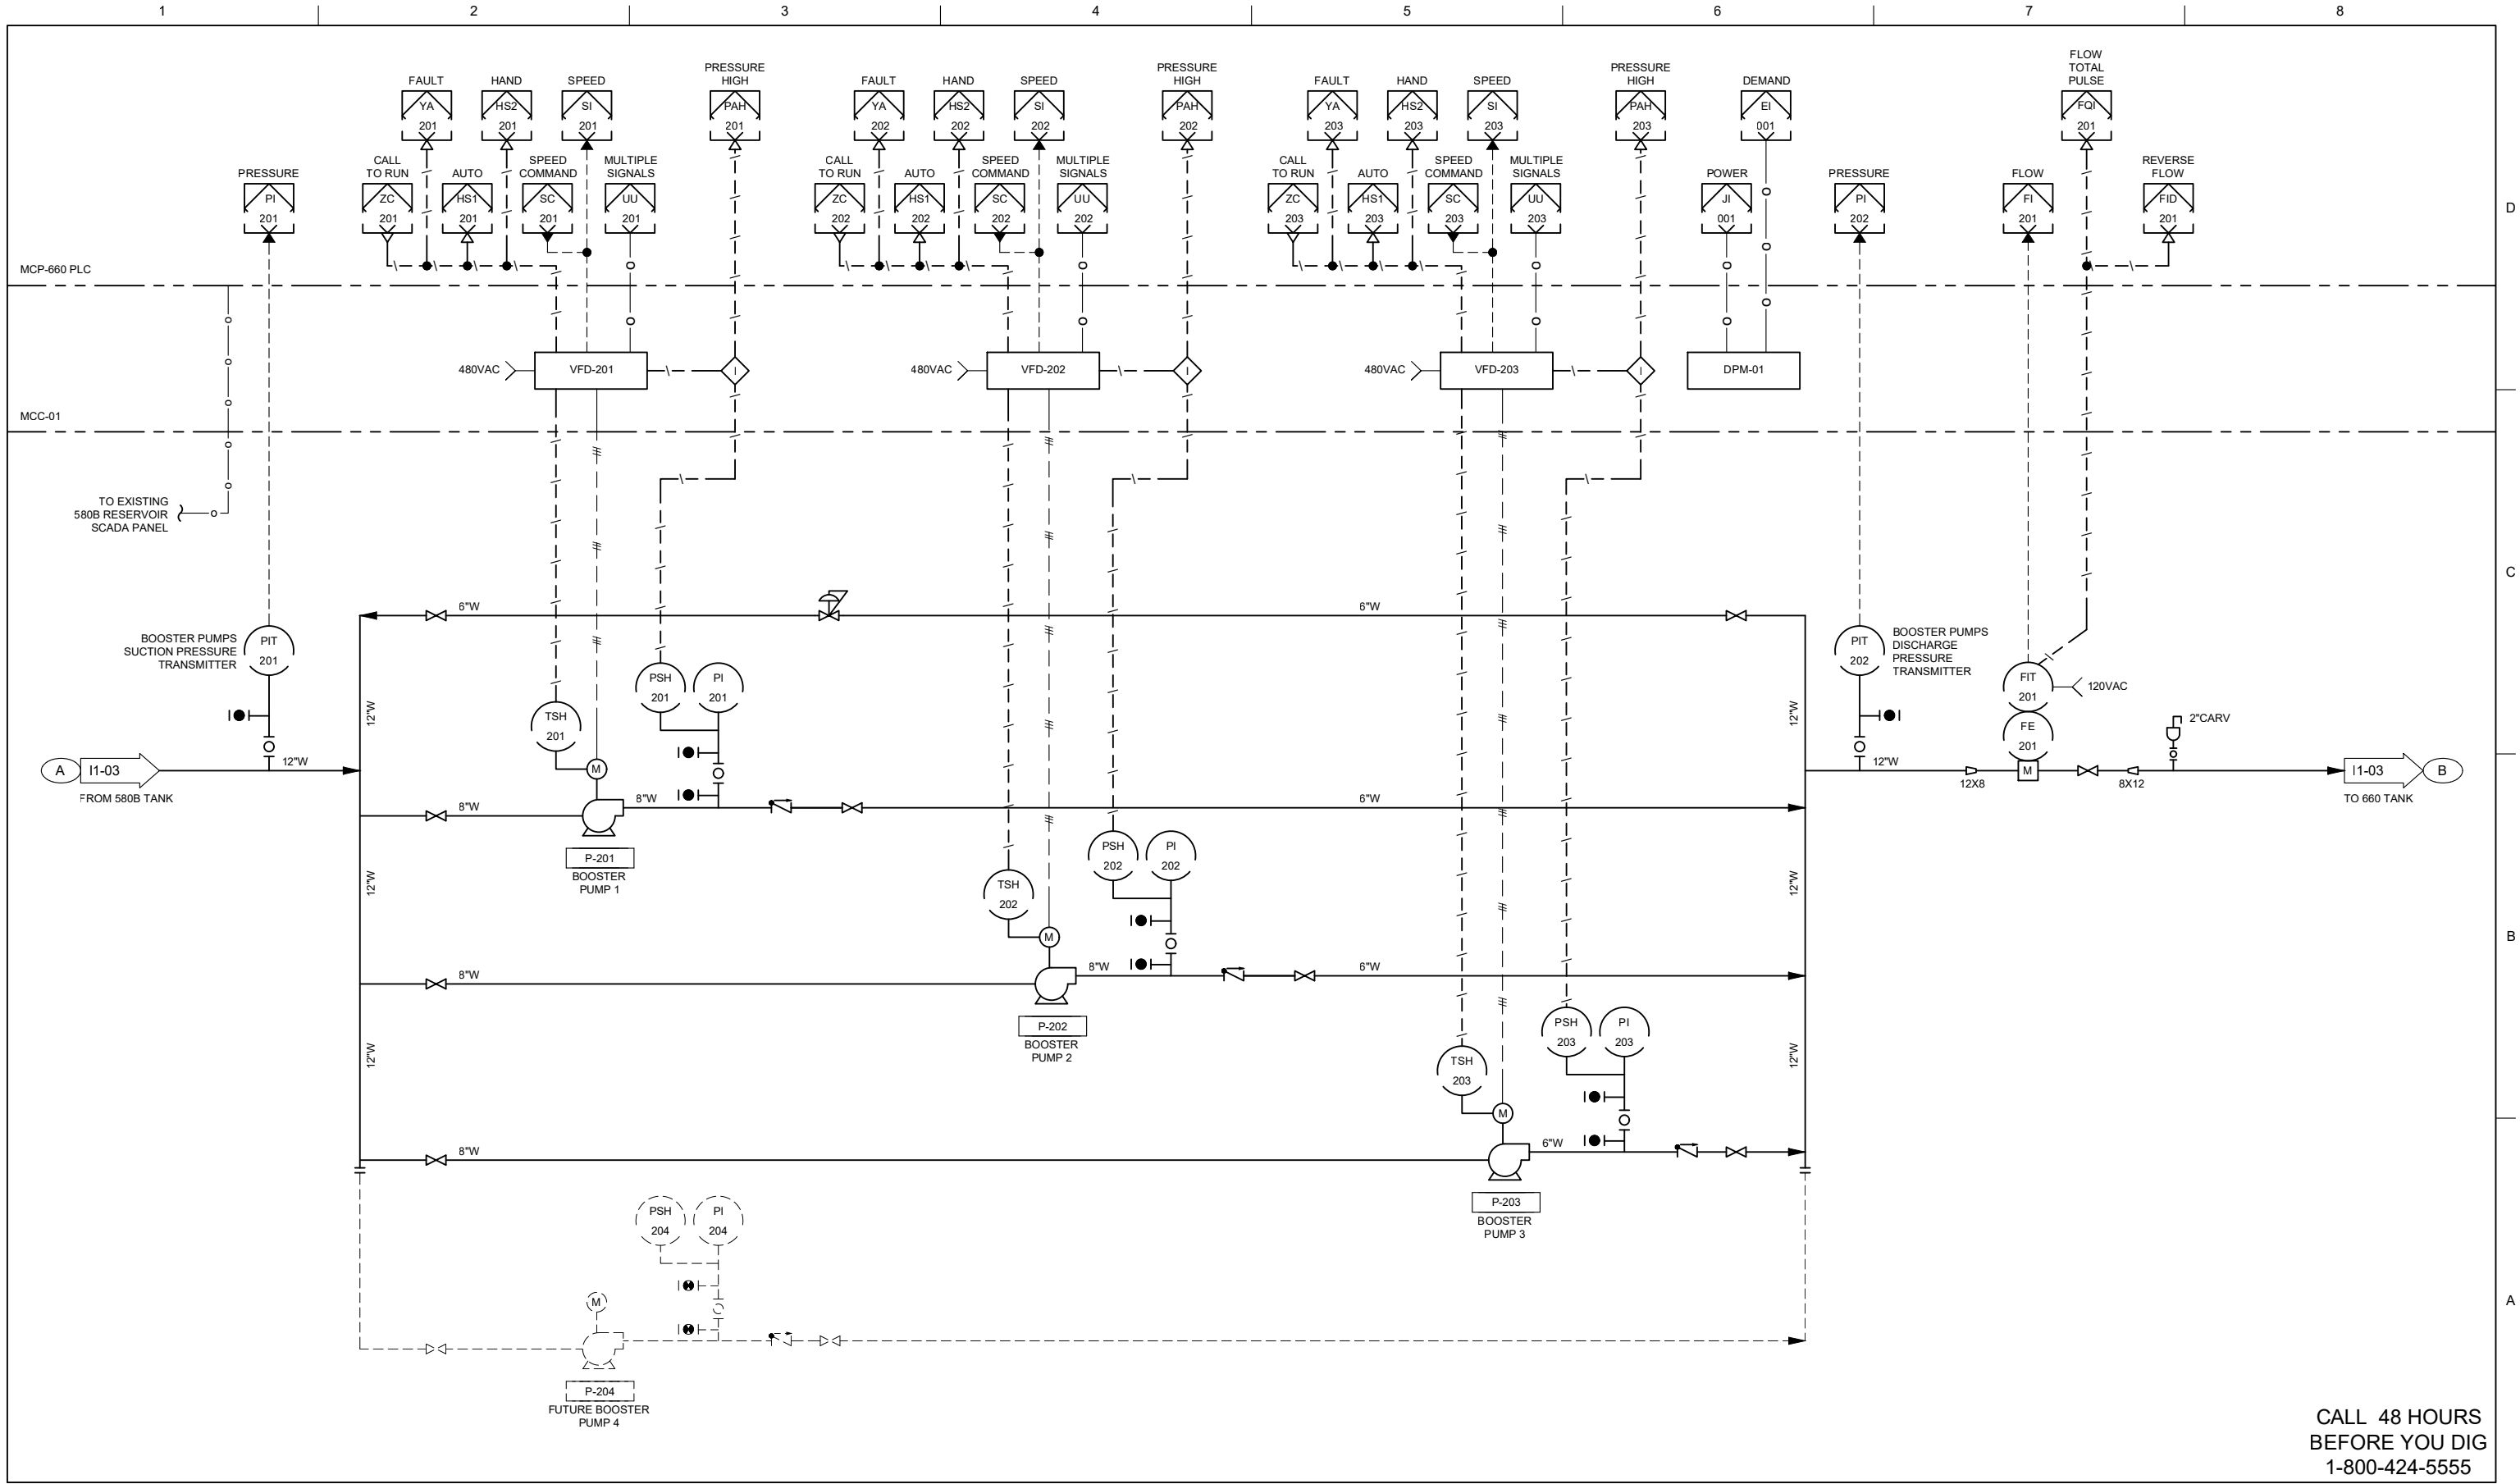


CALL 48 HOURS
BEFORE YOU DIG
1-800-424-5555



7/2022 BID SET		
ISSUE	DATE	DESCRIPTION


PROJECT MANAGER		L. NOLAN
CIVIL ENG.	J. KNOLL	
WATER ENG.	L. CHENG	
STRUCTURAL ENG.	M. HIJAZI	
ELECTRICAL ENG.	I. RINCON	
INSTR. ENG.	M. HUTSON	
PROJECT NUMBER		10172116

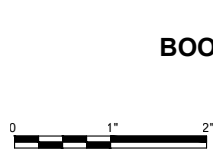

P&ID
BOOSTER PUMP STATION

FILENAME | 11-02.dwg
SCALE | AS NOTED

SHEET
11-02

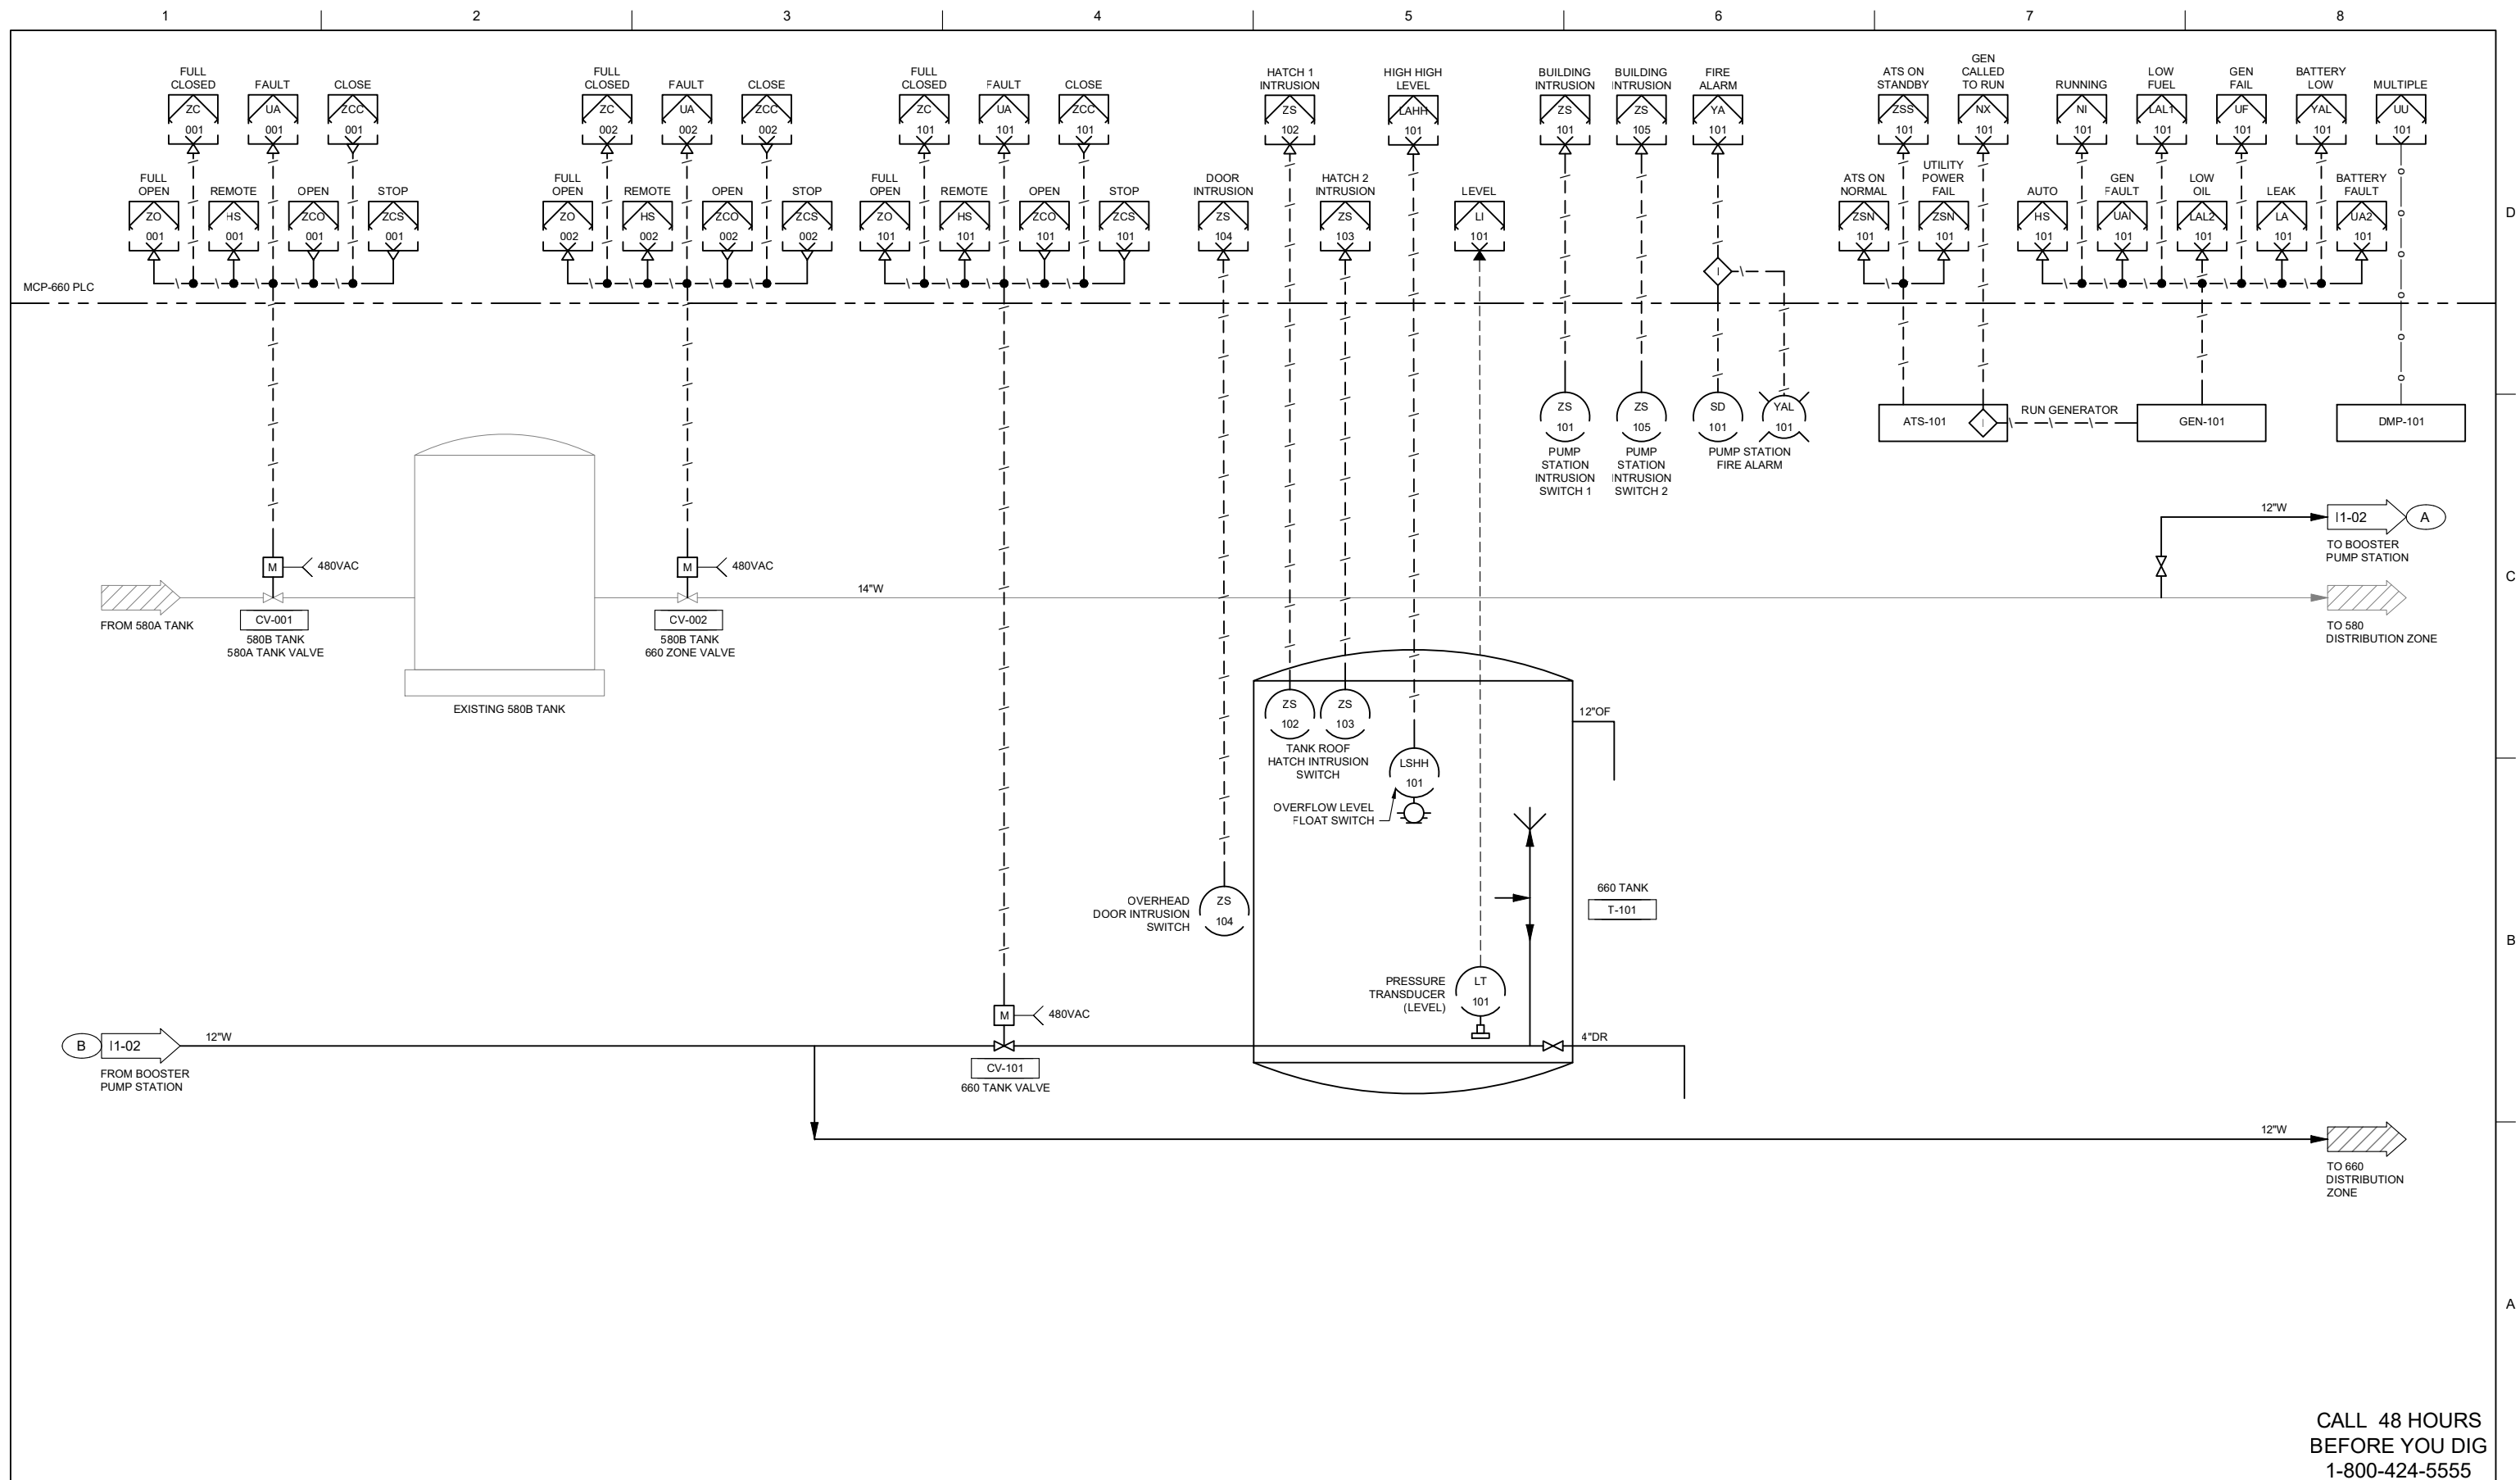

CALL 48 HOURS
BEFORE YOU DIG
1-800-424-5555

[illegible]


PROJECT MANAGER	L. NOLAN
CIVIL ENG	J. KNOLL
WATER ENG	L. CHENG
STRUCTURAL ENG	M. HIJAZI
ELECTRICAL ENG	I. RINCON
INSTR. ENG	M. HUTSON
PROJECT NUMBER	10172116




P&ID	
660 TANK	
FILENAME	I1-03.dwg
SCALE	AS NOTED

SHEET


I1-03

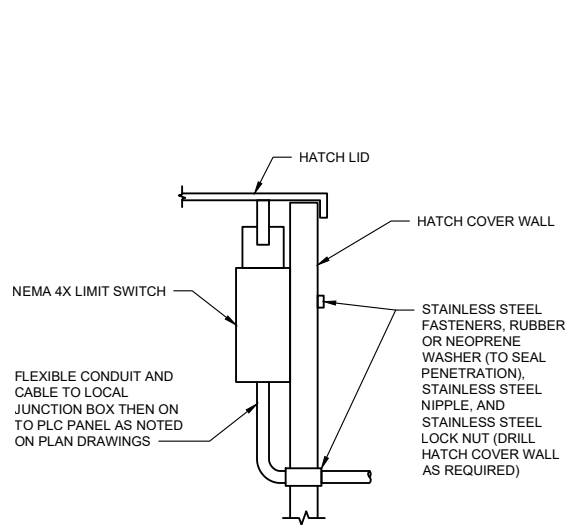


HATCH INTRUSION SWITCH
SCALE: N.T.S.

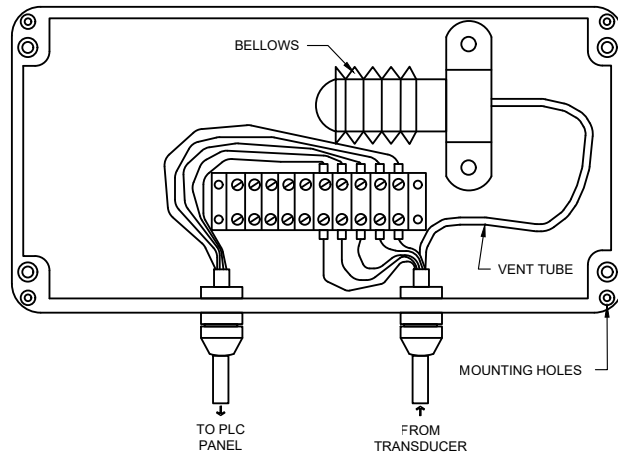

KPSI LEVEL TRANSDUCER BELLOWS JUNCTION BOX PN 845
SCALE: N.T.S.

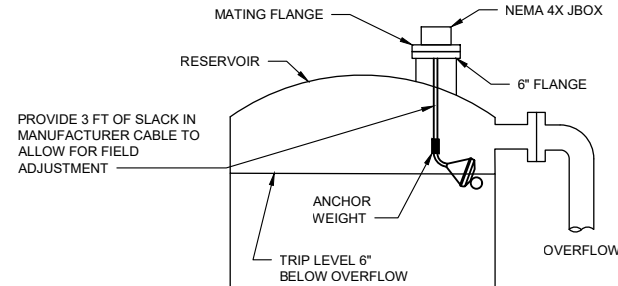


RESERVOIR FLOAT SWITCH INSTALLATION
SCALE: N.T.S.

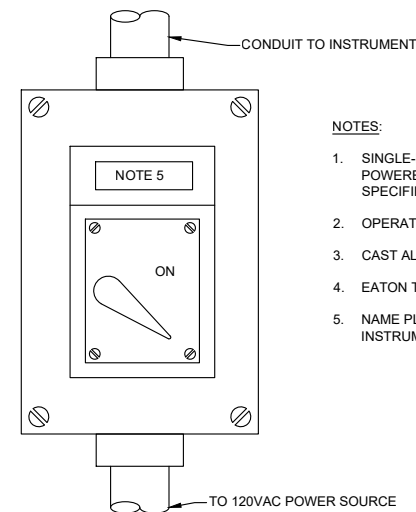


SINGLE-PHASE DISCONNECT
SCALE: N.T.S.

- NOTES:**
1. SINGLE-PHASE, MANUAL SWITCH REQUIRED FOR POWERED INSTRUMENT, UNLESS OTHERWISE SPECIFIED
 2. OPERATING HANDLE PAD-LOCKABLE IN OFF POSITION
 3. CAST ALUMINUM NEMA 4X, WATERPROOF ENCLOSURE
 4. EATON TYPE MS, OR EQUAL
 5. NAME PLATE ATTACHED SECURELY. ENGRAVED WITH INSTRUMENT TAG NUMBER

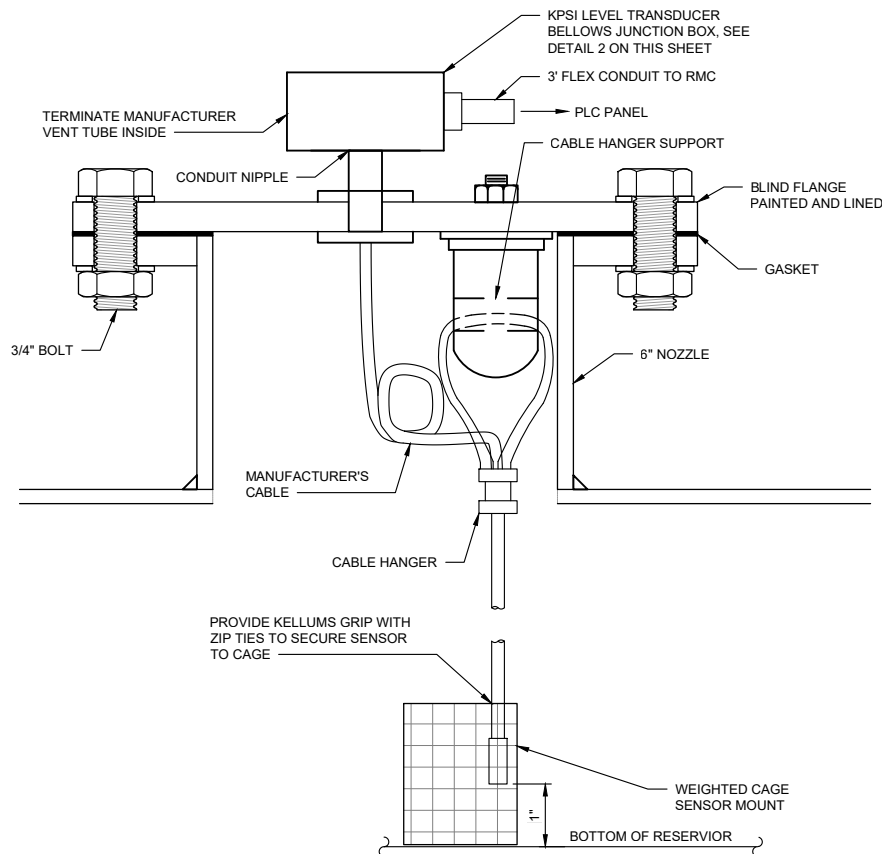


LEVEL SENSOR MOUNTING DETAILS
SCALE: N.T.S.

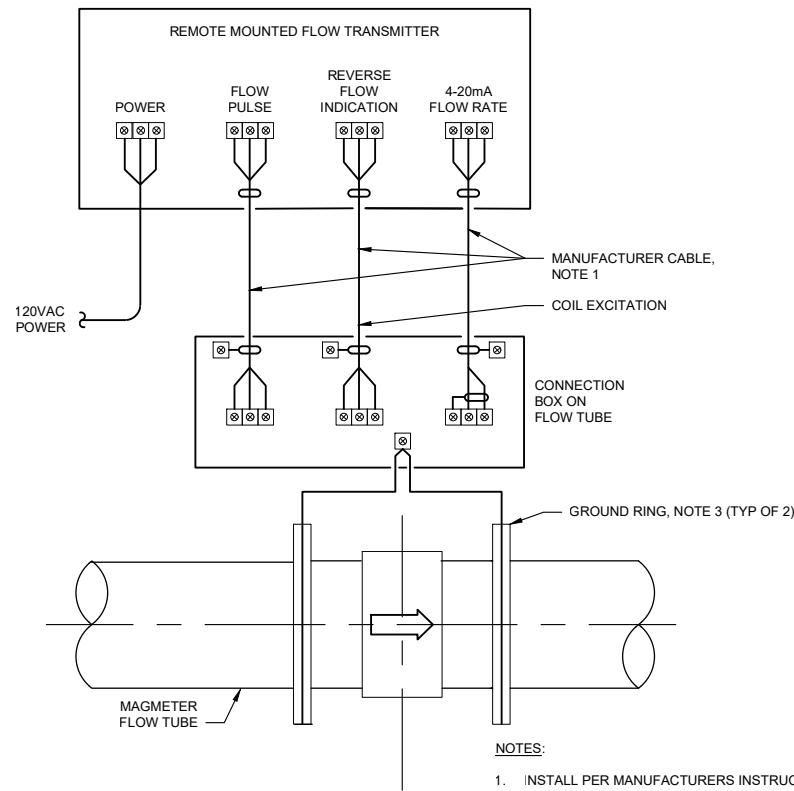

MAGNETIC FLOW METER FLOW TUBE INSTALLATION
SCALE: N.T.S.

- NOTES:**
1. INSTALL PER MANUFACTURERS INSTRUCTIONS.
 2. METER REGISTER TO INCLUDE CUSTODY TRANSFER OPTION.

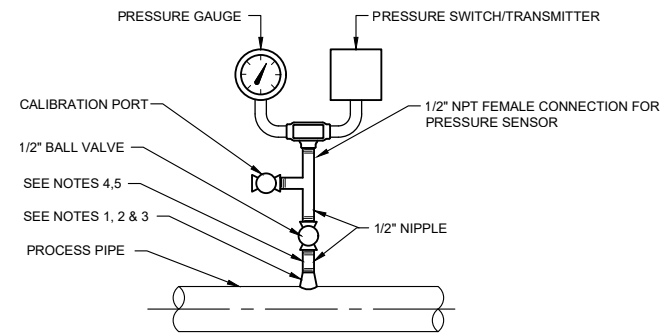


- NOTES:**
1. FOR PIPE 2 1/2" AND SMALLER, USE A BUSHING IN A TEE.
 2. FOR DI AND PVC ALL SIZES, USE PIPE SADDLE W/ BUSHING.
 3. FOR STL, AND SST PIPES 3" AND LARGER, AND PRESSURE VESSELS. USE SHOP INSTALLED THREAD-O-LET, OR EQUAL AS SHOWN.
 4. PROVIDE 1/2" TEE WITH BALL VALVE FOR AIR RELEASE FOR PRESSURE SWITCH/PRESSURE GAUGE ASSEMBLY ONLY.
 5. AIR RELEASE VALVE SHALL BE MINIMUM 3" ABOVE THE TOP OF THE ASSOCIATED PUMP VOLUTE.
 6. TYPICAL FOR INSTALLATIONS WITH EITHER PRESSURE GAUGE, PRESSURE SWITCH/TRANSMITTER OR BOTH.

PRESSURE GAUGE AND PRESSURE SWITCH/TRANSMITTER
SCALE: N.T.S.




PROJECT MANAGER	L. NOLAN
CIVIL ENG	J. KNOLL
WATER ENG	L. CHENG
STRUCTURAL ENG	M. HIJAZI
ELECTRICAL ENG	I. RINCON
INSTR. ENG	M. HUTSON
PROJECT NUMBER	10172116

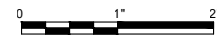

FILENAME | 11-04.dwg
SCALE | AS NOTED

SHEET
11-04

INSTRUMENTATION DETAILS

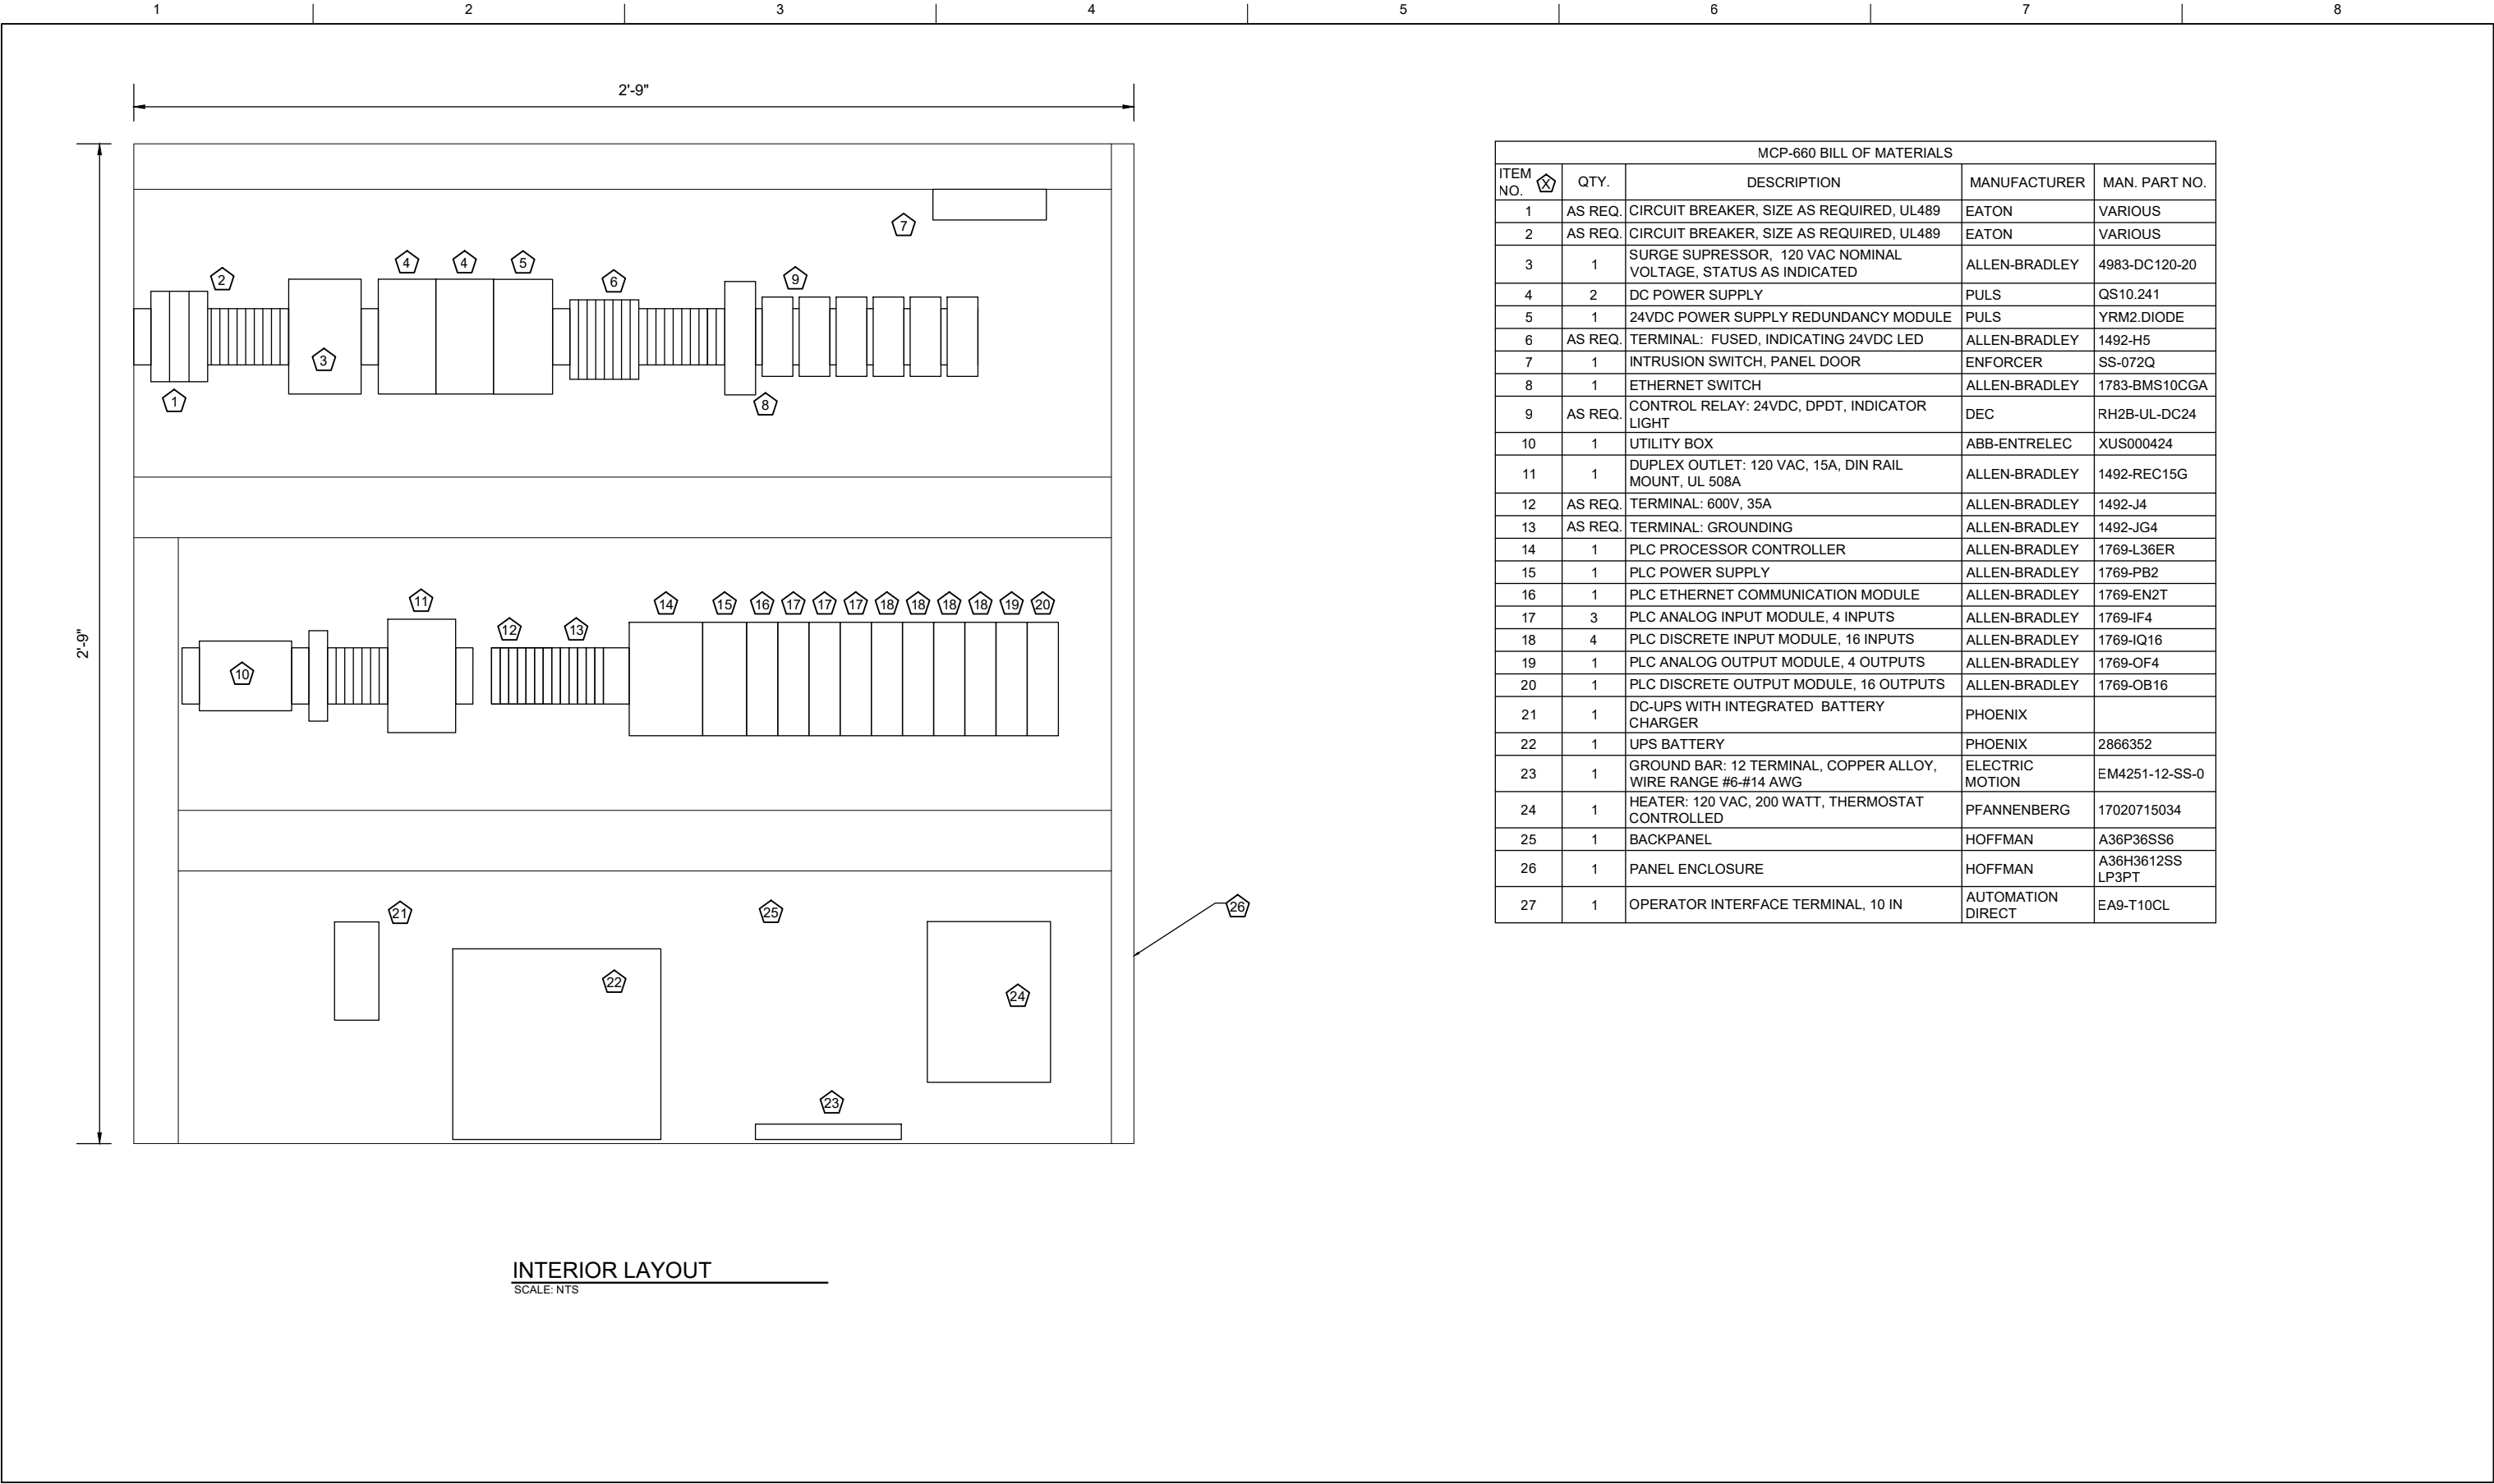

MCP-660 BILL OF MATERIALS				
ITEM NO.	QTY.	DESCRIPTION	MANUFACTURER	MAN. PART NO.
1	AS REQ.	CIRCUIT BREAKER, SIZE AS REQUIRED, UL489	EATON	VARIOUS
2	AS REQ.	CIRCUIT BREAKER, SIZE AS REQUIRED, UL489	EATON	VARIOUS
3	1	SURGE SUPPRESSOR, 120 VAC NOMINAL VOLTAGE, STATUS AS INDICATED	ALLEN-BRADLEY	4983-DC120-20
4	2	DC POWER SUPPLY	PULS	QS10.241
5	1	24VDC POWER SUPPLY REDUNDANCY MODULE	PULS	YRM2.DIODE
6	AS REQ.	TERMINAL: FUSED, INDICATING 24VDC LED	ALLEN-BRADLEY	1492-H5
7	1	INTRUSION SWITCH, PANEL DOOR	ENFORCER	SS-072Q
8	1	ETHERNET SWITCH	ALLEN-BRADLEY	1783-BMS10CGA
9	AS REQ.	CONTROL RELAY: 24VDC, DPDT, INDICATOR LIGHT	DEC	RH2B-UL-DC24
10	1	UTILITY BOX	ABB-ENTRELEC	XUS000424
11	1	DUPLEX OUTLET: 120 VAC, 15A, DIN RAIL MOUNT, UL 508A	ALLEN-BRADLEY	1492-REC15G
12	AS REQ.	TERMINAL: 600V, 35A	ALLEN-BRADLEY	1492-J4
13	AS REQ.	TERMINAL: GROUNDING	ALLEN-BRADLEY	1492-JG4
14	1	PLC PROCESSOR CONTROLLER	ALLEN-BRADLEY	1769-L36ER
15	1	PLC POWER SUPPLY	ALLEN-BRADLEY	1769-PB2
16	1	PLC ETHERNET COMMUNICATION MODULE	ALLEN-BRADLEY	1769-EN2T
17	3	PLC ANALOG INPUT MODULE, 4 INPUTS	ALLEN-BRADLEY	1769-IF4
18	4	PLC DISCRETE INPUT MODULE, 16 INPUTS	ALLEN-BRADLEY	1769-IQ16
19	1	PLC ANALOG OUTPUT MODULE, 4 OUTPUTS	ALLEN-BRADLEY	1769-OF4
20	1	PLC DISCRETE OUTPUT MODULE, 16 OUTPUTS	ALLEN-BRADLEY	1769-OB16
21	1	DC-UPS WITH INTEGRATED BATTERY CHARGER	PHOENIX	
22	1	UPS BATTERY	PHOENIX	2866352
23	1	GROUND BAR: 12 TERMINAL, COPPER ALLOY, WIRE RANGE #6-#14 AWG	ELECTRIC MOTION	EM4251-12-SS-0
24	1	HEATER: 120 VAC, 200 WATT, THERMOSTAT CONTROLLED	PFANNENBERG	17020715034
25	1	BACKPANEL	HOFFMAN	A36P36SS6
26	1	PANEL ENCLOSURE	HOFFMAN	A36H3612SS LP3PT
27	1	OPERATOR INTERFACE TERMINAL, 10 IN	AUTOMATION DIRECT	EA9-T10CL

INTERIOR LAYOUT
SCALE: NTS



7/2022	BID SET	
ISSUE	DATE	DESCRIPTION

PROJECT MANAGER		L. NOLAN
CIVIL ENG	J. KNOLL	
WATER ENG	L. CHENG	
STRUCTURAL ENG	M. HIJAZI	
ELECTRICAL ENG	I. RINCON	
INSTR. ENG	M. HUTSON	
PROJECT NUMBER		10172116






MCCORMICK
CLOSE TO WHAT COUNTS

PORT ORCHARD 660 RESERVOIR

CONTROL PANEL LAYOUT
AND BILL OF MATERIALS

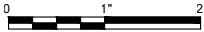

FILENAME	11-05.dwg
SCALE	AS NOTED

SCHEDULE B

GENERAL

G1. Scope

The notes on in this section apply to the elevated reservoir and its foundation.

G2. Applicable specifications and codes

- A. 2015 International Building Code (IBC)
- B. ASCE 7-10, Minimum Design Loads for Buildings and other Structures
- C. ACI 318-14, Building code requirements for structural concrete
- D. AISC Steel Construction Manual, 14th Edition
- E. AISC 341-10, Seismic design manual
- F. AWWA D100-21

G3. Design criteria

(LOCATION: 4607 SW OLD CLIFTON ROAD, PORT ORCHARD, WA 98367)

- A. DEAD LOAD
1. SUPERIMPOSED DEAD LOAD 8 PSF
- B. ROOF LIVE LOAD 25 PSF
- C. WIND LOAD
1. WIND SPEED 85 MPH
2. AWWA D100-21, WIND EXPOSURE B
3. AWWA D100-21, WIND IMPORTANCE FACTOR (I) 1.15
4. AWWA D100-21, GUST FACTOR, G 1.00
5. FORCE COEFFICIENT, CF 1.00
- D. SNOW LOAD
1. AWWA D100-21, GROUND SNOW LOAD 27 PSF
2. EXPOSURE FACTOR, CE= 1.0
3. THERMAL FACTOR, CT= 1.0
4. IMPORTANCE FACTOR Is = 1.2
- E. SEISMIC LOAD:
1. AWWA SEISMIC USE GROUP III
2. SHORT PERIOD RESPONSE ACCELERATION Ss: 1.626
3. LONG PERIOD RESPONSE ACCELERATION S1: 0.567
4. SOIL SITE CLASSC
- Fa: 1.0
- Fv: 1.3
- Sds: 1.08
5. IMPULSIVE RESPONSE MODIFICATION FACTOR Ri = 3.0
6. CONVECTIVE RESPONSE MODIFICATION FACTOR Rc = 1.5
7. SEISMIC IMPORTANCE FACTOR Ie = 1.5

G4. Geotechnical design criteria

1. Allowable Bearing Capacity Under Foundation 8,000 PSF
2. Frost Depth 12"
3. Reference Geotechnical Report by Riley Group dated July 2, 2019 and their letter dated December 14, 2021.

G5. Special inspections

Special Inspections are required in accordance with Chapter 1 and Chapter 17 of the IBC. Payment of these inspections is not the responsibility of T BAILEY, INC but they will provide full access to the work by the Special Inspector per the inspection schedule provided by others. Special Inspections are required for the following items of work:

- Grading, excavation, and back filling
- Concrete testing and placement
- Reinforcing steel placement
- Anchors, embeds, and bolts in concrete
- High strength bolting
- Structural Welding
- Anchor bolt installation

CONCRETE

C1. Design strengths

F'c = 5,000 PSI

Fy = 60,000 PSI

C2. Concrete cover

- Concrete deposited against earth: 3"
- Tie reinforcing at cols: 1 ½"
- All other: 2"

C3. All detailing, fabrication, and erection of reinforcing bars shall be in accordance with the current edition of the ACI manual of standard practice.

C4. Provide ¼" chamfers at all exposed edges and ½" chamfers at joints.

C5. Field adjust reinforcing at openings and embedded items as needed.

C6. Absolutely no welding of reinforcing bars or torching to bend reinforcing without the specific approval of the structural engineer.

C7. All Cast-In-Place anchors shall comply with Chapter 17 of ACI 318 and Chapter 19 of the IBC.

STEEL

S1. Design strengths per design calculations

S2. Dimensions to centerline of column and beams, top surfaces of beams and back of channels and angles.

S3. Elevations noted refer to top surface of member or flange, UNO.

S4. Welding shall conform to AWS Code for arc and gas welding. Welders shall be certified.

S5. Bolts for structural steel connections shall be high strength conforming to ASTM A325. Installation of bolts shall conform to AISC specifications for structural joints.

S6. Conform to AISC 360, Steel Construction Manual and AISC 341, Seismic Design Manual.

DEFERRED SUBMITTALS

DS1. Deferred submittals are those portions of the design which are not submitted at the time of permit application and which are to be submitted to the permitting agency for acceptance prior to installation of the port of the work.

DS2. The following is a list of anticipated deferred submittals for the elevated reservoir and foundation that will be submitted for review prior to installation:

- 1. Ladders, platforms, and handrail systems
- 2. Grating
- 3. Access hatches
- 4. Vents
- 5. Reservoir nozzles and attachments

SPECIAL INSPECTIONS (IBC 1705)

SI1. Special Inspections and structural observations are required in accordance with IBC Chapter 1

and Chapter 17. Payment for these inspections is not he responsibility of T BAILEY, INC.

We

will provide full access to the work by the Special Inspector.

SI2. T BAILEY, INC is an approved AISC Shop Fabricator and will provide a certificate of compliance

stating work was performed in accordance with the approved construction documents.

SI3. The following construction is subject to special inspection:

Schedule of Special Inspection Service			
Inspection Item Required	Frequency		Code Reference
	Continuous	Periodic	
General Structural Observations			
Conduct daily visual observations of the structural systems for general conformance to the construction documents. Prepare weekly report of observations describing work progress and non-conforming items.		X	
Soil & Earthwork			
Verify materials below foundation is adequate to achieve the design bearing capacity.		X	
Verify excavation is extended to proper depth and has reach proper material.		X	
Perform classification and testing of compacted fill materials.		X	Table 1705.06
Verify use of proper materials, densities, and lift thickness during placement and compaction of compacted fill.	X		
Prior to placement of compacted fill, observe subgrade and verify that site has been prepared properly.		X	

Schedule of Special Inspection Service			
Inspection Item Required	Frequency		Code Reference
	Continuous	Periodic	
Concrete and Reinforcing Steel			Table 1705.06
Inspection of reinforcing steel size and placement.		X	ACI 318: Ch.20, 25.2, 25.3, 26.5.1-
Inspection of reinforcing steel welding.		X	AWS D1.4, ACI 318: 26.5.4
Inspection of anchor placement.		X	ACI 318: 17.8.2
Verifying use of required design mix.		X	ACI 318: Ch.19, 26.4.3, 26.4.4
At the time fresh concrete is sampled to fabricate specimens for strength tests, perform slump and aire content tests, and determine temperature of the concrete.	X		A5TM C172 & C31, ACI 318: 26.4.5, 26.12
Inspection of concrete placement for proper application techniques.	X		ACI 318: 26.4.5
Inspection for maintenance of specified curing temperature and techniques.		X	ACI 318: 26.4.7 - 26.4.9
Verify concrete strength		X	ACI 318: 26.10.2
Inspect formwork for shape, location, and dimensions of the concrete member being formed.		X	ACI 318: 26.10.1(b)
Structural Steel			
Verifying fabricator certification		X	
Hold pre-construction meetings with the owner and fabricator to discuss the project, fabrication/erection procedures, and inspection procedures/scheduling.		X	
Inspect /observe fabrication shop and procedures.		X	
Material verification of HS bolts/nuts and manufacturers certificate of compliance.		X	AISC 360: A3.3 and ASTM
Inspection of HS bolting: Snug tight joints.		X	AISC 360: M2.5
Material verification of structural steel for identification markings to conform to AISC 360.			AISC 360: M2.6
Material verification of other steel to conform to ASTM Standards.		X	
Material verification of manufacturers certified test reports.		X	
Material verification of weld filler materials and manufacturers certificate of compliance.		X	
Verify welder certifications.		X	
Visually inspect welds.		X	
Verify radiographic inspection of full penetration welds per design requirements was performed by 3rd party.		X	



REV.	BY	DATE	DESCRIPTION
REVISIONS			

T BAILEY INC.

9628 S March Point Rd.
Anacortes, WA 98221
PH: (360) 293-0682
FAX: (360) 293-3893

Website:
www.TBailey.com



aisc
CERTIFIED
FABRICATOR

The technical information provided on this drawing is the confidential property of T Bailey Inc. Reproduction of this drawing or use of this information for anything other than its limited, intended purpose as to this project, without the written permission of T Bailey Inc., is prohibited.


DRAWN BY: PJ DATE: 06/28/2022 CHK'D BY: DB DATE: 06/28/2022

CUSTOMER: McCORMICK COMMUNITIES, LLC 70'-0" I.D. WATER TANK
PROJECT: PORT ORCHARD 660 RESERVOIR

TITLE: GENERAL STRUCTURAL NOTES

JOB#: 681-01 (HEI: 21-1657) SHT#: S-1



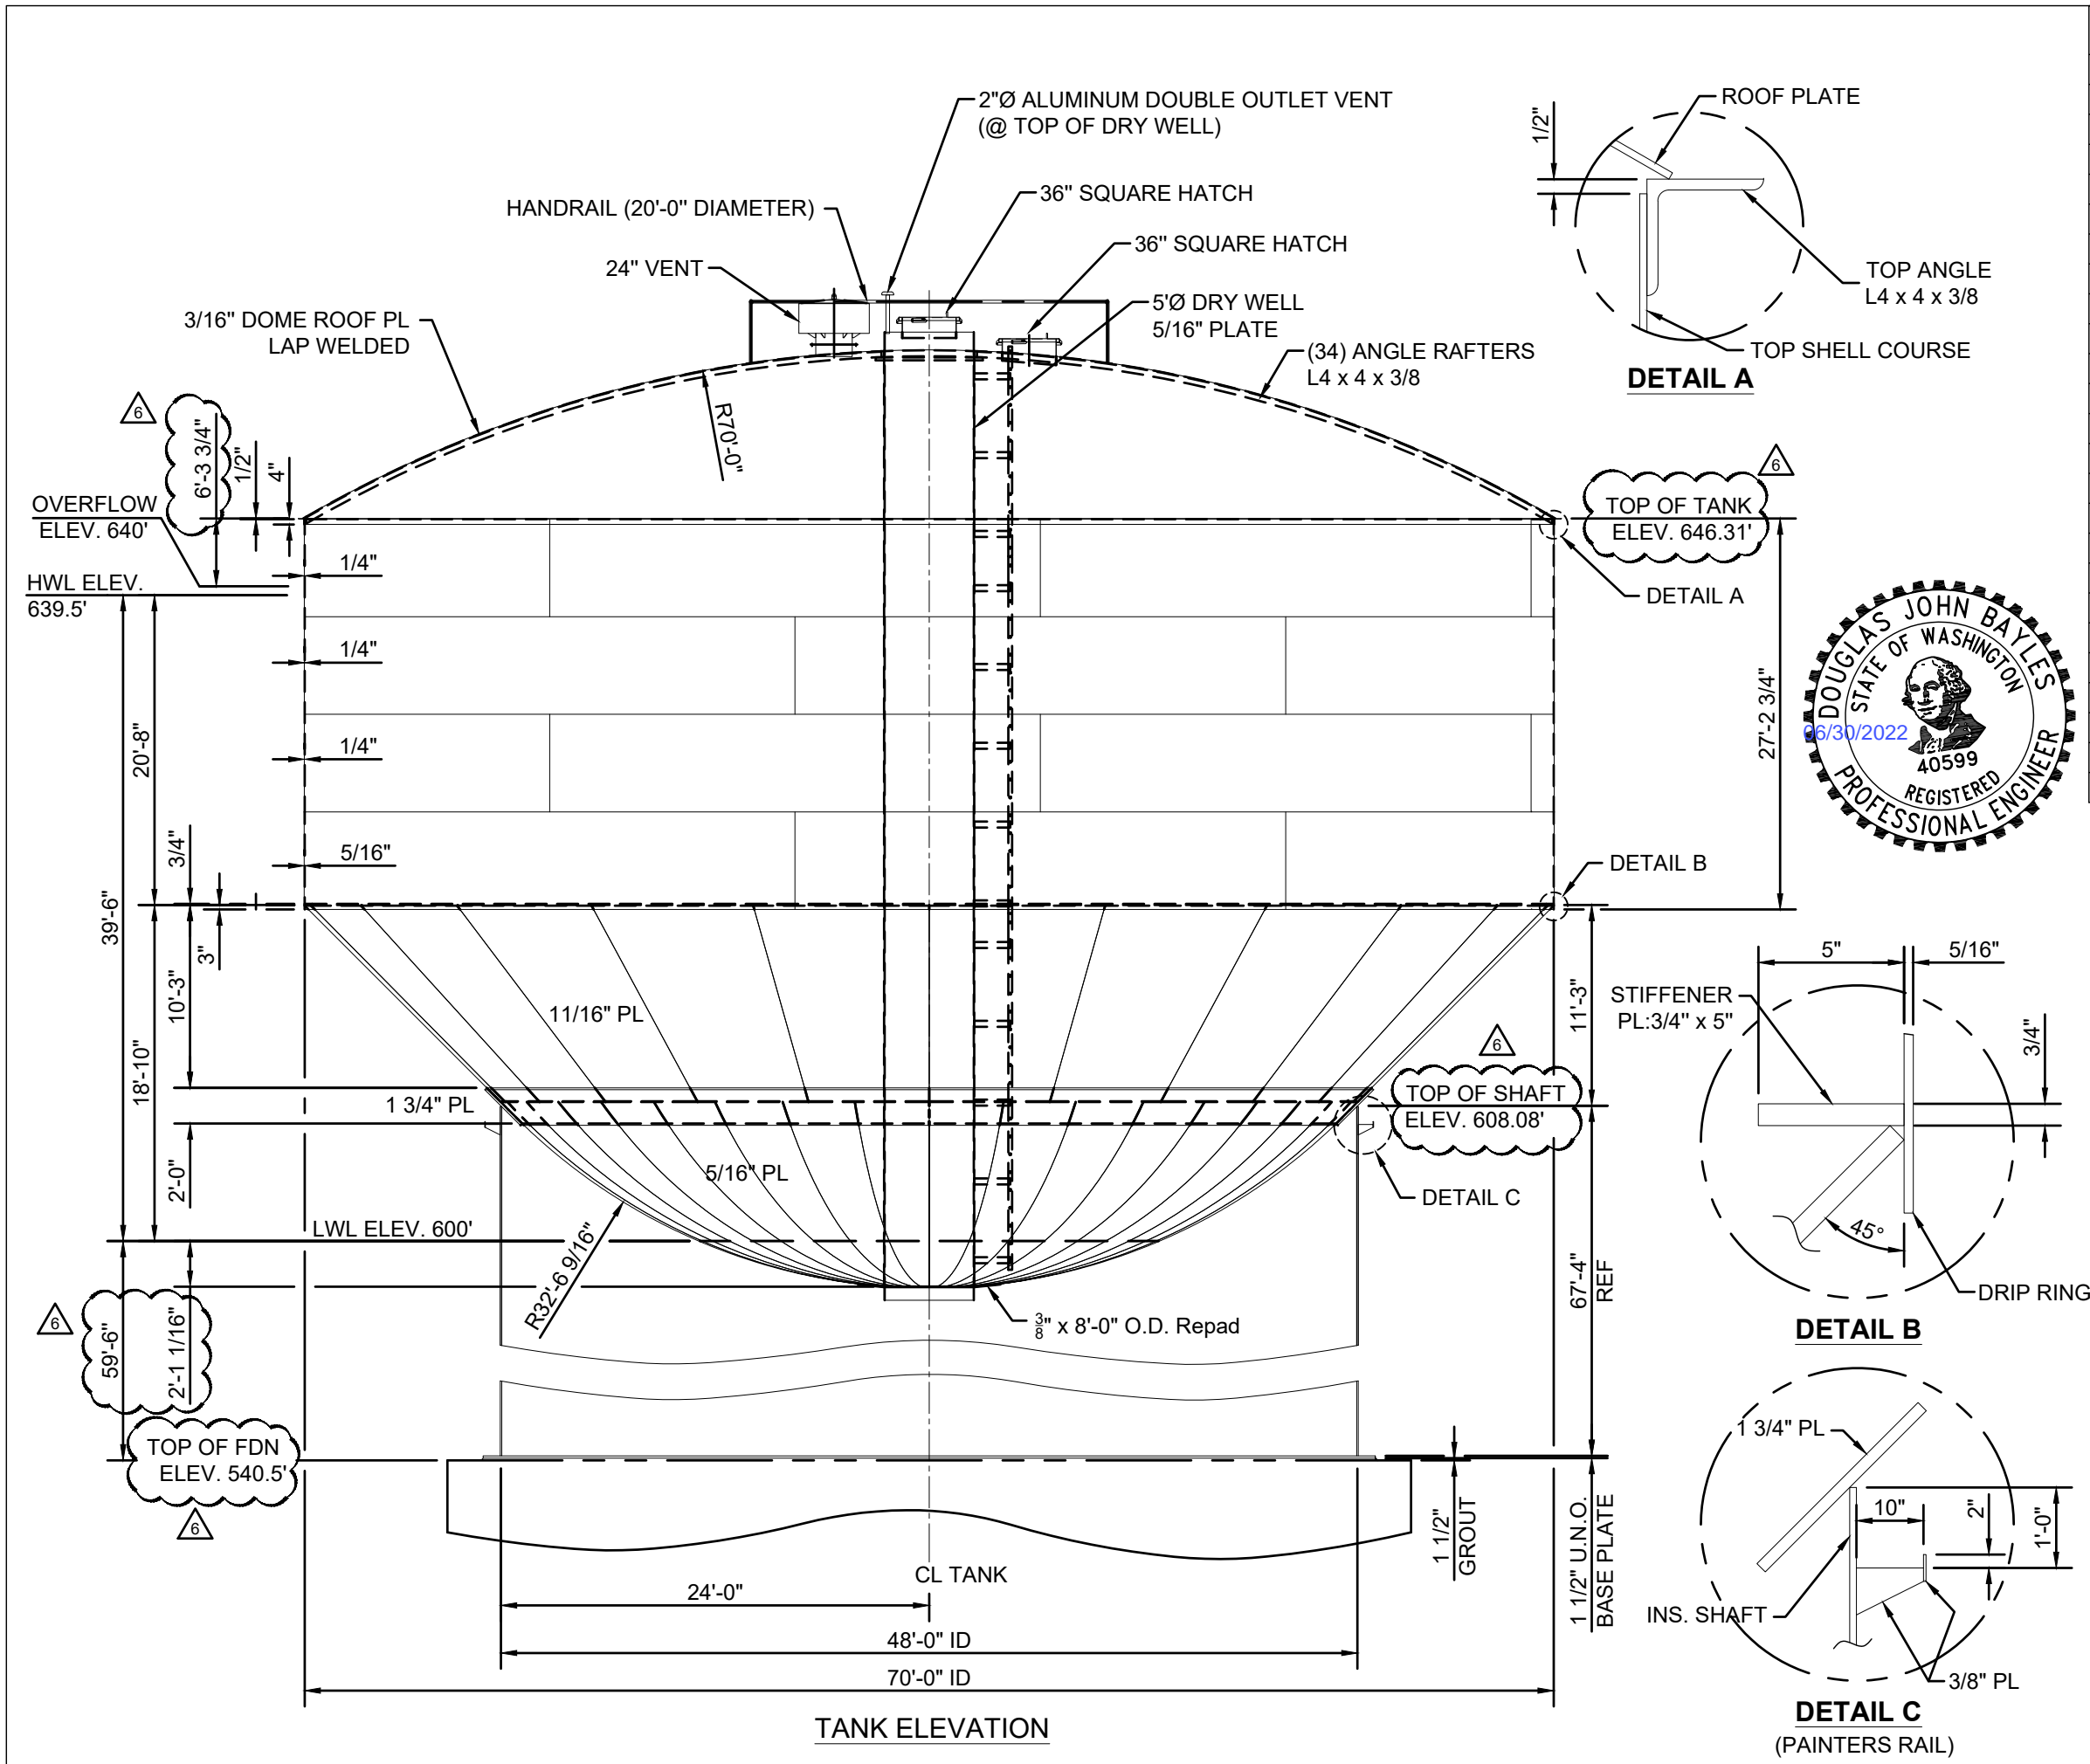

DESIGN INFORMATION			
CODE: AWWA D100-21			
INSIDE DIAMETER: 70'-0"			
HEIGHT: 40'-6"			
DESIGN LIQUID LEVEL: 39'-6"			
NOMINAL CAPACITY: 892,000 GALS			
NET WORK CAPACITY: 885,000 GALS			
PRODUCT: WATER			
DESIGN SPECIFIC GRAVITY: 1.0			
DESIGN PRESSURE: ATMOSPHERIC			
DESIGN VACUUM: ATMOSPHERIC			
MAXIMUM DESIGN TEMPERATURE: AMBIENT			
MAXIMUM OPERATING TEMPERATURE: AMBIENT			
DESIGN METAL TEMPERATURE: N/A			
WIND SPEED: 108 MPH (3 SEC GUST-ULT)			
WIND IMPORTANCE FACTOR: 1.15			
SEISMIC SITE SPECIFIC: S _s = 1.625, S ₁ = 0.567			
SITE CLASS: "C"			
SEISMIC SUG: 111, 1 = 1.5			
ROOF LIVE LOAD: 25 PSF			
JOINT EFFICIENCY: 0.85 ON SHELL, CONE AND BOWL			
CORROSION ALLOWANCE: NONE			
FILL RATE: 0-2400 GPM ⁶			
SUCTION RATE: 0-2400 GPM ⁶			
MATERIAL: CS			
ALLOWABLE SOIL BEARING: 8,000 PSF			

REV.	BY	DATE	DESCRIPTION
6	PJ	6/28/2022	REVISED ELEVATIONS, UPDATED DESIGN TABLE
5	PJ	6/10/2022	REVISED TANK HEIGHT
4	PJ	3/31/2022	REVISED CONE PLATE THICKNESS TO 11/16" ONLY
3	DB	1/12/2022	REVISED WIND SPEED, TOP ANGLE AND RAFTER SIZES
2	DB	1/10/2022	REVISED PER CUSTOMER MARKUPS
1	DB	1/3/2022	REVISED PER CUSTOMER MARKUPS

REVISIONS			
-----------	--	--	--

T

BAILEY

INC.

AISC

CERTIFIED

FABRICATOR


9628 S March Point Rd.
Anacortes, WA 98221
PH: (360) 293-0682
FAX: (360) 293-3893

Website:

www.TBailey.com

The technical information provided on this drawing is the confidential property of T Bailey Inc. Reproduction of this drawing or use of this information for anything other than its limited, intended purpose as to this project, without the written permission of T Bailey Inc., is prohibited.

DRAWN BY: PAO	DATE: 12/7/2021	CHK'D BY: DB	DATE: 12/7/2021		
CUSTOMER: McCORMICK COMMUNITIES, LLC		70'-0" I.D. WATER TANK			
PROJECT: PORT ORCHARD 660 RESERVOIR					
TITLE: DESIGN SKETCH					
JOB#: 681-01 (HEI: 21-1657)		SHT#: GA-1			

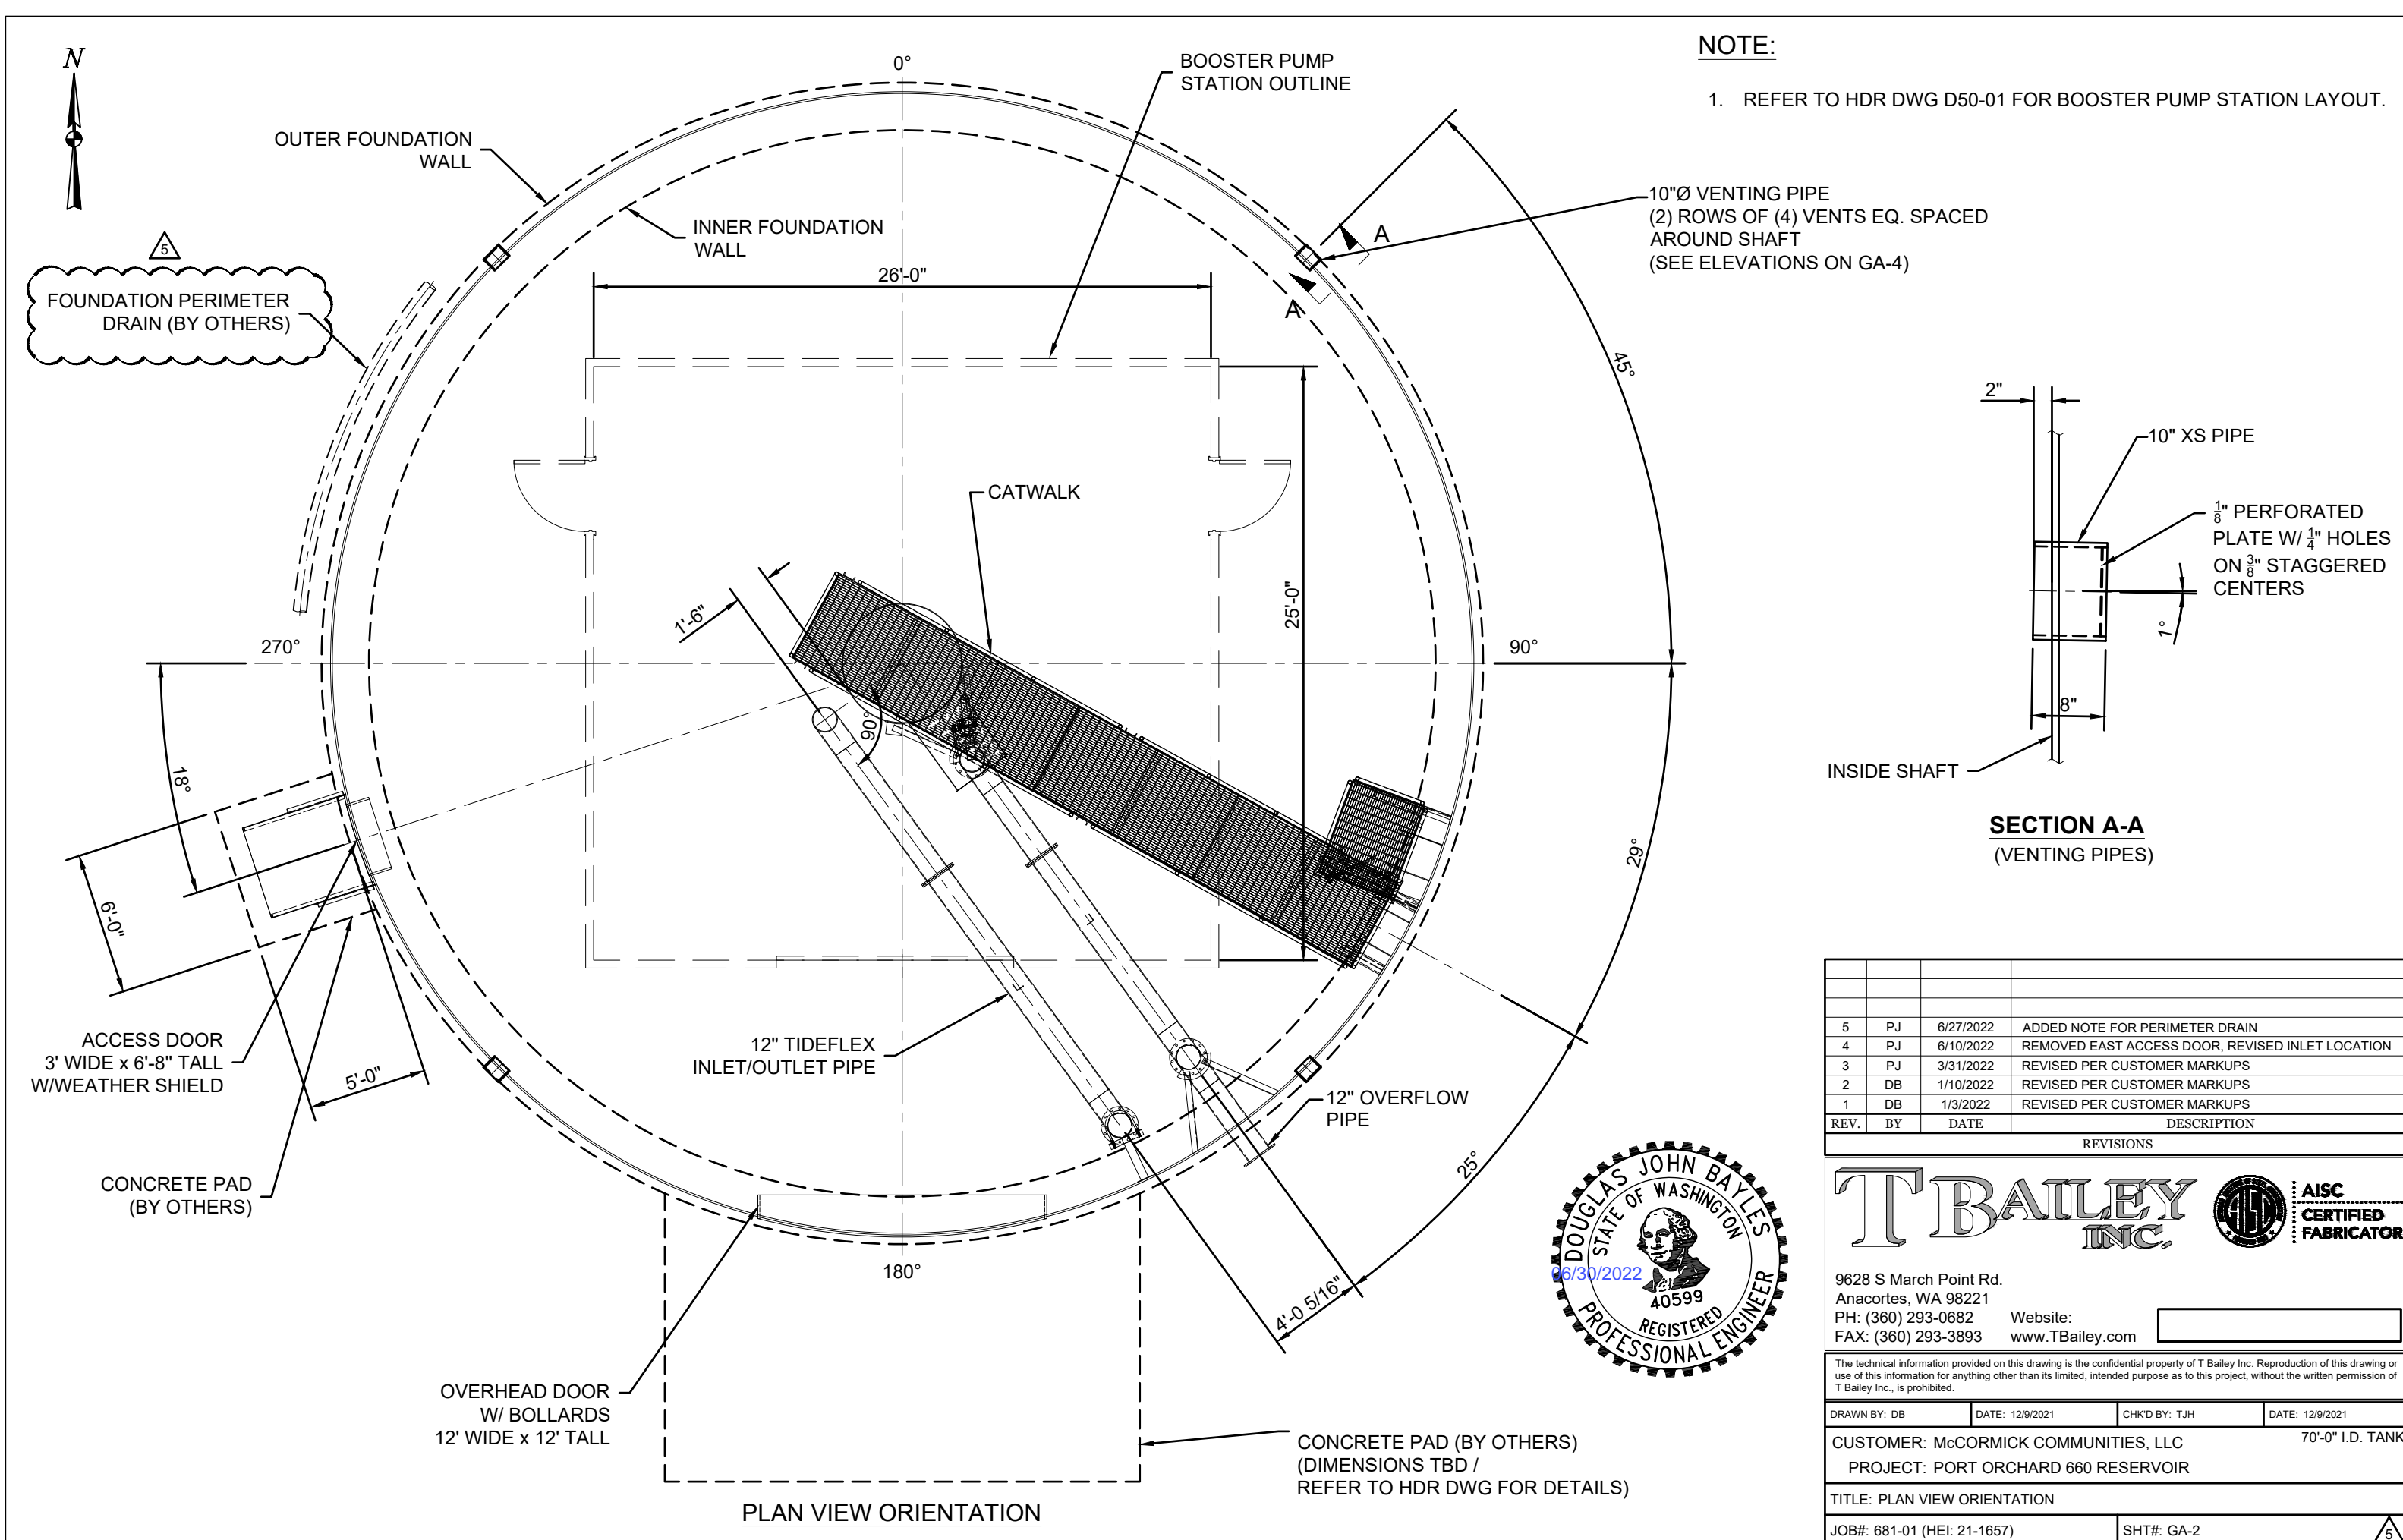



NOTE:

1. REFER TO HDR DWG D50-01 FOR BOOSTER PUMP STATION LAYOUT.

REV.	BY	DATE	DESCRIPTION
5	PJ	6/27/2022	ADDED NOTE FOR PERIMETER DRAIN
4	PJ	6/10/2022	REMOVED EAST ACCESS DOOR, REVISED INLET LOCATION
3	PJ	3/31/2022	REVISED PER CUSTOMER MARKUPS
2	DB	1/10/2022	REVISED PER CUSTOMER MARKUPS
1	DB	1/3/2022	REVISED PER CUSTOMER MARKUPS





9628 S March Point Rd.
Anacortes, WA 98221
PH: (360) 293-0682 Website:
FAX: (360) 293-3893 www.TBailey.com


The technical information provided on this drawing is the confidential property of T Bailey Inc. Reproduction of this drawing or use of this information for anything other than its limited, intended purpose as to this project, without the written permission of T Bailey Inc., is prohibited.

DRAWN BY: DB	DATE: 12/9/2021	CHK'D BY: TJH	DATE: 12/9/2021
--------------	-----------------	---------------	-----------------



CUSTOMER: McCORMICK COMMUNITIES, LLC
PROJECT: PORT ORCHARD 660 RESERVOIR

TITLE: PLAN VIEW ORIENTATION


JOB#: 681-01 (HEI: 21-1657)	SHT#: GA-2	5
-----------------------------	------------	---

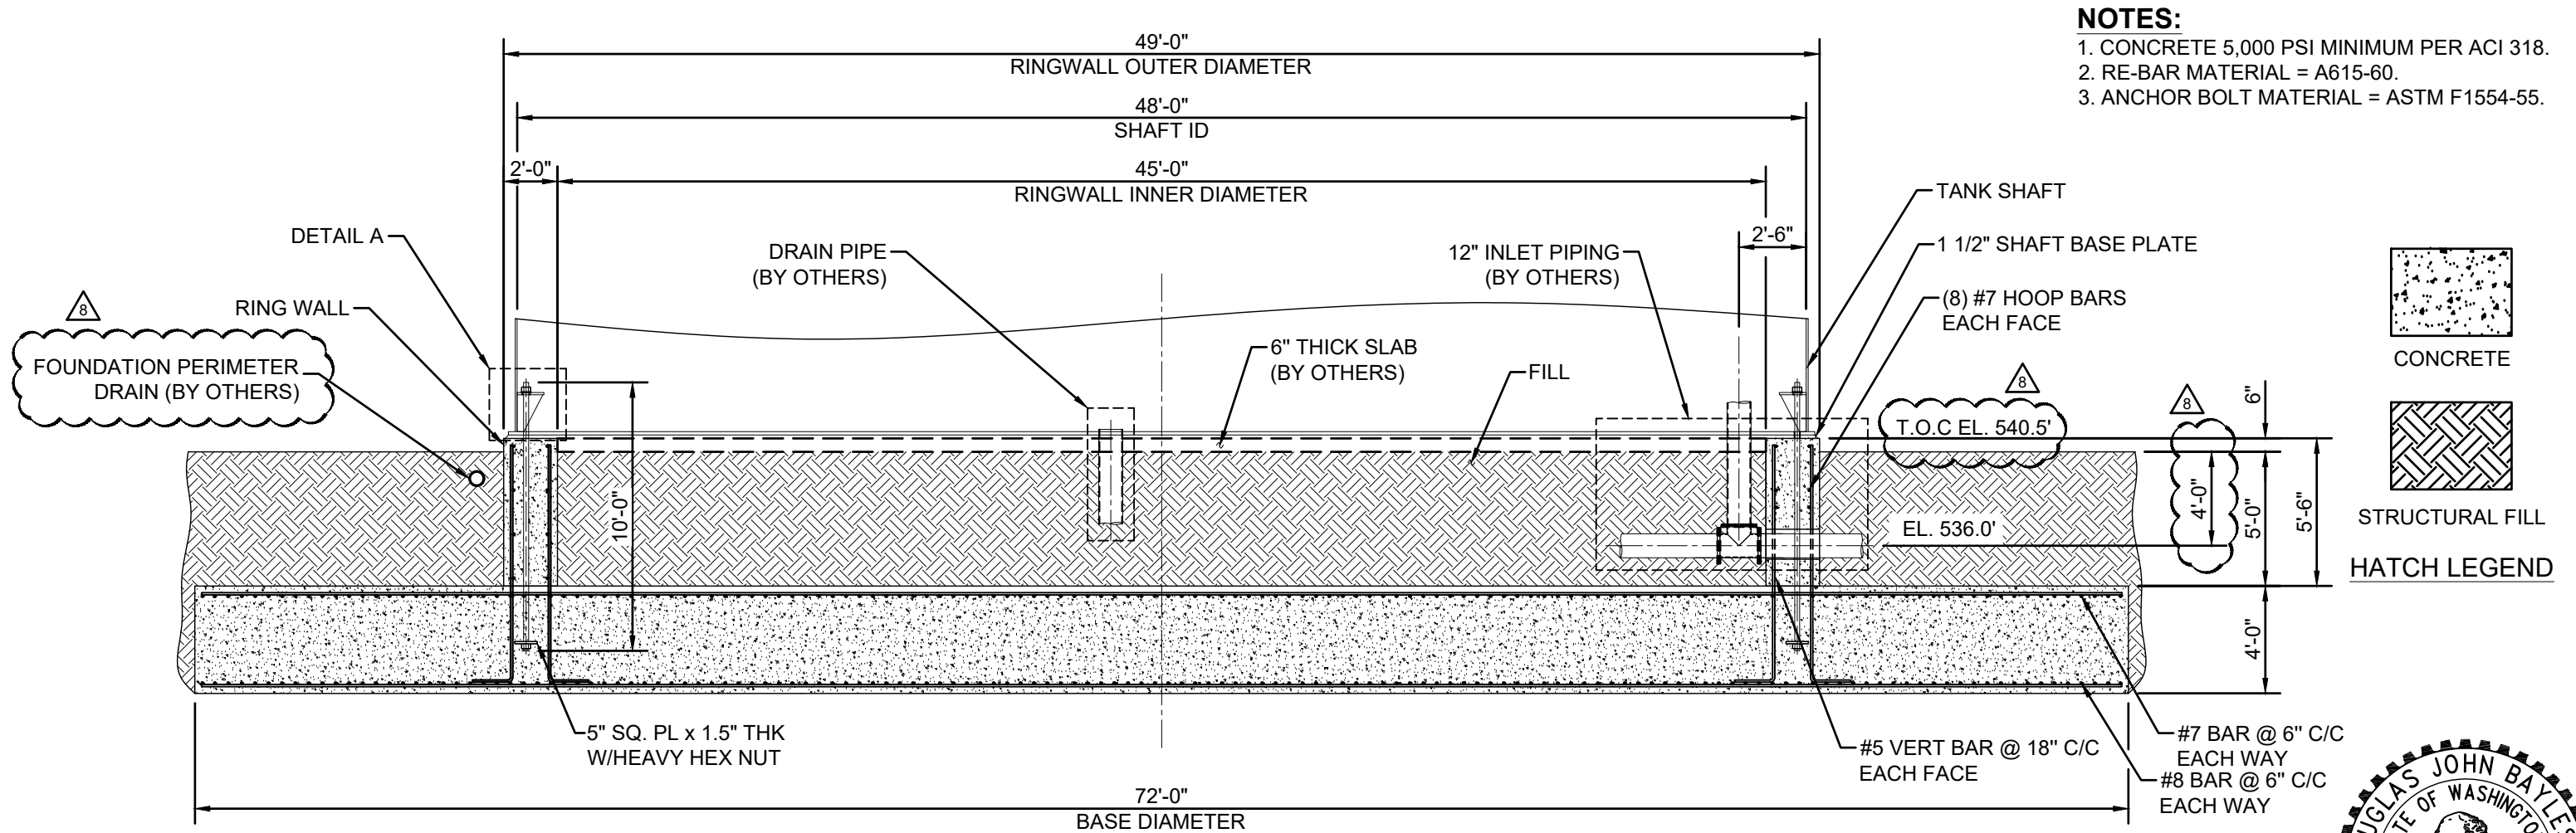

- NOTES:**
1. CONCRETE 5,000 PSI MINIMUM PER ACI 318.
 2. RE-BAR MATERIAL = A615-60.
 3. ANCHOR BOLT MATERIAL = ASTM F1554-55.

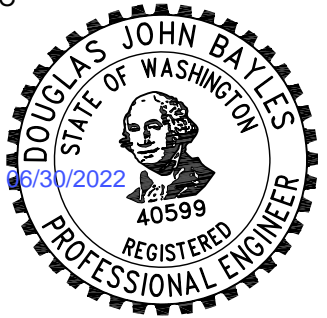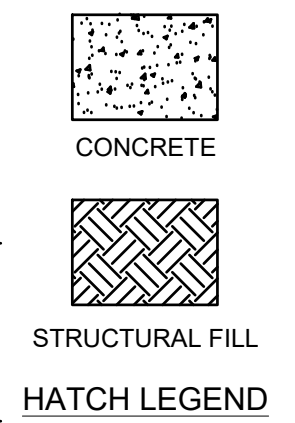

FOUNDATION DESIGN

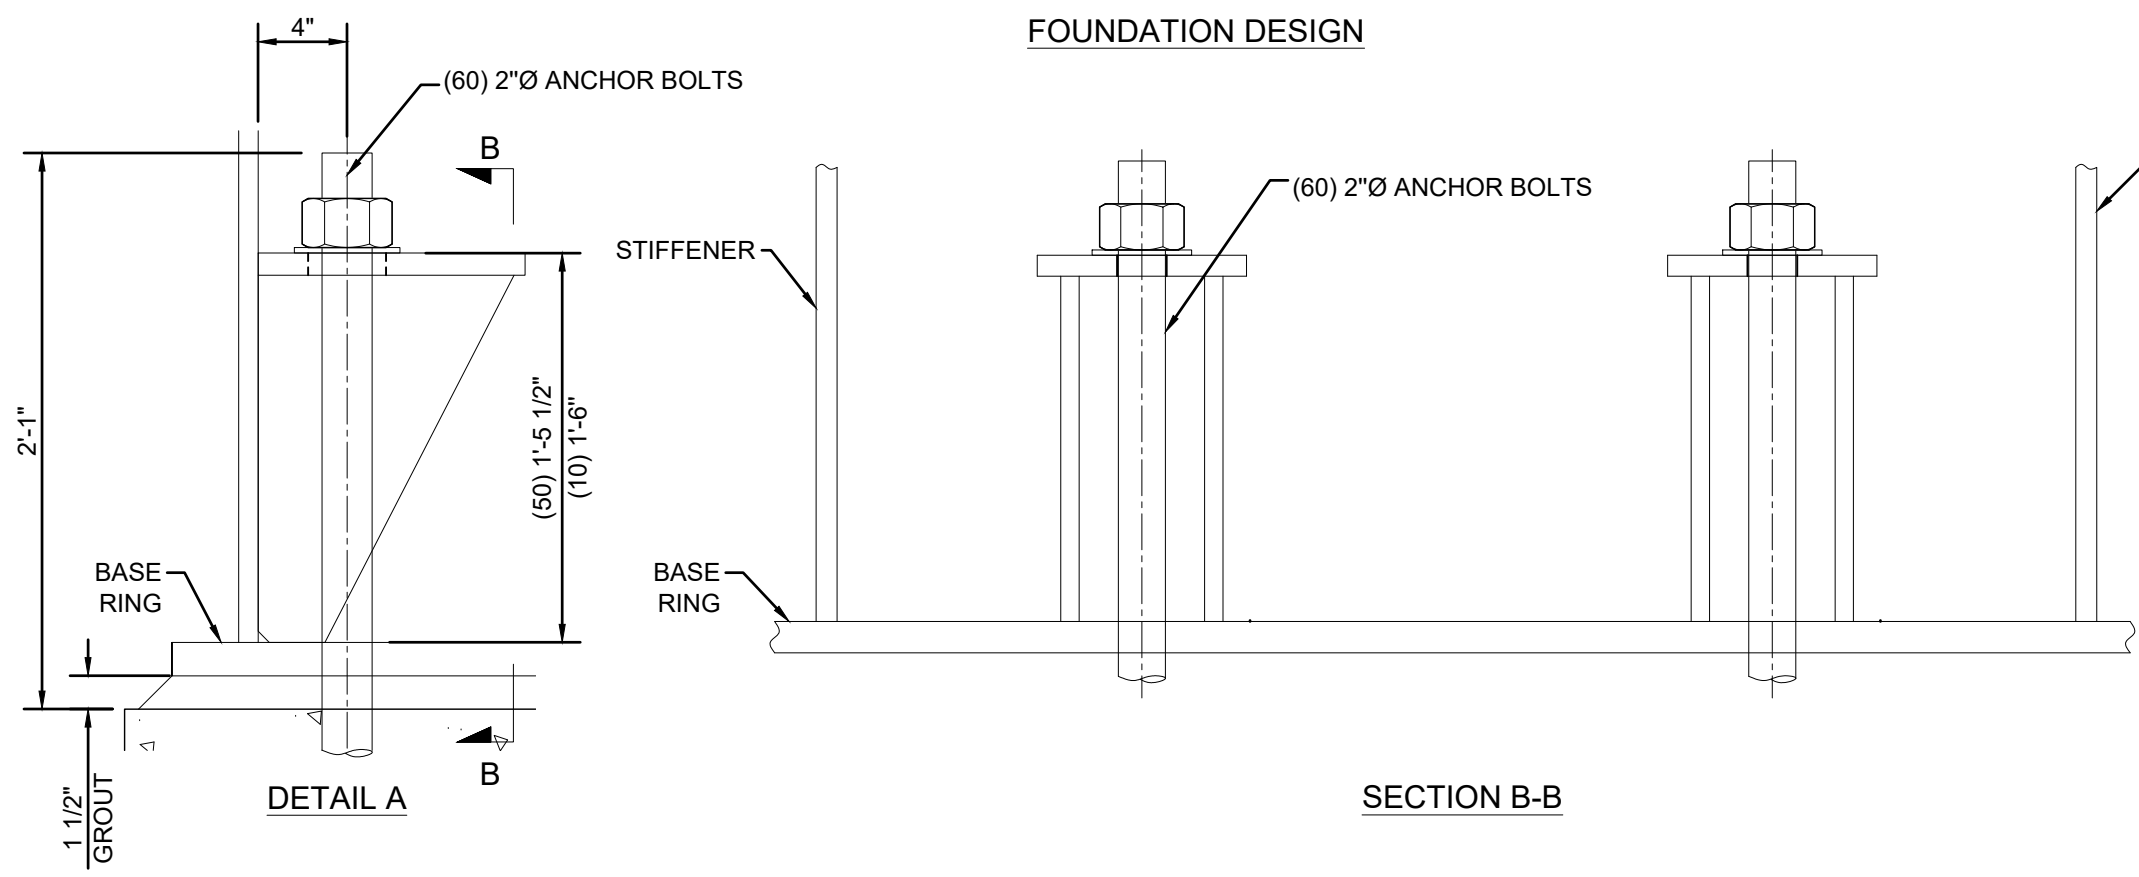


REV.	BY	DATE	DESCRIPTION
8	PJ	6/27/2022	REVISED T.O.C. ELEVATION
7	PJ	6/10/2022	REVISED ANCHOR BOLTS DIAMETER
6	PJ	3/31/2022	REVISED INLET
5	DB	1/12/2022	REVISED ANCHOR CHAIRS
4	DB	1/10/2022	REVISED PER CUSTOMER MARKUPS
3	DB	1/3/2022	REVISED PER CUSTOMER MARKUPS
2	DB	12/23/2021	ADDED THRUST BOX, & REMOVED FLANGES, 10" PIPING
1	DB	12/17/2021	ADDED RINGWALL CALLOUTS DIMENSIONS & DETAILS



9628 S March Point Rd.
Anacortes, WA 98221
PH: (360) 293-0682 Website:
FAX: (360) 293-3893 www.TBailey.com

The technical information provided on this drawing is the confidential property of T Bailey Inc. Reproduction of this drawing or use of this information for anything other than its limited, intended purpose as to this project, without the written permission of T Bailey Inc., is prohibited.

DRAWN BY: DB	DATE: 12/10/2021	CHK'D BY: TJH	DATE: 12/10/2021
CUSTOMER: McCORMICK COMMUNITES, LLC			
PROJECT: PORT ORCHARD 660 RESERVOIR			
TITLE: FOUNDATION DESIGN			
JOB#: 681-01 (HEI: 21-1657)		SHT#: GA-3	

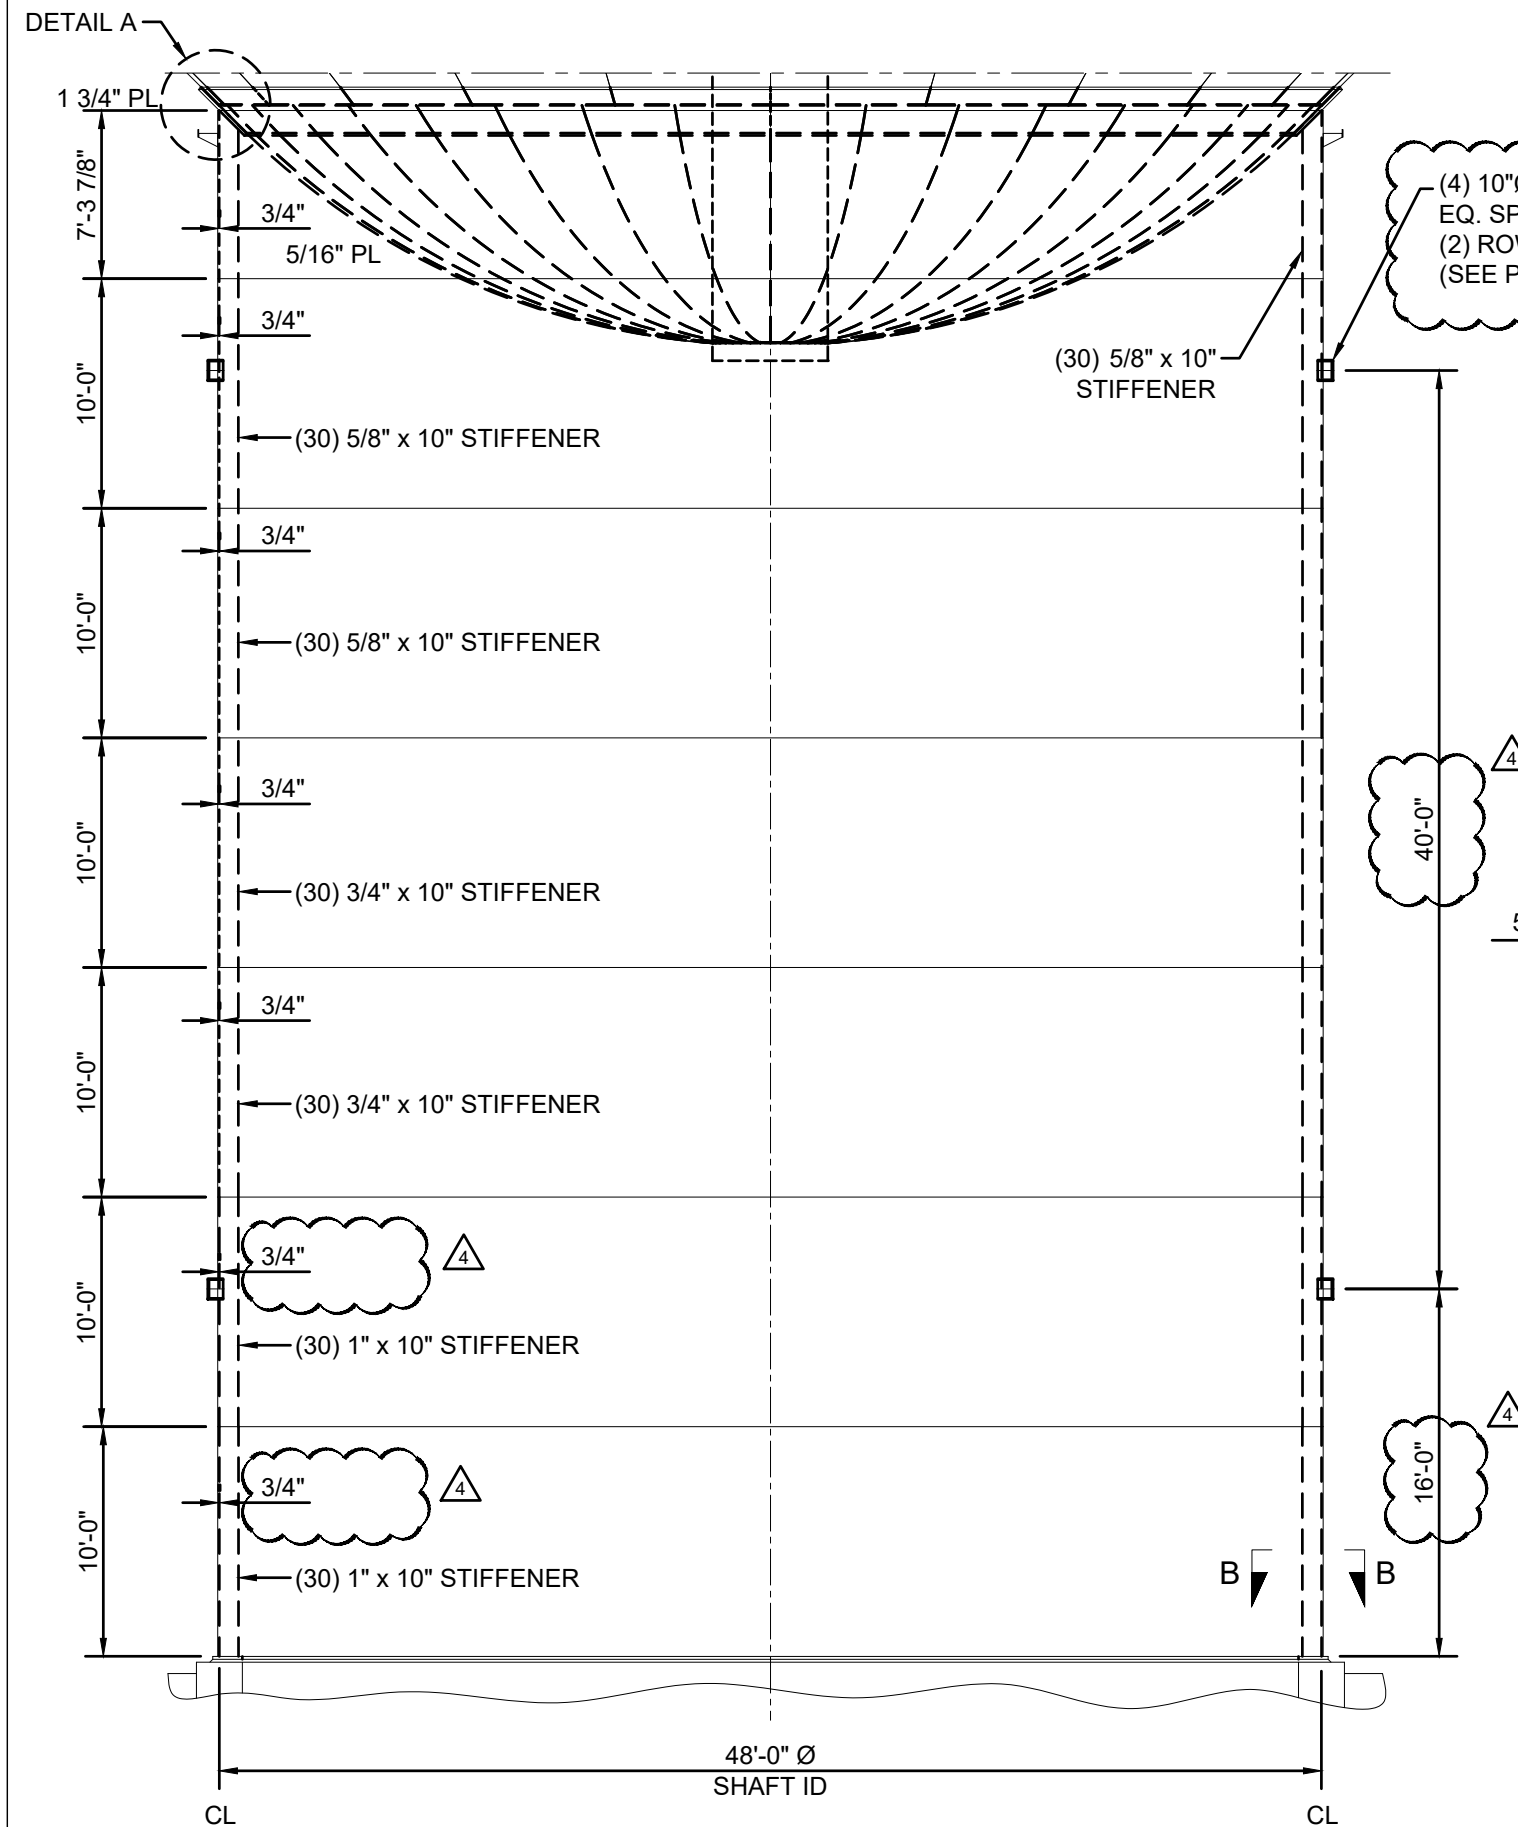

NOTE:
1. STIFFENERS (QUANTITY OF 30) ARE EQUALLY SPACED AROUND OUTSIDE WALL (SHAFT).

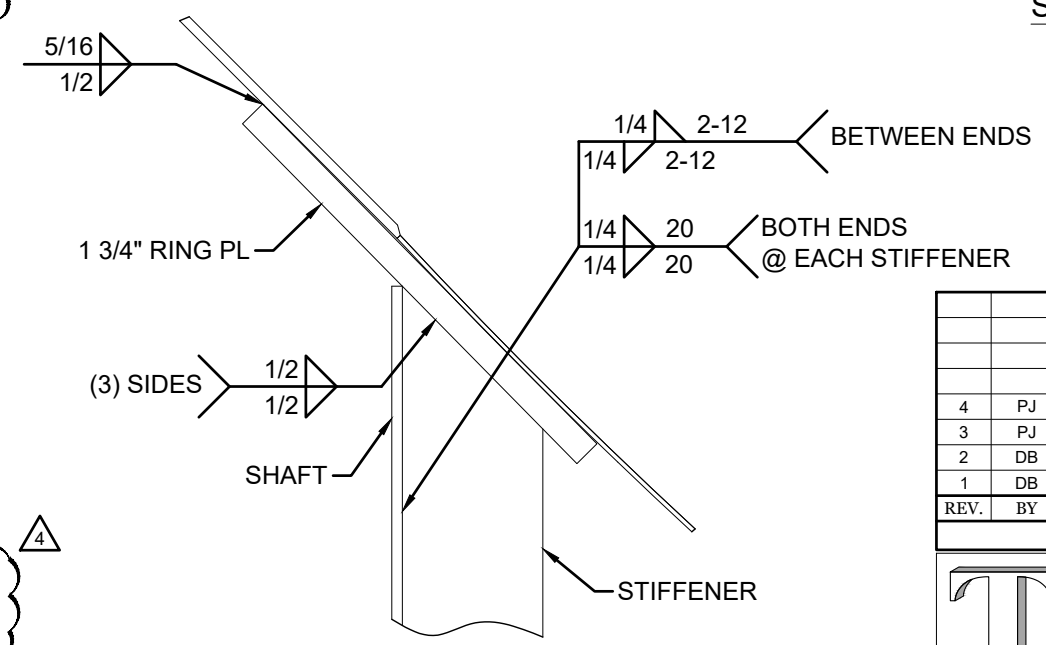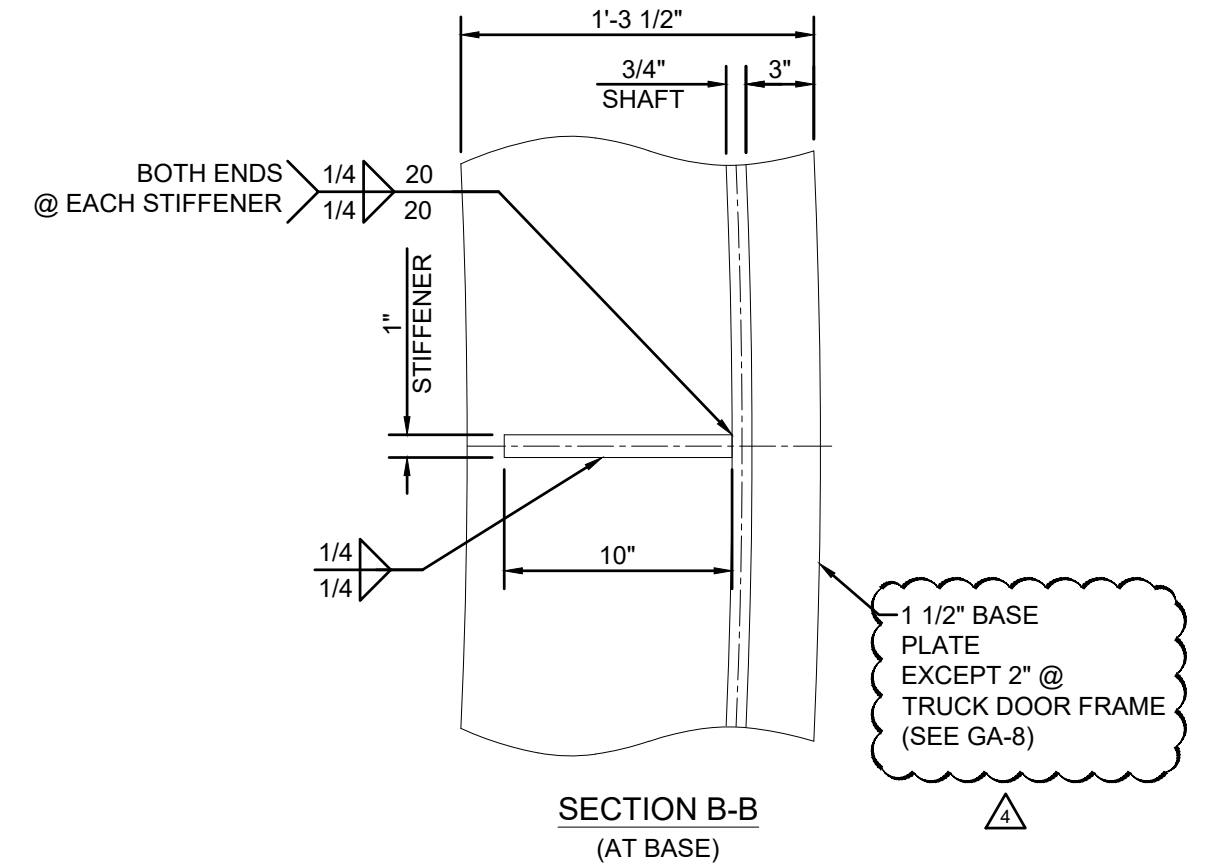

REV.	BY	DATE	DESCRIPTION
4	PJ	6/10/2022	REVISED THK AT SHAFT, REVISED NOTE ON SECTION B-B
3	PJ	3/31/2022	REVISED STIFFENERS WELDS
2	DB	1/10/2022	REVISED PER CUSTOMER MARKUPS
1	DB	1/3/2022	REVISED PER CUSTOMER MARKUPS

REVISIONS

9628 S March Point Rd.
Anacortes, WA 98221
PH: (360) 293-0682 Website:
FAX: (360) 293-3893 www.TBailey.com

The technical information provided on this drawing is the confidential property of T Bailey Inc. Reproduction of this drawing or use of this information for anything other than its limited, intended purpose as to this project, without the written permission of T Bailey Inc., is prohibited.


DRAWN BY: DB	DATE: 12/14/2021	CHK'D BY: TJH	DATE: 12/14/2021
--------------	------------------	---------------	------------------

CUSTOMER: McCORMICK COMMUNITIES, LLC 70'-0" I.D. TANK
PROJECT: PORT ORCHARD 660 RESERVOIR


TITLE: SHAFT DESIGN

JOB#: 681-01 (HEI: 21-1657)	SHT#: GA-4
-----------------------------	------------




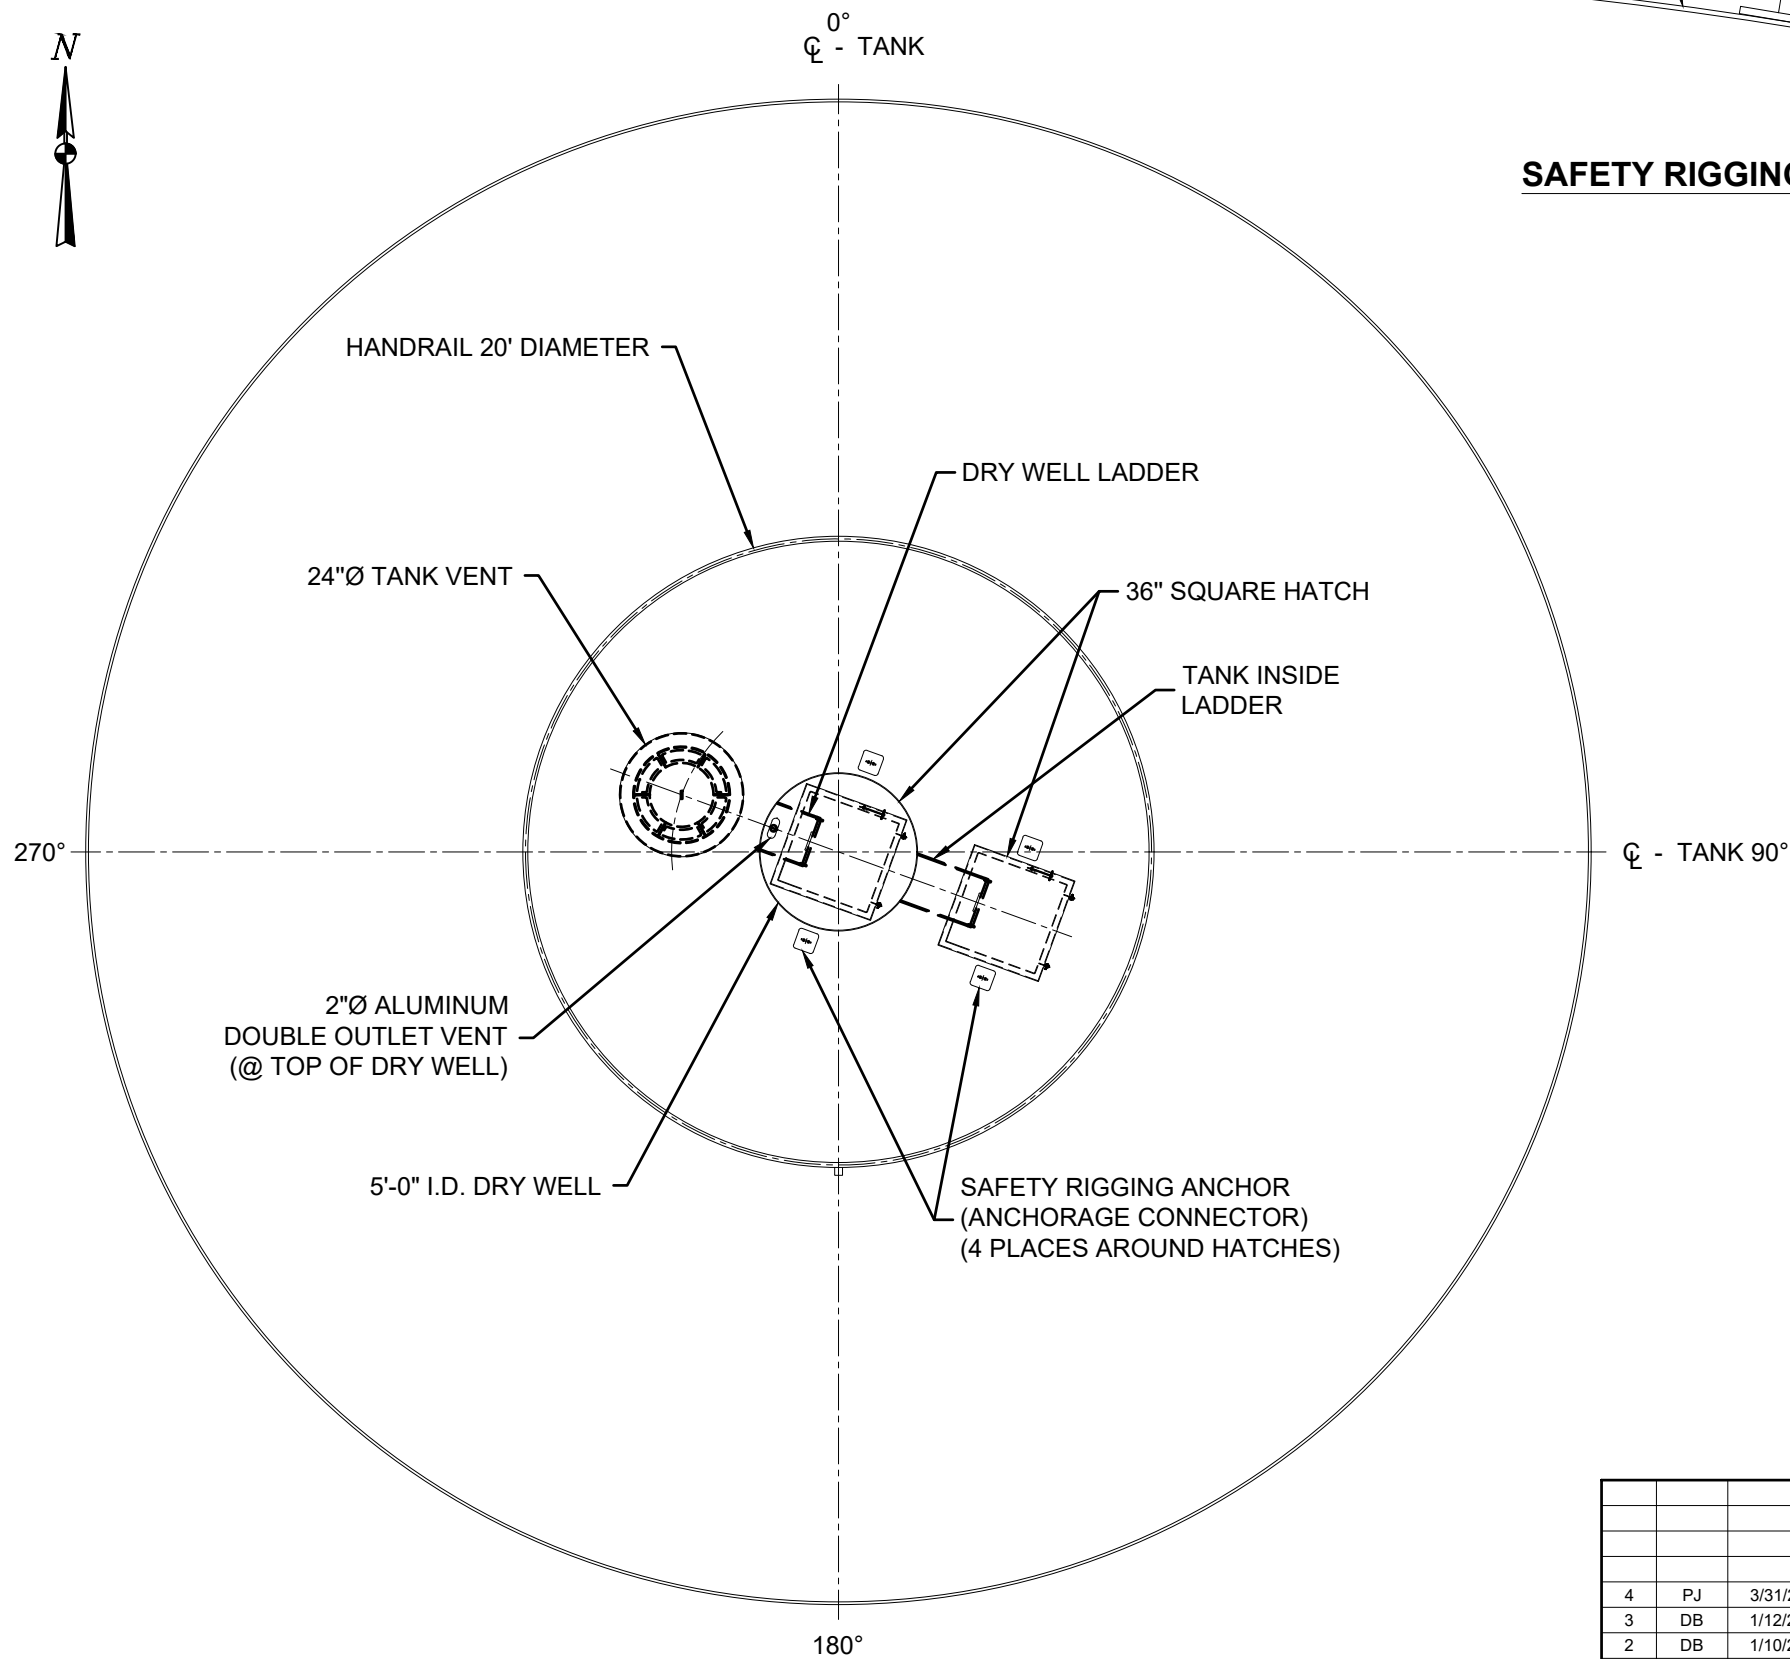


ORIENTATION

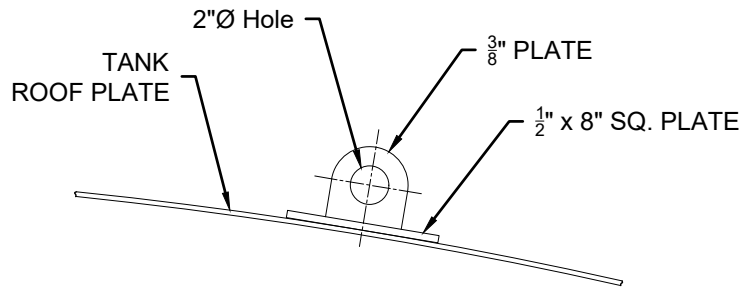

SAFETY RIGGING ANCHOR DETAIL

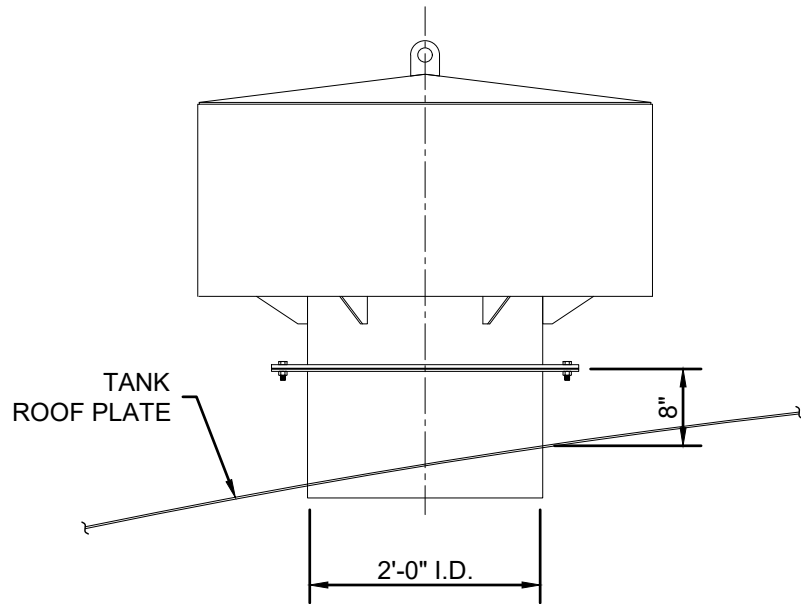

24" TANK VENT DETAIL

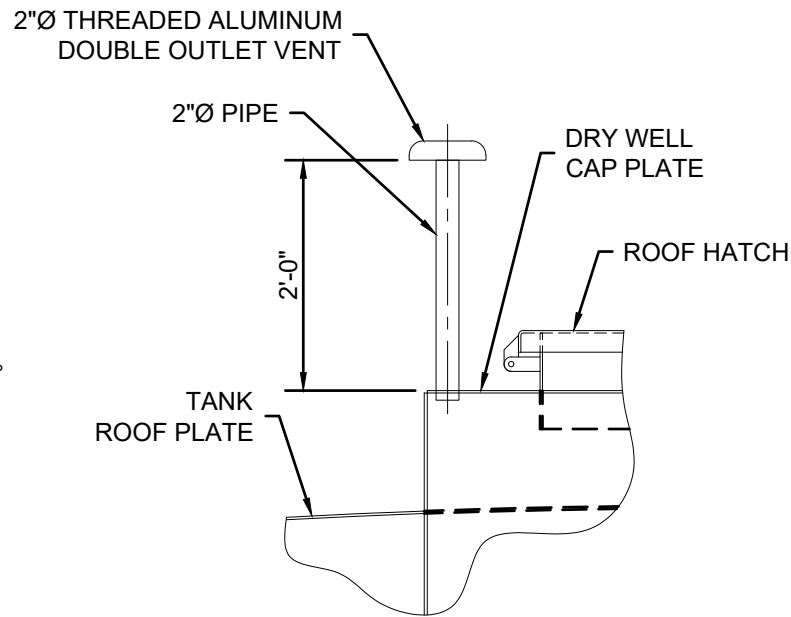

DRY WELL VENT DETAIL



AISC
CERTIFIED
FABRICATOR

9628 S March Point Rd.
Anacortes, WA 98221

PH: (360) 293-0682

FAX: (360) 293-3893

Website:

www.TBailey.com

The technical information provided on this drawing is the confidential property of T Bailey Inc. Reproduction of this drawing or use of this information for anything other than its limited, intended purpose as to this project, without the written permission of T Bailey Inc., is prohibited.

DRAWN BY: DB DATE: 12/16/2021 CHK'D BY: TJH DATE: 12/16/2021


CUSTOMER: McCORMICK COMMUNITIES, LLC 70'-0" I.D. TANK

PROJECT: PORT ORCHARD 660 RESERVOIR


TITLE: ROOF ORIENTATION

JOB#: 681-01 (HEI: 21-1657) SHT#: GA-5

REV.	BY	DATE	DESCRIPTION
4	PJ	3/31/2022	REMOVED FA LIGHT MOUNT
3	DB	1/12/2022	MOVED ANCHOR CHAIRS TO ANOTHER DRAWING
2	DB	1/10/2022	REVISED PER CUSTOMER MARKUPS
1	DB	1/3/2022	REVISED PER CUSTOMER MARKUPS
REVISIONS			

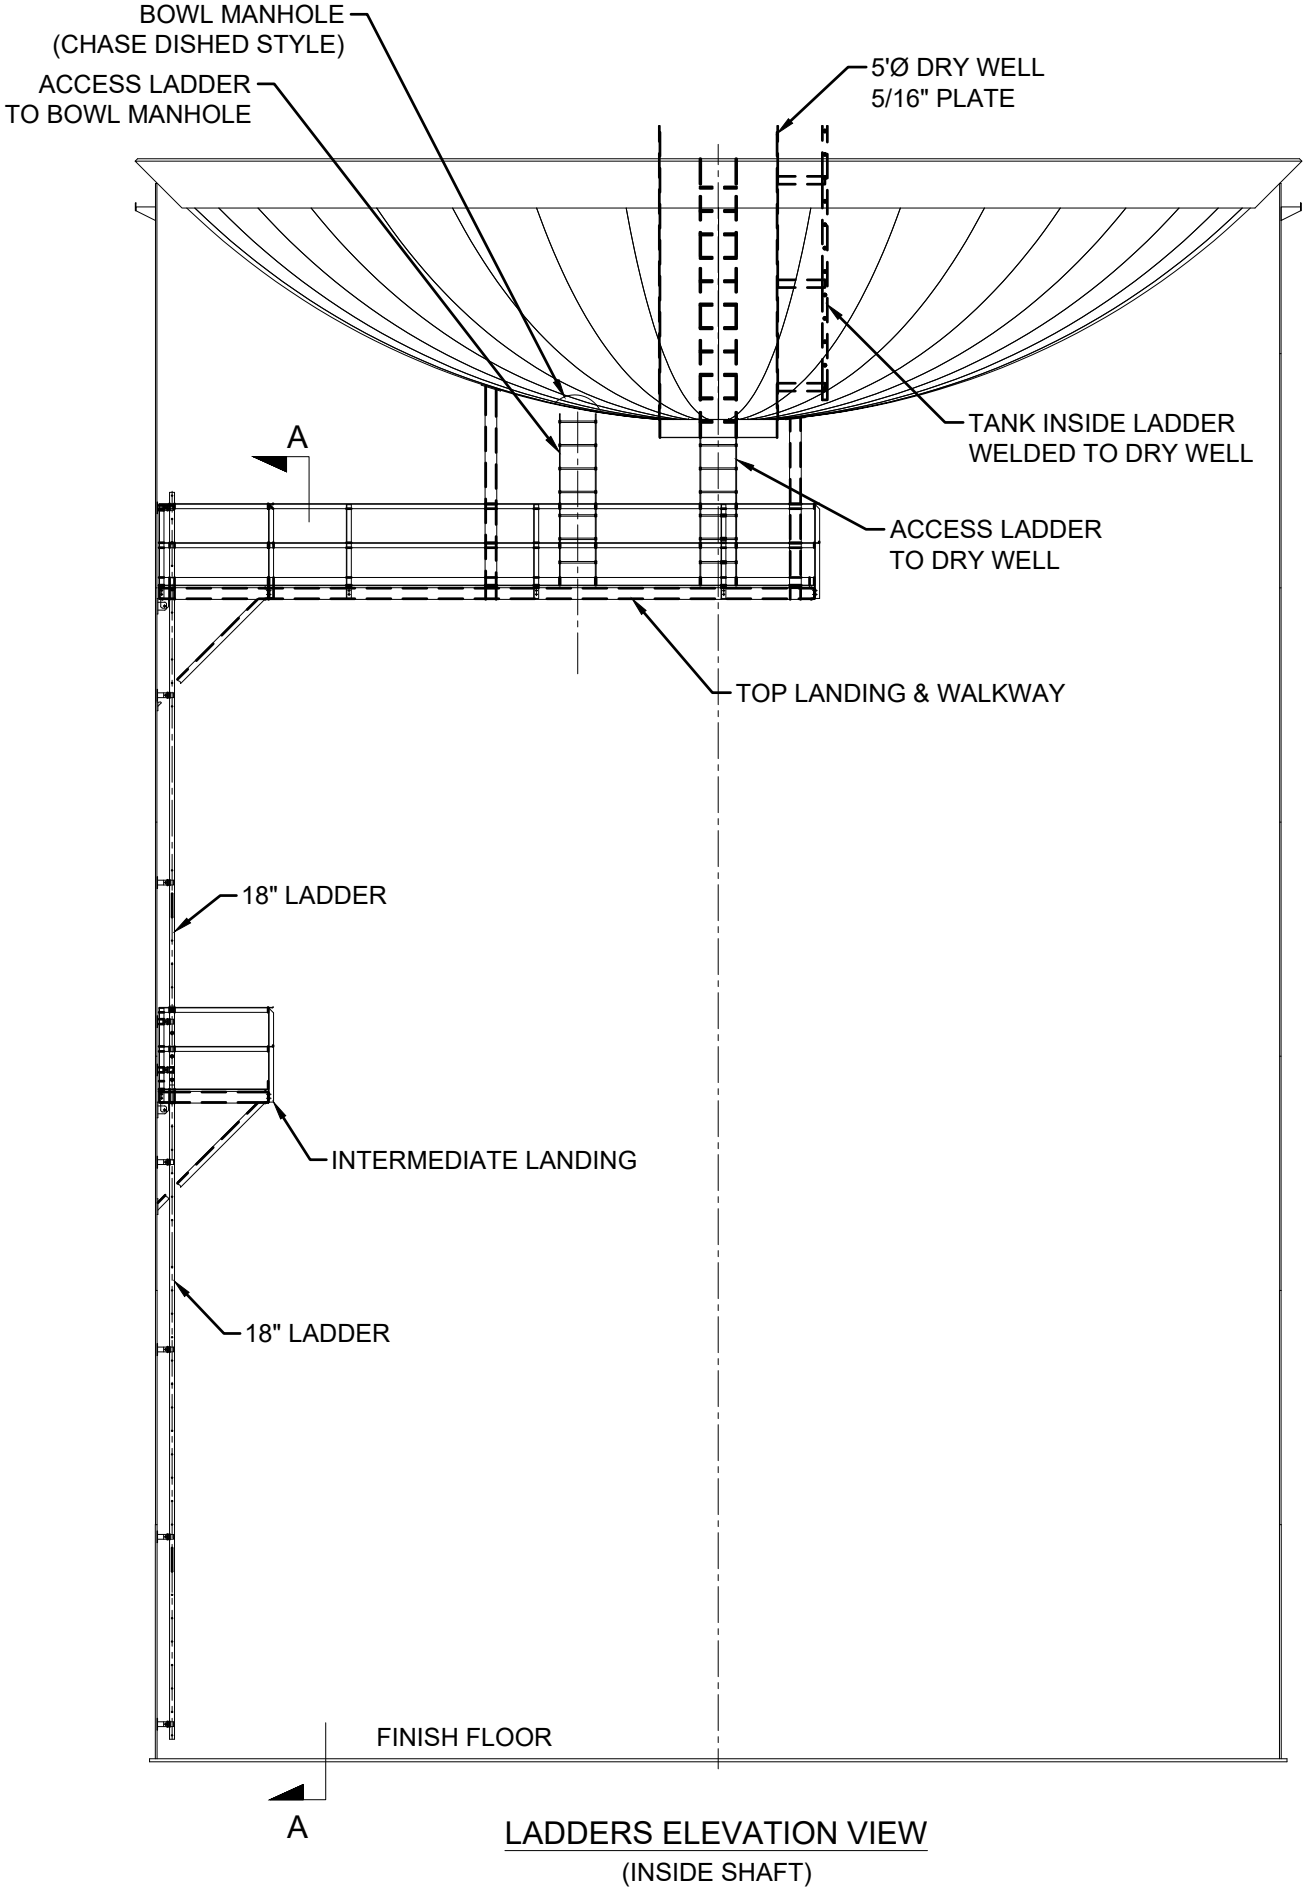

LADDERS ELEVATION VIEW
(INSIDE SHAFT)

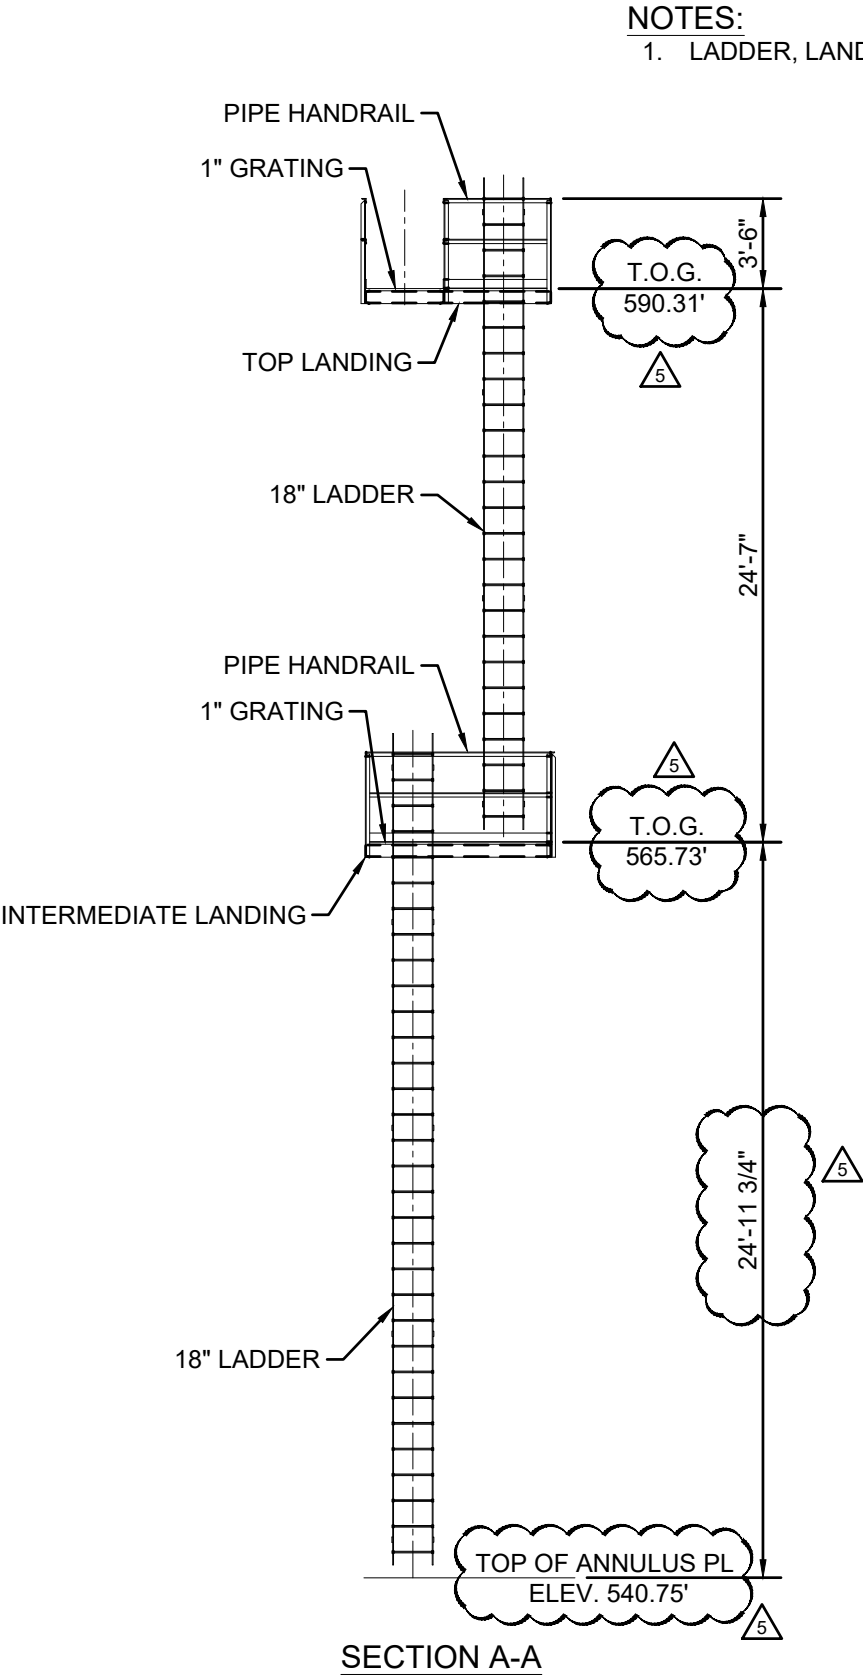

SECTION A-A

NOTES:
1. LADDER, LANDING - DESIGN AND FABRICATION BASIS - OSHA 29 CFR 1910




REV.	BY	DATE	DESCRIPTION
5	PJ	6/27/2022	REVISED ELEVATIONS
4	PJ	6/10/2022	REVISED VIEW CALLOUT
3	PJ	3/31/2022	REVISED TOP OF PLATFORM ELEVATIONS
2	DB	1/10/2022	REVISED PER CUSTOMER MARKUPS
1	DB	1/3/2022	REVISED PER CUSTOMER MARKUPS




9628 S March Point Rd.
Anacortes, WA 98221
PH: (360) 293-0682 Website:
FAX: (360) 293-3893 www.TBailey.com

The technical information provided on this drawing is the confidential property of T Bailey Inc. Reproduction of this drawing or use of this information for anything other than its limited, intended purpose as to this project, without the written permission of T Bailey Inc., is prohibited.

DRAWN BY: DB	DATE: 12/17/2021	CHK'D BY: TJH	DATE: 12/17/2021
CUSTOMER: McCORMICK COMMUNITIES, LLC			70'-0" I.D. TANK
PROJECT: PORT ORCHARD 660 RESERVOIR			
TITLE: LADDER WITH PLATFORM DESIGNS			
JOB#: 681-01 (HEI: 21-1657)		SHT#: GA-6	

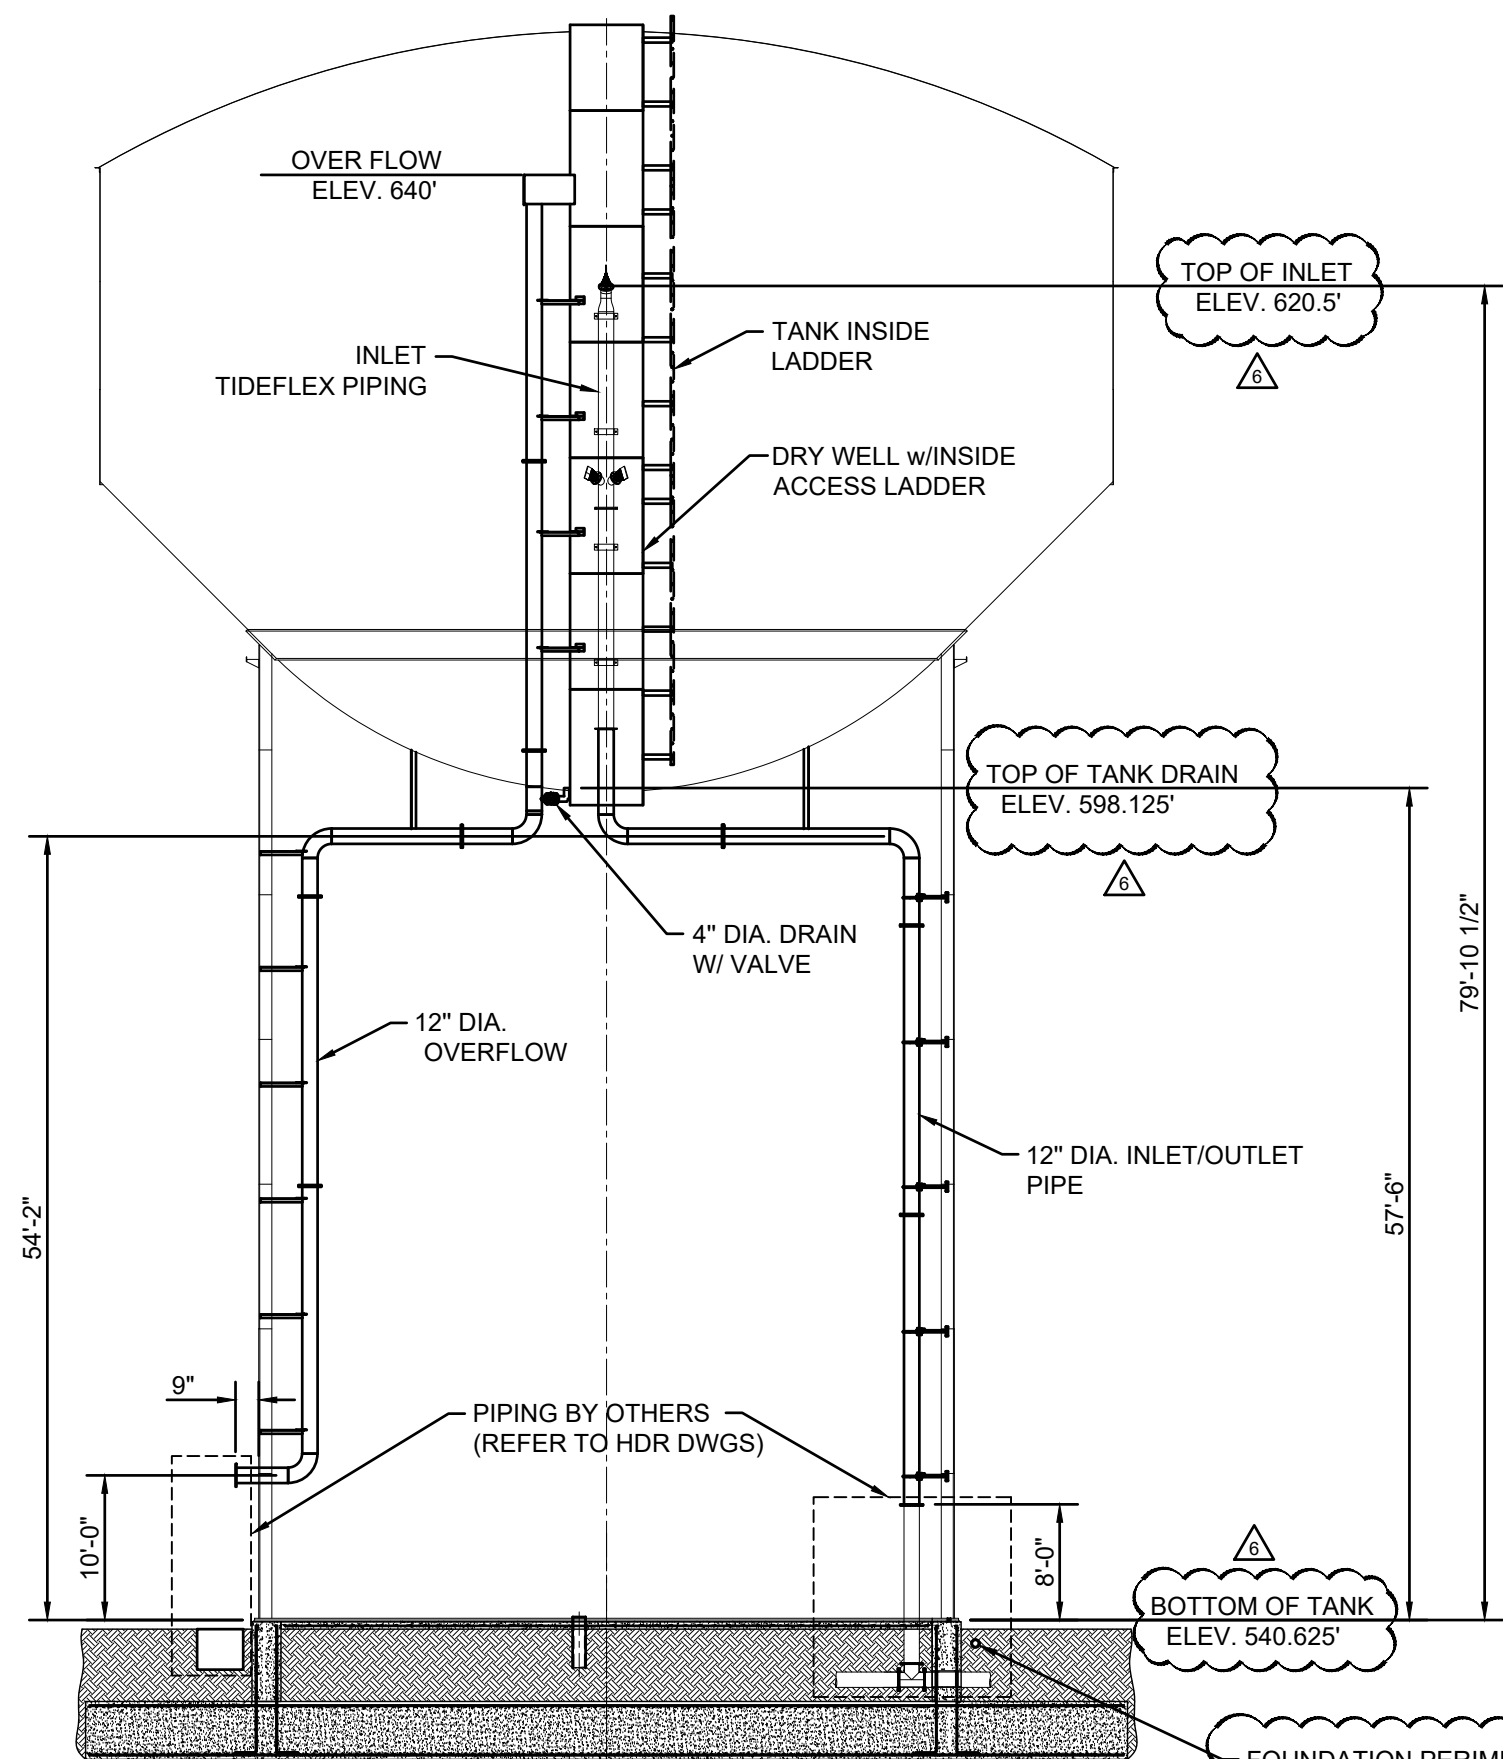

PIPING ELEVATION

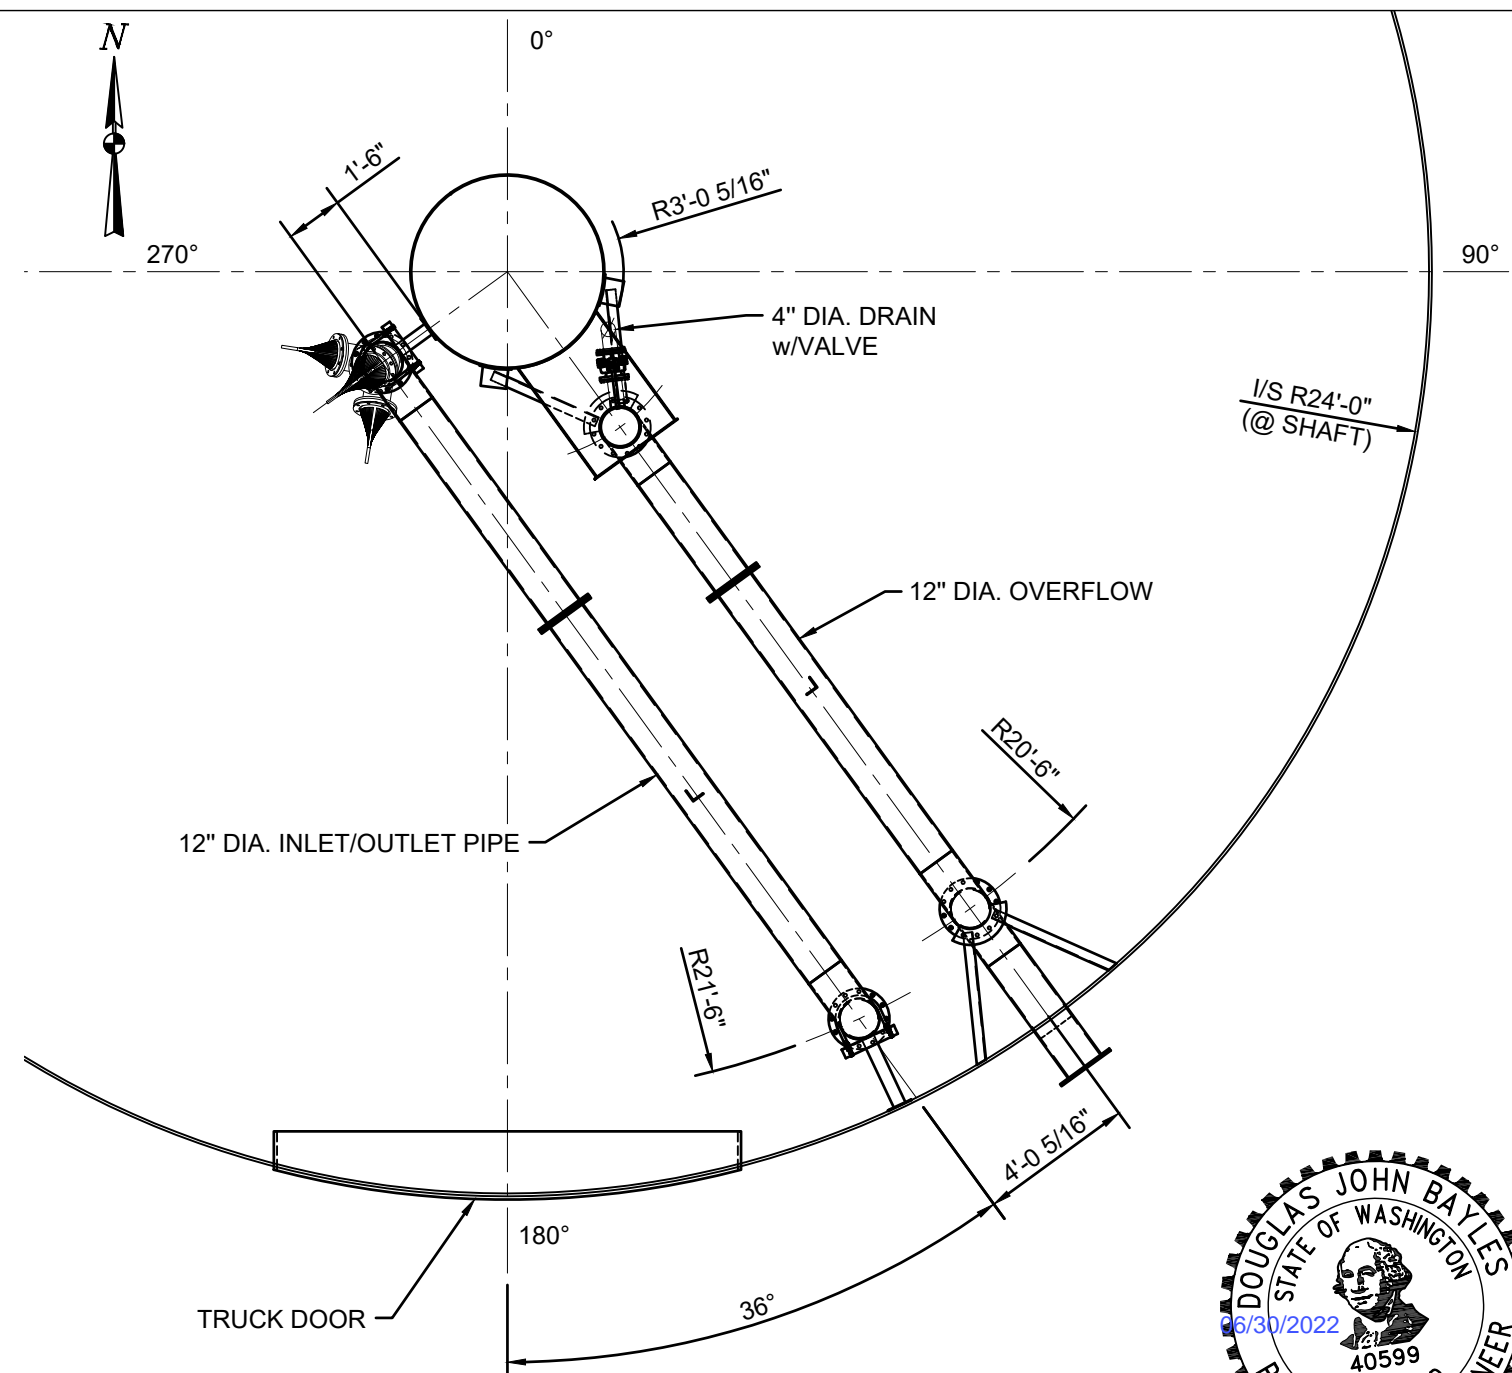




PIPING PLAN



REV.	BY	DATE	DESCRIPTION
6	PJ	6/27/2022	REVISED ELEVATIONS, ADDED PERIMETER DRAIN NOTE
5	PJ	6/10/2022	REVISED INLET LOCATION
4	PJ	3/31/2022	REVISED PER CUSTOMER MARKUPS
3	DB	1/10/2022	REVISED PER CUSTOMER MARKUPS
2	DB	1/3/2022	REVISED PER CUSTOMER MARKUPS
1	DB	12/23/2021	ADDED THRUST BOX
REVISIONS			
The technical information provided on this drawing is the confidential property of T Bailey Inc. Reproduction of this drawing or use of this information for anything other than its limited, intended purpose as to this project, without the written permission of T Bailey Inc., is prohibited.			
DRAWN BY: DB		DATE: 12/23/2021	CHK'D BY: TJH
CUSTOMER: McCORMICK COMMUNITIES, LLC		70'-0" I.D. TANK	
PROJECT: PORT ORCHARD 660 RESERVOIR		TITLE: PIPING PLAN	
JOB#: 681-01 (HEI 21-1657)		SHT#: GA-7	

9628 S March Point Rd.
 Anacortes, WA 98221
 PH: (360) 293-0682
 FAX: (360) 293-3893

Website: www.TBailey.com

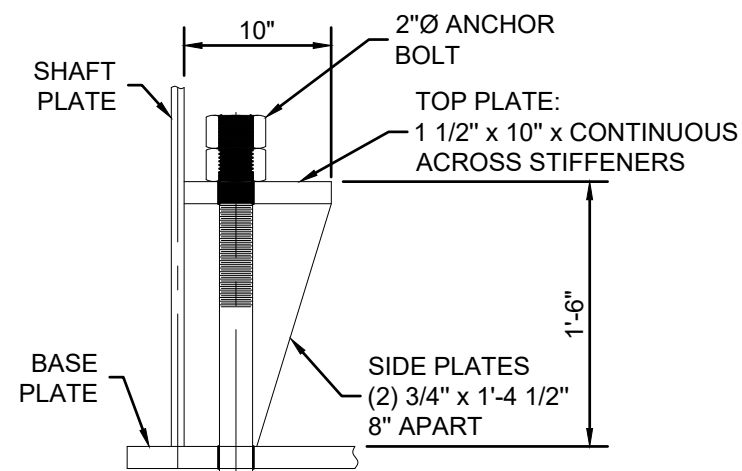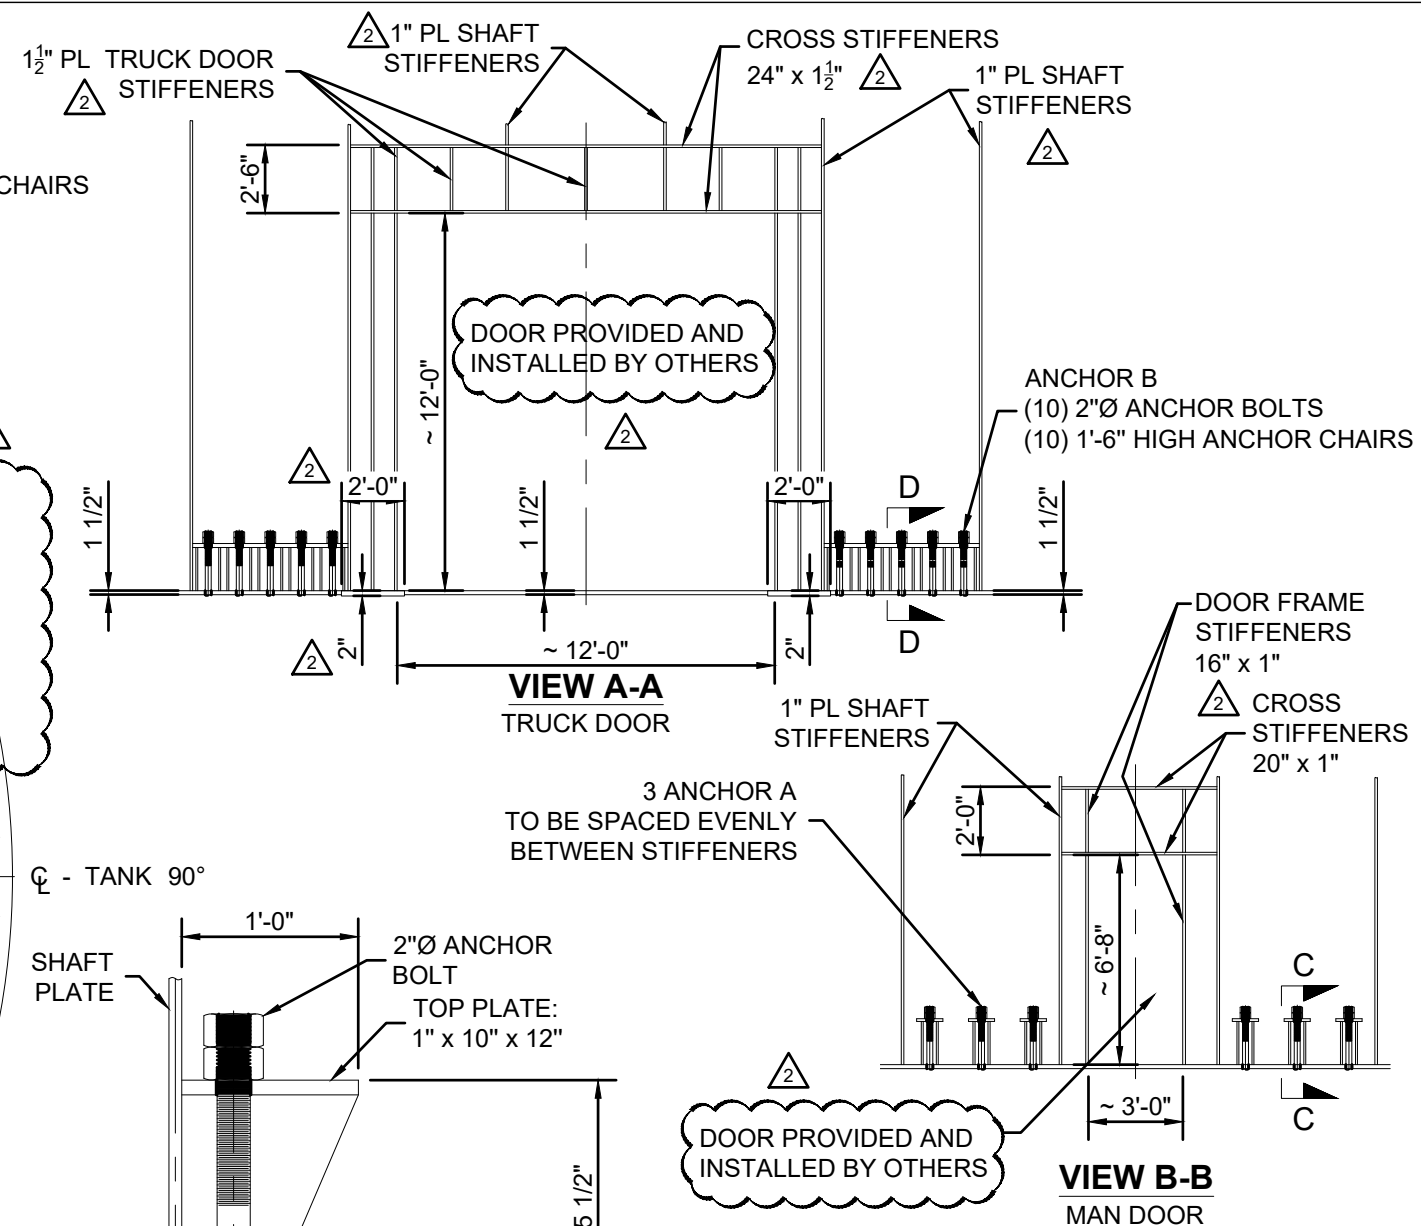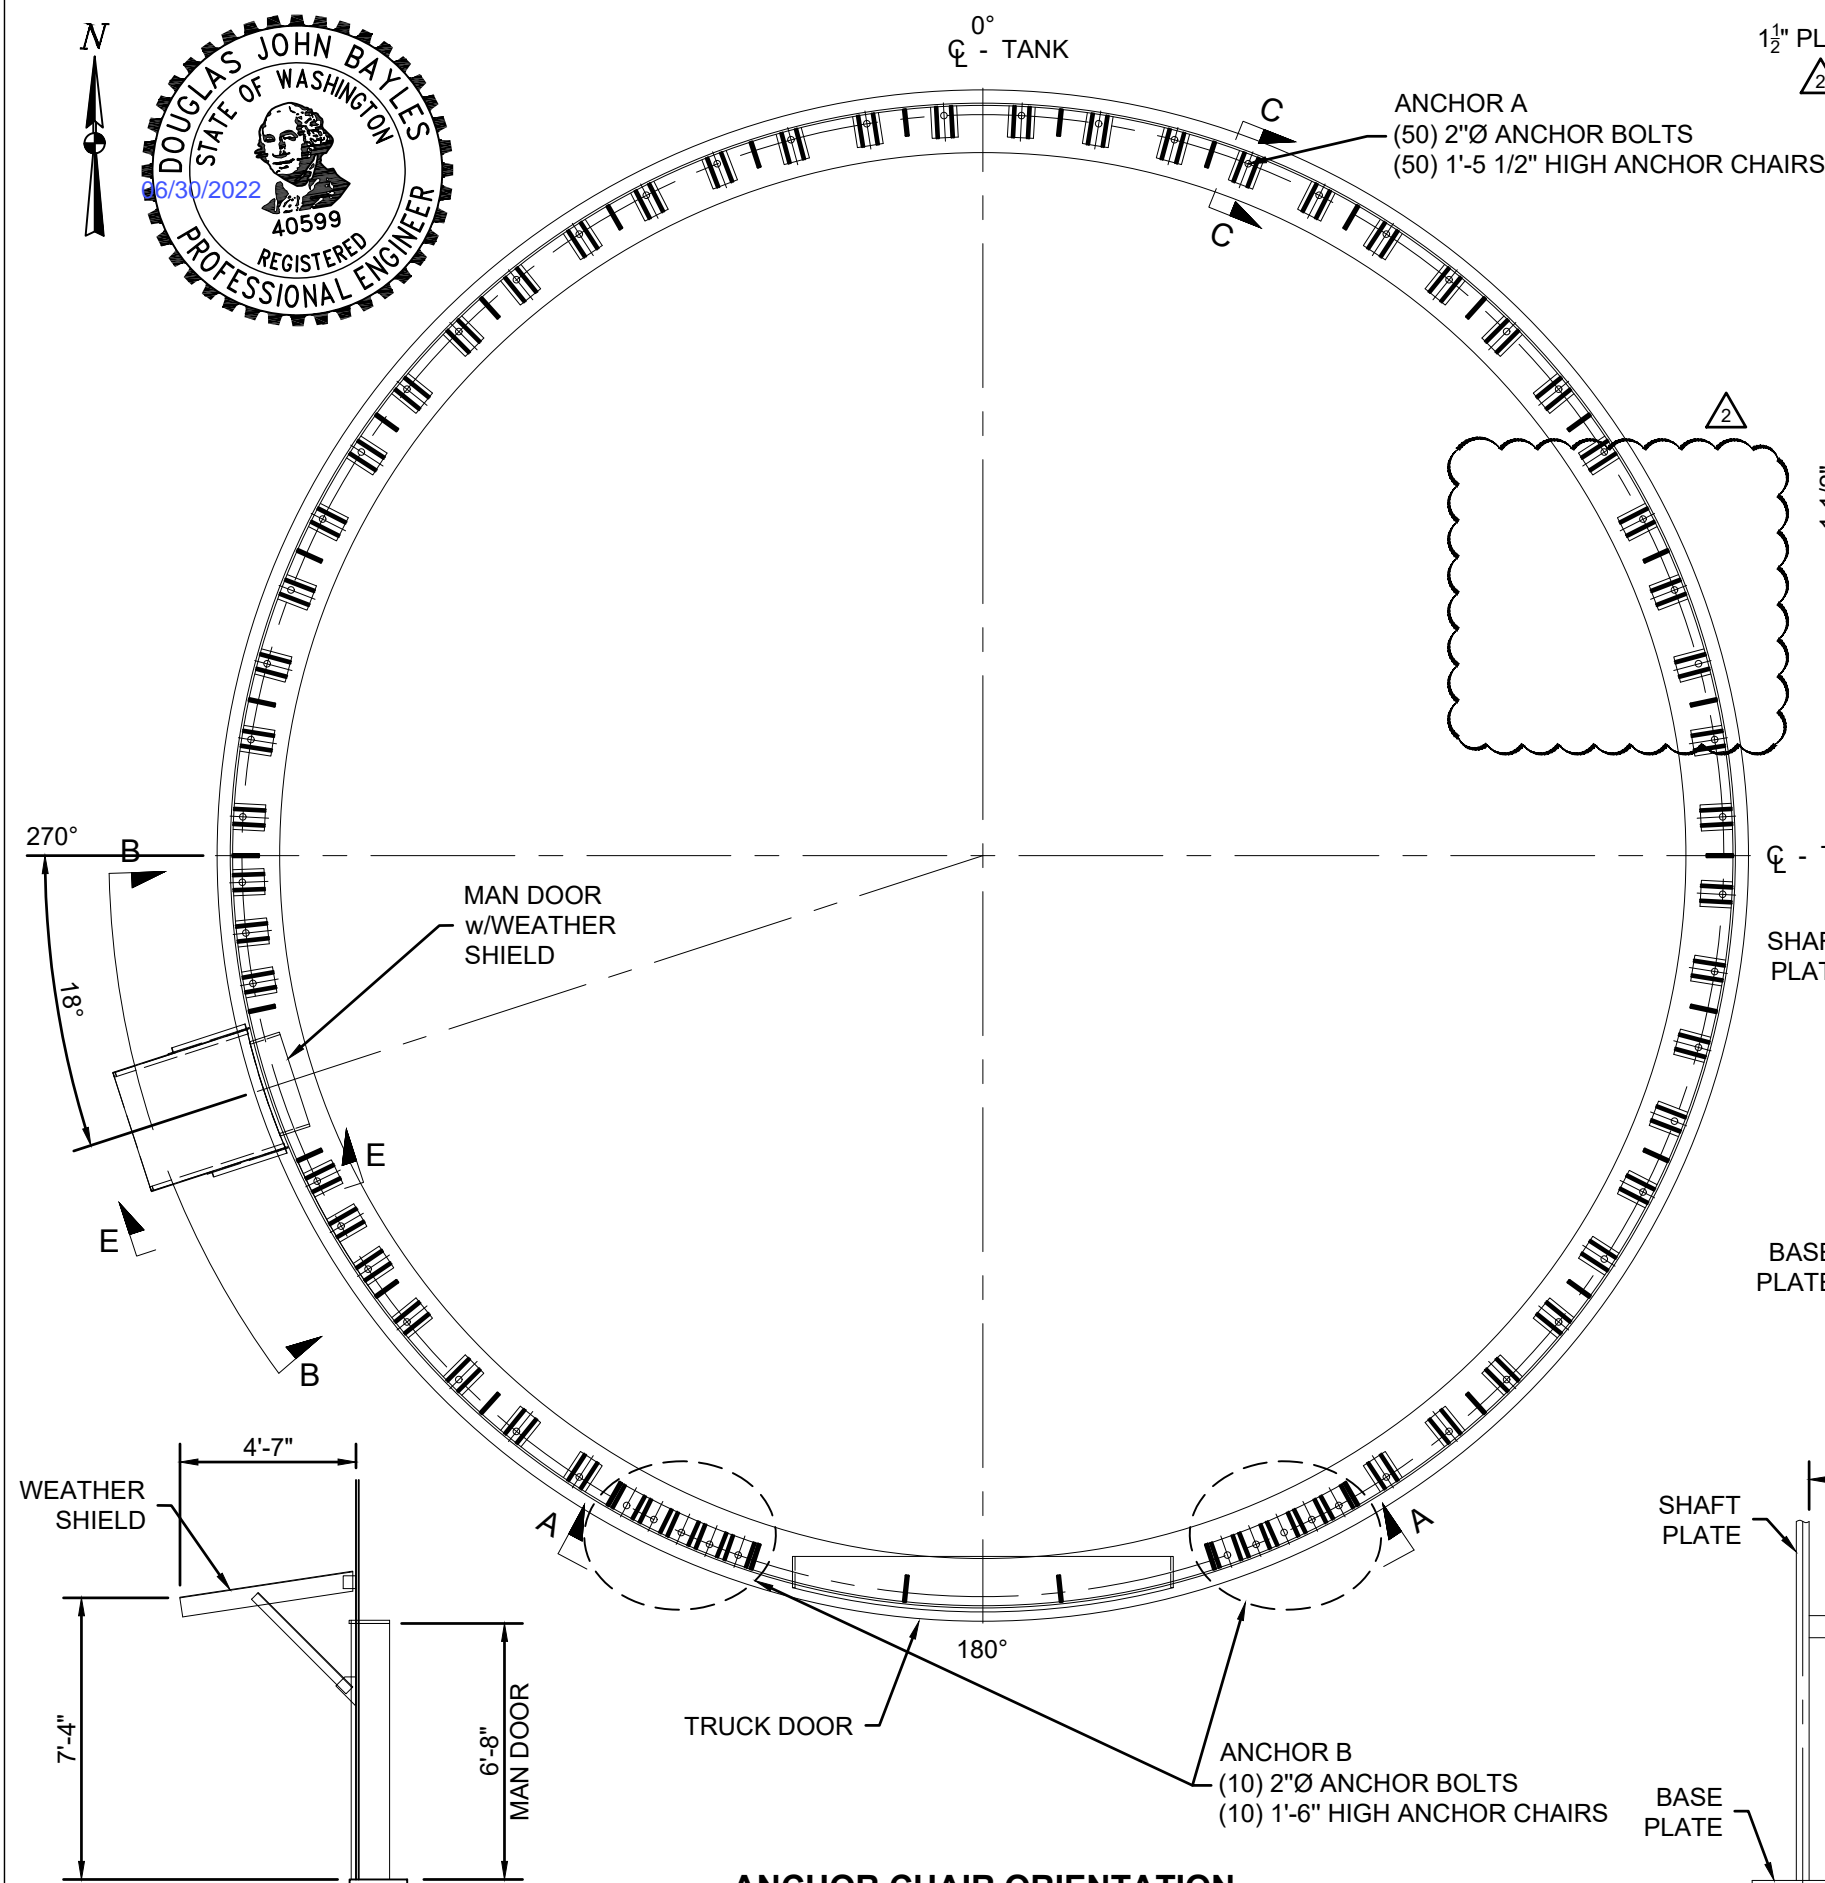

2	PJ	6/10/2022	REMOVED EAST ACCESS DOOR
1	PJ	3/31/2022	ADDED SECOND MAN DOOR & WEATHER SHIELDS
REV.	BY	DATE	DESCRIPTION
REVISIONS			

T BAILEY INC.

9628 S March Point Rd.
Anacortes, WA 98221
PH: (360) 293-0682 Website:
FAX: (360) 293-3893 www.TBailey.com

The technical information provided on this drawing is the confidential property of T Bailey Inc. Reproduction of this drawing or use of this information for anything other than its limited, intended purpose as to this project, without the written permission of T Bailey Inc., is prohibited.

DRAWN BY: DB	DATE: 1/13/2021	CHK'D BY: TJH	DATE: 1/13/2021
--------------	-----------------	---------------	-----------------

CUSTOMER: McCORMICK COMMUNITIES, LLC	70'-0" I.D. TANK
PROJECT: PORT ORCHARD 660 RESERVOIR	

TITLE: ANCHOR CHAIR & DOORS ORIENTATION & DETAILS

JOB#: 681-01 (HEI: 21-1657)	SHT#: GA-8	2
-----------------------------	------------	---