


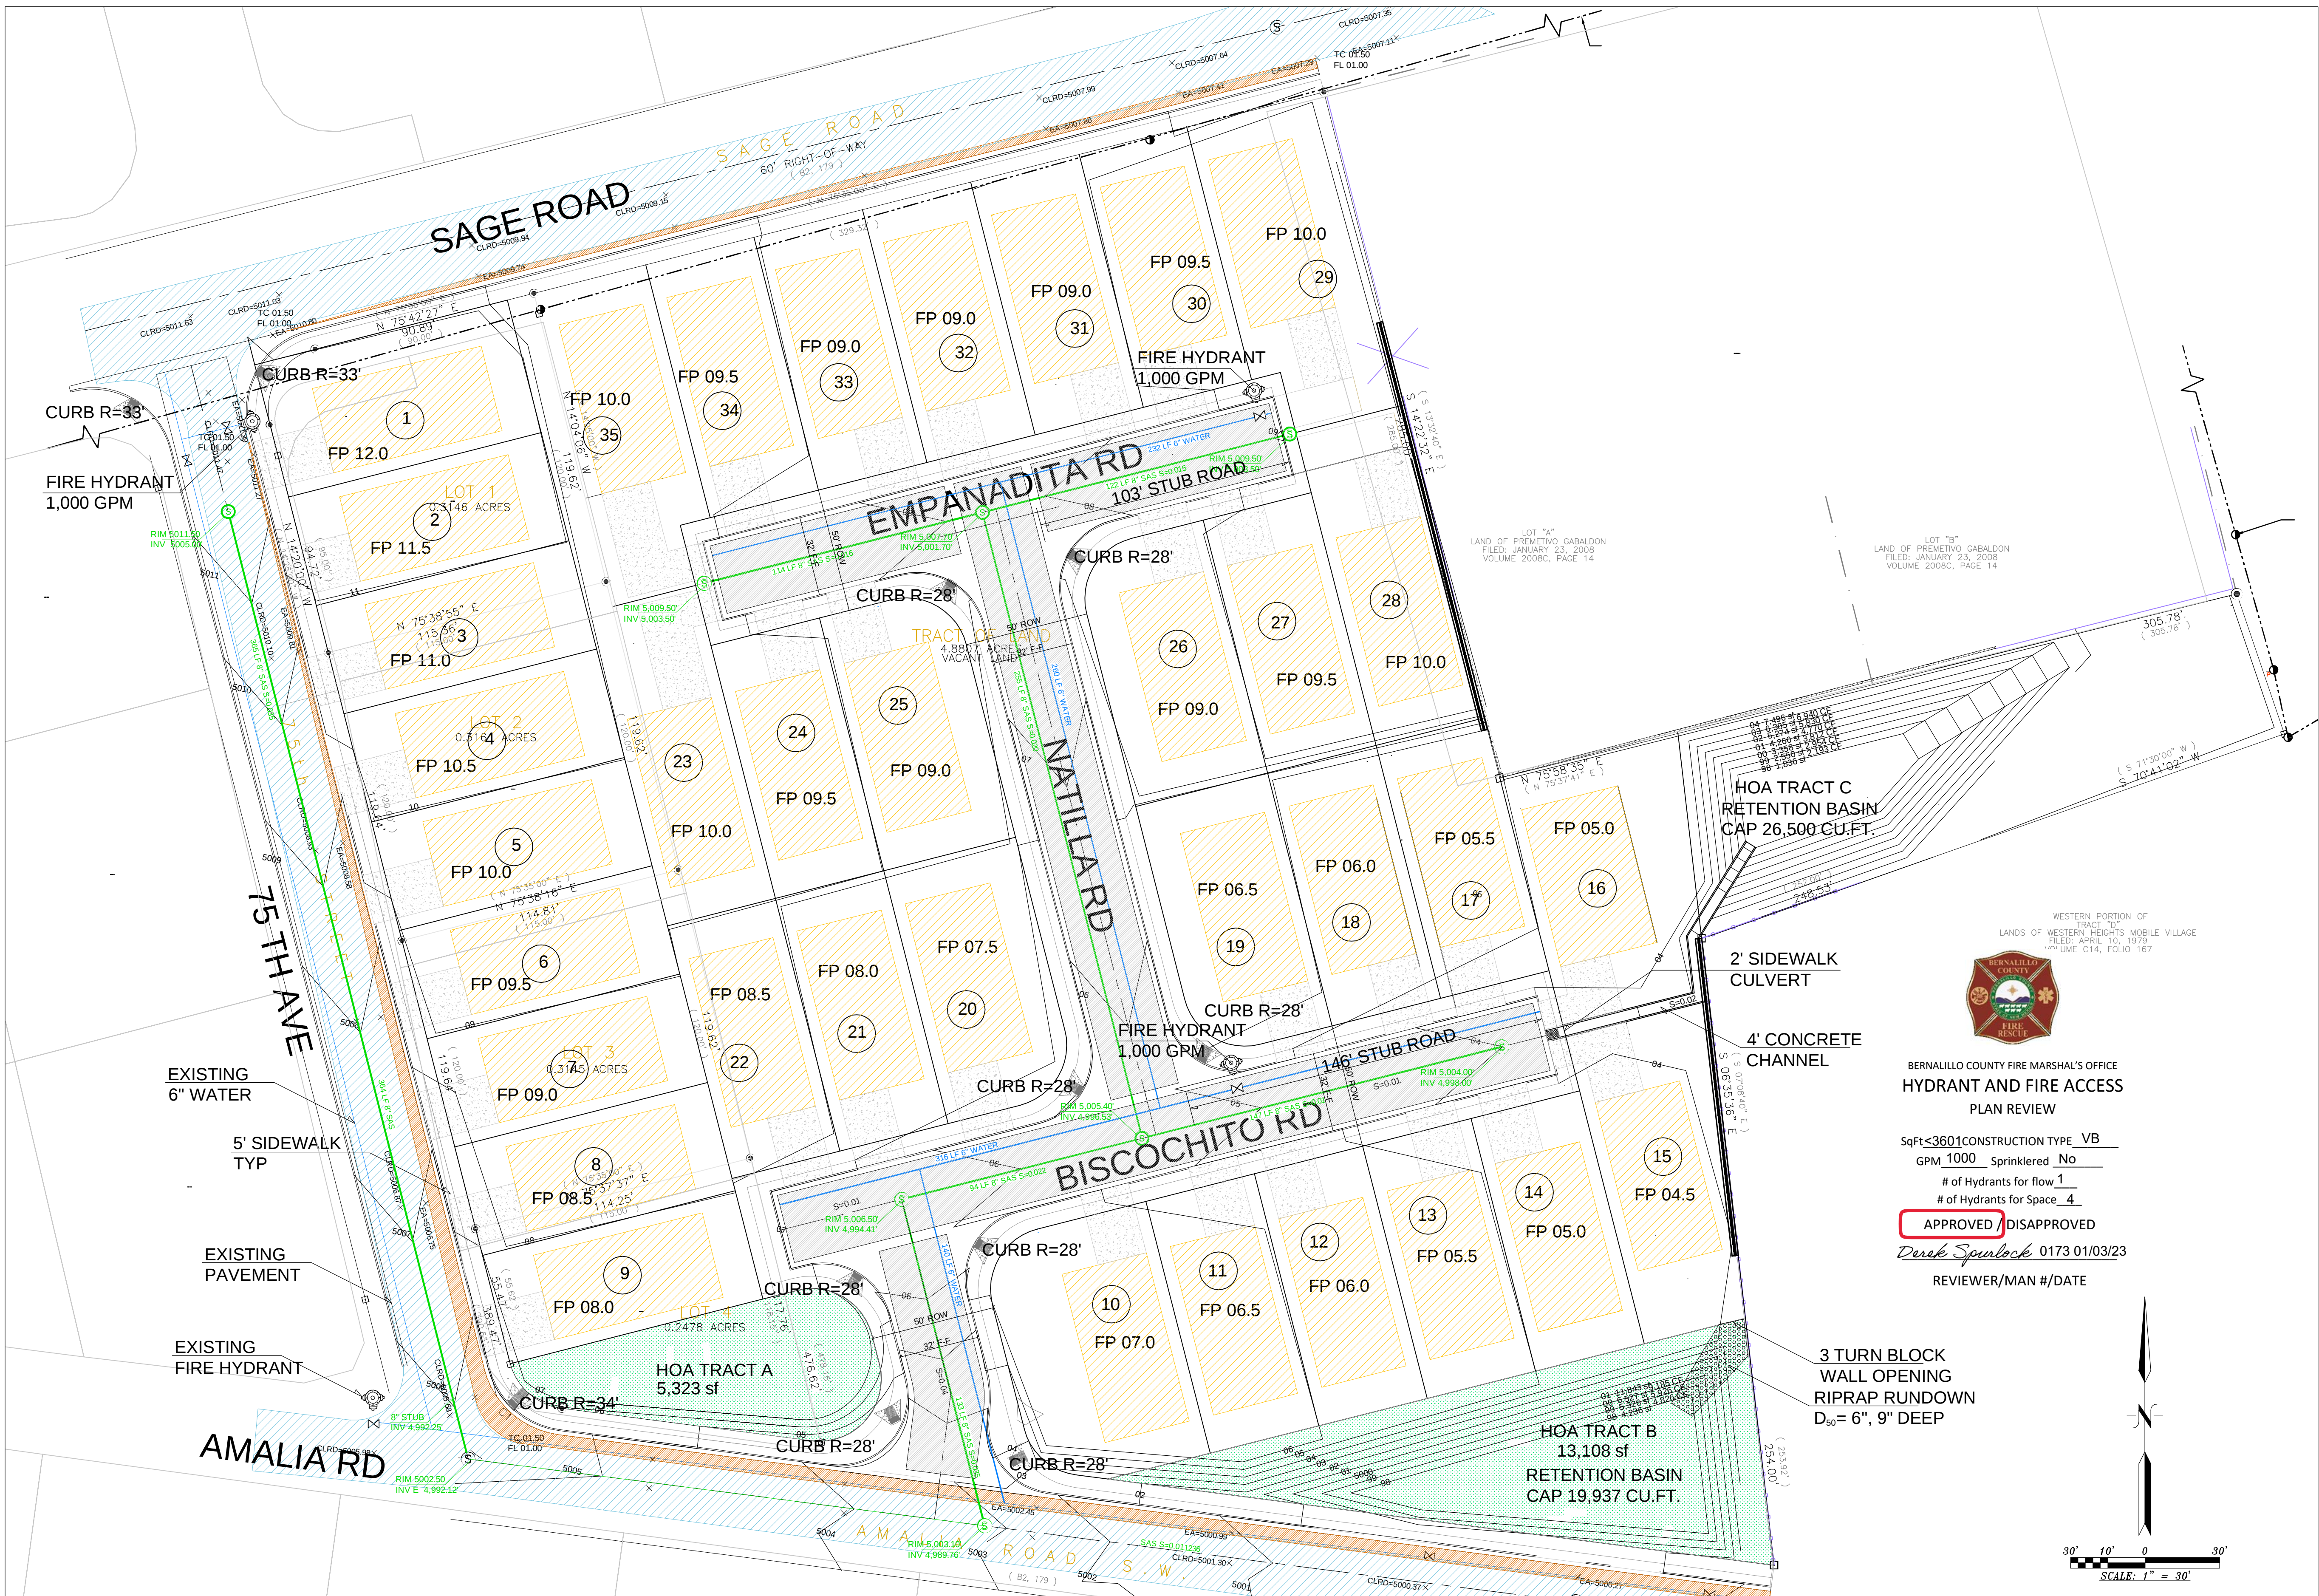


CURVE TABLE					
CURVE	RADIUS	ARC LENGTH	CHORD LENGTH	CHORD BEARING	DELTA ANGLE
C1	25.00'	29.80'	28.07'	S 48°28'56" E	68°17'52"
C2	25.00'	39.29'	35.37'	N 30°41'14" E	90°02'27"

WESTERN PORTION OF
TRACT "D"
LANDS OF WESTERN HEIGHTS MOBILE VILLAGE
FILED: APRIL 10, 1979
17" UME C14, FOLIO 167


BERNALILLO COUNTY FIRE MARSHAL'S OFFICE
HYDRANT AND FIRE ACCESS
PLAN REVIEW

SqFt<3601 CONSTRUCTION TYPE VB
GPM 1000 Sprinklered No
of Hydrants for flow 1
of Hydrants for Space 4
APPROVED / DISAPPROVED
Derek Spaullock 0173 01/03/23
REVIEWER/MAN #/DATE

3 TURN BLOCK
WALL OPENING
RIPRAP RUNDOWN
D₅₀ = 6", 9" DEEP

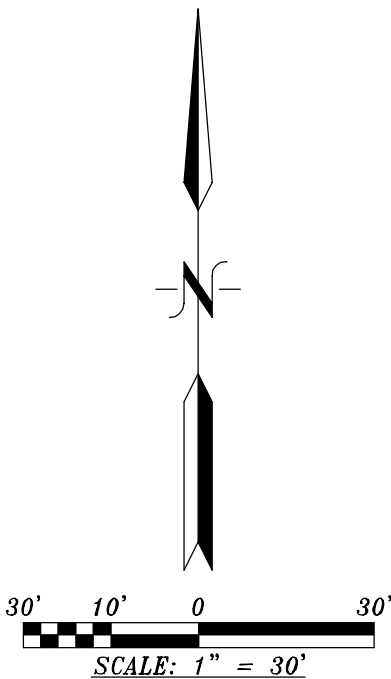

DESIGNED BY: M.H.B.

DRAWN BY: T.D.S.

CHECKED BY:



January 2, 2023

Mark H. Burak, P.E.
1512 Sagebrush Trail SE
Albuquerque, New Mexico, 87123
(505) 235-2256
mburak@comcast.net



Engineering
BURAK
Consulting
Development and Design

AMALIA SAGE SUBDIVISION

FIRE 1 PLAN

Single Family Residential - Building Code R-3

DRAWING NUMBER

F1

REVISION

BY

DATE

MARK

1 OF 1