

Architectural floor plan of the second floor, showing various rooms and dimensions:

- OFFICE** 11'-6" X 19'-11"
- OFFICE** 10'-4" X 19'-11"
- OFFICE** 16'-9" X 10'-9"
- OFFICE** 16'-9" X 11'-11"
- OFFICE** 11'-5" X 11'-8"
- BATH** 4'-8" X 5'-4"
- HALL** 10'-4" X 8'-3"
- STAIRWELL** 5'-0" X 11'-1"
- RETURN AIR**
- DOOR** (multiple locations)
- UP** (multiple locations)
- DOWN** (multiple locations)
- Dimensions:** 67' (overall width), 127' (overall length)




DATE:
7/18/2022

SCALE:
1/4"=1'

SHEET:
A-1

ARCHULETA
DRAFTING AND HOME DESIGN
LOUIE F. ARCHULETA PH. 505-326-5946
508 BARCELONA CR. CELL: (505) 486-5613
FARMINGTON, NM 87401
E-MAIL: archuleta166@outlook.com

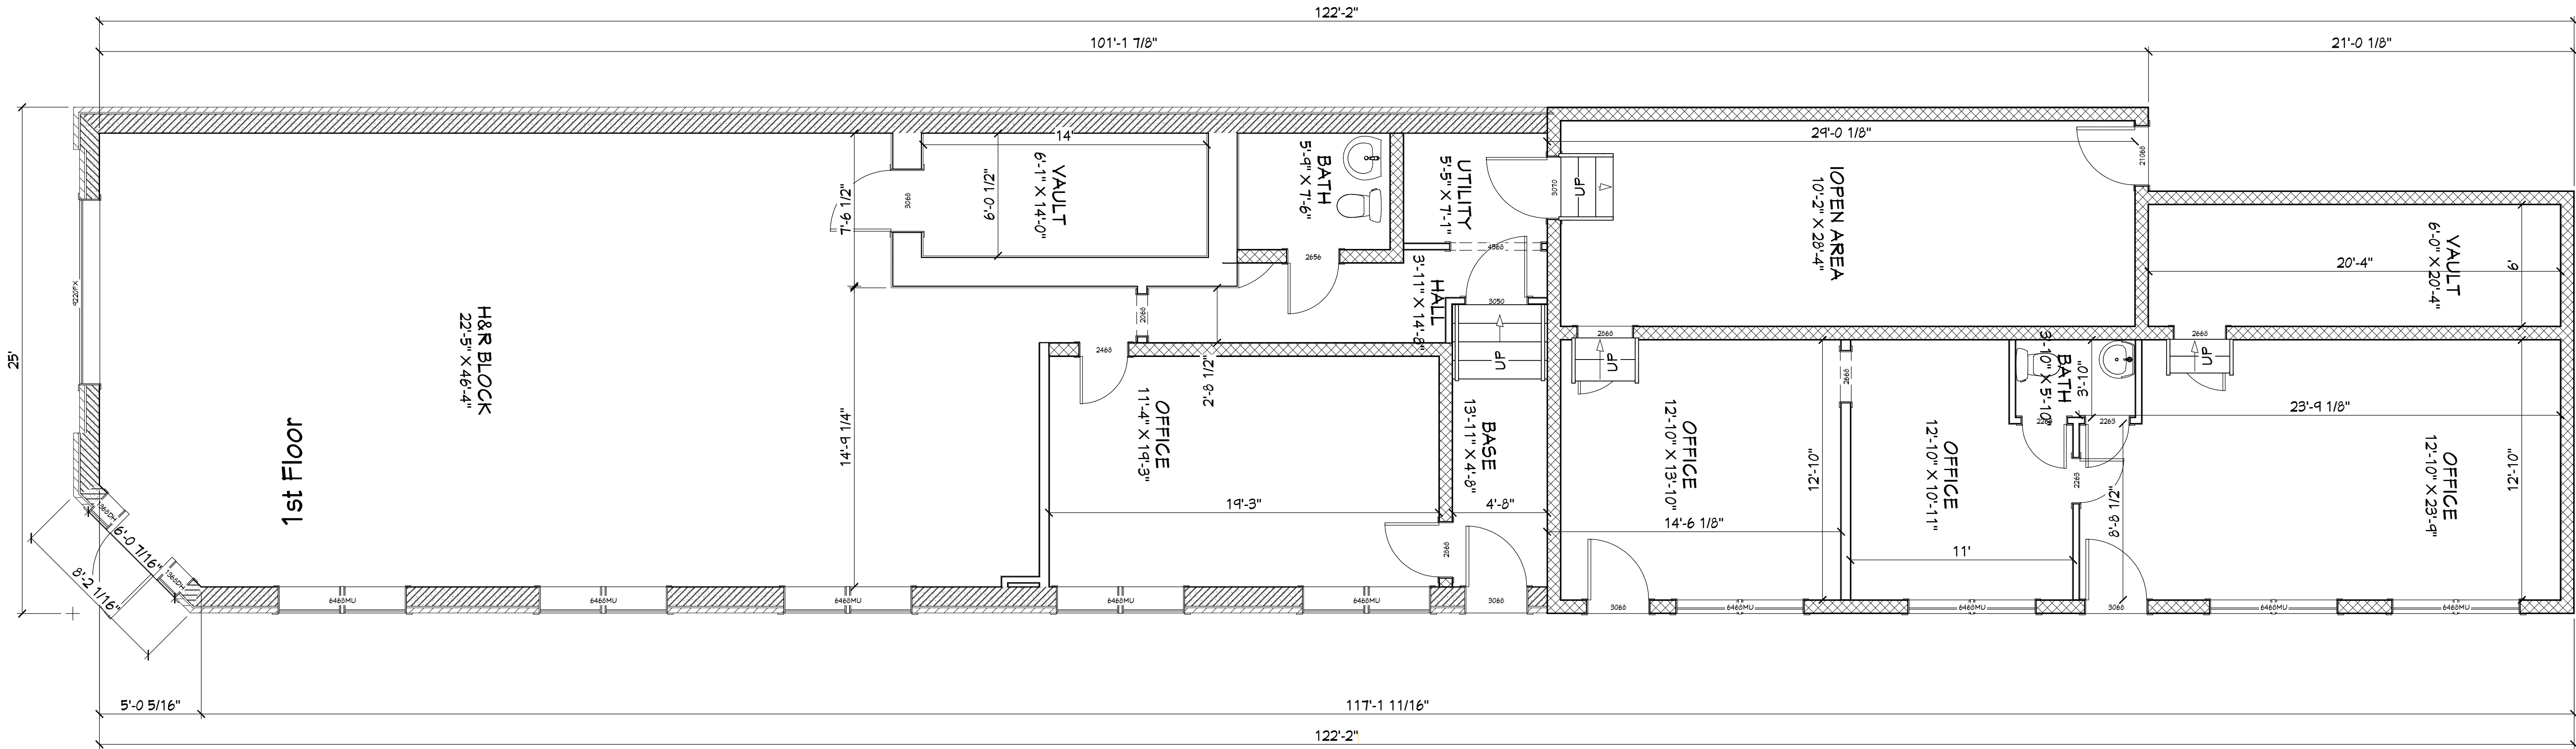


SITE PLAN AND AS-BUILT
H&R BLOCK UNIT 106
FARMINGTON, NM 97401

DATE:
7/18/2022
SCALE:
1/4"=1'
SHEET:

A-
2

THESE DRAWINGS ARE THE PROPRIETARY
WORK PRODUCT AND PROPERTY OF
ARCHULETA DRAFTING & HOME DESIGN
ARCHULETA DRAFTING & HOME DESIGN
OR CONTRACTOR/BUILDER WITHOUT THE
CONSENT OF ARCHULETA DRAFTING & HOME DESIGN
ANY CHANGES MADE TO ORIGINAL PLAN.

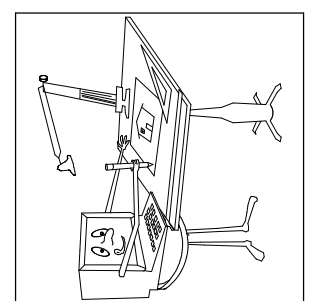

ARCHULETA
DRAFTING AND HOME DESIGN
LOUIE F. ARCHULETA PH. 505-326-5946
4509 BARCELONA CR. CELL: (505) 486-5673
FARMINGTON, NM 87401
E-MAIL: archuletaf66@outlook.com