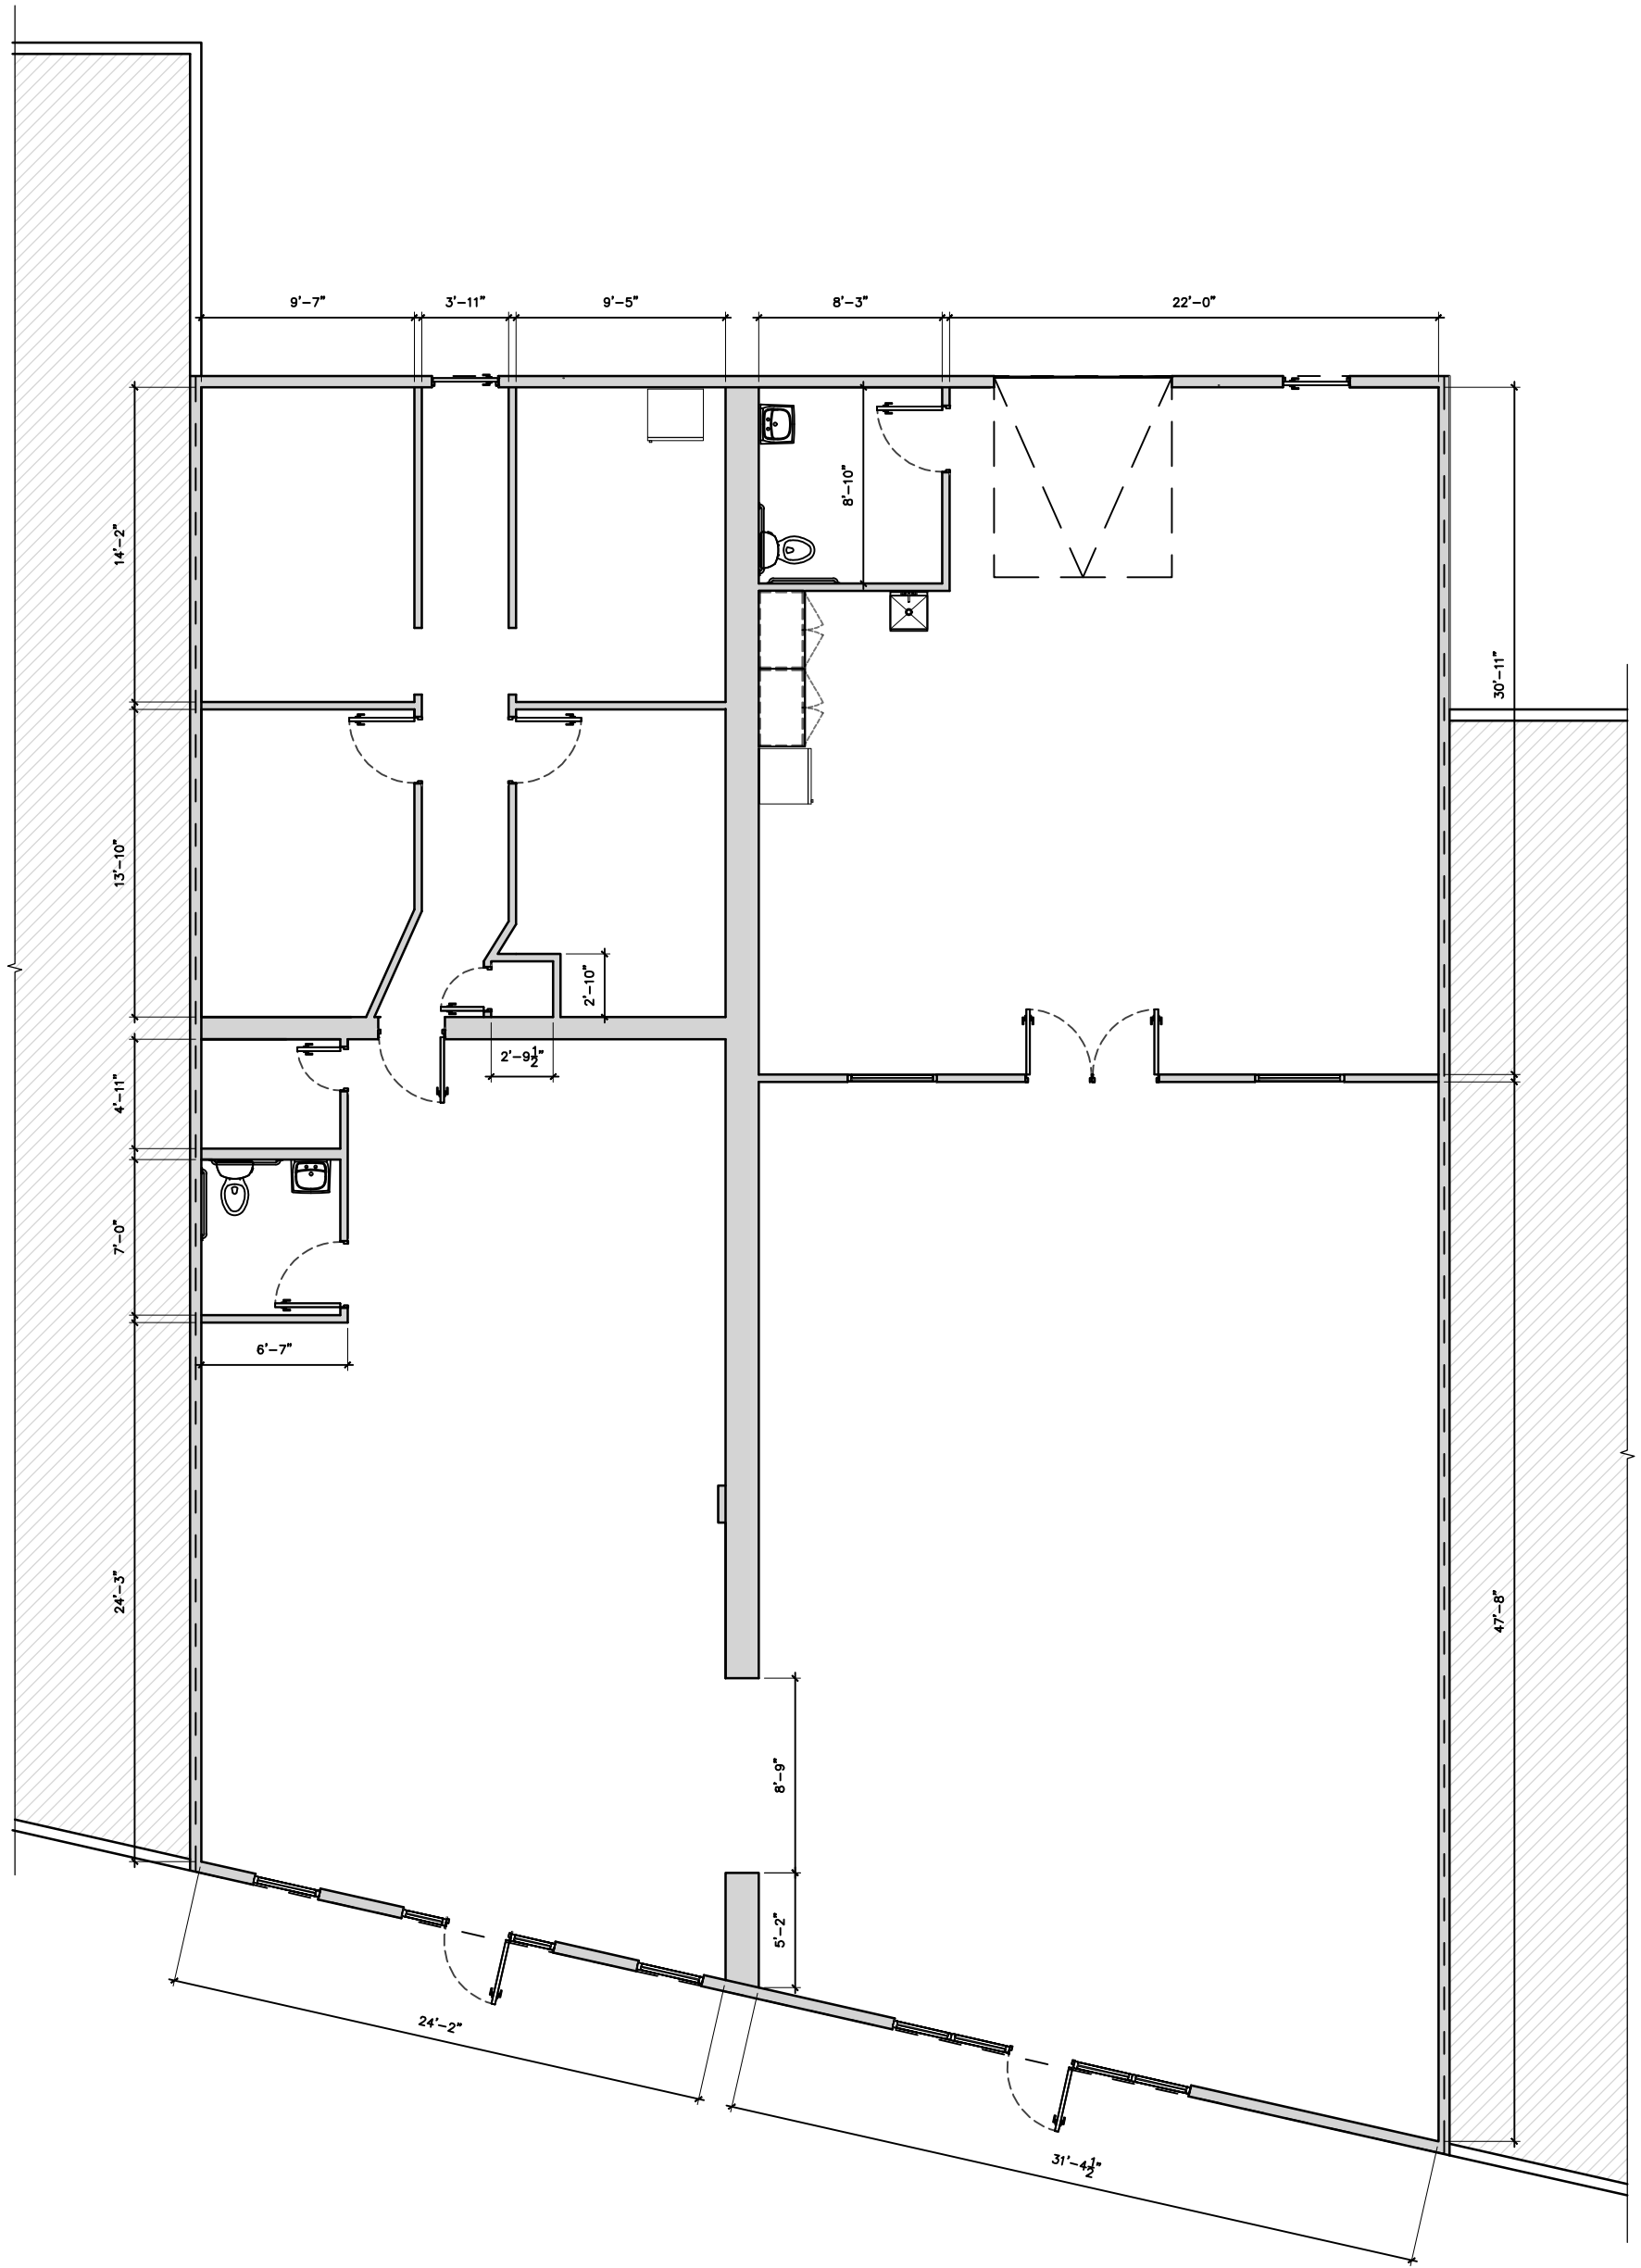


FLOOR PLAN

SCALE: 1/8"=1'-0"

ADDRESS:	812 SPRUCE
AREA:	4,137 SQ FT