


AS-BUILT SITE PLAN
1"=20'-0"

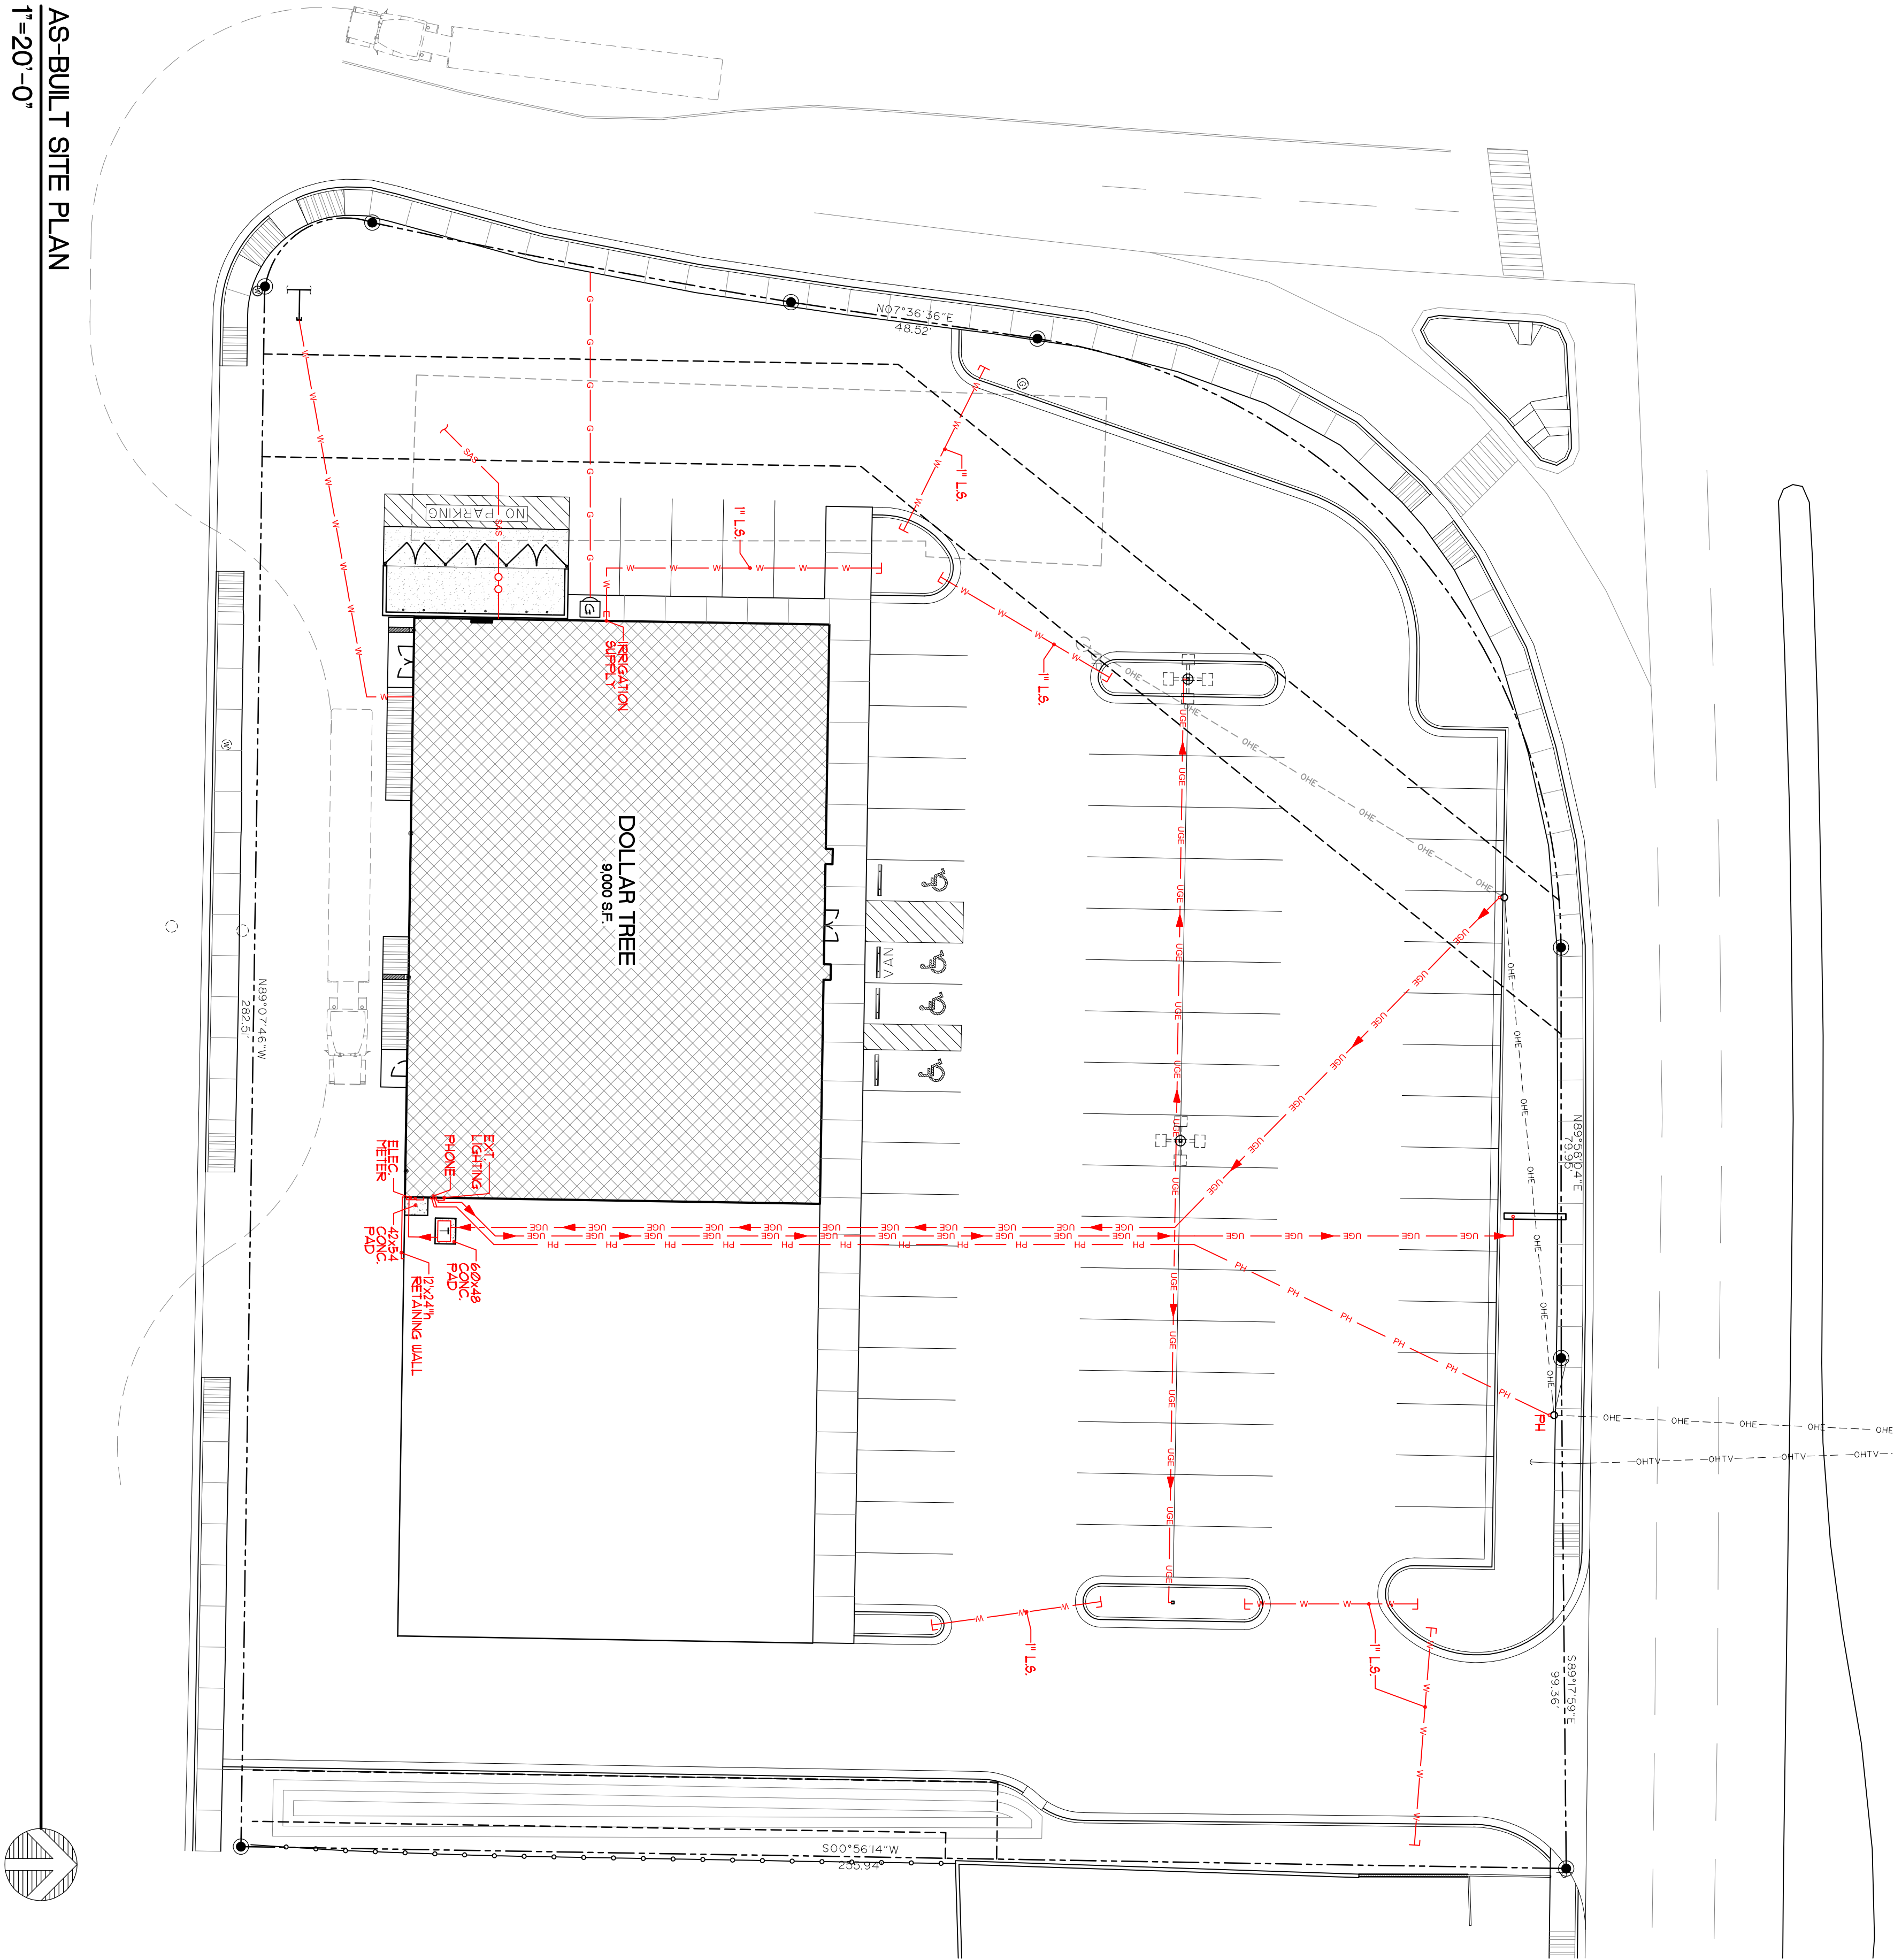

DATE:	8/2014
REVISIONS:	
SHEET:	

AS-BUILT SITE PLAN

LUCKY TURTLE, LLC
RETAIL DEVELOPMENT
SHELL BUILDING

501 E. BROADWAY AVENUE
FARMINGTON, NEW MEXICO

JOHN KIRKPATRICK
ARCHITECT

411 HWY 314 NW
LOS LUNAS, N.M.
P.O. BOX 1473
87031

AB