


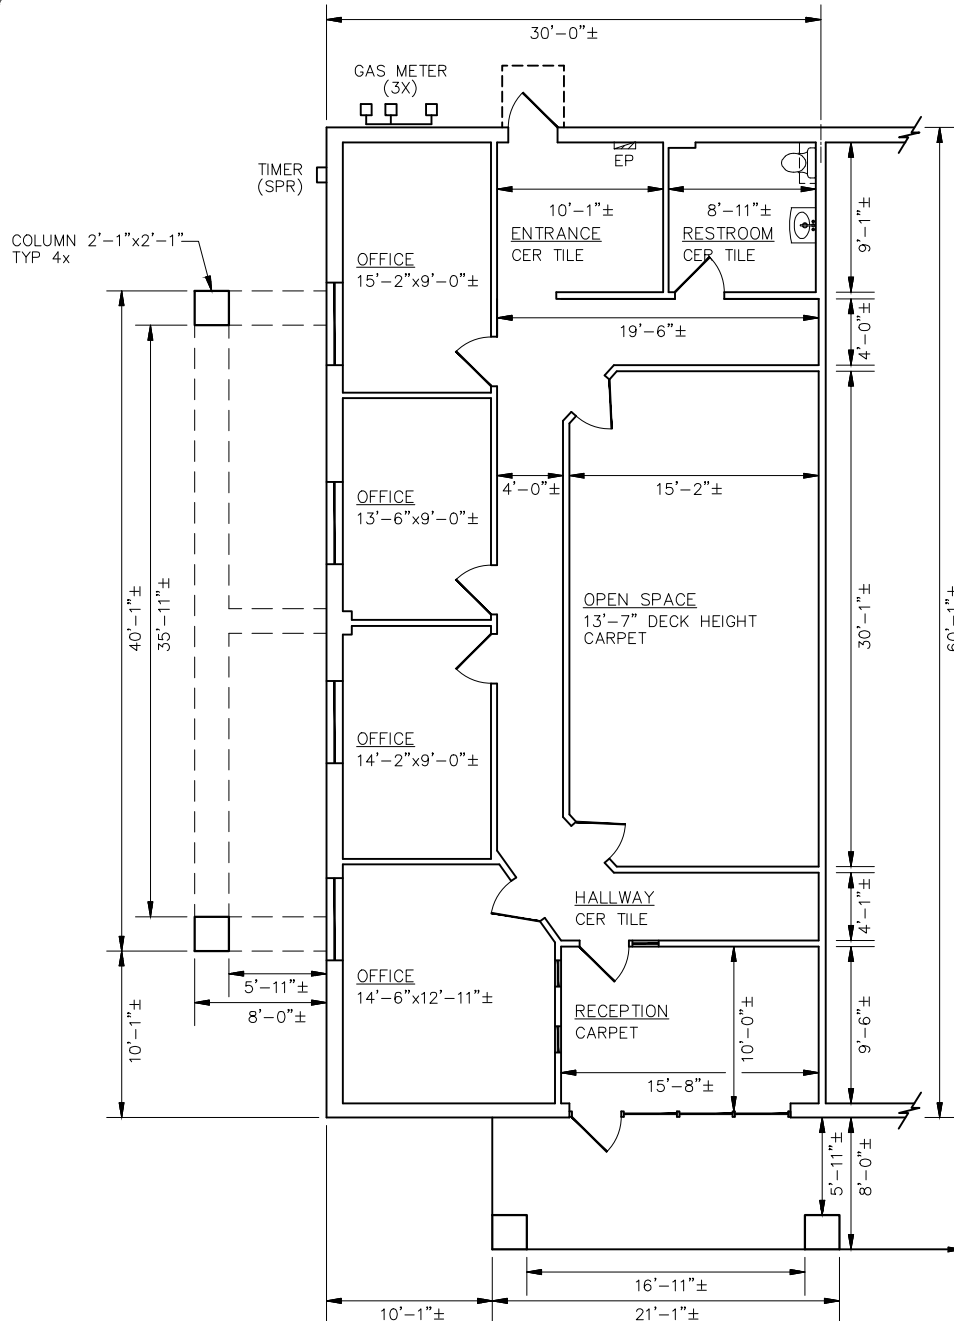

NOTES

1. ALL CALCULATIONS INDICATE "GROSS RETAIL" AREA AS PER "BOMA" STANDARDS.
2. ALL FIXTURES INDICATED ARE BUILT-IN.
3. ALL FLOORS ARE WOOD LAMINATE UNLESS OTHERWISE INDICATED.
4. ALL CEILING HEIGHTS ARE 9'-0" UNLESS OTHERWISE NOTED.
5. ALL DIMENSIONS TO BE FIELD VERIFIED PRIOR TO ANY CONSTRUCTION.

AREA CALCULATIONS:

TOTAL AREA 1802.50 SQ. FT.

PROJECT:
THE SHOPPES AT
TAYLOR RANCH

DESCRIPTION:
AS-BUILT
DRAWING

CLIENT:

SHEET #
01
OF 01

CLIENT REFERENCE #

4801 MONTANO RD NW SUITE B1, 87120

MSR'D BY: PL
DRAFTED BY: PL
CHECKED BY: SL
REVISED ON:

ORIENTATION:



REFERENCE #

SCALE:

DATE: 05/16/2022