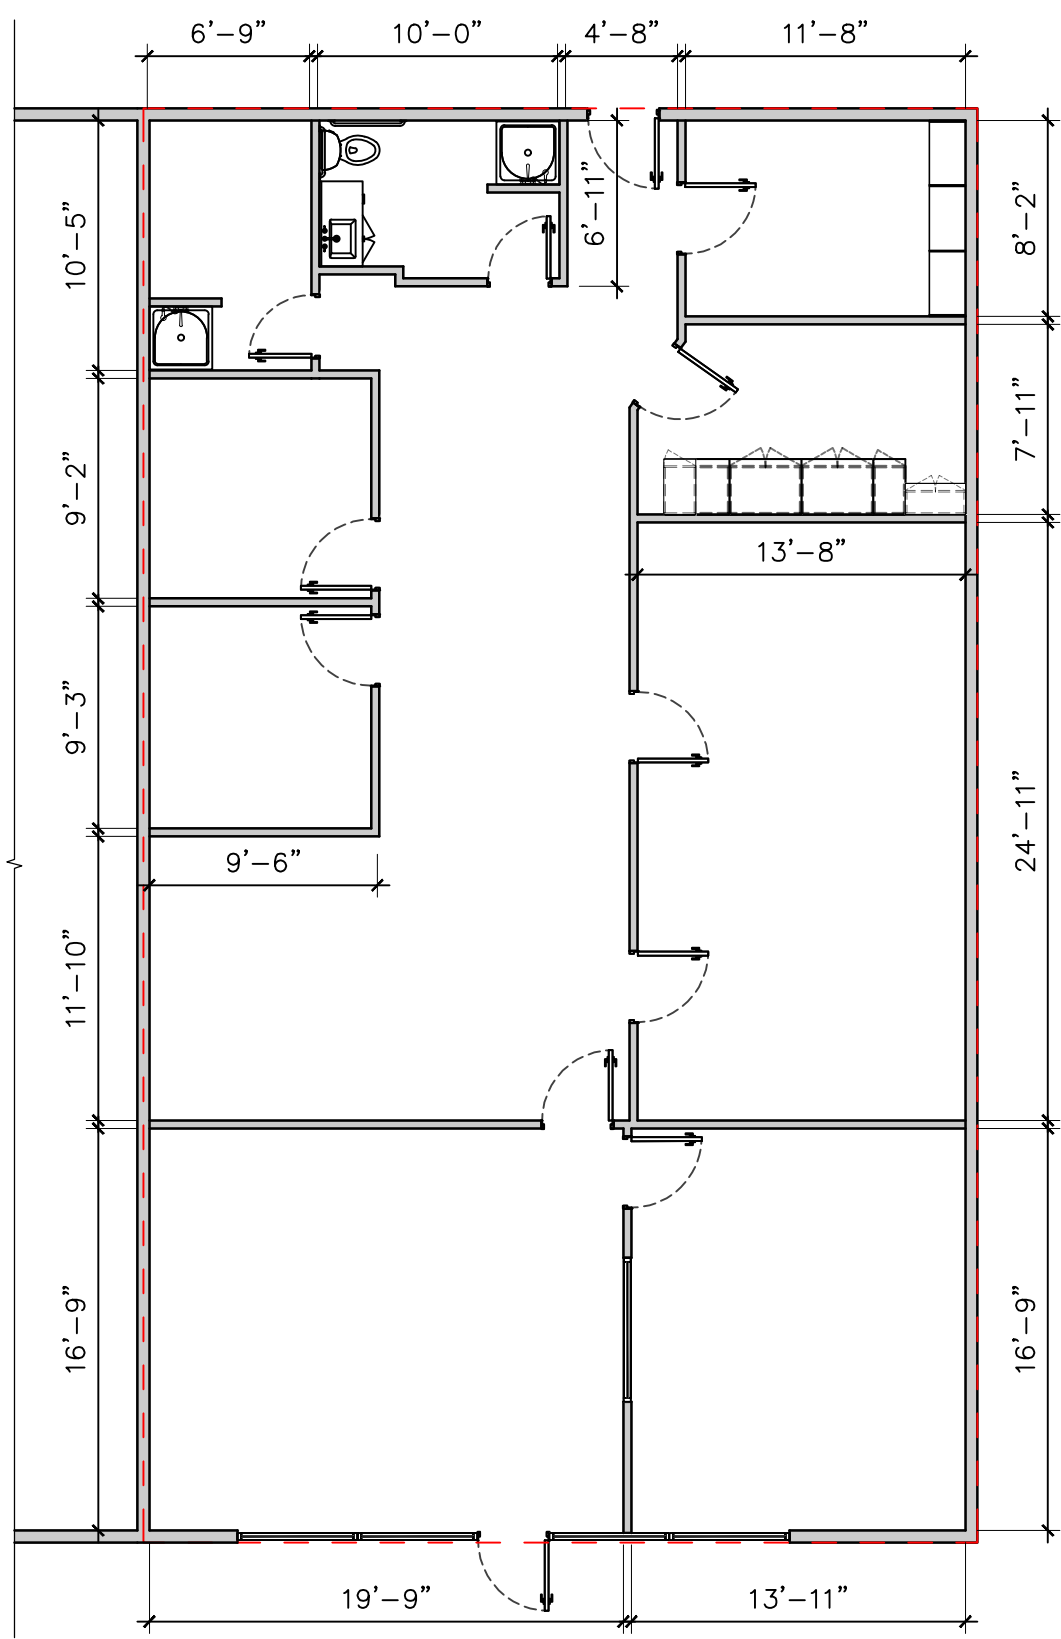


FLOOR PLAN

SCALE: 1/8"=1'-0"

ADDRESS:	1125 NORTH SOLANO
AREA:	2,076 SQ FT