


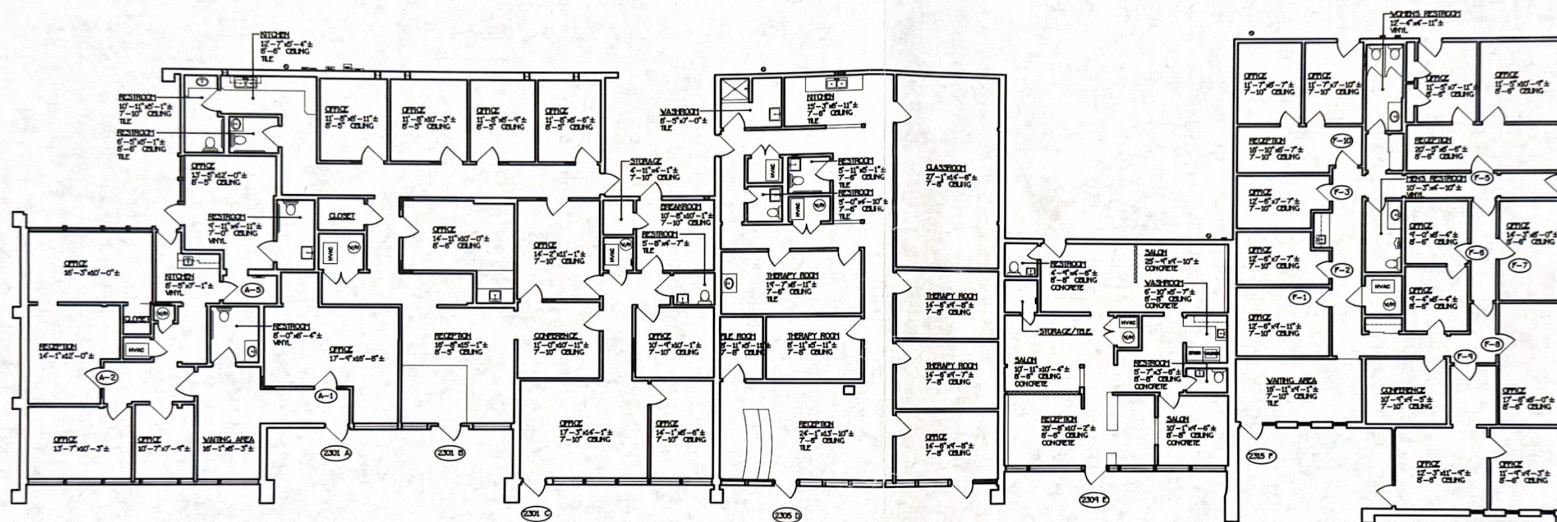

NOTES

1. ALL CALCULATIONS INDICATE "GROSS RETAIL" AREA AS PER "BOMA" STANDARDS.
2. AREA CALCULATIONS FOR 2301 AND 2315 ARE CALCULATED AS "GROSS RETAIL" WITH COMMON AREA AS PER "BOMA" STANDARDS.
3. ALL FIXTURES INDICATED ARE BUILT-IN.
4. ALL FLOORS ARE CARPET UNLESS OTHERWISE INDICATED.
5. ALL CEILING HEIGHTS ARE 8'-0" UNLESS OTHERWISE NOTED.
6. ALL DIMENSIONS TO BE FIELD VERIFIED PRIOR TO ANY CONSTRUCTION.

"GROSS RETAIL" AREA CALCULATIONS:

2301 A	1724.91 SQ. FT.	Aid Home Healthcare
2301 B	1921.17 SQ. FT.	Southwest Funding
2301 C	827.29 SQ. FT.	
2305 D	2357.98 SQ. FT.	Spa Pima
2309 E	1058.58 SQ. FT.	Collage Hair Salon
2315 F	2761.39 SQ. FT.	Multiple Tenants

"USEABLE" AREA CALCULATIONS:

2301 A-1	274.18 SQ. FT.	Aid Home Healthcare
2301 A-2	634.05 SQ. FT.	
2301 A-5	282.50 SQ. FT.	
2301 A COMMON	534.17 SQ. FT.	
2315 F-1	132.52 SQ. FT.	Ruth Ann Bowker
2315 F-2	97.52 SQ. FT.	Janitorial Storage
2315 F-3	97.25 SQ. FT.	Eleganza Skin Care
2315 F-5	398.76 SQ. FT.	Dr. Georgia Graham
2315 F-6	157.03 SQ. FT.	League of Women
2315 F-7	125.11 SQ. FT.	Voters
2315 F-8	156.71 SQ. FT.	Vacant
2315 F-9	458.14 SQ. FT.	Farmer's Insurance
2315 F-10	321.89 SQ. FT.	ABQ Home Care
2315 F COMMON	799.68 SQ. FT.	

AS OF JUNE 1, 2009

PROJECT:
2301, 2305
2309, 2315
SAN PEDRO
NE

DESCRIPTION:
AS-BUILT
DRAWING

CLIENT:

COMMERCIAL
REAL ESTATE
MANAGEMENT

CLIENT REFERENCE #

SHEET #
01
OF 01

MSRD BY: D.G.

DRAFTED BY: D.G.

CHECKED BY: P.M.

REVISED ON:

SCALE: 1/16" = 1'-0"

ORIENTATION:



DATE: 09/19/08

COMPUTER DRAFTING
& DESIGN BY:

YOUR CAD
DRAFTING

CALL 805-899-1199