


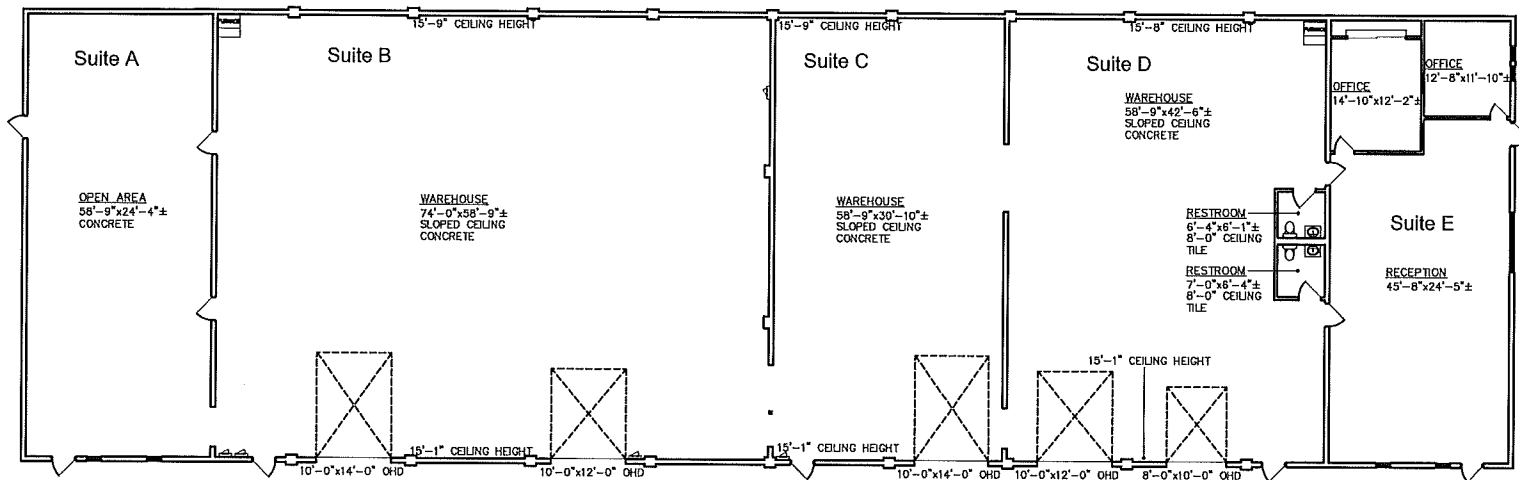

2105 AZTEC BLVD. NE, EAST BLDG.

Suite A - 1518.75 sf
 Suite B - 4480.88 sf
 Suite C - 1811.26 sf
 Suite D - 2572.59 sf
 Suite E - 1620.07 sf

NOTES

1. ALL CALCULATIONS INDICATE "GROSS RETAIL" AREA AS PER "BOMA" STANDARDS.
2. ALL FIXTURES INDICATED ARE BUILT-IN.
3. ALL FLOORS ARE CARPET UNLESS OTHERWISE INDICATED.
4. ALL CEILING HEIGHTS ARE 9'-0" UNLESS OTHERWISE NOTED.
5. ALL DIMENSIONS TO BE FIELD VERIFIED PRIOR TO ANY CONSTRUCTION.

AREA CALCULATIONS:

NORTH OFFICE AREA 1518.75 SQ. FT.
 NORTH WAREHOUSE AREA 4480.88 SQ. FT.
 NORTH OFFICE AREA 1620.07 SQ. FT.
SOUTH WAREHOUSE AREA 4384.53 SQ. FT.
 TOTAL AREA 12,004.23 SQ. FT.

ORIENTATION 	MEASURED BY	JR
	DESIGNED BY	N.A.
	DRAFTED BY	JR
	CHECKED BY	P.M.
SCALE 1/16"=1'-0"	DATE 01/17/11	REVISED 3

SHEET #
01
 OF 01

PROJECT:
**2105
 AZTEC ROAD NE
 EAST
 BLDG.**

DESCRIPTION:
**AS-BUILT
 DRAWING**

CLIENT:
**COMMERCIAL
 REAL
 ESTATE
 MANAGEMENT**

YCD DESIGNS
 505-899-1199