


ADDRESS:	1061 NORTH SOLANO
AREA:	1,105 SQ FT



FLOOR PLAN

SCALE: 3/16"=1'-0"

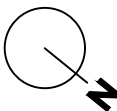