


NOTES

- 1. ALL CALCULATIONS INDICATE "GROSS RETAIL" AREA AS PER "BOMA" STANDARDS.
- 2. ALL FIXTURES INDICATED ARE BUILT-IN.
- 3. ALL FLOORS ARE CARPET UNLESS OTHERWISE INDICATED.
- 4. ALL CELING HEIGHTS ARE 9'-10" UNLESS OTHERWISE NOTED.
- 5. ALL DIMENSIONS TO BE FIELD VERIFIED PRIOR TO ANY CONSTRUCTION.

AREA CALCULATIONS:

AREA 3708.85 SQ. FT.

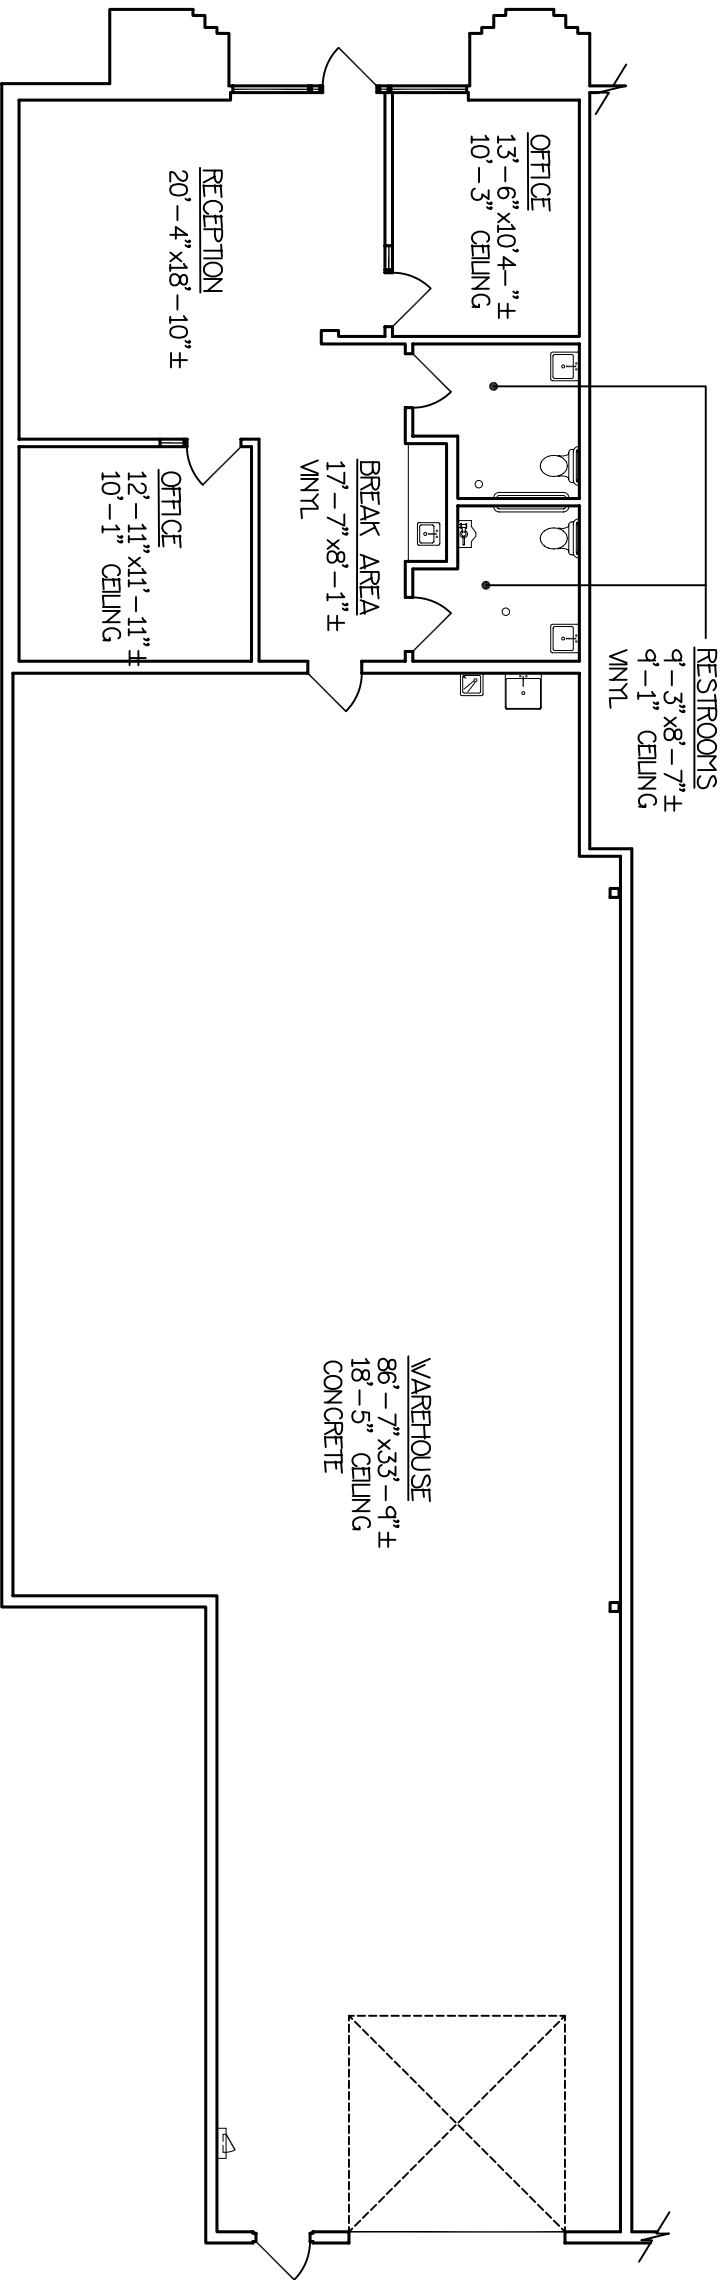

PROJECT:

520
AIRPORT DR. NW
SUITE A9

DESCRIPTION:

AS-BUILT
DRAWING

CLIENT:

DON
GRADY

CLIENT REFERENCE #

SHEET #

02
OF 02


MSRPD BY: JR

DRAFTED BY: JR

CHECKED BY: M.G.


REVISED ON:

ORIENTATION:

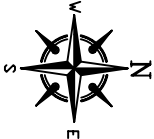

COMPUTER DRAFTING

& DESIGN BY:

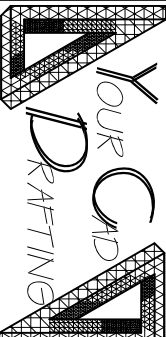

SCALE: 3/32"=1'-0"

DATE: 09/12/08

DESIGN #

5

CALL: 505-899-1199