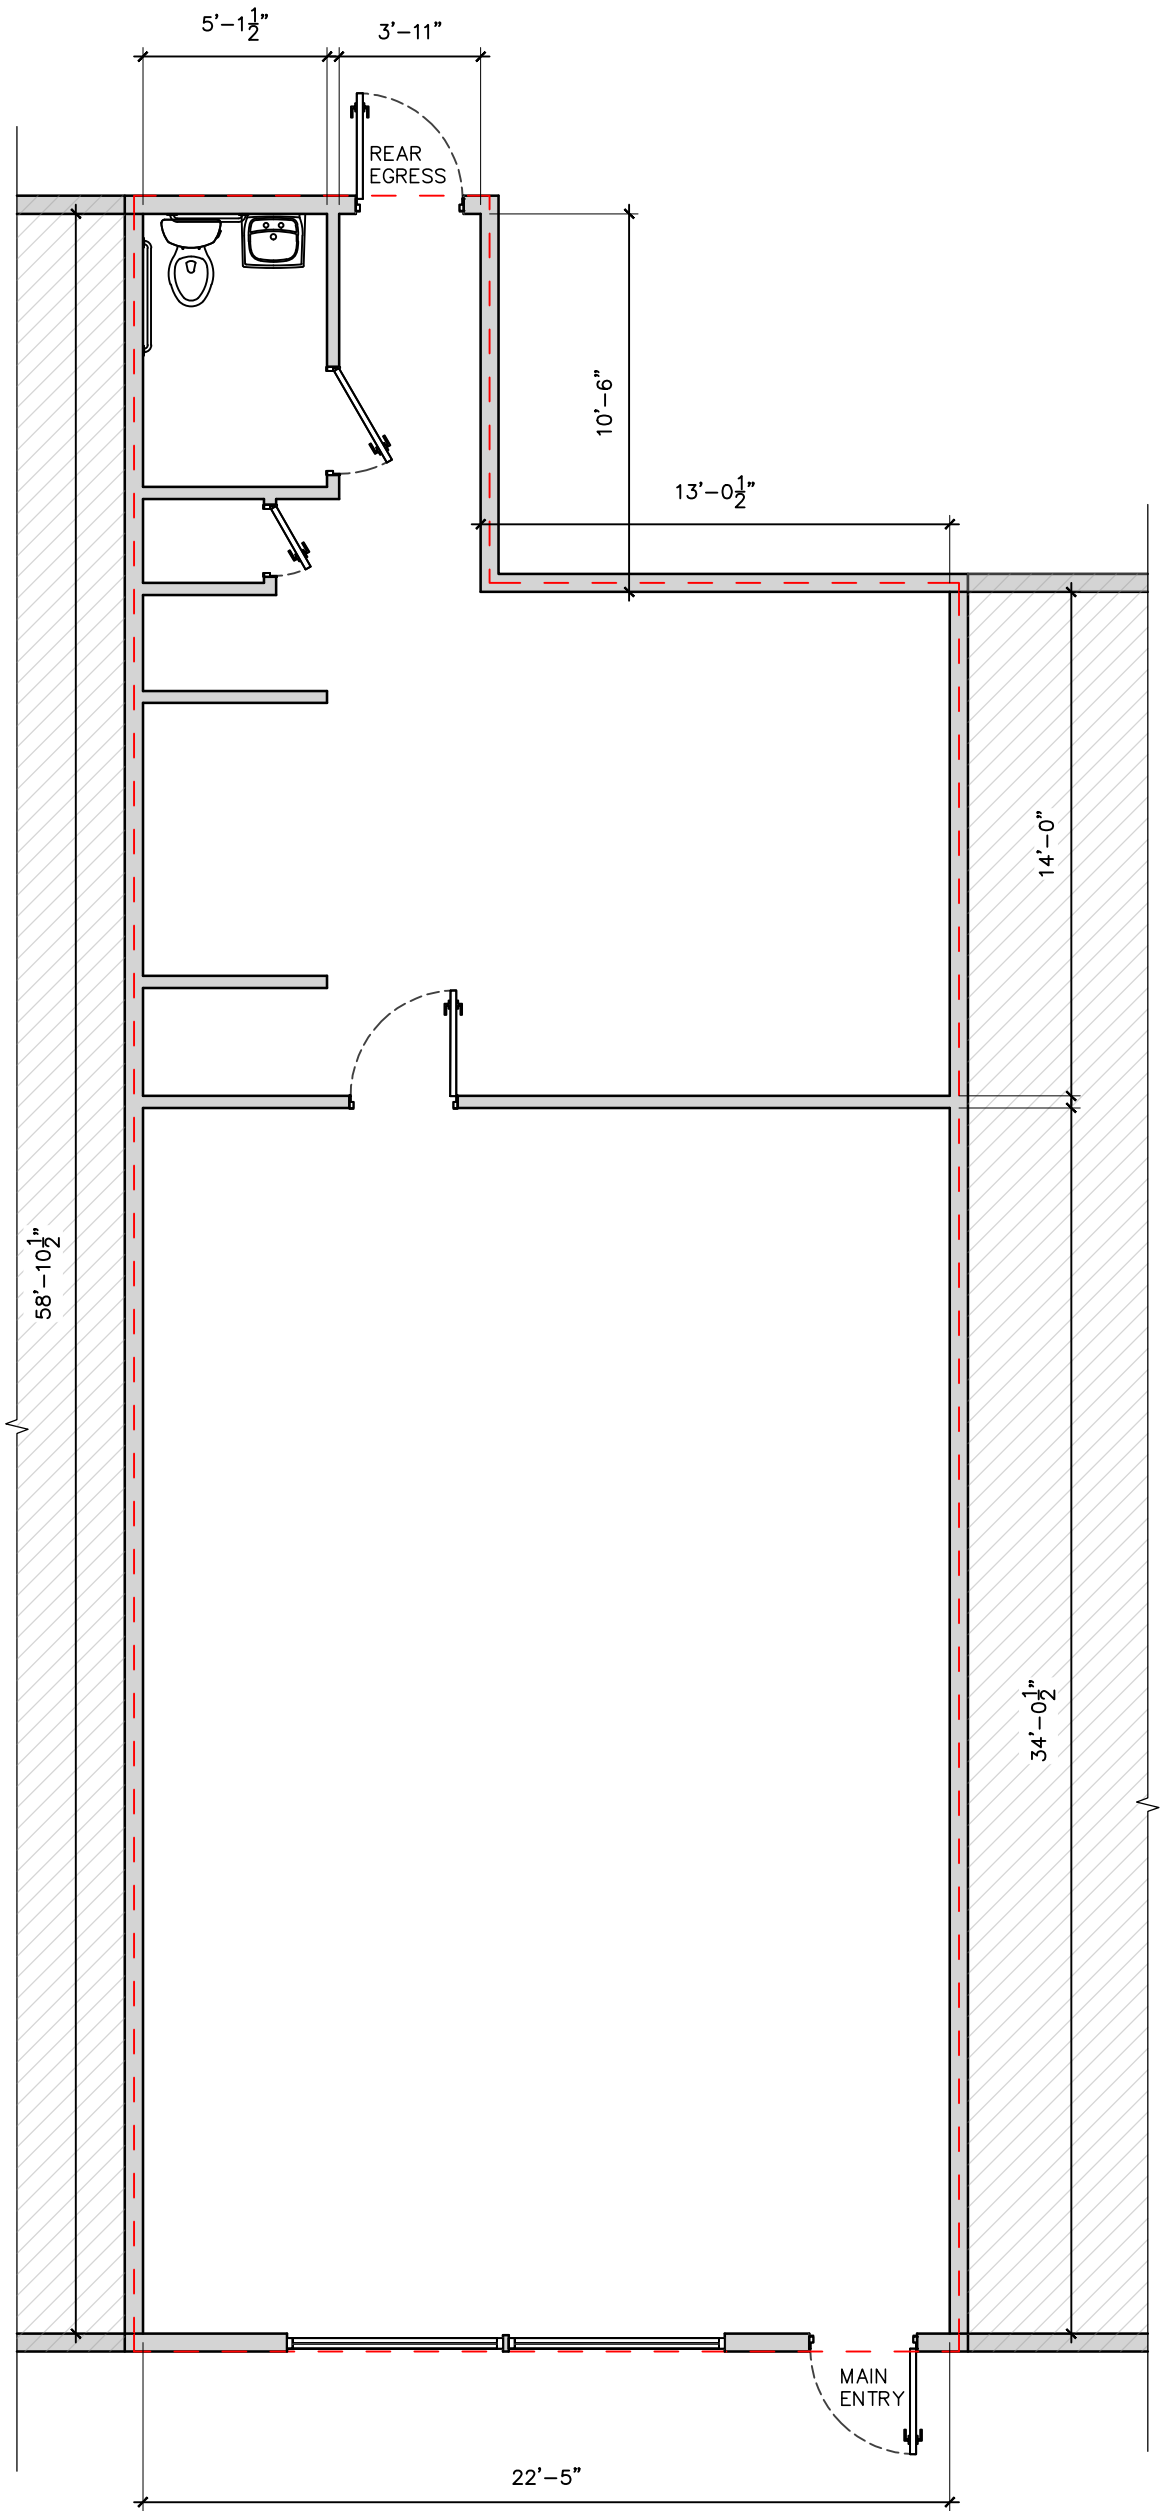


FLOOR PLAN

SCALE: 3/16"=1'-0"

ADDRESS:	1115 NORTH SOLANO
AREA:	1,232 SQ FT