


475 COORS ROAD NW - SUITE E

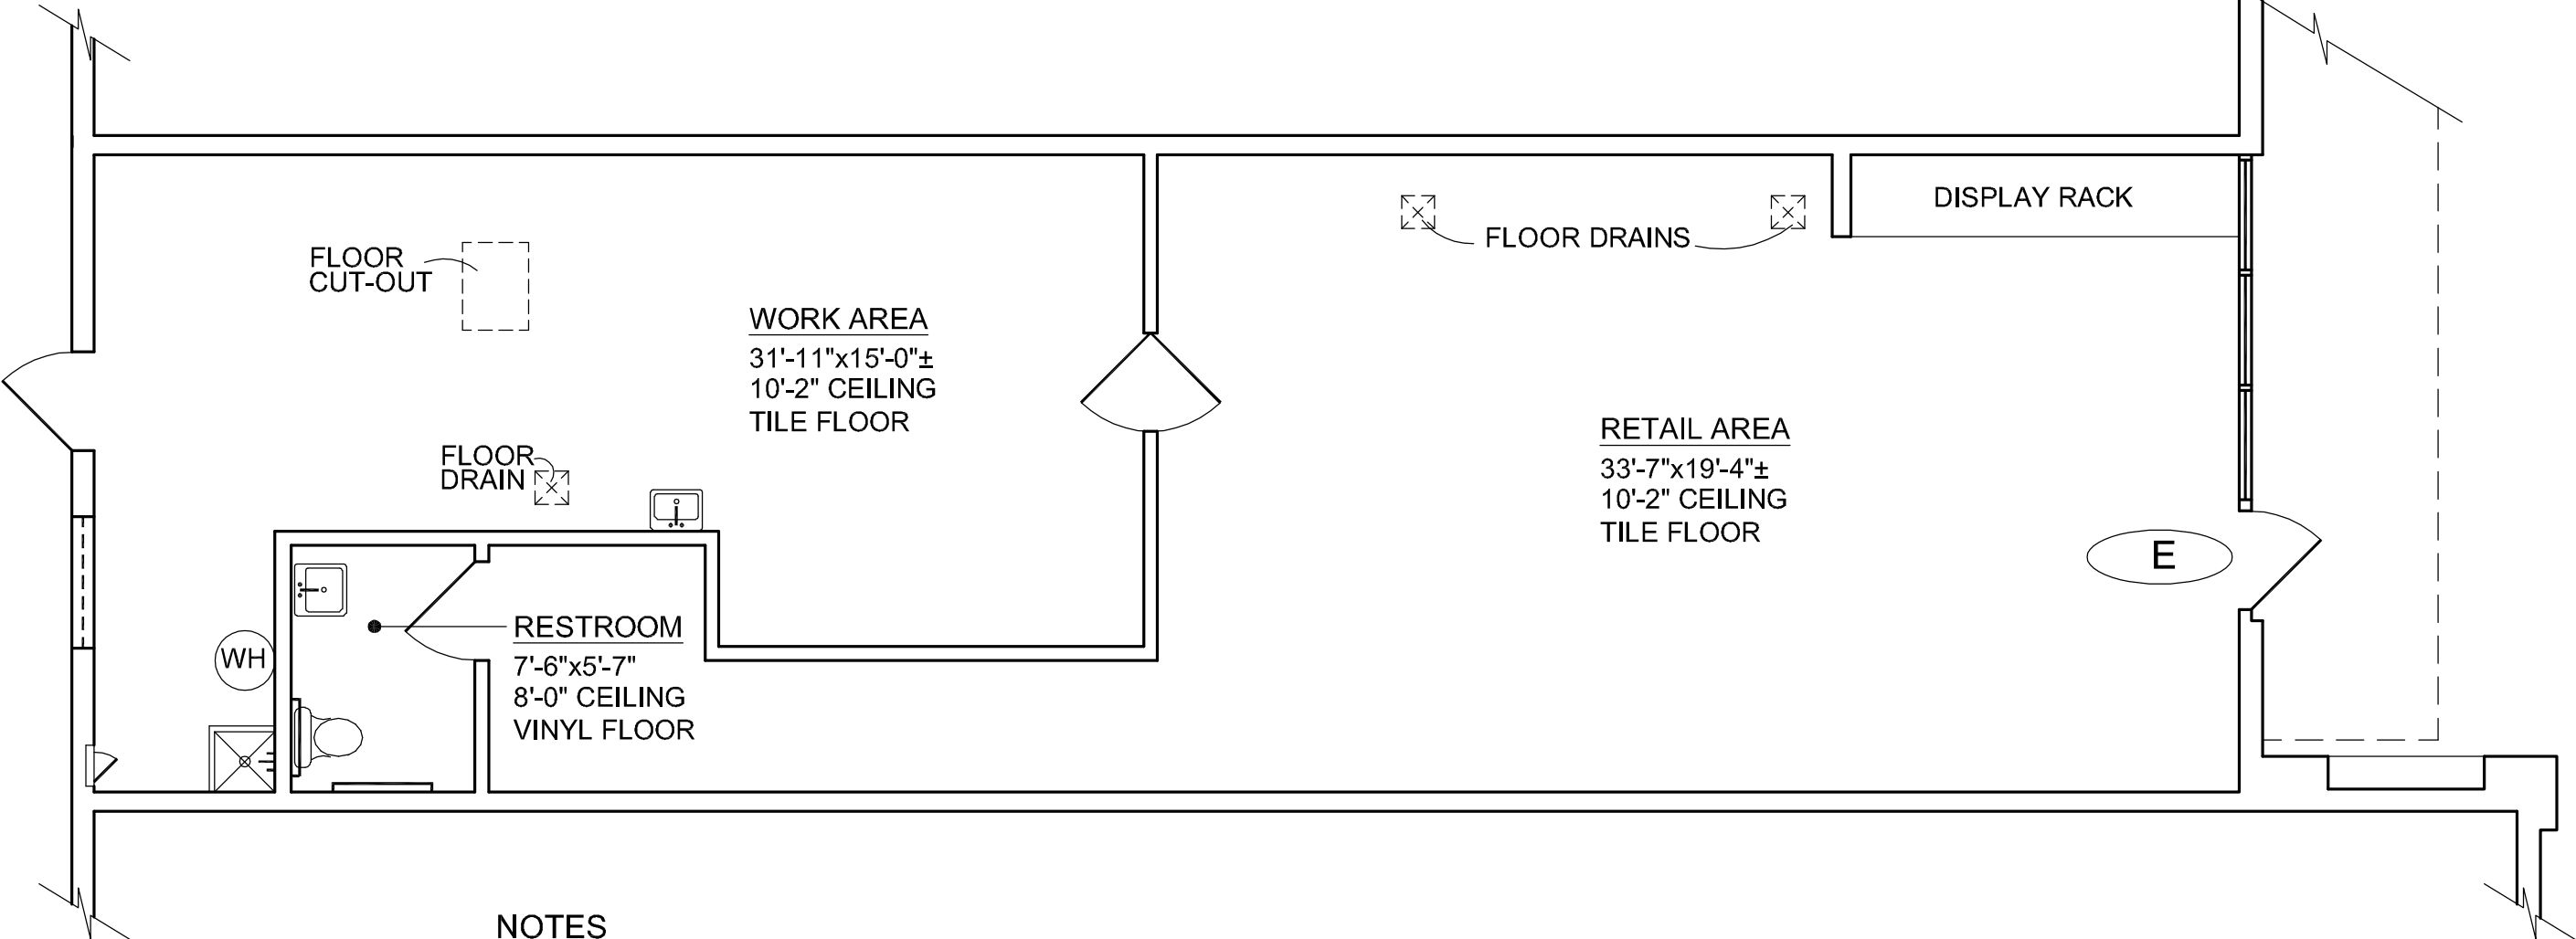

NOTES

- 1. ALL CALCULATIONS INDICATE "GROSS RETAIL" AREA AS PER "BOMA" STANDARDS
- 2. ALL FIXTURES INDICATED ARE BUILT-IN.
- 3. ALL DIMENSIONS TO BE FIELD VERIFIED PRIOR TO ANY CONSTRUCTION.

AREA CALCULATION:
SUITE E: 1324.07 SQ. FT.

PROJECT:
475
COORS NW
SUITE E

DESCRIPTION:
AS-BUILT
DRAWING

CLIENT:
VANGIE
PAVLAKOS
AND
CREM

SHEET #
01
OF 01

ORIENTATION	MEASURED BY	MG	1
	DESIGNED BY	N.A.	3
	DRAFTED BY	MG	2
	CHECKED BY	MG	4
	REVISED:		
SCALE 3/16"=1'-0"	DATE 4-13-23		

505-899-1199