


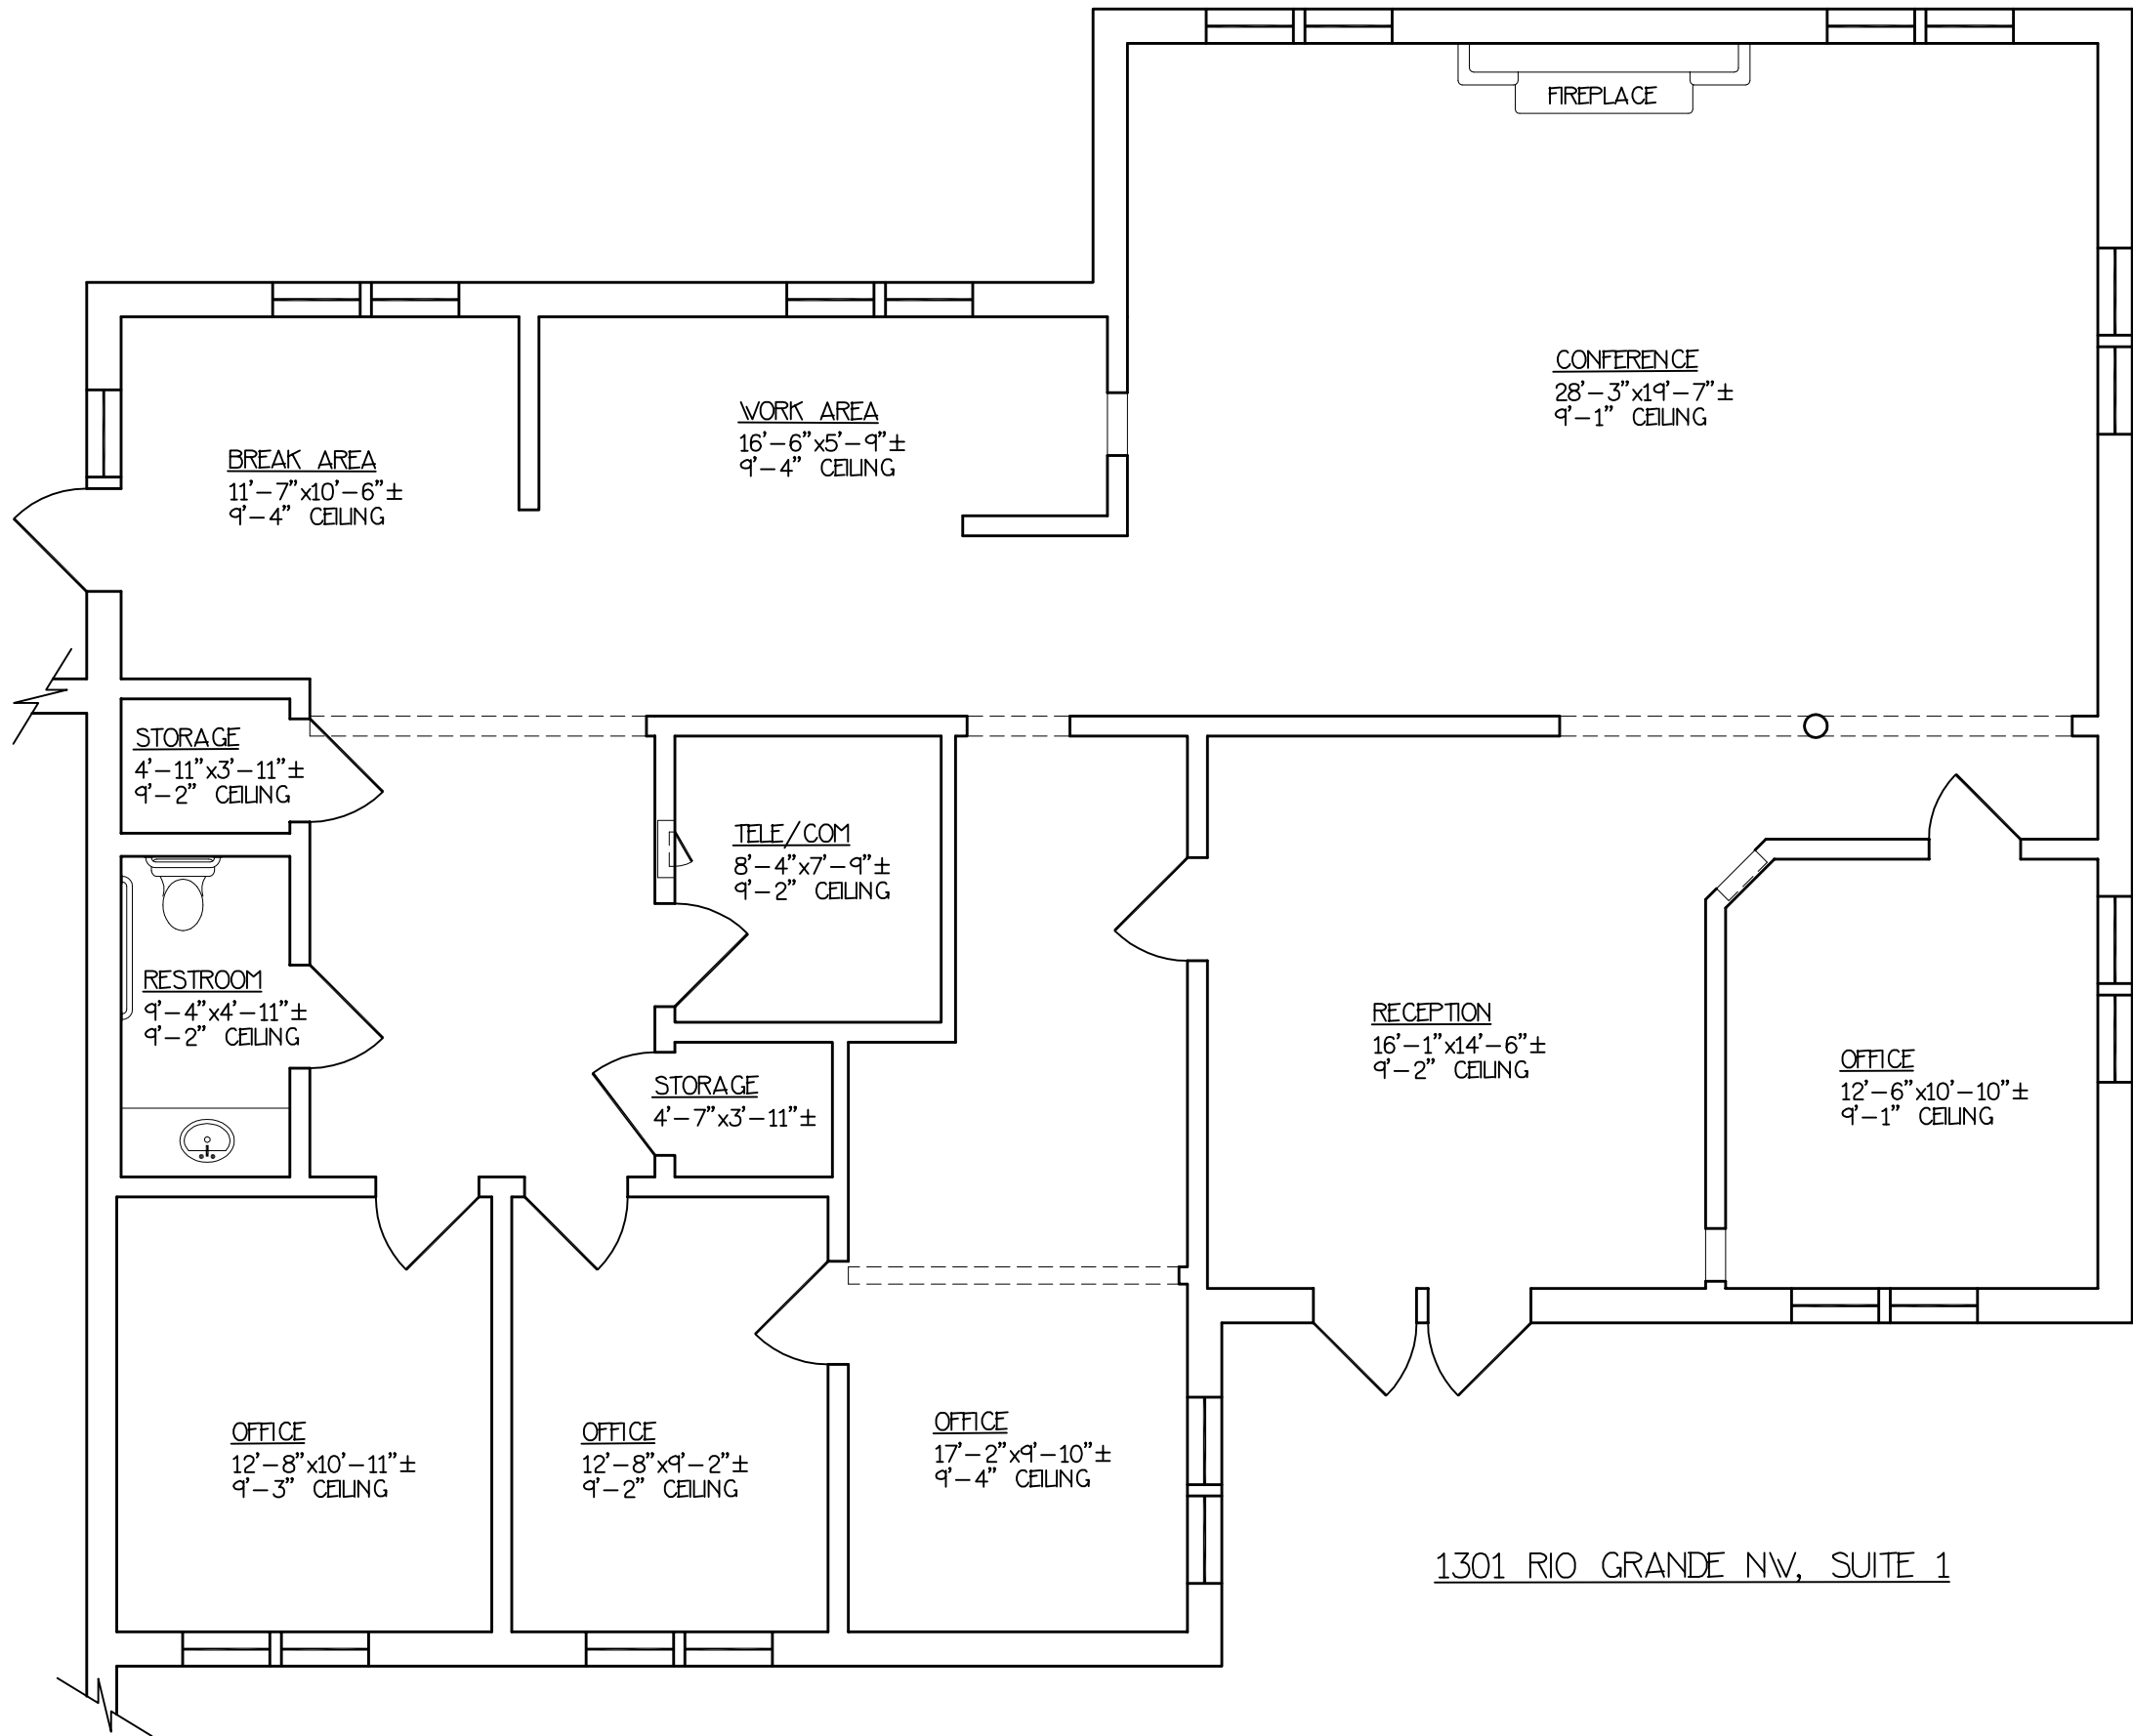

NOTES

1. ALL CALCULATIONS INDICATE "GROSS RETAIL" AREA AS PER "BOMA" STANDARDS.
2. ALL FIXTURES INDICATED ARE BUILT-IN.
3. ALL FLOORS ARE TILE UNLESS OTHERWISE INDICATED.
4. ALL CEILING HEIGHTS ARE TO THE BOTTOM OF CEILING VIGAS.
5. ALL DIMENSIONS TO BE FIELD VERIFIED PRIOR TO ANY CONSTRUCTION.

AREA CALCULATIONS:

AREA 2361.52 SQ. FT.

PROJECT:
1301
RIO GRANDE
BLVD NW
SUITE 1

DESCRIPTION:
**AS-BUILT
DRAWING**


CLIENT:
**GRUBB
& ELLIS**

SHEET #
01
OF 01

	ORIENTATION	MEASURED BY	JR	REFERENCE 1 0 0 3 1
		DESIGNED BY	N.A.	
		DRAFTED BY	JR	
		CHECKED BY	P.M.	
		REVISED:		
SCALE		DATE		
3/16"=1'-0"		01/28/10		



YCD DESIGNS
505-899-1199

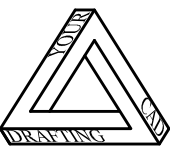

YCD DESIGNS
505-899-1199