


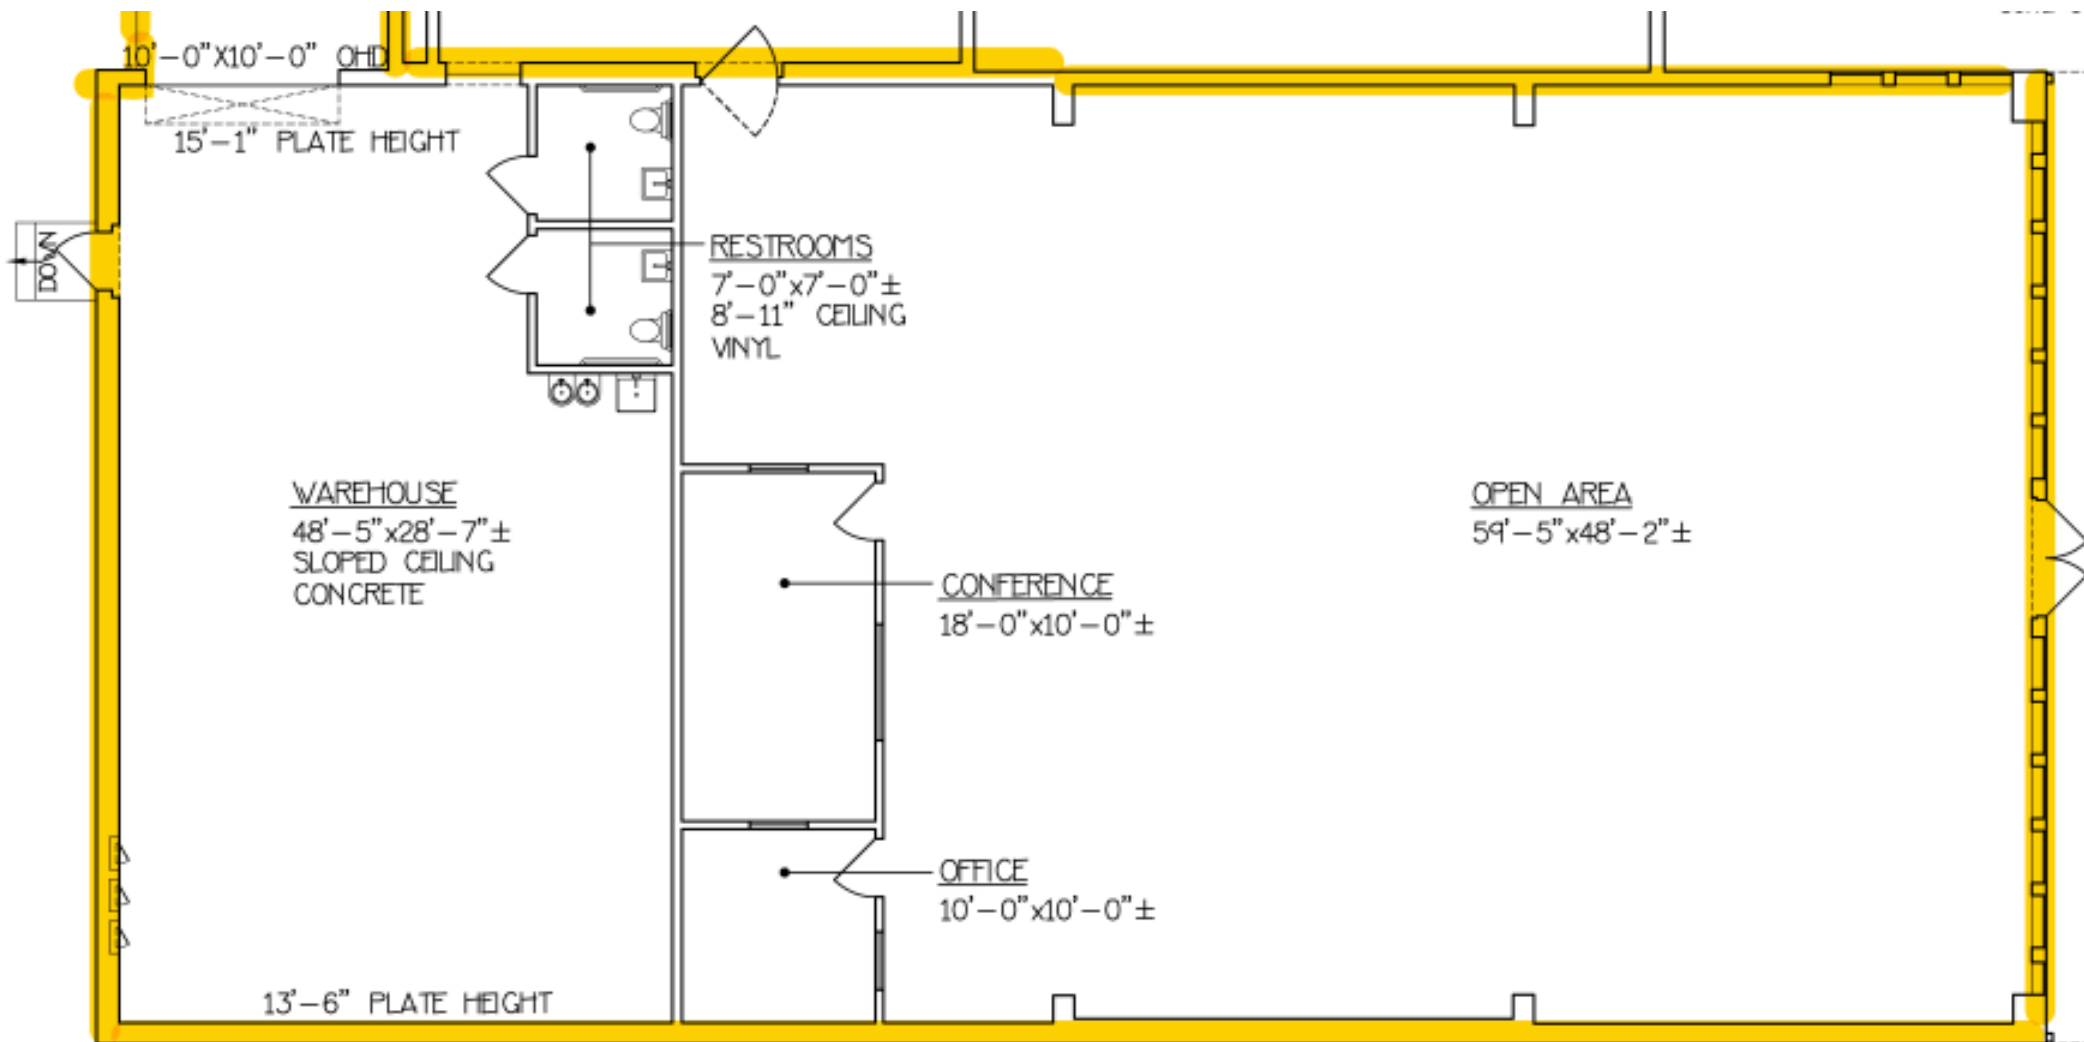

3965 CERRILLOS ROAD, SANTA FE, NM