


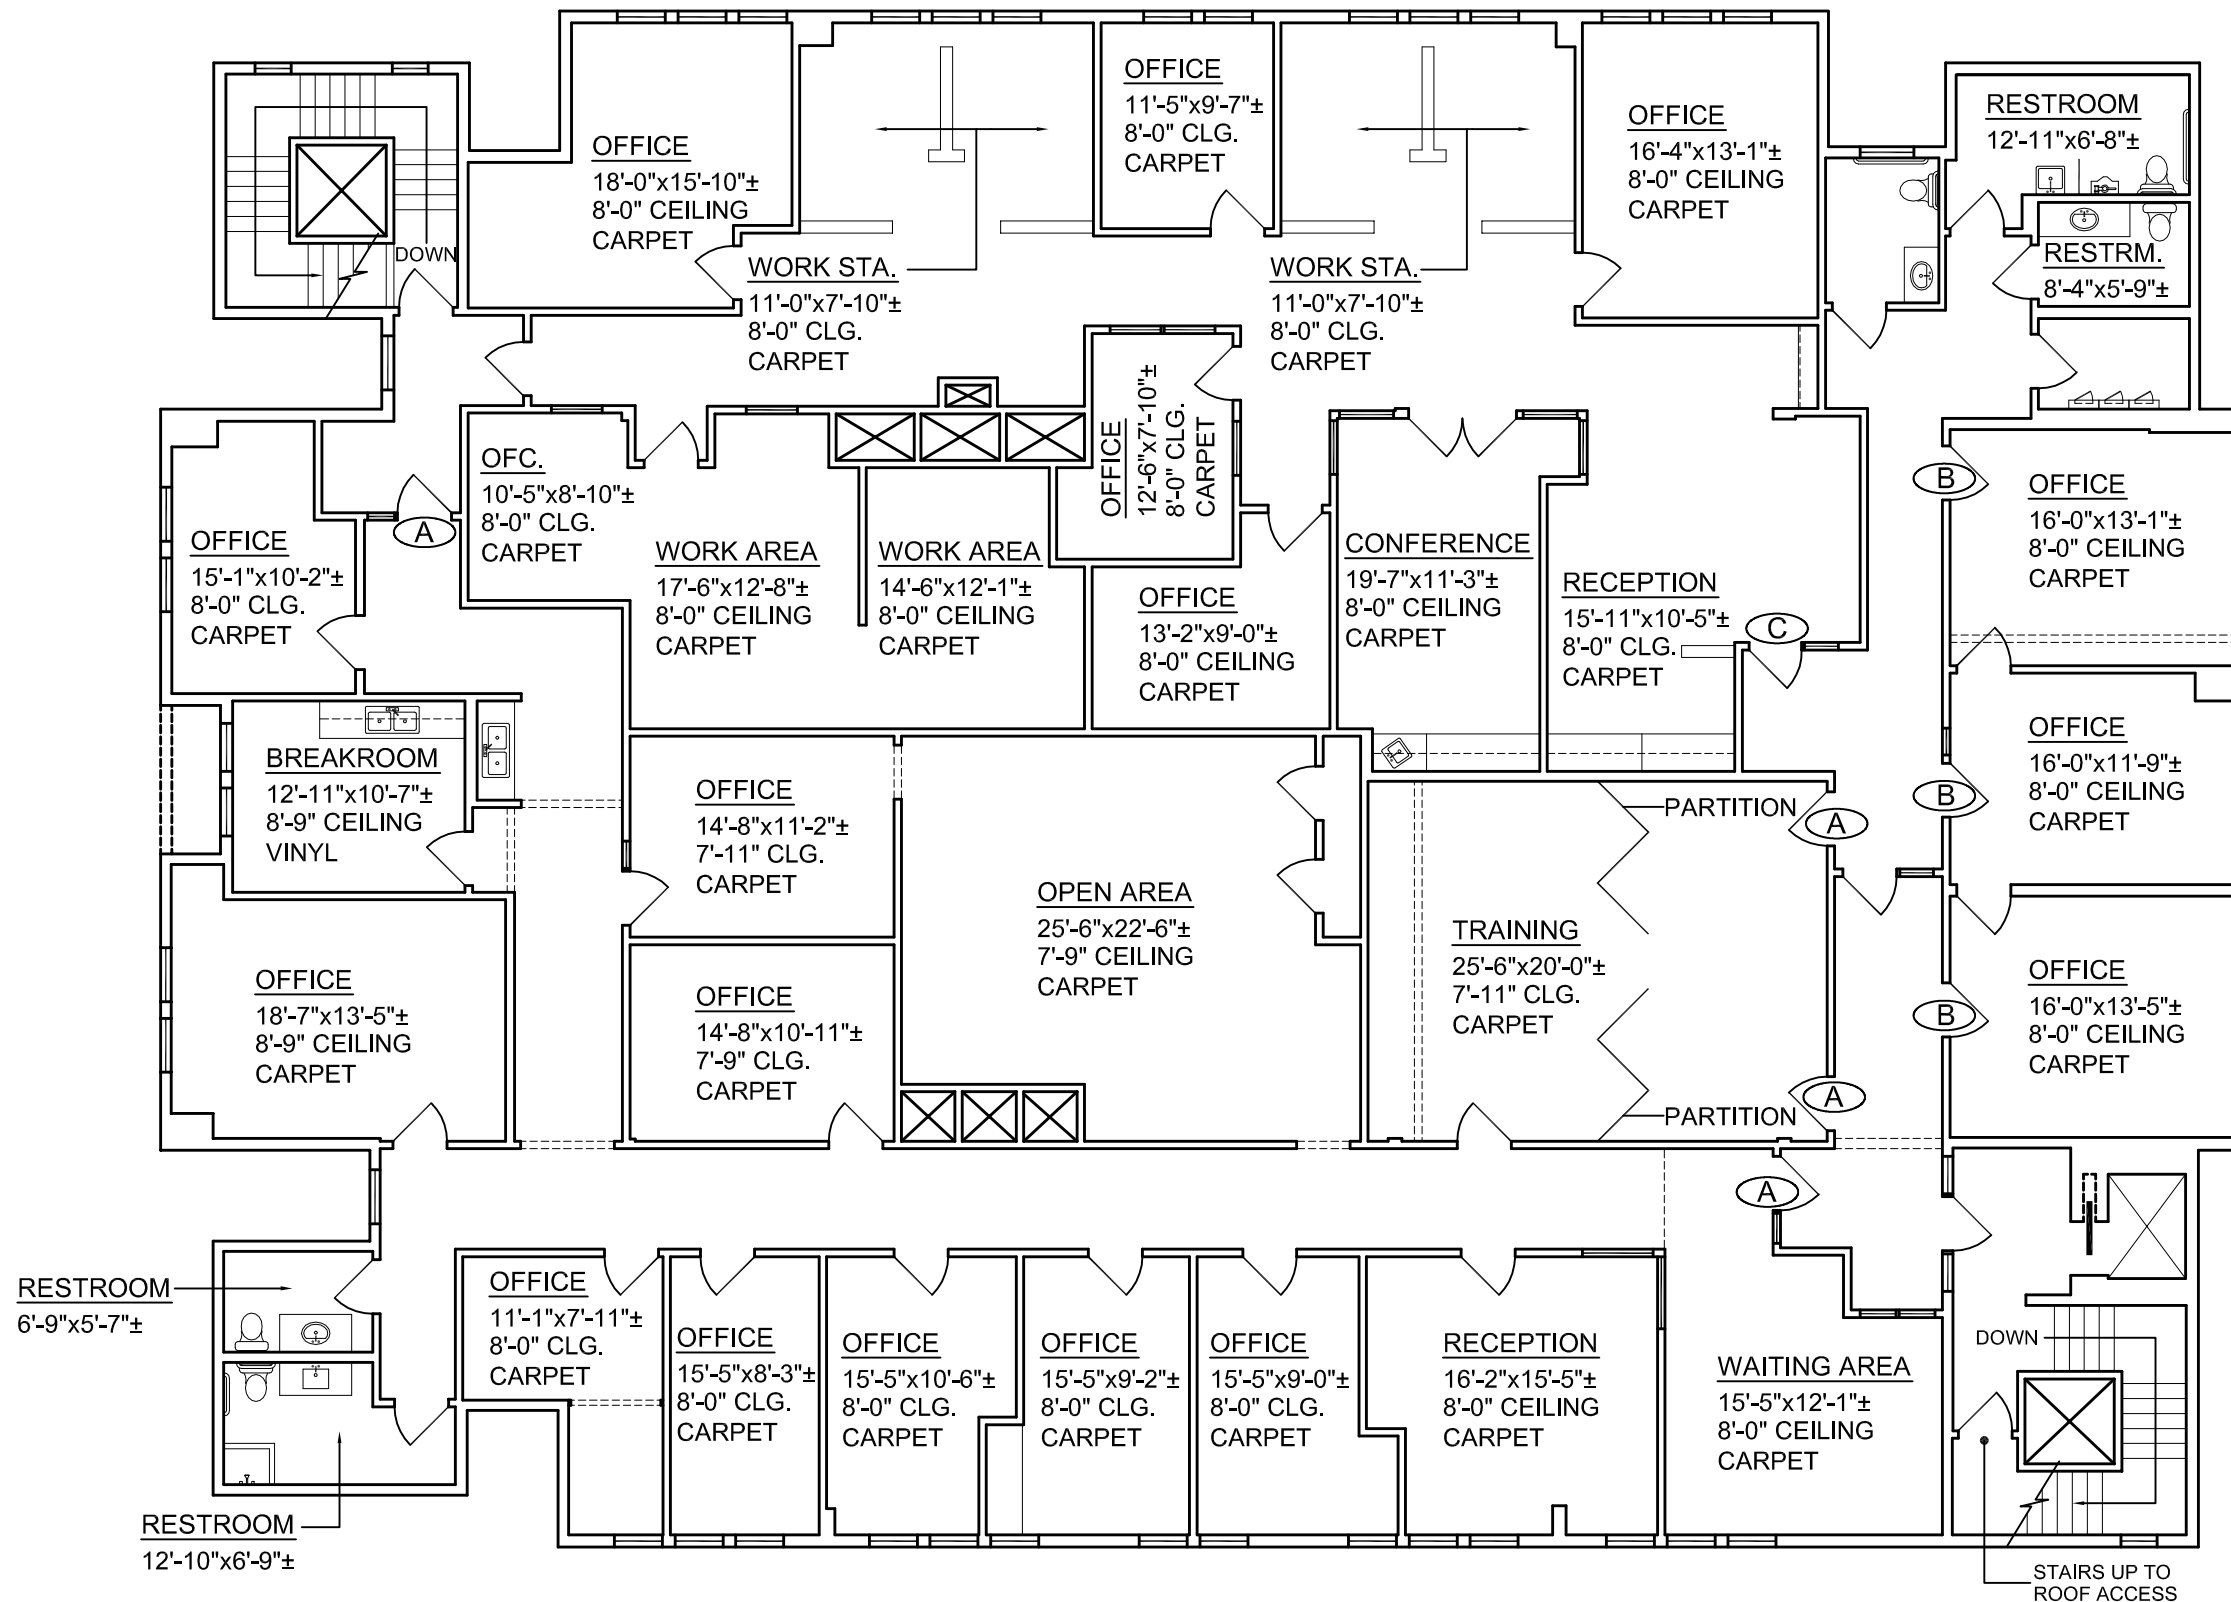

SECOND FLOOR

NOTES

1. ALL CALCULATIONS INDICATE "USABLE" AREA AS PER "BOMA" STANDARDS.
2. ALL FIXTURES INDICATED ARE BUILT-IN.
3. ALL FLOORS ARE TILE UNLESS OTHERWISE INDICATED.
4. ALL CEILING HEIGHTS ARE 7'-11" UNLESS OTHERWISE NOTED.
5. ALL DIMENSIONS TO BE FIELD VERIFIED PRIOR TO ANY CONSTRUCTION.
6. CALCULATIONS EXCLUDE ALL STAIRWELL AND VERTICAL PENETRATIONS.

AREA CALCULATIONS:

SUITE - A AREA	4,148.25 SQ. FT.
SUITE - B AREA	628.51 SQ. FT.
SUITE - C AREA	2,830.57 SQ. FT.
COMMON AREA	908.30 SQ. FT.

PROJECT:
2006
BOTULPH RD.
SANTA FE
SECOND FLR.

DESCRIPTION:
AS-BUILT
DRAWING

CLIENT:

SANTA FE
RING LLC.

SHEET #
02
OF **03**

ORIENTATION 	MEASURED BY	JR	REFERENCE 2 5 0 6 4
	DESIGNED BY	N.A.	
	DRAFTED BY	JR	
	CHECKED BY	M.G.	
	REVISED:		
SCALE 3/32" = 1'-0"	DATE 11/21/25		



505-899-1199