


25500 Meadowbrook Road  
Suite 115  
6,036 RSF

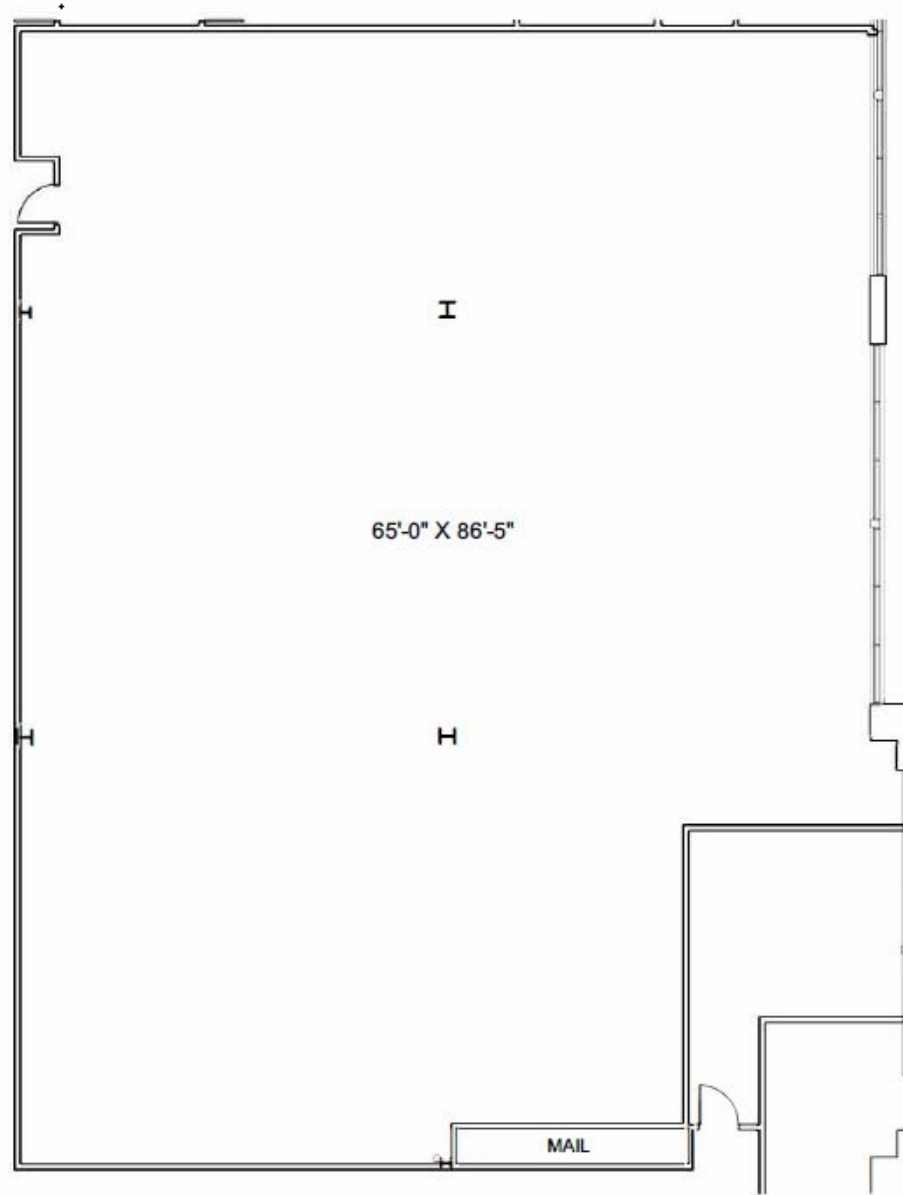

AS BUILT FLOOR PLAN  
SUITE 115  
6,036 RSF  
11-18-21

