


25500 Meadowbrook Road

Suite 205

1,805 RSF

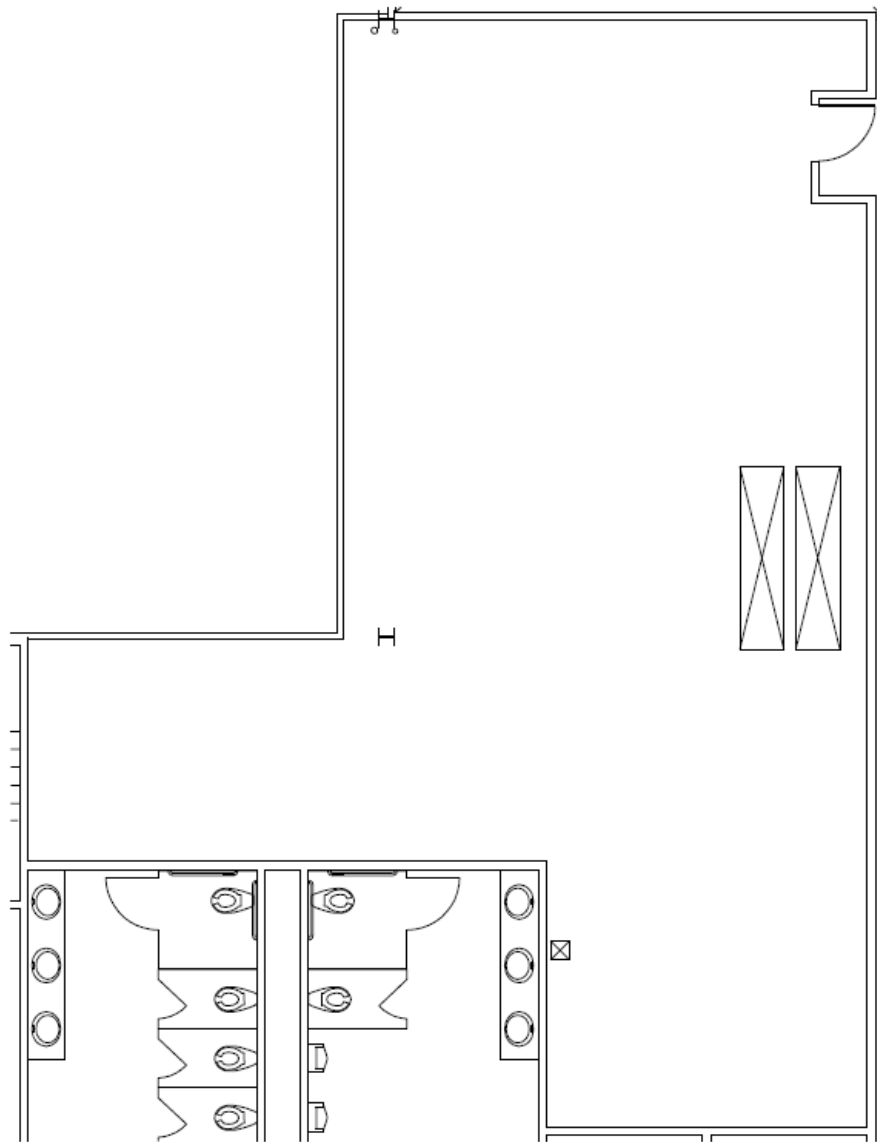

AS BUILT FLOOR PLAN  
SUITE 205  
AS BUILT FLOOR PLAN  
1,805 RSF  
05-30-19

