


DRAWN BY:

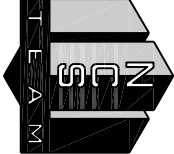

NCS TEAM
One Towne Square
Suite 150
Southfield, MI 48076
Tel: 248-320-1921
www.ncs-team.com


RSM DEVELOPMENT
& MANAGEMENT

MANAGEMENT ADDRESS

POST OFFICE BOX OFFICE
BIRMINGHAM, MI 48012
(248) 645-2600

PROJECT ADDRESS

25500 MEADOWBROOK RD
NOVI, MI 48375

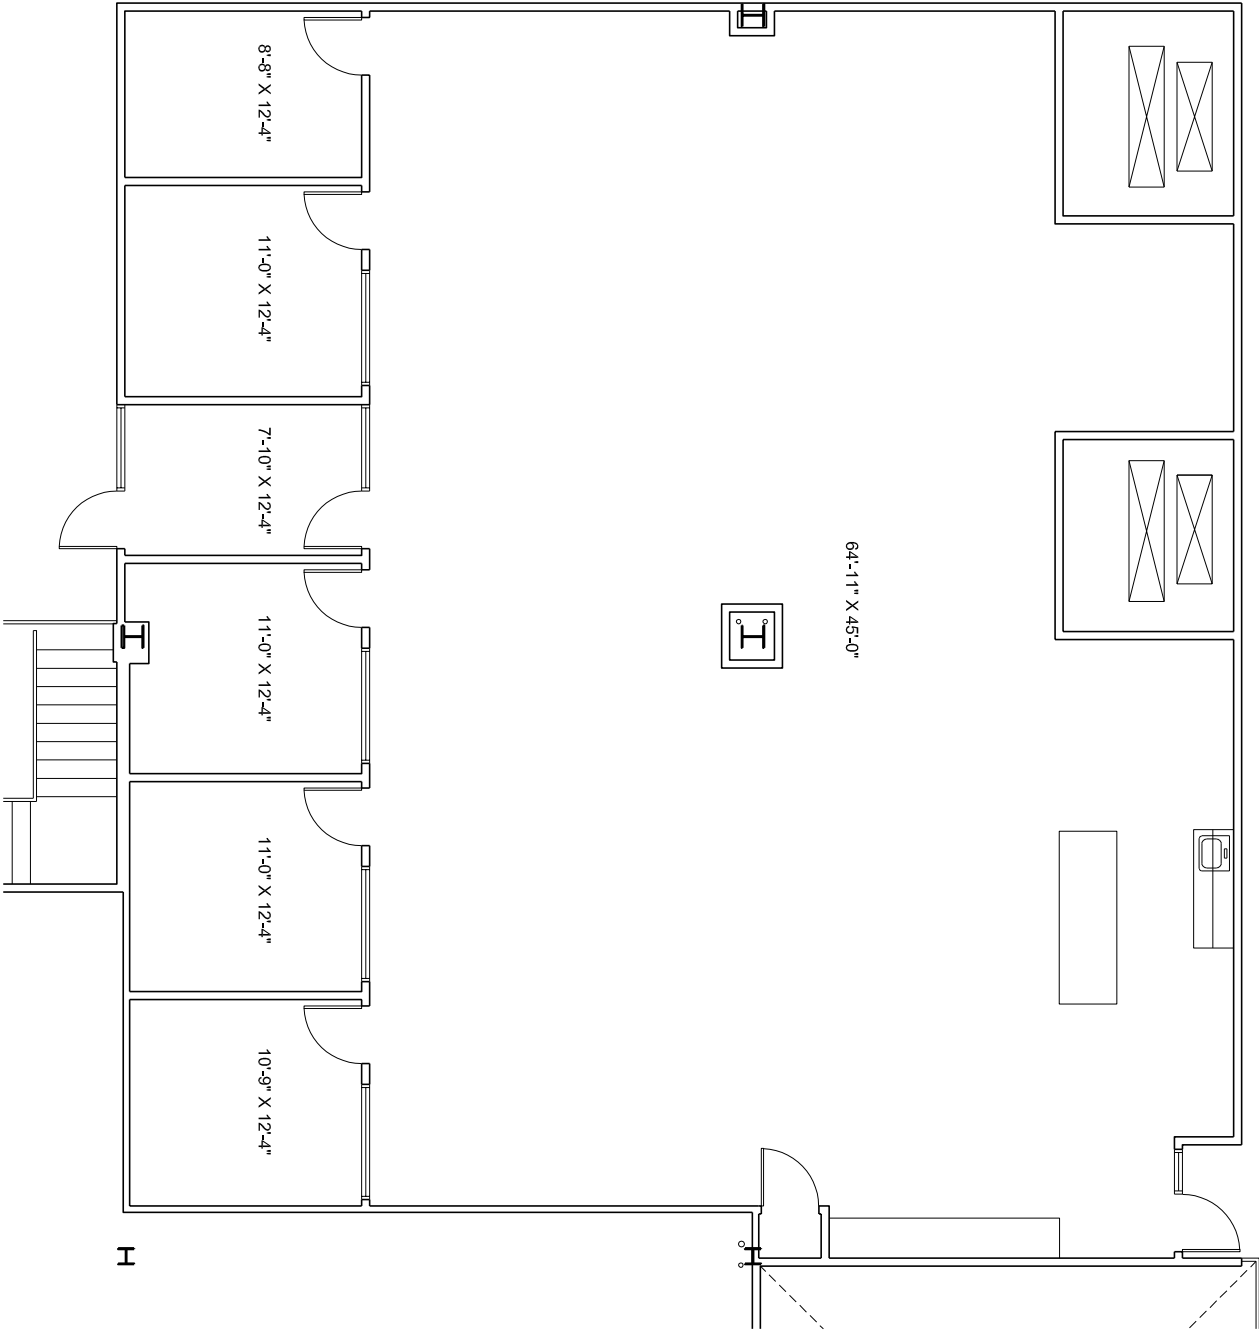

AS BUILT FLOOR PLAN

SUITE 235

3,956 RSF

08-14-2024



KEY PLAN

