



File: F:\CBI\CAD Files\

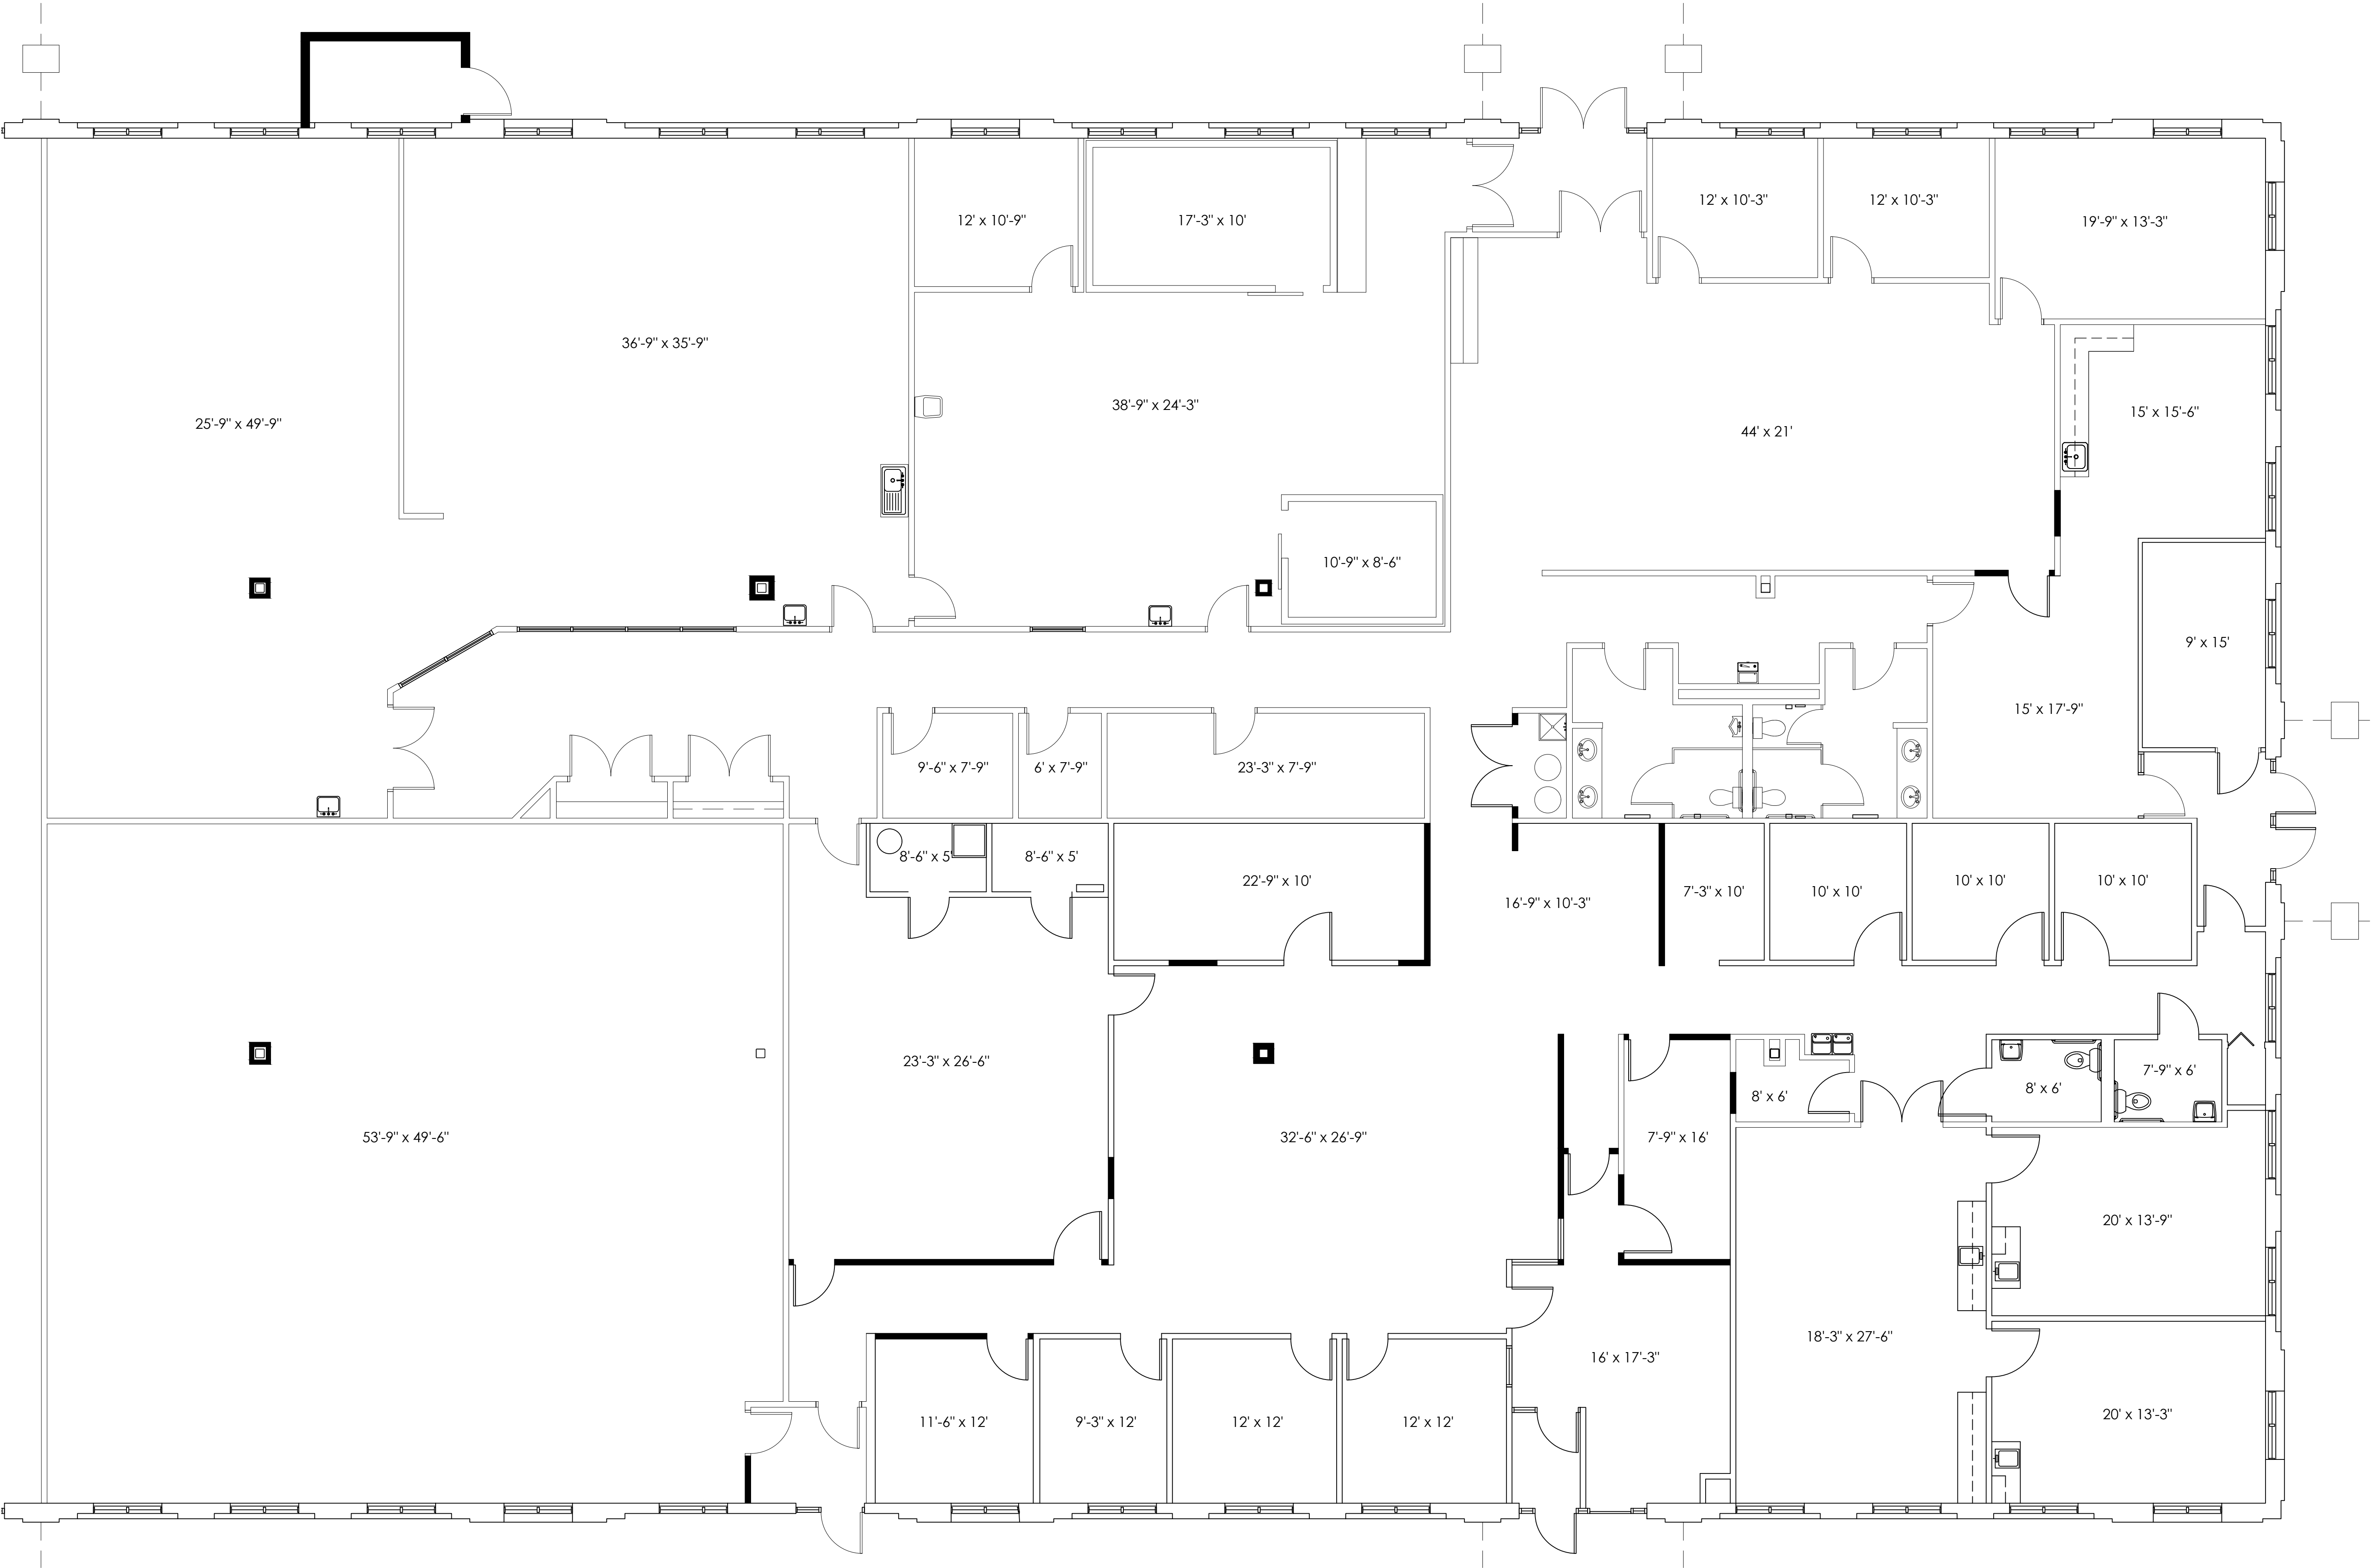

PLAN
SCALE: N.T.S.

OVERALL ROOM DIMENSIONS ARE INTENDED TO REPRESENT GENERAL
ROOM SIZES AND NOT FRAMING DIMENSIONS. ALL EXISTING
CONDITIONS SHALL BE FIELD VERIFIED PRIOR TO CONSTRUCTION.

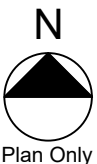

Cathy Burgess Interiors
155 East Main Street Suite 102 Lexington, Kentucky 40507
859.255.9400 fx 859.255.9437

**1745 ALYSHEBA WAY
LEXINGTON, KENTUCKY**

DATE:	07.31.25
SCALE:	N.T.S.
DRAWN BY:	MEF
REVISIONS:	

ASBUILT PLAN

A-1