


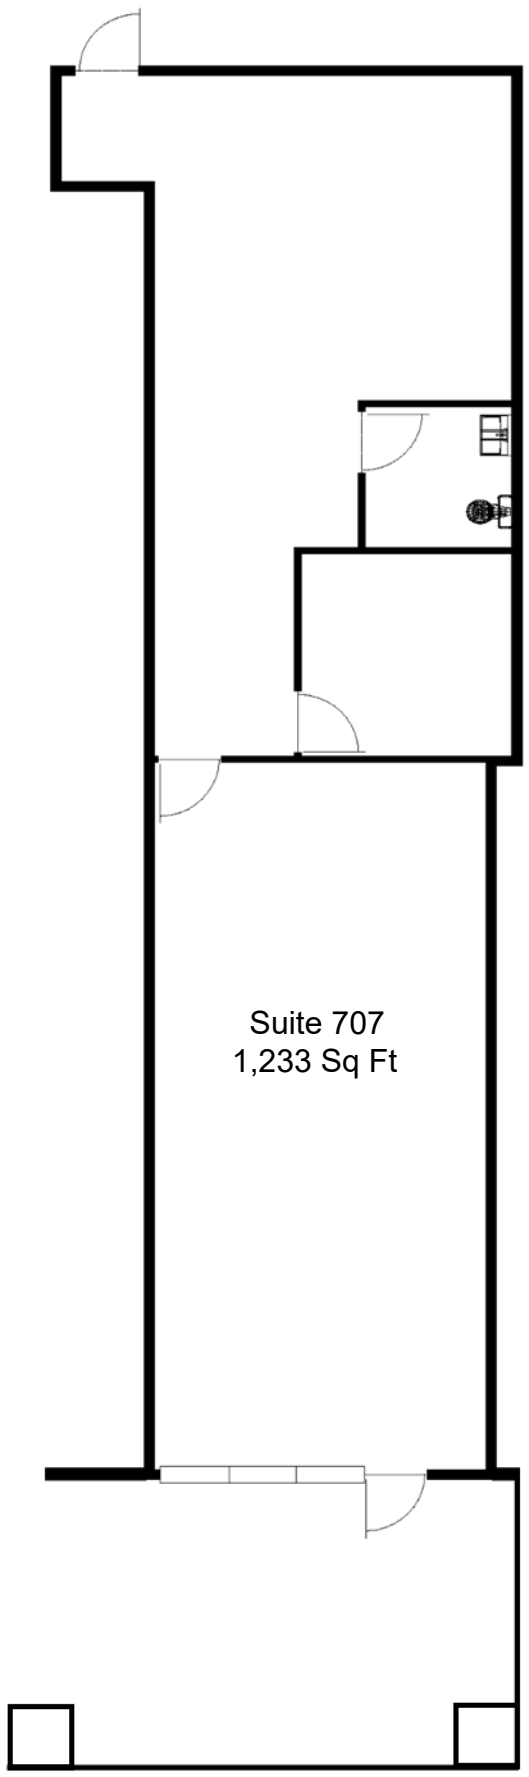

This is a floor plan for Suite 707. The suite is an irregularly shaped room with a thick black border. It features a large central area and a smaller room on the right side. The smaller room contains a desk, a chair, and a window. There are four quarter-circle symbols indicating specific corners or features: one at the top left, one at the top of the smaller room, one at the bottom left of the main area, and one at the bottom right of the main area. A small rectangular area is located at the bottom center, and two small squares are at the bottom left and bottom right corners of the overall plan.

Suite 707
1,233 Sq Ft