


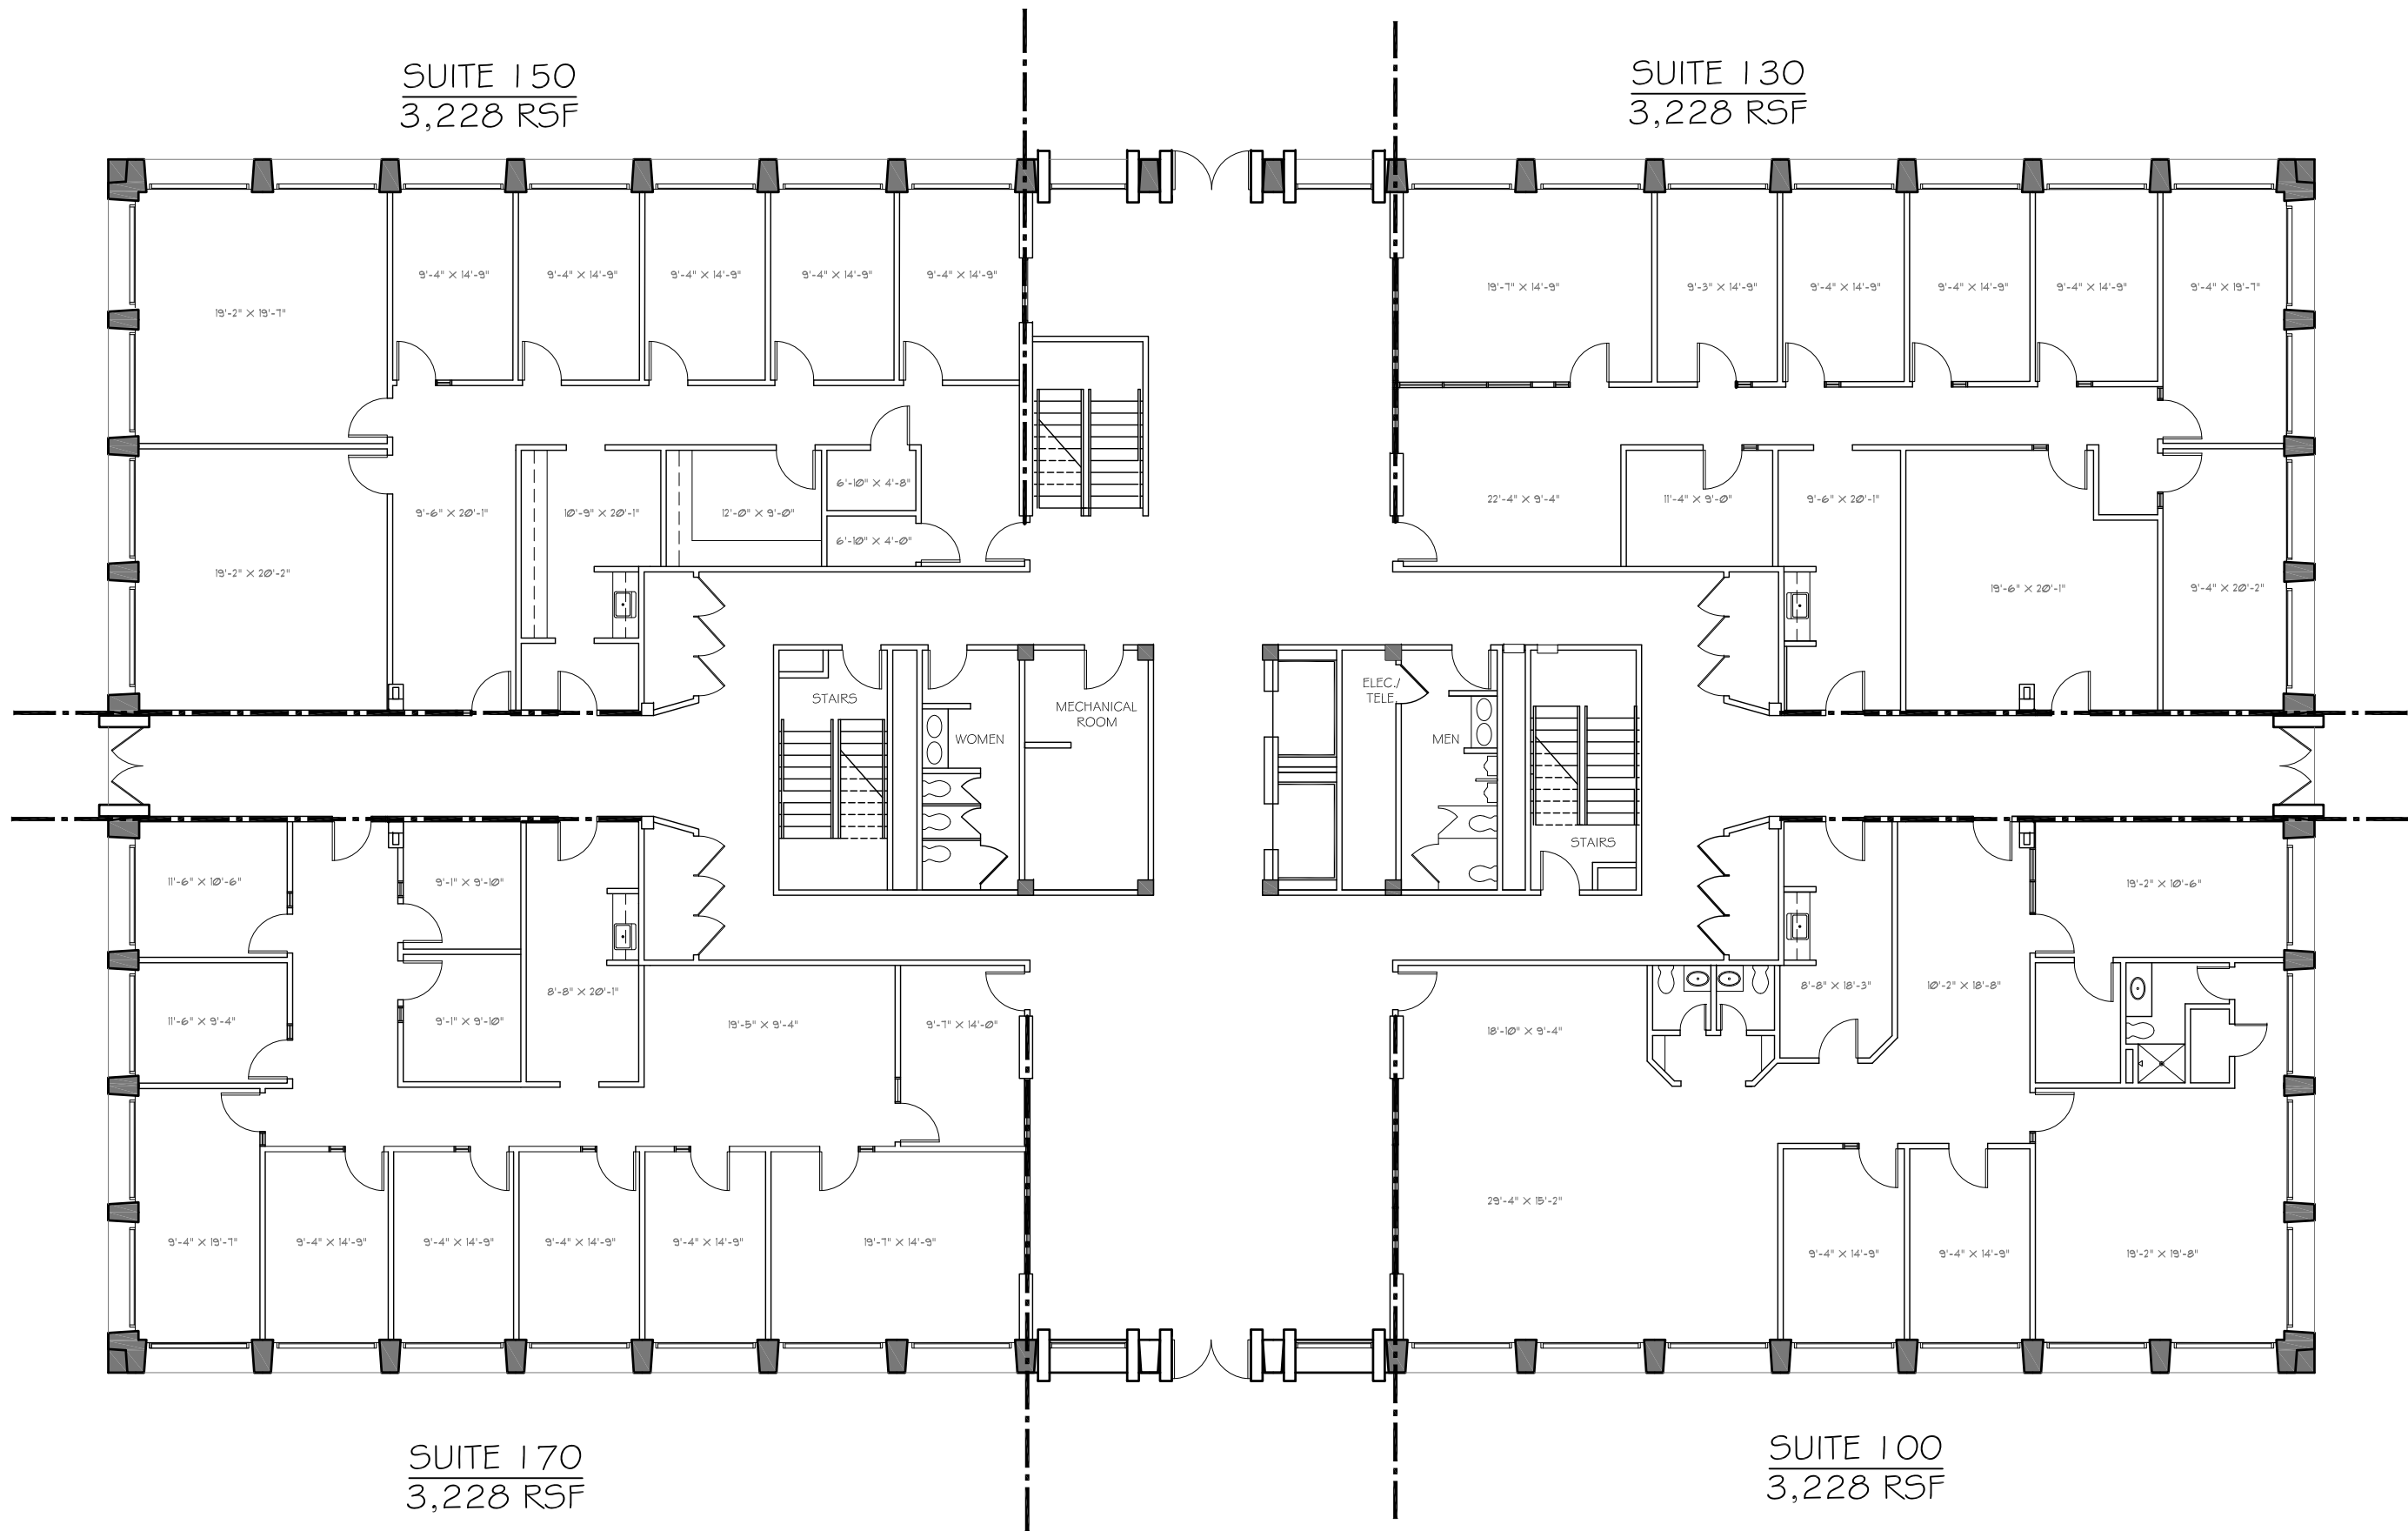

ONE JAMES PARK
AS-BUILT FLOOR 1
100 JAMES DRIVE
ST. ROSE, LA 70087

03-09-17	03-07-17	02-24-17	02-24-17	02-24-17
6505	6505	6505	6505	6505
TASK NO.	TASK NO.	TASK NO.	TASK NO.	TASK NO.
FLOOR	FLOOR	FLOOR	FLOOR	FLOOR
1	1	1	1	1
AB	AB	AB	AB	AB

AGL
COMMERCIAL INTERIORS
433 METAIRE ROAD
SUITE 208
METAIRE, LA 70005
504.888.9077

AGLDESIGNS.COM

PROJECT