


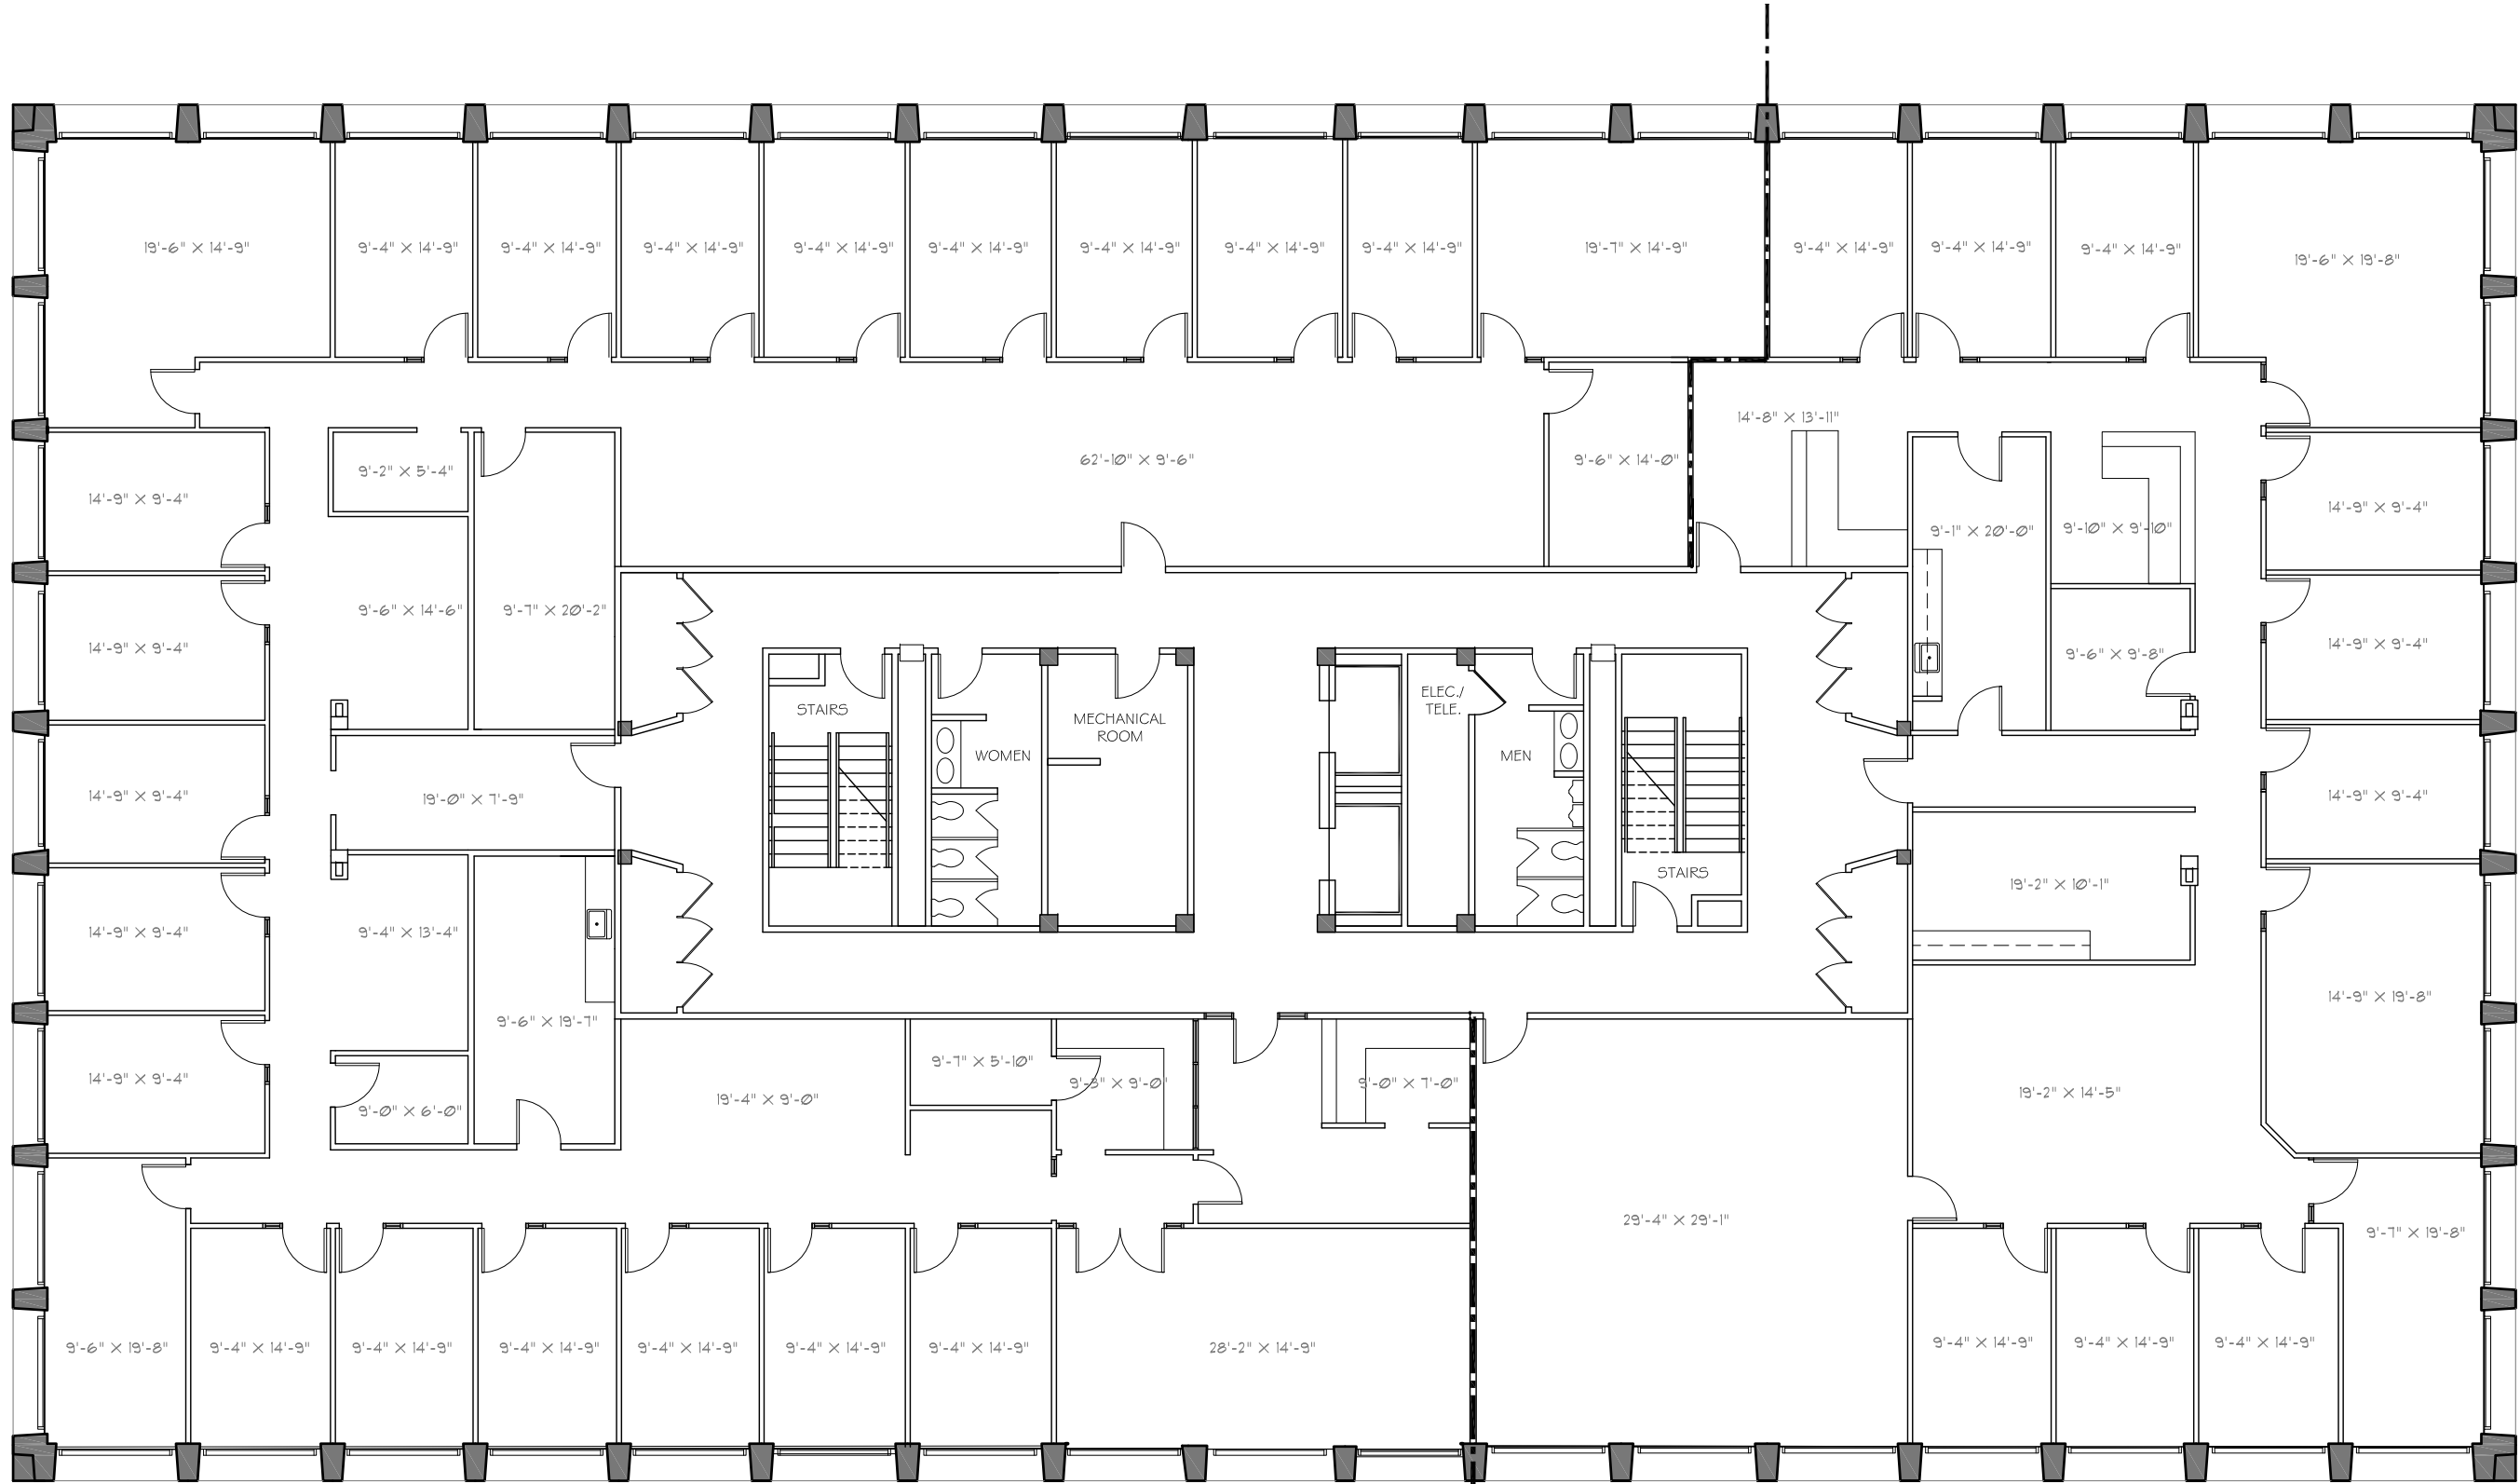

SUITE 350
9,959 RSF

SUITE 300
6,284 RSF

03-09-17

03-07-17

6505

DATE

02-24-17

DATE

TASK NO.

FLOOR

3

AB

PROJECT

ONE JAMES PARK
AS-BUILT FLOOR 3
100 JAMES DRIVE
ST. ROSE, LA 70087

AGL

COMMERCIAL INTERIORS

433 METAIRE ROAD
SUITE 208

AGDESIGNS.COM

METAIRE, LA 70005

504.888.9077