




PARKWAY PLAZA

2001 EVANGELINE THRUWAY, LAFAYETTE, LA
TOTAL CENTER: 136,707.06 SQ. FT.

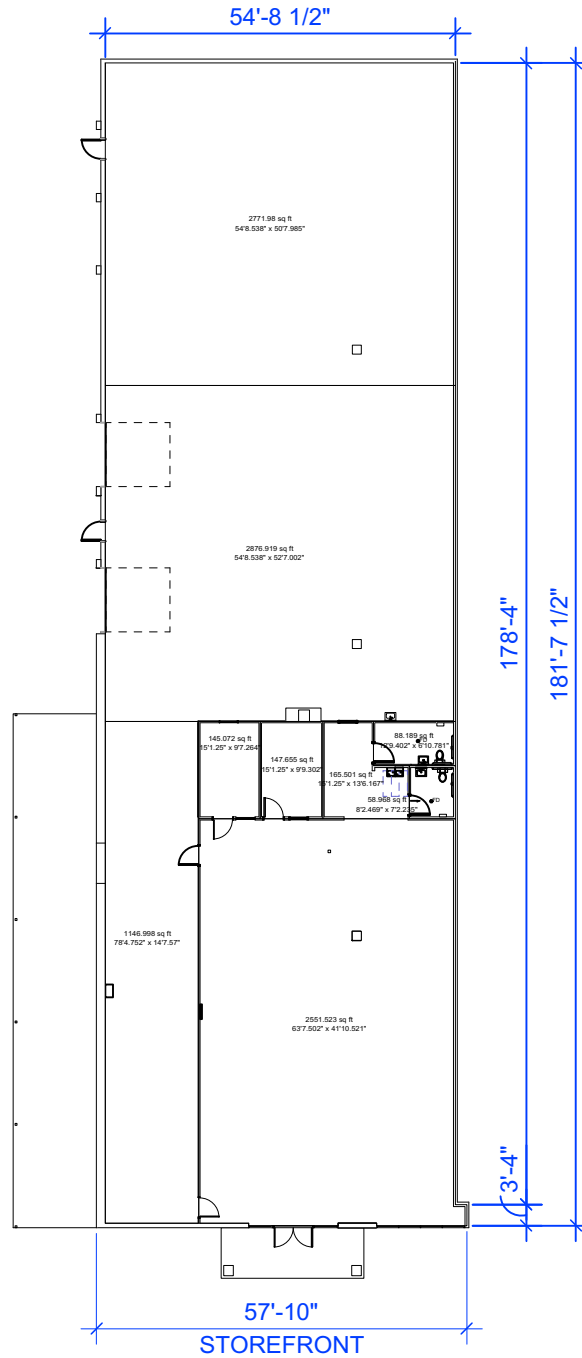

KEY PLAN

SUITE - 1

SCALE: 1" = 30'
DATE: 1/11/2018

FRONT AREA	2,551.523 SQ.FT.
BACK AREA	7,401.282 SQ.FT.

TOTAL AREA	9,952.805 SQ.FT.
------------	------------------

Vermilion Architects, LLC

101 Hamilton Place, Lafayette, LA 70501

phone: (337) 234-4166

fax: (337) 234-7411

Angelique@VermilionArchitects.com

David@VermilionArchitects.com