



NAME	USABLE	COMMON (16%)	RENTABLE SF
Suite 503 (5A)	3,141 SF	502 SF	3,643 SF
5B	2,923 SF	468 SF	3,391 SF
Suite 504 (5C)	1,200 SF	192 SF	1,392 SF
5D	937 SF	150 SF	1,087 SF

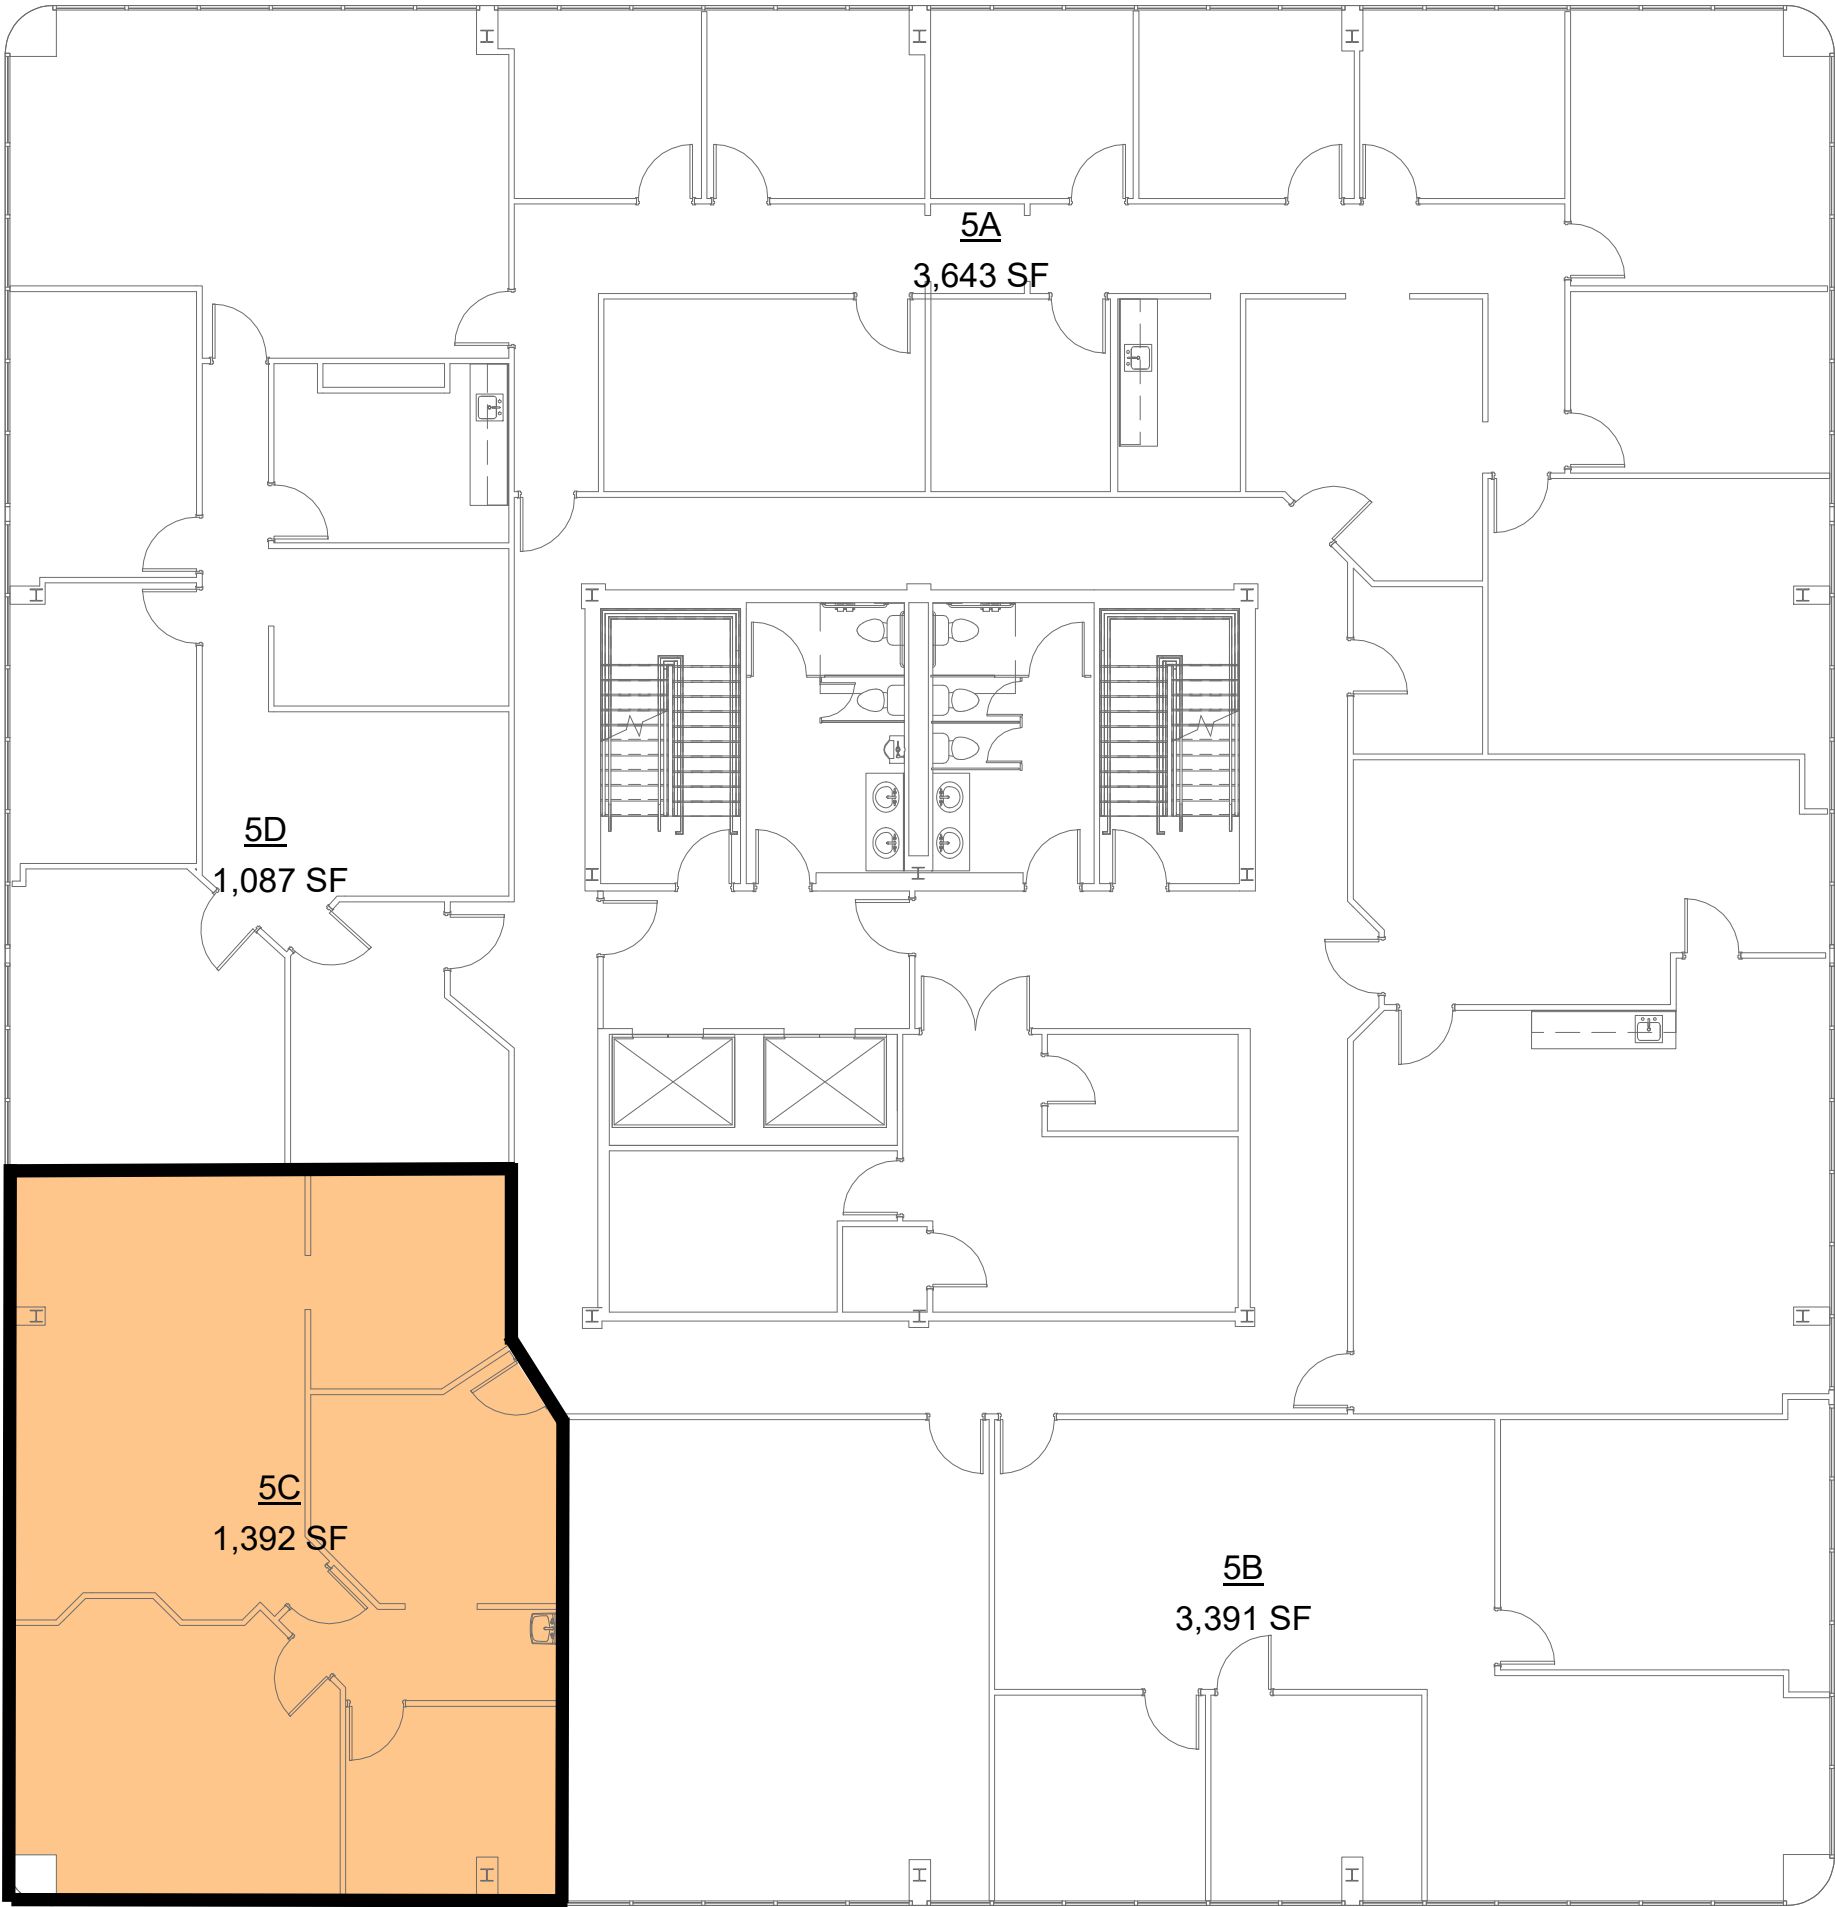

1 FIFTH FLOOR

SCALE: 3/32" = 1'-0"

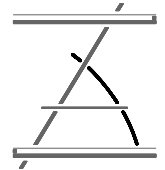

**ZILER
ARCHITECTS**
A PROFESSIONAL ARCHITECTURAL CORPORATION
101 CALCO BLVD
LAFAYETTE, LOUISIANA 70503
337 269 6326 FAX 269 6380

DOCUMENTS PREPARED BY ZILER ARCHITECTS ARE INSTRUMENTS OF THE ARCHITECTS SERVICE FOR USE SOLELY WITH RESPECT TO THIS PROJECT. THE ARCHITECT SHALL RETAIN ALL COMMON LAW, STATUTORY AND OTHER RESERVED RIGHTS, INCLUDING THE COPYRIGHT. THEY ARE NOT TO BE USED BY THE CONTRACTOR OR ANY SUBCONTRACTOR, MATERIAL OR EQUIPMENT SUPPLIERS OR ANYONE FOR OTHER PROJECTS OR FOR ADDITIONS TO THIS PROJECT OUTSIDE THE SCOPE OF THE WORK WITHOUT THE SPECIFIC WRITTEN CONSENT OF ZILER ARCHITECTS.

RECORD DRAWINGS FOR:

LAHAYE CENTER

201 RUE IBERVILLE
LAFAYETTE, LOUISIANA 70508



DATE ISSUED
08/16/21
REVISED
-

PLOT DATE
08/18/21 4:13:46 PM
DRAWN BY
KEM
CHECKED BY
SRP
PROJECT NO.
2106
SHEET NO.
AC0.5
OF ____