


509 W 67th St., Shreveport, LA

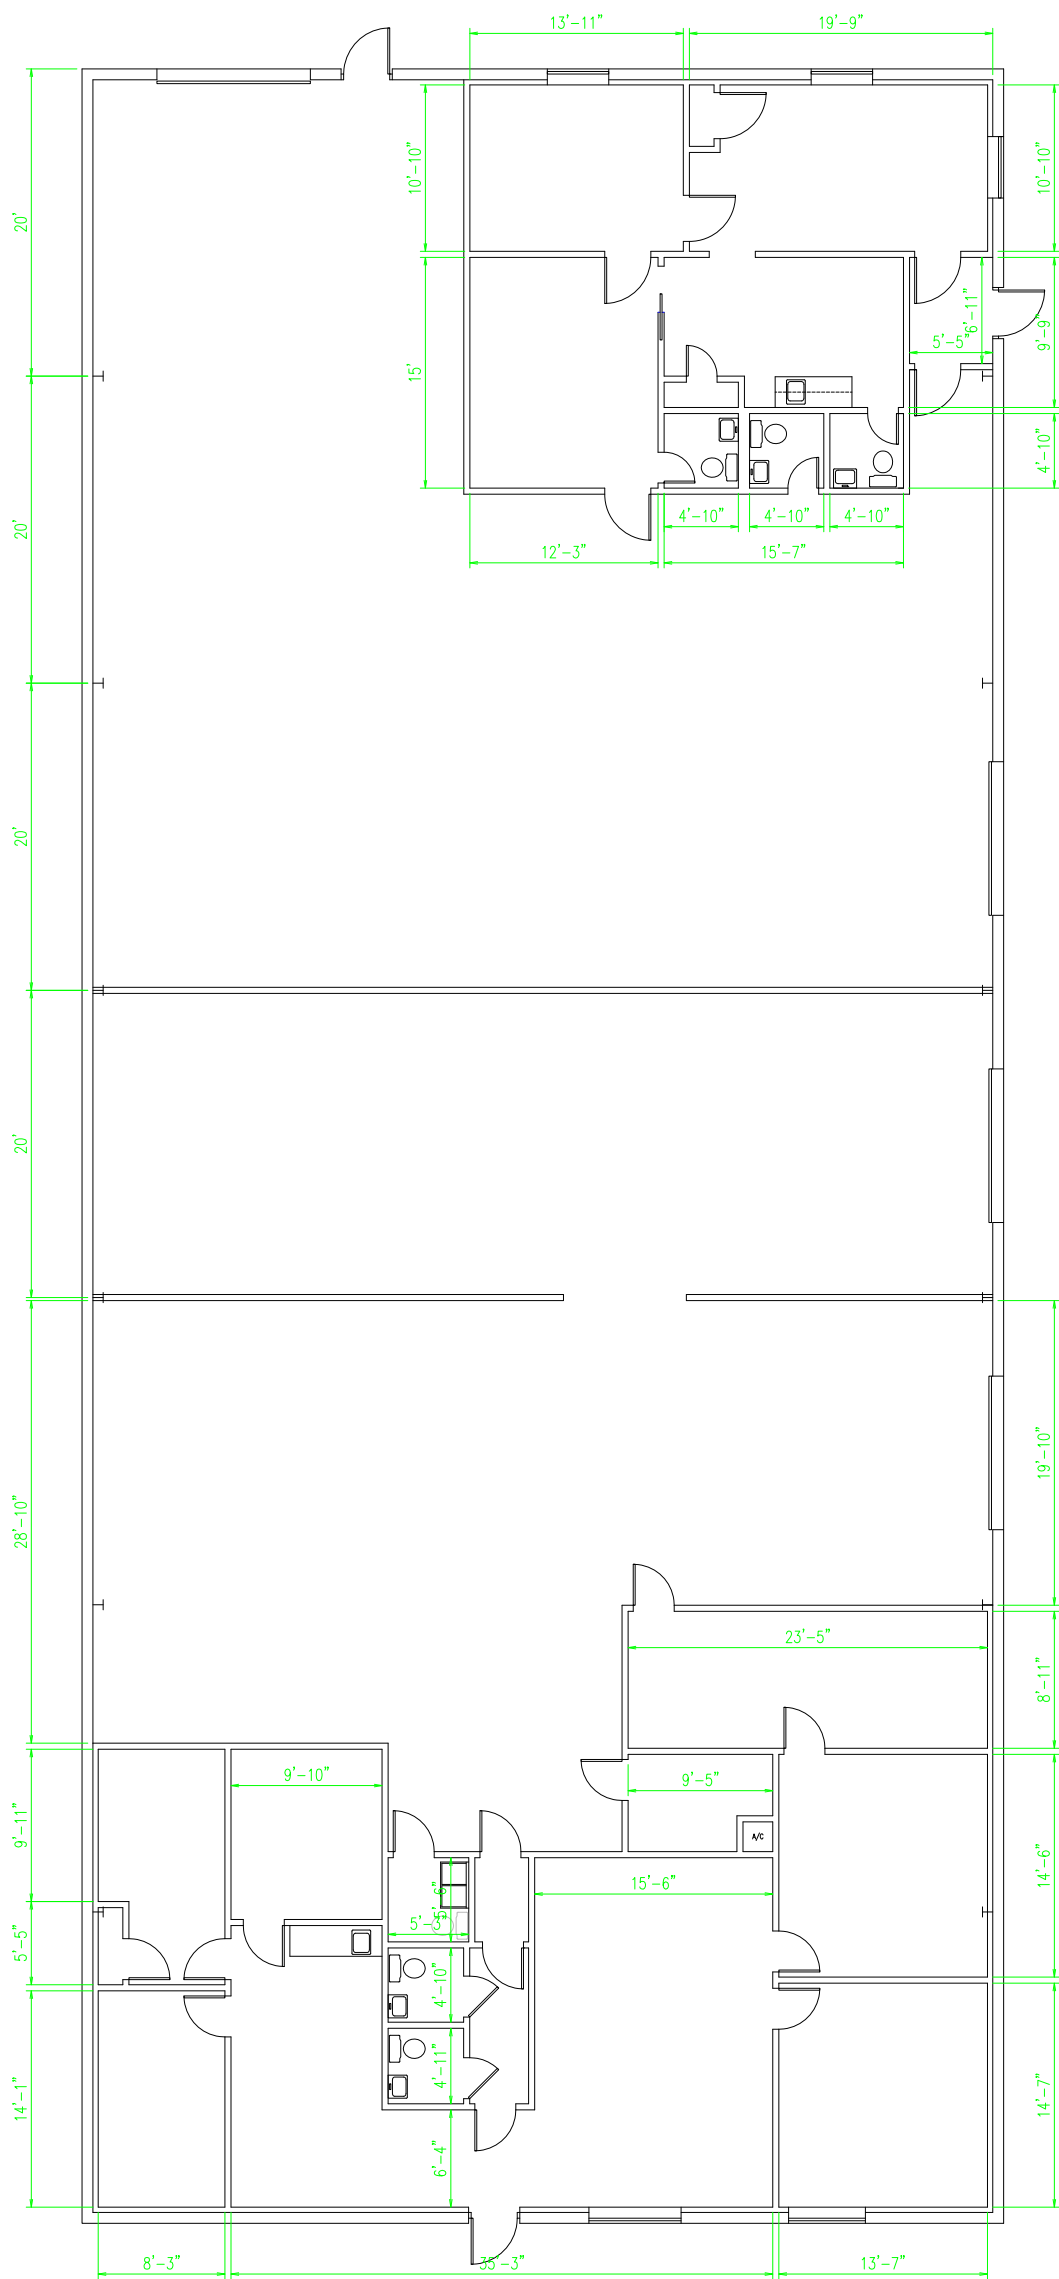

THIS PLAN IS INTENDED FOR REPRESENTATIONAL PURPOSES ONLY. ALL INFORMATION IS SUBJECT TO CHANGE.