


CONTRACT DOCUMENTS ARE PROTECTED BY UNITED STATES COPYRIGHT LAW. THEY HAVE BEEN PREPARED SPECIFICALLY FOR THE PROJECT IDENTIFIED AND ARE NOT SUITABLE FOR USE ON ANY OTHER PROJECT OR AT ANY OTHER LOCATION WITHOUT THE WRITTEN PERMISSION OF THE ARCHITECT. ALL RIGHTS ARE RESERVED TO MURRAY ARCHITECTS.



AREA CALCULATIONS

FIRST FLOOR	
329 DECATUR	1,849 SQFT
331 DECATUR	1,784 SQFT
TOTAL	3,633 SQFT
SECOND FLOOR	
UNIT 201	864 SQFT
UNIT 202	802 SQFT
STAIR WELL CIRCULATION	100 SQFT
TOTAL	1,766 SQFT
3RD FLOOR	
301 LIVING	1441 SQFT
PATIO	271 SQFT
302 LIVING	1,350 SQFT
302 PATIO	271 SQFT
STAIR WELL CIRULATION	200 SQFT
TOTAL	3,533 SQFT

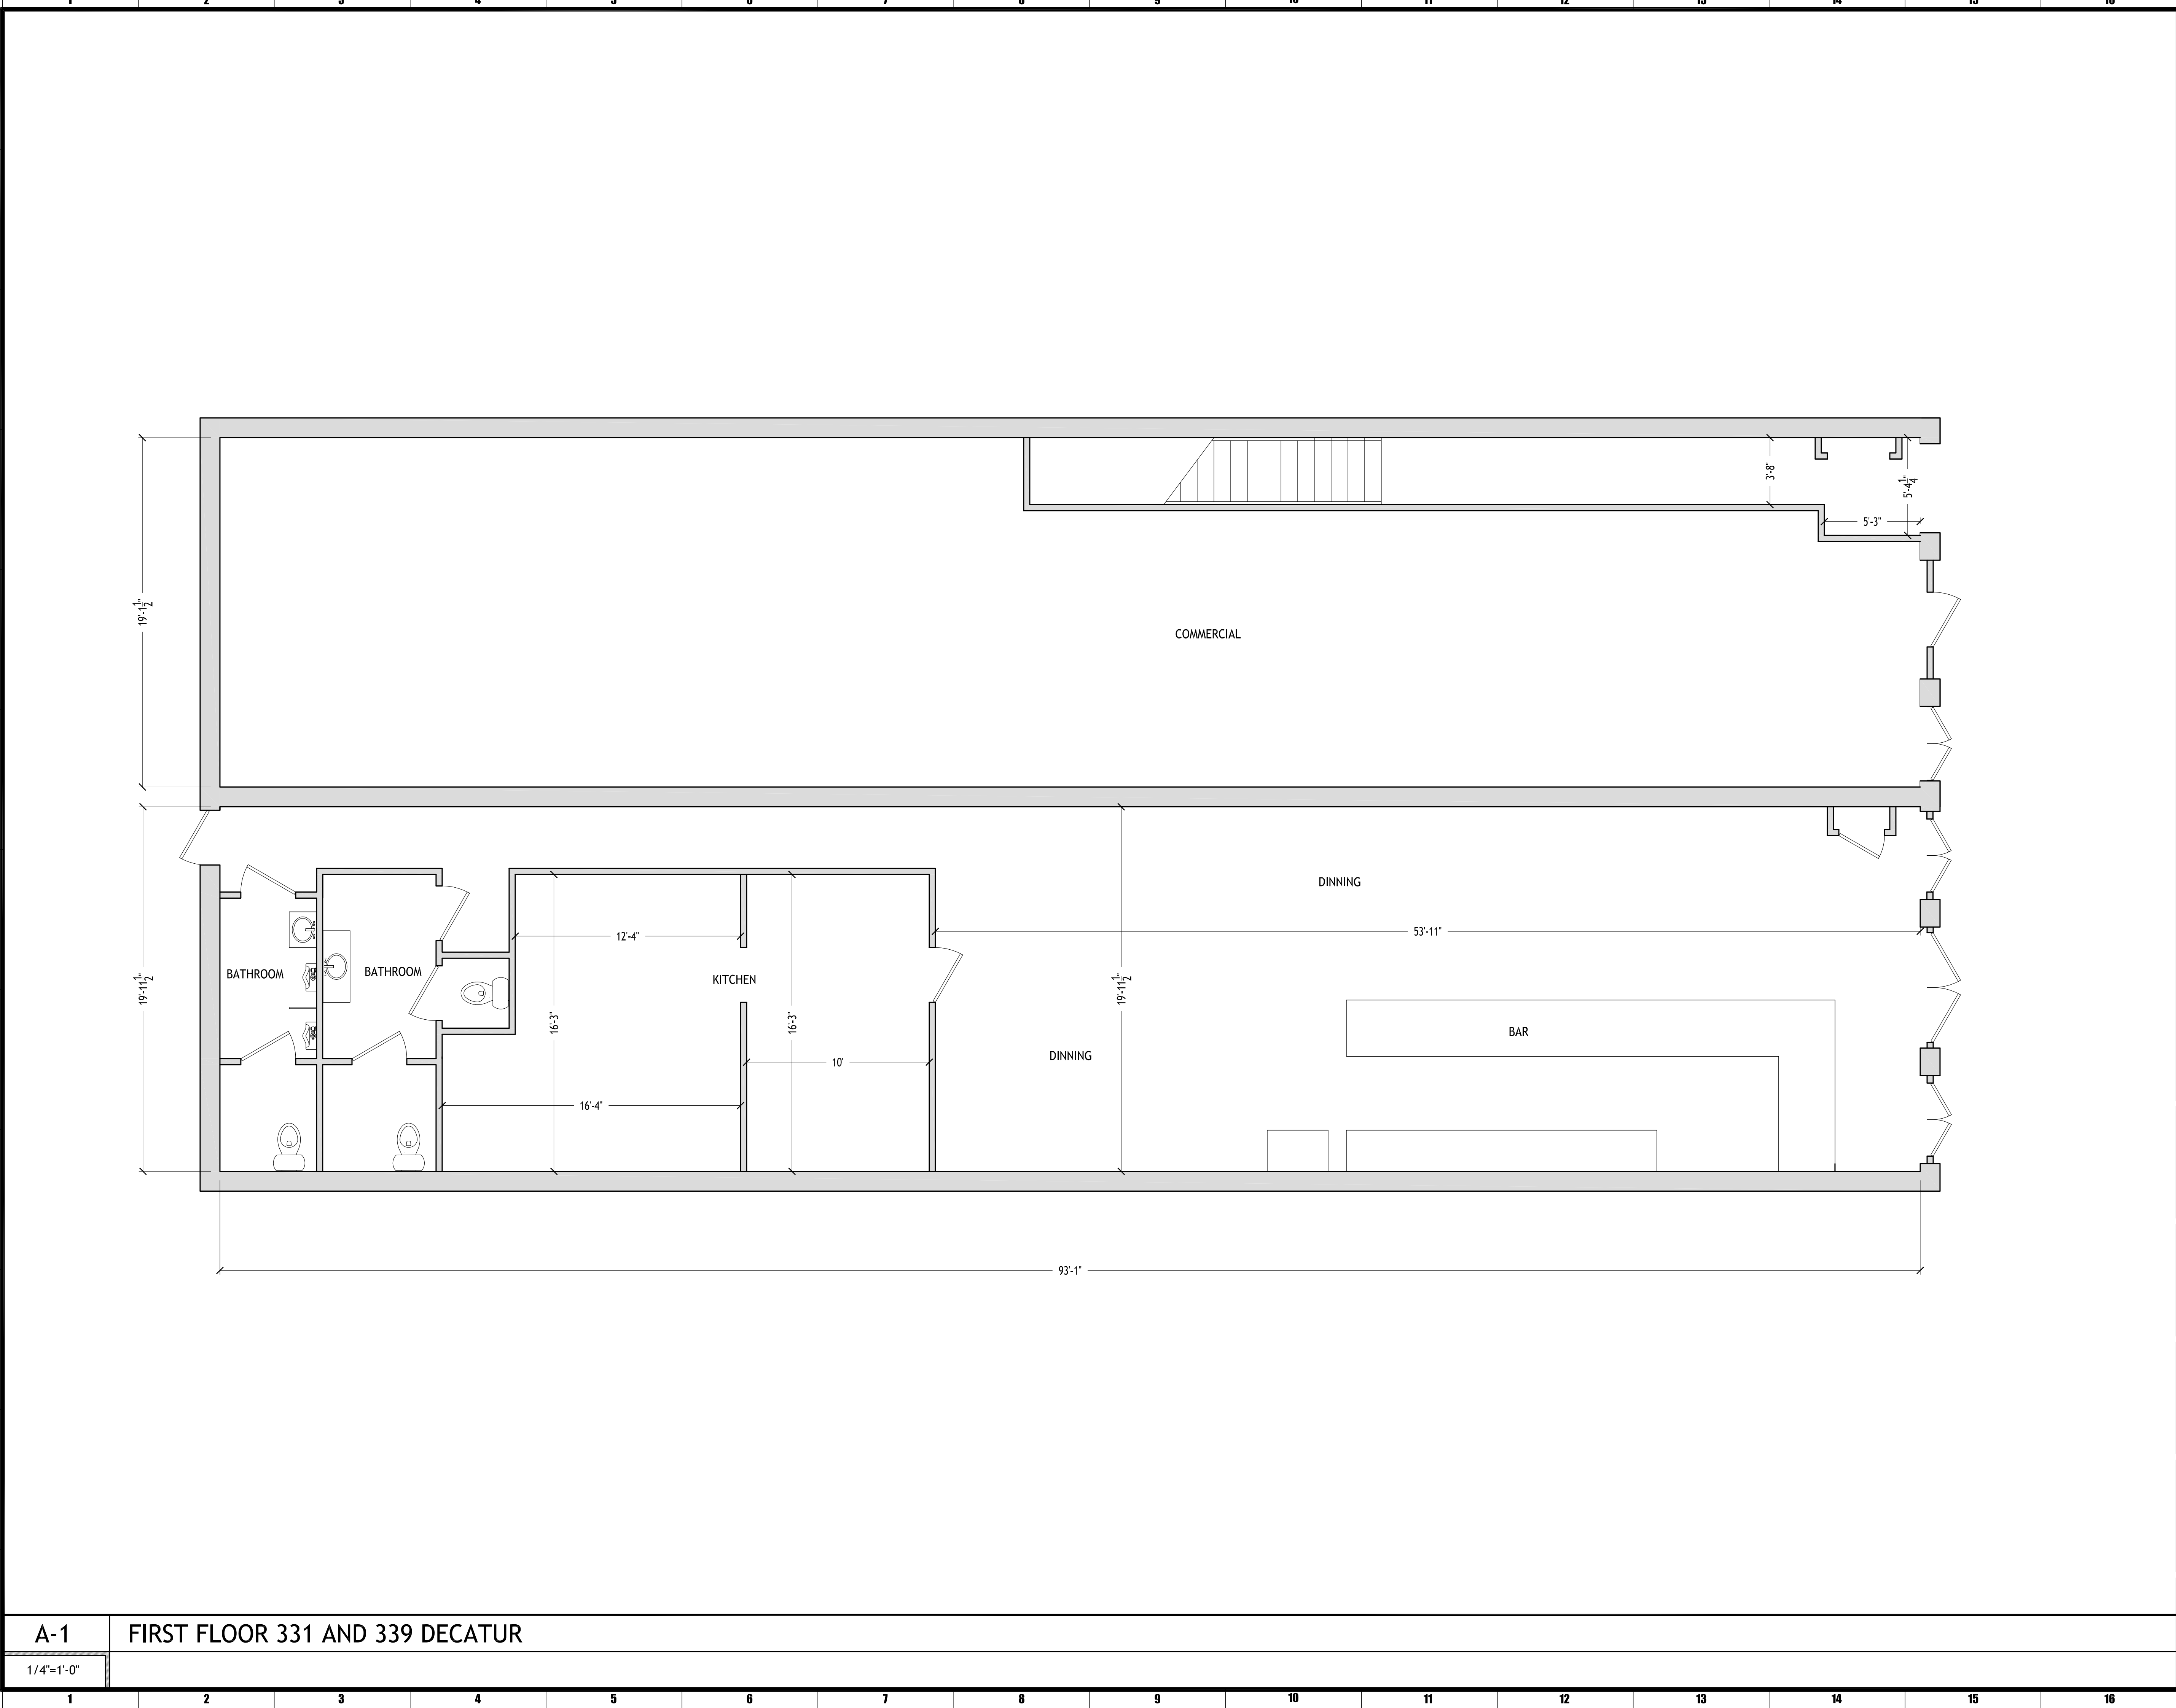

13760 river road

denver, la 70047

(985) 764-7276

fax (985) 725-0382

no.	revisions	date
1		
2		
3		
4		
5		
6		

329 AND 331 DECATUR

329 AND 331 DECATUR STREET, NEW ORLEANS LA 70130

331 AND 329 FIRST FLOOR

seal



project number

1445

date

11.10.14

phase

AS BUILT

drawing number

A.1.1