


APPROXIMATE SQUARE FOOTAGE

TENANT SPACE: 2,083 S.F.

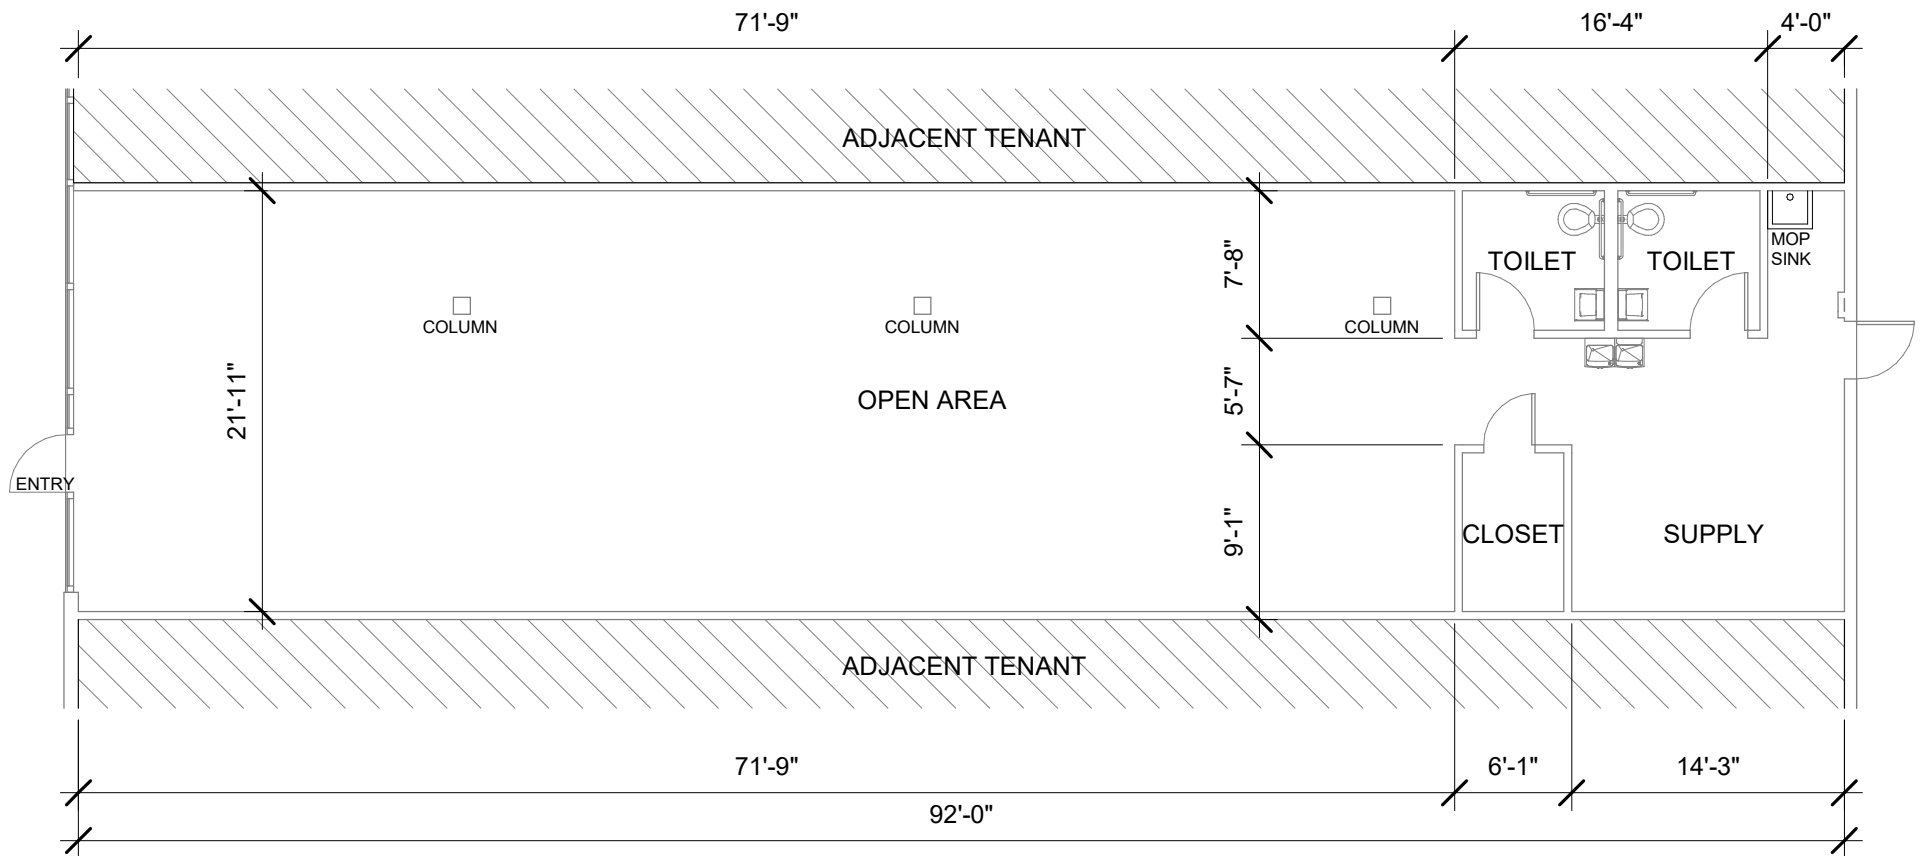

Sam Rue, Architect, LLC
phone: 337-581-2152

Project:
AN EXISTING TENANT SPACE FOR
DWIGHT ANDRUS REAL ESTATE

5419 JOHNSTON STREET
LAFAYETTE, LA 70503

DIMENSIONS HAVE
BEEN ROUNDED
TO THE NEAREST
INCH FOR CLARITY

EXISTING PLAN

Project number 2024.017

Date 03-25-2024

Drawn by SR

Checked by SR

Ax-101

Scale 1" = 10'-0"