


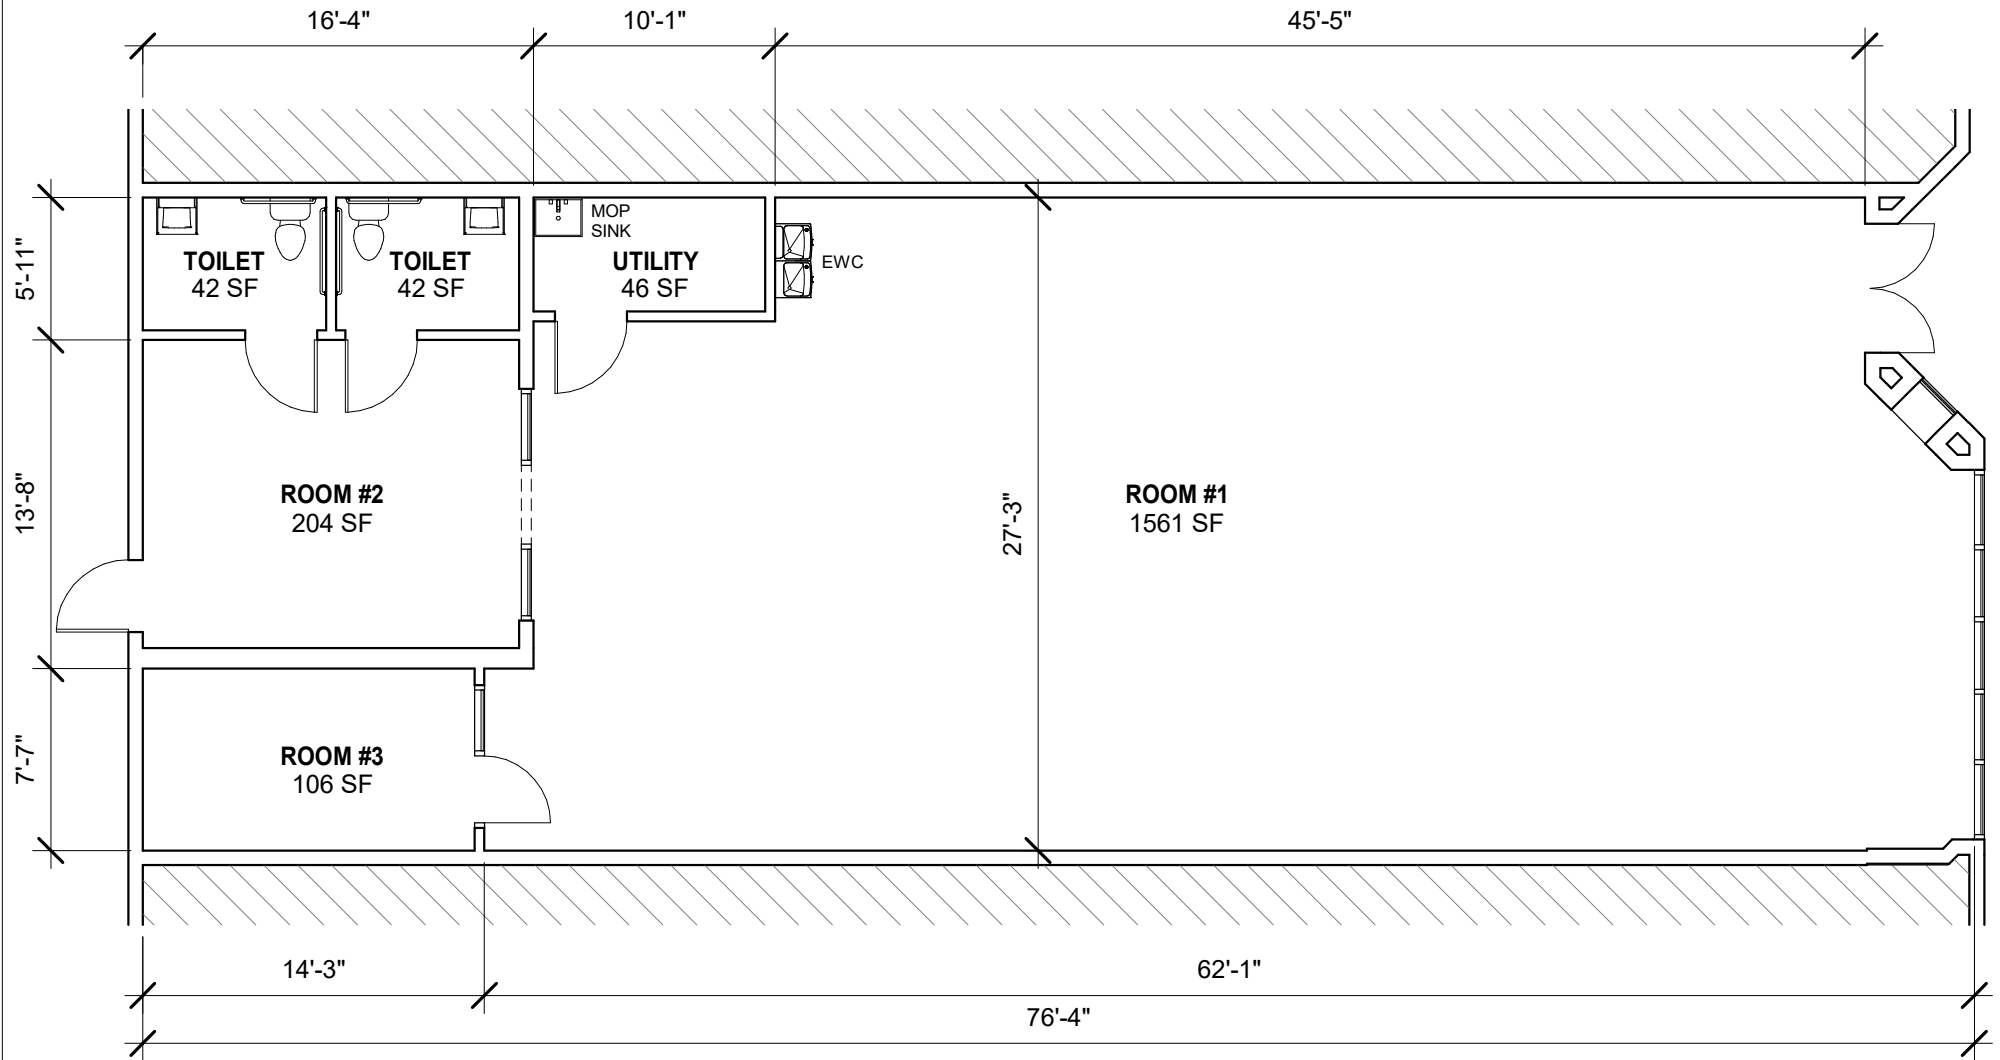

1 **FIRST FLOOR PLAN**
1/8" = 1'-0"

SQUARE FOOTAGE

TENANT SPACE: 2,149 S.F.



Sam Rue, Architect, LLC
phone: 337-581-2152

Project:
AN EXISTING TENANT SPACE FOR
DWIGHT ANDRUS REAL ESTATE

5433 JOHNSTON STREET
LAFAYETTE, LA 70503

DIMENSIONS HAVE
BEEN ROUNDED
TO THE NEAREST
INCH FOR CLARITY

EXISTING PLAN

Project number	2022.063
Date	01-10-2023
Drawn by	SR
Checked by	SR

Ax-101

Scale 1/8" = 1'-0"