



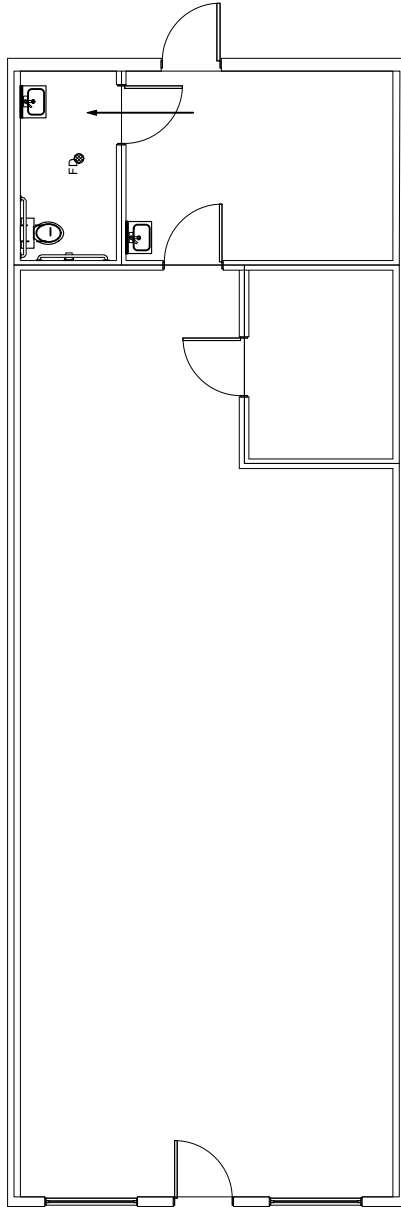

PARKWAY PLAZA

2001 EVANGELINE THRUWAY, LAFAYETTE, LA
TOTAL CENTER: 136,707.06 SQ. FT.

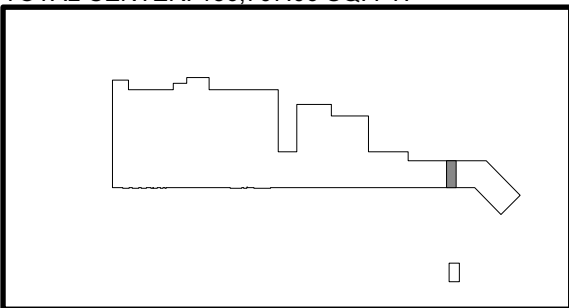

KEY PLAN

SUITE - 2025

SCALE: 1" = 10'

TOTAL AREA

1,250 SQ.FT.