



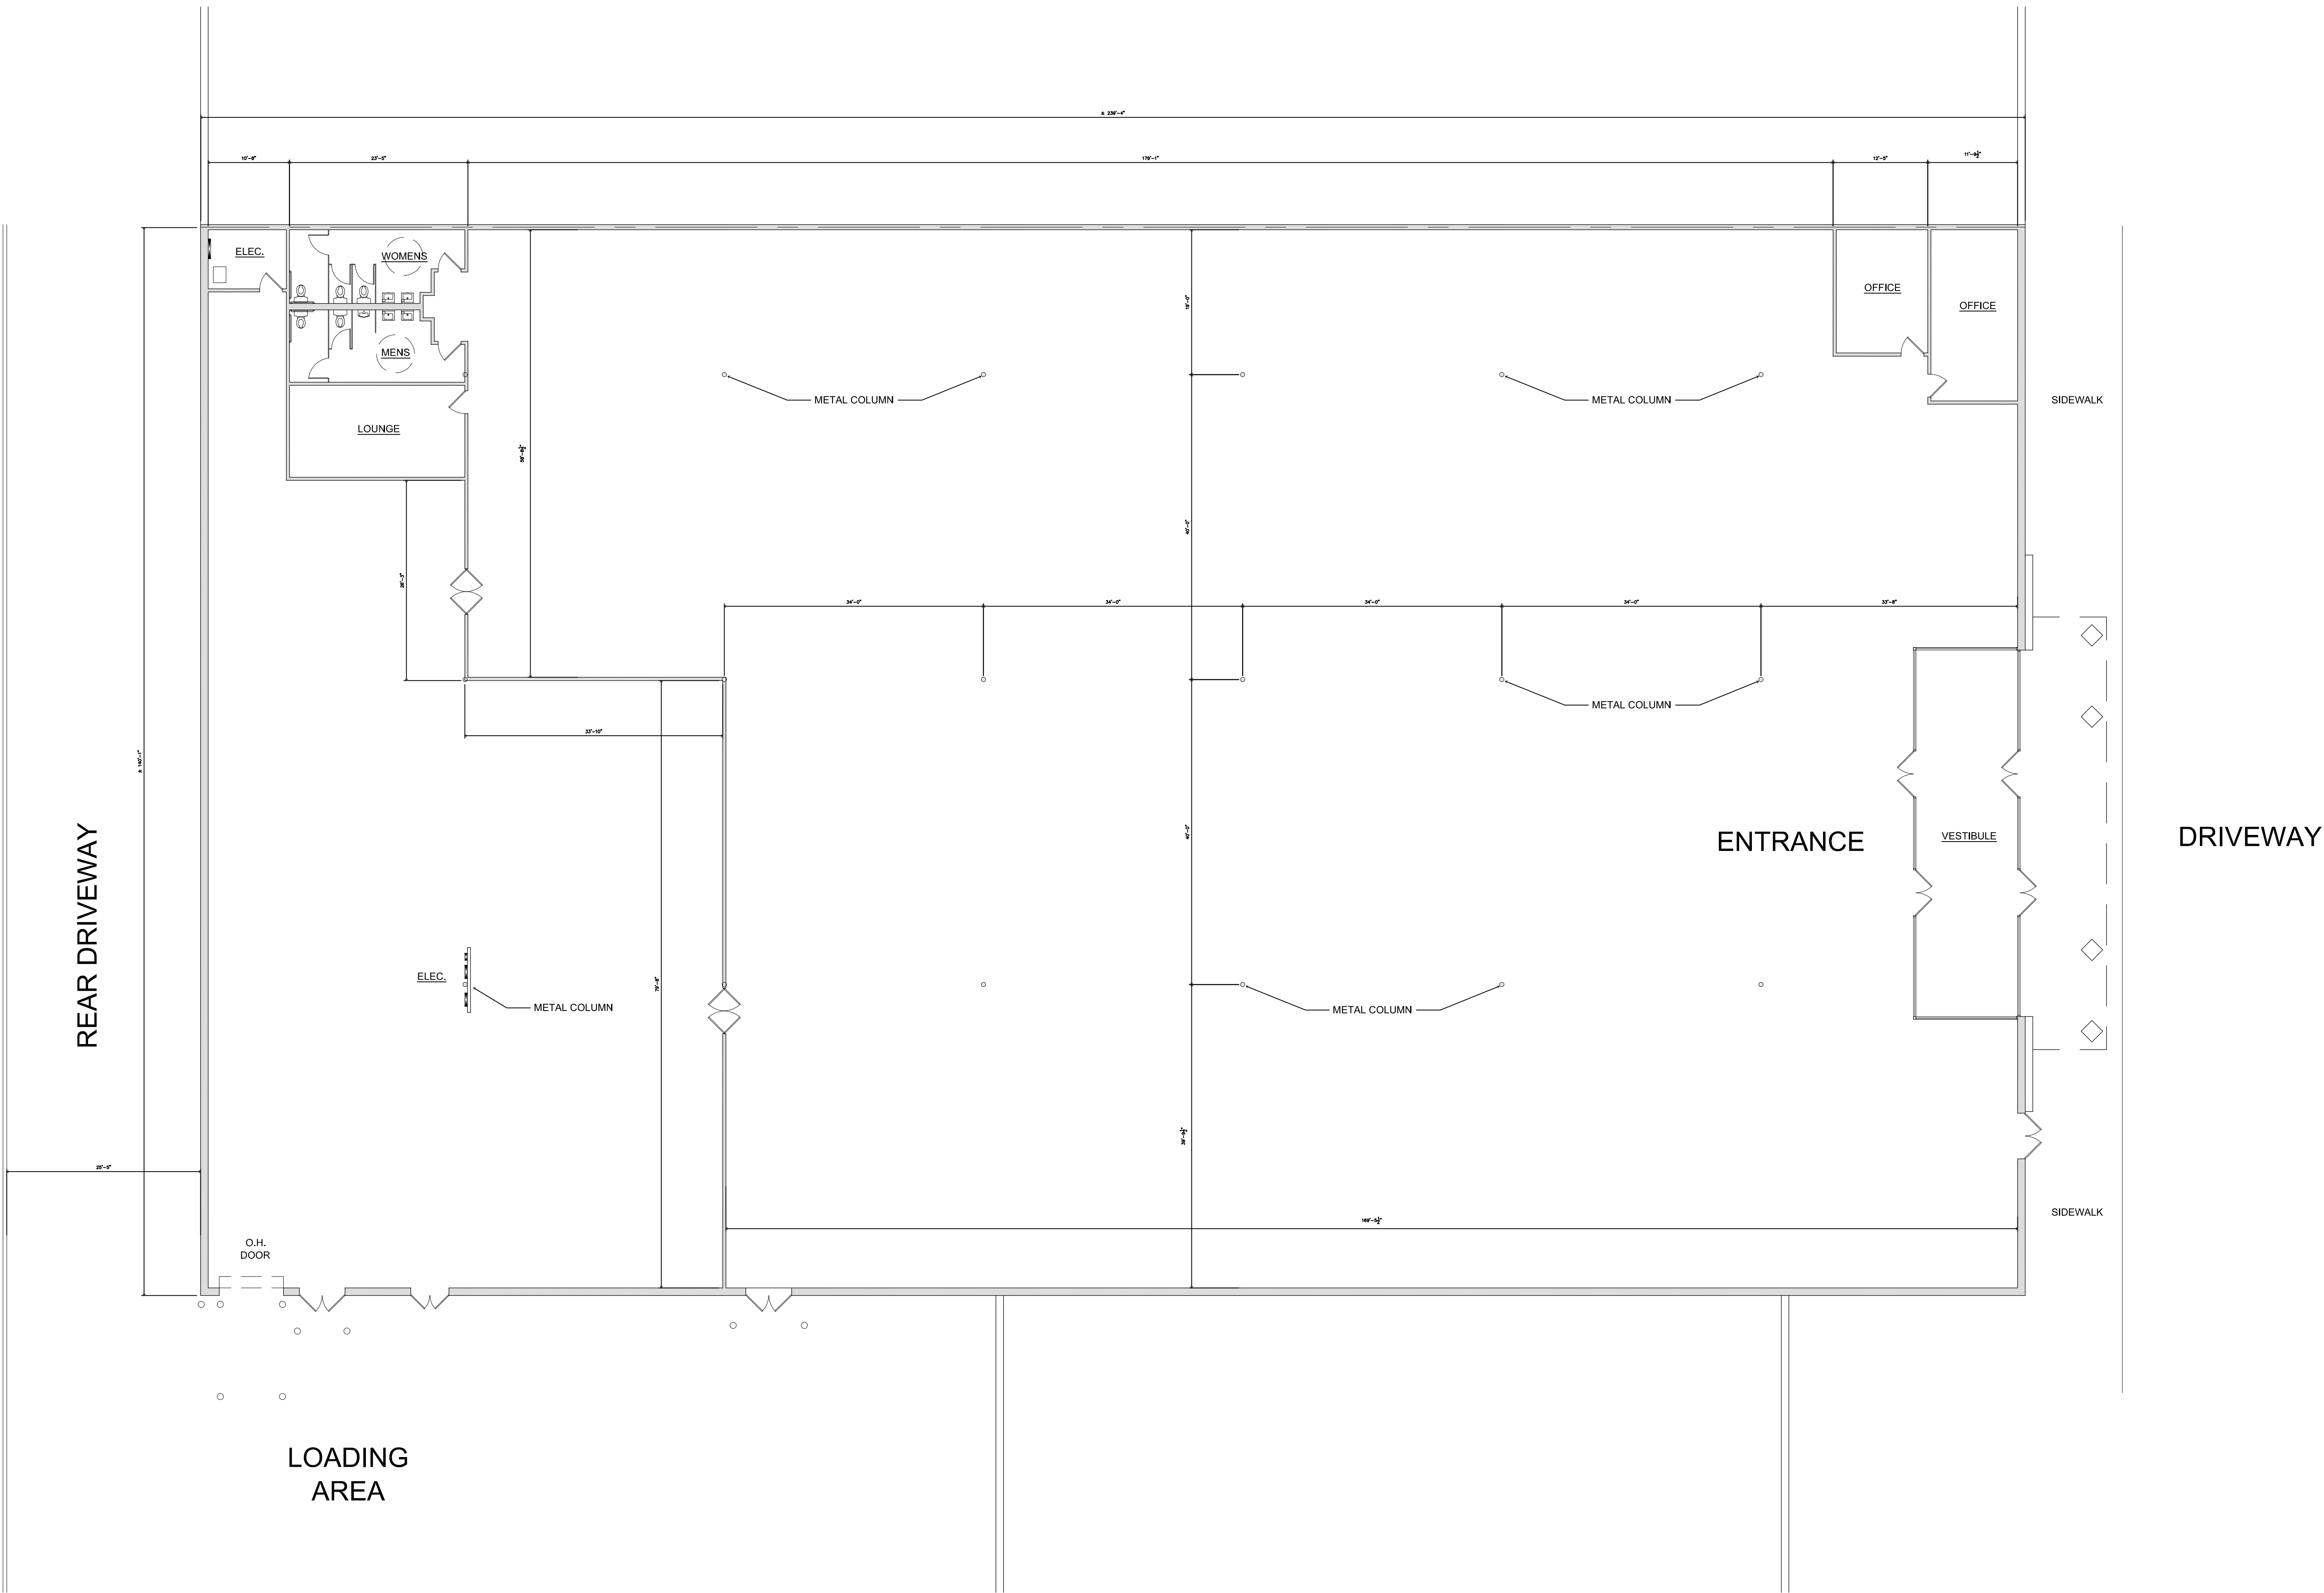

1 EXISTING FLOOR PLAN - ± 33,502 S.F.
SCALE: 3/32" = 1'-0"

- PLAN NOTES:**
- THIS DRAWING IS FOR PLANNING PURPOSES ONLY.
 - DO NOT SCALE FOR WORKING DRAWINGS. ALL DIMENSIONS SHALL BE VERIFIED ON SITE PRIOR TO COMMENCING ANY WORKS.

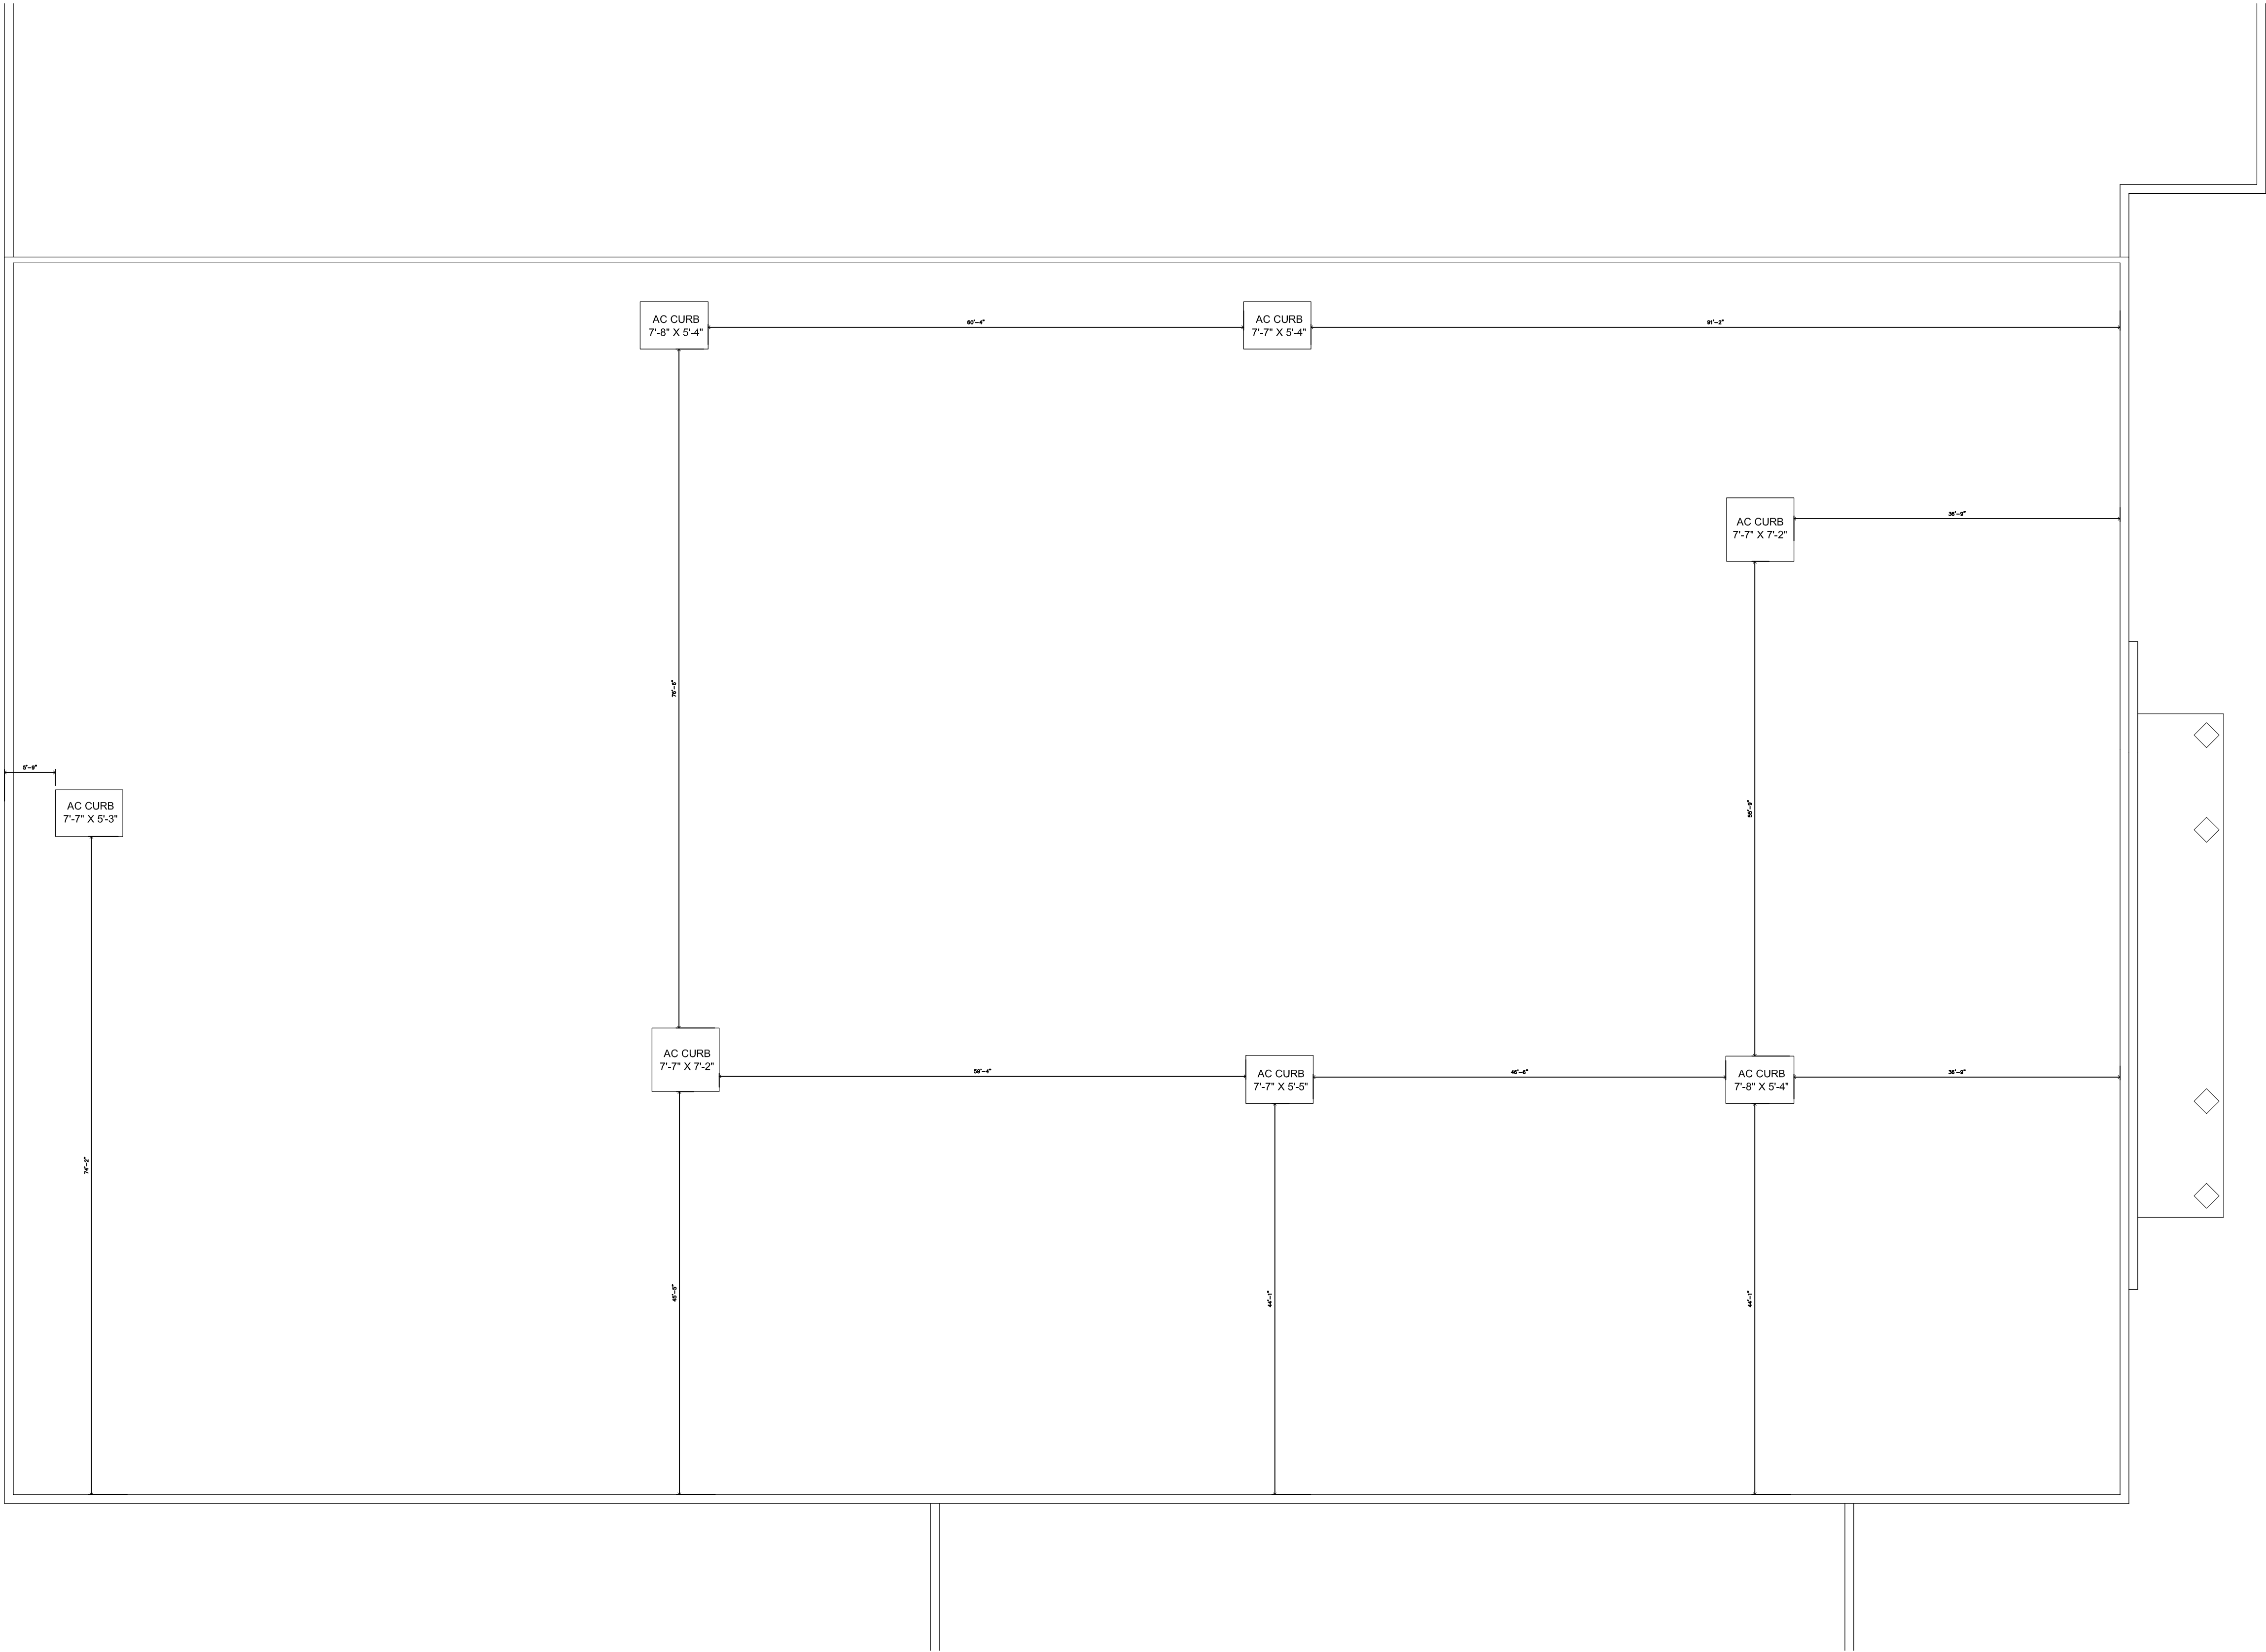

1

EXISTING AC CURB ROOF PLAN

SCALE: 3/32" = 1'-0"

PLAN NOTES:

- THIS DRAWING IS FOR PLANNING PURPOSES ONLY.
- DO NOT SCALE FOR WORKING DRAWINGS. ALL DIMENSIONS SHALL BE VERIFIED ON SITE PRIOR TO COMMENCING ANY WORKS.