


LEGAL DESCRIPTION:
A Parcel of land located in Sections 1 and 2, Township 7 South, Range 7 East, Tangipahoa Parish, Louisiana as shown hereon.

COPY

CLUB DELUXE ROAD

CLERK OF COURT

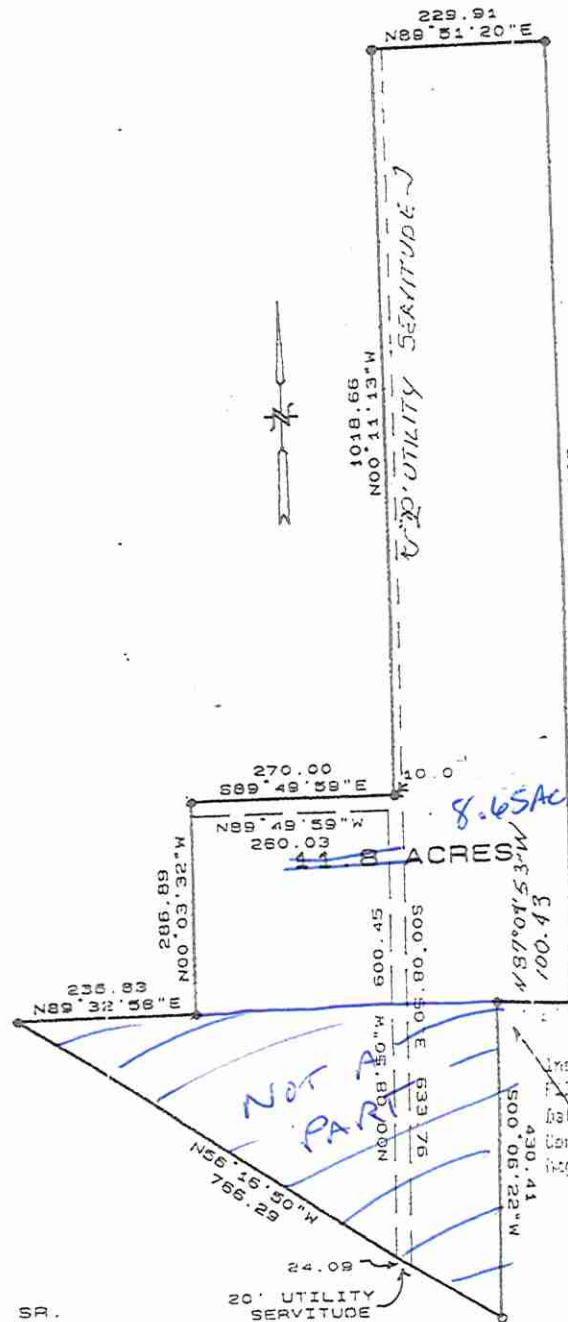

This Point is described as being West 865.92 feet from the Northeast Corner of Headright 47, Tangipahoa Parish Louisiana.

JOHN D. PIERCE, SR.
ELMWOOD PARK OF
STAMMANY LLC

LEGEND:

SET	1/2"	IRON	ROD
FOUND	OLD	IRON	ROD
FENCE	X-X	X-X	
BEARING	---	RECORD	
SETBACK	LINES	---	
FRONT		SIDE	
REAR		STREET	

This survey is based upon the description furnished by the client. There may be other restrictions in the shown on this plat that may exist in the public records. There are no visible encumbrances on the existing except those shown on the plat. If not otherwise noted, these restrictions refer to NGVD 1929 datum.

I, hereby certify that this map is based on a physical survey made on the ground in accordance with the minimum Standard Specifications for ALTA / ASOM Land Title Surveys. I warrant as to the accuracy of the information furnished by me, and the applicability of the standards of practice cited in LAC 48:LXI. Signature must be in AEO and signed by the undersigned for this plat to be certified.

DPR

REC. No. 4572

REFERENCES

PROFESSIONAL

WILSON-ROPE, PLS

LOUISIANA REGISTERED LAND SURVEYORS

1220 BURG DRIVE
MANDEVILLE, LOUISIANA 70448

MANDEVILLE, LOUISIANA 70448
TEL: (504) 826-3851 FAX: (504) 826-3826

CLASS/TYPE	"Q"	CNP:	220206 Q225 D
BOUNDARY	27 458 00	FIRM DATE:	18 SEP 51
FORMS/CARDS		FIRM ZONE:	"X"
SLAB TIE		BASE FLOOD:	
AS-BUILT		REVISED:	
JOB NO.	70215	SCALE:	1 inch = 200 ft