

1  
AB


AS BUILT

SCALE: N.T.S


SUITE 100

5,082 USF  
5,844 RSF

KEY PLAN

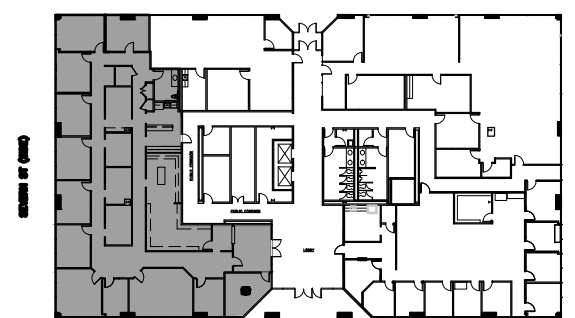

\*NOTE: ROOM SIZES AND SQUARE FOOTAGES ARE APPROXIMATE AND ARE TO ONLY PROVIDE A SENSE OF SCALE.

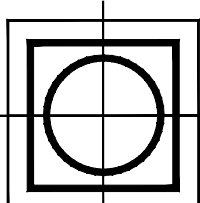

**AGL**  
COMMERCIAL INTERIORS  
AGLDESIGNS.COM  
433 METAIRIE ROAD  
SUITE 208  
METAIRIE, LA 70005  
504. 888. 9077

PROJECT

**SUITE 100**

SEVERN PLACE  
2450 SEVERN AVE  
METAIRIE, LA

TASK NO. 12202	DATE 07-08-25	
DRAWN BY MMH	FLOOR 1	SHEET AC
CHECKED BY RHT		