


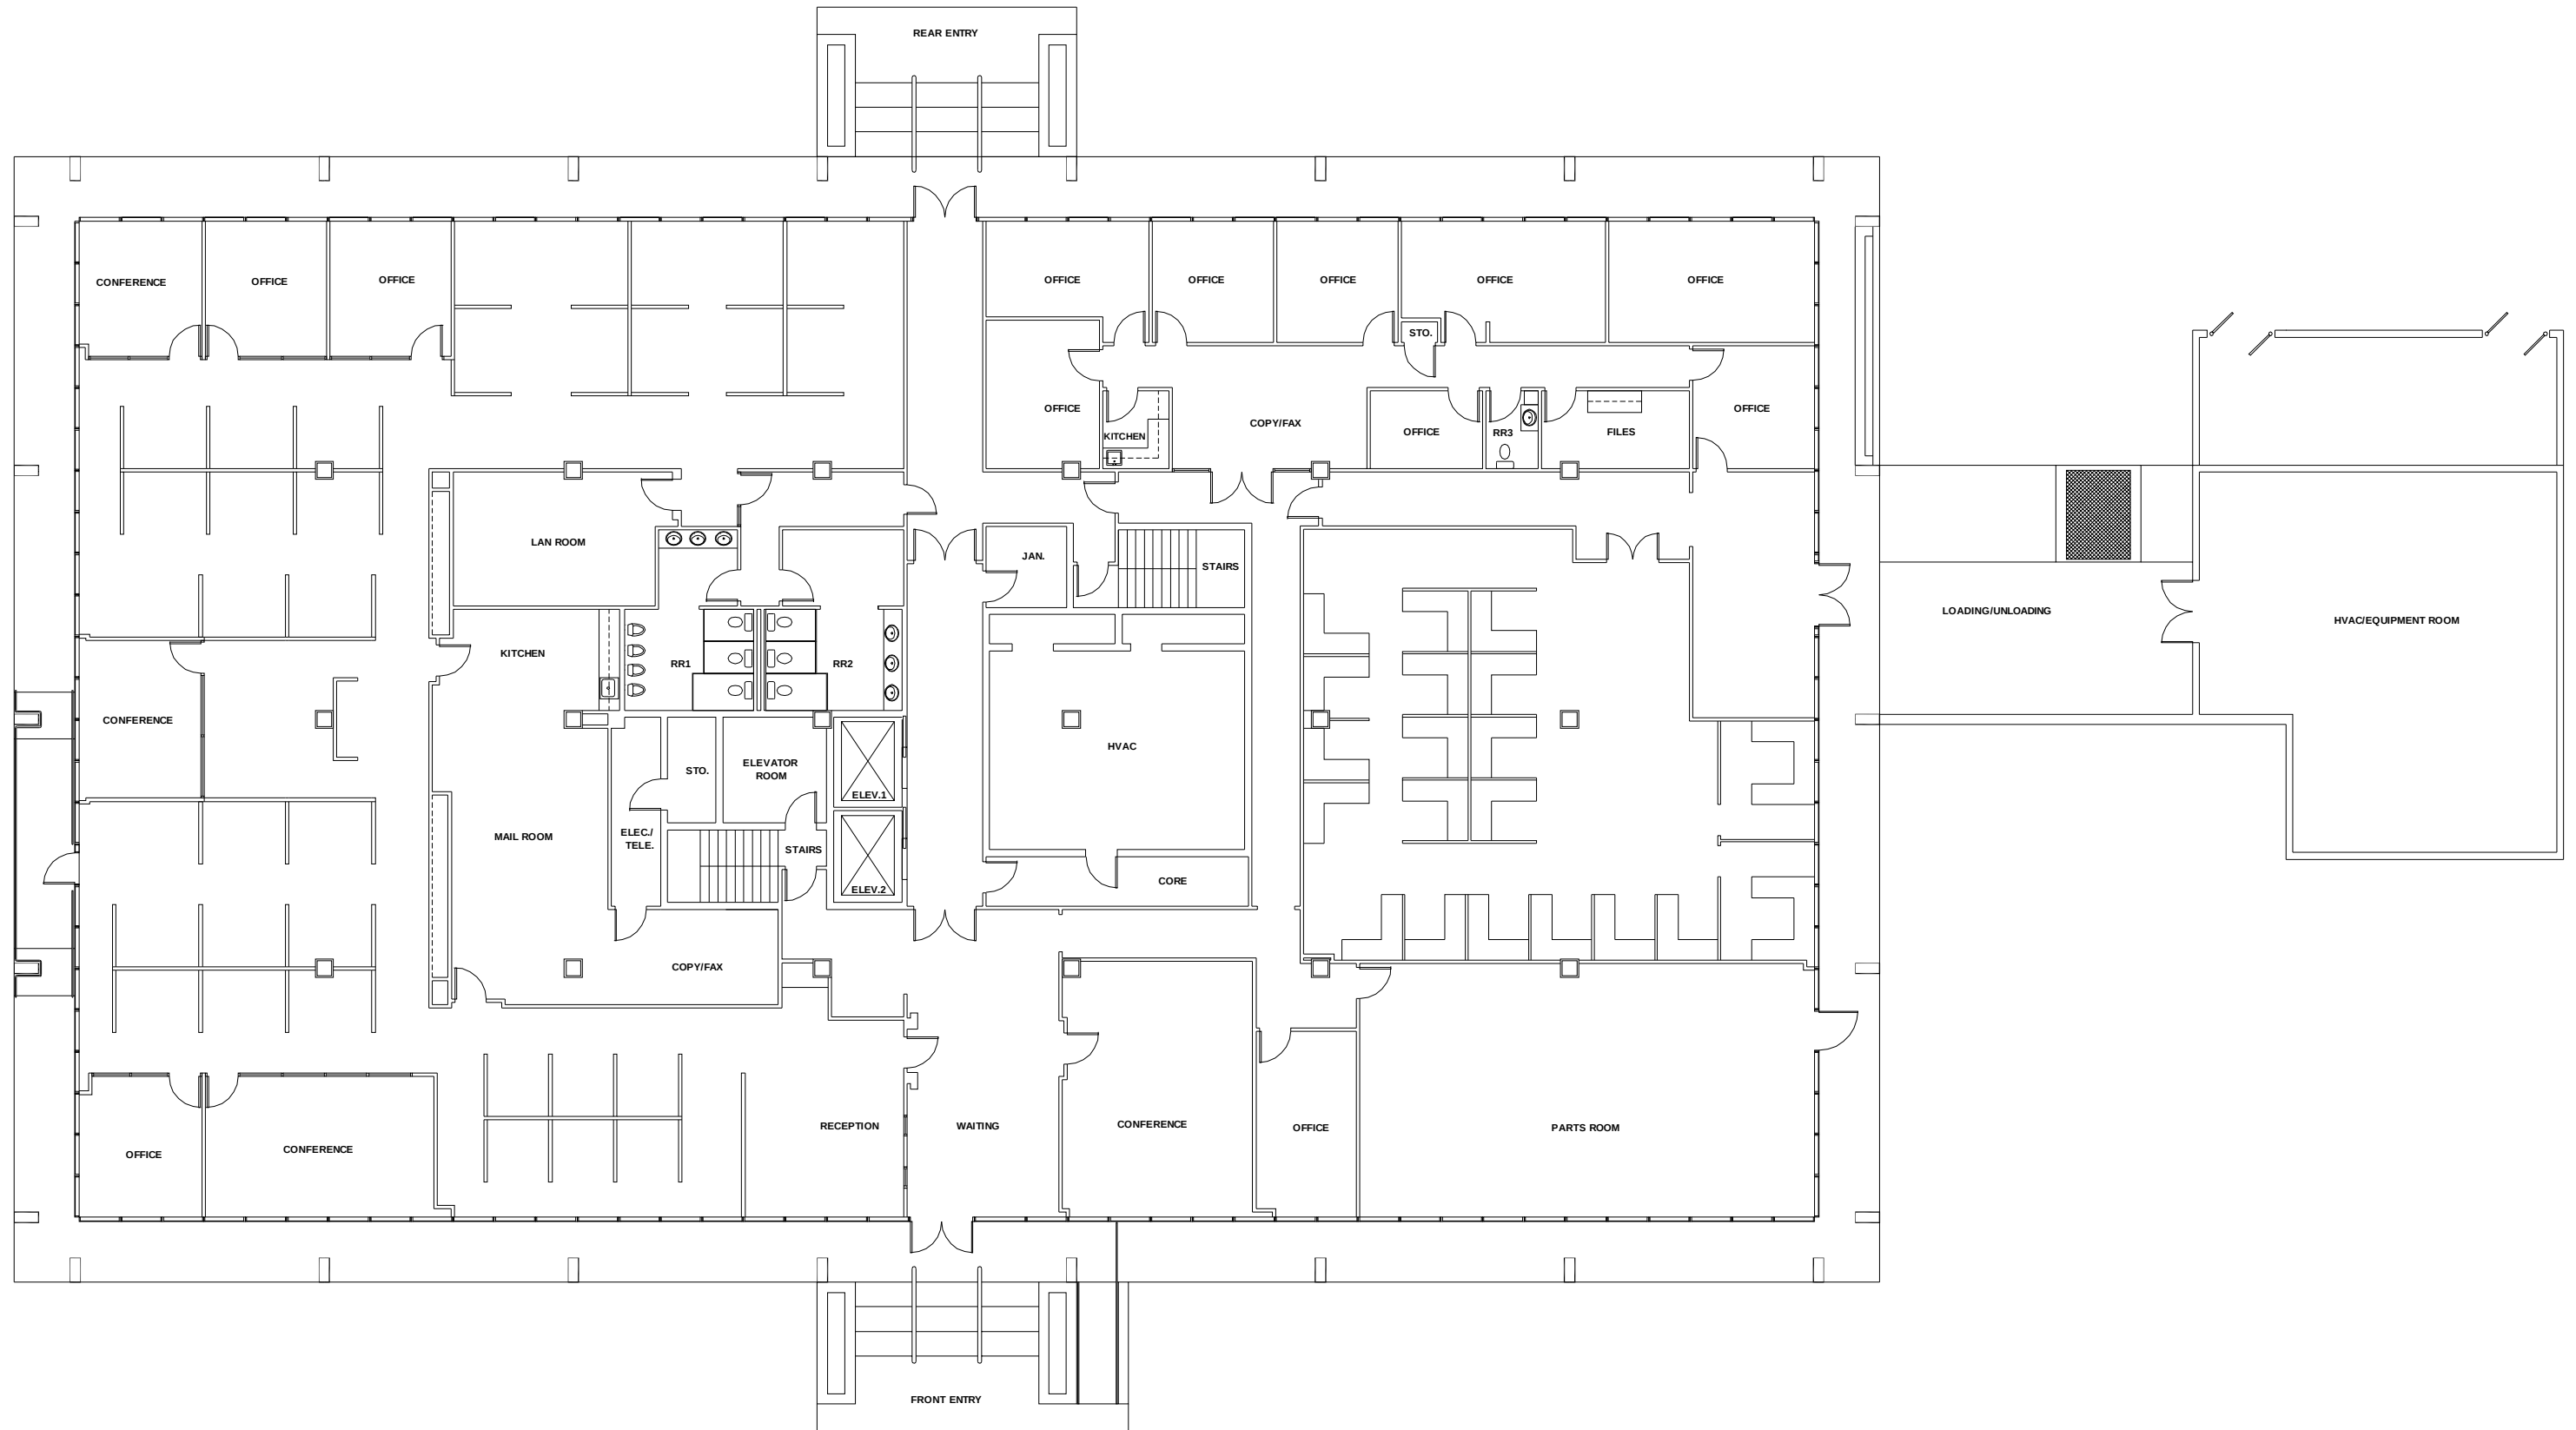

11100 MEAD ROAD

1 EXISTING FLOOR PLAN "FIRST FLOOR"

1/8"=1'-0"