



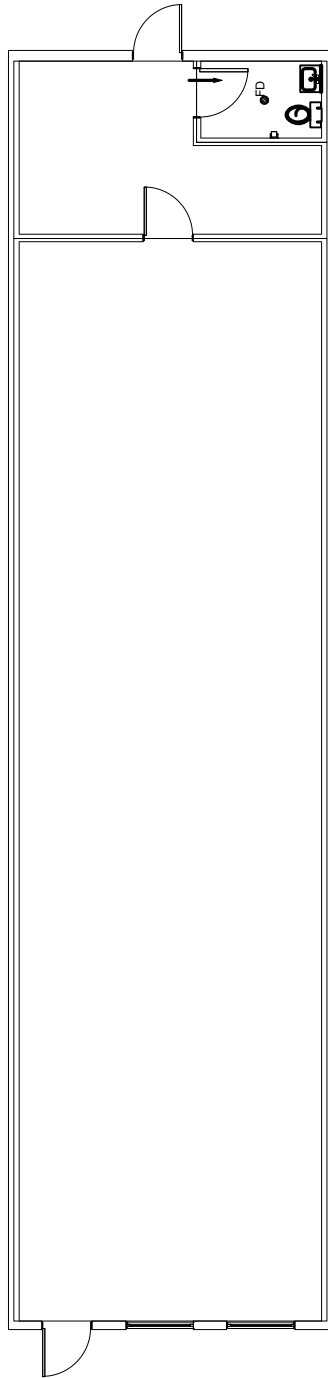

PARKWAY PLAZA

2001 EVANGELINE THRUWAY, LAFAYETTE, LA
TOTAL CENTER: 136,707.06 SQ. FT.

SUITE - 2011

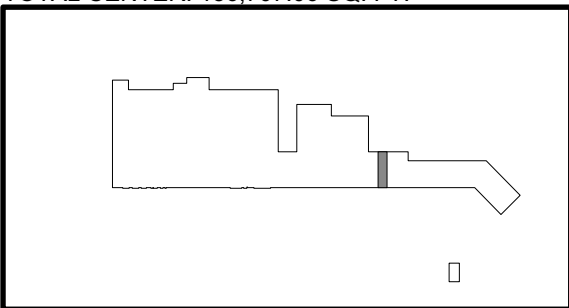

KEY PLAN

STORE FRONT	20'-3"
TOTAL AREA	1,600 SQ.FT.