



NAME	USABLE	COMMON (16%)	RENTABLE SF
Suite 300 (3A)	1,787 SF	286 SF	2,073 SF
3B	3,316 SF	531 SF	3,847 SF
Suite 304 (3C)	1,621 SF	259 SF	1,880 SF
Suite 310 (3D)	2,236 SF	358 SF	2,593 SF

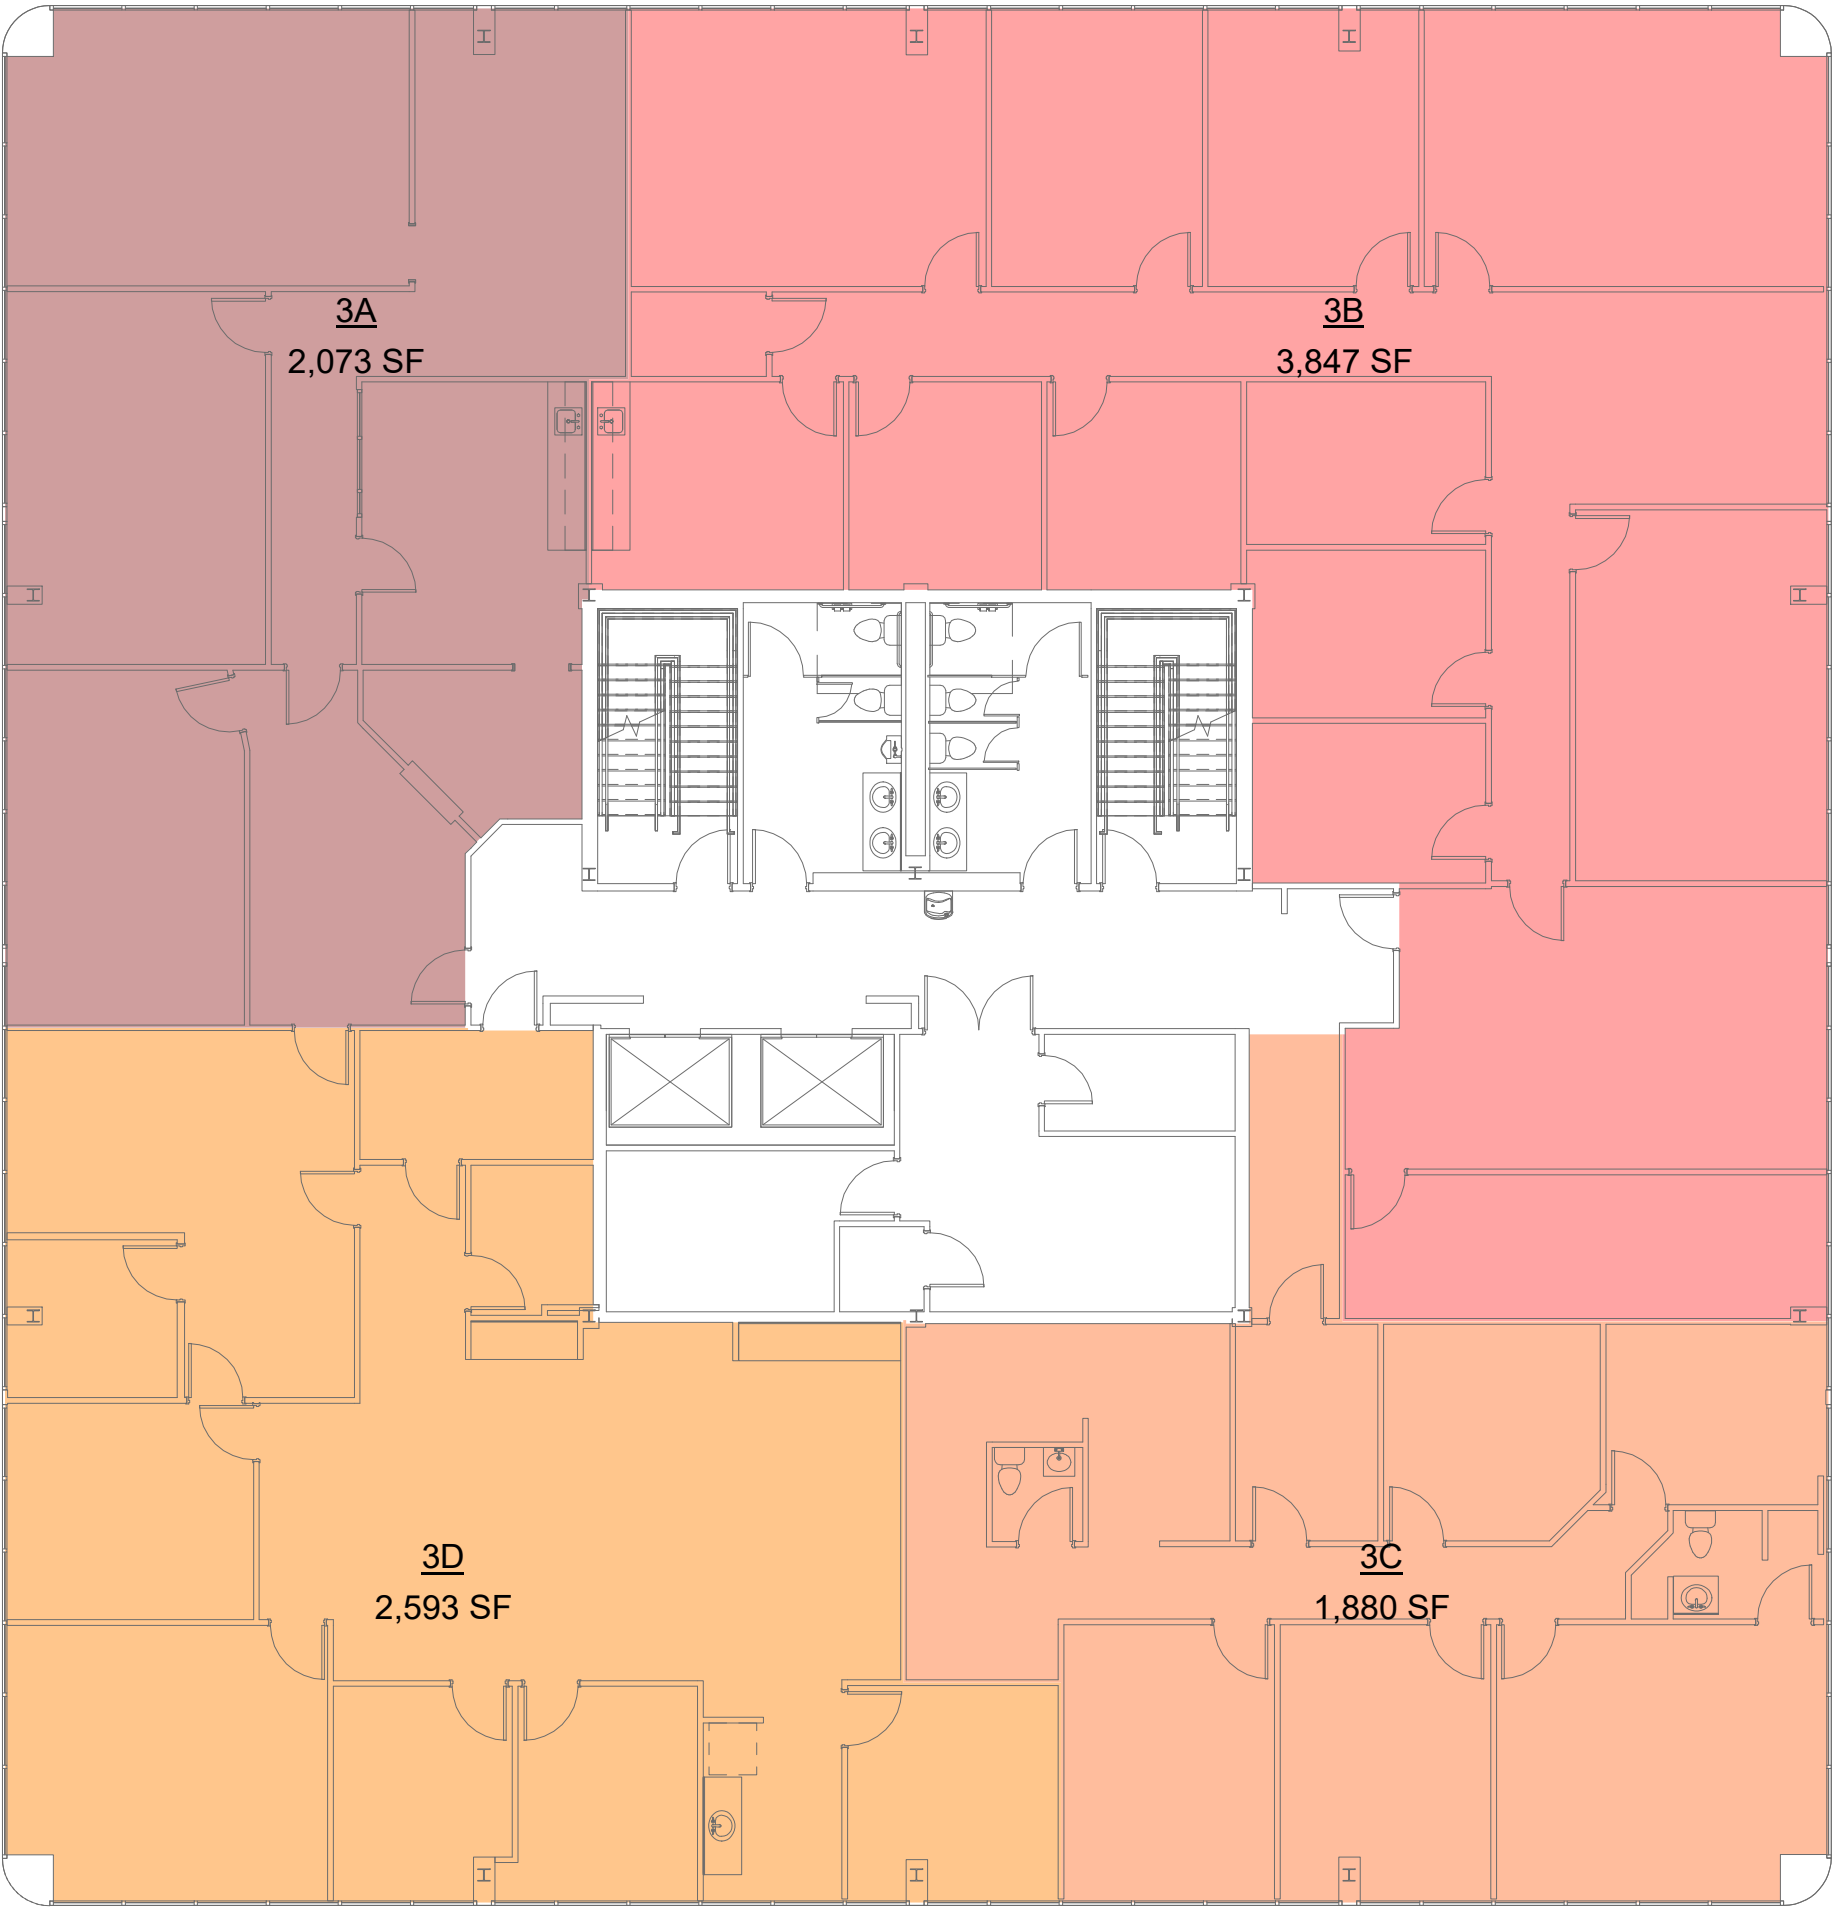

1 THIRD FLOOR
SCALE: 3/32" = 1'-0"

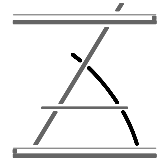

ZILER ARCHITECTS
A PROFESSIONAL ARCHITECTURAL CORPORATION
101 CALCO BLVD
LAFAYETTE, LOUISIANA 70503
337 269 6326 FAX 269 6380

DOCUMENTS PREPARED BY ZILER ARCHITECTS ARE INSTRUMENTS OF THE ARCHITECT'S SERVICE FOR USE SOLELY WITH RESPECT TO THIS PROJECT. THE ARCHITECT SHALL RETAIN ALL COMMON LAW, STATUTORY AND OTHER RESERVED RIGHTS, INCLUDING THE COPYRIGHT. THEY ARE NOT TO BE USED BY THE CONTRACTOR OR ANY SUBCONTRACTOR, MATERIAL OR EQUIPMENT SUPPLIERS OR ANYONE FOR OTHER PROJECTS OR FOR ADDITIONS TO THIS PROJECT OUTSIDE THE SCOPE OF THE WORK WITHOUT THE SPECIFIC WRITTEN CONSENT OF ZILER ARCHITECTS.

RECORD DRAWINGS FOR:

LAHAYE CENTER
201 RUE IBERVILLE
LAFAYETTE, LOUISIANA 70508



DATE ISSUED	08/16/21
REVISED	-
PLOT DATE	
08/18/21 4:13:39 PM	
DRAWN BY	
KEM	
CHECKED BY	
SRP	
PROJECT NO.	
2106	
SHEET NO.	
AC0.3	
OF	