


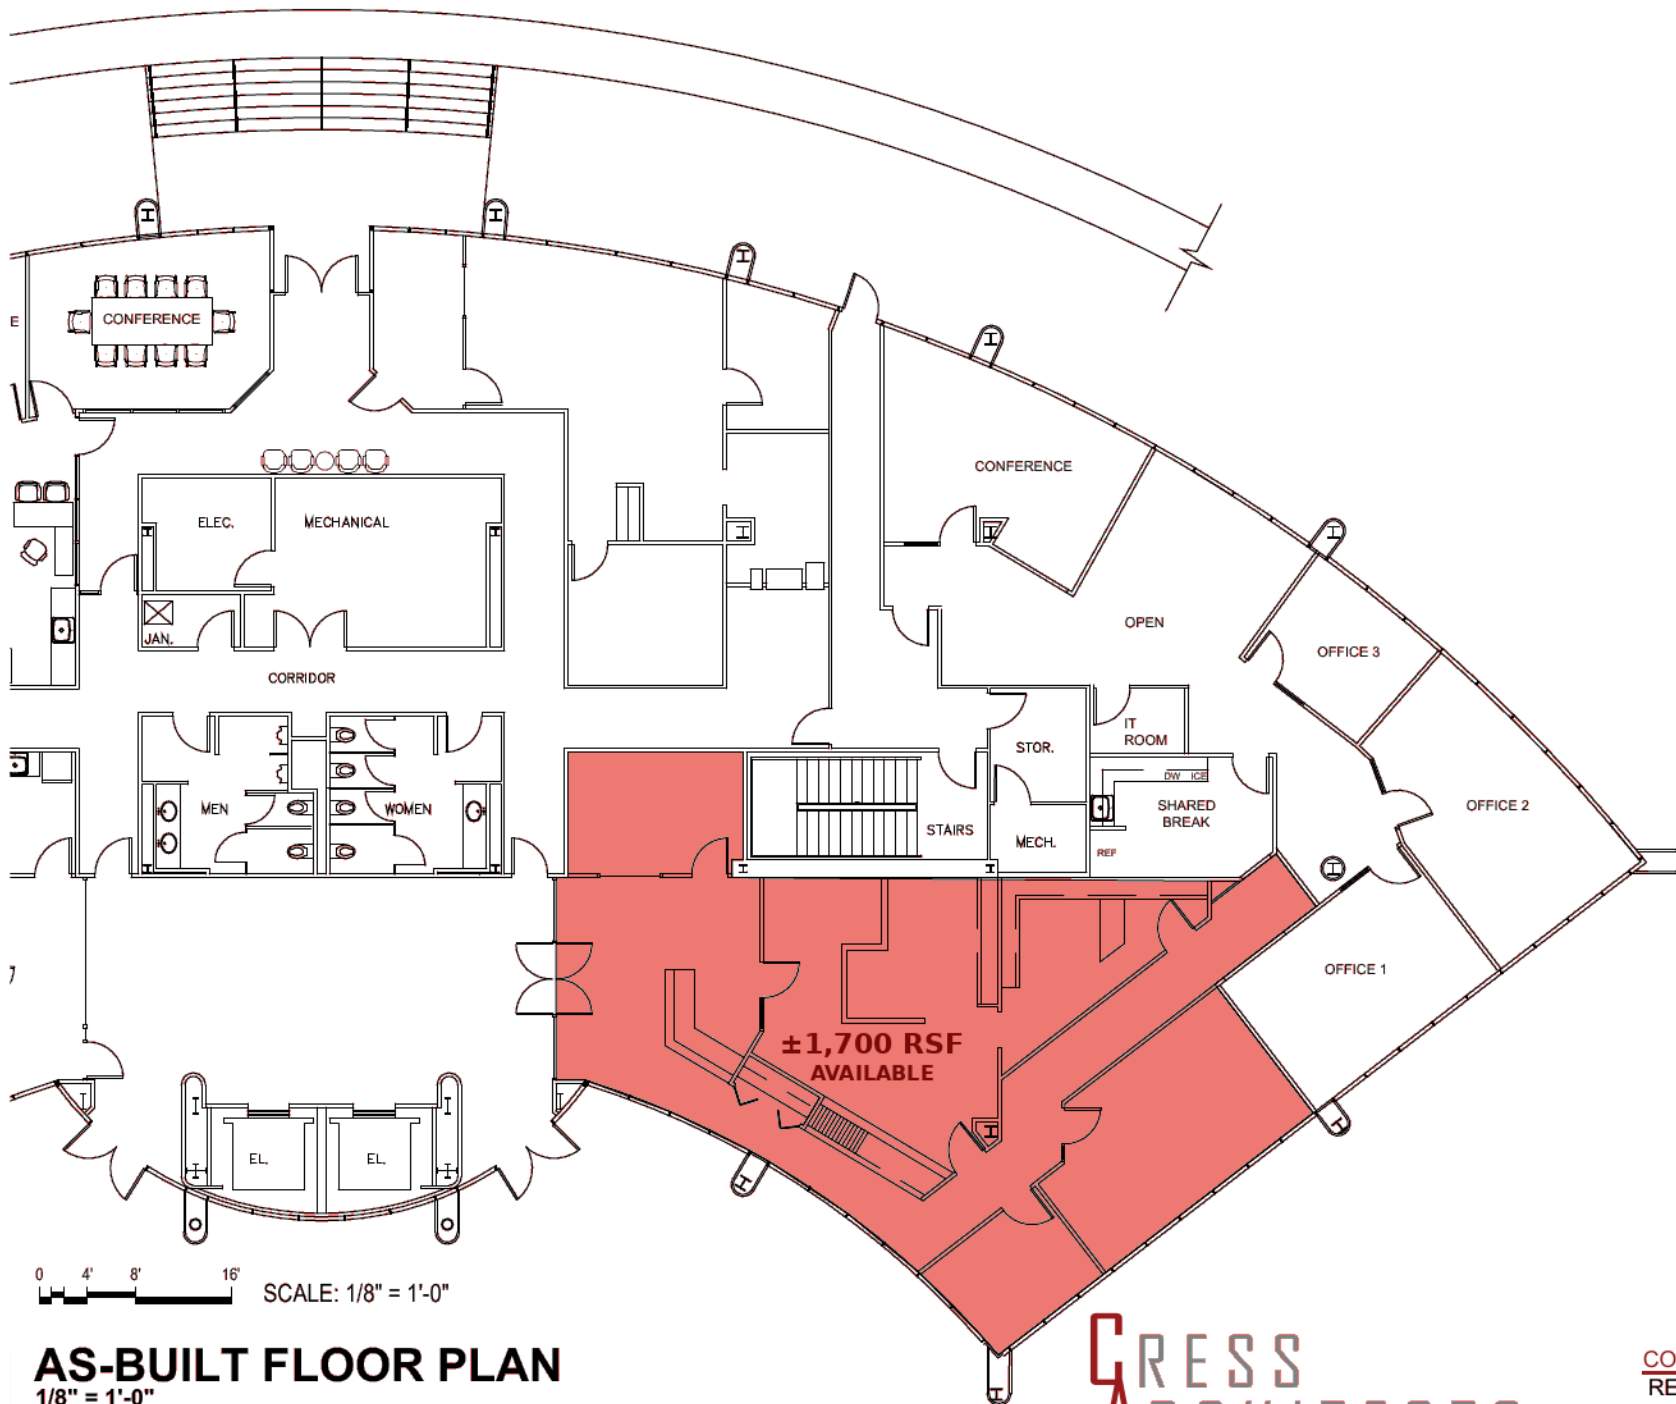

AS-BUILT FLOOR PLAN
1/8" = 1'-0"

CRESS
ARCHITECTS L.L.C.
A PROFESSIONAL ARCHITECTURAL COMPANY
P.O. BOX 65007
BATON ROUGE, LOUISIANA 70896 PH. (225) 937-7763

